



Purchasing Division

ADDENDUM NO. 2

DATE: June 22, 2020
FROM: City of Grand Junction Purchasing Division
TO: All Offerors
RE: Professional Engineering Services for N. Leach Creek Bridge at 24 Road & G Road
RFP-4802-20-DH

Offerors responding to the above referenced solicitation are hereby instructed that the requirements have been clarified, modified, superseded and supplemented as to this date as hereinafter described.

Please make note of the following clarifications:

1. Q. Are there any current and project traffic counts available?
 - A. No.
2. Q. Is there a crash analysis report?
 - A. No.
3. Q. Are "As-Builts" available at this time?
 - A. Yes, see attached.
4. Q. What are the project scope limits on G Road and 24 Road?
 - A. The bridge design project is limited to the area of G Road crossing North Leach Creek.
5. Q. Can the existing roundabout alignment indicated in the RFP be made available now?
 - A. The roundabout linework will be included in an addendum to this solicitation.
6. Q. Has the road overtopped from N. Leach Creek and if so, are flooding history records available?
 - A. No, we are not aware of any historic flooding of this crossing. The LOMR from FEMA will be included in this addendum for information.
7. Q. Does the City anticipate a section 404 permit?

- A. Yes.
- 8. Q. Are Environmental Clearances required?
 - A. At this time, only the 404 permit is required.
- 9. Q. Any state or federal funding tied to this project?
 - A. The G Road bridge construction does not have any state or federal funding.
- 10. Q. Is the survey and base mapping files recent or does the consultant need to survey?
 - A. All survey will be provided by the City.
- 11. Q. Is there cross sectional survey information of the creek for the bridge hydraulics?
 - A. Survey information will be provided by the City to the selected consultant.
- 12. Q. Is SUE required?
 - A. Yes.
- 13. Q. Is Landscaping required?
 - A. Minor landscaping (reseeding at the end of the project) will be required.
- 14. Q. To assist us in understanding and developing a proposal for the subject RFP, I am requesting the following documents:
 - 1. Hydraulics Report,
 - 2. Geotechnical Investigation Report,
 - 3. Plan & Profile of the proposed roundabout and G Road in the vicinity of the North Leach Creek channel

as noted in Section 4.3 of the RFP (page 16, City Provided Materials).

- A. 1. This information will be given to the awarded firm.
 - 2. This information will be given to the awarded firm.
 - 3. Some of this is included with this addendum.
- 15. The following additional scope is being added to this solicitation:

4.1 General/Background:

The City of Grand Junction has applied for funding from CDOT as part of the Multi-modal Opportunity Fund to design and construct a bicycle path along 24 Road. The proposed trail will connect the existing trail north of F 1/2 Road to Canyon View Park. This trail will cross the existing Leach Creek drainageway and G Road before connecting to the Park.

The selected Consulting Civil Engineering firm or team shall provide all services necessary to perform design engineering of the new bridge to carry the new bike path over Leach Creek and the new underpass to cross G Road near Canyon View Park.

The design project for the two bike path crossings calls for the following:

- Identification of up to 2 structure alternatives at each crossing to be evaluated by the City (with oversight by CDOT) and appropriate stakeholders. Alternatives shall be presented in a Structure Selection Report which includes horizontal and vertical alignment of the proposed structures, Engineers Estimate of Probable Cost, State and Federal Permitting requirements, potential constraints to construction schedule or other limiting factors, and potential utility conflicts
- Preliminary Design Review (Field Inspection Review, FIR) with plans of chosen alternative for review by City and stakeholders (including but not limited to: US Army Corps of Engineers, Xcel Energy, Grand Valley Power, Ute Water, City of Grand Junction Sewer and Stormwater utilities, and CDOT)
- Final Design Review (Final Office Review, FOR) with Construction Drawings, Standard and Project Specifications, and Probable Opinion of Construction Costs for review by City and stakeholders
- Preparation of construction plans and documents to be included in the Solicitation for Construction Documents published by the City. Assistance with bidding services includes aiding the City Project Manager in responding to questions and completing the addenda as part of the contractor selection process.

This additional scope for the design of the bridge structures of the bike path shall be kept separate from the G Road bridge design project since the bike path project may be partially funded by CDOT. This includes all cost estimates and billing during the design must be submitted to the City as separate files.

The proposed design schedule for the bike path bridge and underpass will lag behind the schedule for the G Road bridge design.

4.2 Special Conditions/Provisions

4.2.1 Price/Fees: Project pricing shall be all inclusive, to include, but not be limited to: labor, materials, equipment, travel, design, drawings, engineering work, shipping/freight, licenses, permits, fees, etc.

Provide a not to exceed cost using Solicitation Response Form found in Section 7, accompanied by a complete list of costs breakdown.

This additional scope pricing for the 24 Road Bike Path Bridge and Underpass design shall be submitted separately from the G Road Bridge design.

Firm shall provide Fee Proposals electronically with their bid submission as a separate electronic file titled “Fee Proposal G Road Bridge” and “Fee Proposal 24 Road Bike Path Bridge and Underpass.”

All fees will be considered by the Owner to be negotiable. The fee proposal will not be opened by the Owner until a prospective awarded firm has been determined. Then, only the fee proposal of the successful preferred proposer will be opened. However, the Owner reserves the right to open the competing fee proposals and consider their contents if a contract agreement cannot be negotiated with the number one selected firm or if it is considered in the best interest of the Owner to do so.

4.3 Specifications/Scope of Services:

Task 2 – Preliminary Design Plans (FIR) and Structure Selection Report

The Consultant will prepare preliminary/conceptual design plans and a Structure Selection Report for up to two (2) pedestrian bridge alternatives and up to two (2) underpass alternatives. The plan set for the bike path structures shall be separate from the plan set for the G Road bridge plan set, and will include at 30% complete level at a minimum the following:

- Plan, Foundation Layout and Cross-section of pedestrian bridge and underpass for up to two (2) alternatives based on the Geotechnical Investigation to be provided by the City.
- Plans shall follow CDOT format with City of Grand Junction title block.
- All design is to be coordinated with the City's bike path designer, both horizontal and vertical alignments.
- Hydraulic considerations for each defined alternative of the bike path pedestrian bridge.
- Bank stability and scour protection for each defined alternative if needed.
- Regulatory requirements for each defined alternative.
- Storm drainage shall be addressed at this level. MS4 stormwater design criteria are to be followed. A drainage report may be required depending on the structure selected.
- A FIR meeting with the City and CDOT is required. This meeting will be separate from the FIR meeting for the G Road Bridge.
- Any other pertinent detail that may weigh the decision of one alternative over another.
- Engineer's Opinion of Probable Cost for each design alternative.

The City will provide the following:

- Proposed 24 Road Bike Path alignment, linework, and Civil3D surfaces.
- Property ownership and property line information for the project (any ROW acquisition will be handled by the City)
- As-built drawings of existing facilities as available
- Previous hydraulic report for Leach Creek
- GIS data
- Survey, Base mapping and existing plan files
- Geotechnical Investigation Report

Task 3 – Final Design Plans and Project Specifications

In addition to the requirements in the original Scope of Services in the Solicitation, the Consultant shall keep the plans and specifications for the bike path structures separate from the G Road Bridge Final Design plans and specifications.

A FOR meeting with the City and CDOT is required (including a final cost estimate of the structures). This meeting will be separate from the FOR meeting for the G Road Bridge.

Task 4 – Construction Phase Services

The Consultant shall provide services as noted in the original solicitation during the pre-construction and construction phase for these two additional structures.

4.4 Attached Documents:

Bike Path Alignment (Preliminary 30% plans)


The original solicitation for the project noted above is amended as noted.

All other conditions of subject remain the same.

Respectfully,




Duane Hoff Jr., Senior Buyer
City of Grand Junction, Colorado

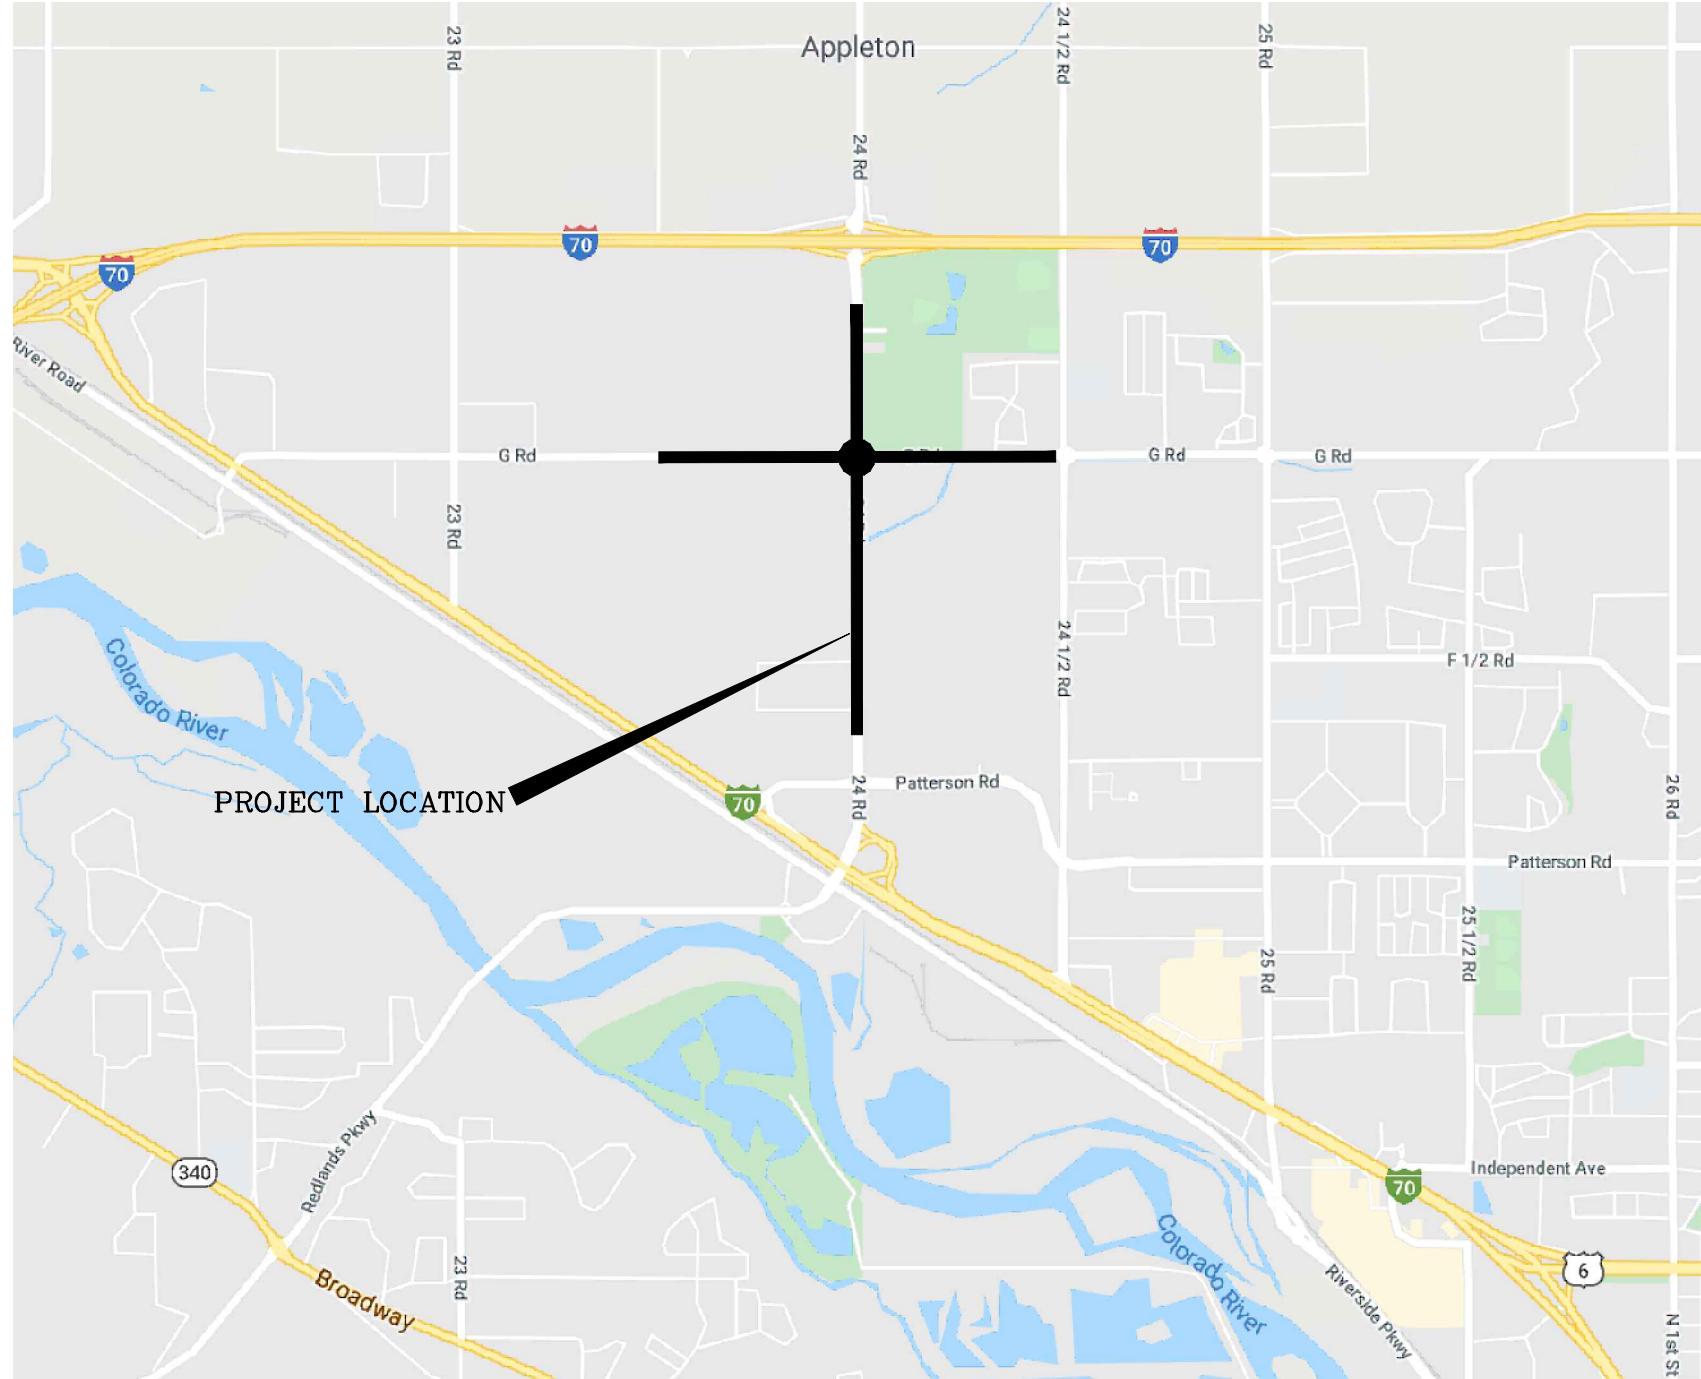

VICINITY MAP

0 1250 2500

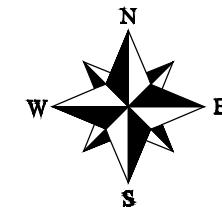

Sheet Index

- 1 Cover Sheet
- 2 Standard Abbreviations, Legend, & Symbols
- 3 Summary of Approximate Quantities
- 4 Project Control Map
- 5-8 Typical Cross Sections
- 9-12 Storm Drain Plan and Profiles
- 13-58 Improvement Plan
- 59-99 Road Profile
- 100-114 Road Cross Sections



Know what's below.
Call before you dig.

NOTE:
NOTIFY AFFECTED UTILITY VENDOR 48 HOURS PRIOR
TO EXCAVATIONS THAT WILL EXPOSE UTILITY LINES.
THE COVER SHEET WILL HAVE A LISTING OF UTILITY
VENDORS AND TELEPHONE NUMBERS.

DESCRIPTION	DATE
REVISION ▲ REV 1	- DATE
REVISION ▲ REV 2	- DATE
REVISION ▲ REV 3	- DATE
REVISION ▲ REV 4	- DATE

DRAWN BY <u>JCS</u>	DATE 2020
DESIGNED BY <u>JCS</u>	DATE 2020
CHECKED BY <u>ALC</u>	DATE 2020
APPROVED BY <u>TCP</u>	DATE 2020

SEE PLAN FOR SCALE INFO

CITY OF
Grand Junction
COLORADO


PUBLIC WORKS
ENGINEERING DIVISION
PROJECT NO. 207-F1903

24 ROAD AND G ROAD
30 PERCENT PROGRESS PLANS
COVER



ABBREVIATIONS

AASHTO	AMERICAN ASSOCIATION OF STATE HIGHWAY & TRANSPORTATION OFFICIALS
ABC	AGGREGATE BASE COURSE
AC	ASBESTOS CEMENT
AP	ANGLE POINT
ASB	ANCHORED STRAW BALES
ASP	ALUMINIZED STEEL PIPE
ASTM	AMERICAN SOCIETY FOR TESTING MATERIALS
AWWA	AMERICAN WATER WORKS ASSOCIATION
BC	BACK OF CURB
BF	BUTTERFLY VALVE
BOW	BACK OF WALK
BCR	BEGIN CURB RETURN
BOT	BOTTOM
BSWMP	BETTER STORM WATER MANAGEMENT PRACTICES
CH	CHORD
CAP	CORRUGATED ALUMINUM PIPE
CDOT	COLORADO DEPARTMENT OF TRANSPORTATION
CI	CAST IRON
C,G,& SW	CURB, GUTTER & SIDEWALK
CL	CENTER LINE
CMP	CLEAR
CO	CORRUGATED METAL PIPE
COMB	CLEAN OUT
CONC	COMBINATION (AS IN STORM SEWER AND SANITARY SEWER)
CSM	CONCRETE
CSP	CITY SURVEY MONUMENT
CU	CORRUGATED STEEL PIPE
DI	COPPER
DWY	DUCTILE IRON
E	DRIVEWAY
ECR	ELECTRIC
EG	END CURB RETURN
EL	EDGE OF GUTTER
EP	ELEVATION
EX	EDGE OF PAVEMENT
FB	EXISTING
FC	FULL BODY
FG	FACE OF CURB
FL	FINISHED GRADE
FM	FLOW LINE
FO	FORCE MAIN
FO	FIBER OPTICS
FS	FAR SIDE
FTG	FOOTING
G	GAS
GB	GRADE BREAK
GM	GAS METER
GV	GATE VALVE
HBP	HOT BITUMINOUS PAVEMENT
HDPE	HIGH DENSITY POLYETHYLENE
INV	INVERT
IRR	IRRIGATION
L	LENGTH OF ARC
LC	LONG CHORD
LF	LINEAR FEET
LL	LONG ARC
LS	SHORT ARC
LT	LEFT
MB	MAILBOX
MCSM	MESA COUNTY SURVEY MONUMENT
MH	MANHOLE
MJ	MECHANICAL JOINT
MW	MILL WRAP
N/A	NOT APPLICABLE
NIC	NOT IN CONTRACT
NOP	NO ONE PERSON
NRCP	NON-REINFORCED CONCRETE PIPE
NS	NEAR SIDE
NTS	NOT TO SCALE
OHP	OVERHEAD POWER
OHT	OVERHEAD TELEPHONE
PC	POINT OF CURVATURE
PCC	POINT OF COMPOUND CURVATURE
PE	POLYETHYLENE
PERF	PERFORATED
PI	POINT OF INTERSECTION
PIP	PLASTIC IRRIGATION PIPE
POC	POINT ON CURVE
POT	POINT ON TANGENT
PR	PROPOSED
PRC	POINT OF REVERSE CURVATURE
PT	POINT OF TANGENCY
PVC	POLYVINYL CHLORIDE
R	RADIUS
RCP	REINFORCED CONCRETE PIPE
REQ'D	REQUIRED
RG	RESTRAINED GLANDS
RL	LONG RADIUS
ROW	RIGHT OF WAY
RP	RADIUS POINT
RR	RAIL ROAD
RS	SHORT RADIUS
RT	RIGHT
S	SLOPE
SAN	SANITARY
SC	SHORT CHORD
SCD	STANDARD CONTRACT DOCUMENTS
SCH	SCHEDULE
SF	SILT FENCE
SL	SECTION LINE
SSRB	STANDARD SPECIFICATIONS FOR ROAD & BRIDGE CONSTRUCTION
SSUU	STANDARD SPECIFICATIONS FOR CONSTRUCTION OF UNDERGROUND UTILITIES
STA	STATION
STL	STEEL
STM	STORM
T	TELEPHONE
TAN	LENGTH OF TANGENT
TC	TOP OF CURB
TH	TEST HOLE
TV	TELEVISION
(TYP)	TYPICAL
UU	UNDERGROUND UTILITIES
VC	VERTICAL CURVE
VCP	VITRIFIED CLAY PIPE
VPC	VERTICAL POINT OF CURVATURE
VPCC	VERTICAL POINT OF COMPOUND CURVATURE
VPRC	VERTICAL POINT OF REVERSE CURVATURE
VPI	VERTICAL POINT OF INTERSECTION
VPT	VERTICAL POINT OF TANGENCY
W	WATER
△	DELTA ANGLE

LEGEND

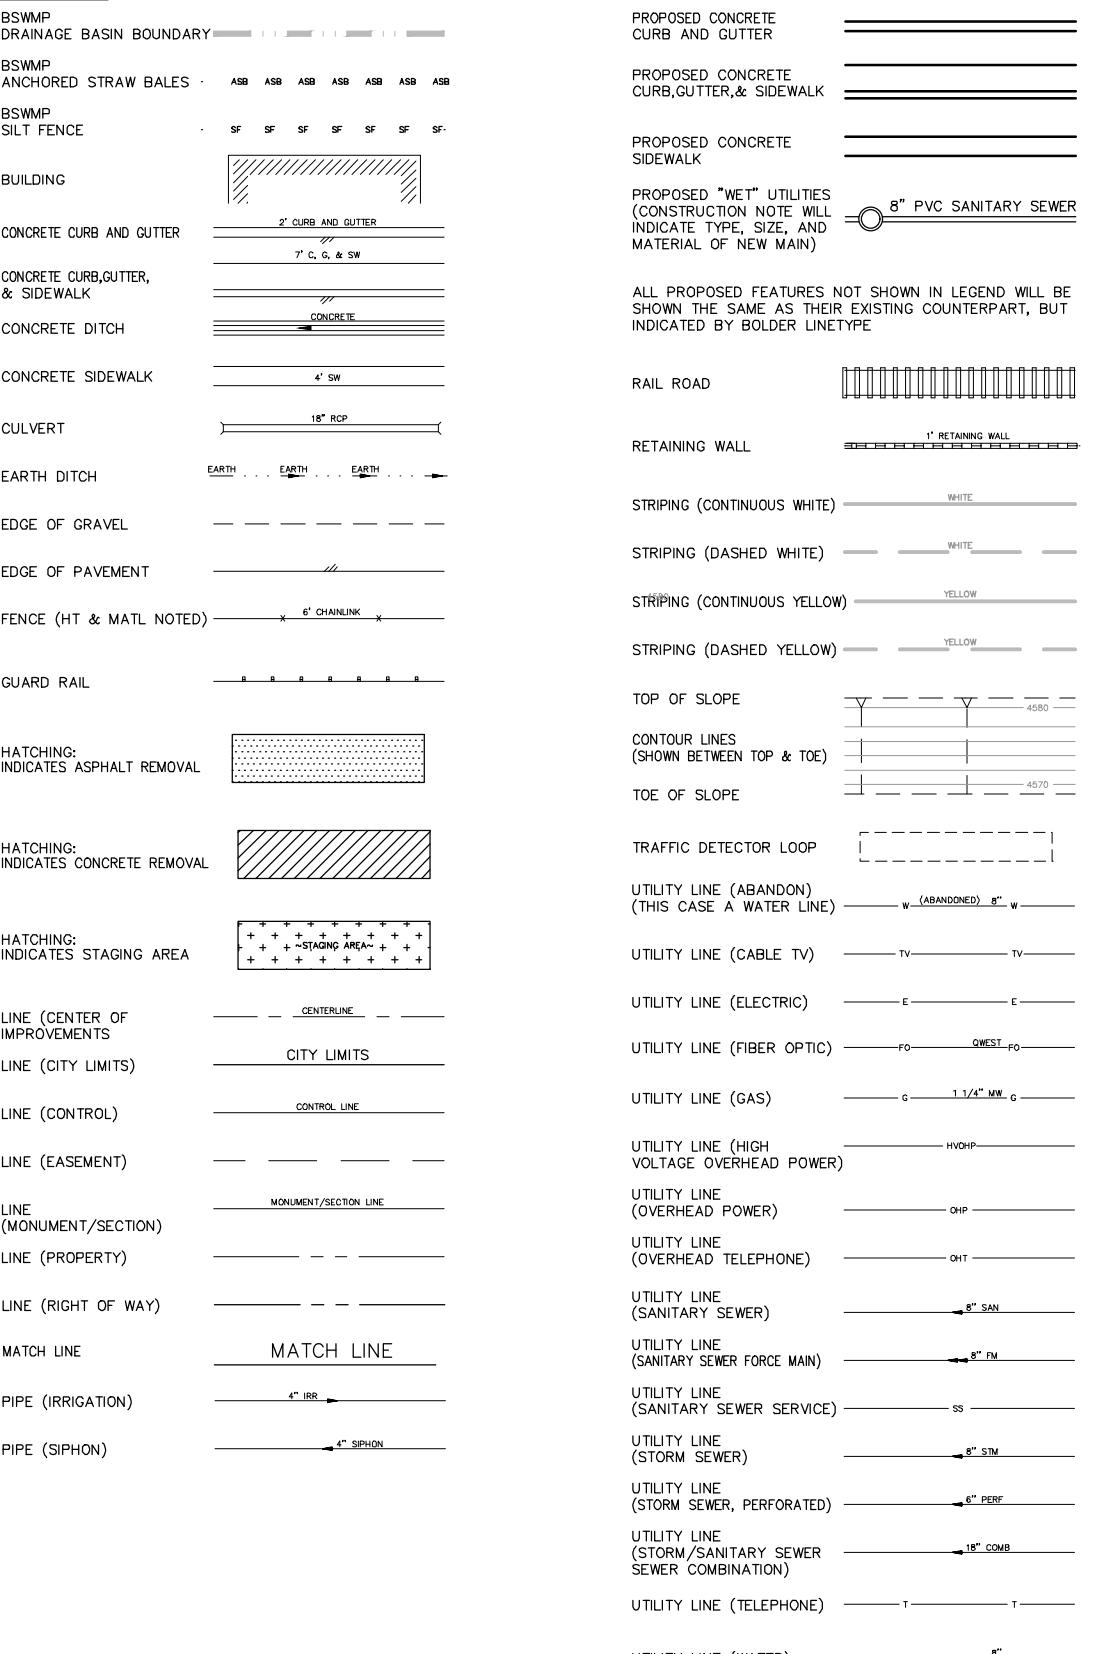

SYMBOLS

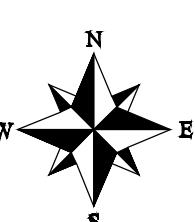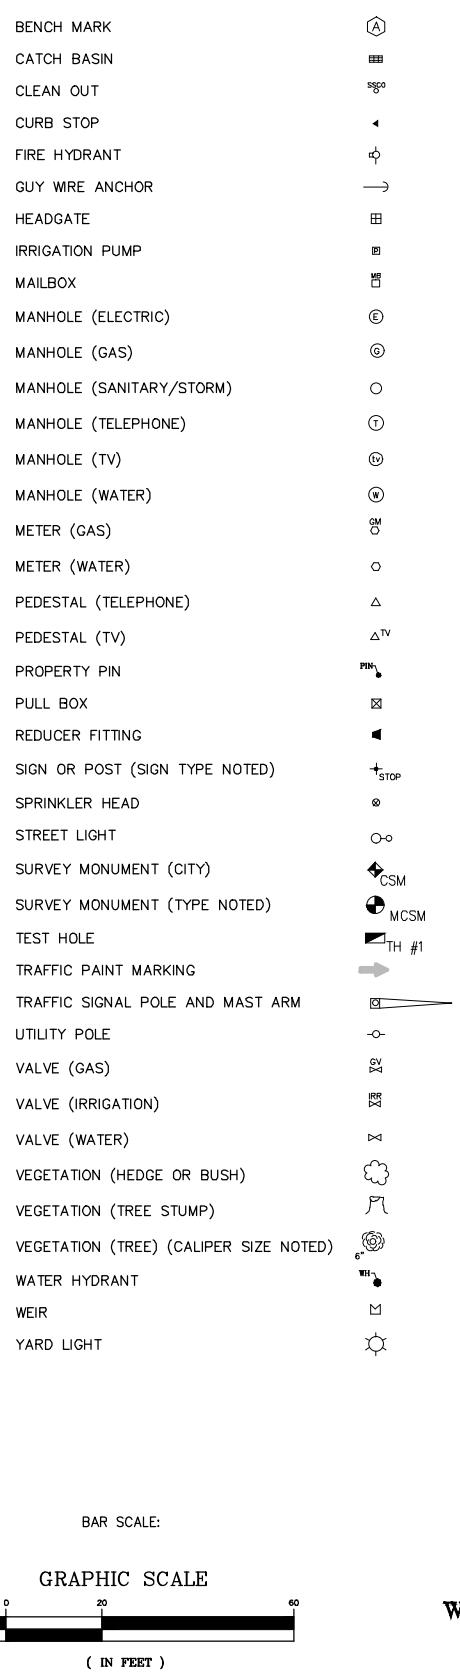

DESCRIPTION	DATE
REVISION ▲ REV 1	- DATE
REVISION ▲ REV 2	- DATE
REVISION ▲ REV 3	- DATE
REVISION ▲ REV 4	- DATE

DRAWN BY JCS	DATE 2020
DESIGNED BY JCS	DATE 2020
CHECKED BY ALC	DATE 2020
APPROVED BY TCP	DATE 2020

SEE PLAN FOR SCALE INFO



PUBLIC WORKS
ENGINEERING DIVISION
PROJECT NO. 207-F1903

24 ROAD AND G ROAD
STANDARD ABBREVIATIONS, LEGENDS, &
SYMBOLS

DESCRIPTION	DATE
REVISION A REV 1	- DATE
REVISION A REV 2	- DATE
REVISION A REV 3	- DATE
REVISION A REV 4	- DATE


DRAWN BY	JCS	DATE 2020
DESIGNED BY	JCS	DATE 2020
CHECKED BY	ALC	DATE 2020
APPROVED BY	TCP	DATE 2020

NO SCALE



PUBLIC WORKS
ENGINEERING DIVISION
PROJECT NO. 207-F1903

24 ROAD AND G ROAD
SUMMARY OF APPROXIMATE QUANTITIES

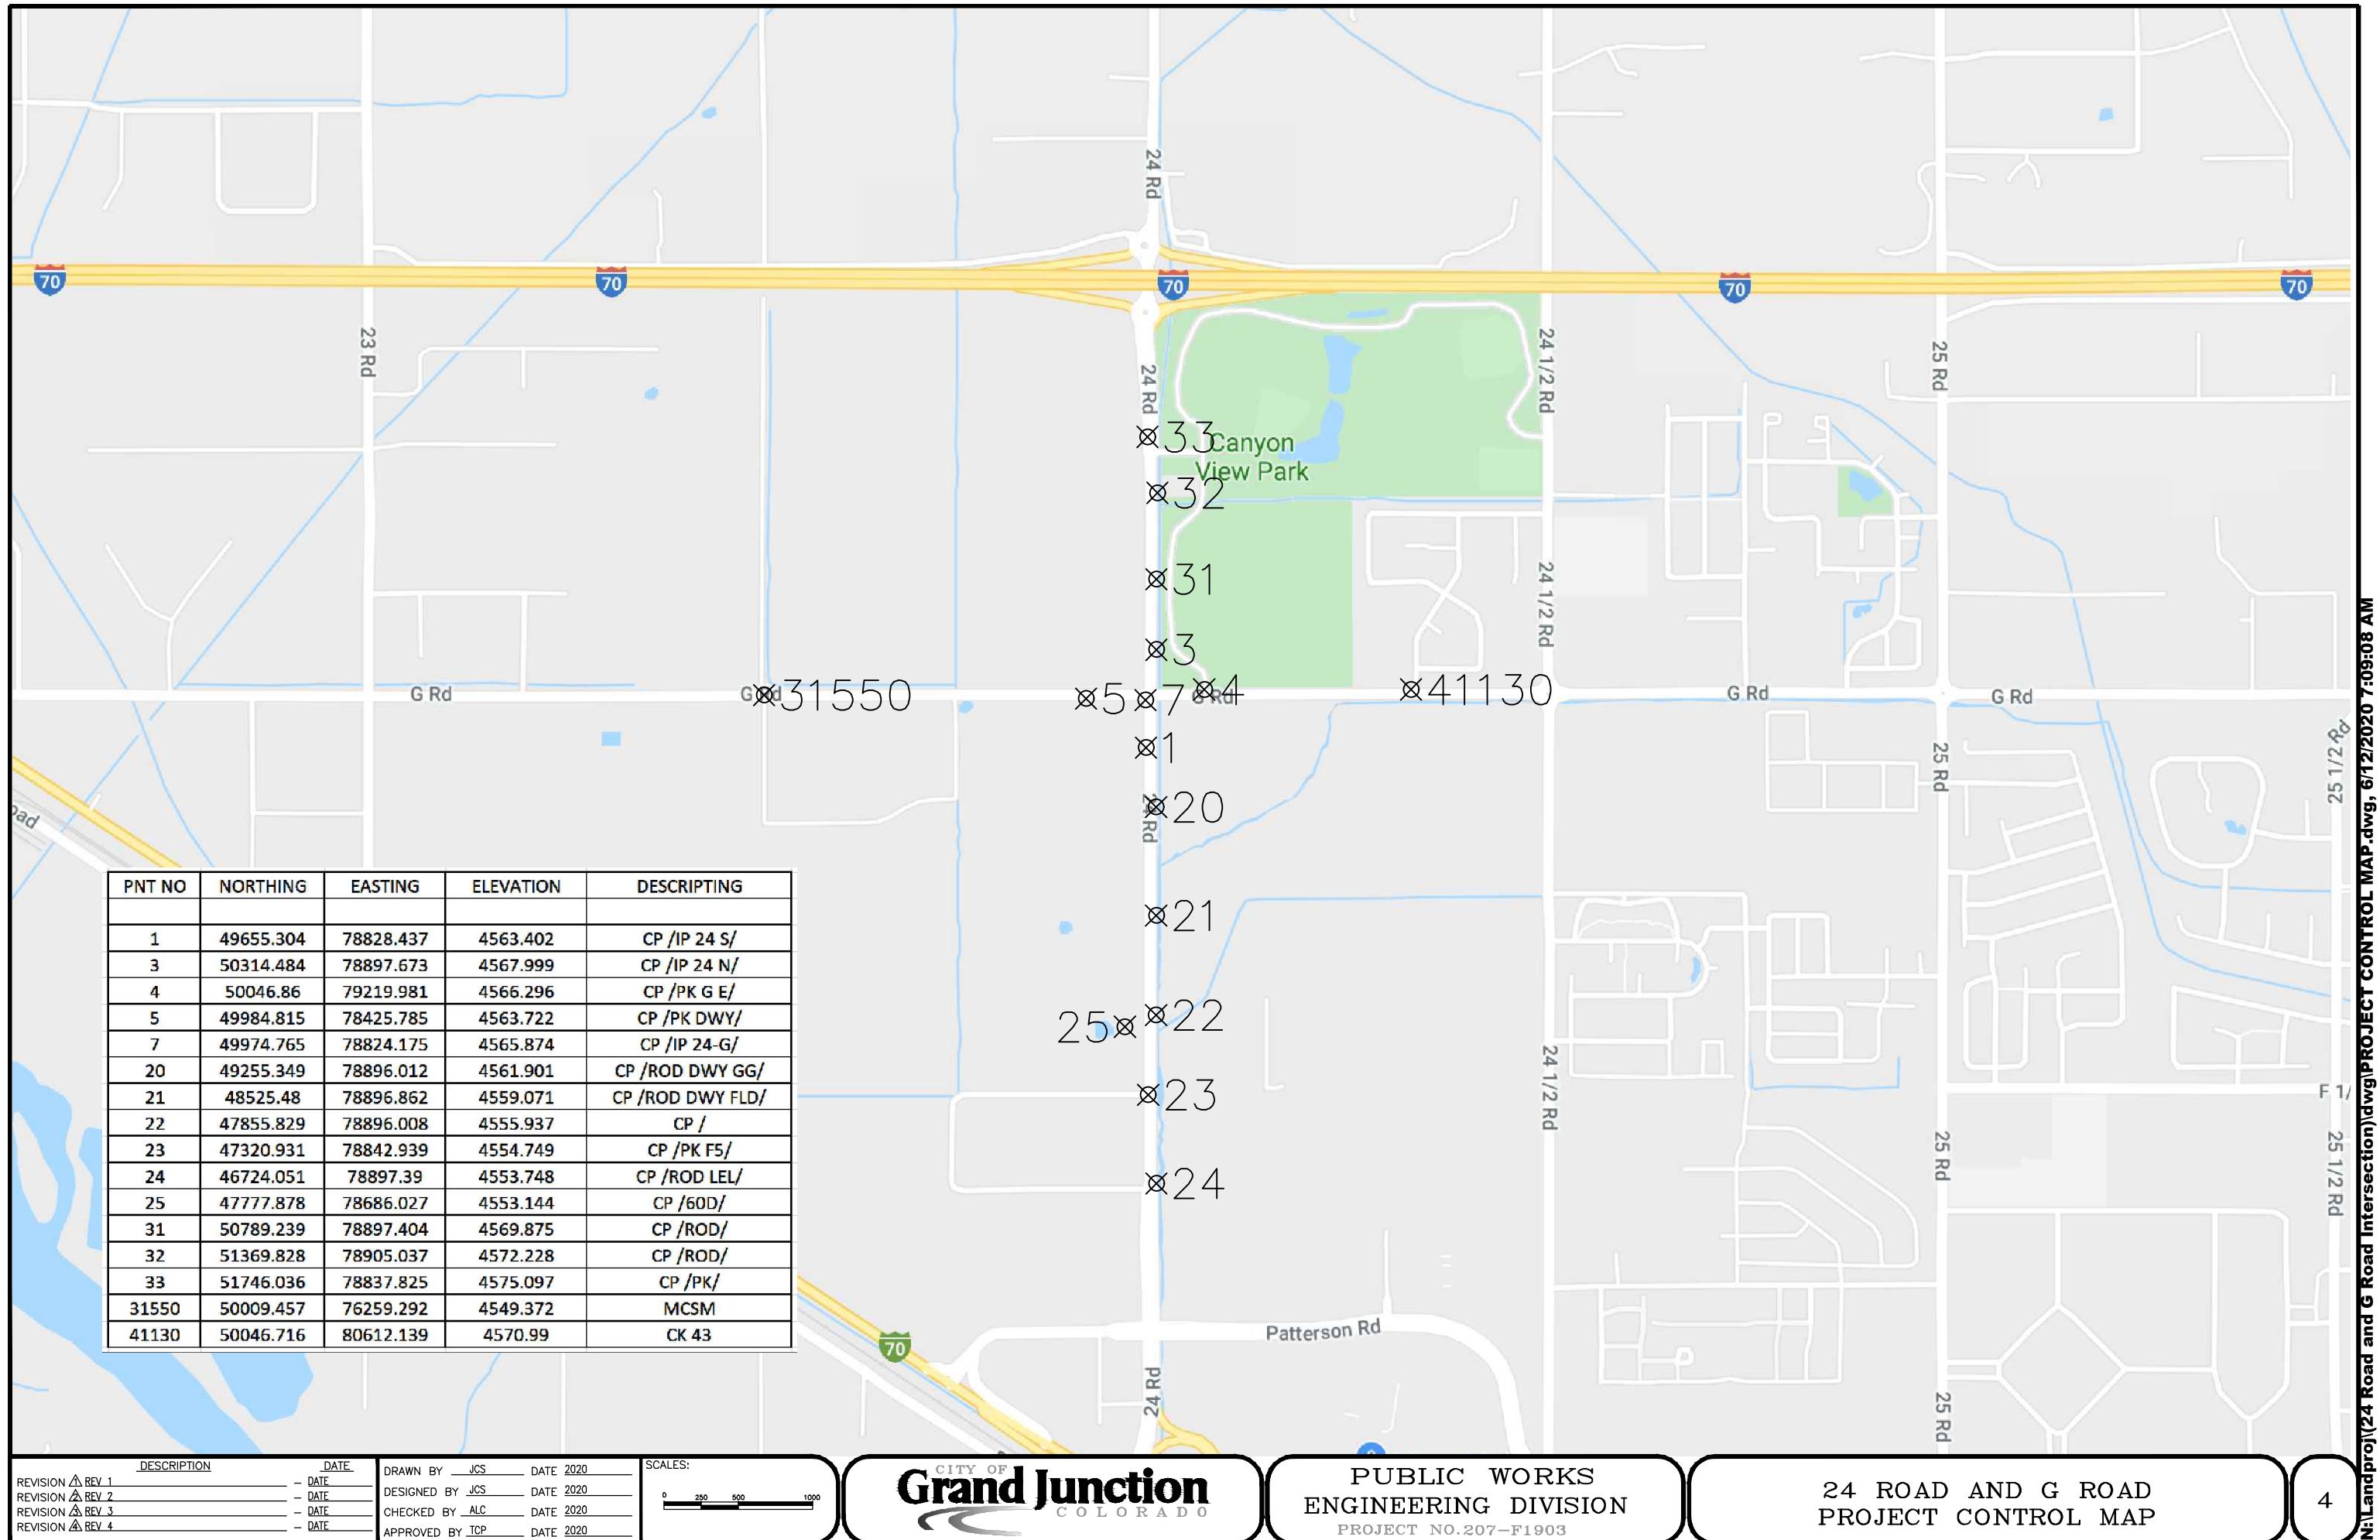

<u>DESCRIPTION</u>	<u>DATE</u>
REVISION A REV 1	DATE
REVISION A REV 2	DATE
REVISION A REV 3	DATE
REVISION A REV 4	DATE


DRAWN BY JCS DATE 2020
DESIGNED BY JCS DATE 2020
CHECKED BY ALC DATE 2020

SCALES:



PUBLIC WORKS
ENGINEERING DIVISION
PROJECT NO. 207-F1903

24 ROAD AND G ROAD
PROJECT CONTROL MAP

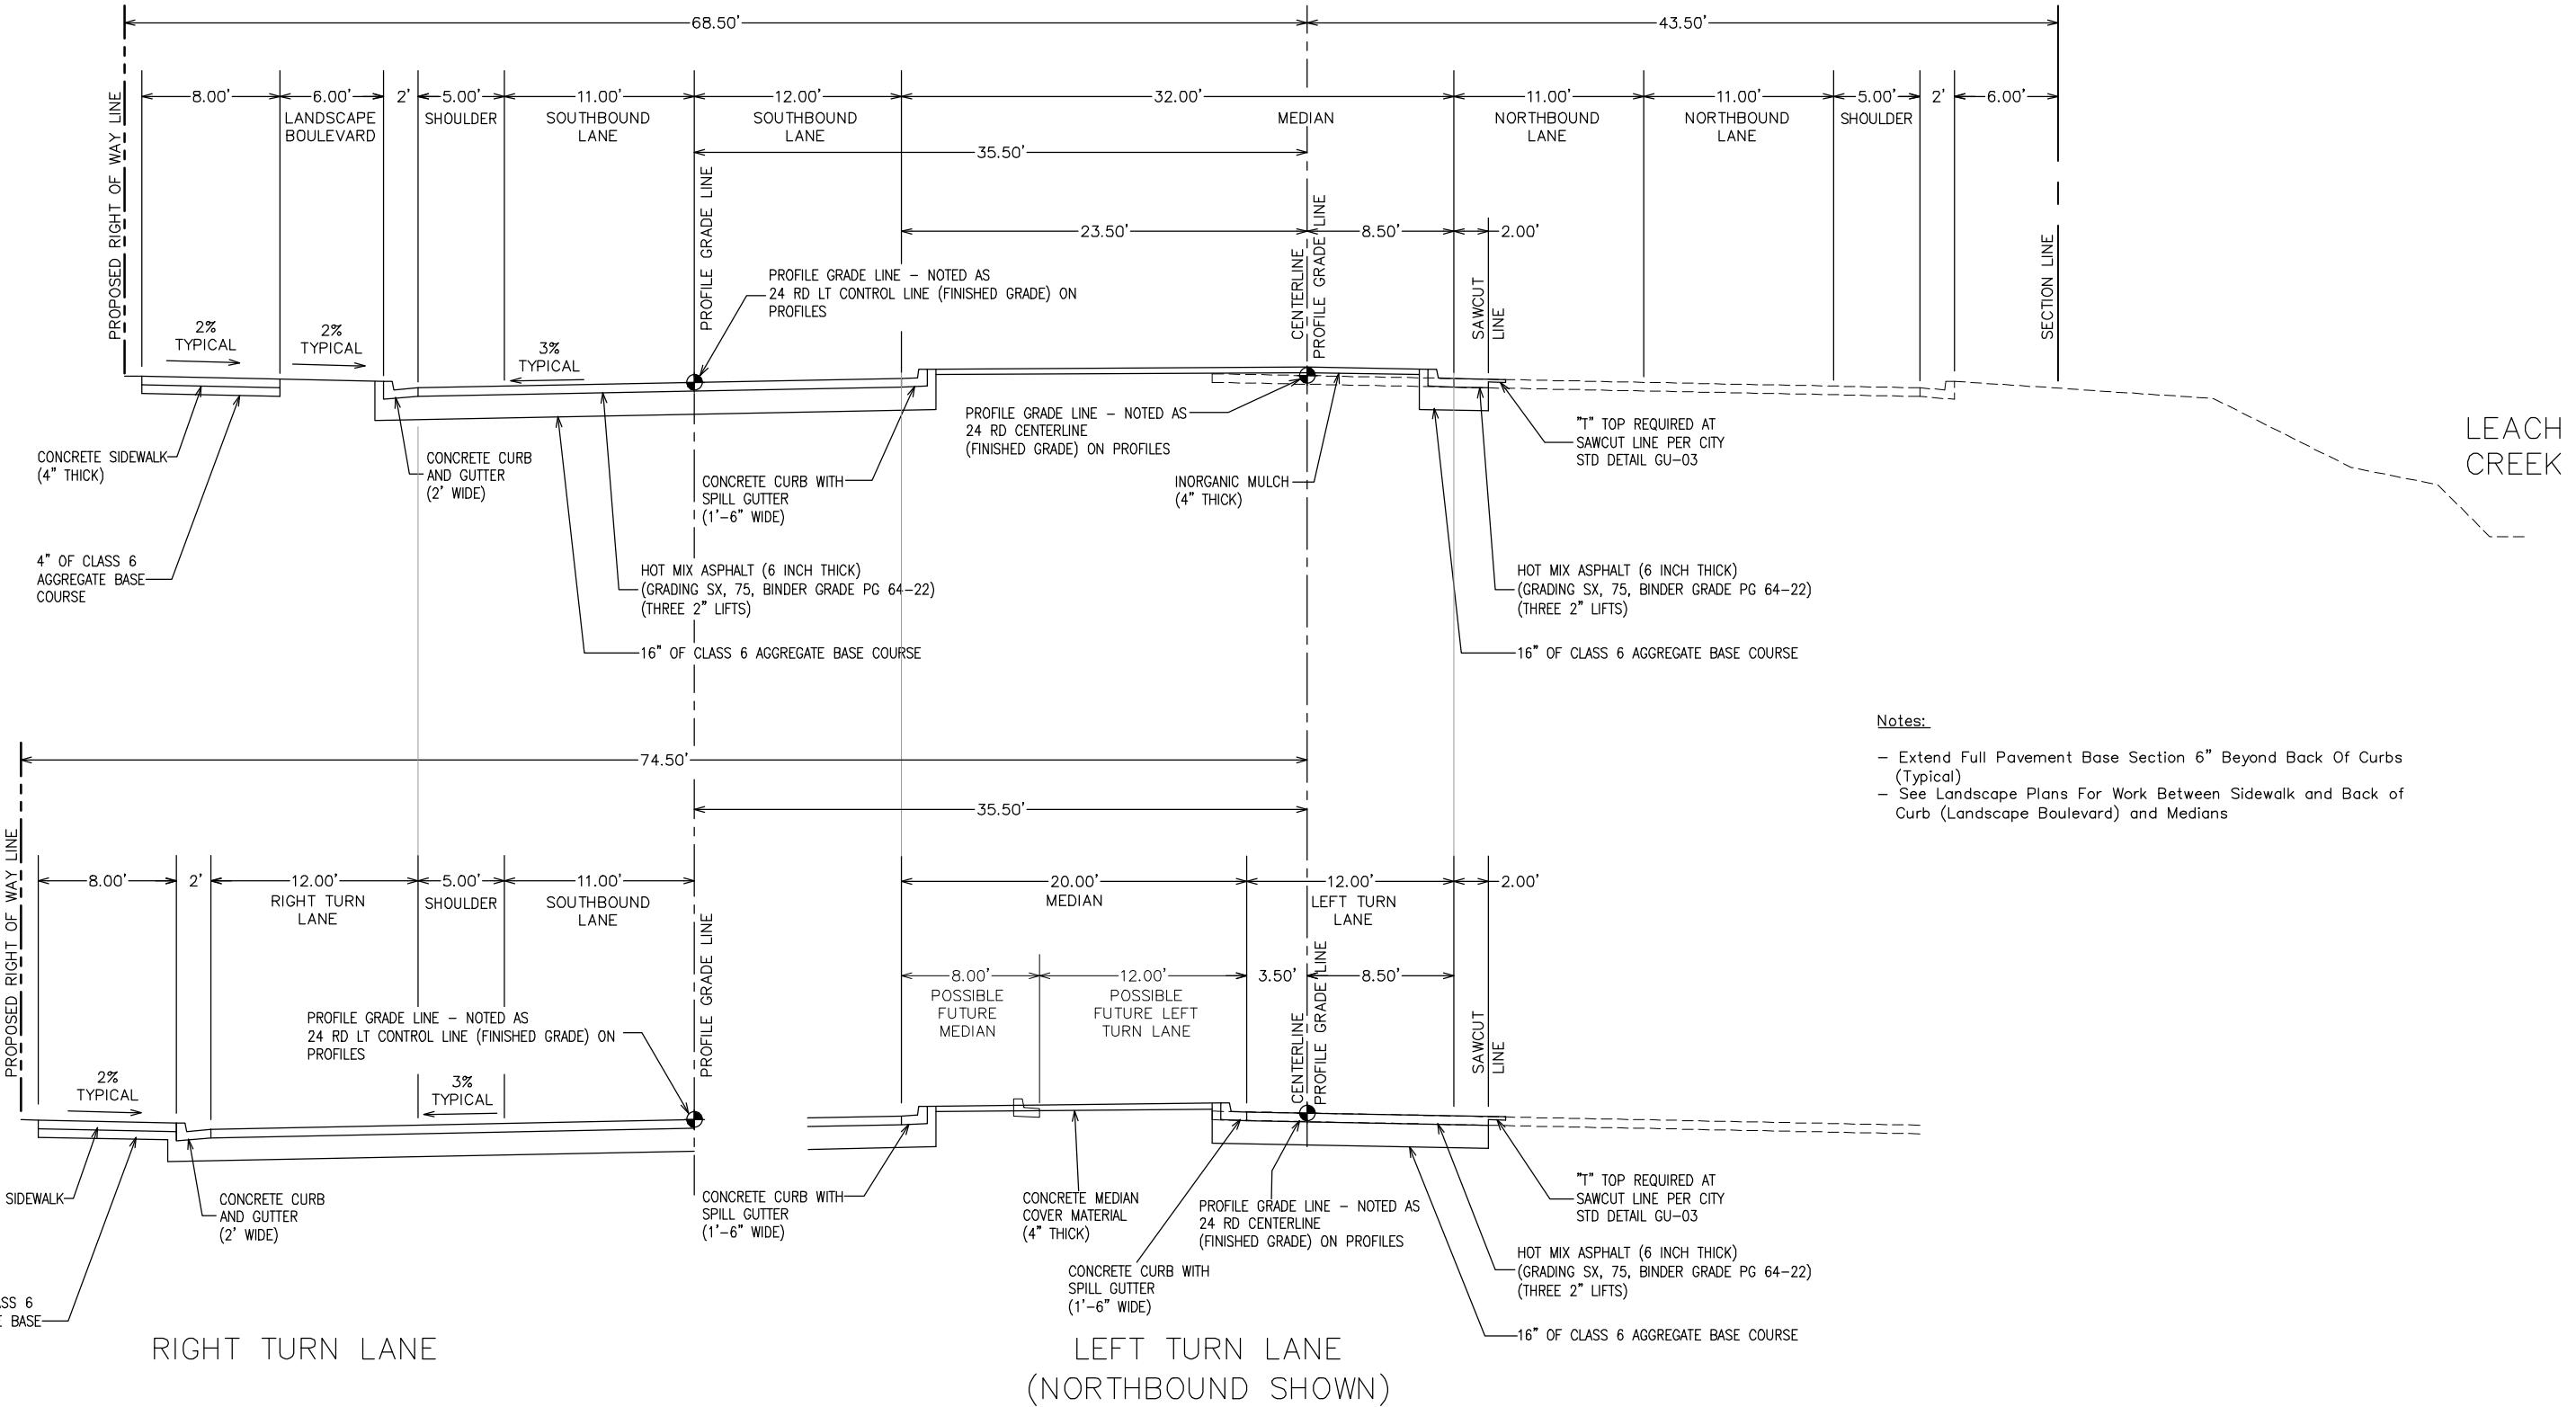

24 ROAD AT F 1/2 ROAD


DESCRIPTION	DATE	DRAWN BY	JCS	DATE	2020
REVISION A REV 1	DATE	DESIGNED BY	JCS	DATE	2020
REVISION A REV 2	DATE	CHECKED BY	ALC	DATE	2020
REVISION A REV 3	DATE	APPROVED BY	TCP	DATE	2020
REVISION A REV 4	DATE				

SCALES:
PLAN
0 25 5 10

CITY OF
Grand Junction
COLORADO

PUBLIC WORKS
ENGINEERING DIVISION
PROJECT NO. 207-F1903

24 ROAD AND G ROAD
TYPICAL CROSS SECTION - 24 RD

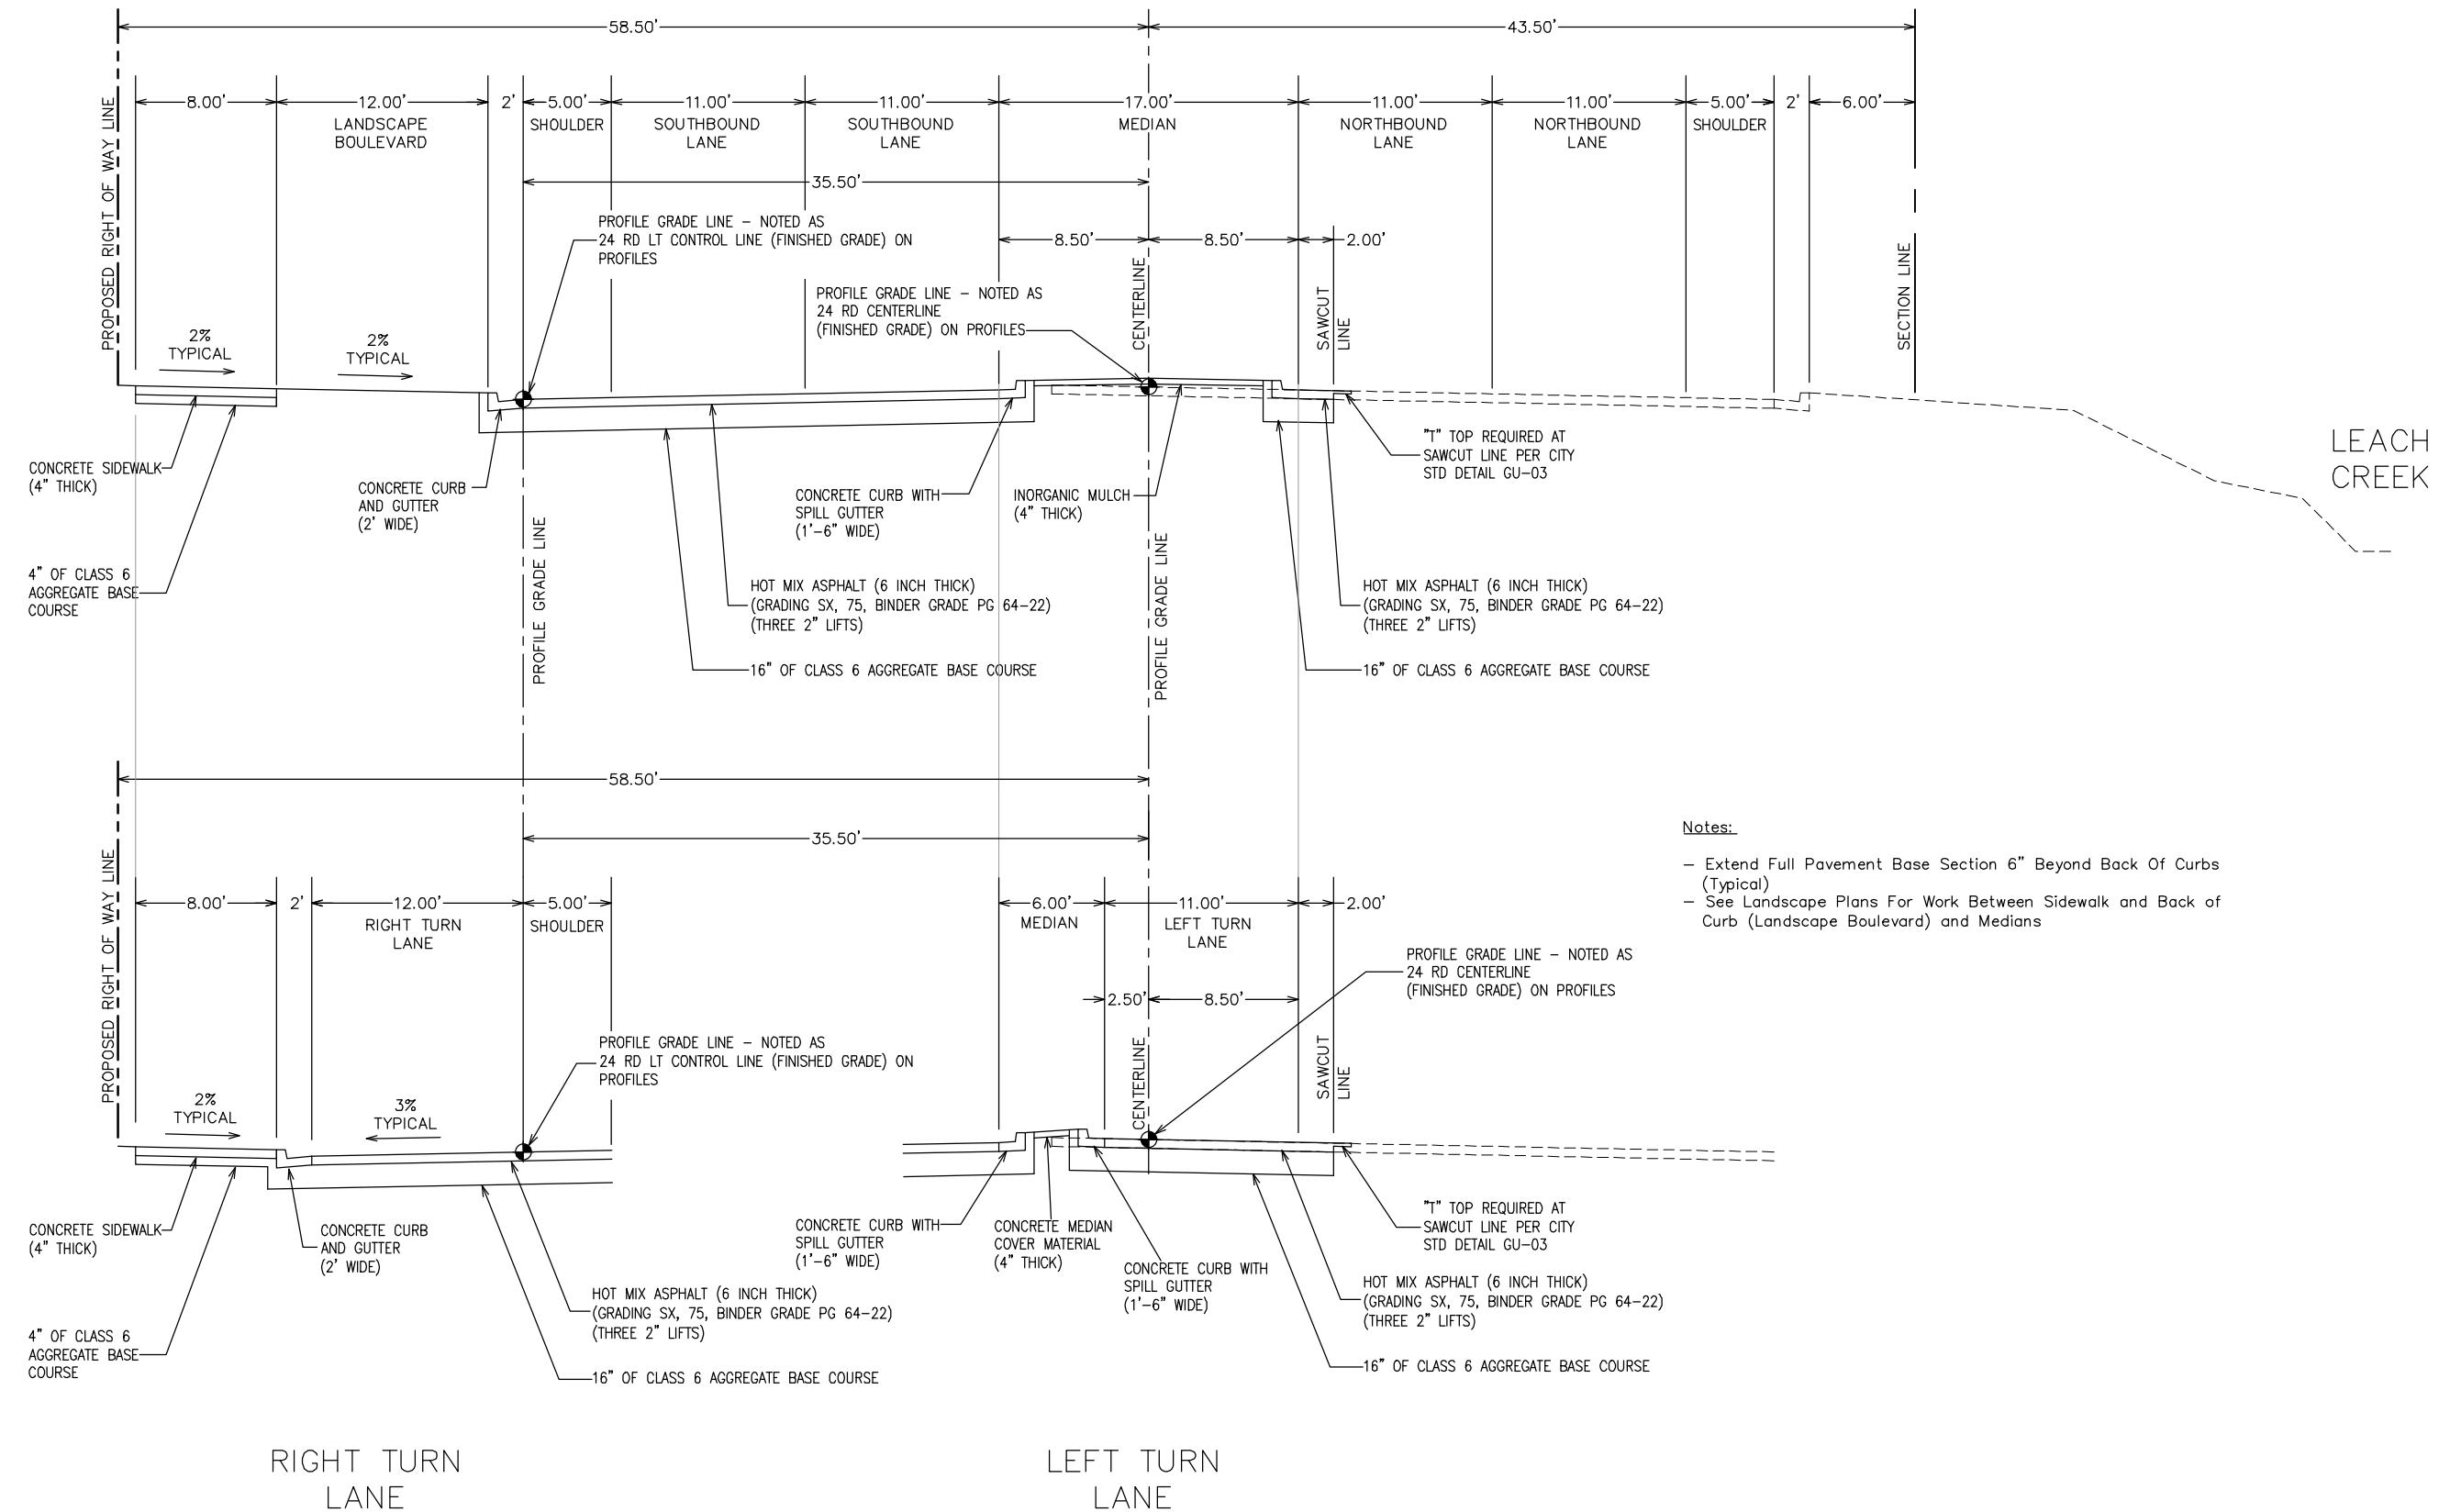

DESCRIPTION	DATE
REVISION A REV 1	DATE
REVISION A REV 2	DATE
REVISION A REV 3	DATE
REVISION A REV 4	DATE


DRAWN BY	JCS	DATE	2020
DESIGNED BY	JCS	DATE	2020
CHECKED BY	ALC	DATE	2020
APPROVED BY	TCP	DATE	2020

SCALES:
PLAN
0 25 5 10

CITY OF
Grand Junction
COLORADO

PUBLIC WORKS
ENGINEERING DIVISION
PROJECT NO. 207-F1903


24 ROAD AND G ROAD
TYPICAL CROSS SECTION — 24 RD 2

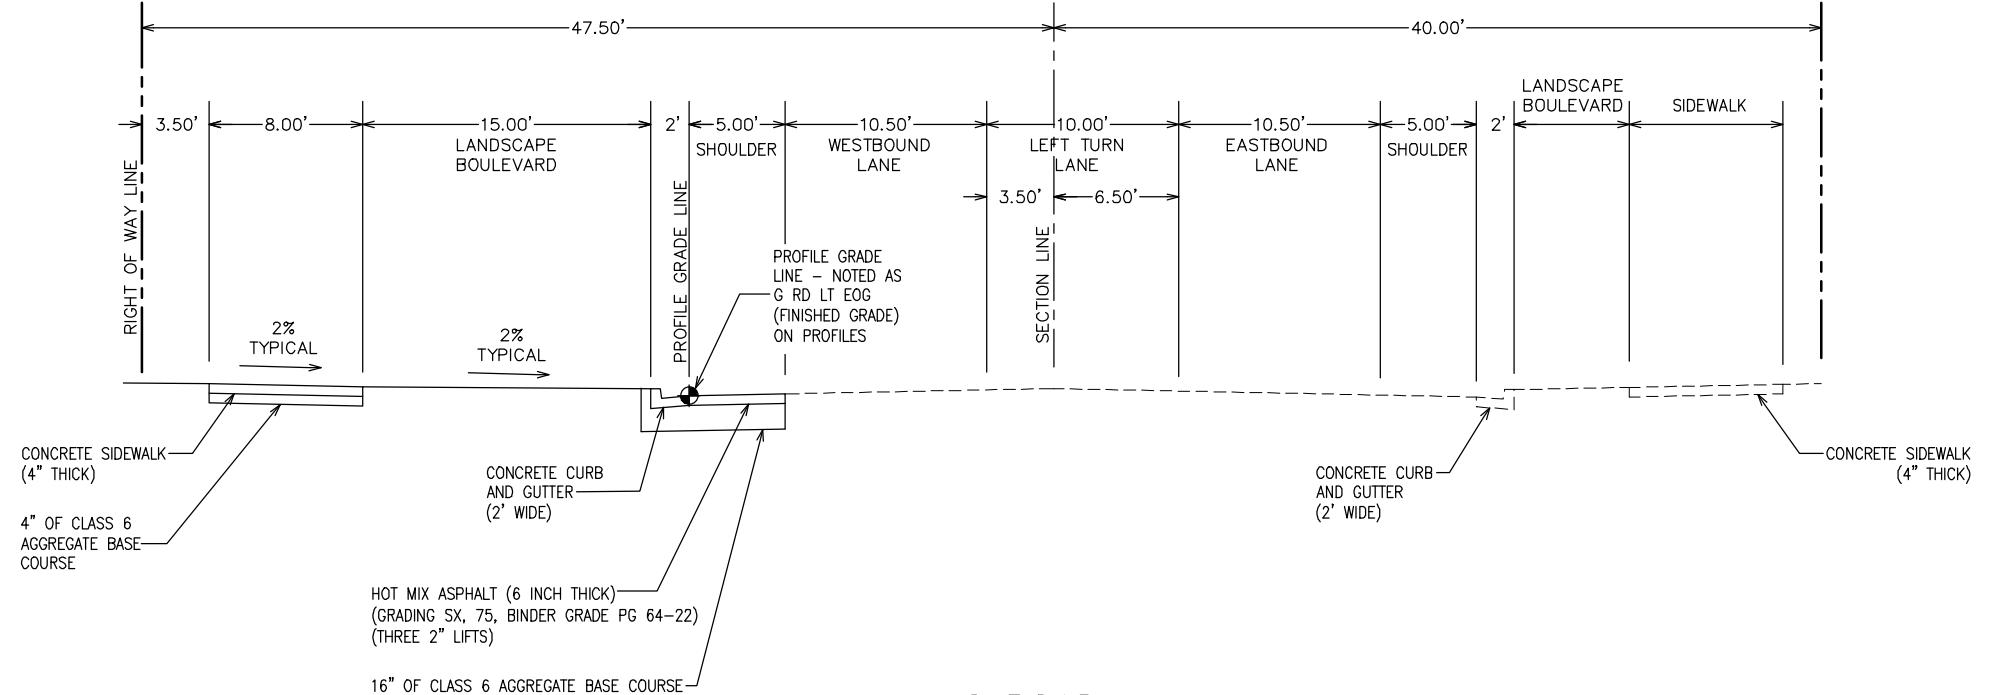

G ROAD
23 1/2 TO 23 3/4 RD

Notes:

- Extend Full Pavement Base Section 6" Beyond Back Of Curbs (Typical)
- See Landscape Plans For Work Between Sidewalk and Back of Curb (Landscape Boulevard) and Medians

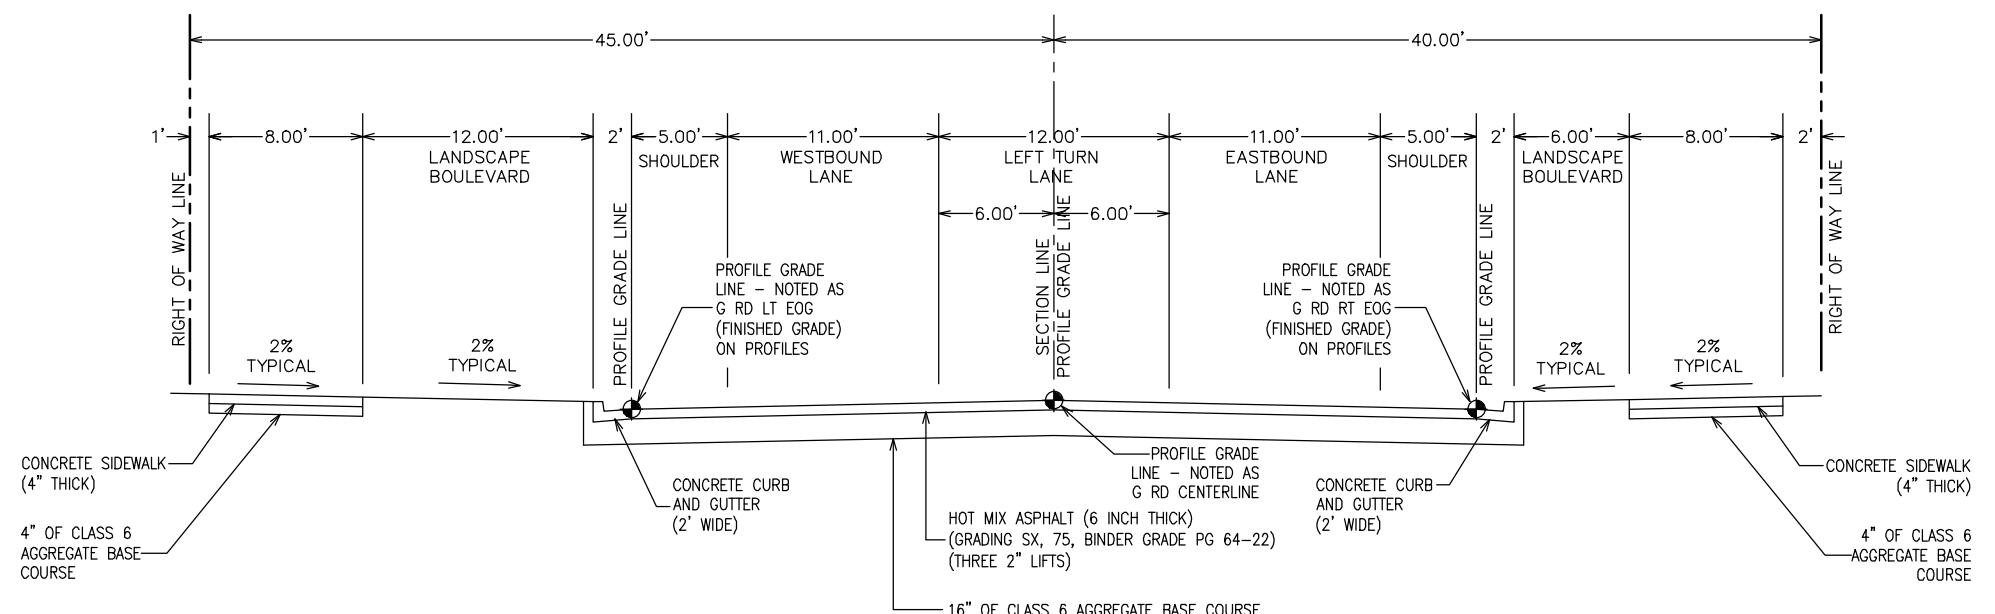

G ROAD
23 3/4 TO 24 RD

DESCRIPTION	DATE
REVISION A REV 1	DATE
REVISION A REV 2	DATE
REVISION A REV 3	DATE
REVISION A REV 4	DATE


DRAWN BY	JCS	DATE	2020
DESIGNED BY	JCS	DATE	2020
CHECKED BY	ALC	DATE	2020
APPROVED BY	TCP	DATE	2020

SCALES:	
PLAN	0 25 5 10




PUBLIC WORKS
ENGINEERING DIVISION
PROJECT NO. 207-F1903

24 ROAD AND G ROAD
TYPICAL CROSS SECTION - G RD

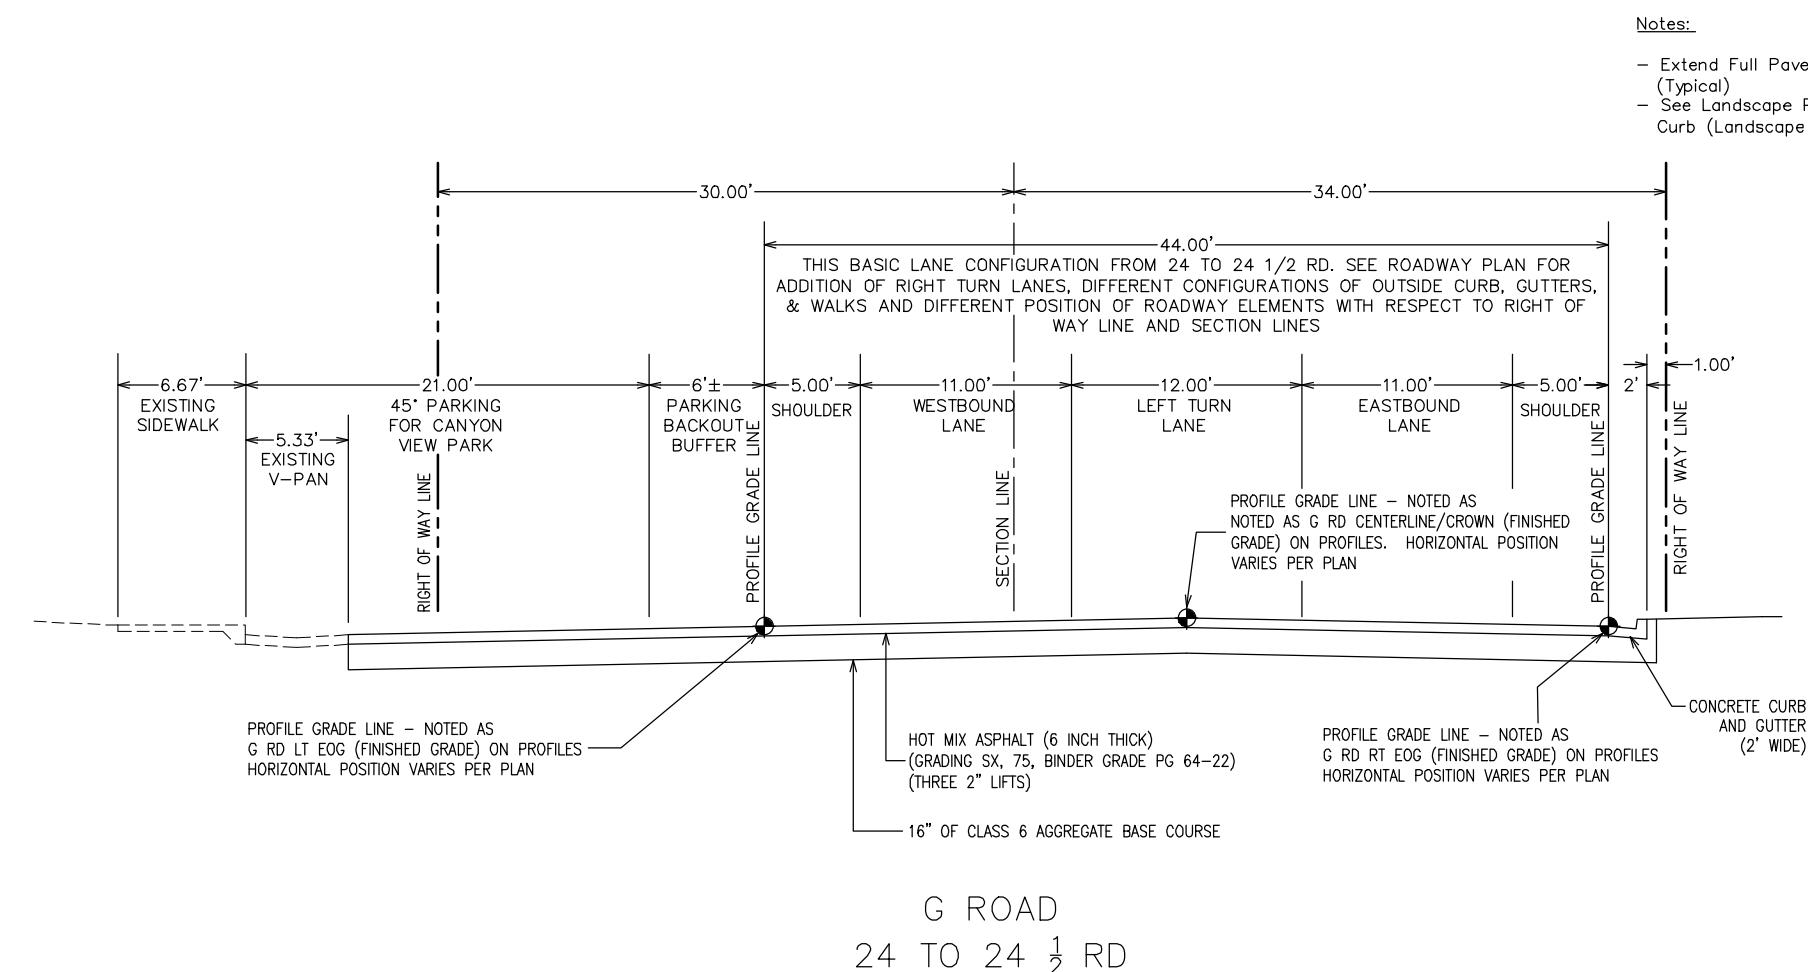



DESCRIPTION	DATE
REVISION A REV 1	DATE
REVISION A REV 2	DATE
REVISION A REV 3	DATE
REVISION A REV 4	DATE

DRAWN BY	JCS	DATE	2020
DESIGNED BY	JCS	DATE	2020
CHECKED BY	ALC	DATE	2020
APPROVED BY	TCP	DATE	2020

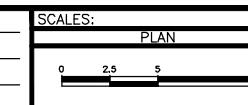

PUBLIC WORKS
ENGINEERING DIVISION
PROJECT NO. 207-F1903

24 ROAD AND G ROAD
TYPICAL CROSS SECTION — G RD 2

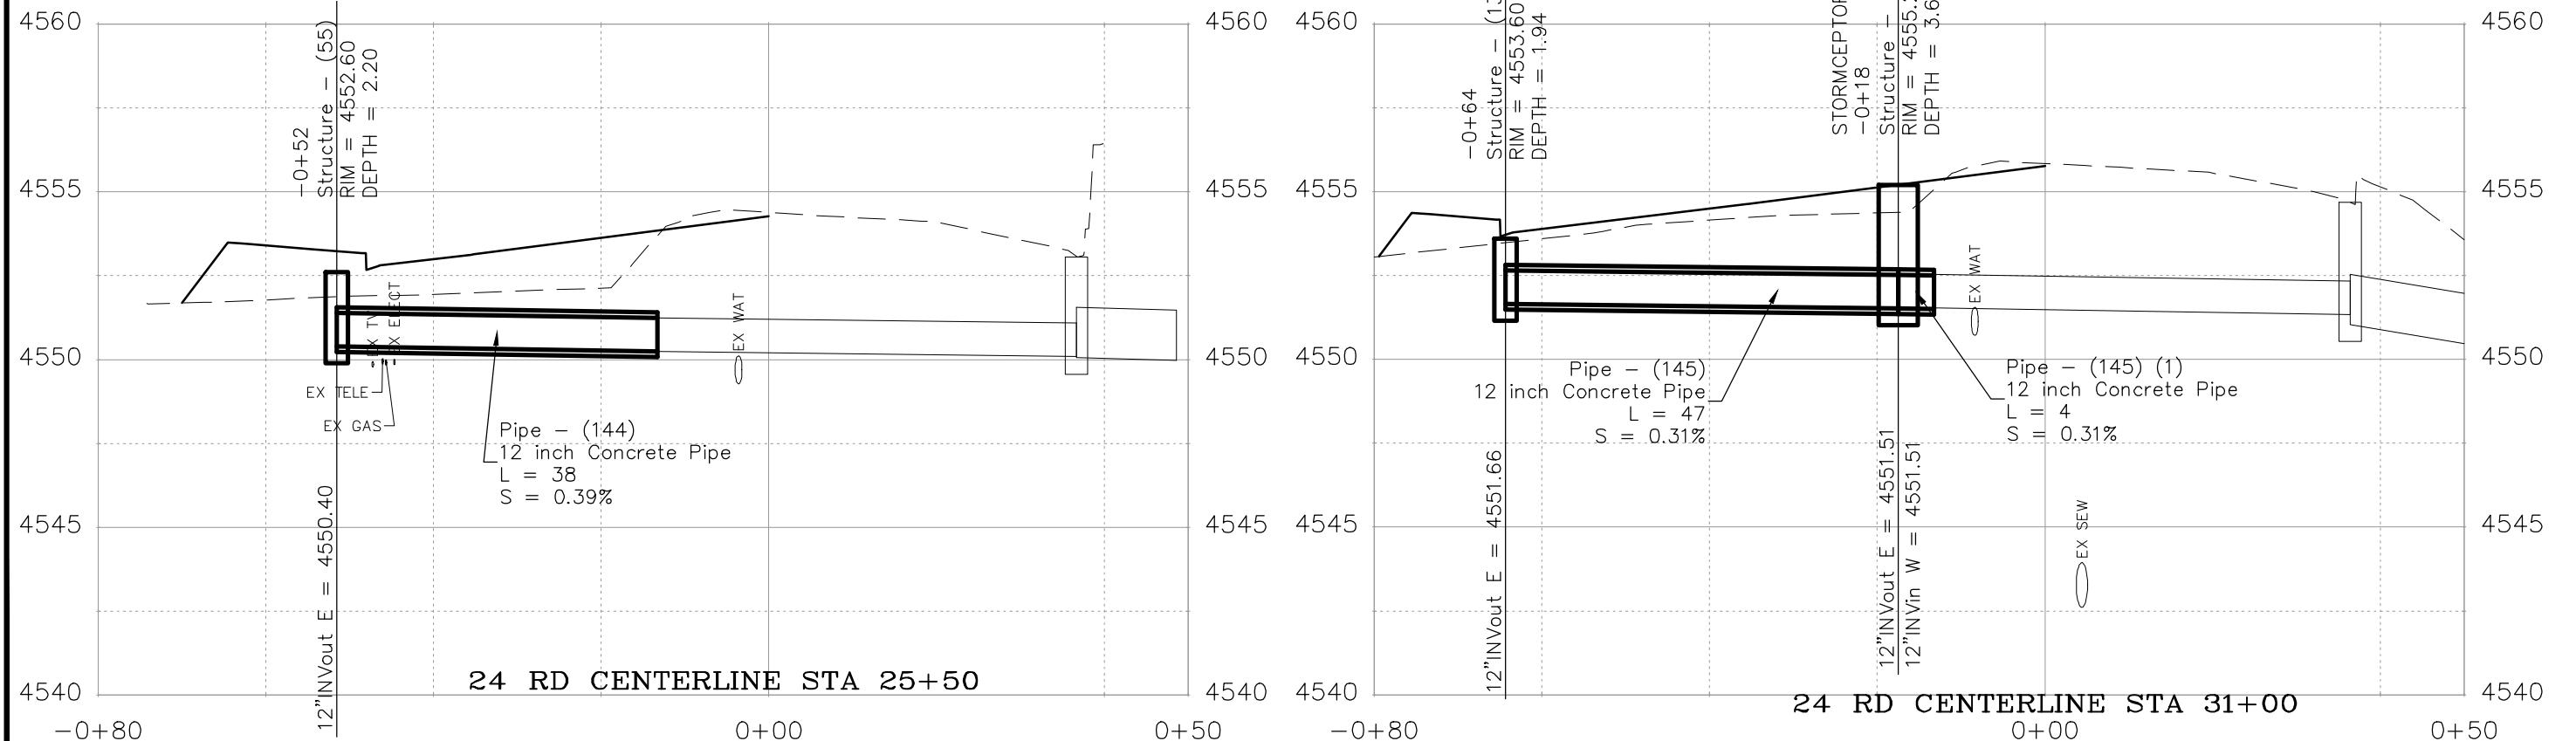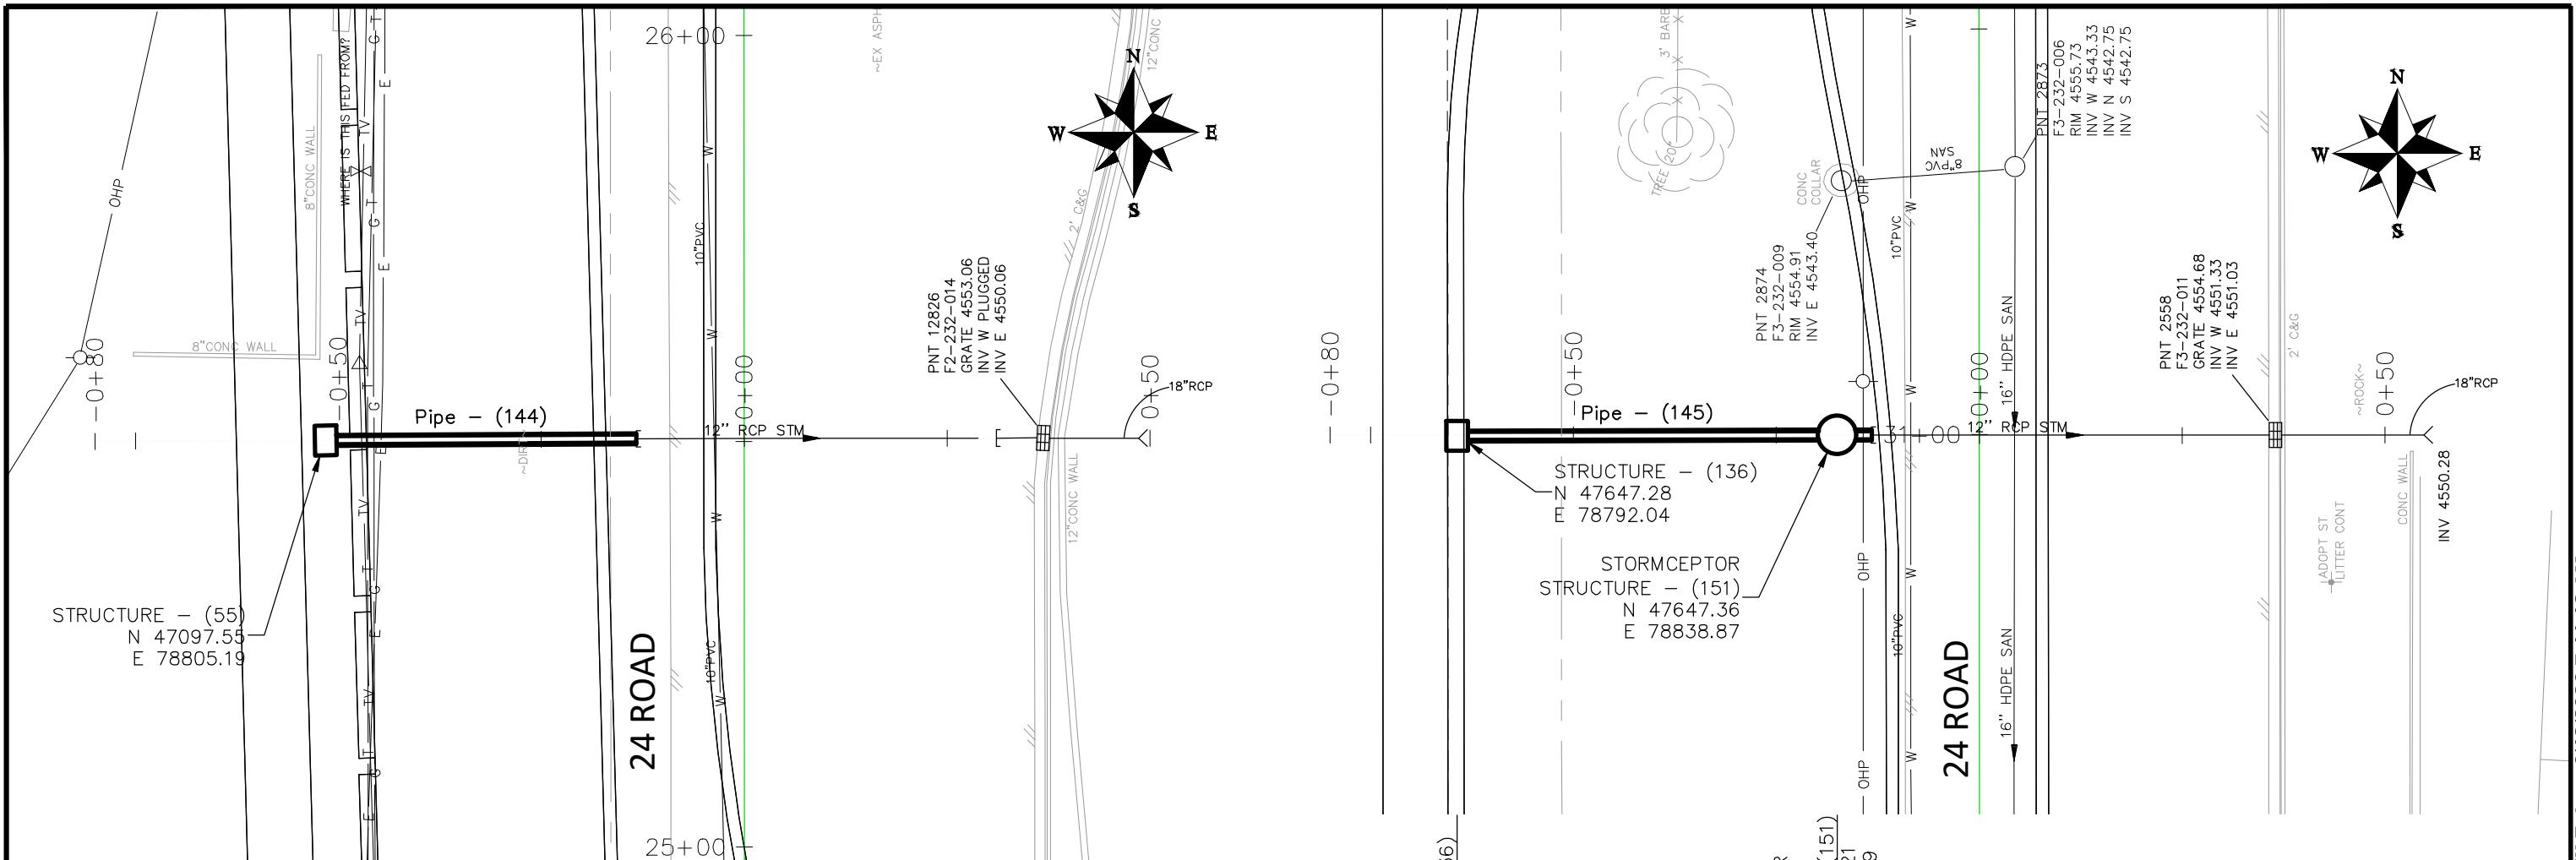

DESCRIPTION	DATE
REVISION A REV 1	DATE
REVISION A REV 2	DATE
REVISION A REV 3	DATE
REVISION A REV 4	DATE




DRAWN BY JCS	DATE 2020
DESIGNED BY JCS	DATE 2020
CHECKED BY ALC	DATE 2020
APPROVED BY TCP	DATE 2020

SCALES:	
PLAN & PROFILE	10' 20'
0	5
HORIZONTAL	VERTICAL

Grand Junction
CITY OF
COLORADO

PUBLIC WORKS
ENGINEERING DIVISION
PROJECT NO. 207-F1903

24 ROAD AND G ROAD
STORM DRAIN PLAN AND PROFILE - 1
June 12, 2020

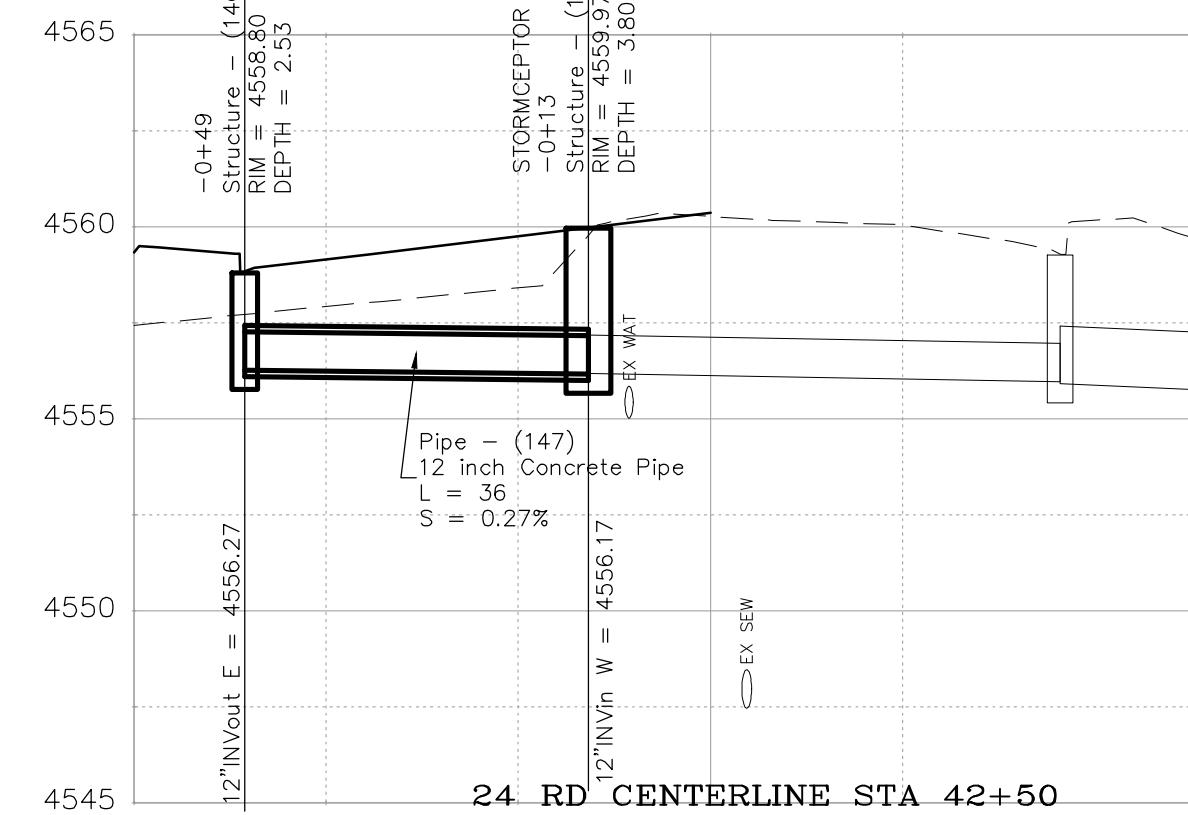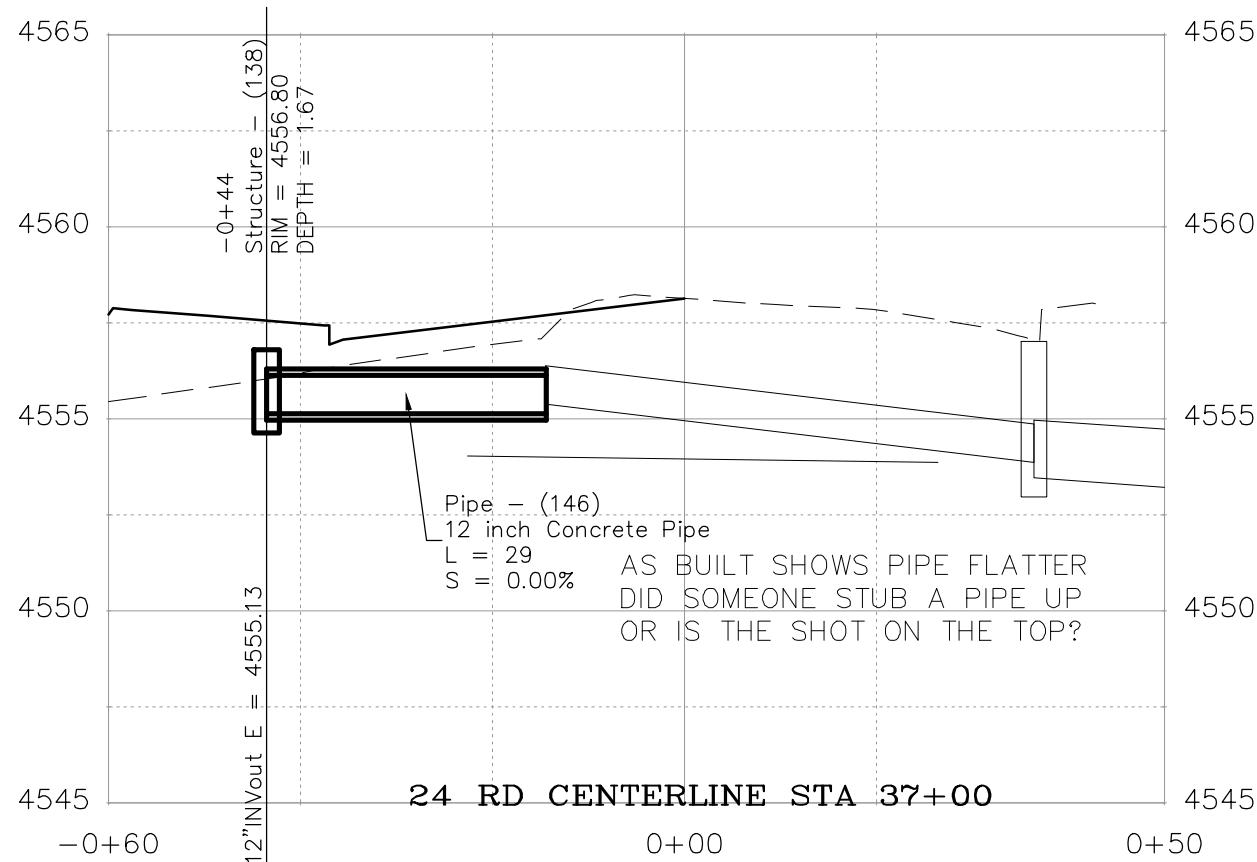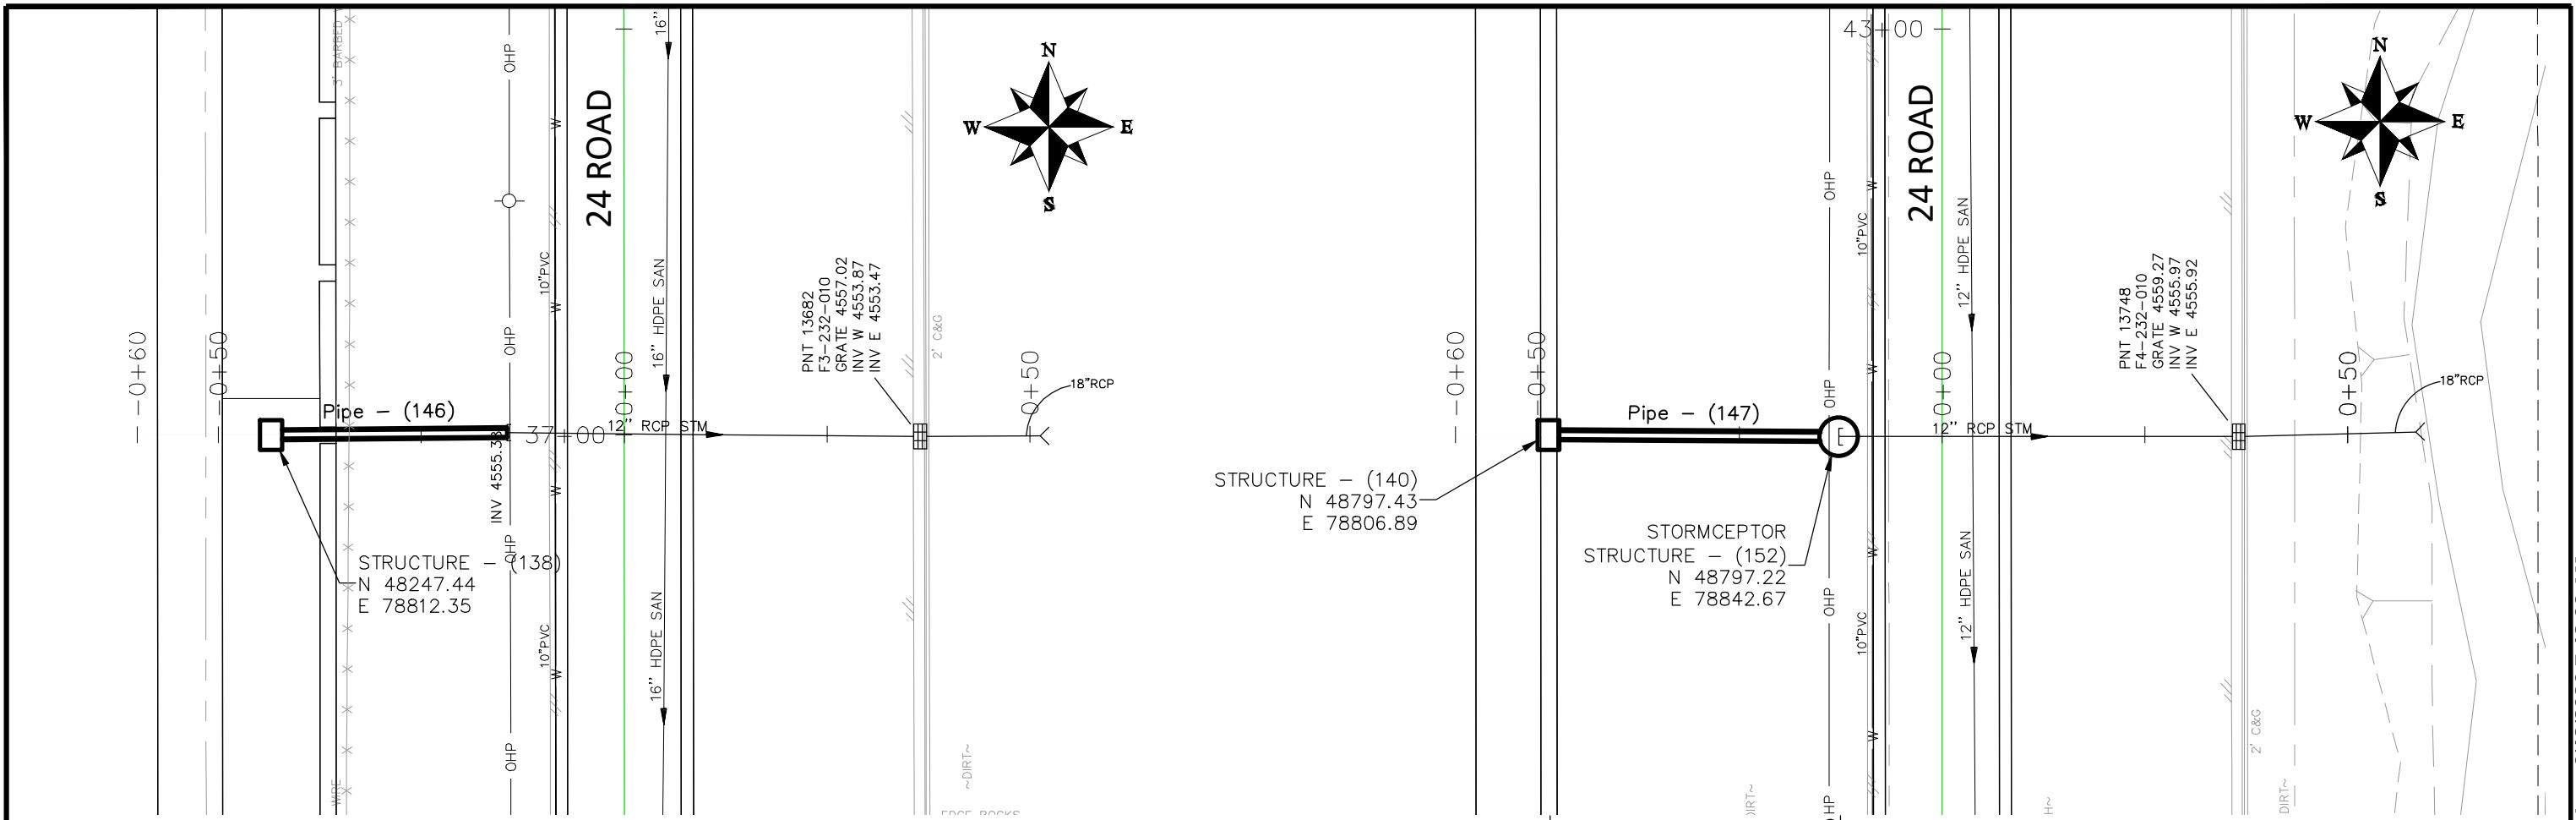


DESCRIPTION	DATE
REVISION A REV 1	DATE
REVISION A REV 2	DATE
REVISION A REV 3	DATE
REVISION A REV 4	DATE
DRAWN BY JCS	DATE 2020
DESIGNED BY JCS	DATE 2020
CHECKED BY ALC	DATE 2020
APPROVED BY TCP	DATE 2020




SCALES:	
PLAN & PROFILE	HORIZONTAL 10° 20°
VERTICAL	5



PUBLIC WORKS
ENGINEERING DIVISION
PROJECT NO. 207-F1903

24 ROAD AND G ROAD
STORM DRAIN PLAN AND PROFILE - 2
June 12, 2020

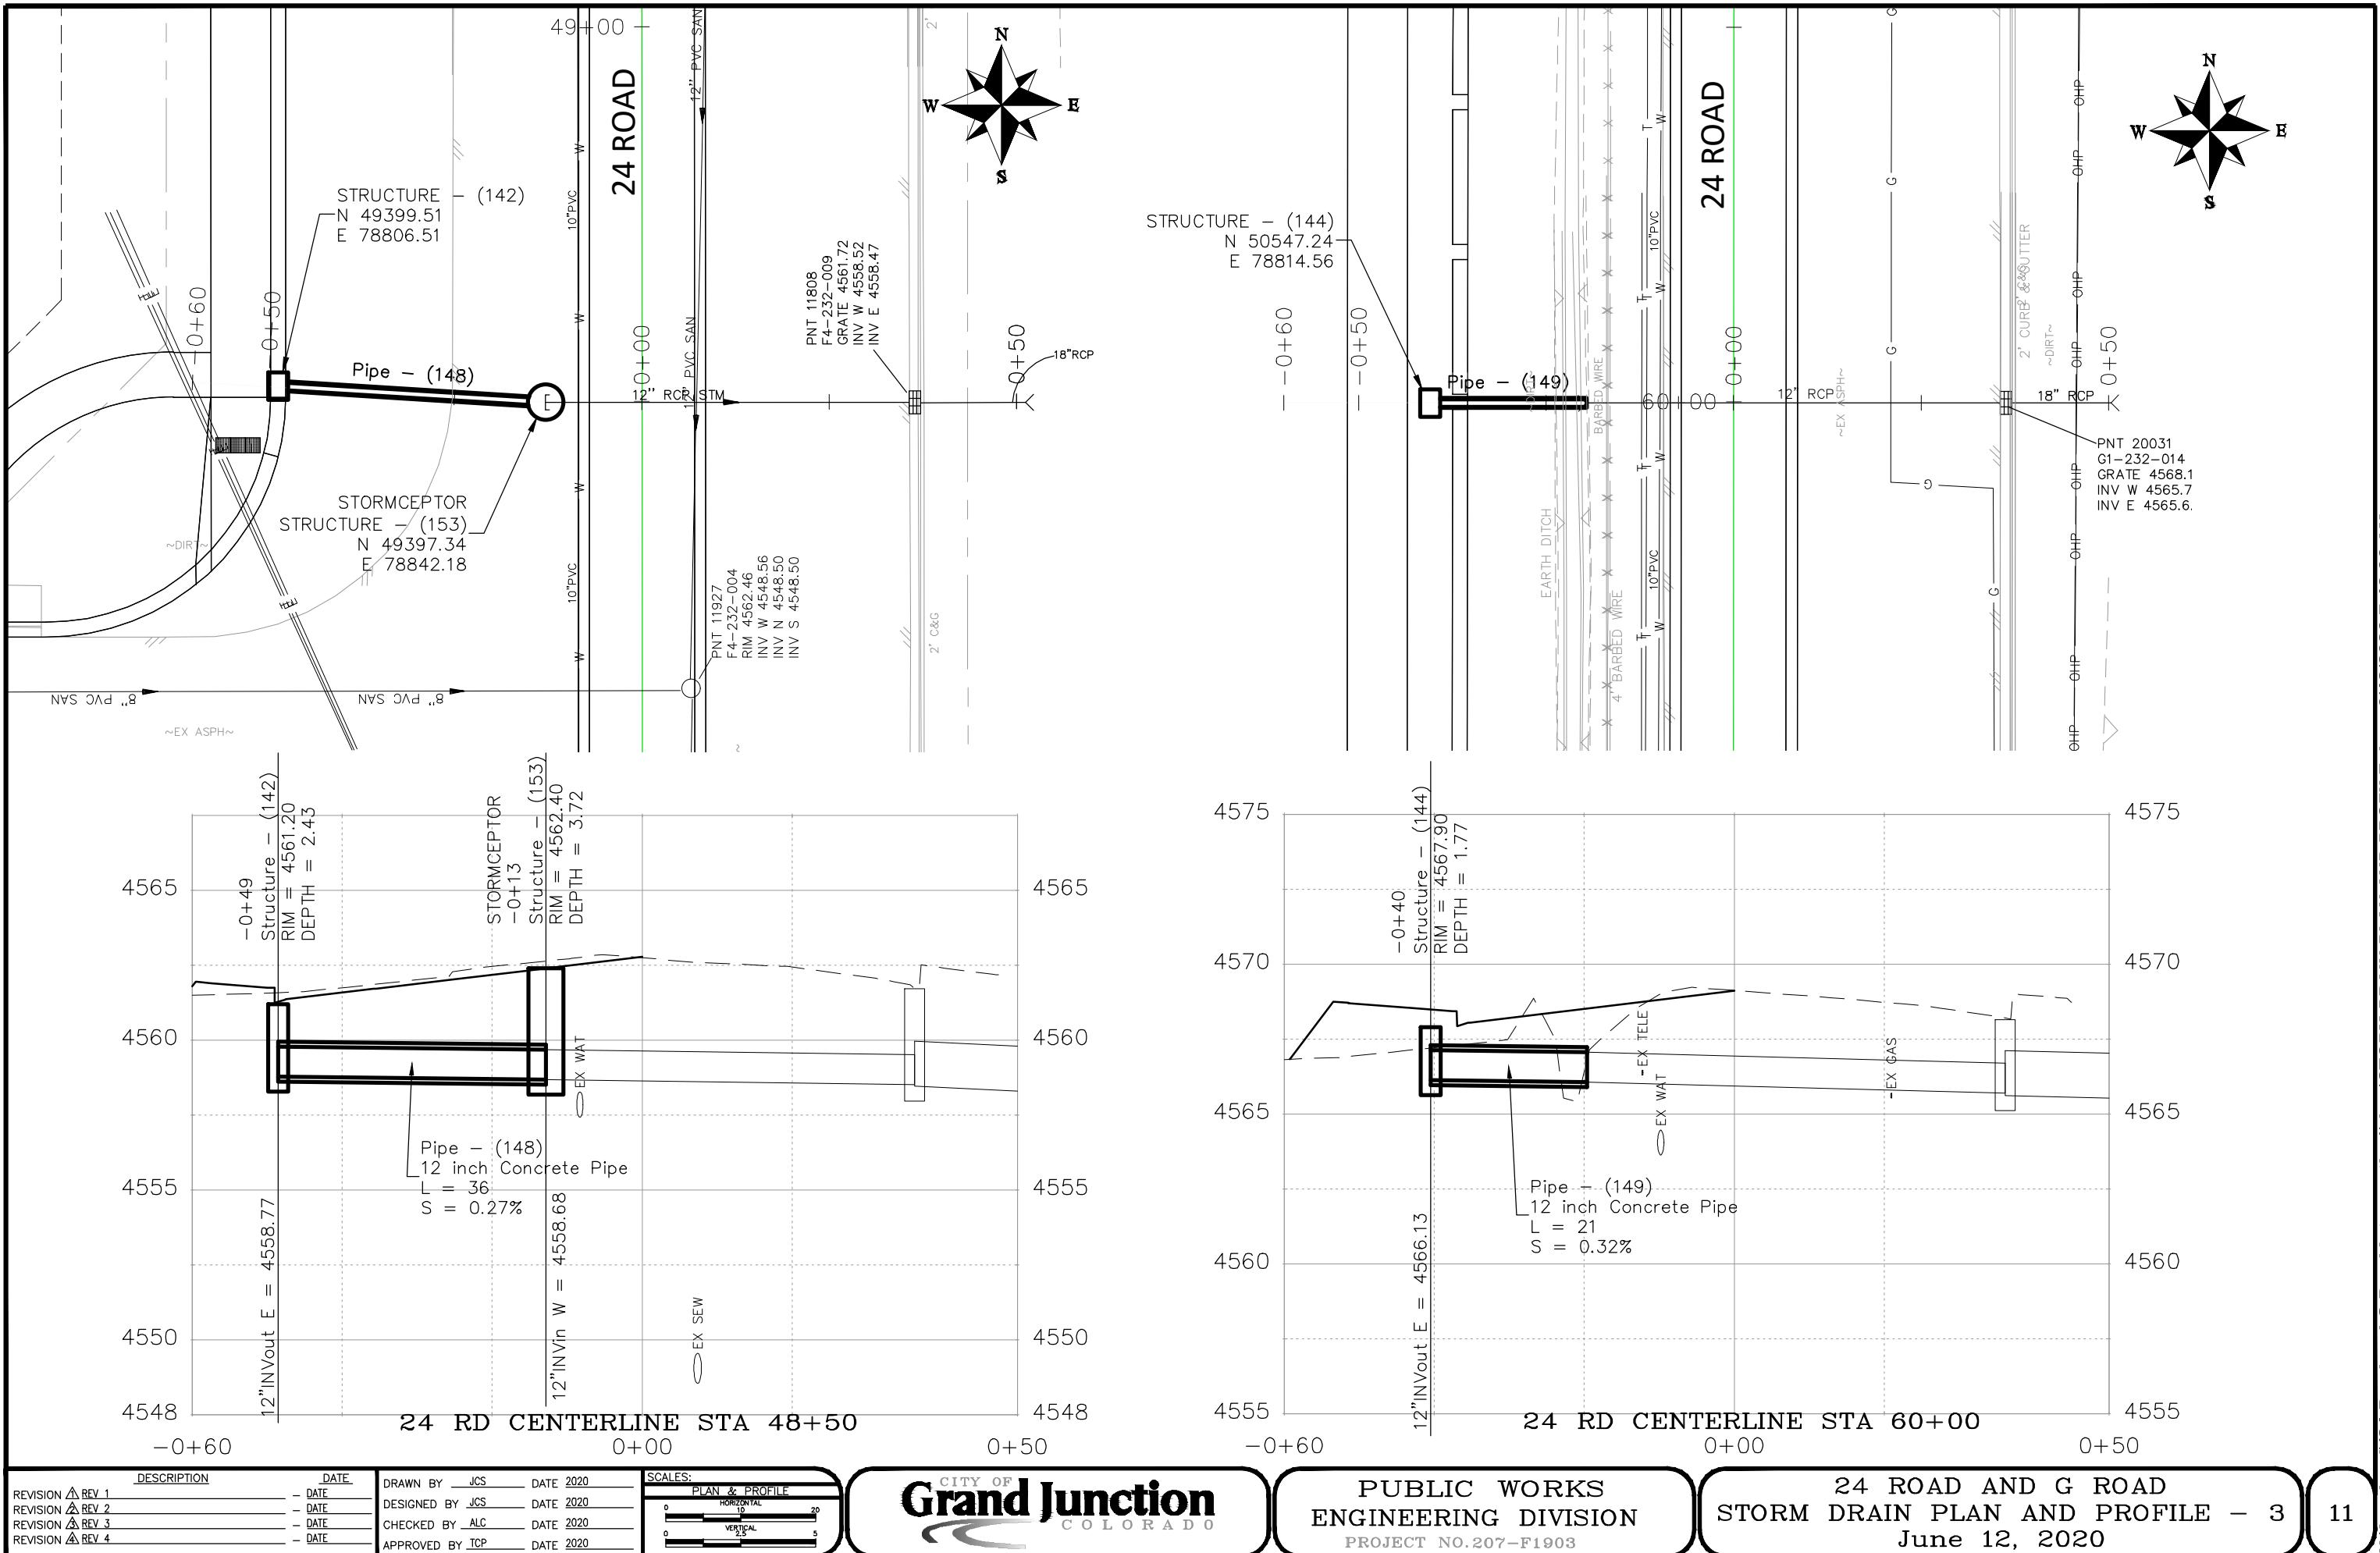

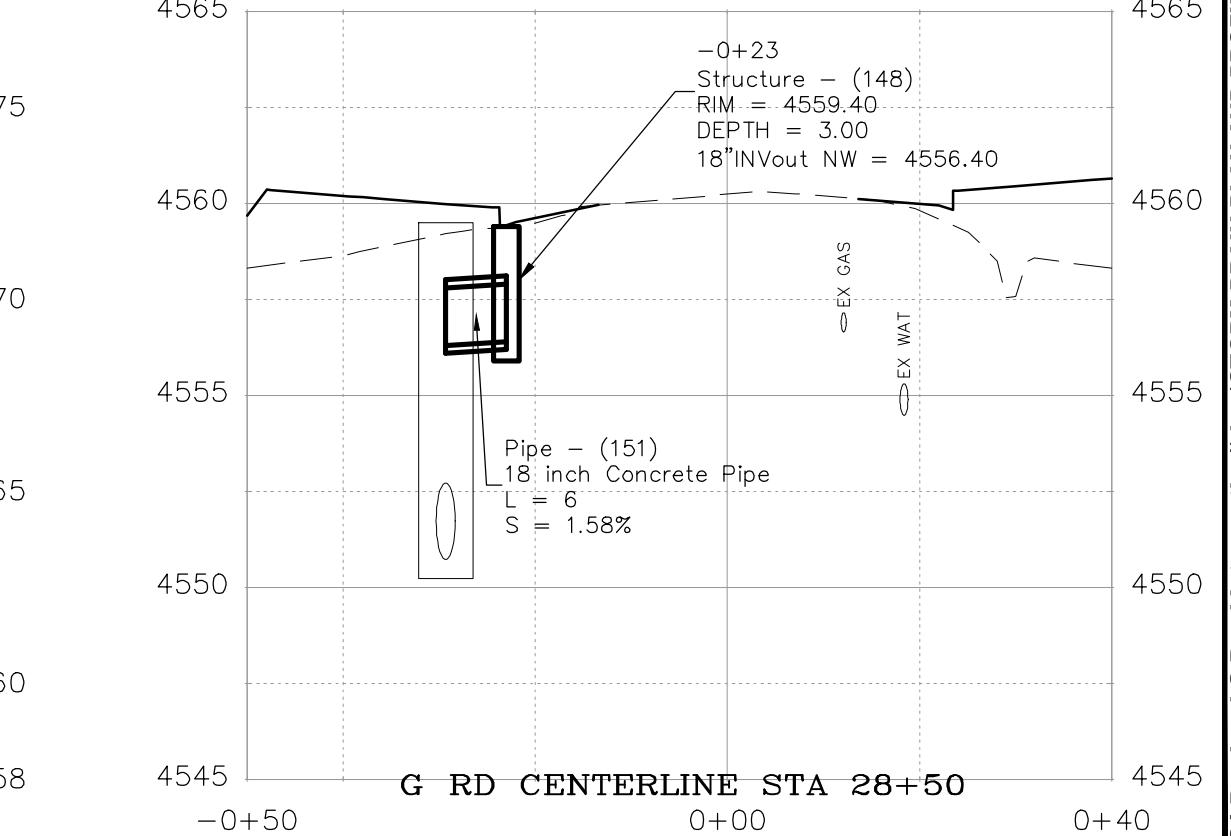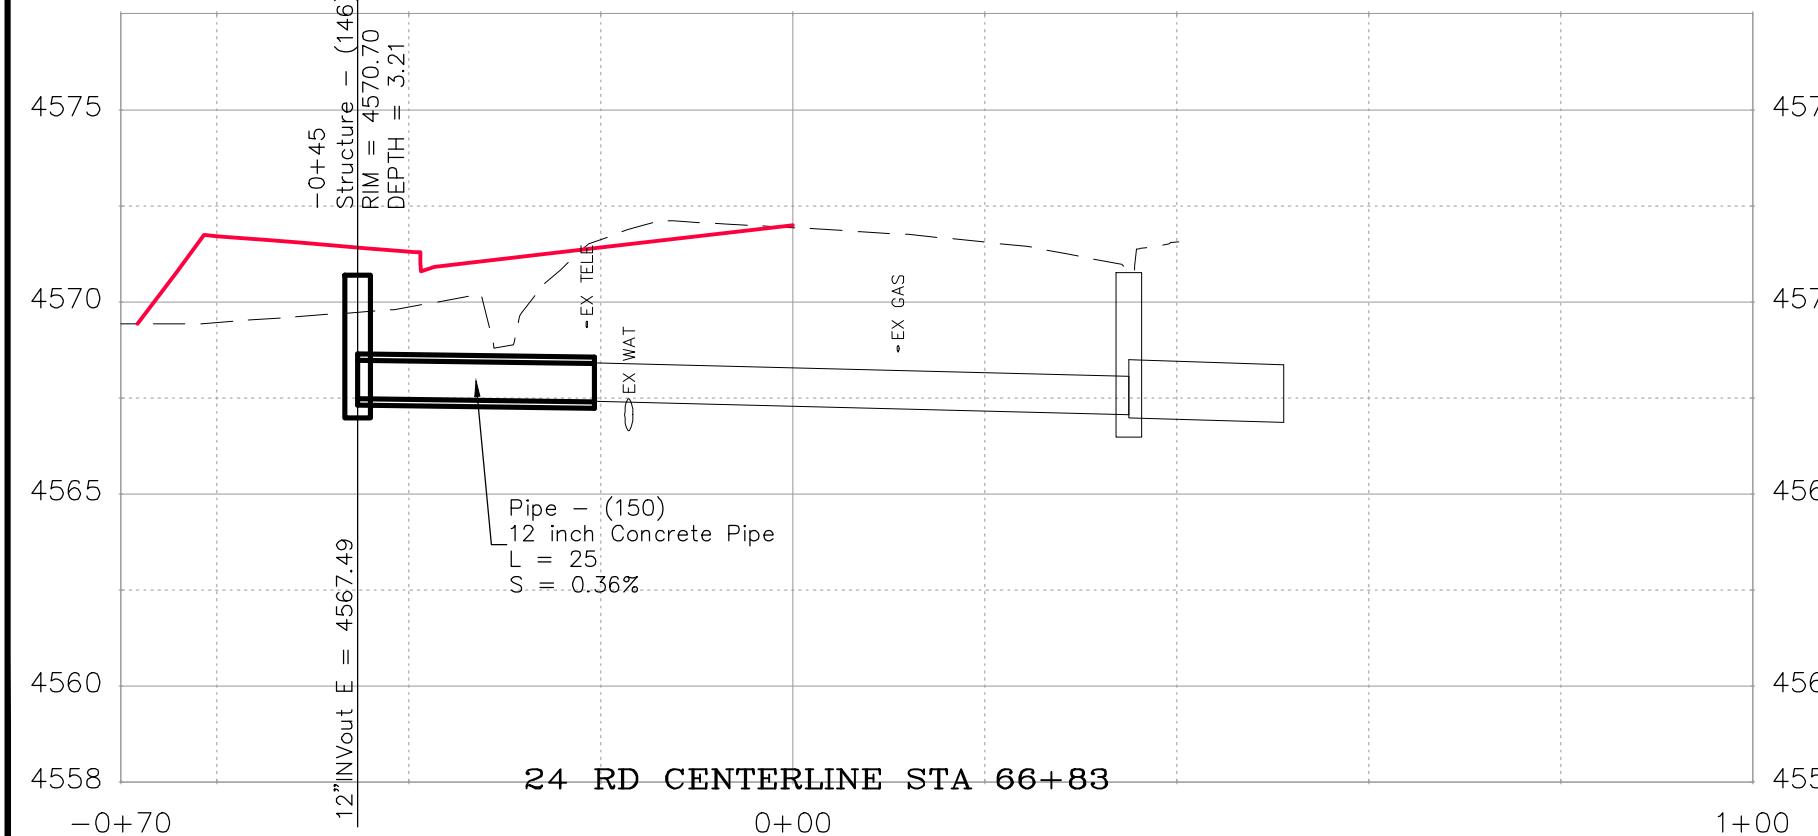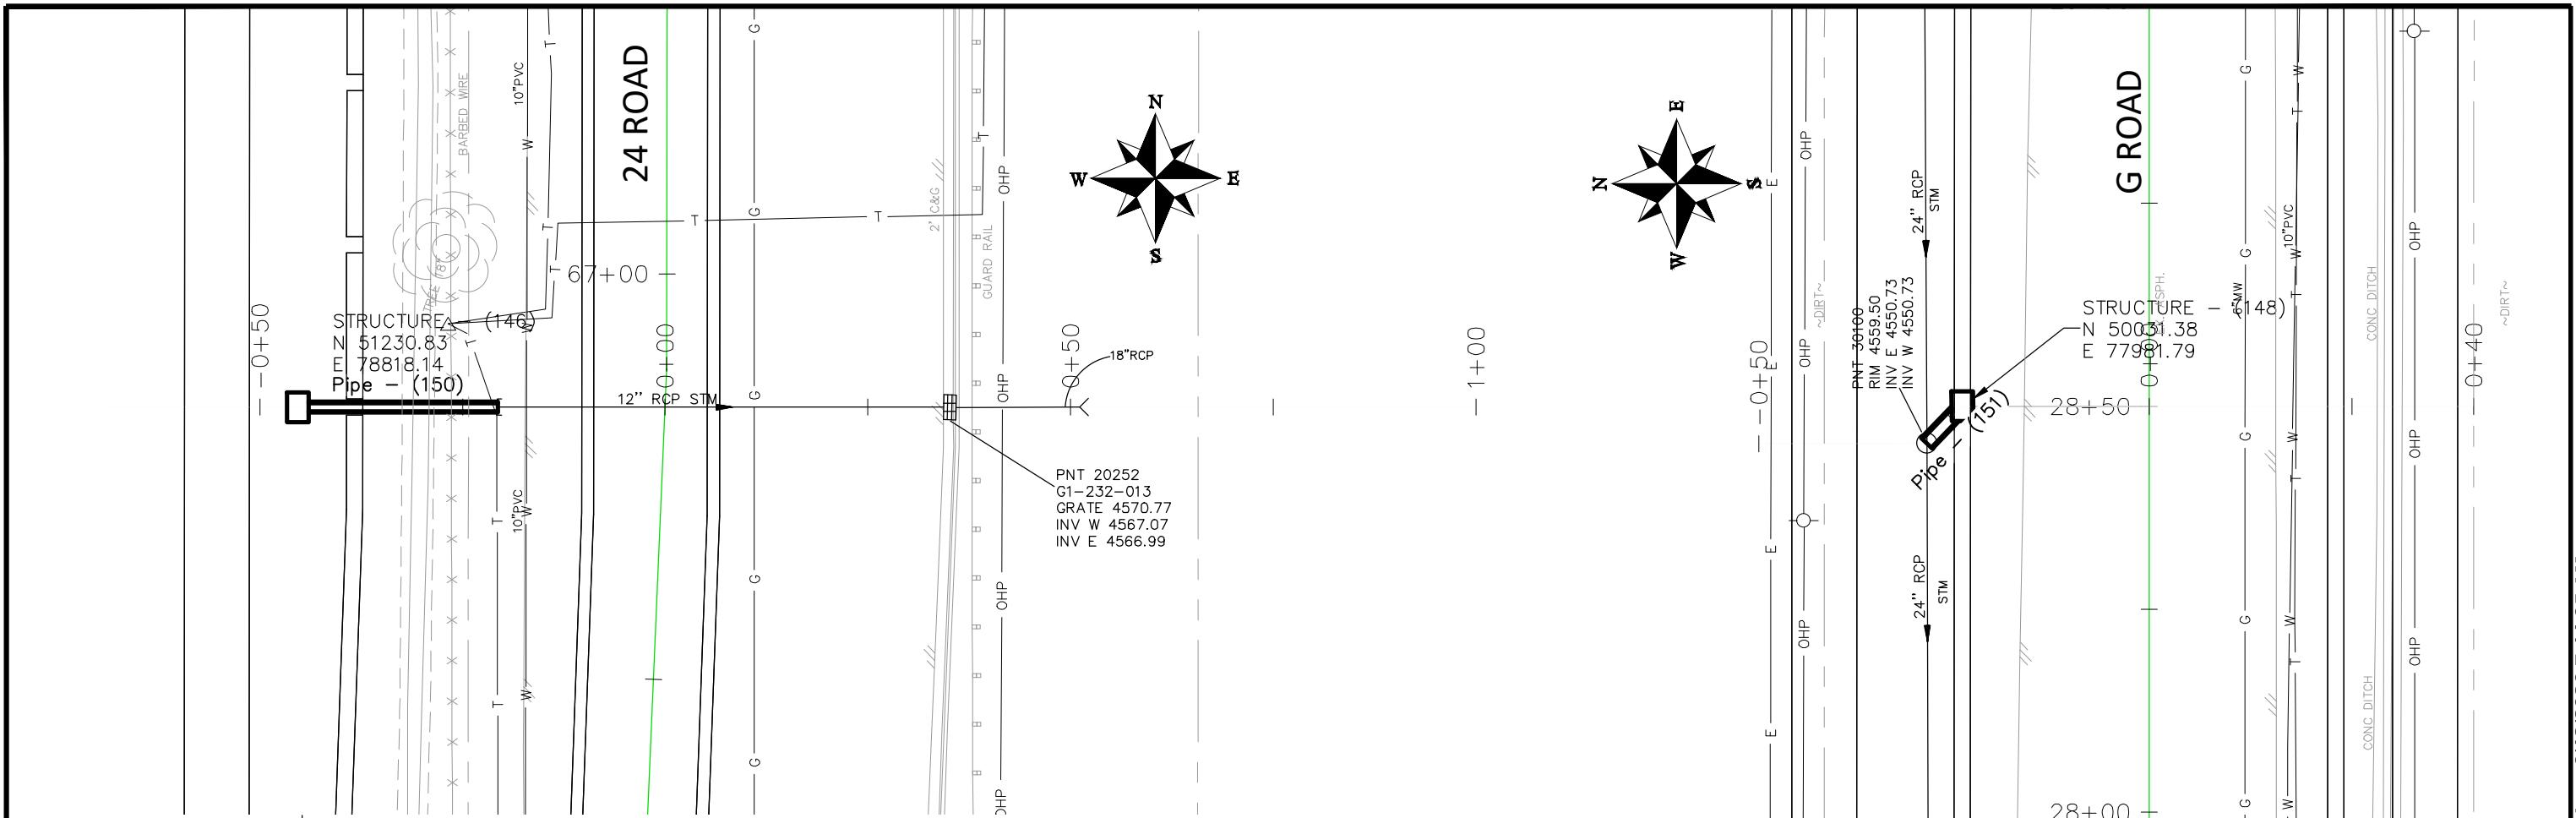

DESCRIPTION	DATE
REVISION A REV 1	DATE
REVISION A REV 2	DATE
REVISION A REV 3	DATE
REVISION A REV 4	DATE


DRAWN BY JCS	DATE 2020
DESIGNED BY JCS	DATE 2020
CHECKED BY ALC	DATE 2020
APPROVED BY TCP	DATE 2020

SCALES:	PLAN & PROFILE
0	HORIZONTAL 10° 20°
0	VERTICAL 5



CITY OF Grand Junction COLORADO

**PUBLIC WORKS
ENGINEERING DIVISION**
PROJECT NO. 207-F1903

**24 ROAD AND G ROAD
STORM DRAIN PLAN AND PROFILE - 4**
June 12, 2020

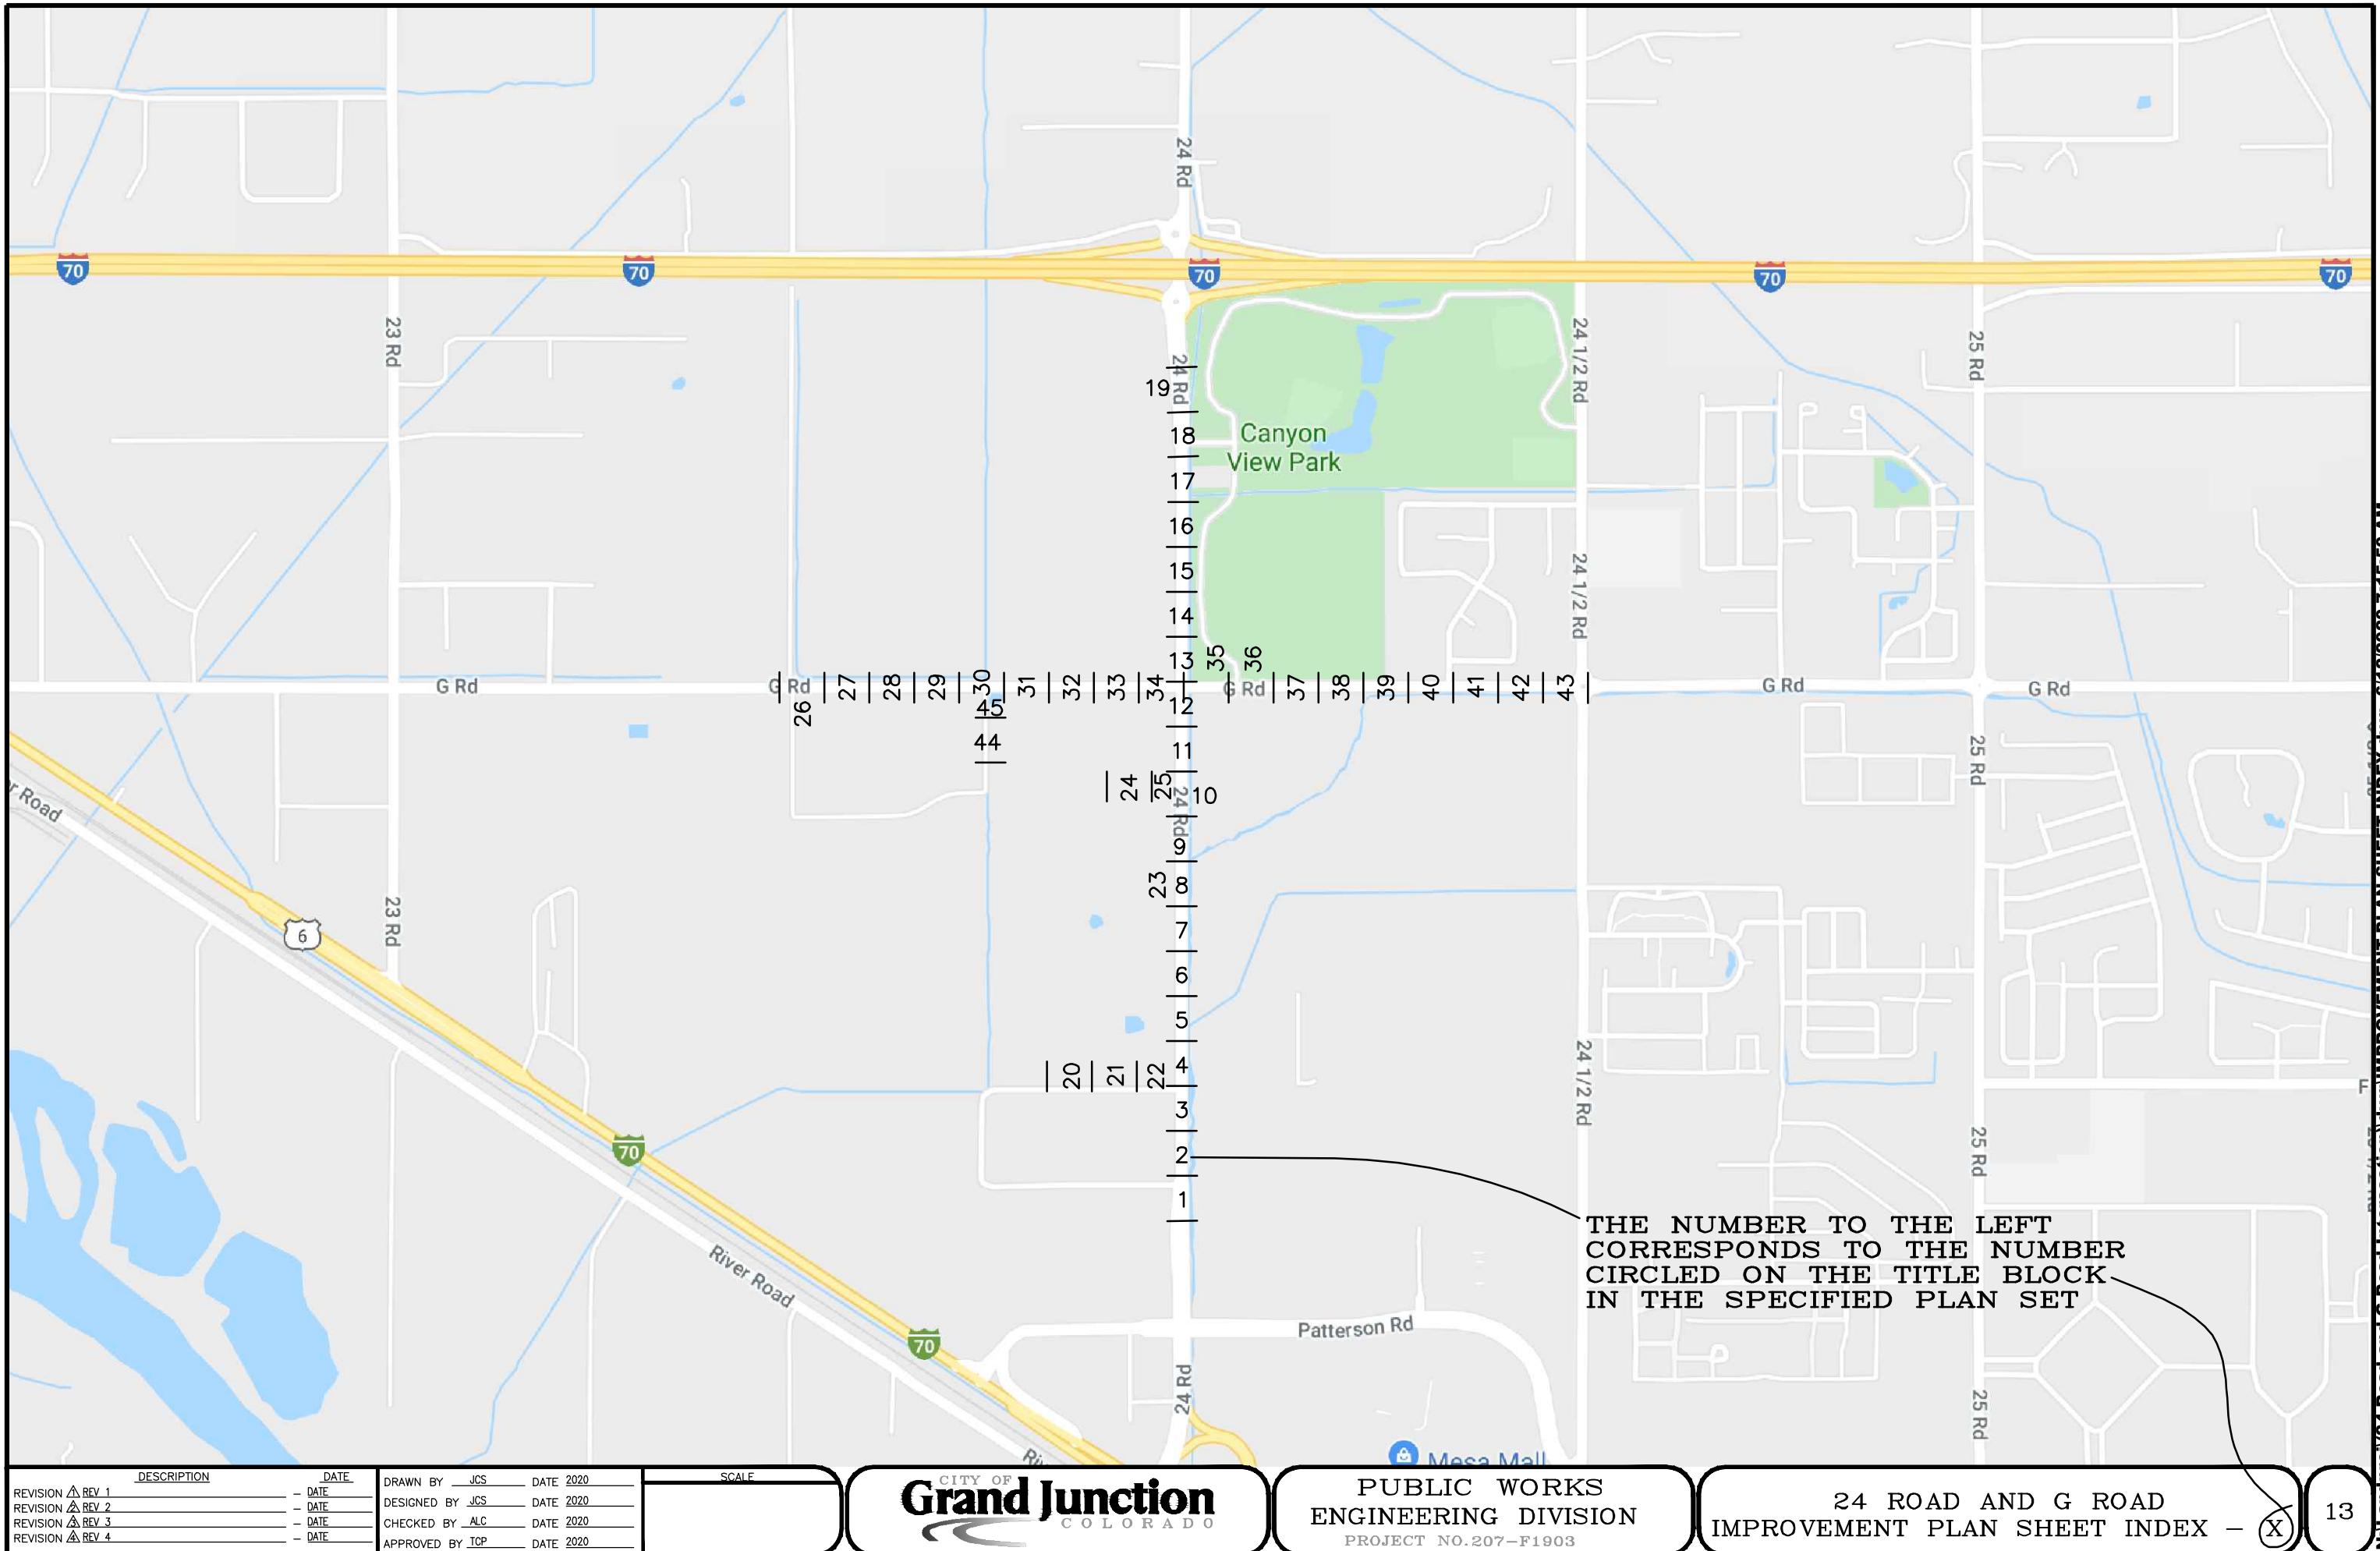


2945-054-00-071
633 24 RD
TIMBERLINE BANK INC

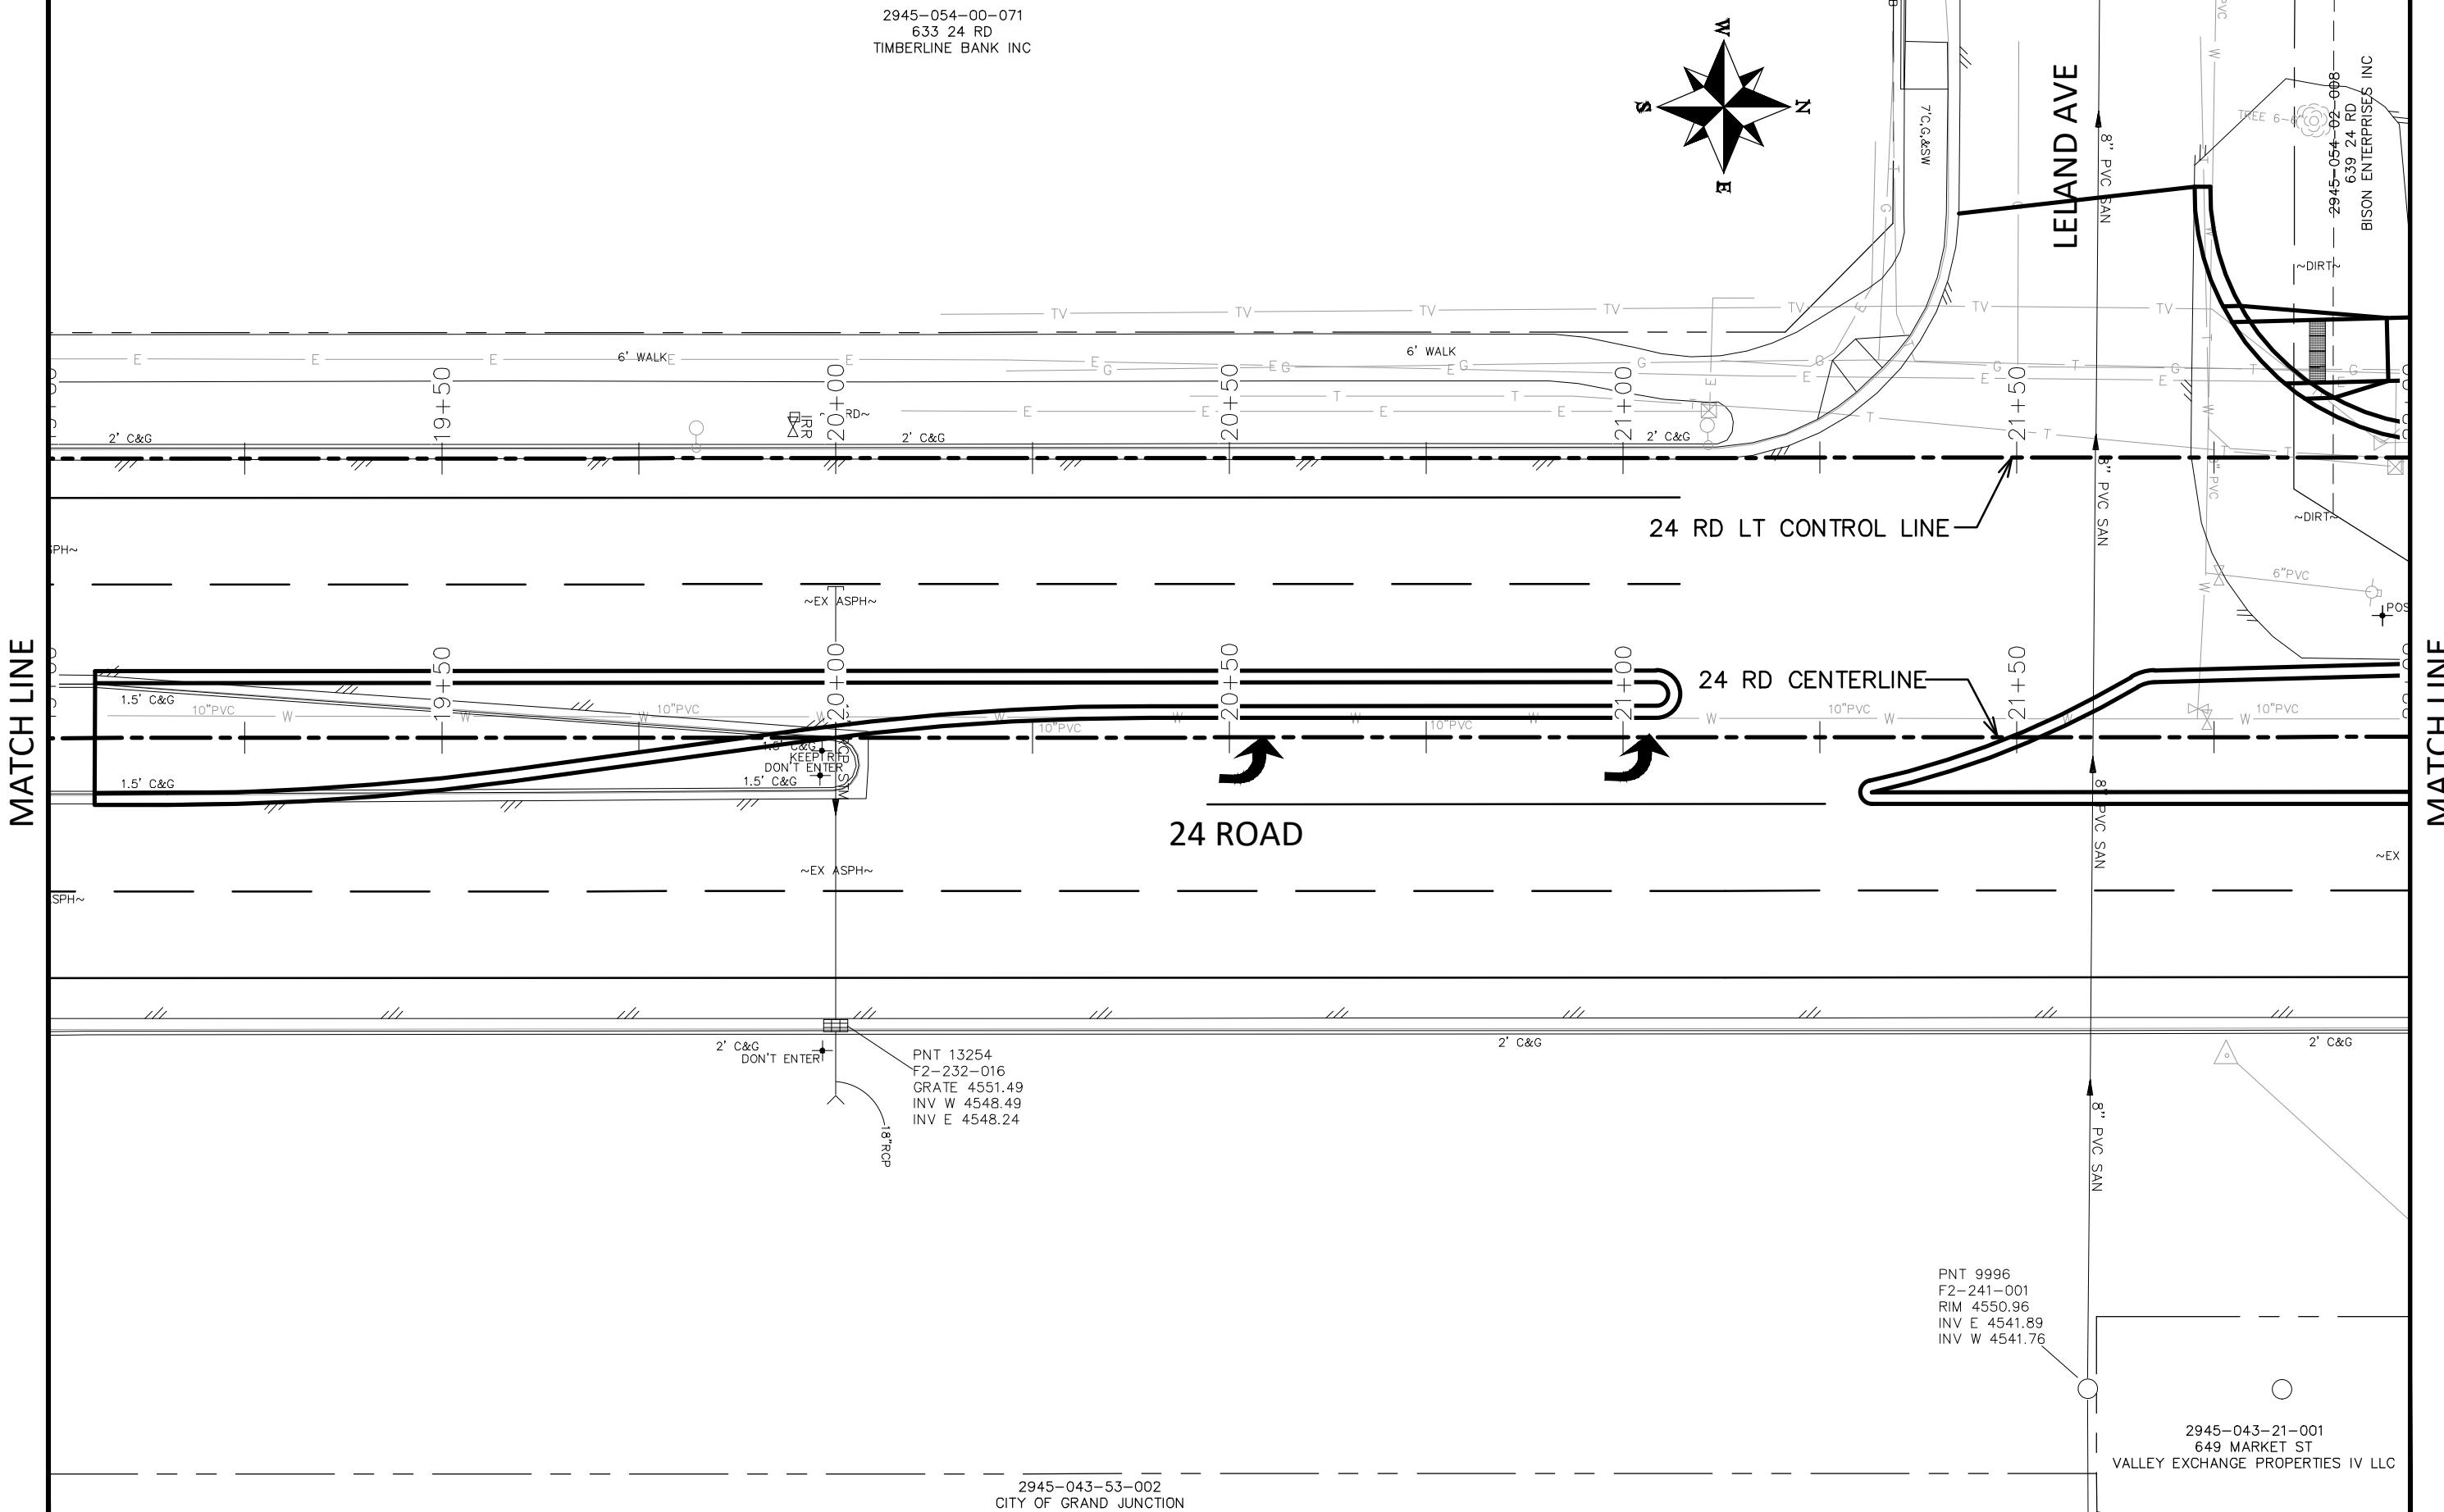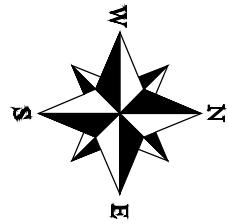

DESCRIPTION	DATE
REVISION A REV 1	- DATE
REVISION A REV 2	- DATE
REVISION A REV 3	- DATE
REVISION A REV 4	- DATE


DRAWN BY	JCS	DATE	2020
DESIGNED BY	JCS	DATE	2020
CHECKED BY	ALC	DATE	2020
APPROVED BY	TCP	DATE	2020

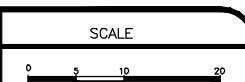

CITY OF
Grand Junction
COLORADO

PUBLIC WORKS
ENGINEERING DIVISION
PROJECT NO. 207-F1903

24 ROAD AND G ROAD
IMPROVEMENT PLAN - 001

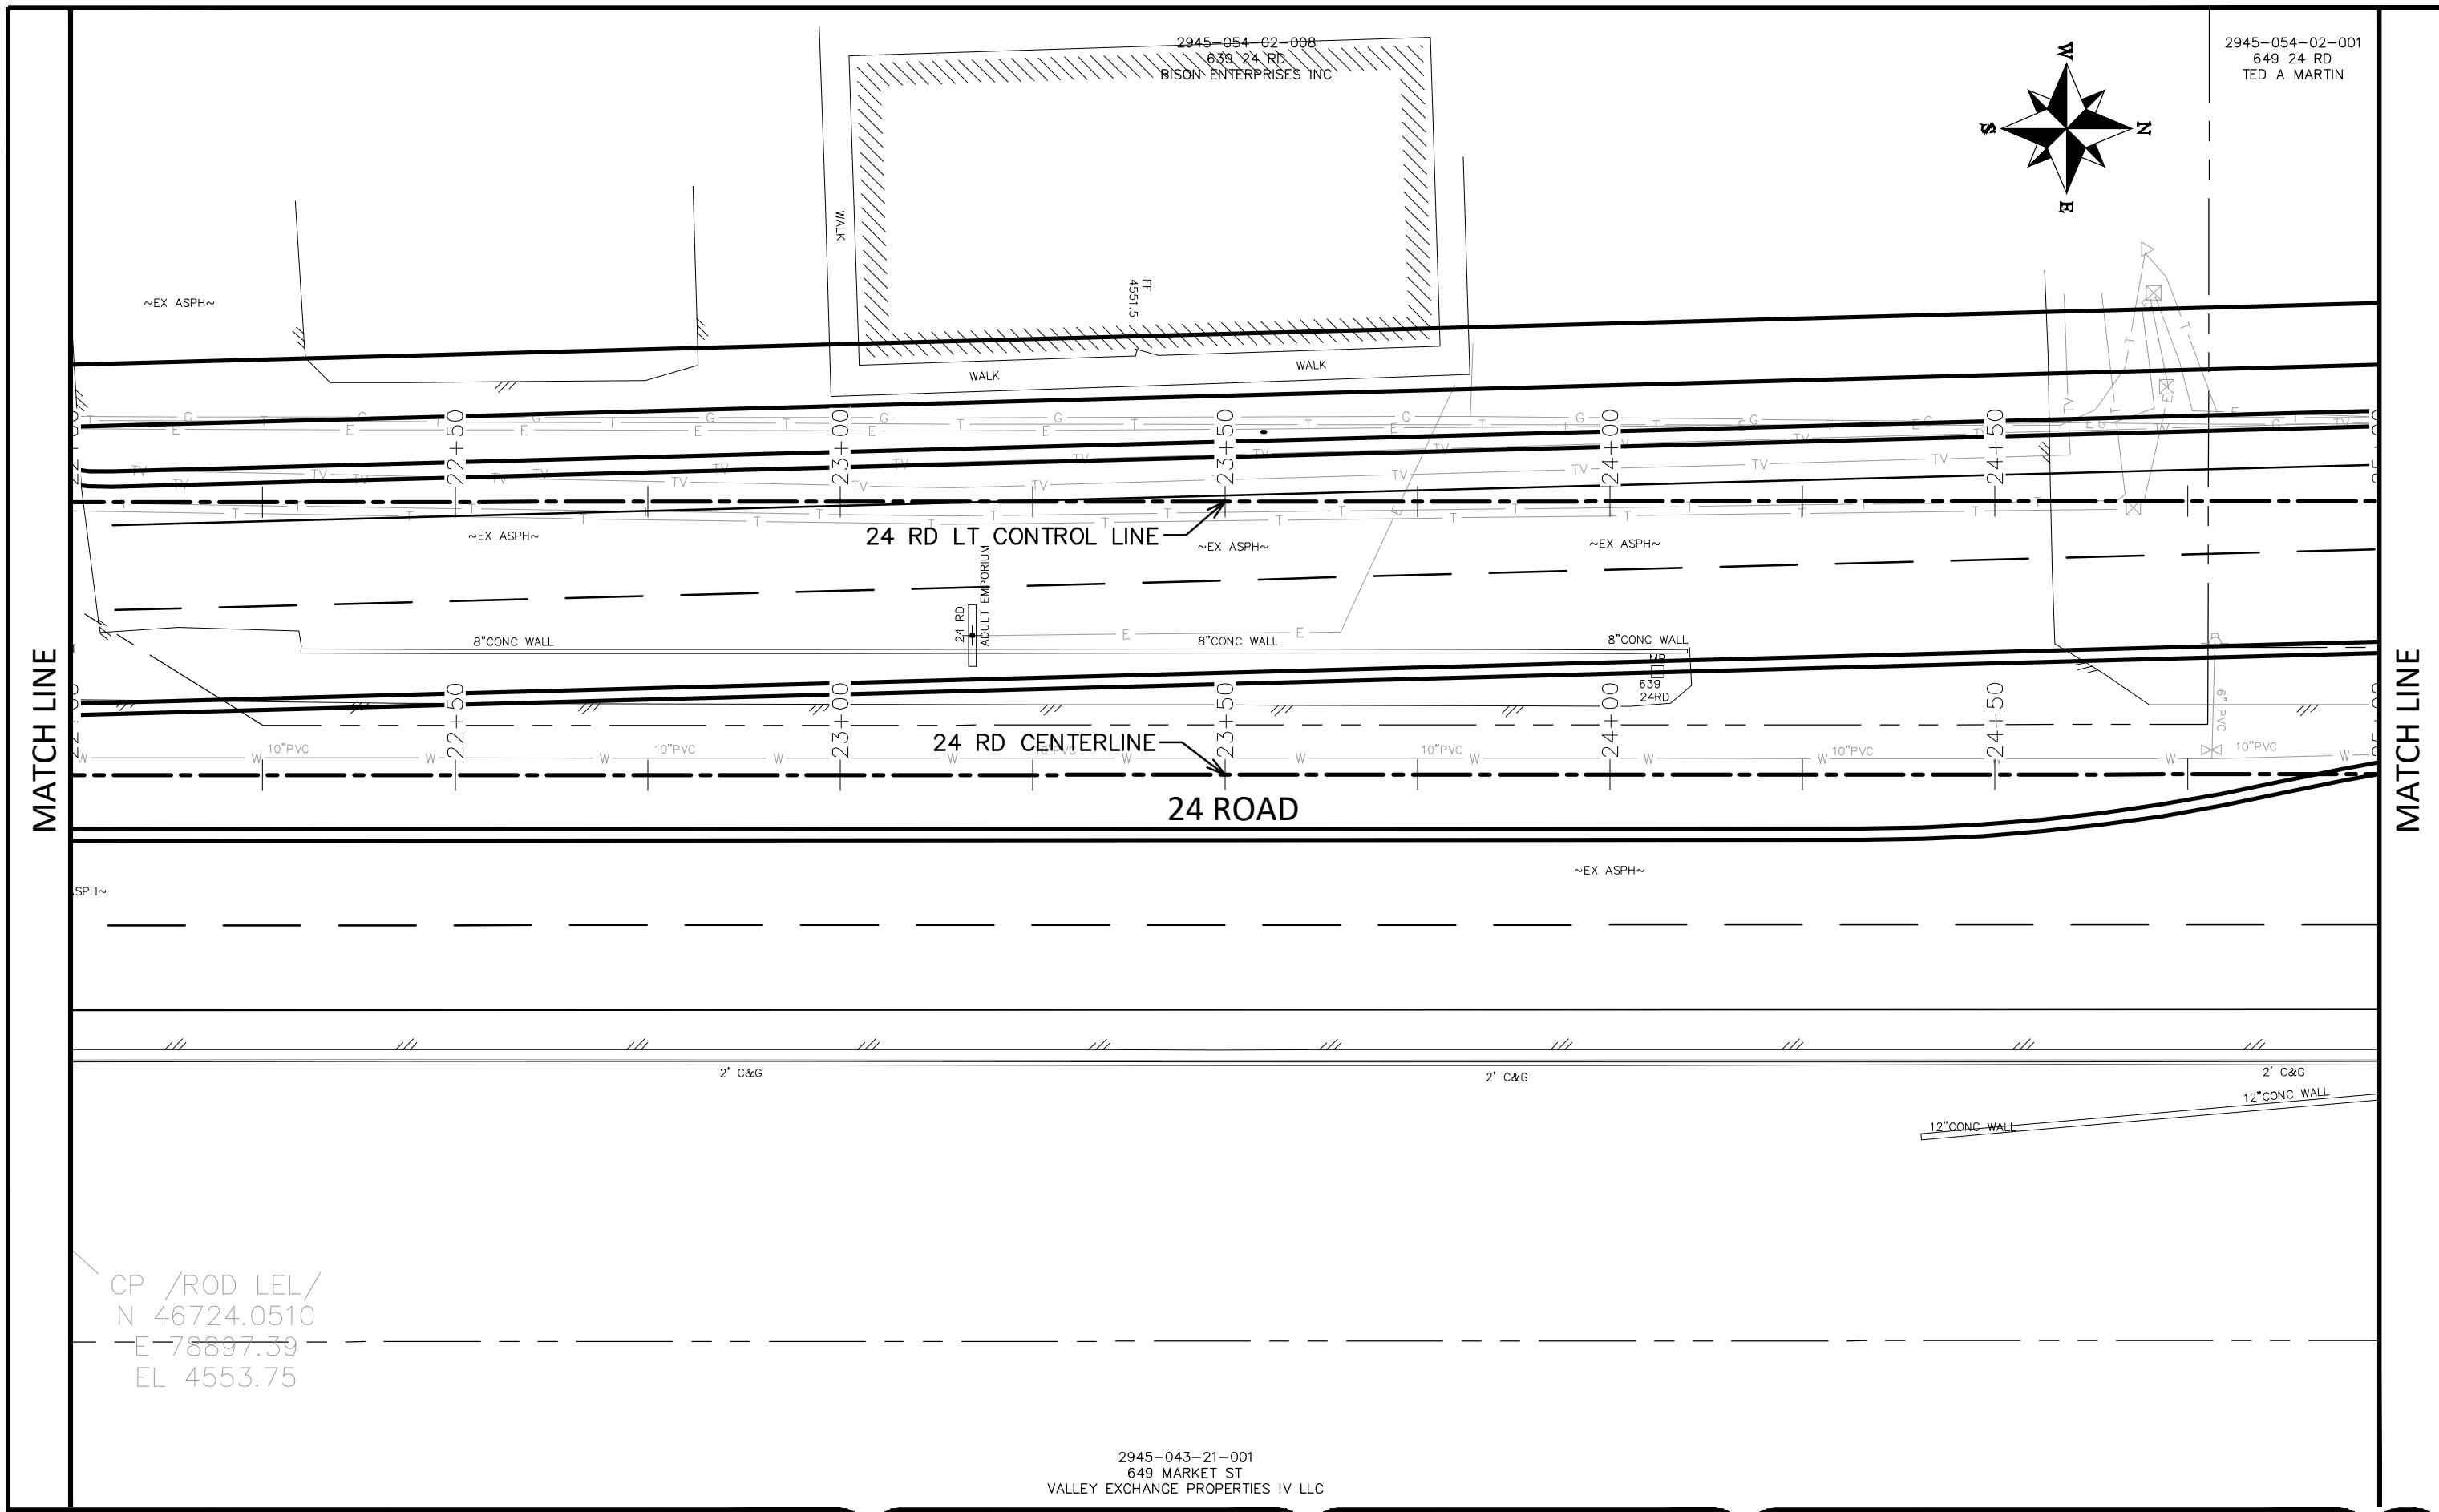

<u>DESCRIPTION</u>	<u>DATE</u>
REVISION A REV 1	— DATE
REVISION A REV 2	— DATE
REVISION A REV 3	— DATE
REVISION A REV 4	— DATE

DRAWN BY JCS DATE 2020
DESIGNED BY JCS DATE 2020
CHECKED BY ALC DATE 2020


SCALE




2945-043-21-001
649 MARKET ST
VALLEY EXCHANGE PROPERTIES IV LLC



PUBLIC WORKS
ENGINEERING DIVISION
PROJECT NO 207-F1903

24 ROAD AND G ROAD
IMPROVEMENT PLAN - 002

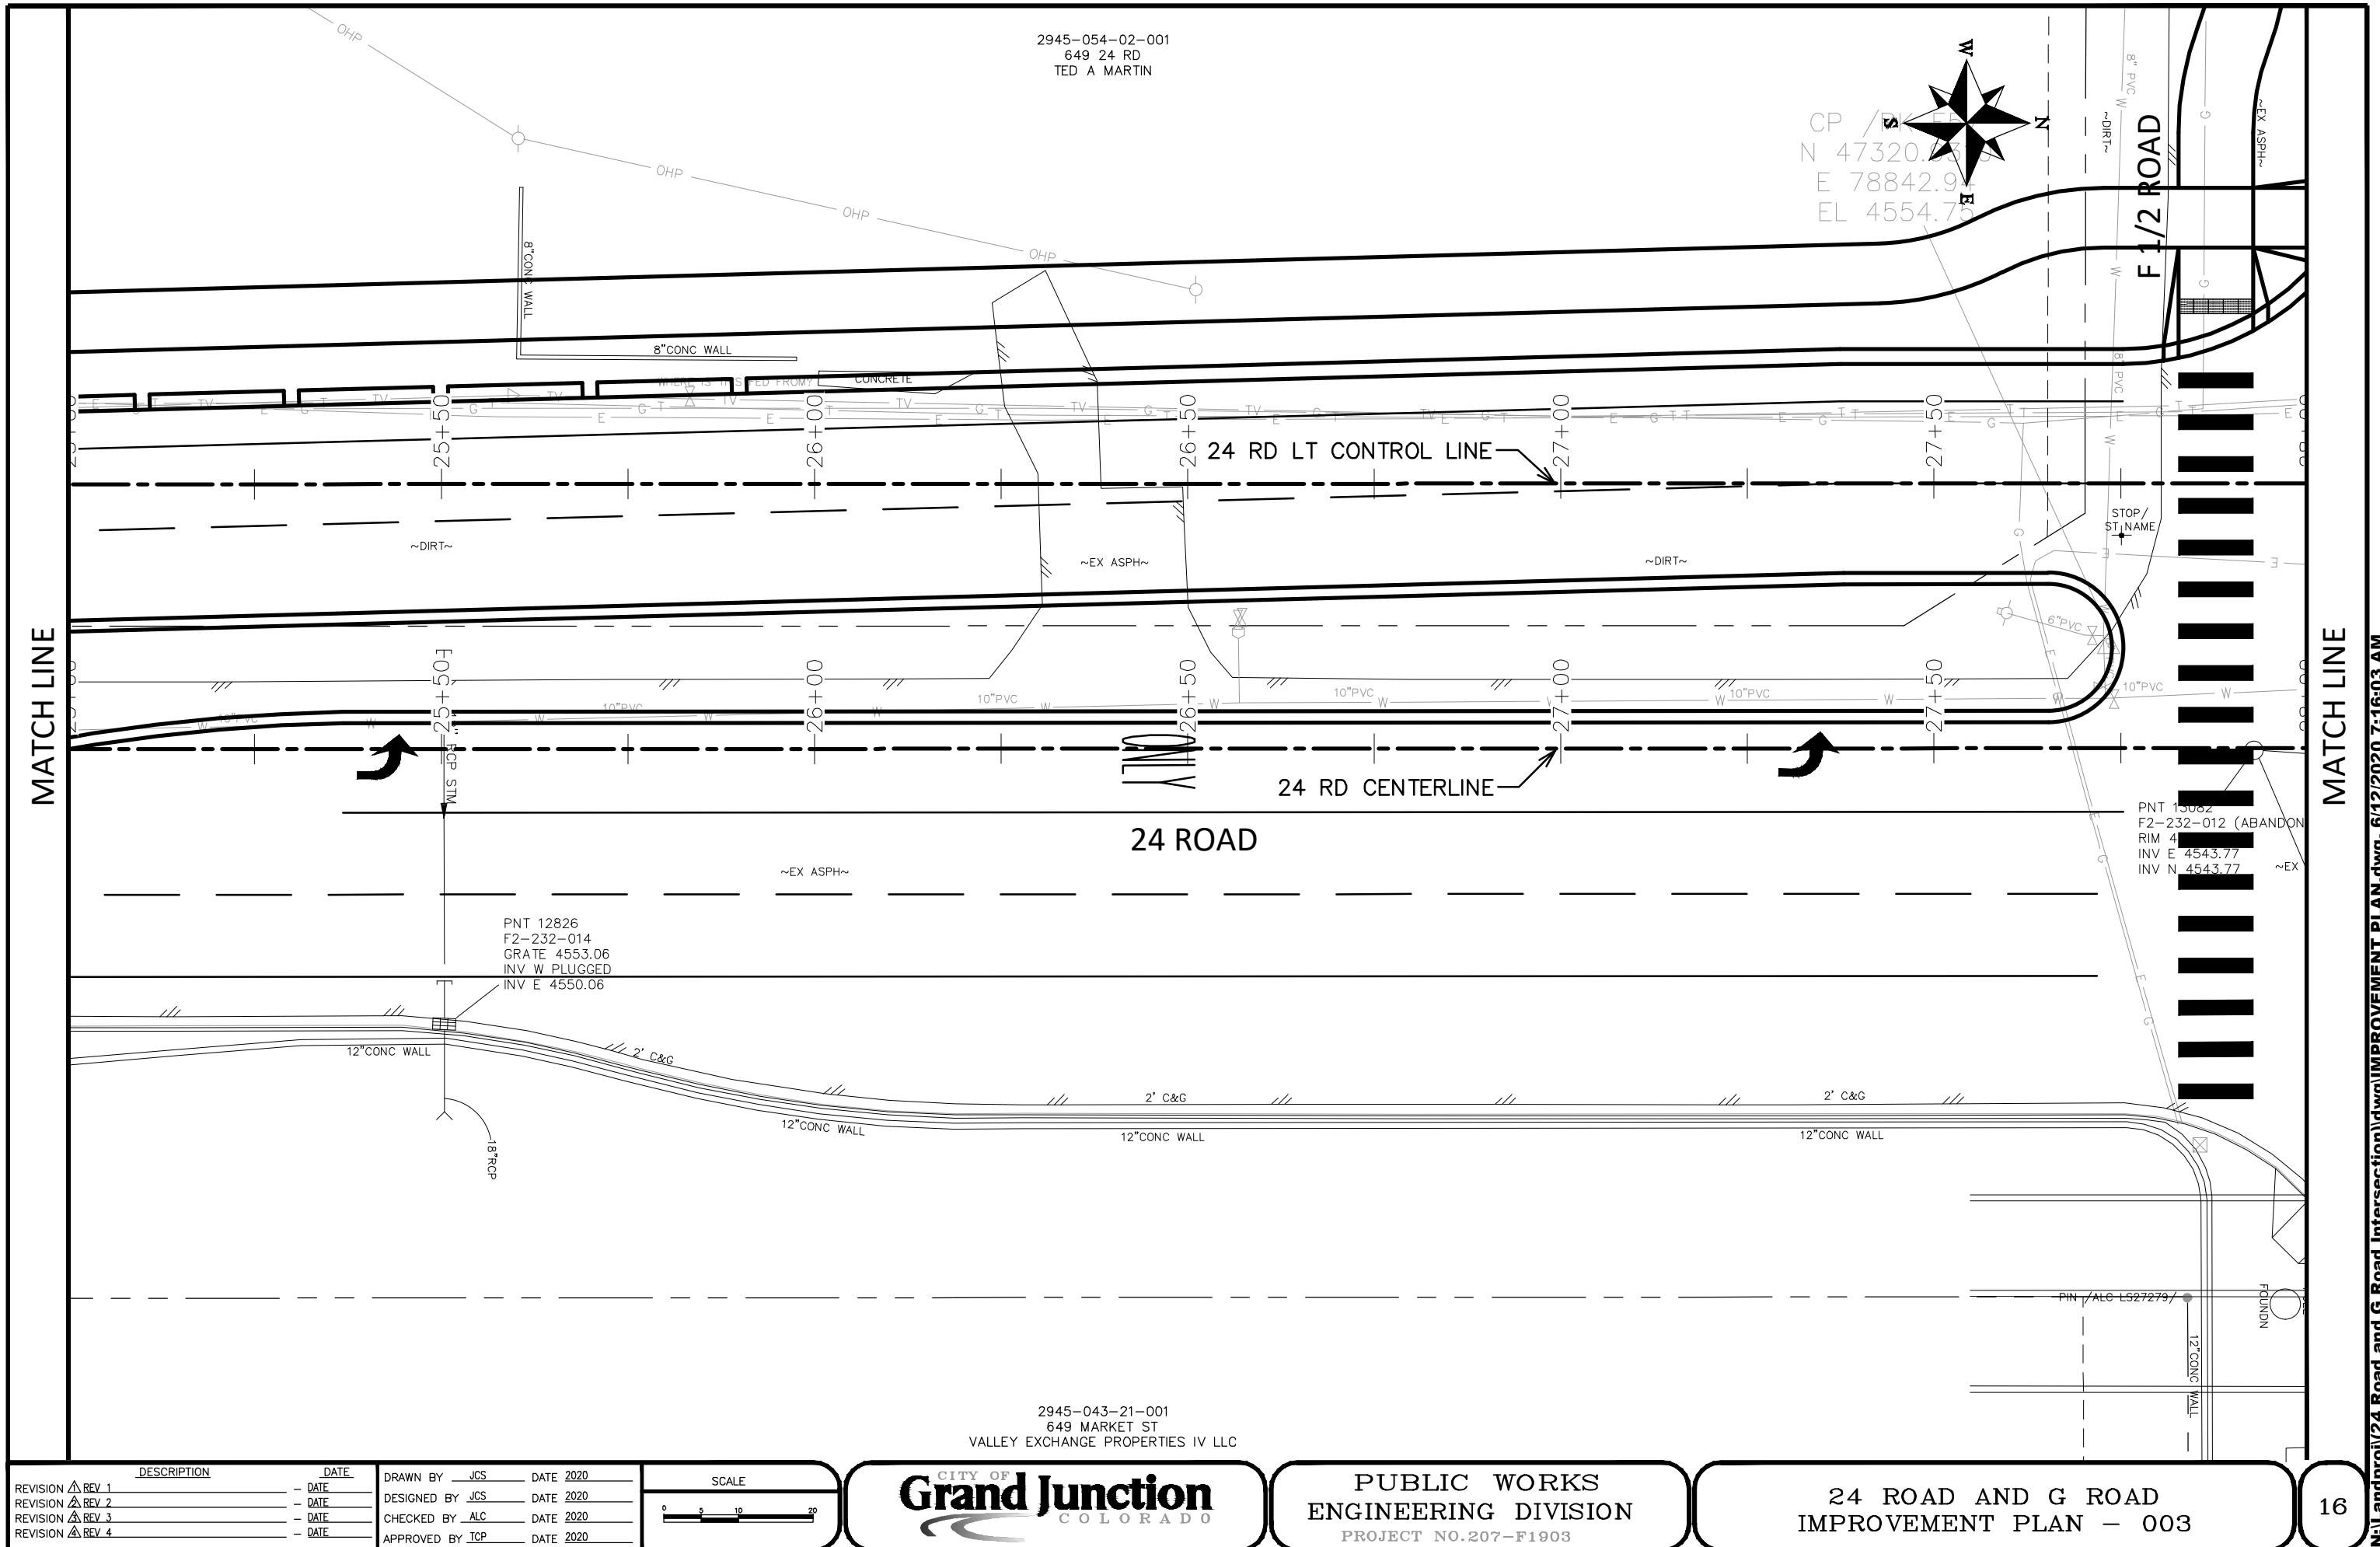

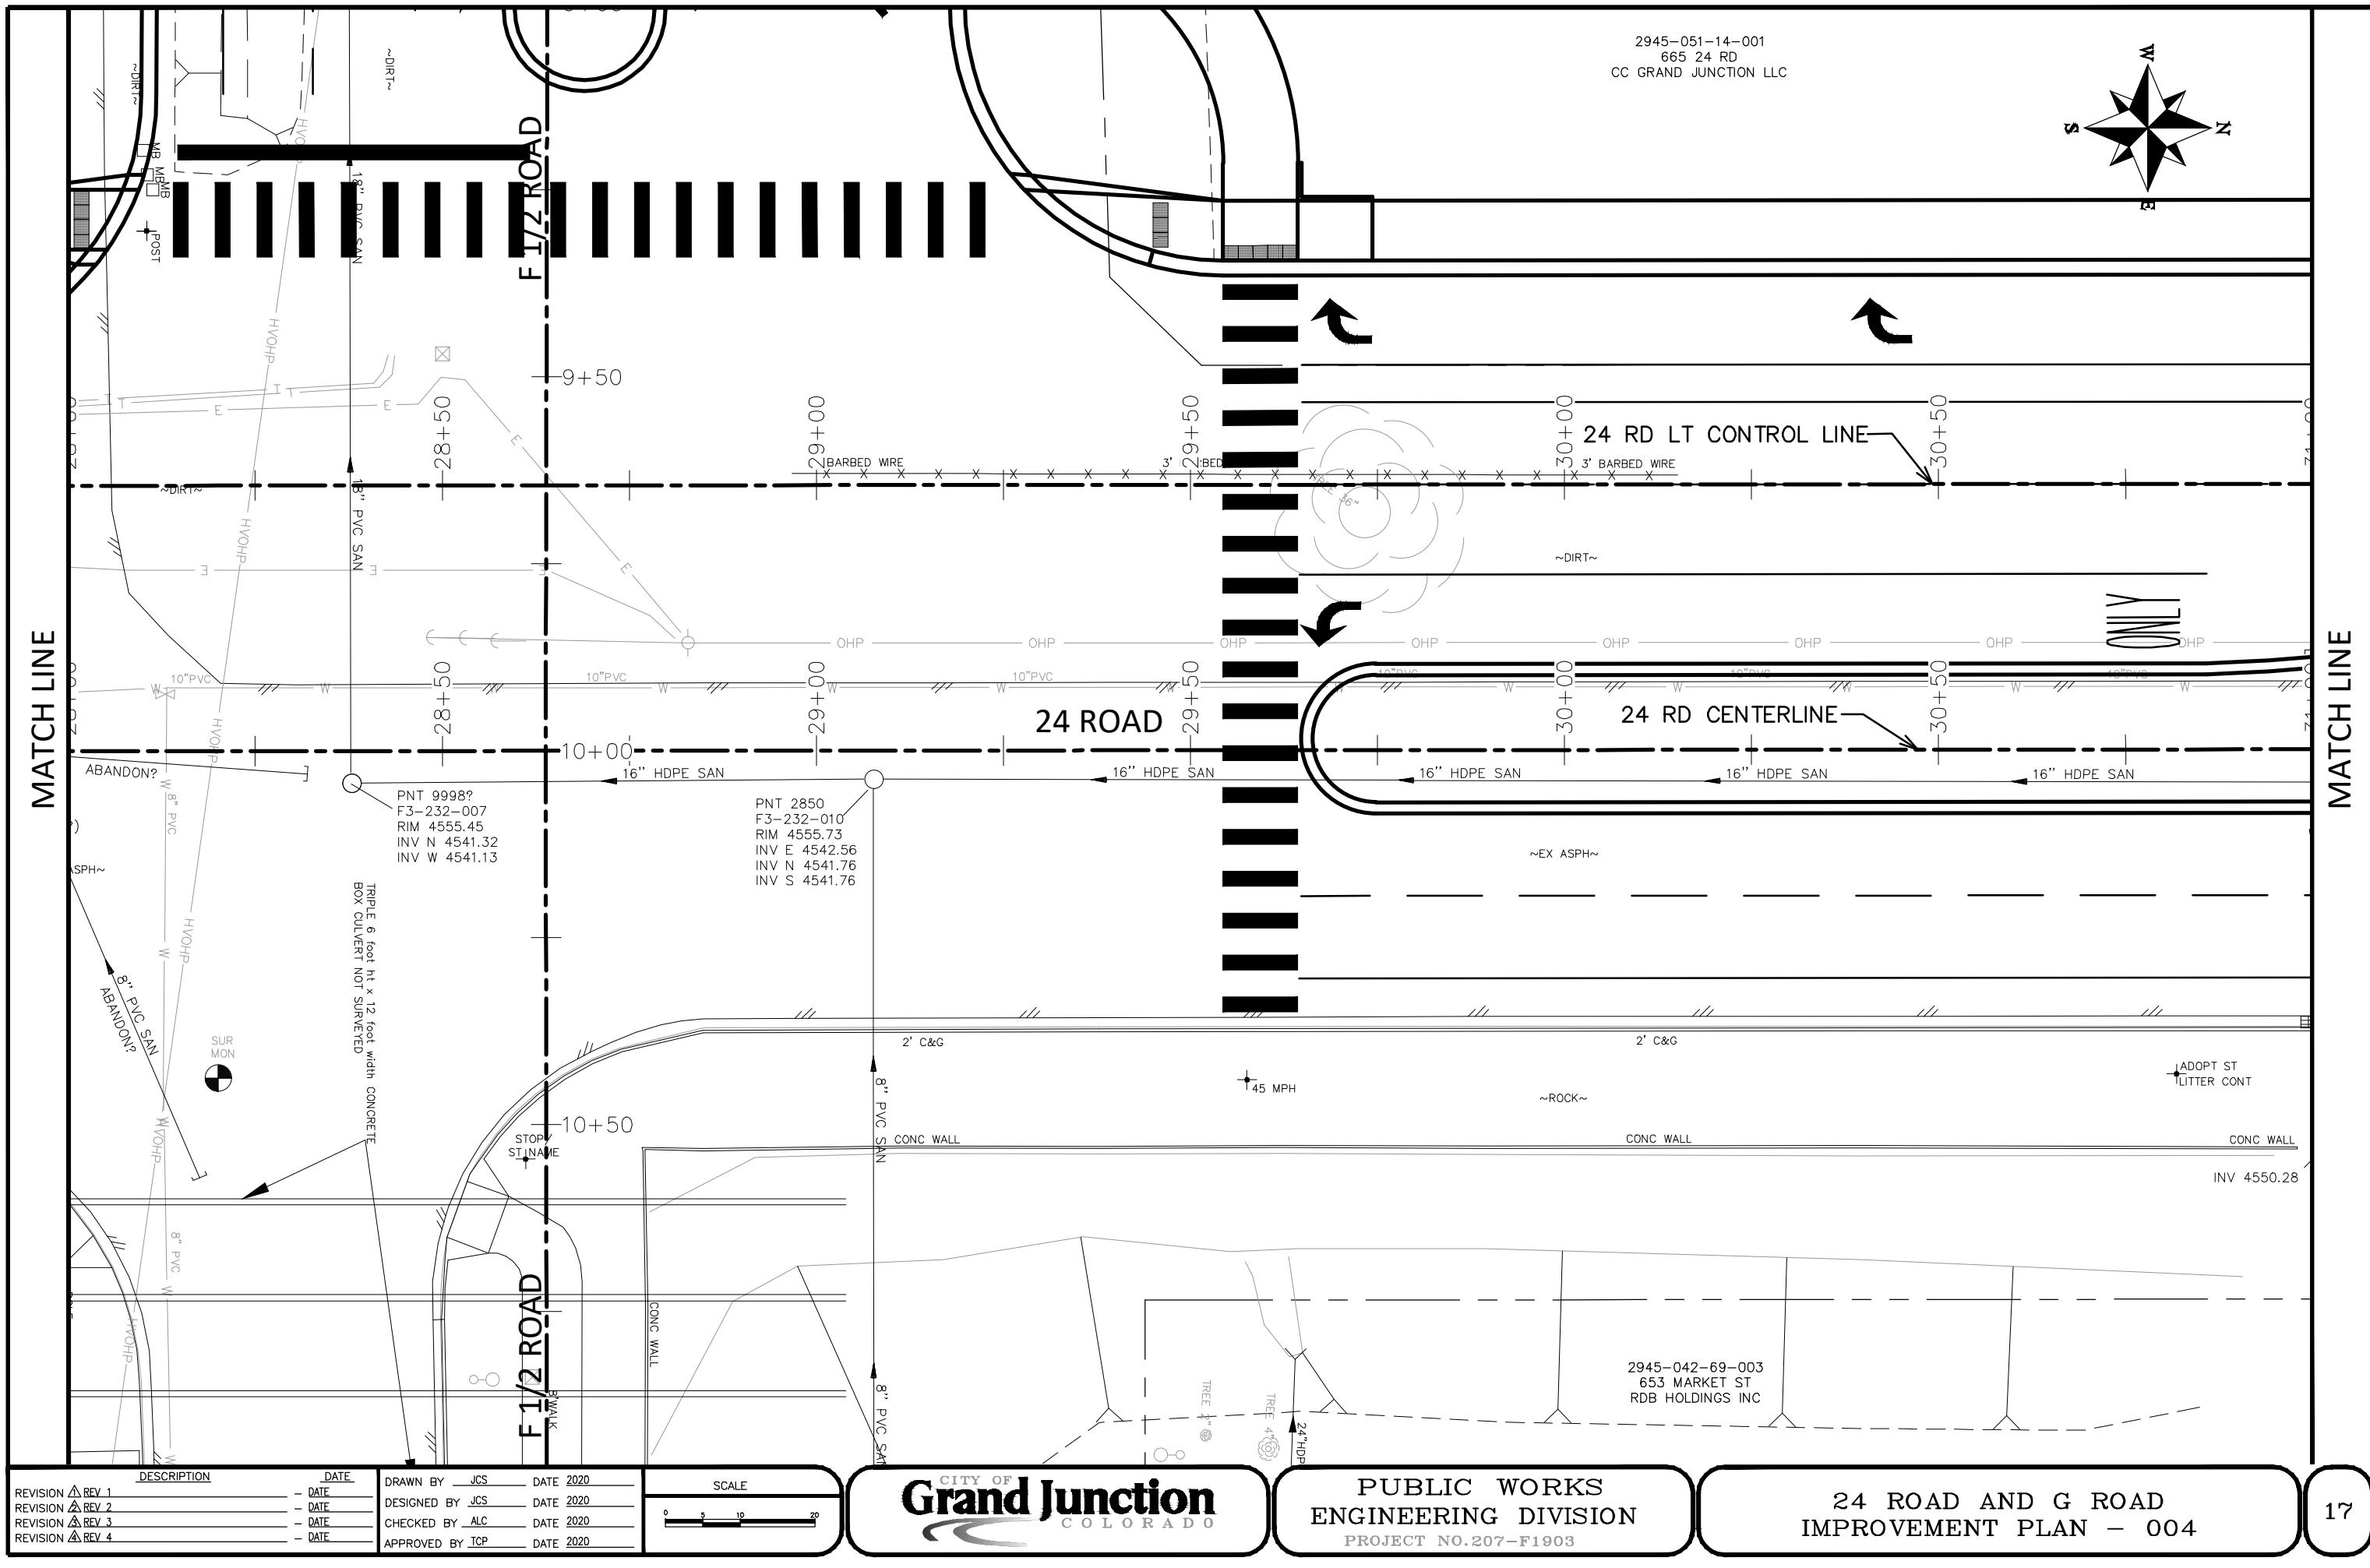


2945-051-14-001
665 24 RD
CC GRAND JUNCTION LLC

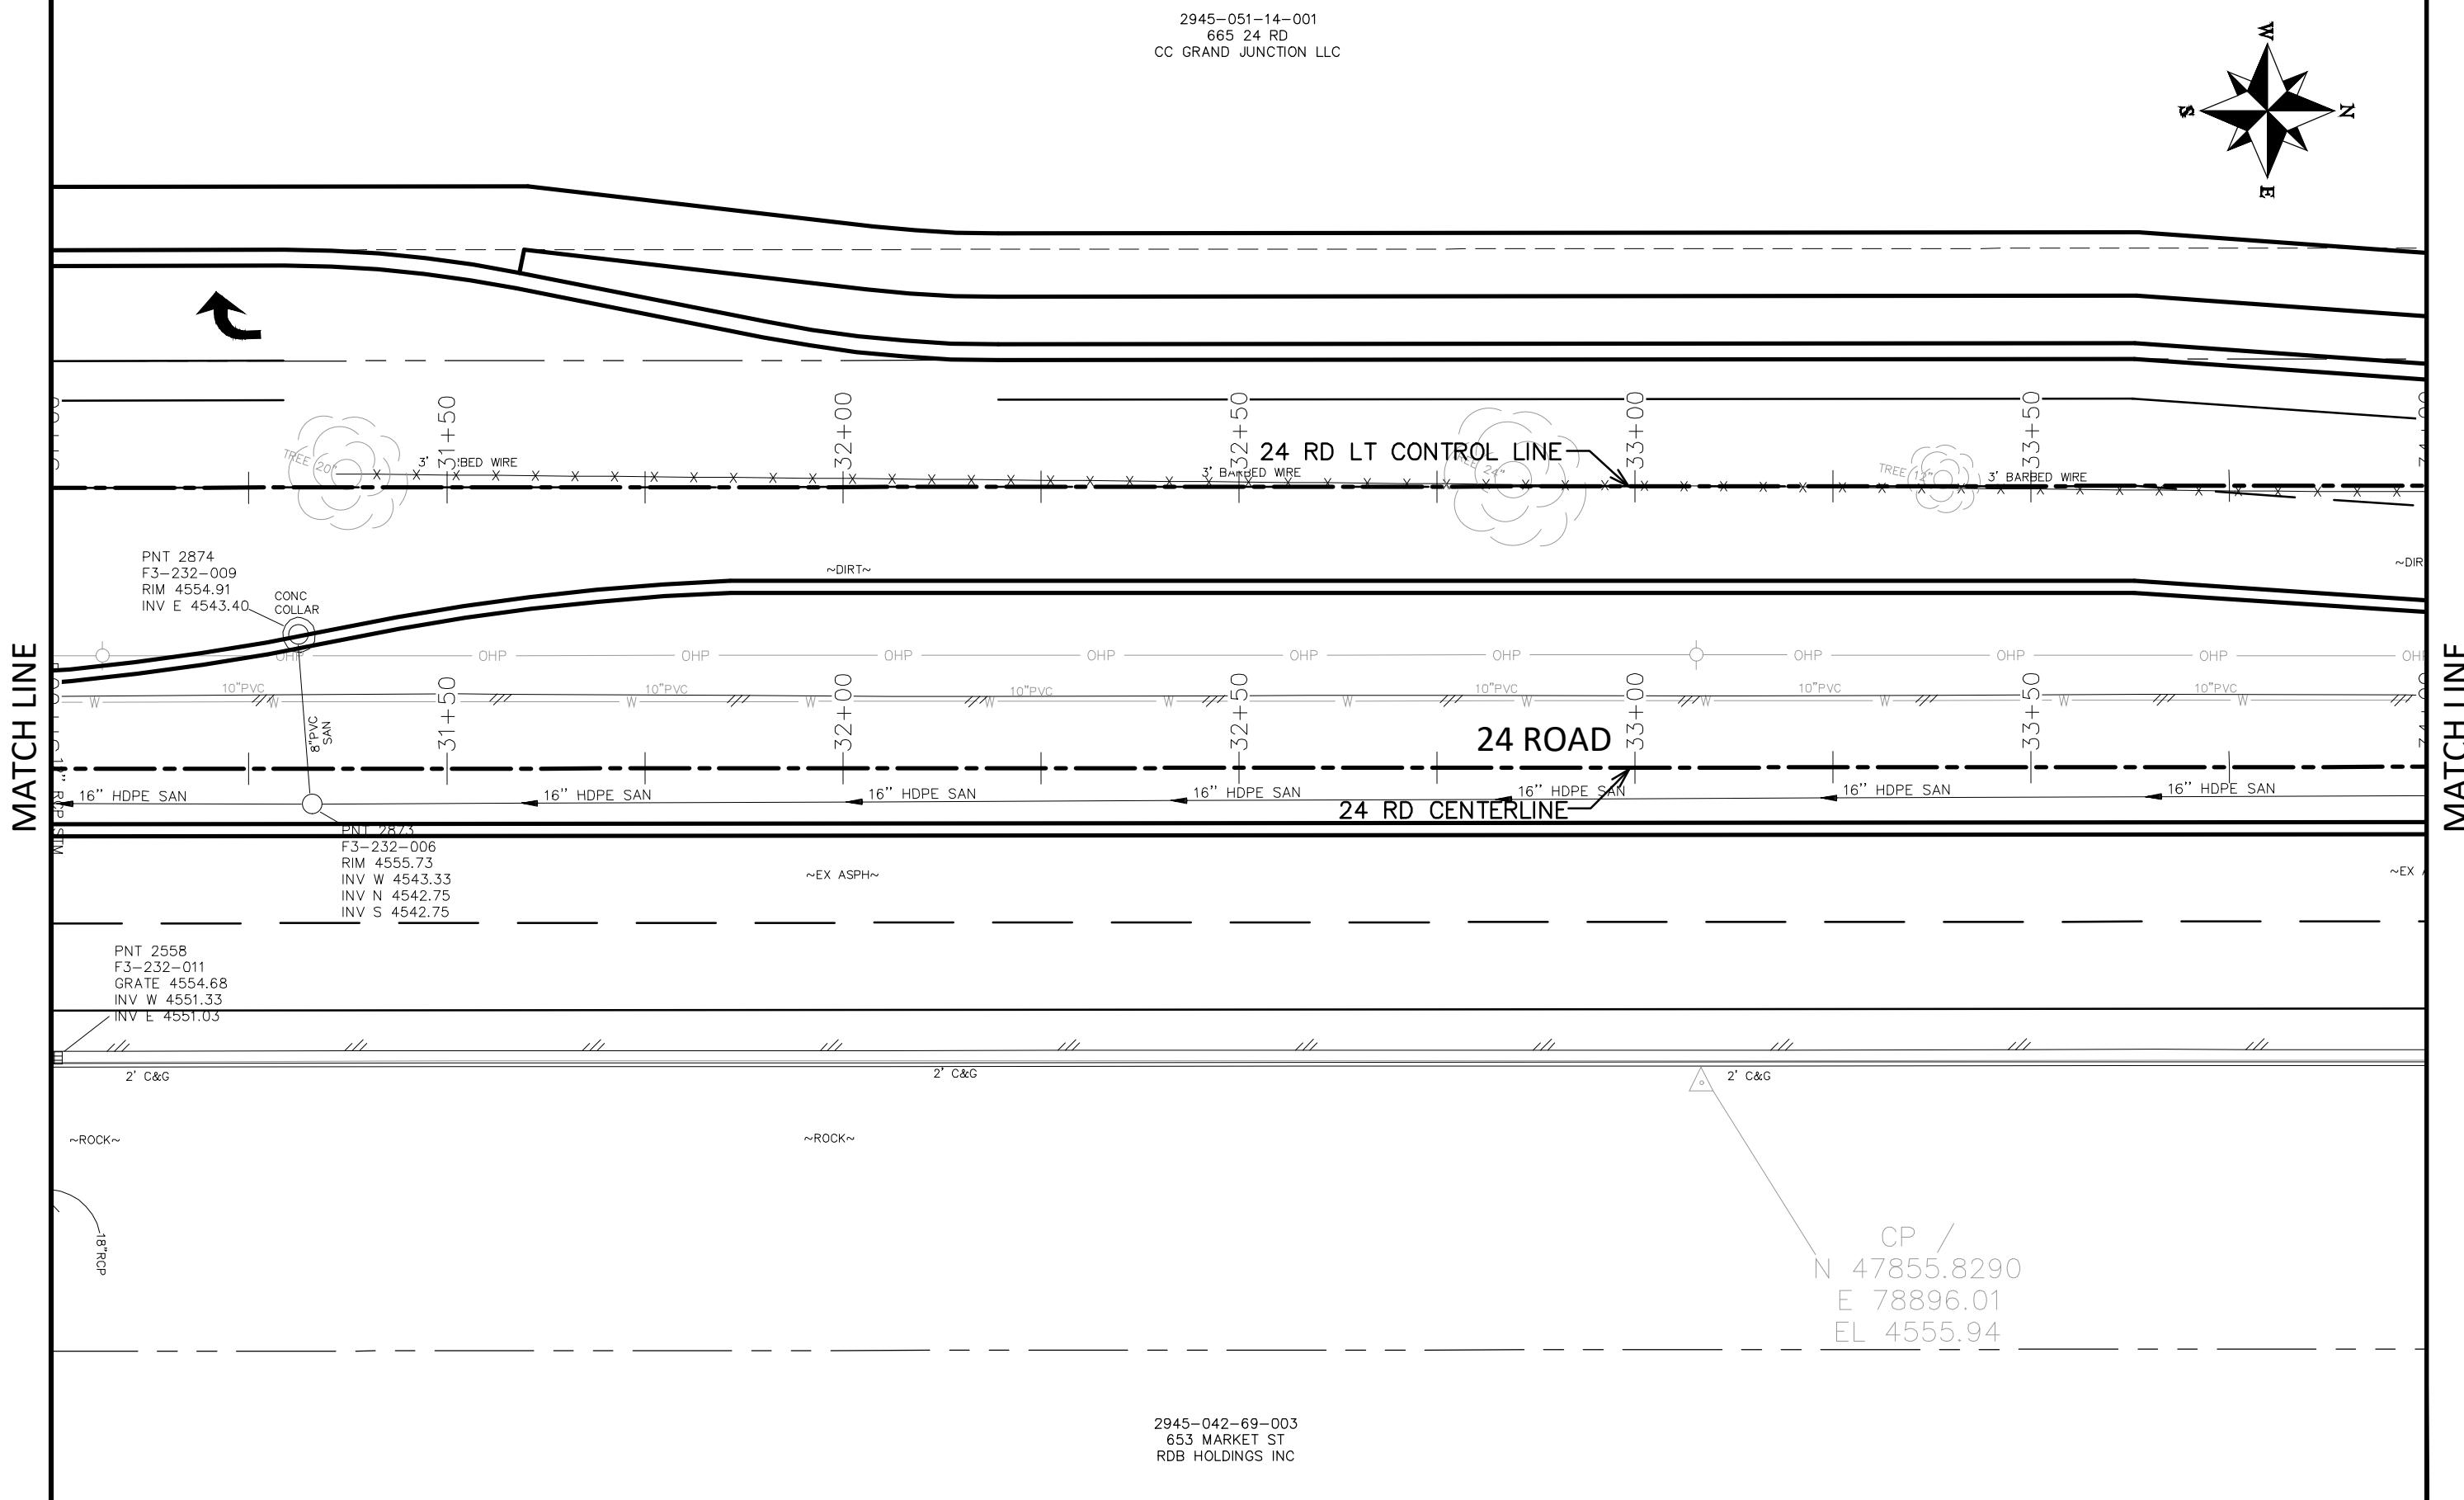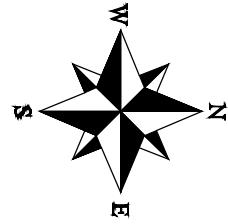

DESCRIPTION	DATE
REVISION A REV 1	- DATE
REVISION A REV 2	- DATE
REVISION A REV 3	- DATE
REVISION A REV 4	- DATE


DRAWN BY	JCS	DATE	2020
DESIGNED BY	JCS	DATE	2020
CHECKED BY	ALC	DATE	2020
APPROVED BY	TCP	DATE	2020

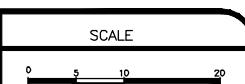

PUBLIC WORKS
ENGINEERING DIVISION
PROJECT NO. 207-F1903


24 ROAD AND G ROAD
IMPROVEMENT PLAN - 005

2945-051-14-001
665 24 RD
CC GRAND JUNCTION LLC

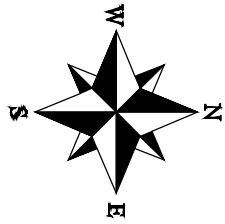

MATCH LINE

MATCH LINE

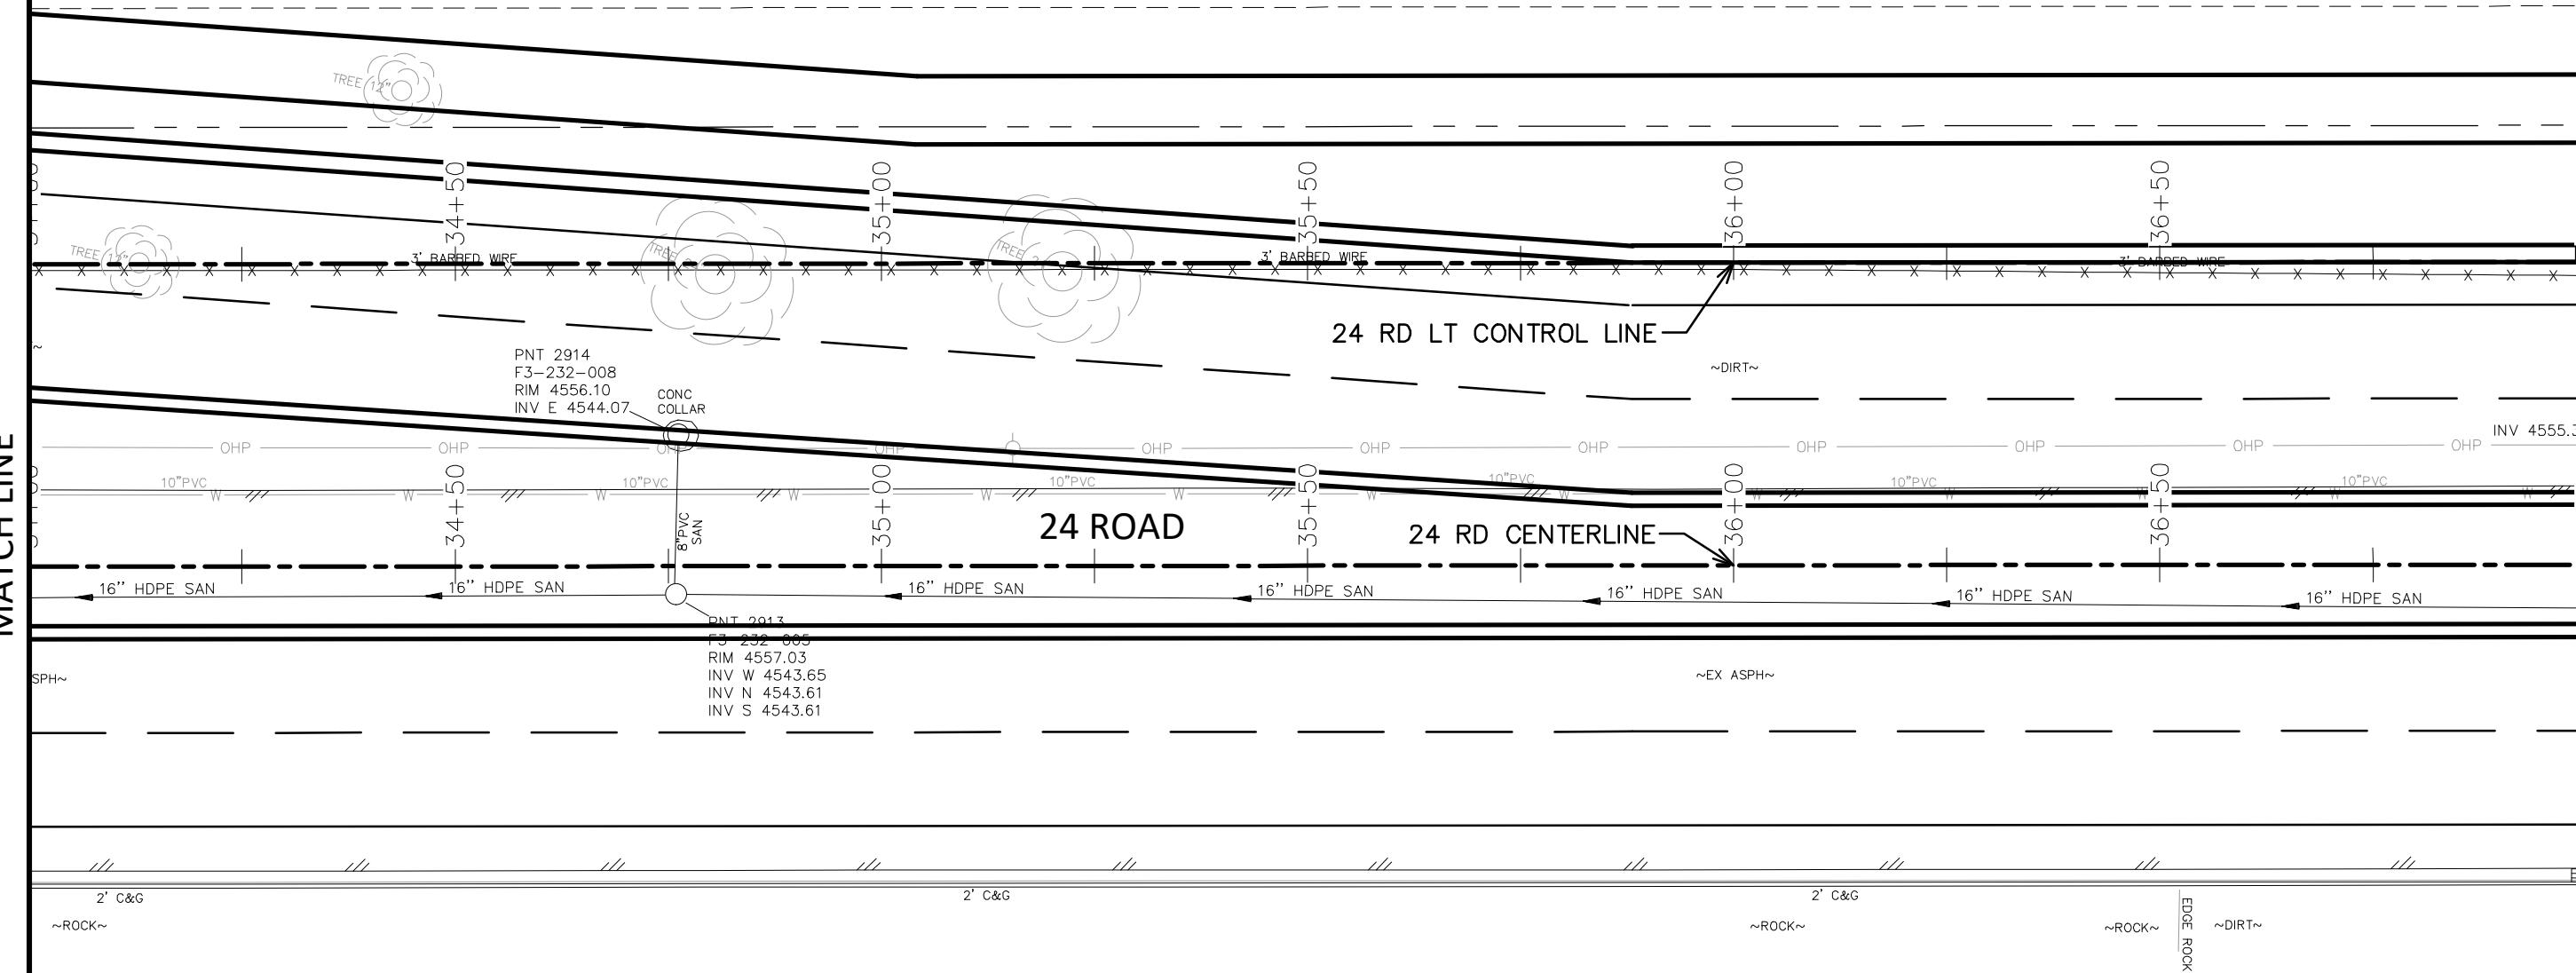

2945-042-69-003
653 MARKET ST
RDB HOLDINGS INC

2945-042-69-001
659 MARKET ST
VP GRD JCT LLC

2945-042-30-002
660 24 RD
USHER NV LLC

DESCRIPTION	DATE
REVISION ▲ REV 1	- DATE
REVISION ▲ REV 2	- DATE
REVISION ▲ REV 3	- DATE
REVISION ▲ REV 4	- DATE

DRAWN BY JCS DATE 2020
DESIGNED BY JCS DATE 2020
CHECKED BY ALC DATE 2020
APPROVED BY TCP DATE 2020



SCALE
0 5 10 20

CITY OF
Grand Junction
COLORADO

PUBLIC WORKS
ENGINEERING DIVISION
PROJECT NO. 207-F1903

24 ROAD AND G ROAD
IMPROVEMENT PLAN - 006

2945-051-14-001
665 24 RD
CC GRAND JUNCTION LLC

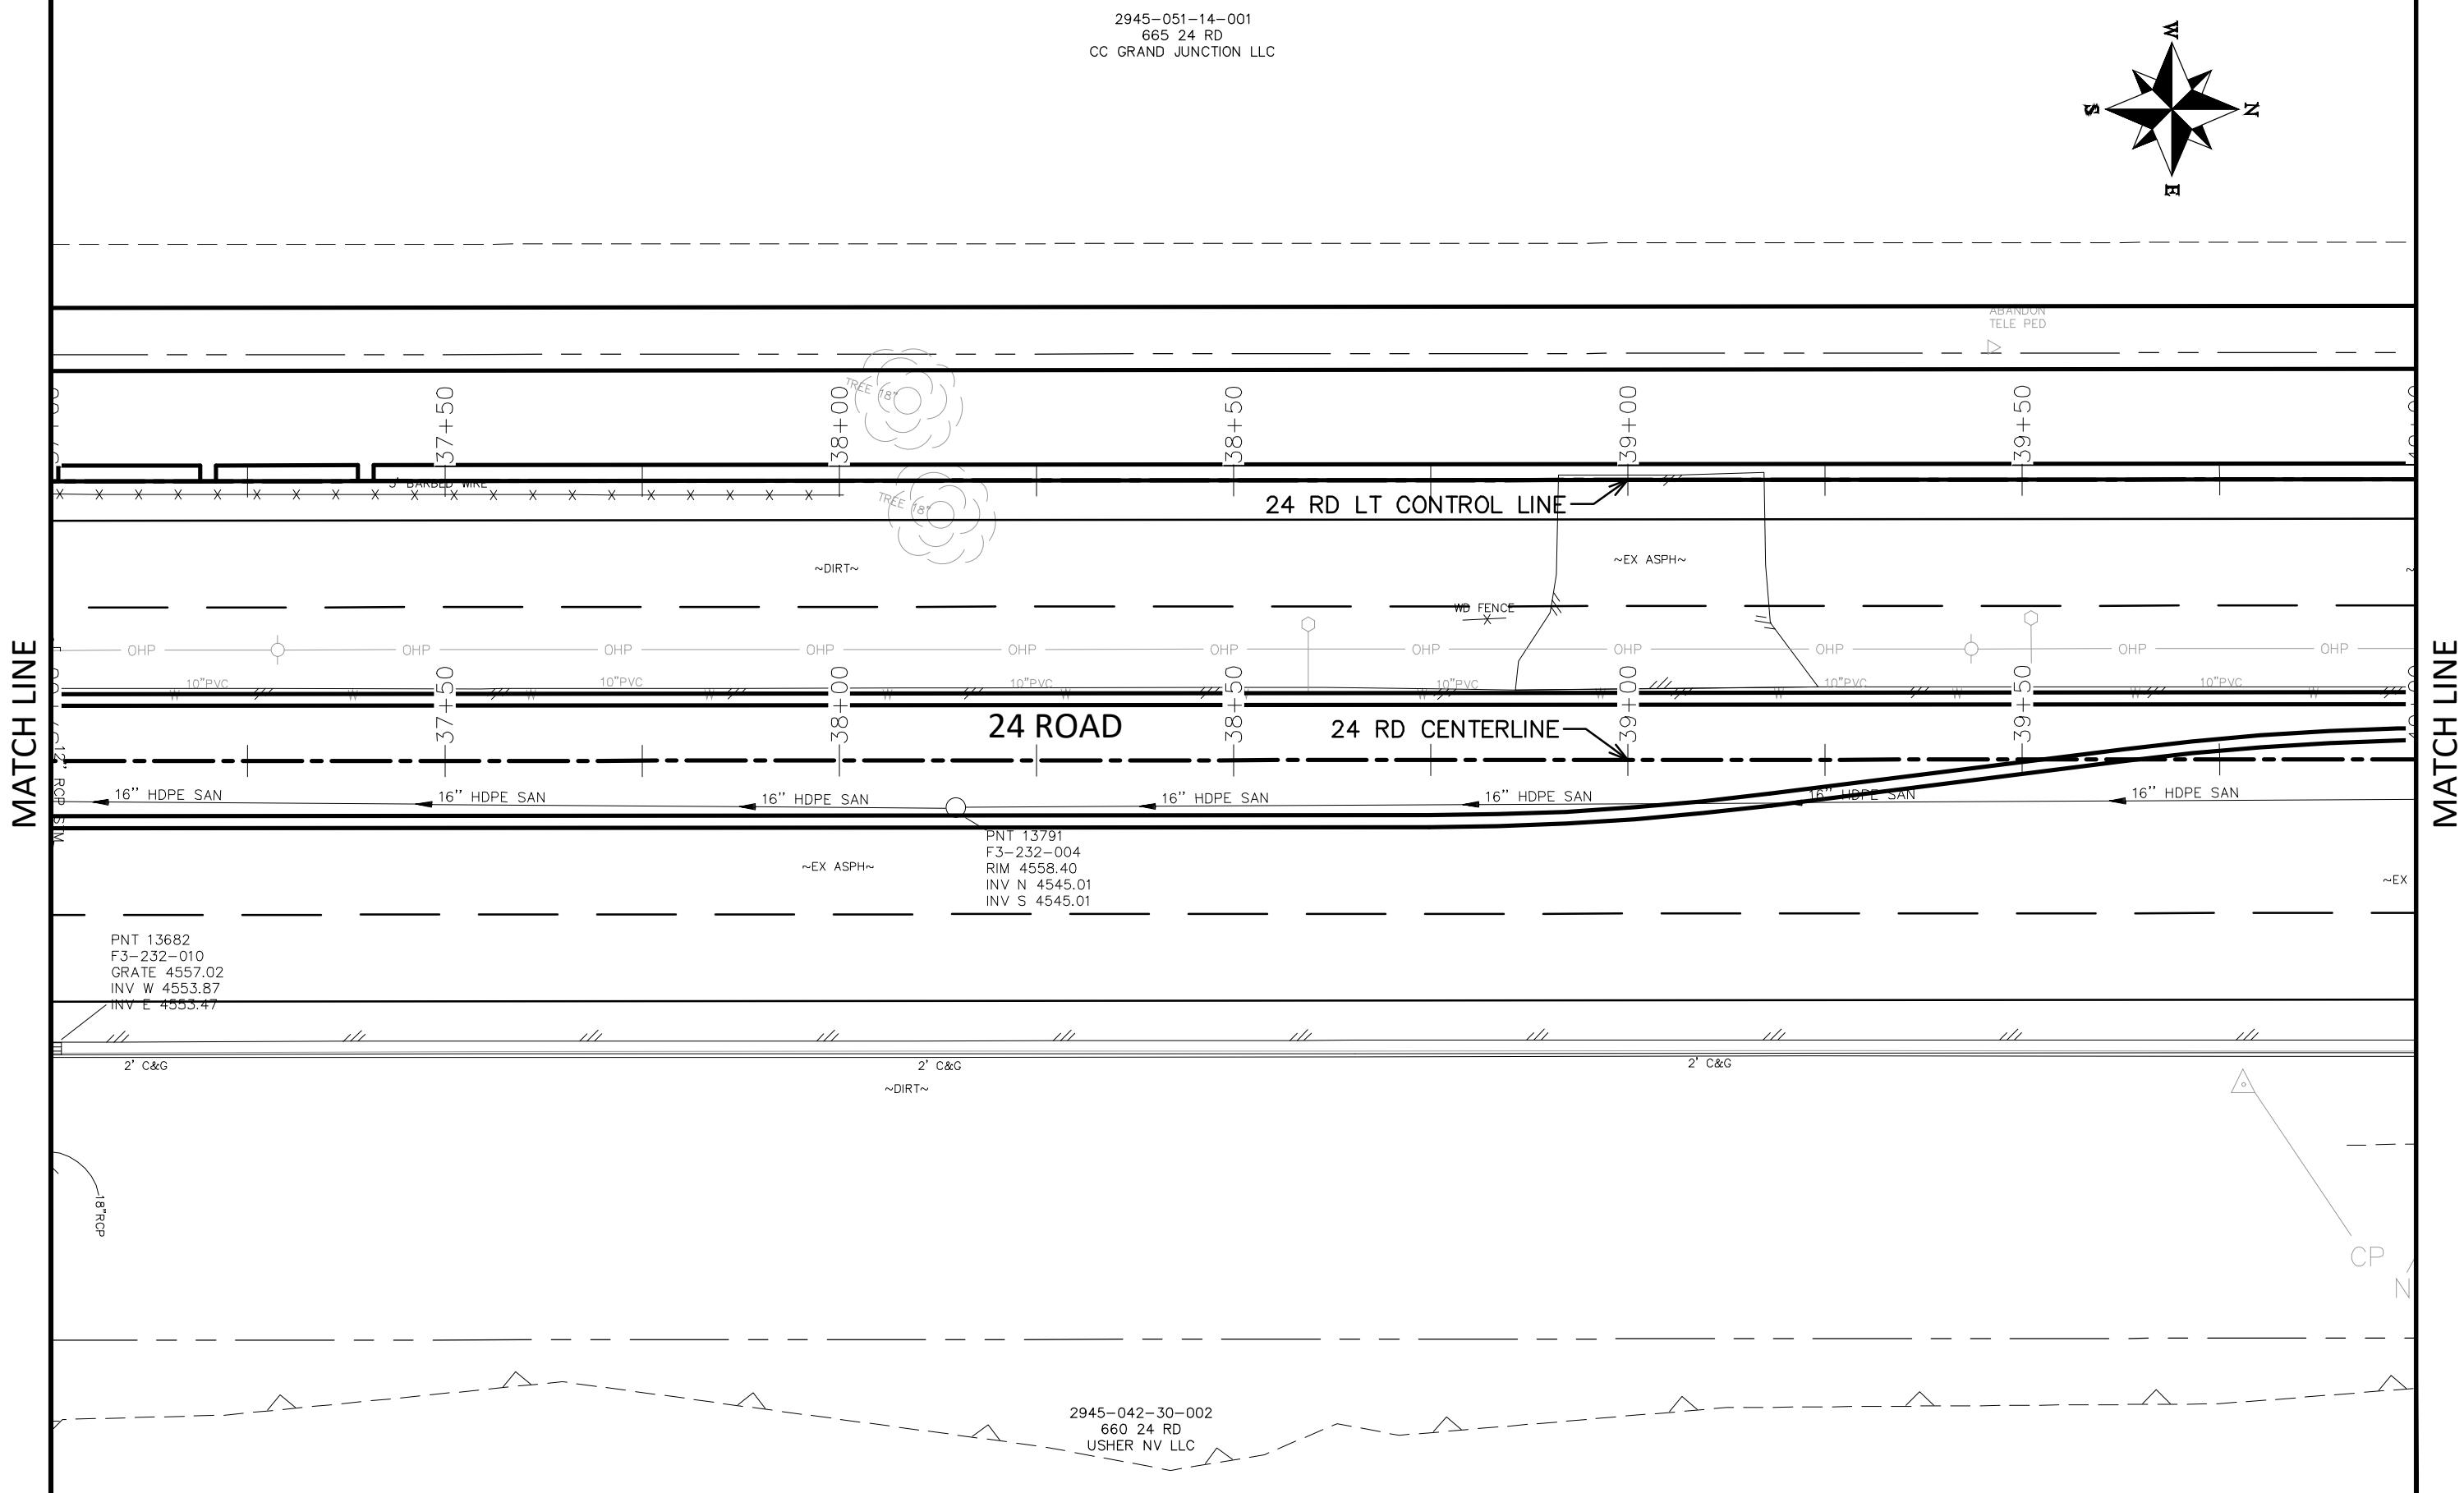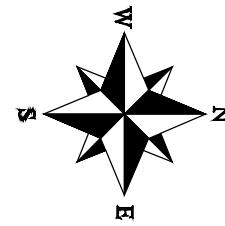

DESCRIPTION	DATE
REVISION A REV 1	- DATE
REVISION A REV 2	- DATE
REVISION A REV 3	- DATE
REVISION A REV 4	- DATE

DRAWN BY	JCS	DATE	2020
DESIGNED BY	JCS	DATE	2020
CHECKED BY	ALC	DATE	2020
APPROVED BY	TCP	DATE	2020

SCALE
0 5 10 20



CITY OF
Grand Junction
COLORADO

PUBLIC WORKS
ENGINEERING DIVISION
PROJECT NO. 207-F1903

24 ROAD AND G ROAD
IMPROVEMENT PLAN - 007

2945-051-14-001
665 24 RD
CC GRAND JUNCTION LLC

2945-051-00-095
NORTHWEST CORNER OF F 3/4 AND 24 RD
MONUMENT INVESTMENT CO. LLC

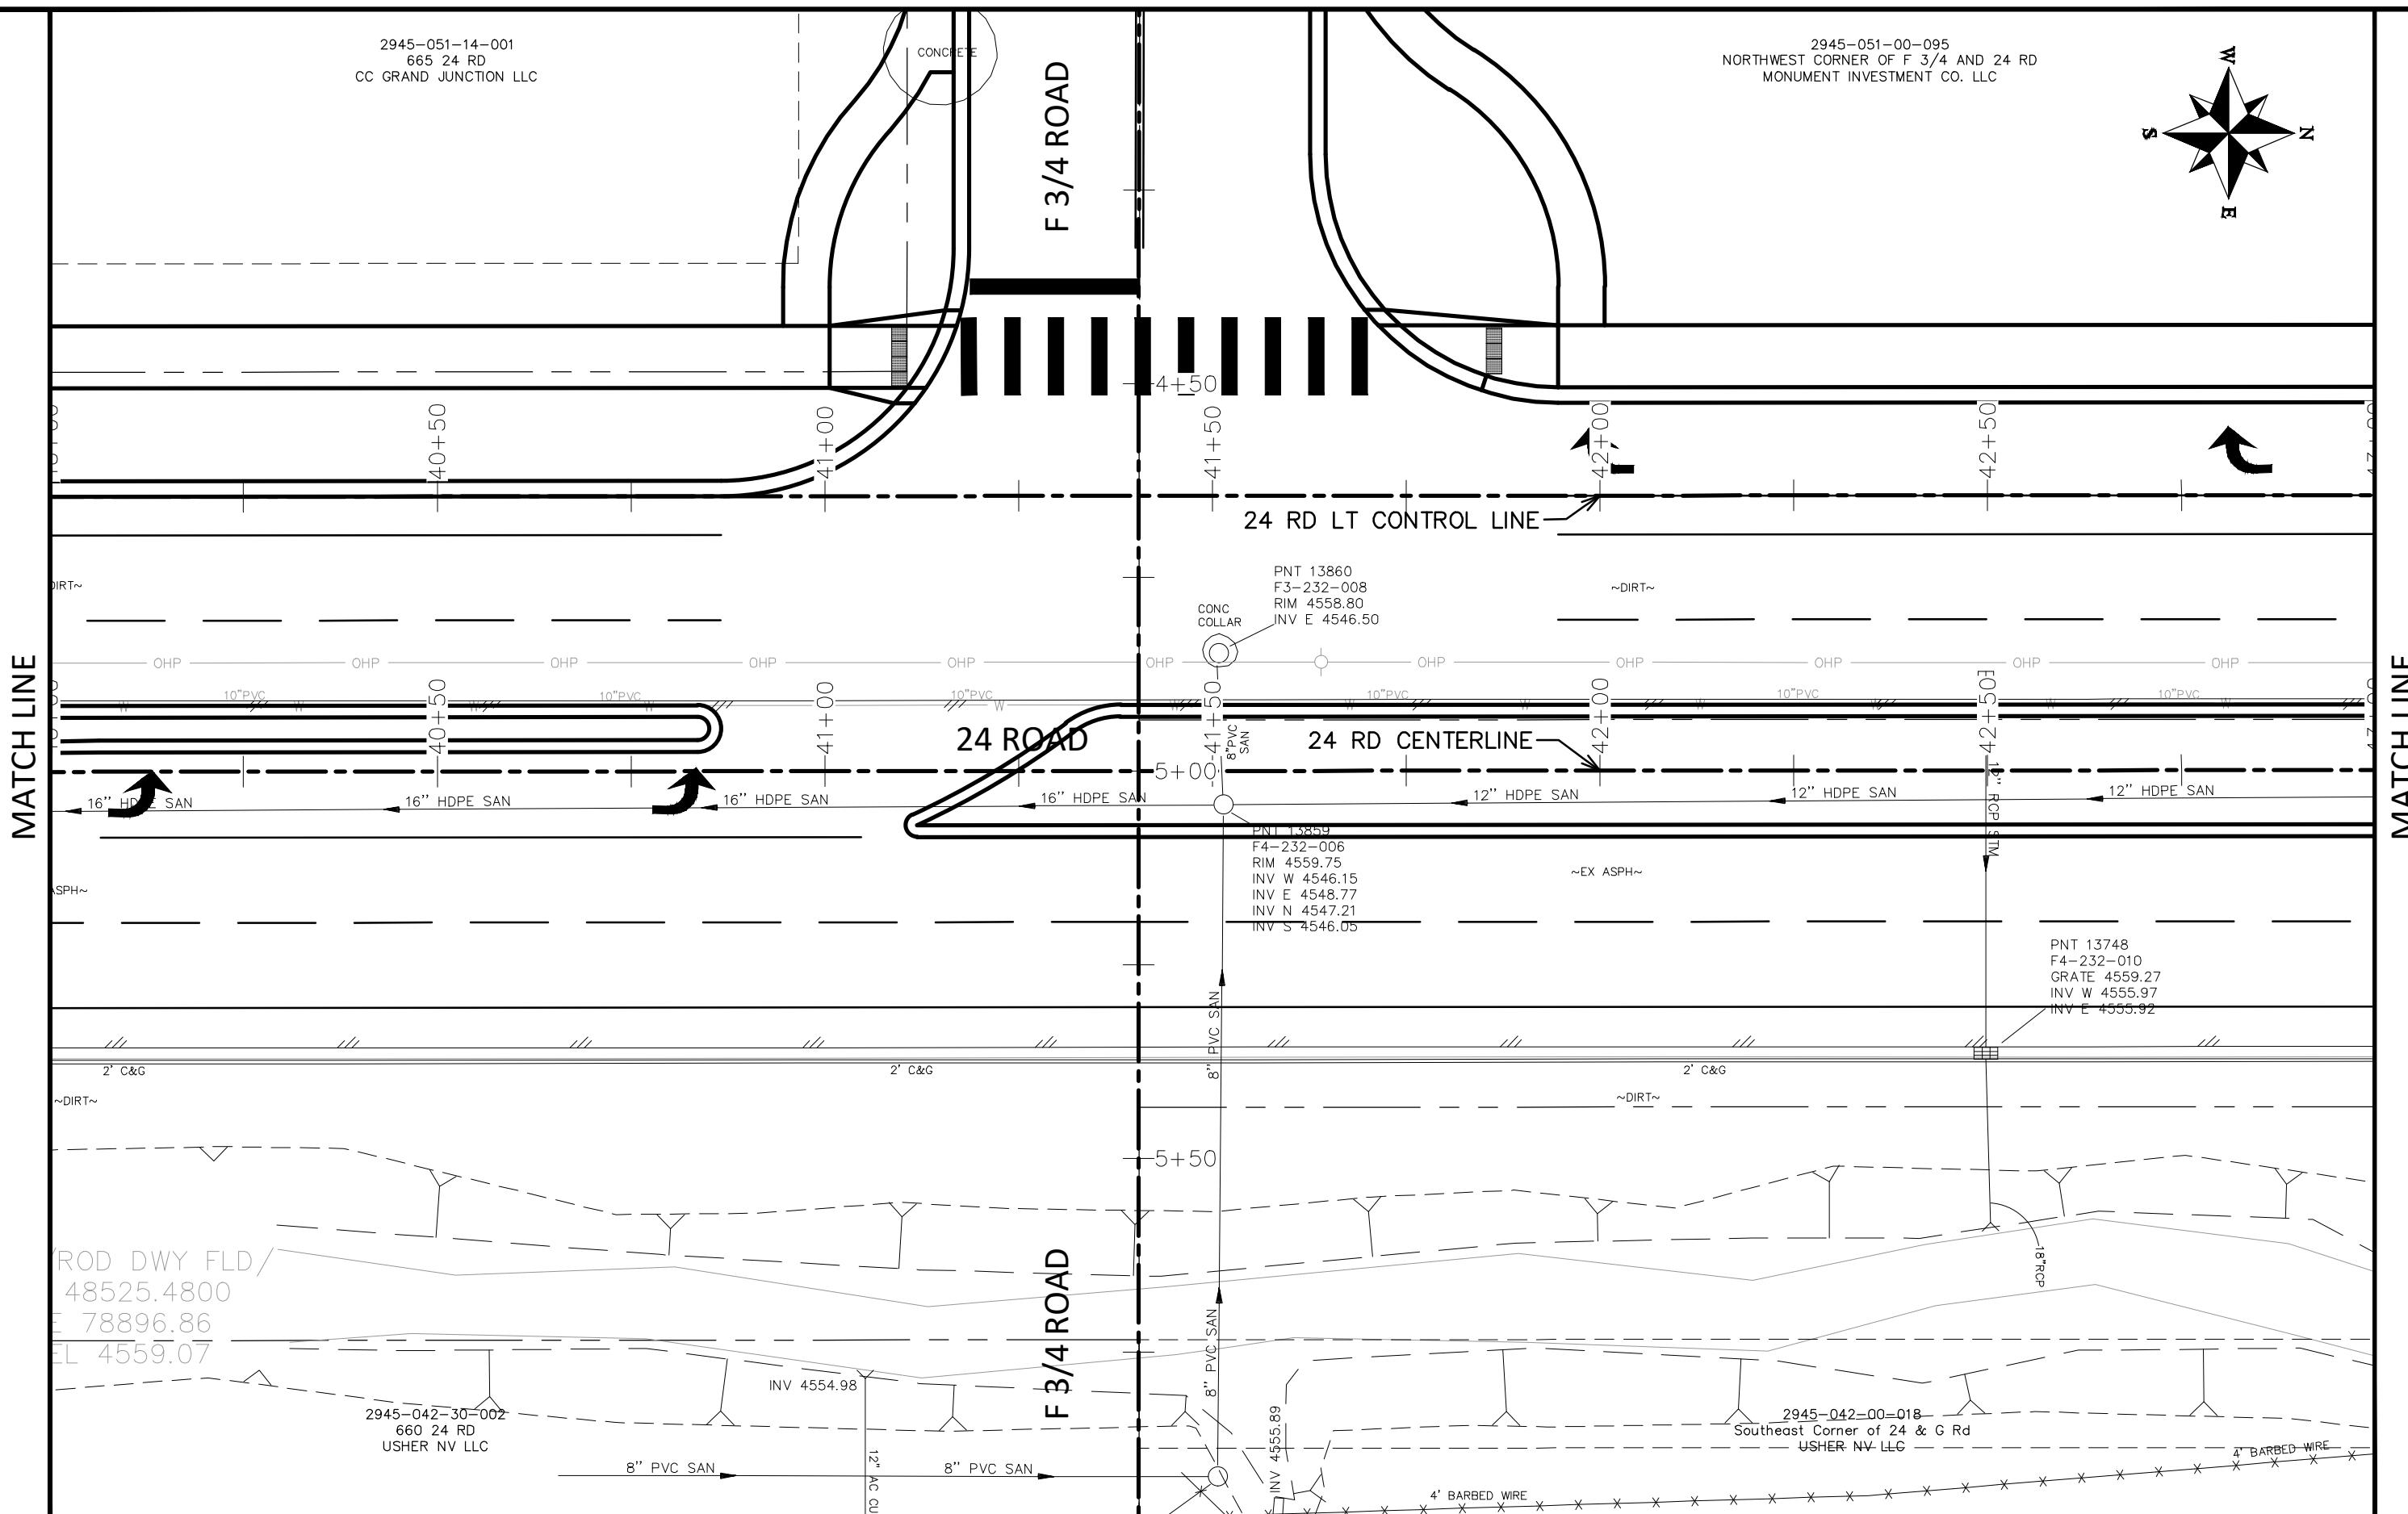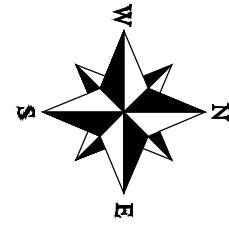

DESCRIPTION	DATE
REVISION A REV 1	DATE
REVISION A REV 2	DATE
REVISION A REV 3	DATE
REVISION A REV 4	DATE

DRAWN BY	JCS	DATE	2020
DESIGNED BY	JCS	DATE	2020
CHECKED BY	ALC	DATE	2020
APPROVED BY	TCP	DATE	2020

SCALE
0 5 10 20


CITY OF
Grand Junction
COLORADO

PUBLIC WORKS
ENGINEERING DIVISION
PROJECT NO. 207-F1903

24 ROAD AND G ROAD
IMPROVEMENT PLAN - 008


2945-051-00-095
NORTHWEST CORNER OF F 3/4 AND 24 RD
MONUMENT INVESTMENT CO. LLC

2945-051-00-096
683 G RD
2J DEVELOPMENT LLC

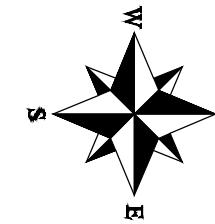

MATCH LINE

MATCH LINE

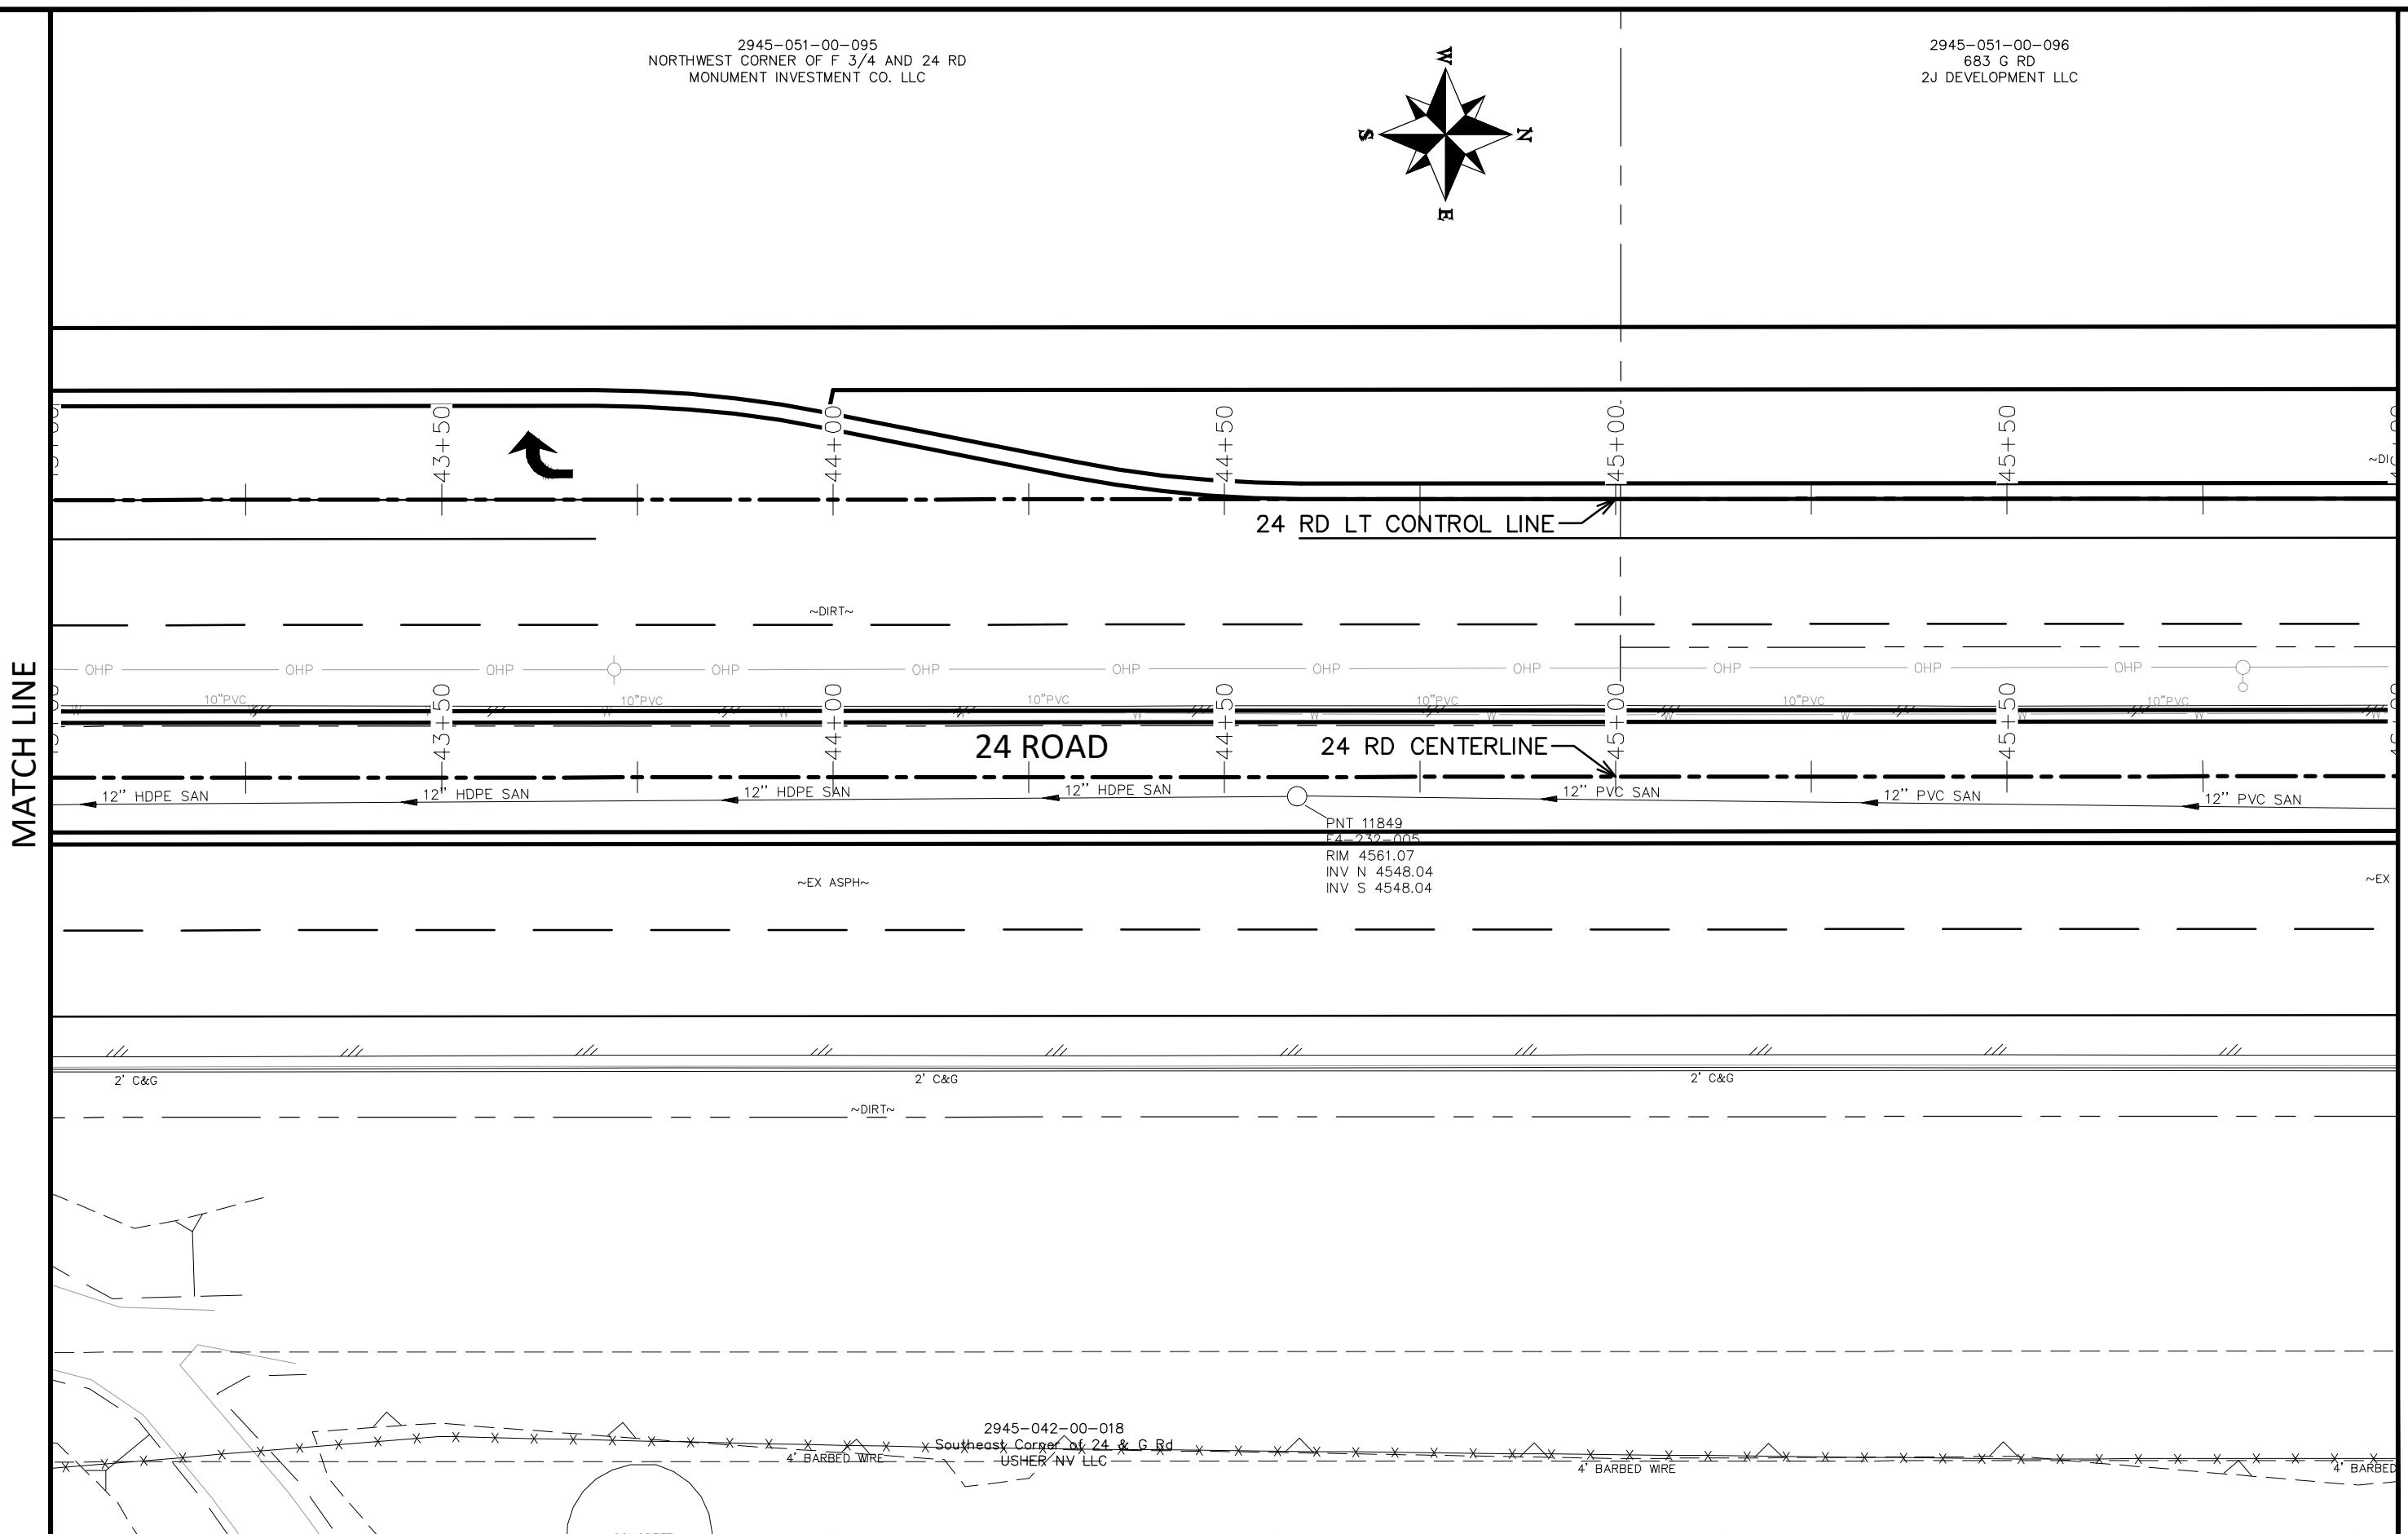

DESCRIPTION	DATE
REVISION A REV 1	DATE
REVISION A REV 2	DATE
REVISION A REV 3	DATE
REVISION A REV 4	DATE

DRAWN BY	JCS	DATE	2020
DESIGNED BY	JCS	DATE	2020
CHECKED BY	ALC	DATE	2020
APPROVED BY	TCP	DATE	2020

SCALE
0 5 10 20

CITY OF
Grand Junction
COLORADO

PUBLIC WORKS
ENGINEERING DIVISION
PROJECT NO. 207-F1903


24 ROAD AND G ROAD
IMPROVEMENT PLAN - 009

2945-051-00-096
683 G RD
2J DEVELOPMENT LLC


2945-051-18-002
2385 G RD
WDM CORPORATION

MATCH LINE

MATHS IN USE

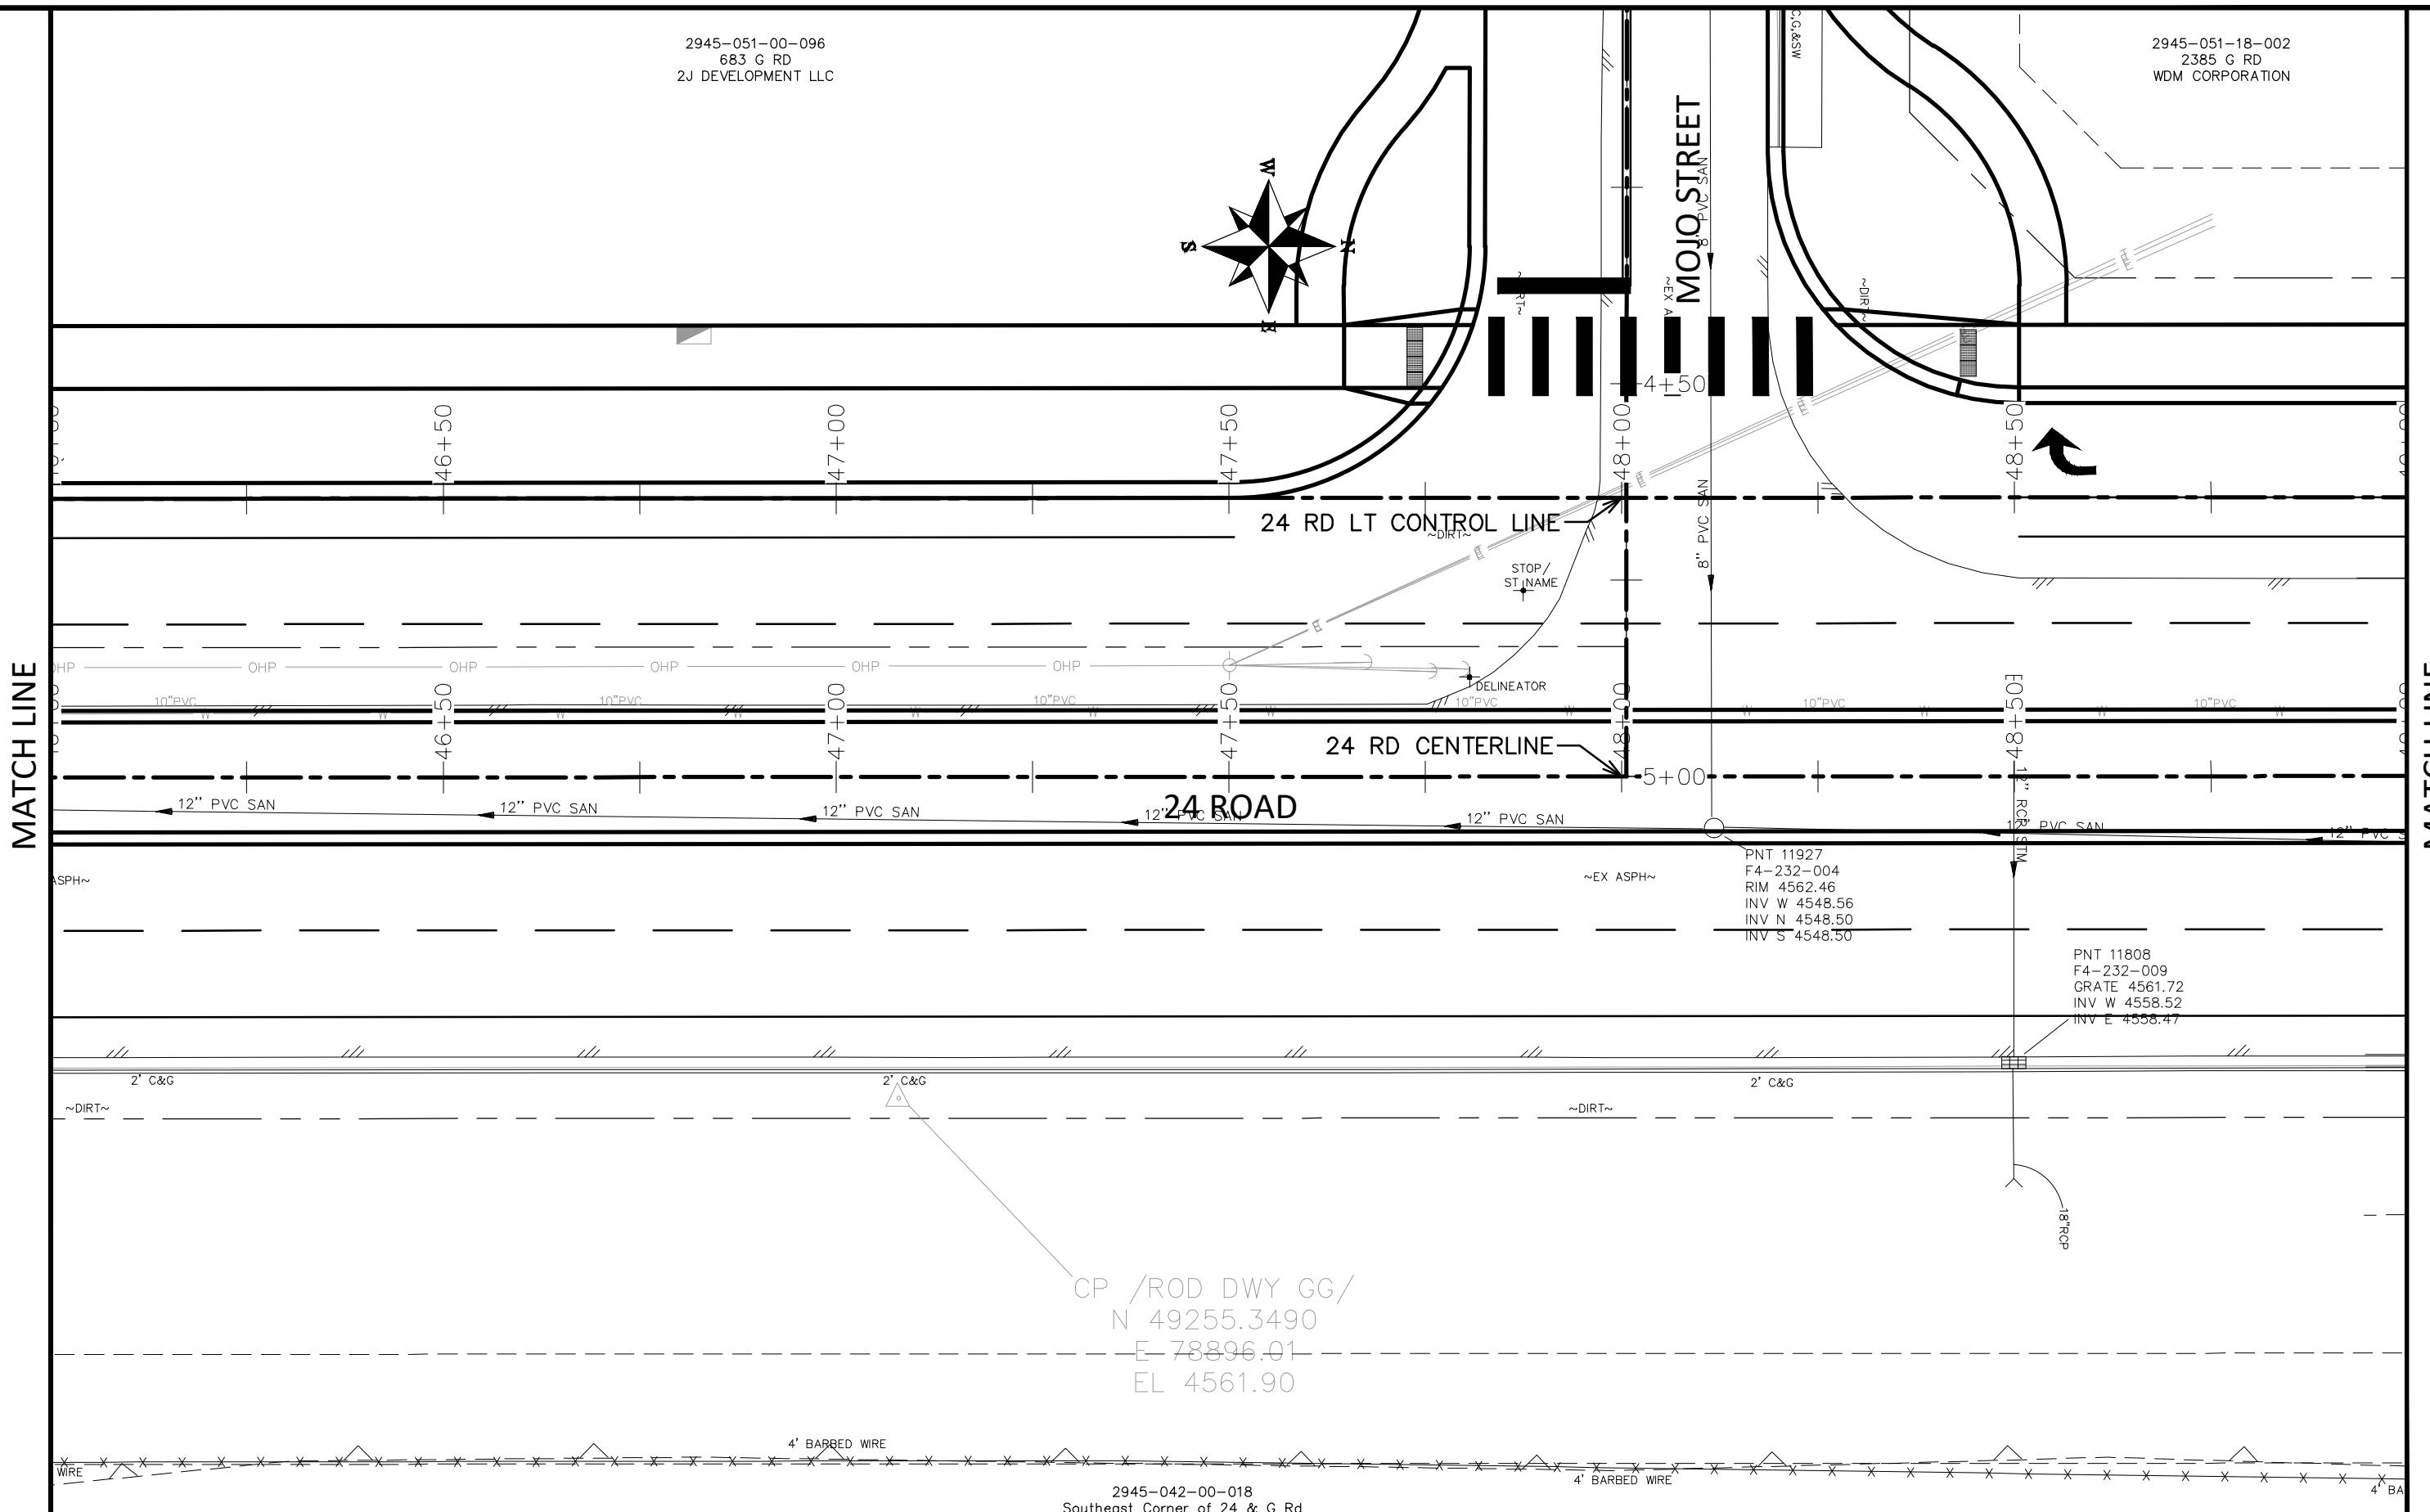


<u>DESCRIPTION</u>	<u>DATE</u>	DRAWN BY	JCS	DATE	2020
REVISION A REV 1	- DATE	DESIGNED BY	JCS	DATE	2020
REVISION A REV 2	- DATE	CHECKED BY	ALC	DATE	2020
REVISION A REV 3	- DATE	APPROVED BY	TCP	DATE	2020
REVISION A REV 4	- DATE				

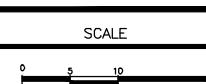

2945-051-18-001
2395 G RD
GOLDEN GATE PETROLEUM
OF NEVADA LLC

MATCH LINE

MATCH LINE
12/2020 7:17:00 AM

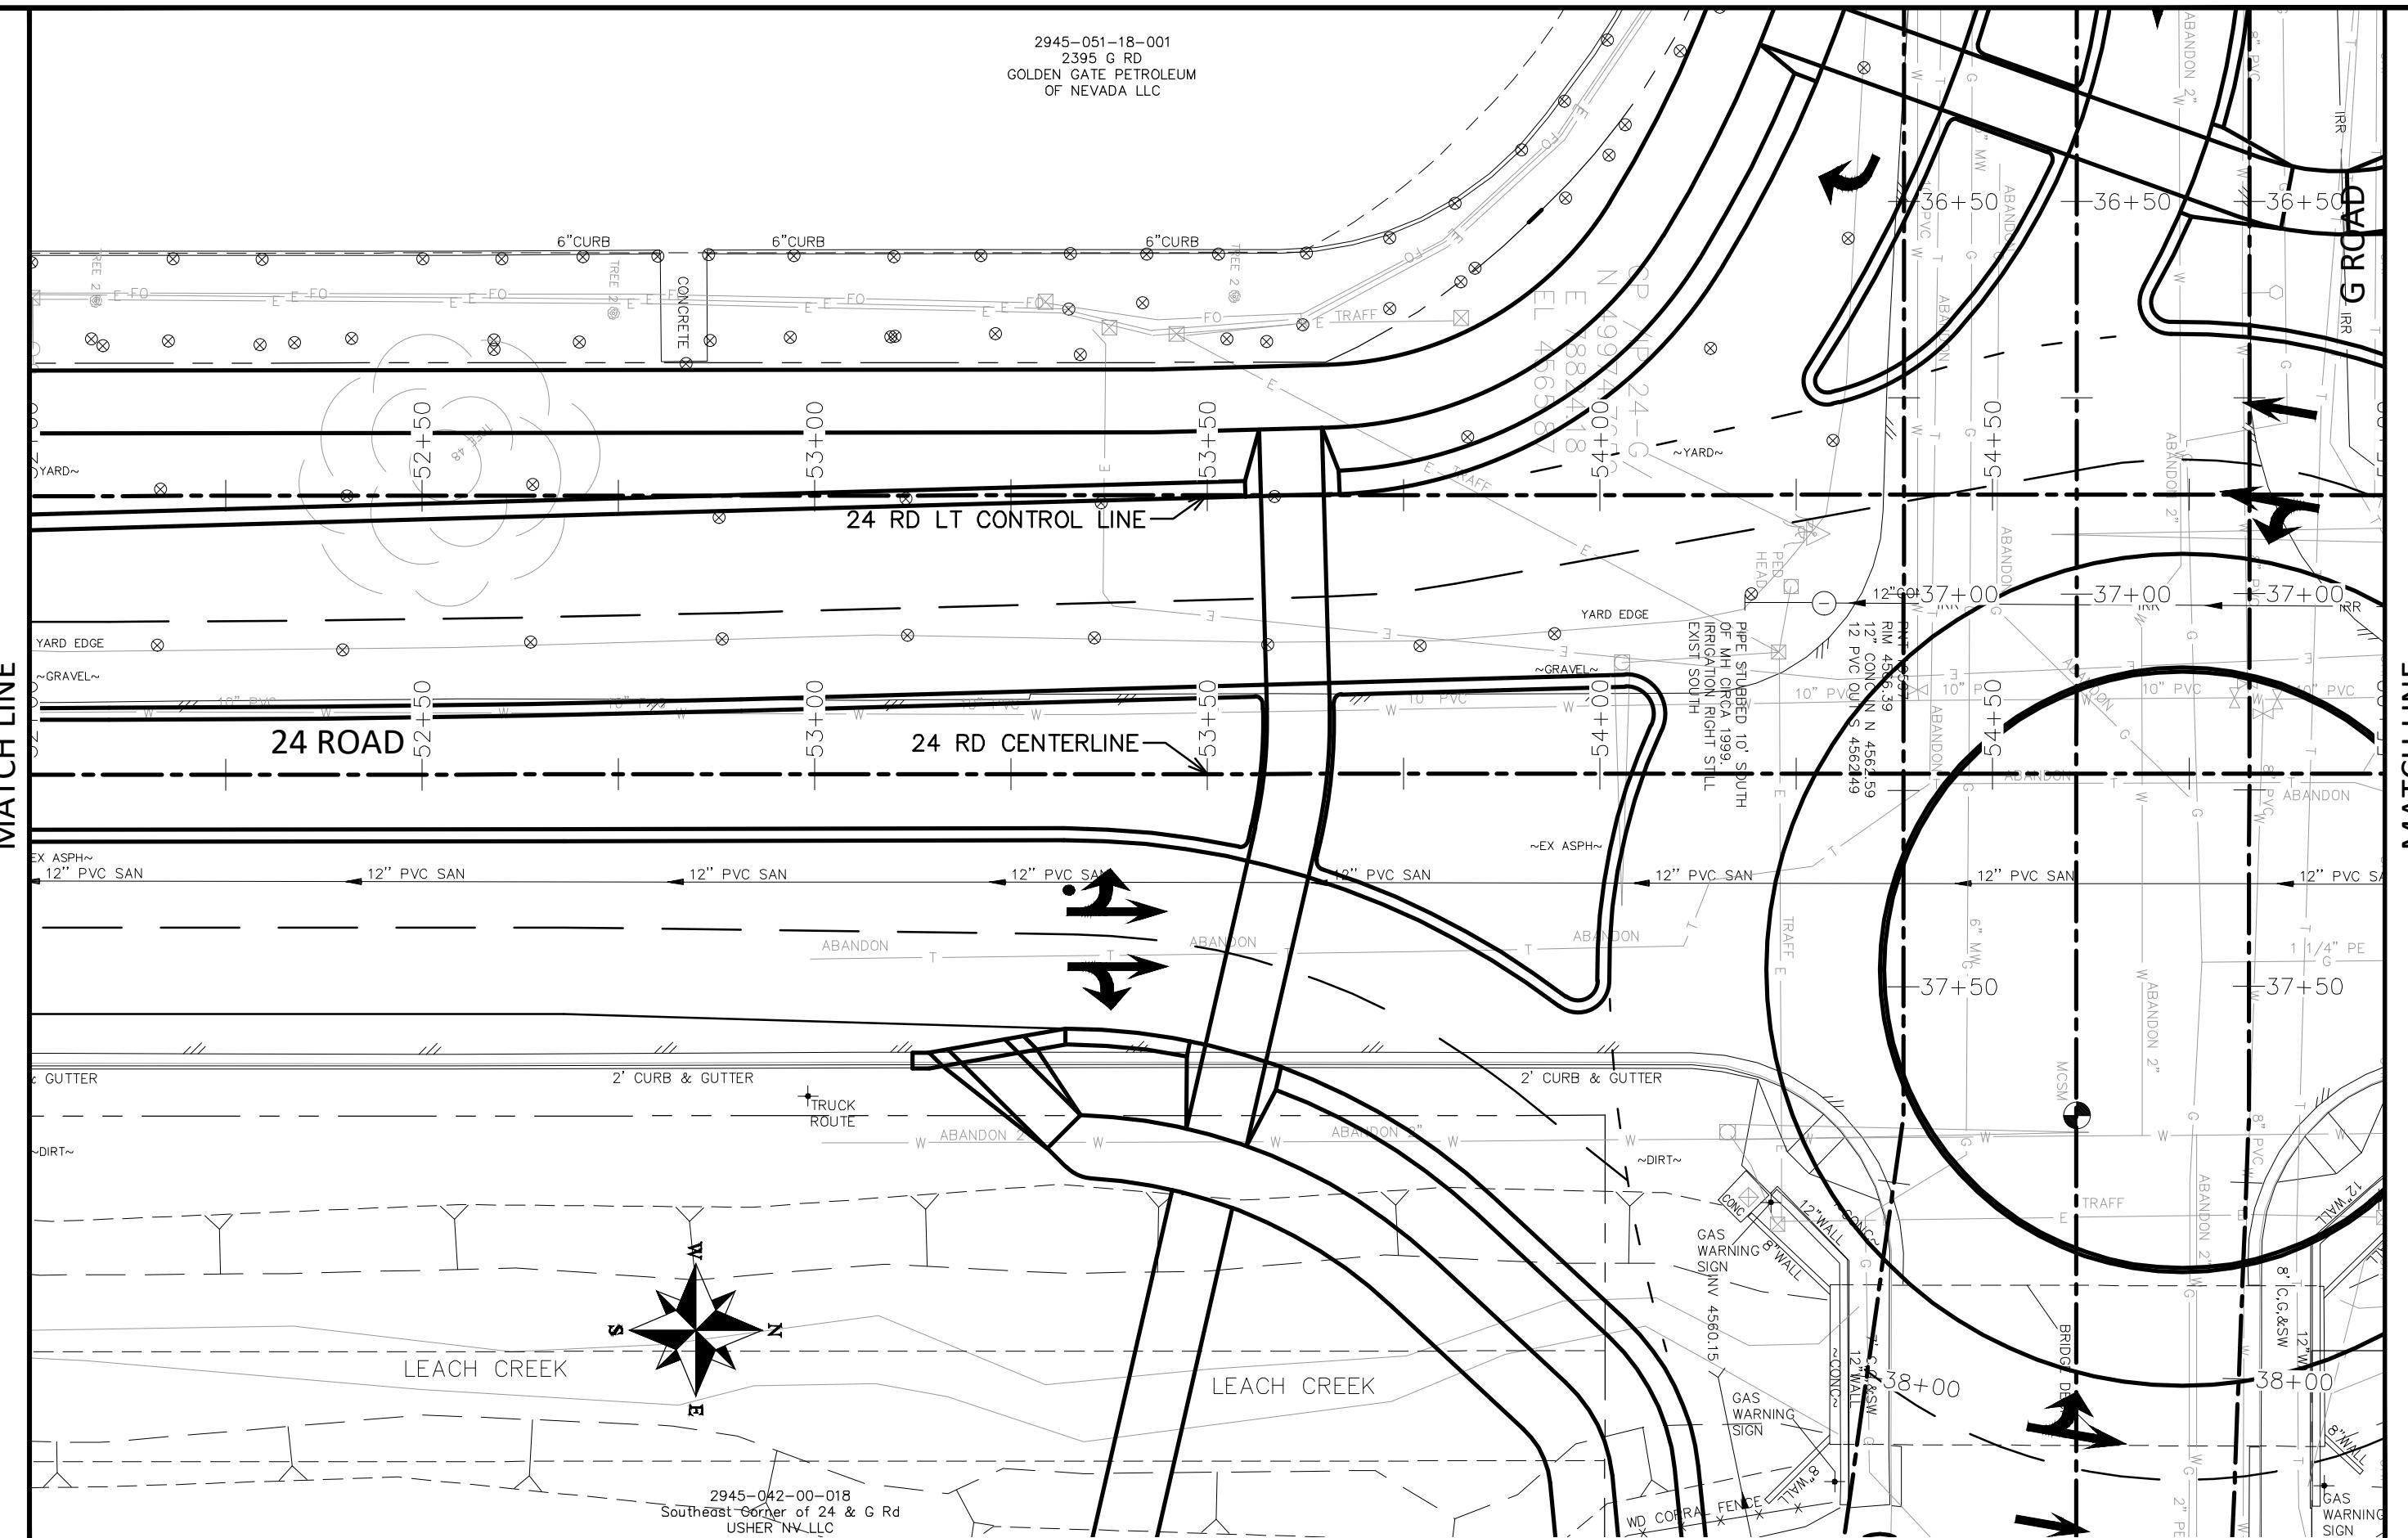


<u>DESCRIPTION</u>	<u>DATE</u>	DRAWN BY	JCS	DATE	2020
REVISION A REV 1	- DATE	DESIGNED BY	JCS	DATE	2020
REVISION A REV 2	- DATE	CHECKED BY	ALC	DATE	2020
REVISION A REV 3	- DATE	APPROVED BY	TCP	DATE	2020
REVISION A REV 4	- DATE				




PUBLIC WORKS
ENGINEERING DIVISION
PROJECT NO. 207-F1903



24 ROAD AND G ROAD
IMPROVEMENT PLAN - 012

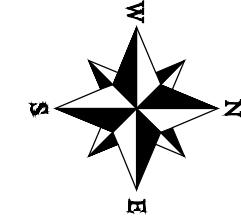

MATCH LINE

MATCH LINE

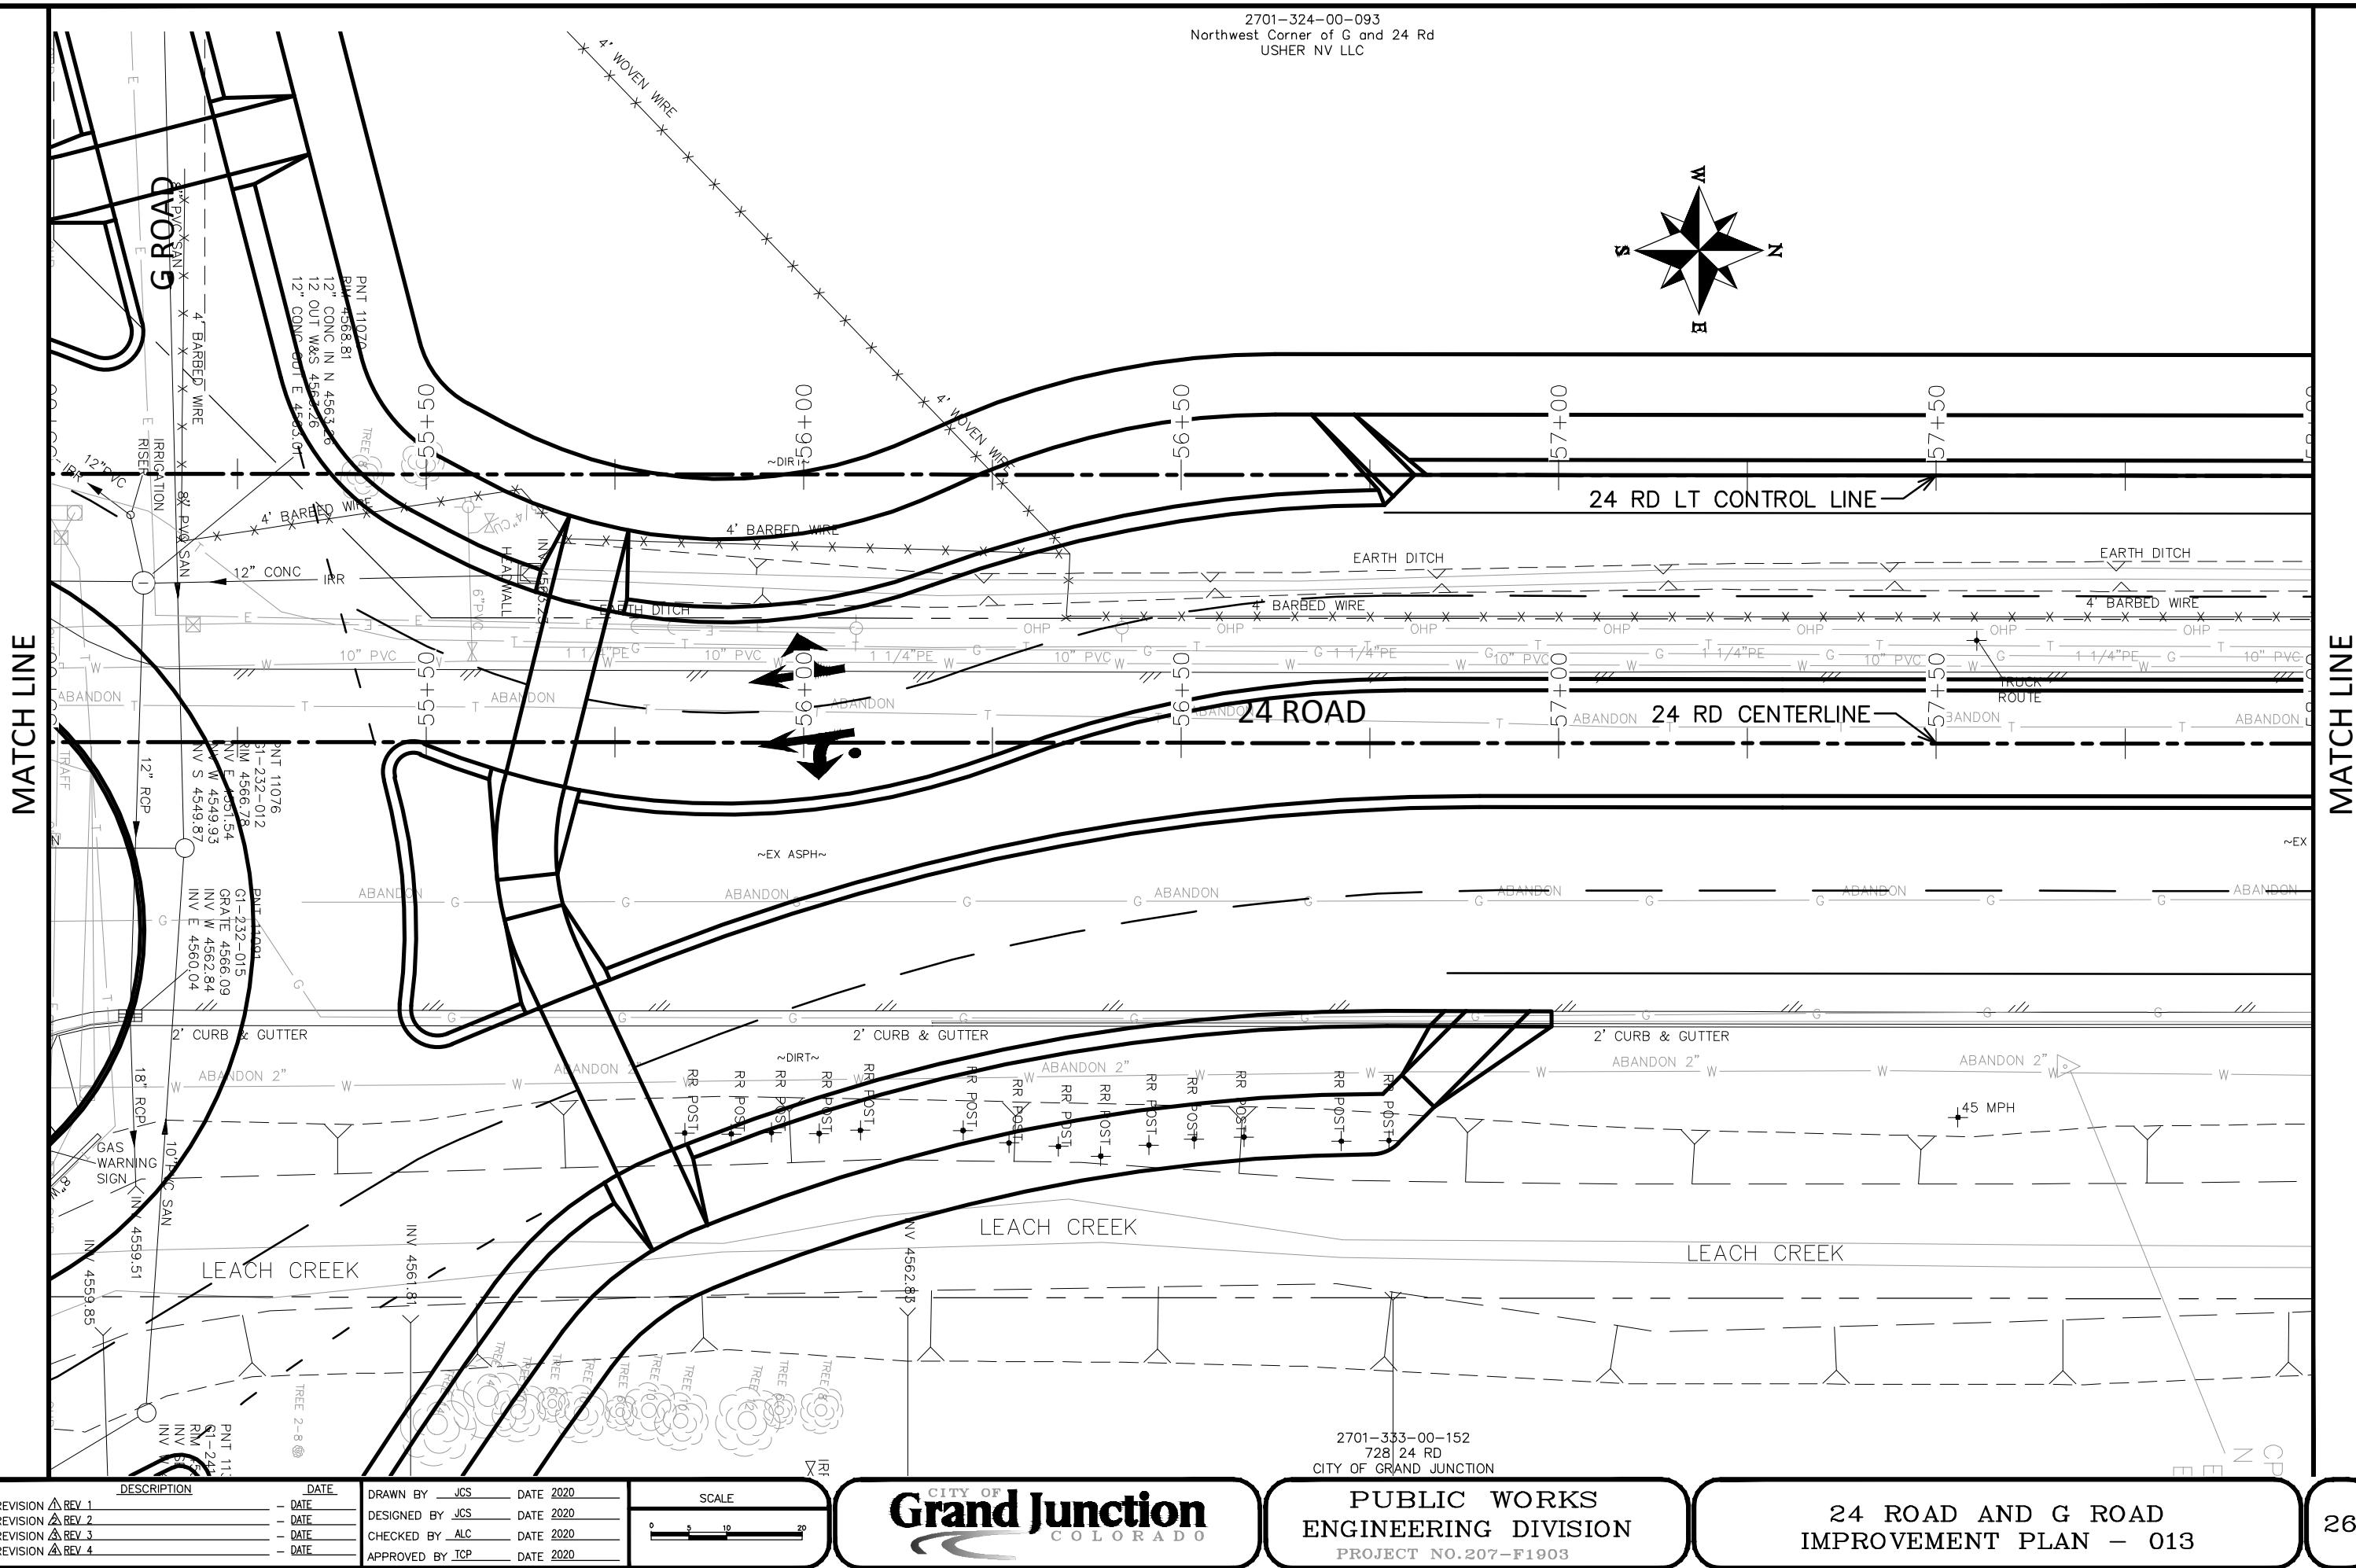

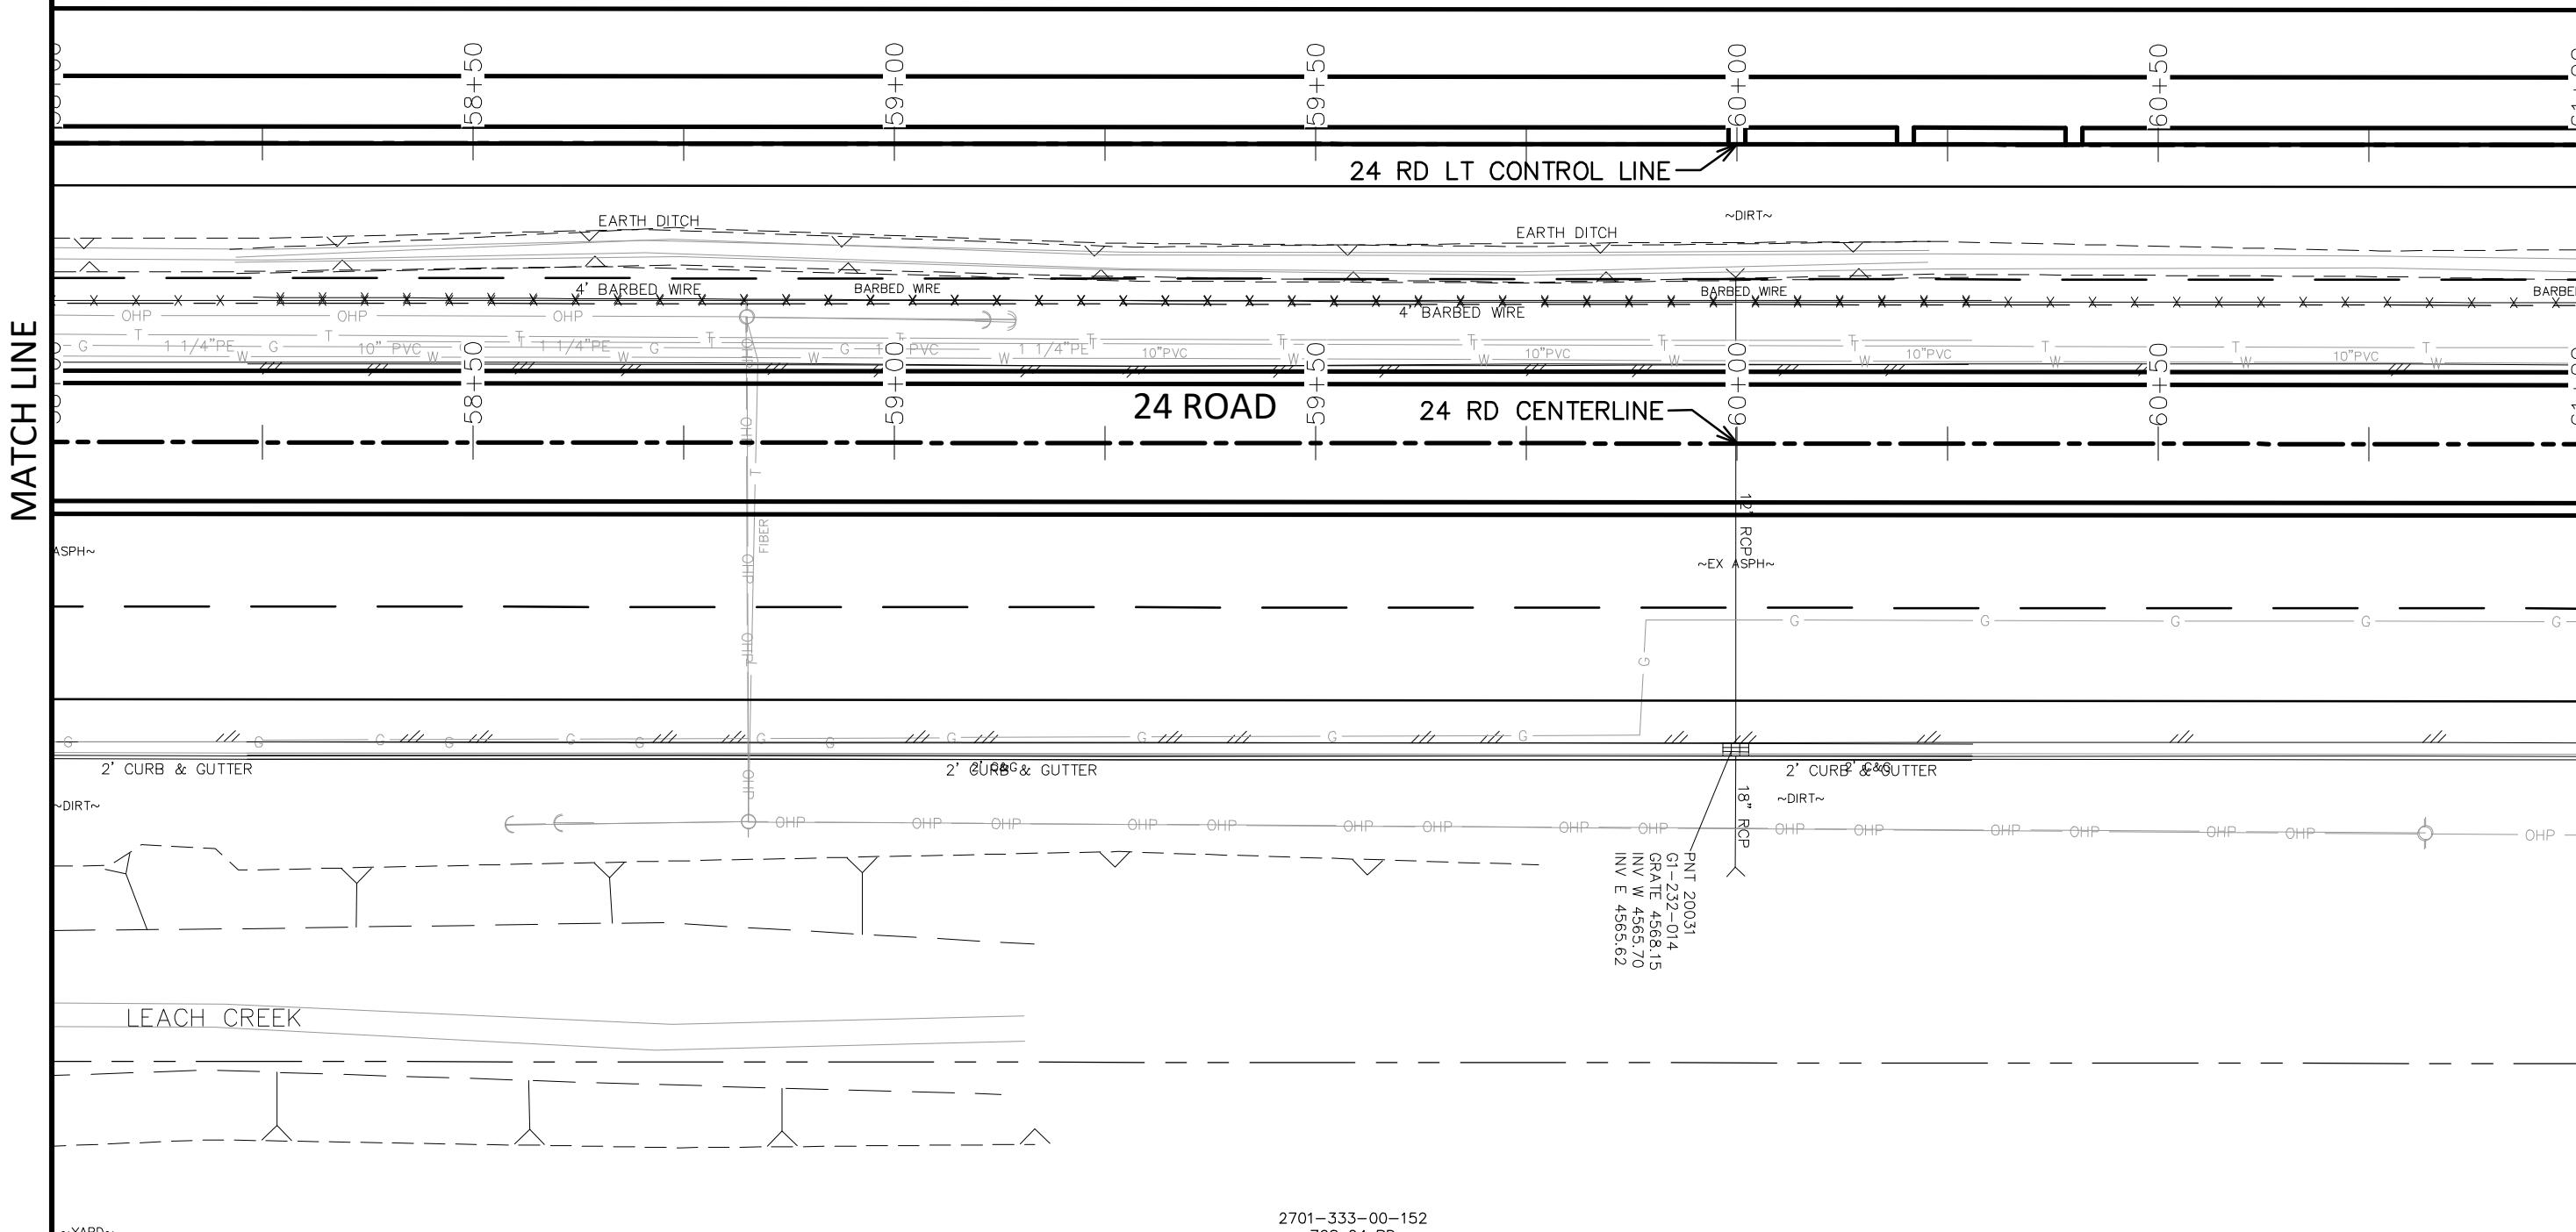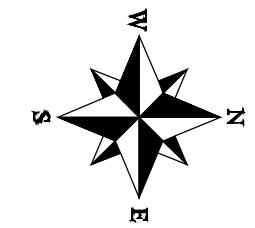

2701-333-00-152
728 24 RD
CITY OF GRAND JUNCTION

DESCRIPTION	DATE
REVISION ▲ REV 1	- DATE
REVISION ▲ REV 2	- DATE
REVISION ▲ REV 3	- DATE
REVISION ▲ REV 4	- DATE


DRAWN BY JCS DATE 2020
DESIGNED BY JCS DATE 2020
CHECKED BY ALC DATE 2020
APPROVED BY TCP DATE 2020

SCALE
0 5 10 20

CITY OF
Grand Junction
COLORADO


PUBLIC WORKS
ENGINEERING DIVISION
PROJECT NO. 207-F1903

24 ROAD AND G ROAD
IMPROVEMENT PLAN - 014

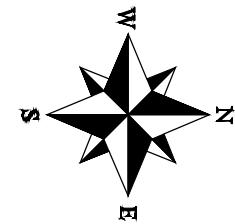

MATCH LINE

MATCH LINE

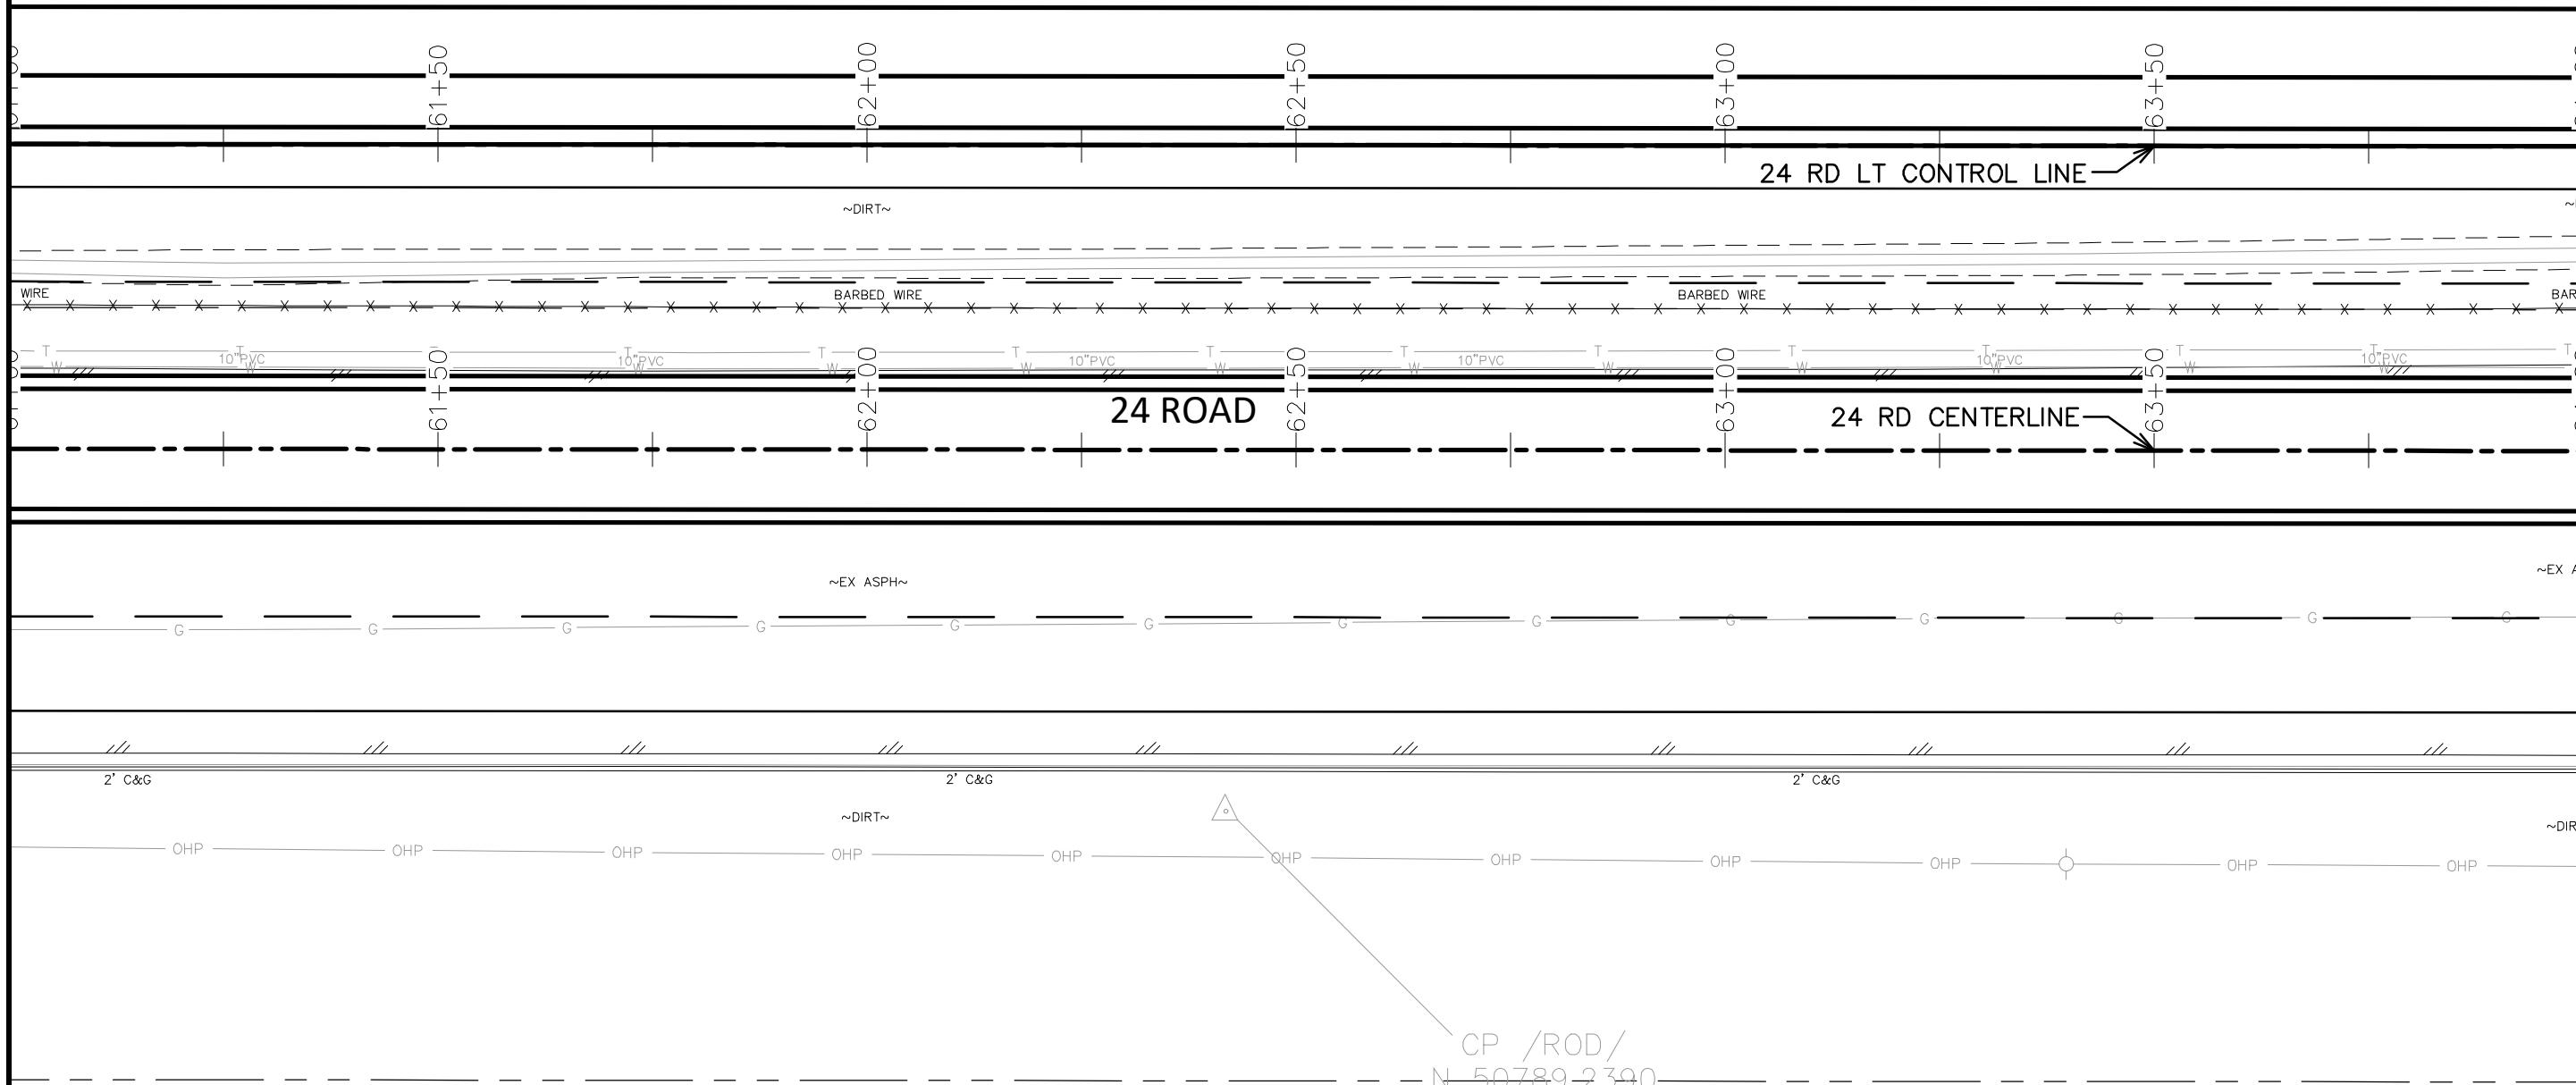

2701-333-00-152
728 24 RD
CITY OF GRAND JUNCTION

DESCRIPTION	DATE
REVISION A REV 1	- DATE
REVISION A REV 2	- DATE
REVISION A REV 3	- DATE
REVISION A REV 4	- DATE

DRAWN BY JCS DATE 2020
DESIGNED BY JCS DATE 2020
CHECKED BY ALC DATE 2020
APPROVED BY TCP DATE 2020


SCALE
0 5 10 20

CITY OF
Grand Junction
COLORADO

PUBLIC WORKS
ENGINEERING DIVISION
PROJECT NO. 207-F1903

24 ROAD AND G ROAD
IMPROVEMENT PLAN - 015

2701-324-00-093
Northwest Corner of G and 24 Rd
USHER NV LLC

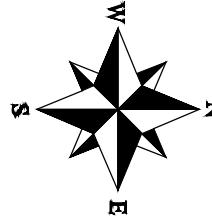

G 1/4 ROAD

4+00

2701-324-00-092
Southwest Corner of 1-70 and 24 Rd
MARIAN JACOBSON, ERIC JACOBSON,
& KIRSTEN JACOBSON

MATCH LINE

MATCH LINE

24 RD LT CONTROL LINE

24 ROAD

24 RD CENTERLINE

2701-333-00-152
728 24 RD
CITY OF GRAND JUNCTION

CITY OF
Grand Junction
COLORADO


DESCRIPTION	DATE
REVISION A REV 1	- DATE
REVISION A REV 2	- DATE
REVISION A REV 3	- DATE
REVISION A REV 4	- DATE

DRAWN BY	JCS	DATE 2020
DESIGNED BY	JCS	DATE 2020
CHECKED BY	ALC	DATE 2020
APPROVED BY	TCP	DATE 2020

SCALE
0 5 10 20

PUBLIC WORKS
ENGINEERING DIVISION
PROJECT NO. 207-F1903


24 ROAD AND G ROAD
IMPROVEMENT PLAN - 016

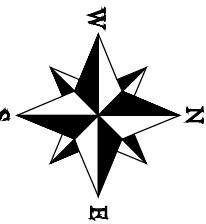


2701-324-00-092
Southwest Corner of I-70 and 24 Rd
MARIAN JACOBSON, ERIC JACOBSON, &
KIRSTEN JACOBSON

MATCH LINE

MATCH LINE

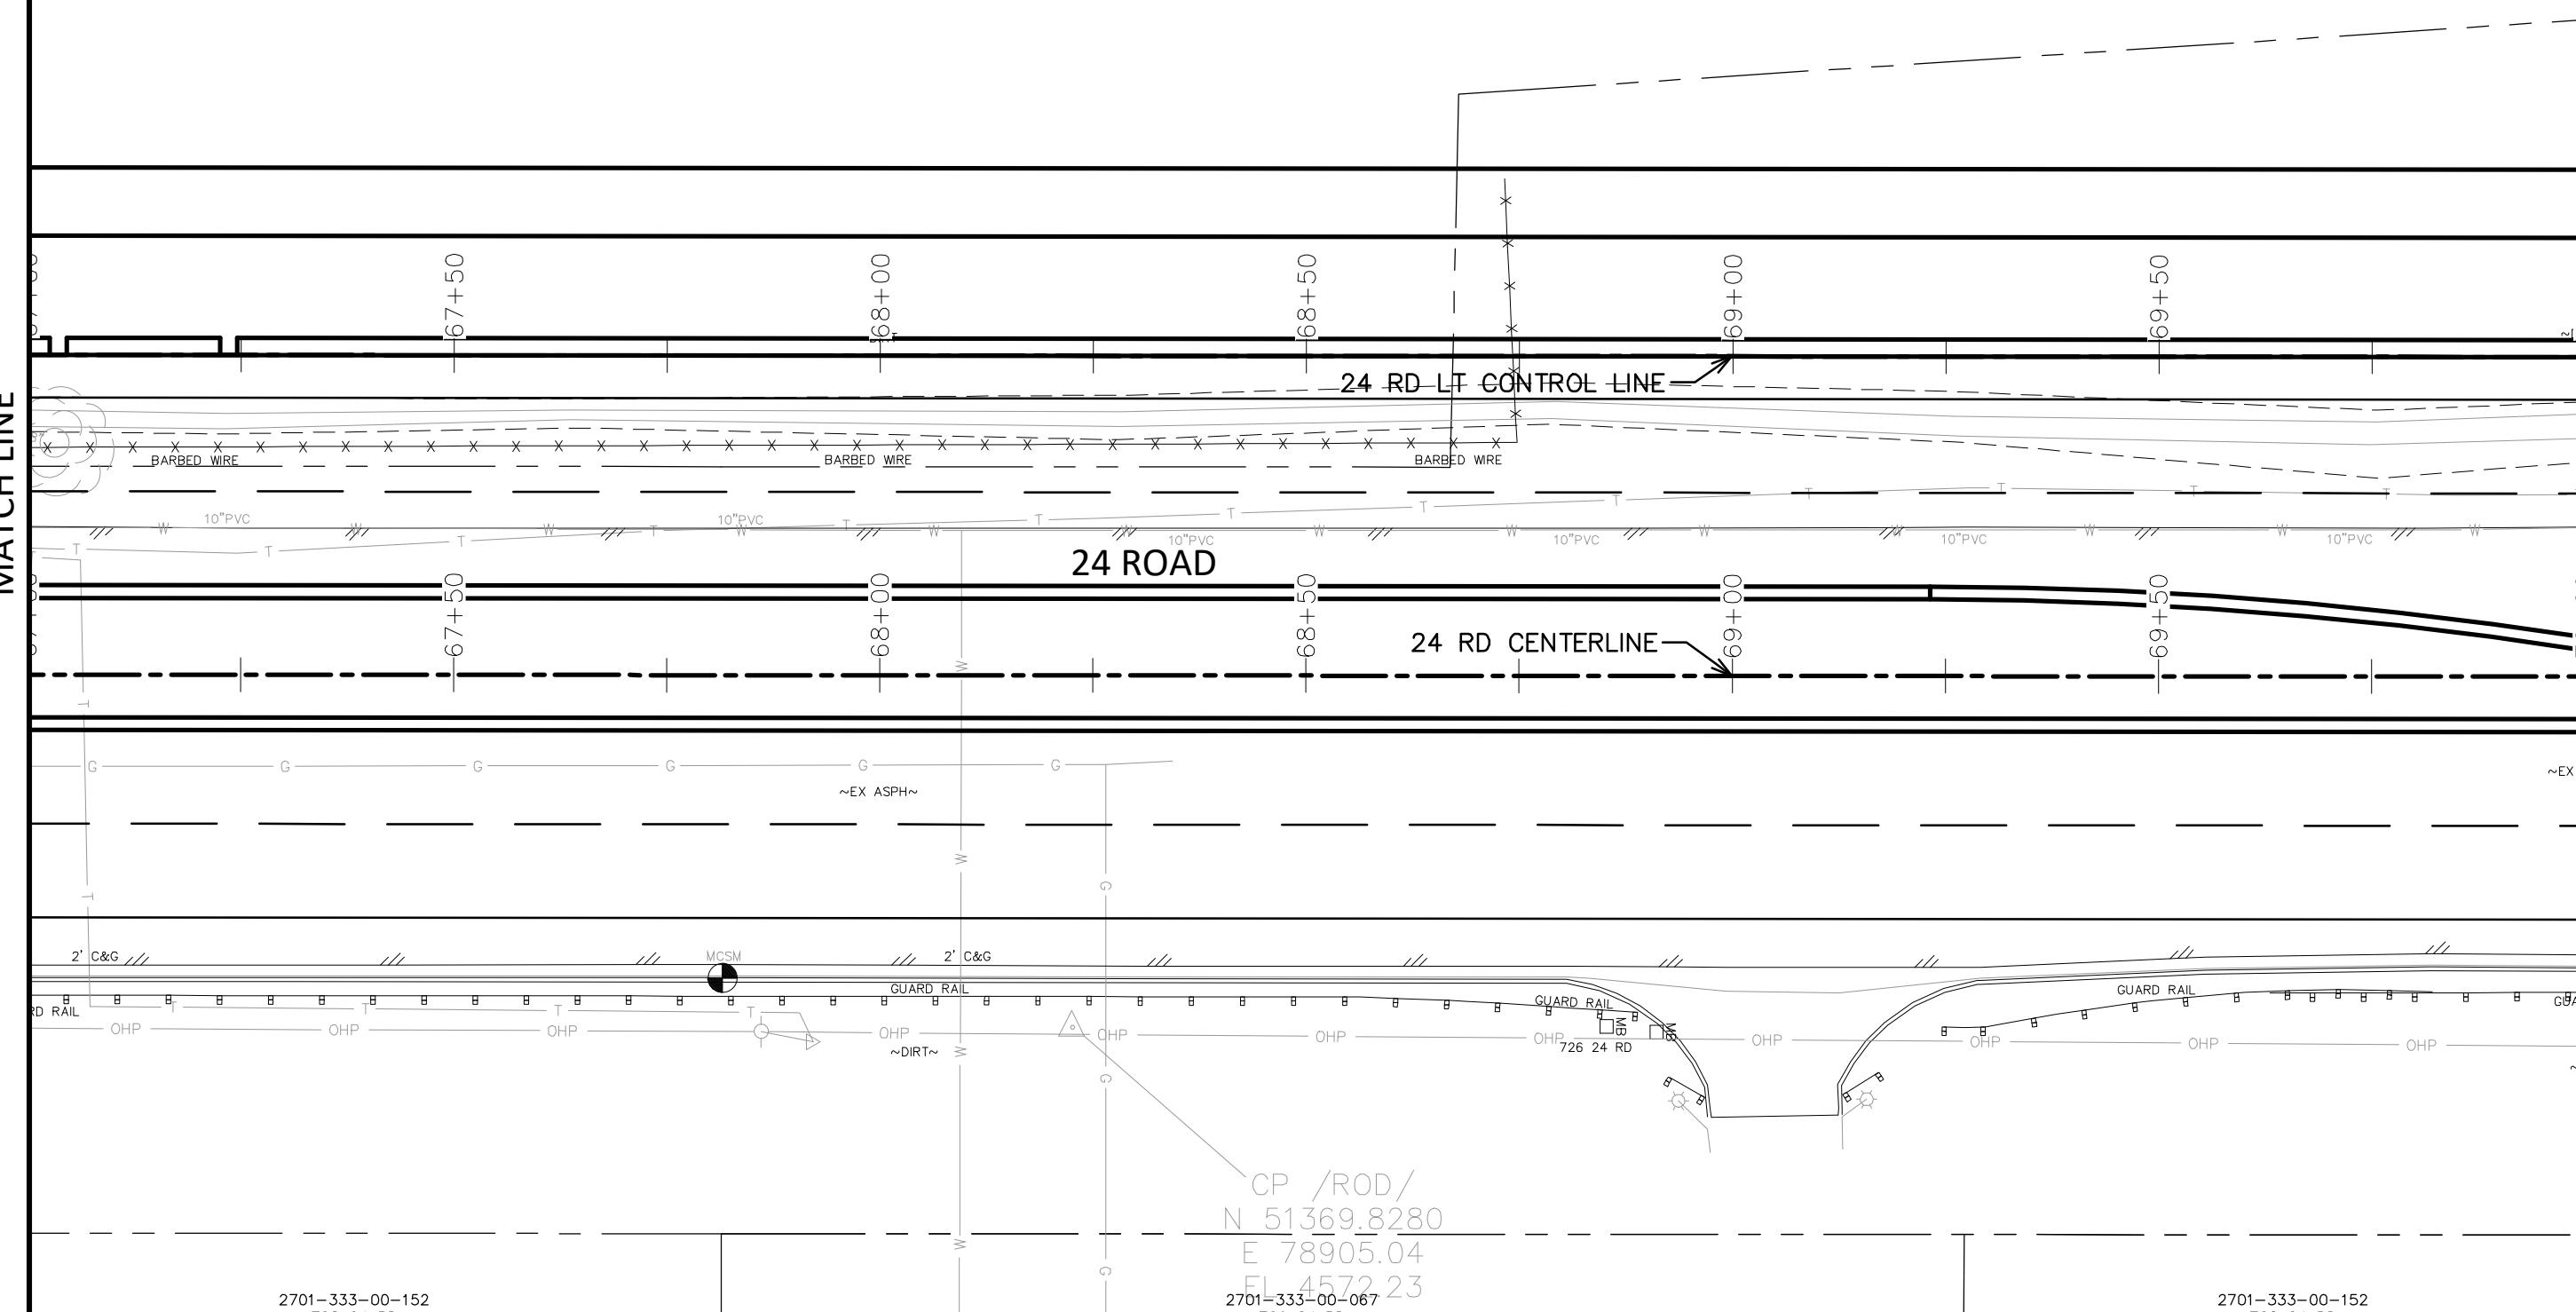

DESCRIPTION	DATE
REVISION A REV 1	- DATE
REVISION A REV 2	- DATE
REVISION A REV 3	- DATE
REVISION A REV 4	- DATE

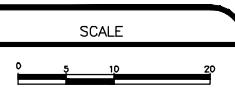


CITY OF
Grand Junction
COLORADO

PUBLIC WORKS
ENGINEERING DIVISION
PROJECT NO. 207-F1903


24 ROAD AND G ROAD
IMPROVEMENT PLAN - 017

2701-324-00-092
Southwest Corner of I-70 and 24 Rd
MARIAN JACOBSON, ERIC JACOBSON, &
KIRSTEN JACOBSON

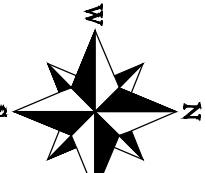


MATCH LINE

MATCHLINE

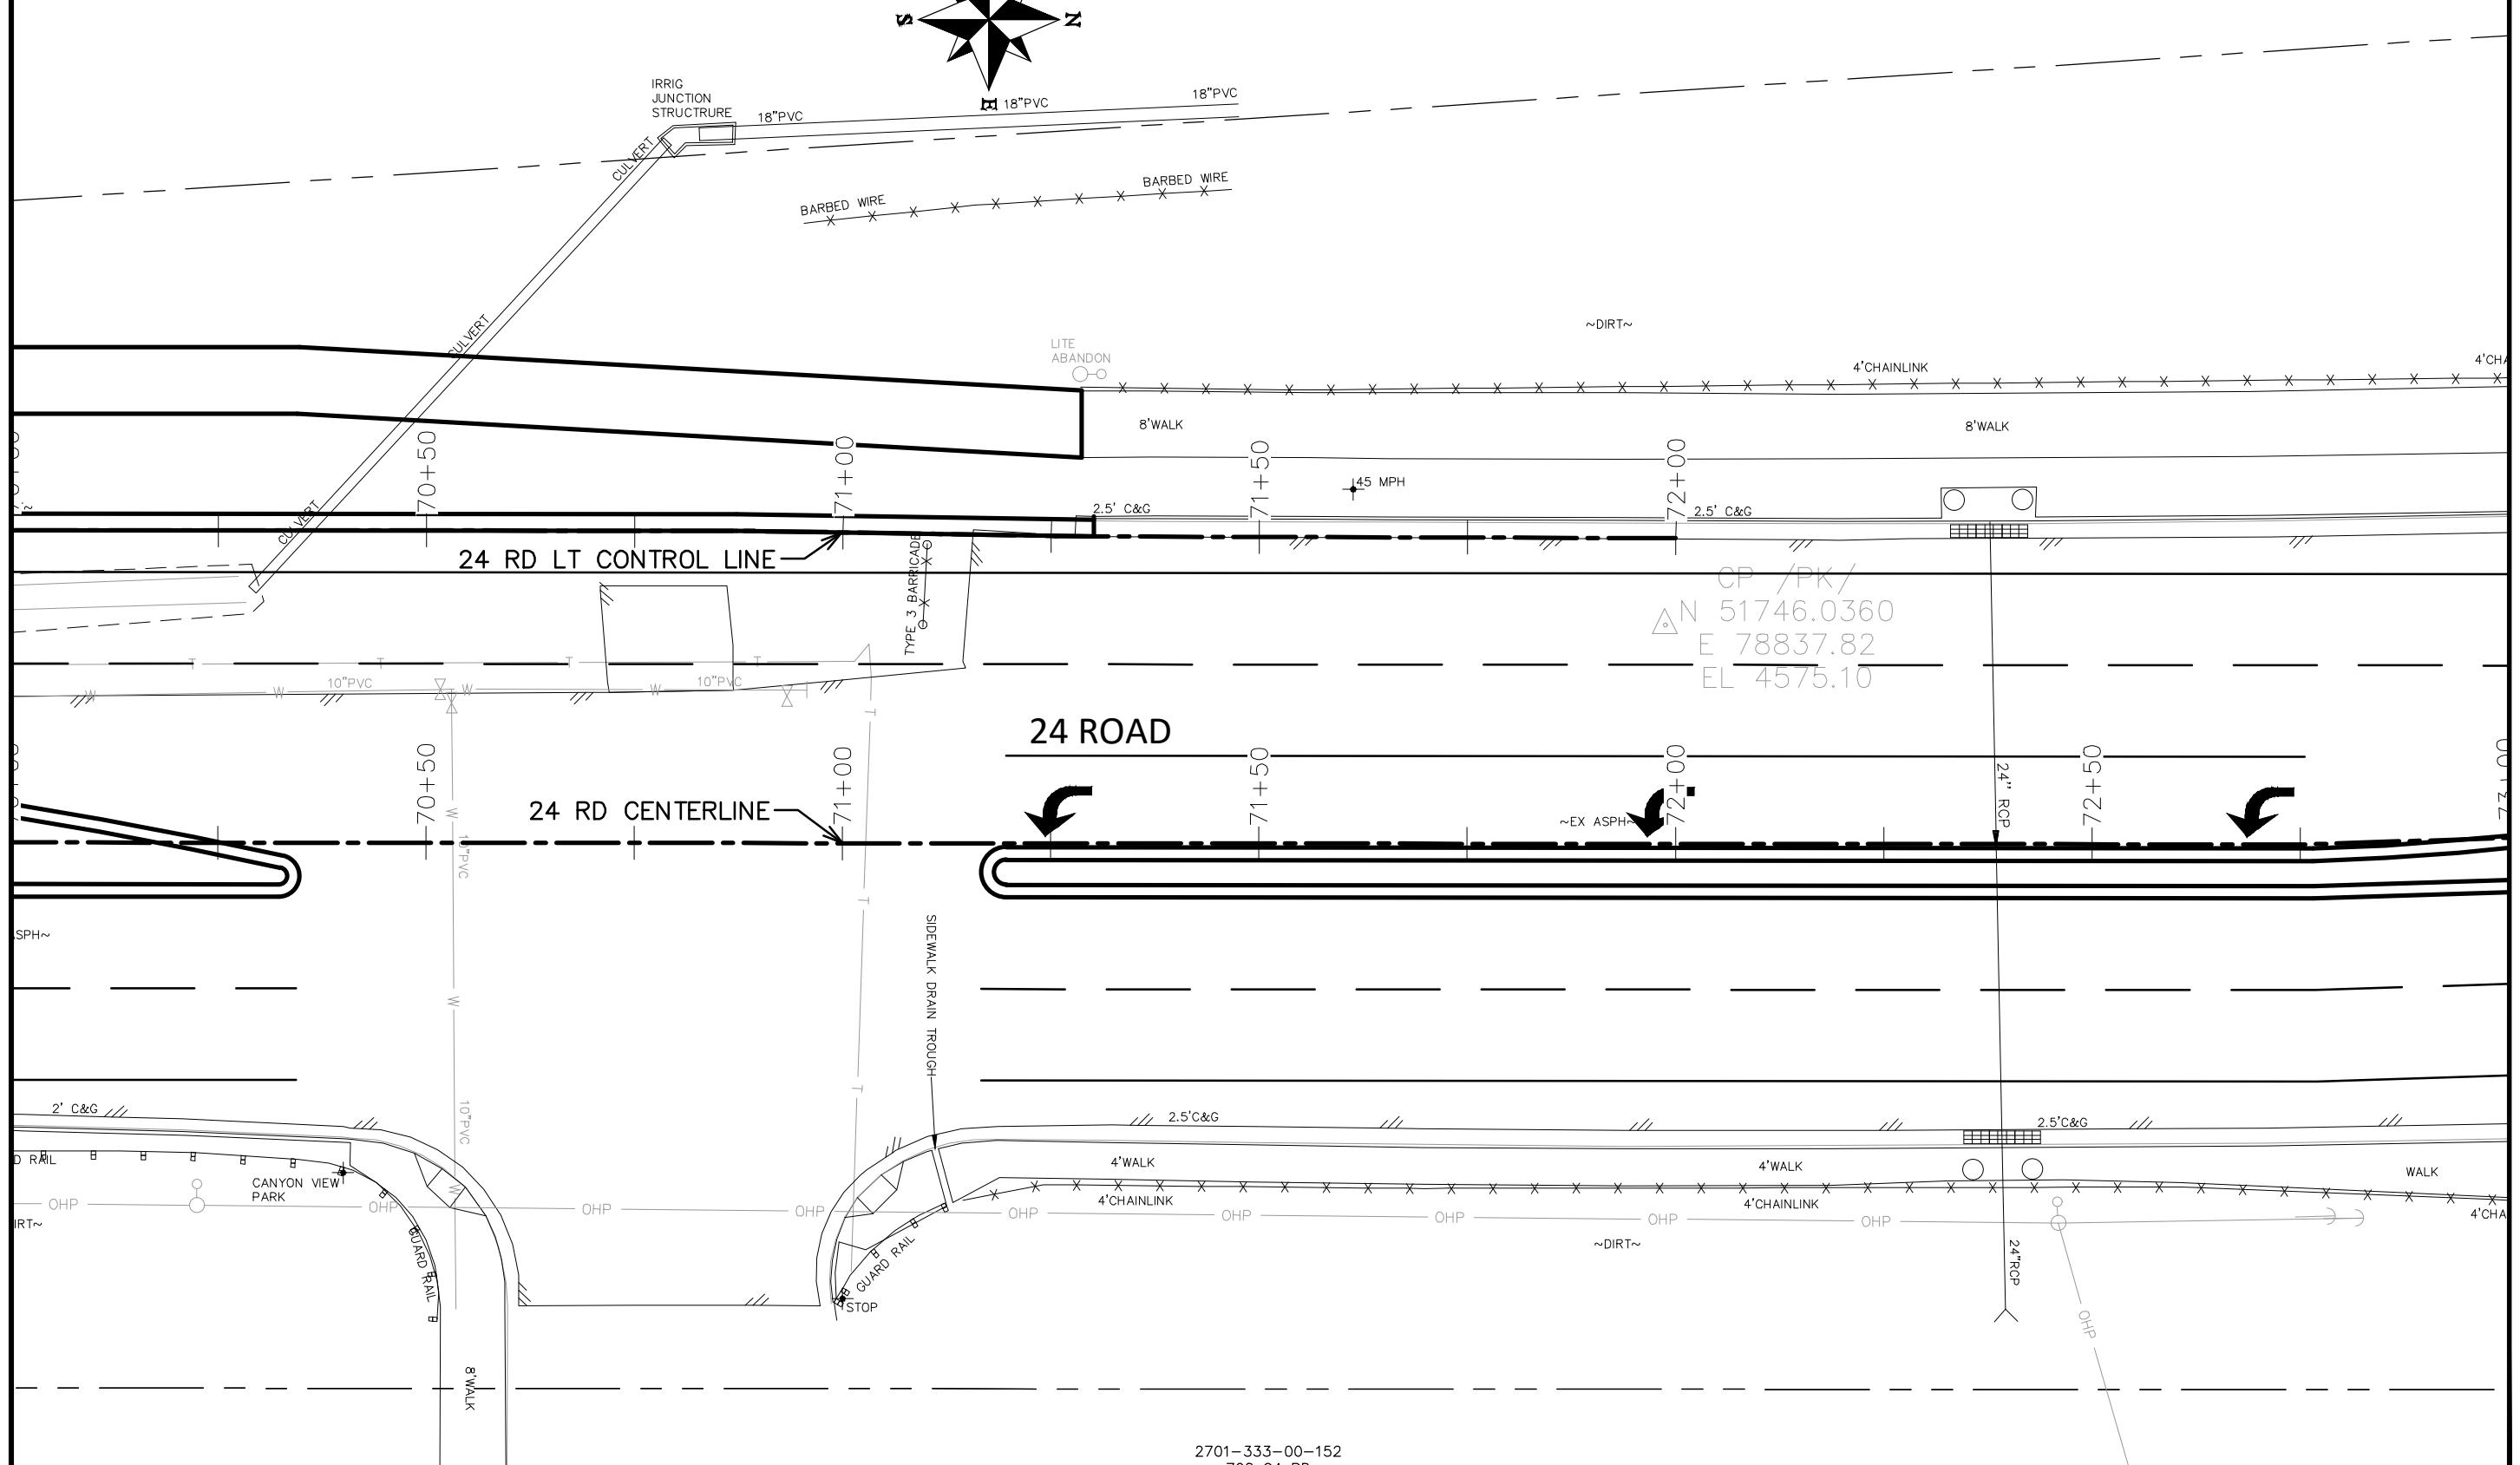

	<u>DESCRIPTION</u>	<u>DATE</u>
REVISION A	REV 1	DATE
REVISION A	REV 2	DATE
REVISION A	REV 3	DATE
REVISION A	REV 4	DATE

DRAWN BY JCS DATE 2020
DESIGNED BY JCS DATE 2020
CHECKED BY ALC DATE 2020
APPROVED BY TCP DATE 2020

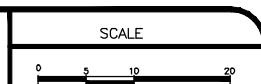


2701-333-00-152
728 24 RD
CITY OF GRAND JUNCTION

PUBLIC WORKS
ENGINEERING DIVISION
PROJECT NO. 207-F1903

24 ROAD AND G ROAD
IMPROVEMENT PLAN - 018


MATCH LINE

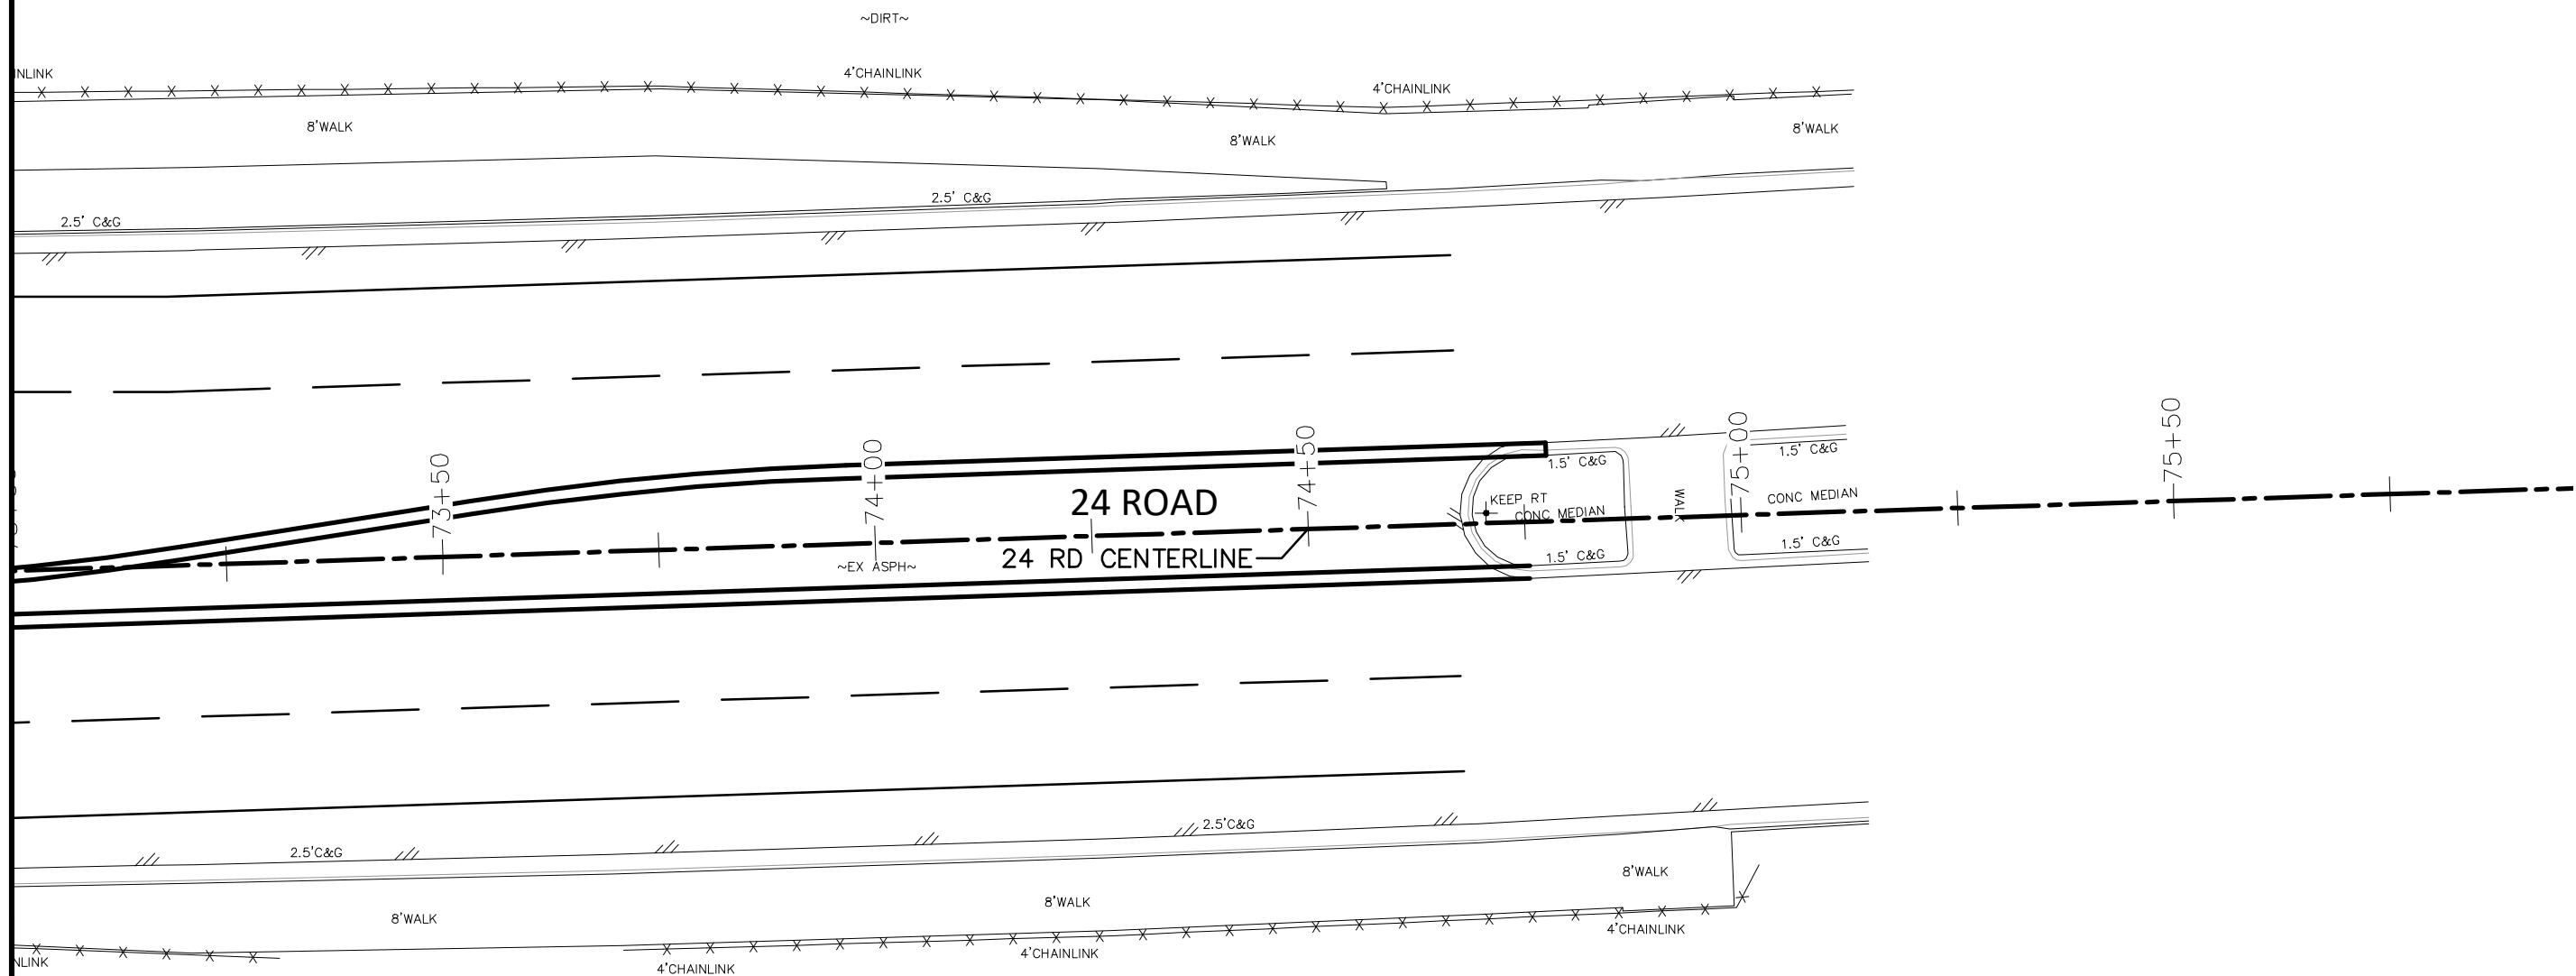

2701-333-00-152
 728 24 RD
 CITY OF GRAND JUNCTION


DESCRIPTION	DATE
REVISION A REV 1	DATE
REVISION A REV 2	DATE
REVISION A REV 3	DATE
REVISION A REV 4	DATE

DRAWN BY	JCS	DATE
DESIGNED BY	JCS	DATE
CHECKED BY	ALC	DATE
APPROVED BY	TCP	DATE

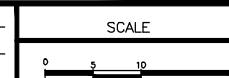

PUBLIC WORKS
 ENGINEERING DIVISION
 PROJECT NO. 207-F1903

24 ROAD AND G ROAD
 IMPROVEMENT PLAN - 019

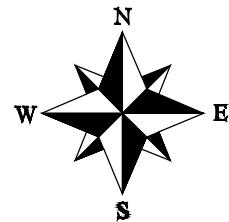

MATCH LINE

+1+50

2+00

2+50

3+00

3+50

MATCH LINE

F 1/2 ROAD

2945-054-01-002

2383 F 1/2 RD

LUCERO LLC

2945-054-01-001

2385 F 1/2 RD

LUCERO LLC

DESCRIPTION	DATE
REVISION A REV 1	- DATE
REVISION A REV 2	- DATE
REVISION A REV 3	- DATE
REVISION A REV 4	- DATE

DRAWN BY	JCS	DATE	2020
DESIGNED BY	JCS	DATE	2020
CHECKED BY	ALC	DATE	2020
APPROVED BY	TCP	DATE	2020


SCALE
0 5 10 20



CITY OF
Grand Junction
COLORADO
PUBLIC WORKS
ENGINEERING DIVISION
PROJECT NO. 207-F1903

649 24 RD
TED A MARTIN
24 ROAD AND G ROAD
IMPROVEMENT PLAN - 020

2945-051-14-001
665 24 RD
CC GRAND JUNCTION LLC

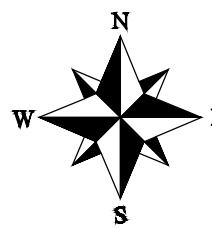

MATCH LINE

MATCH LINE

4+50

5+00

5+50

6+00

6+50

PNT 9997?
F3-232-003
RIM 4552.42
INV E 4540.54
INV W 4540.54

F 1/2 ROAD

DESCRIPTION	DATE
REVISION A REV 1	- DATE
REVISION A REV 2	- DATE
REVISION A REV 3	- DATE
REVISION A REV 4	- DATE


DRAWN BY	JCS	DATE	2020
DESIGNED BY	JCS	DATE	2020
CHECKED BY	ALC	DATE	2020
APPROVED BY	TCP	DATE	2020



PUBLIC WORKS
ENGINEERING DIVISION
PROJECT NO. 207-F1903

24 ROAD AND G ROAD
IMPROVEMENT PLAN - 021

2945-051-14-001
665 24 RD
CC GRAND JUNCTION LLC

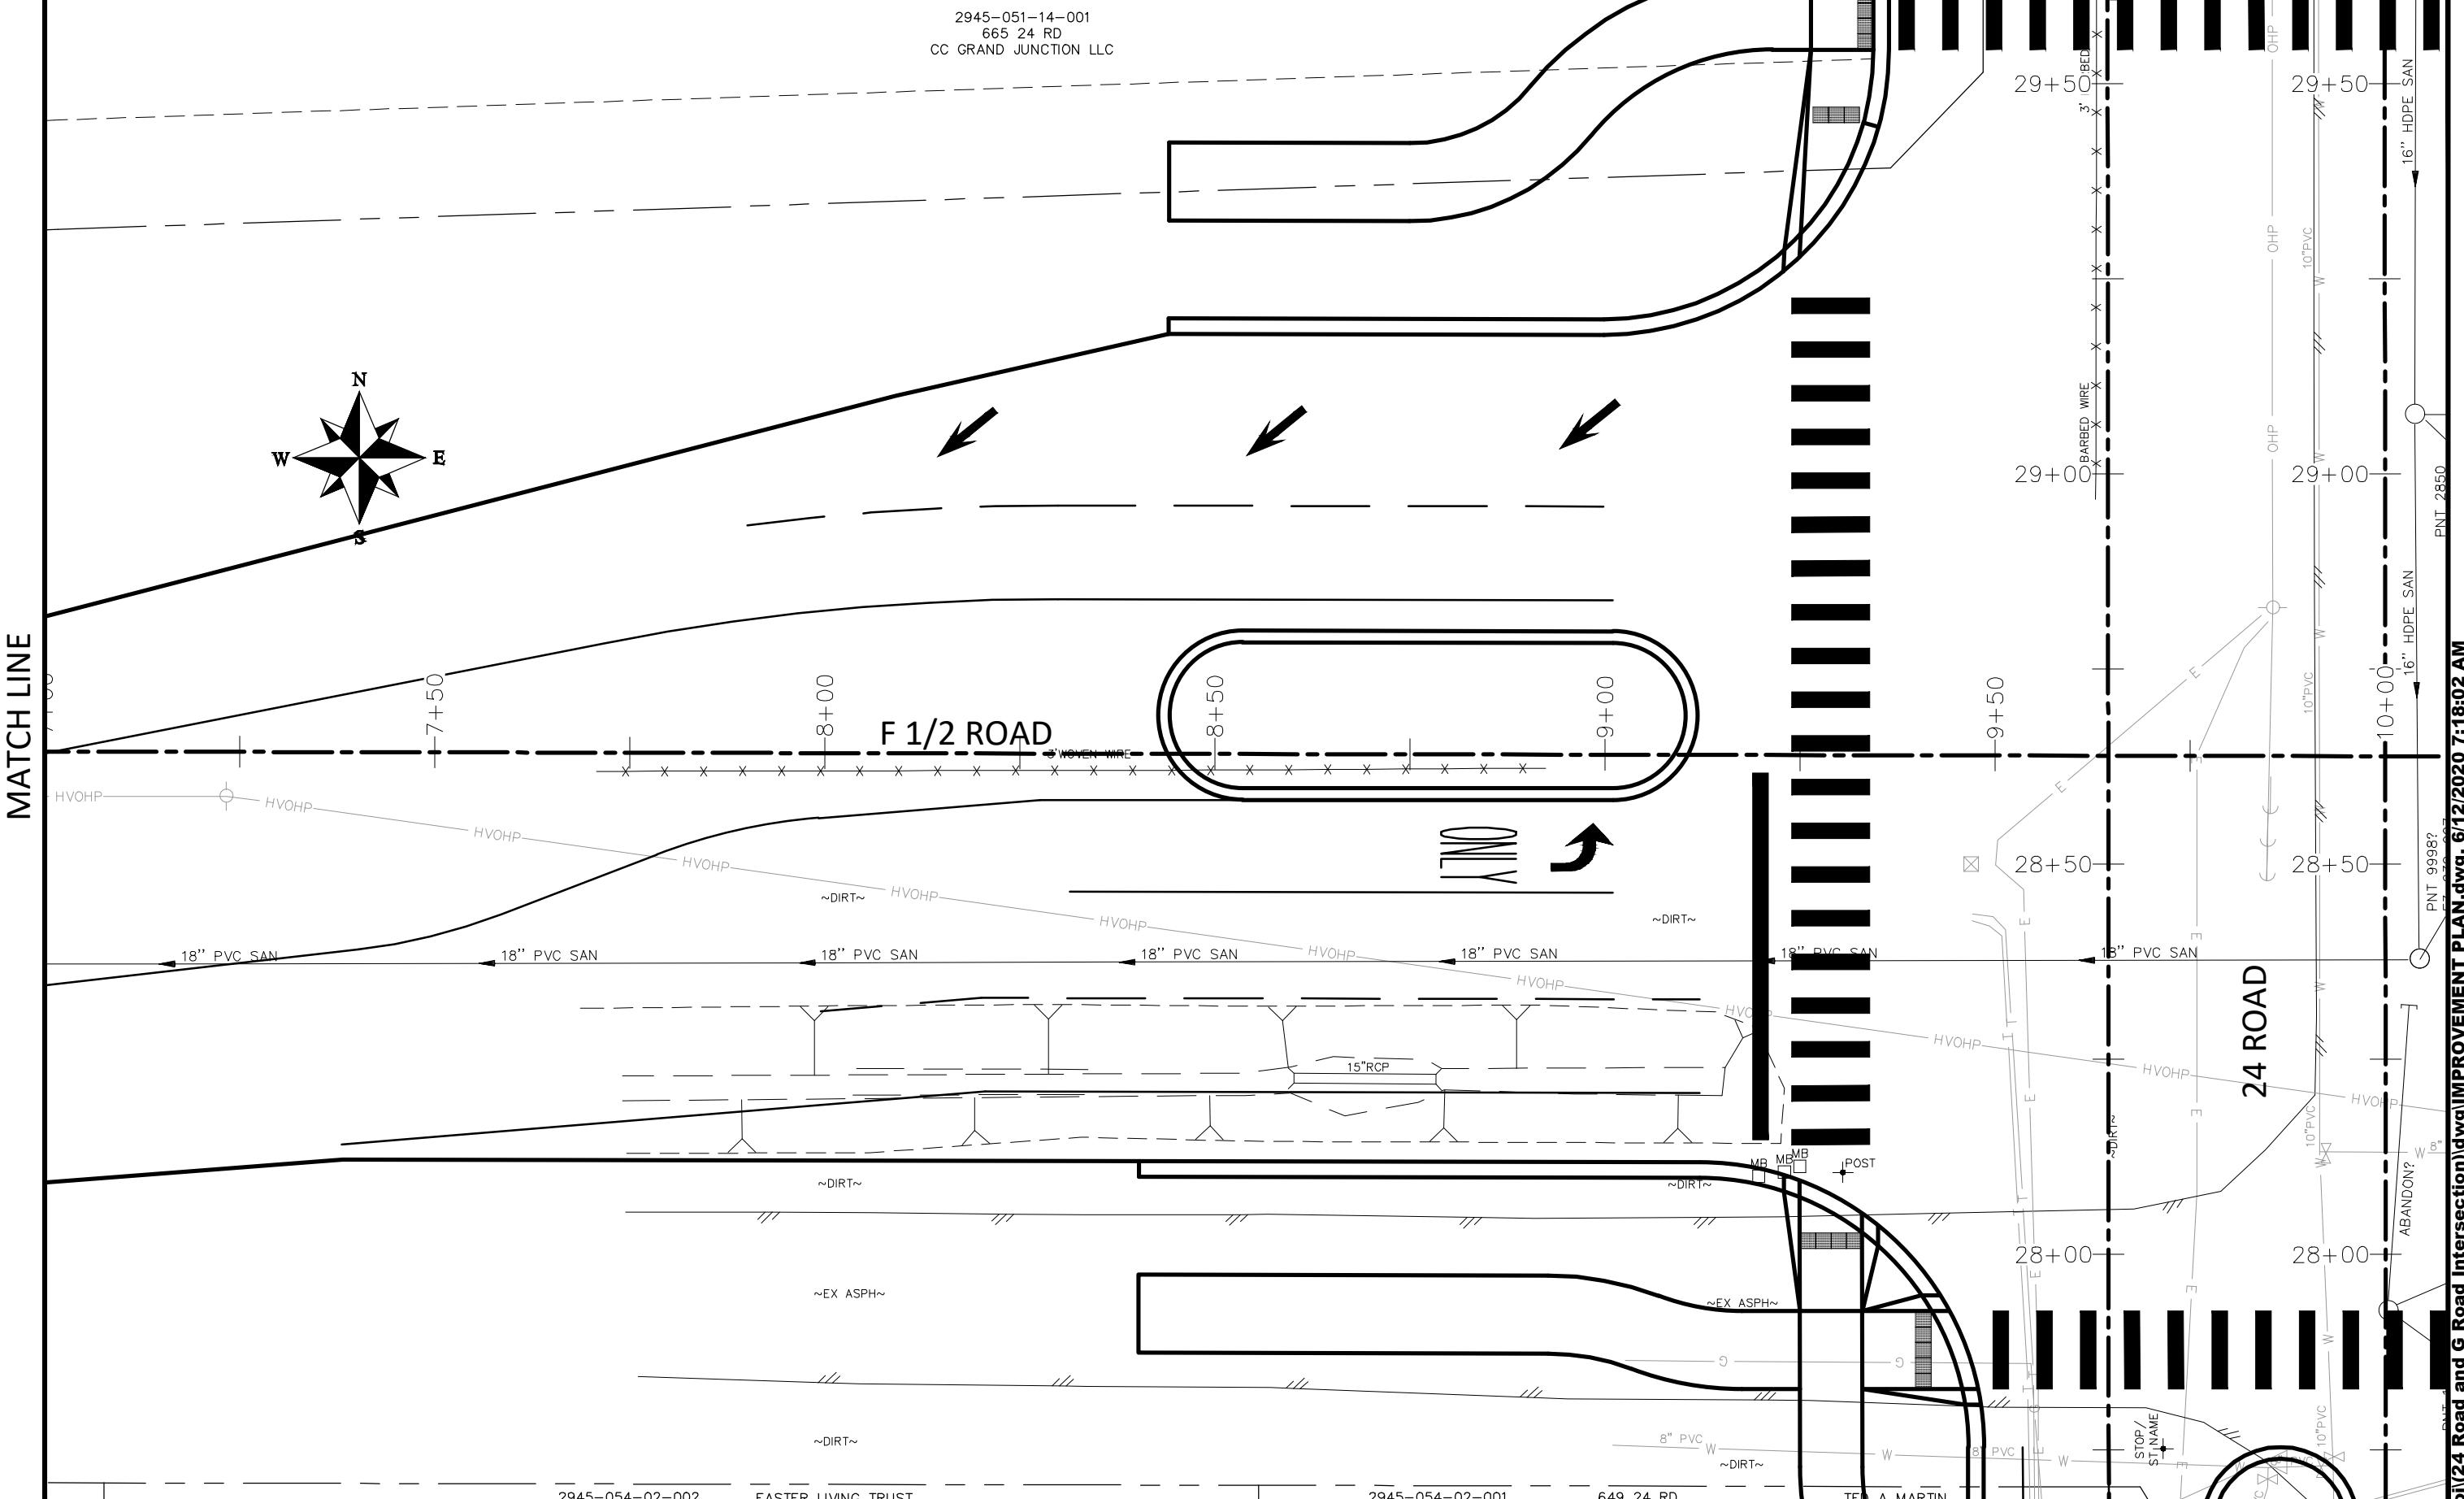

DESCRIPTION	DATE
REVISION ▲ REV 1	- DATE
REVISION ▲ REV 2	- DATE
REVISION ▲ REV 3	- DATE
REVISION ▲ REV 4	- DATE


2945-054-02-002 FASTER LIVING TRUST

CITY OF
Grand Junction
COLORADO

PUBLIC WORKS
ENGINEERING DIVISION
PROJECT NO. 207-F1903

24 ROAD AND G ROAD
IMPROVEMENT PLAN - 022

2945-051-14-001
665 24 RD
CC GRAND JUNCTION LLC

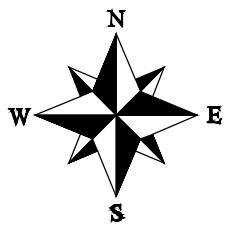

-2+50

3+00

3+50

F 3/4 ROAD

-4+00

50

2945-051-14-001
665 24 RD
CC GRAND JUNCTION LLC

<u>DESCRIPTION</u>	<u>DATE</u>
REVISION A REV 1	- DATE
REVISION A REV 2	- DATE
REVISION A REV 3	- DATE
REVISION A REV 4	- DATE

DRAWN BY JCS DATE 2020
DESIGNED BY JCS DATE 2020
CHECKED BY ALC DATE 2020
APPROVED BY TCP DATE 2020

SCALE



CITY OF **Grand Junction** COLORADO

PUBLIC WORKS
ENGINEERING DIVISION
PROJECT NO. 207-F1903

24 ROAD AND G ROAD
IMPROVEMENT PLAN - 023

36

2945-051-18-002
2385 G RD
WDM CORPORATION

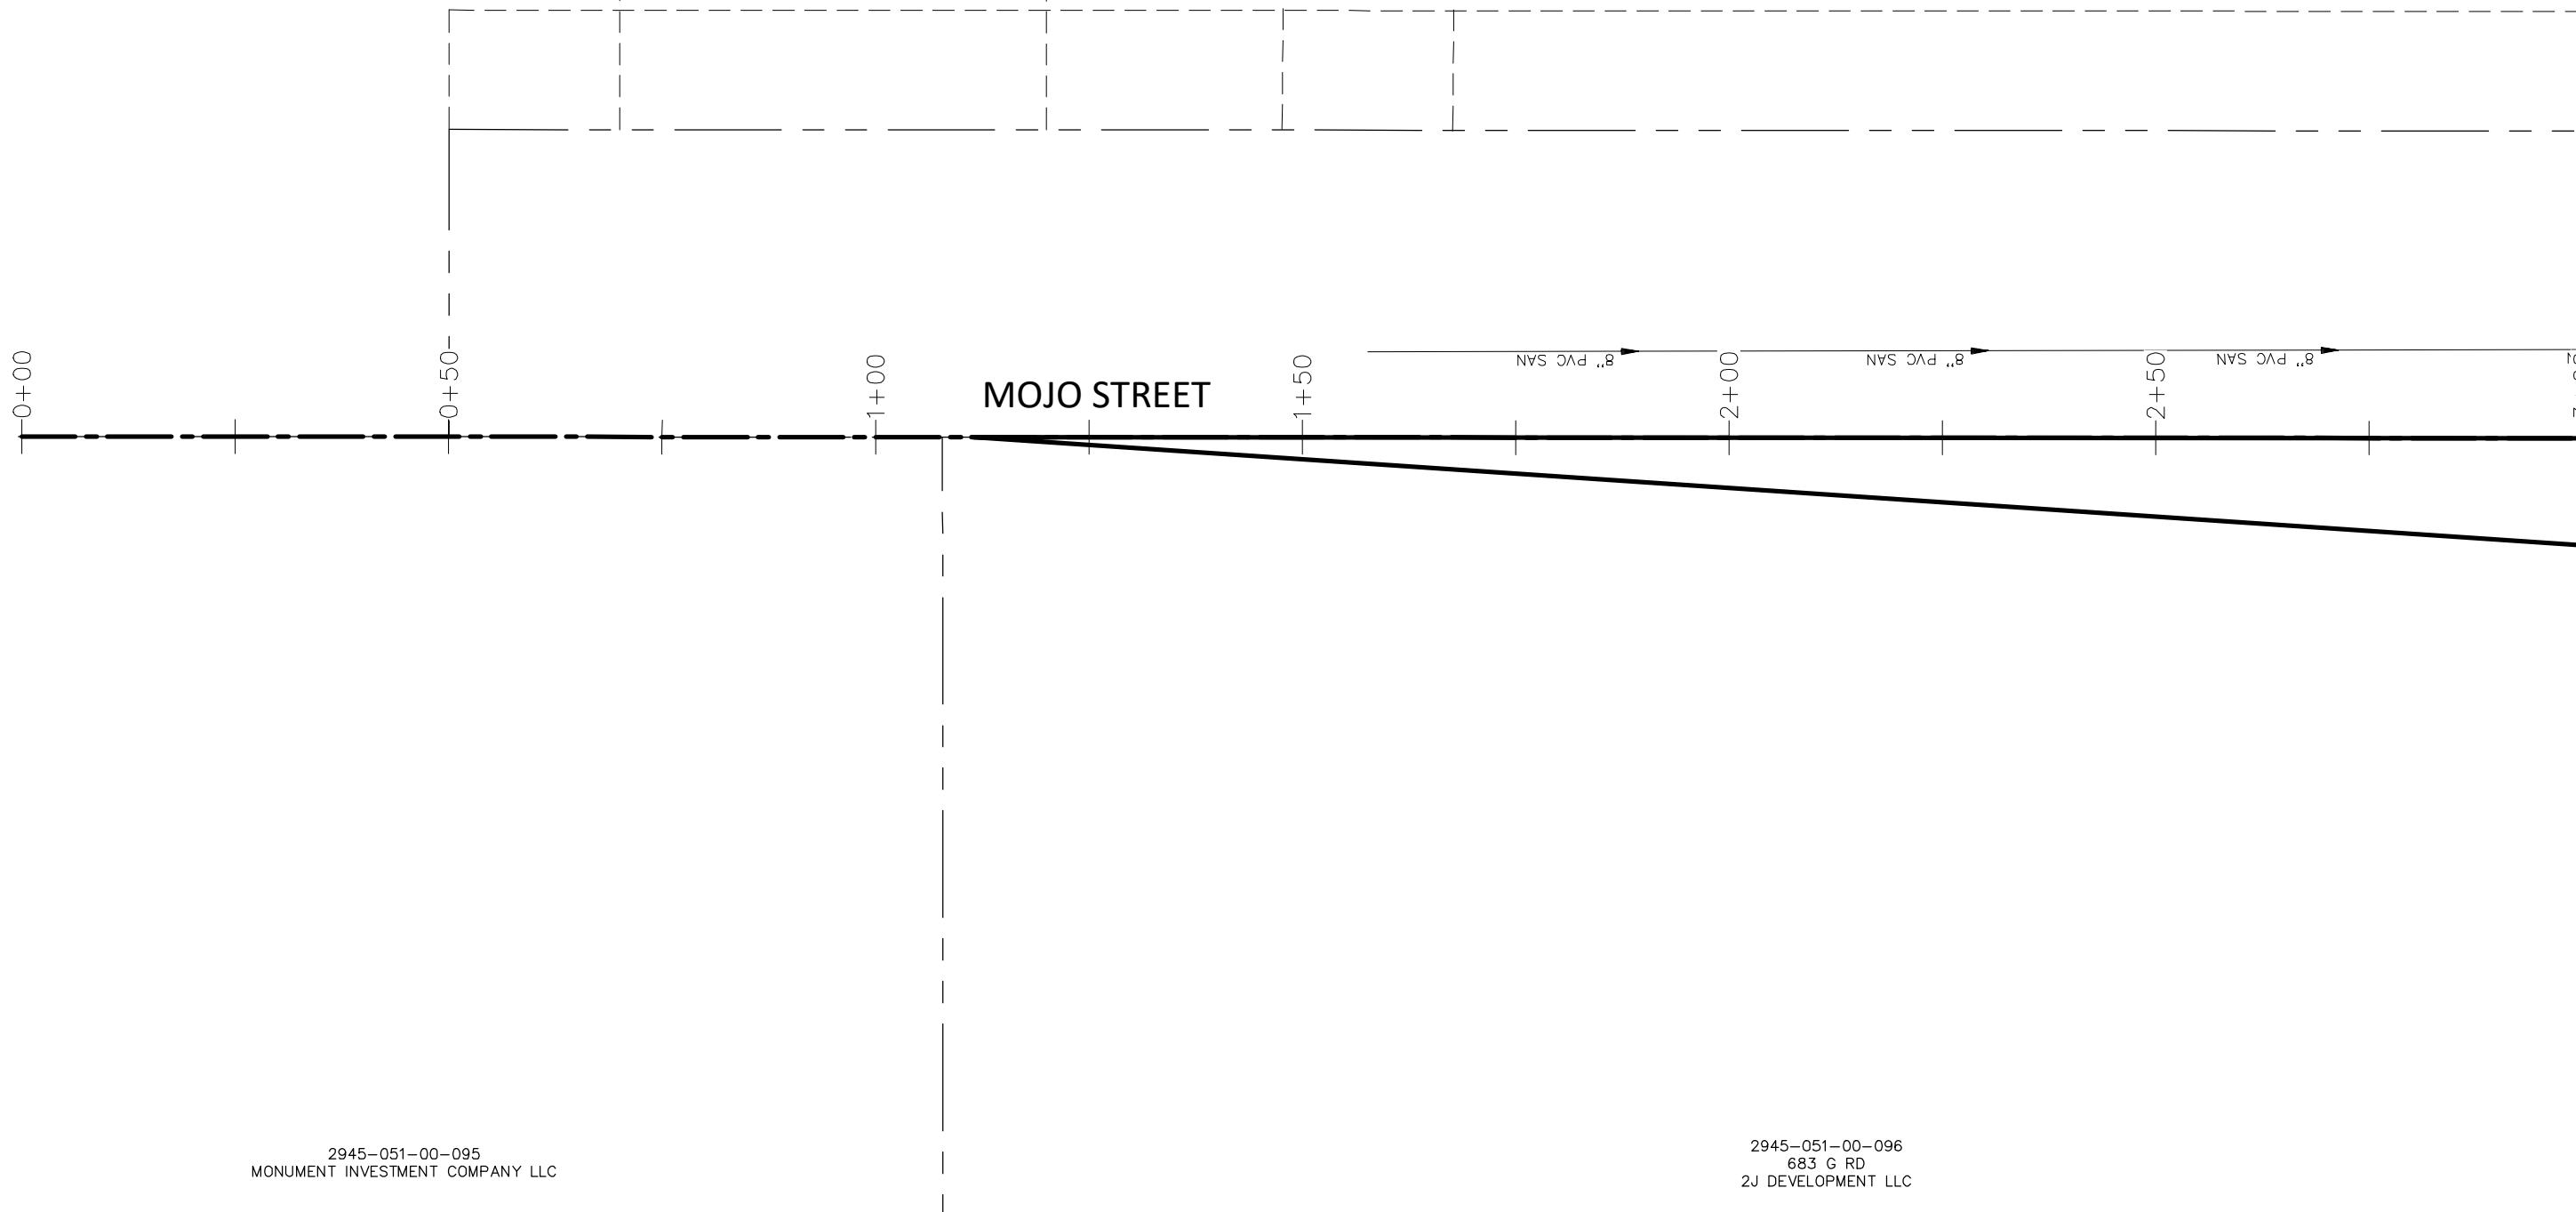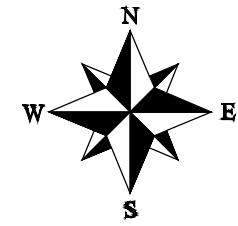

2945-051-00-095
MONUMENT INVESTMENT COMPANY LLC

2945-051-00-096
683 G RD
2J DEVELOPMENT LLC

DESCRIPTION	DATE
REVISION A REV 1	- DATE
REVISION A REV 2	- DATE
REVISION A REV 3	- DATE
REVISION A REV 4	- DATE

DRAWN BY	JCS	DATE	2020
DESIGNED BY	JCS	DATE	2020
CHECKED BY	ALC	DATE	2020
APPROVED BY	TCP	DATE	2020



PUBLIC WORKS
ENGINEERING DIVISION
PROJECT NO. 207-F1903

24 ROAD AND G ROAD
IMPROVEMENT PLAN - 024

2945-051-18-002
2385 G RD
WDM CORPORATION

MATCH LINE

2945-051-18-002
2385 G RD
WDM CORPORATION

2945-051-00-096
683 G RD
2J DEVELOPMENT LLC

MOJO STREET

24 ROAD

W E

18" RCP

12" PVC SAN

10" PVC

8" PVC SAN

7" C&G & SW

3+50 4+00 4+50

48+00 48+50

47+50 47+50

5+00

PVC SAN

OHP

10" PVC

12" PVC SAN

10" PVC

10" PVC

8" PVC SAN

8" PVC SAN

8" PVC SAN

~DIRT~

~EX A~

~RT~

STOP /
ST NAME

DELINEATOR

PNT 11927
F4-232-004
RM 4562.46
INV W 4548.56
INV N 4548.50
INV S 4548.50

F4-232-009
GRADE 4561.72
INV W 4558.52
INV E 4558.47

2' C&G

~DIRT~

~EX ASPH~


2' C&G

4' BARBED WIRE

CP /ROD DWY GG/
N 49255.3490
E 78896.01
EL 4561.90

2945-051-00-096
683 G RD
2J DEVELOPMENT LLC

<u>DESCRIPTION</u>	<u>DATE</u>	DRAWN BY	JCS	DATE	2020
REVISION A REV 1	- DATE	DESIGNED BY	JCS	DATE	2020
REVISION A REV 2	- DATE	CHECKED BY	ALC	DATE	2020
REVISION A REV 3	- DATE	APPROVED BY	TCP	DATE	2020
REVISION A REV 4	- DATE				

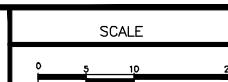


The logo for the City of Grand Junction, Colorado. It features the word "CITY OF" in a small, sans-serif font above the words "Grand Junction" in a large, bold, serif font. Below "Grand Junction" is the word "COLORADO" in a smaller, all-caps, sans-serif font. A stylized, swooping line starts from the bottom left, goes up and around the "G" in "Grand", then down and around the "J" in "Junction".

PUBLIC WORKS
ENGINEERING DIVISION
PROJECT NO. 207-F1903



24 ROAD AND G ROAD
IMPROVEMENT PLAN - 025

MATCH LINE

N:\Landproj\24 Road and G Road Intersection.dwg\IMPROVEMENT PLAN.dwg, 6/12/2020 7:18:27 AM

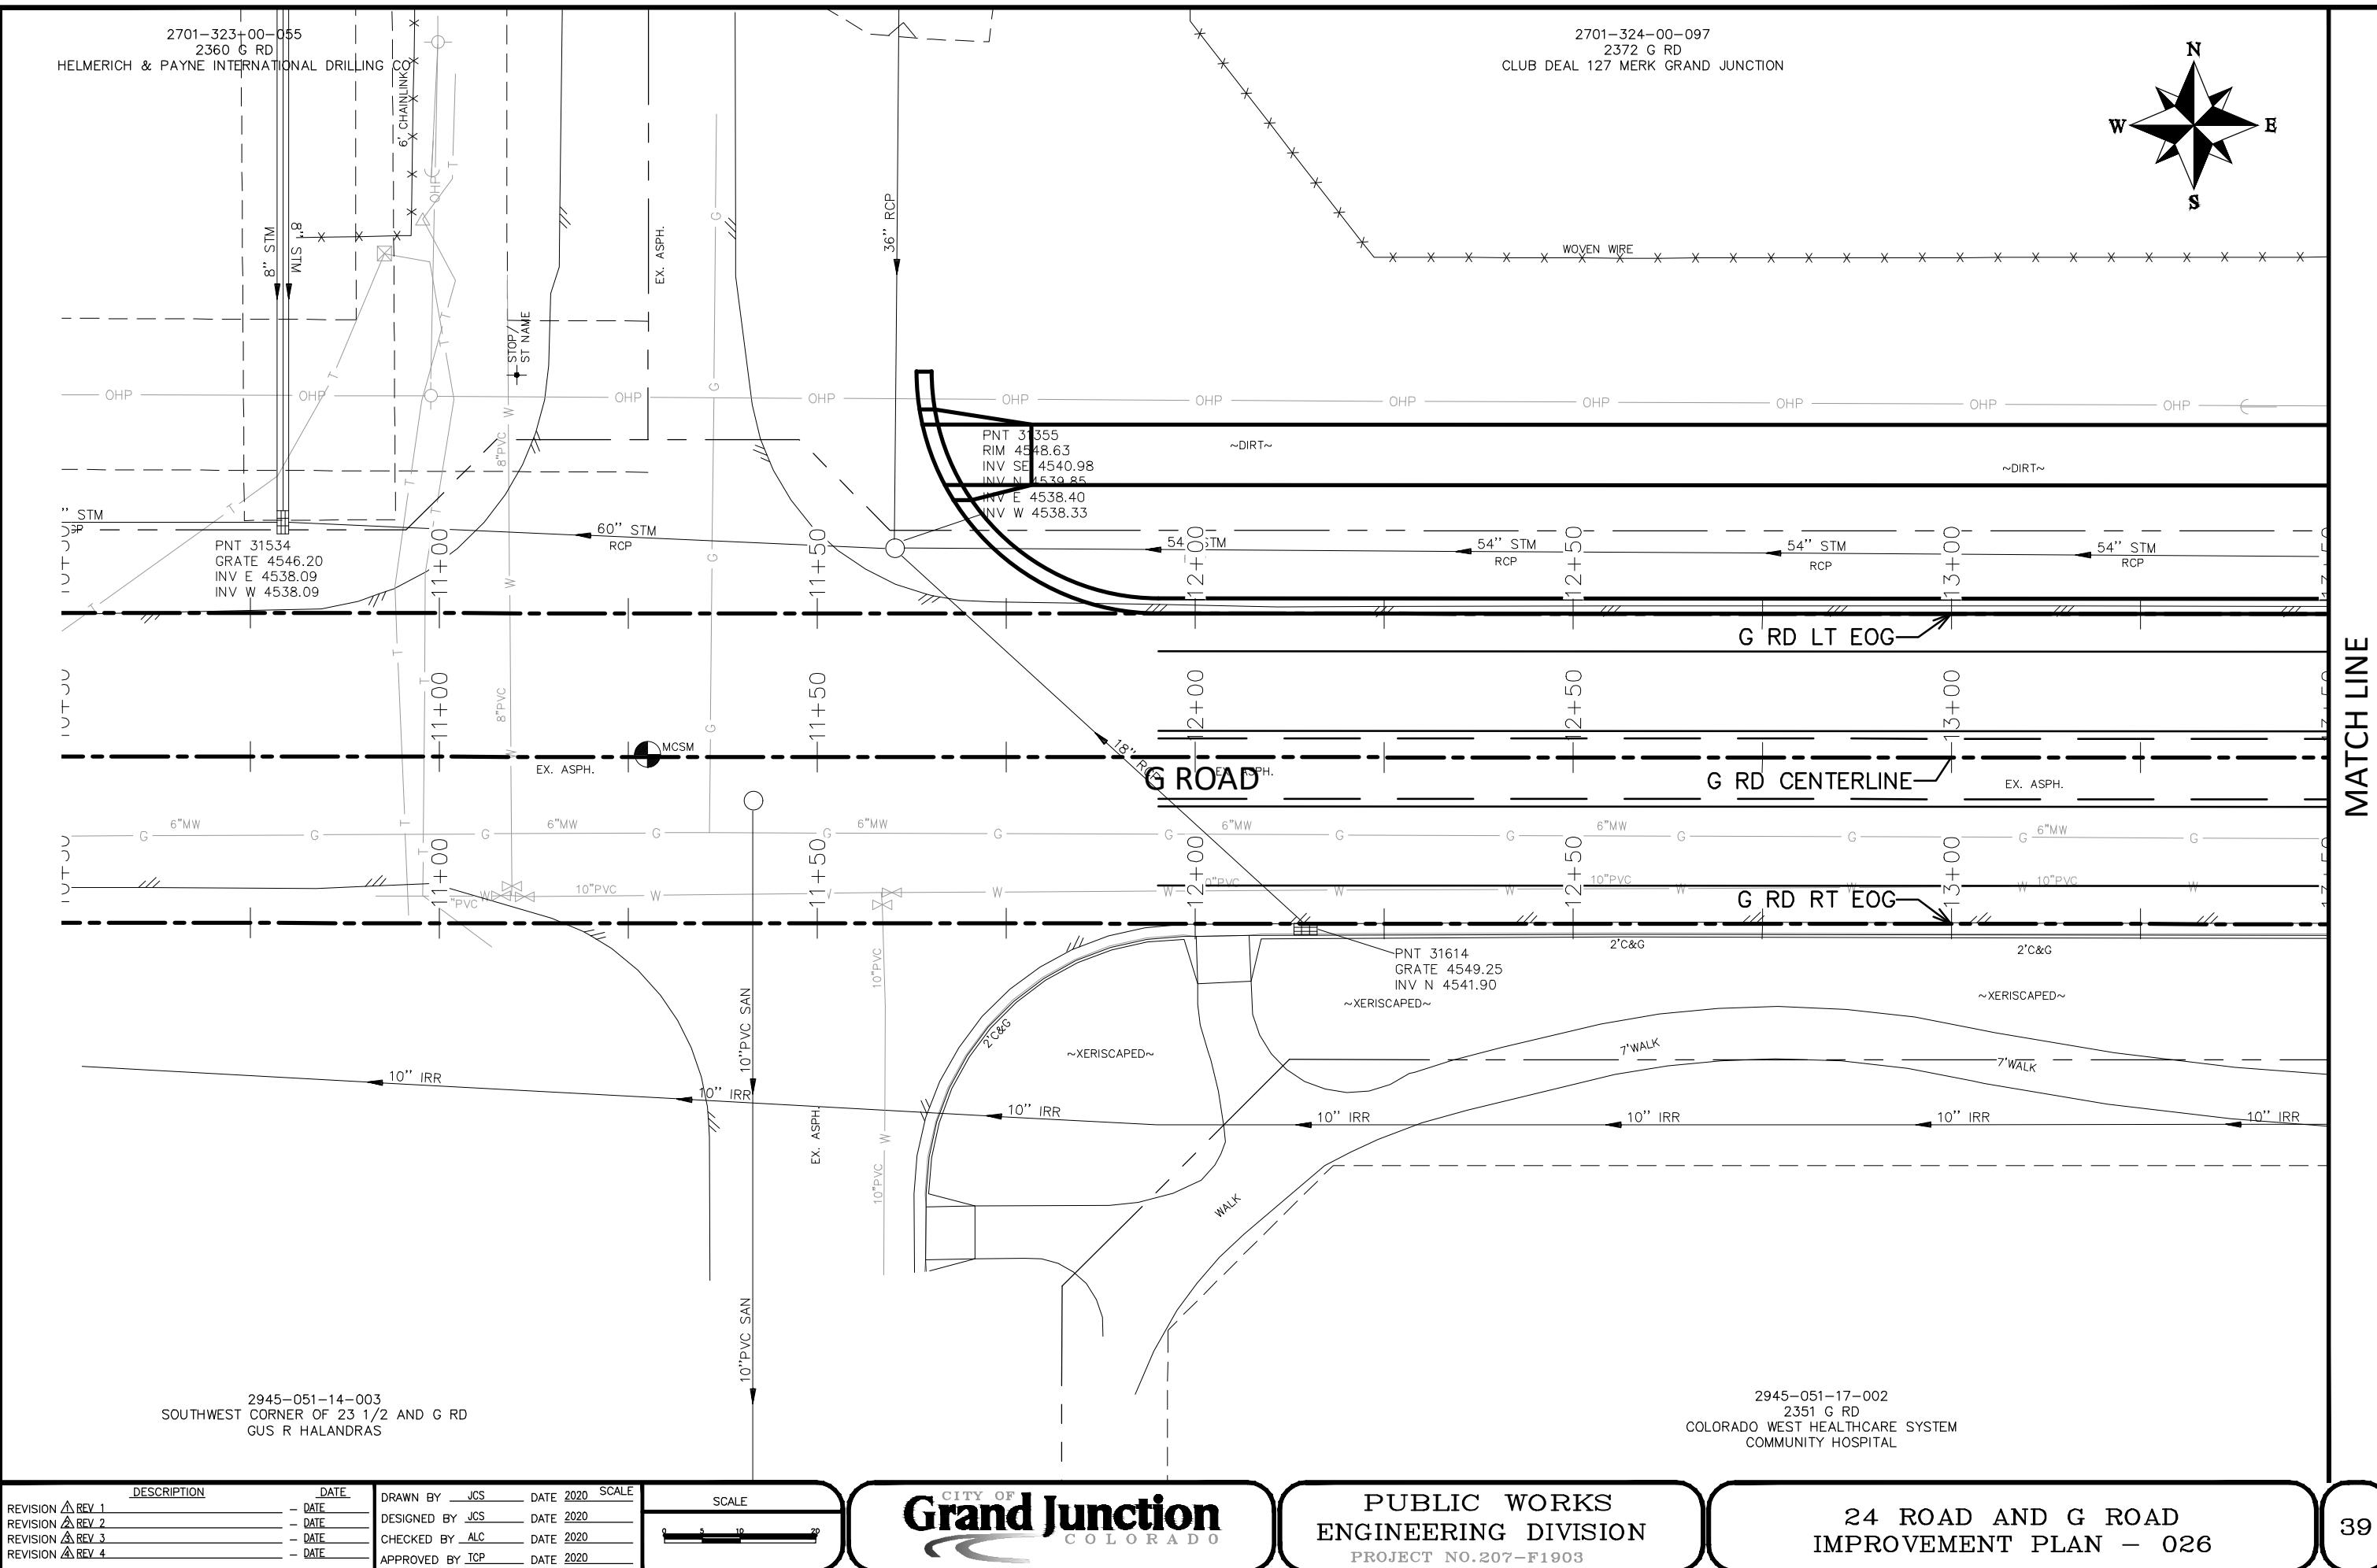


2701-324-00-097
2372 G RD
CLUB DEAL 127 MERK GRAND JUNCTION

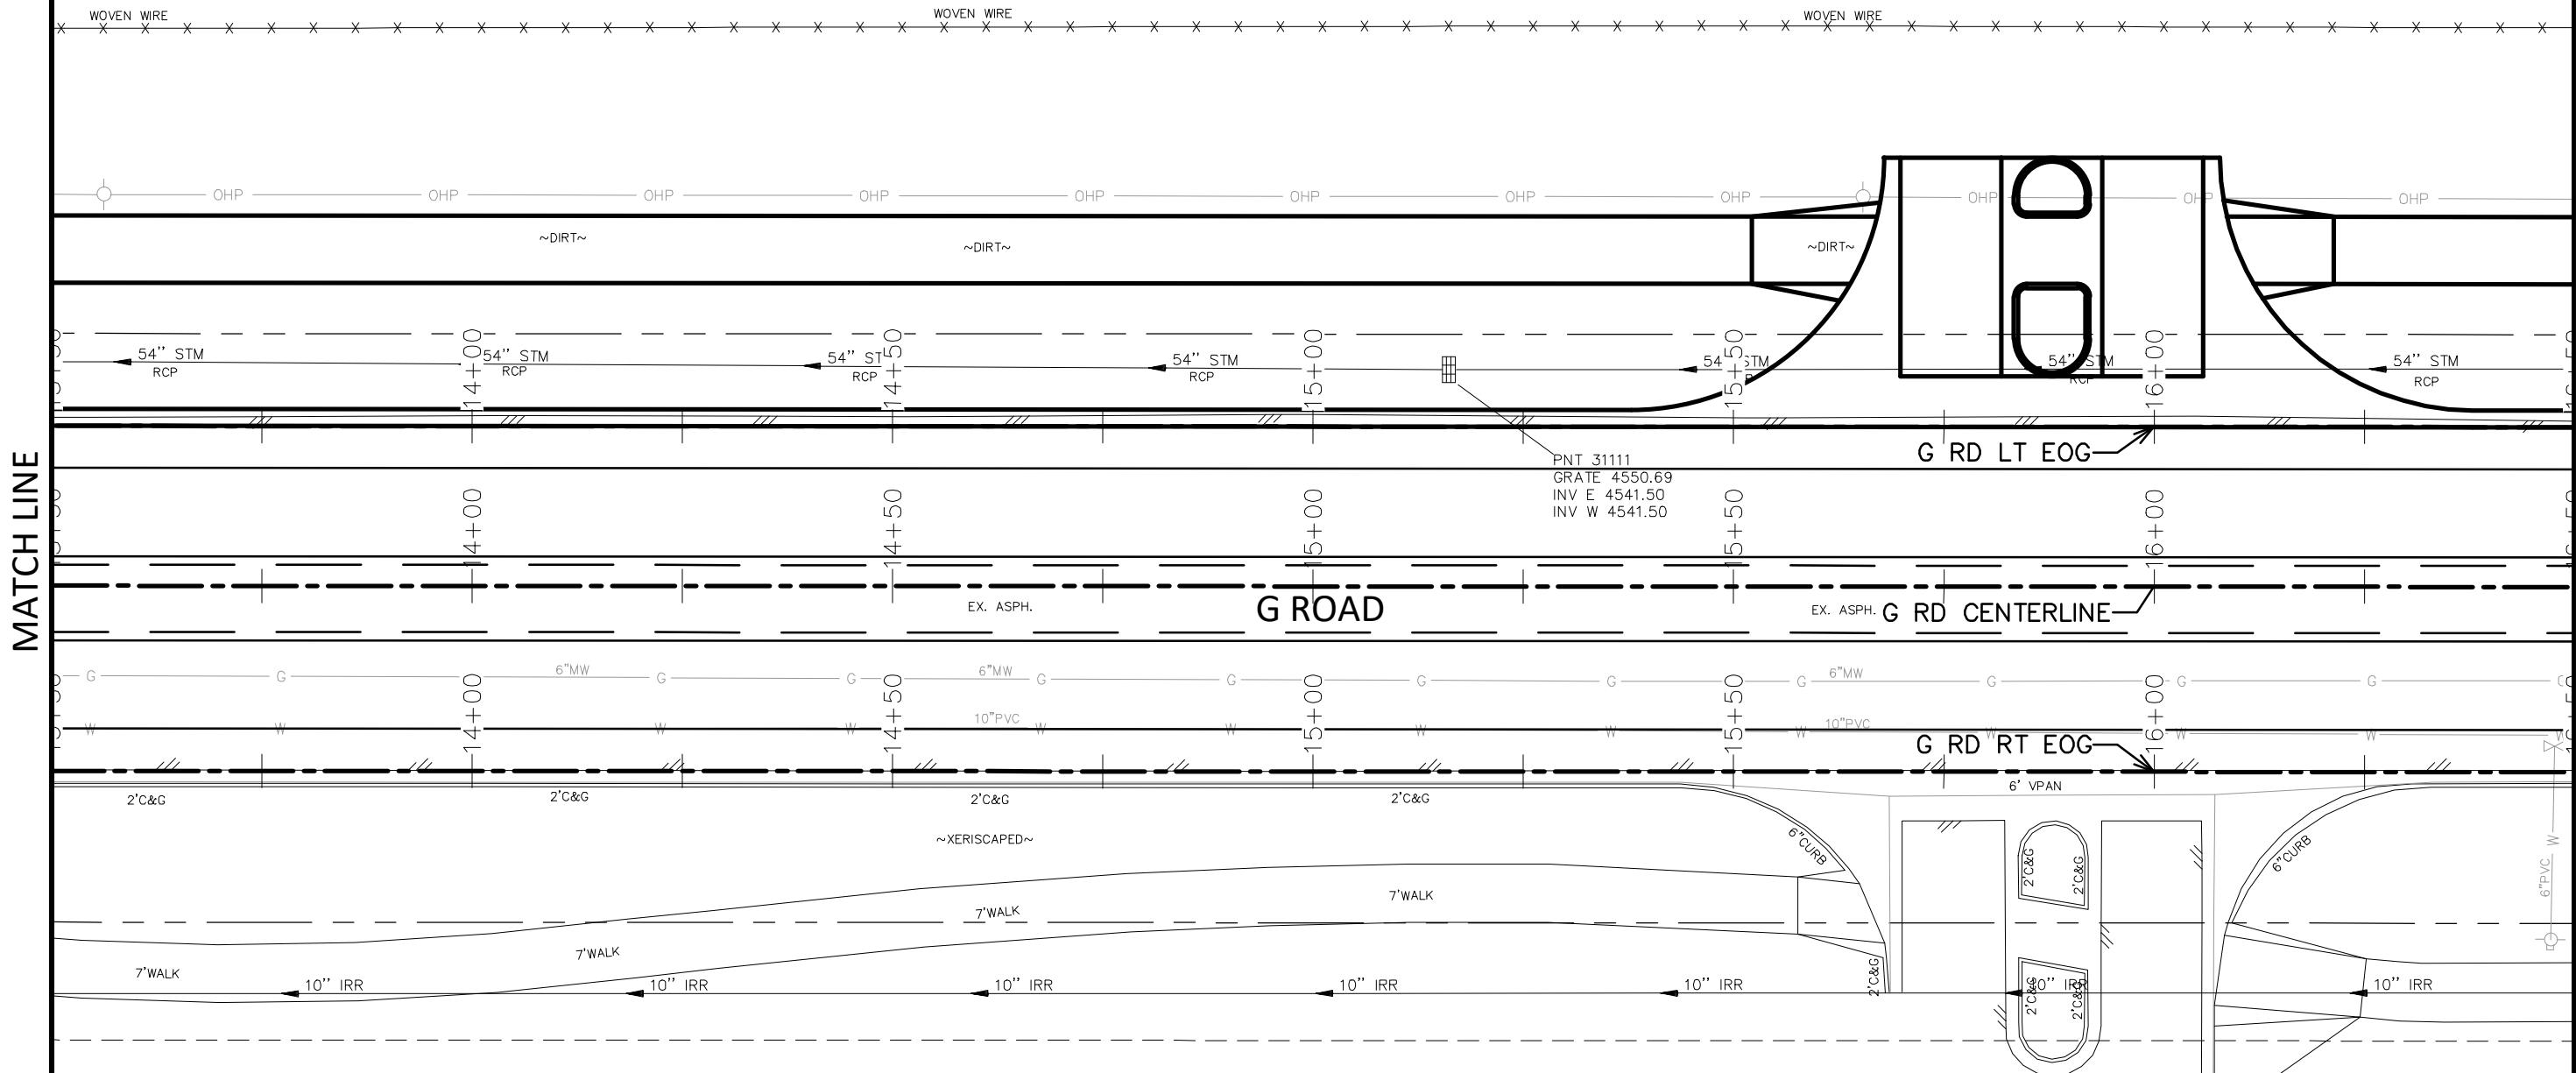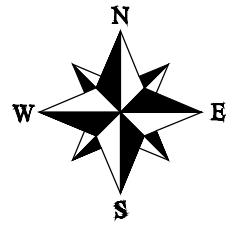

2945-051-17-002
2351 G RD
COLORADO WEST HEALTHCARE SYSTEM
COMMUNITY HOSPITAL

DESCRIPTION	DATE
REVISION A REV 1	- DATE
REVISION A REV 2	- DATE
REVISION A REV 3	- DATE
REVISION A REV 4	- DATE



DRAWN BY	JCS	DATE	2020	SCALE
DESIGNED BY	JCS	DATE	2020	
CHECKED BY	ALC	DATE	2020	
APPROVED BY	TCP	DATE	2020	

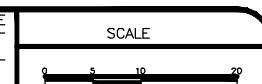

PUBLIC WORKS
ENGINEERING DIVISION
PROJECT NO. 207-F1903

24 ROAD AND G ROAD
IMPROVEMENT PLAN - 027

2701-324-00-097
2372 G RD
CLUB DEAL 127 MERK GRAND JUNCTION

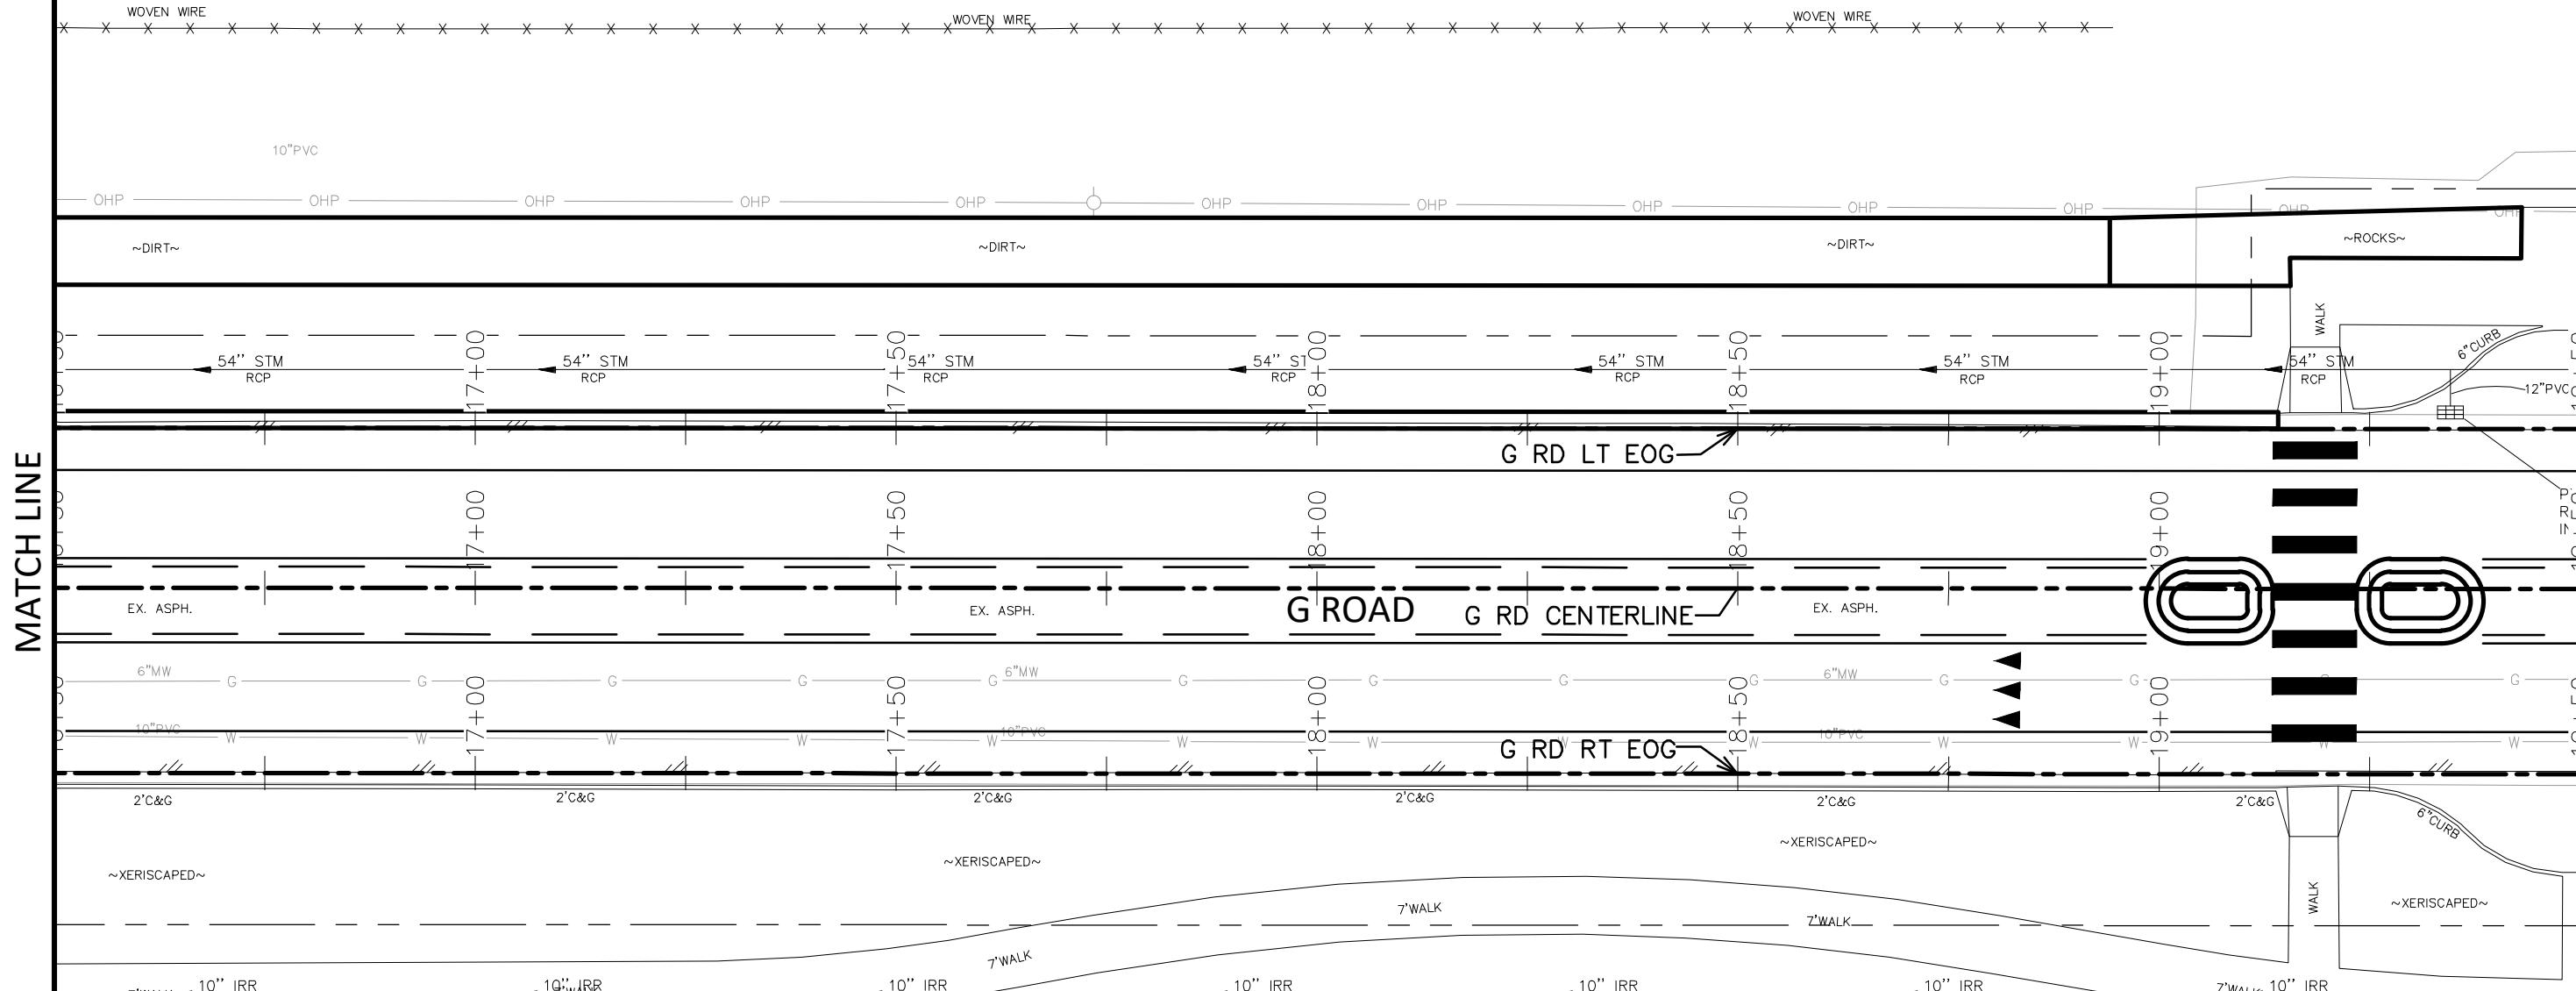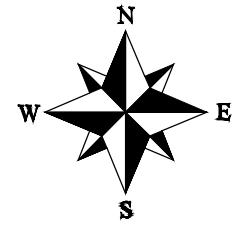

2945-051-17-002
2351 G RD
COLORADO WEST HEALTHCARE SYSTEM
COMMUNITY HOSPITAL

DESCRIPTION	DATE
REVISION A REV 1	- DATE
REVISION A REV 2	- DATE
REVISION A REV 3	- DATE
REVISION A REV 4	- DATE


DRAWN BY	JCS	DATE 2020	SCALE
DESIGNED BY	JCS	DATE 2020	
CHECKED BY	ALC	DATE 2020	
APPROVED BY	TCP	DATE 2020	



PUBLIC WORKS
ENGINEERING DIVISION
PROJECT NO. 207-F1903


24 ROAD AND G ROAD
IMPROVEMENT PLAN - 028

2701-324-00-097
2372 G RD
CLUB DEAL 127 MERK GRAND JUNCTION

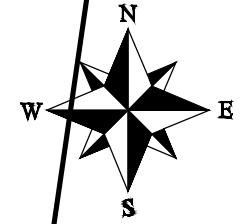

MATCH LINE


MATCH LINE

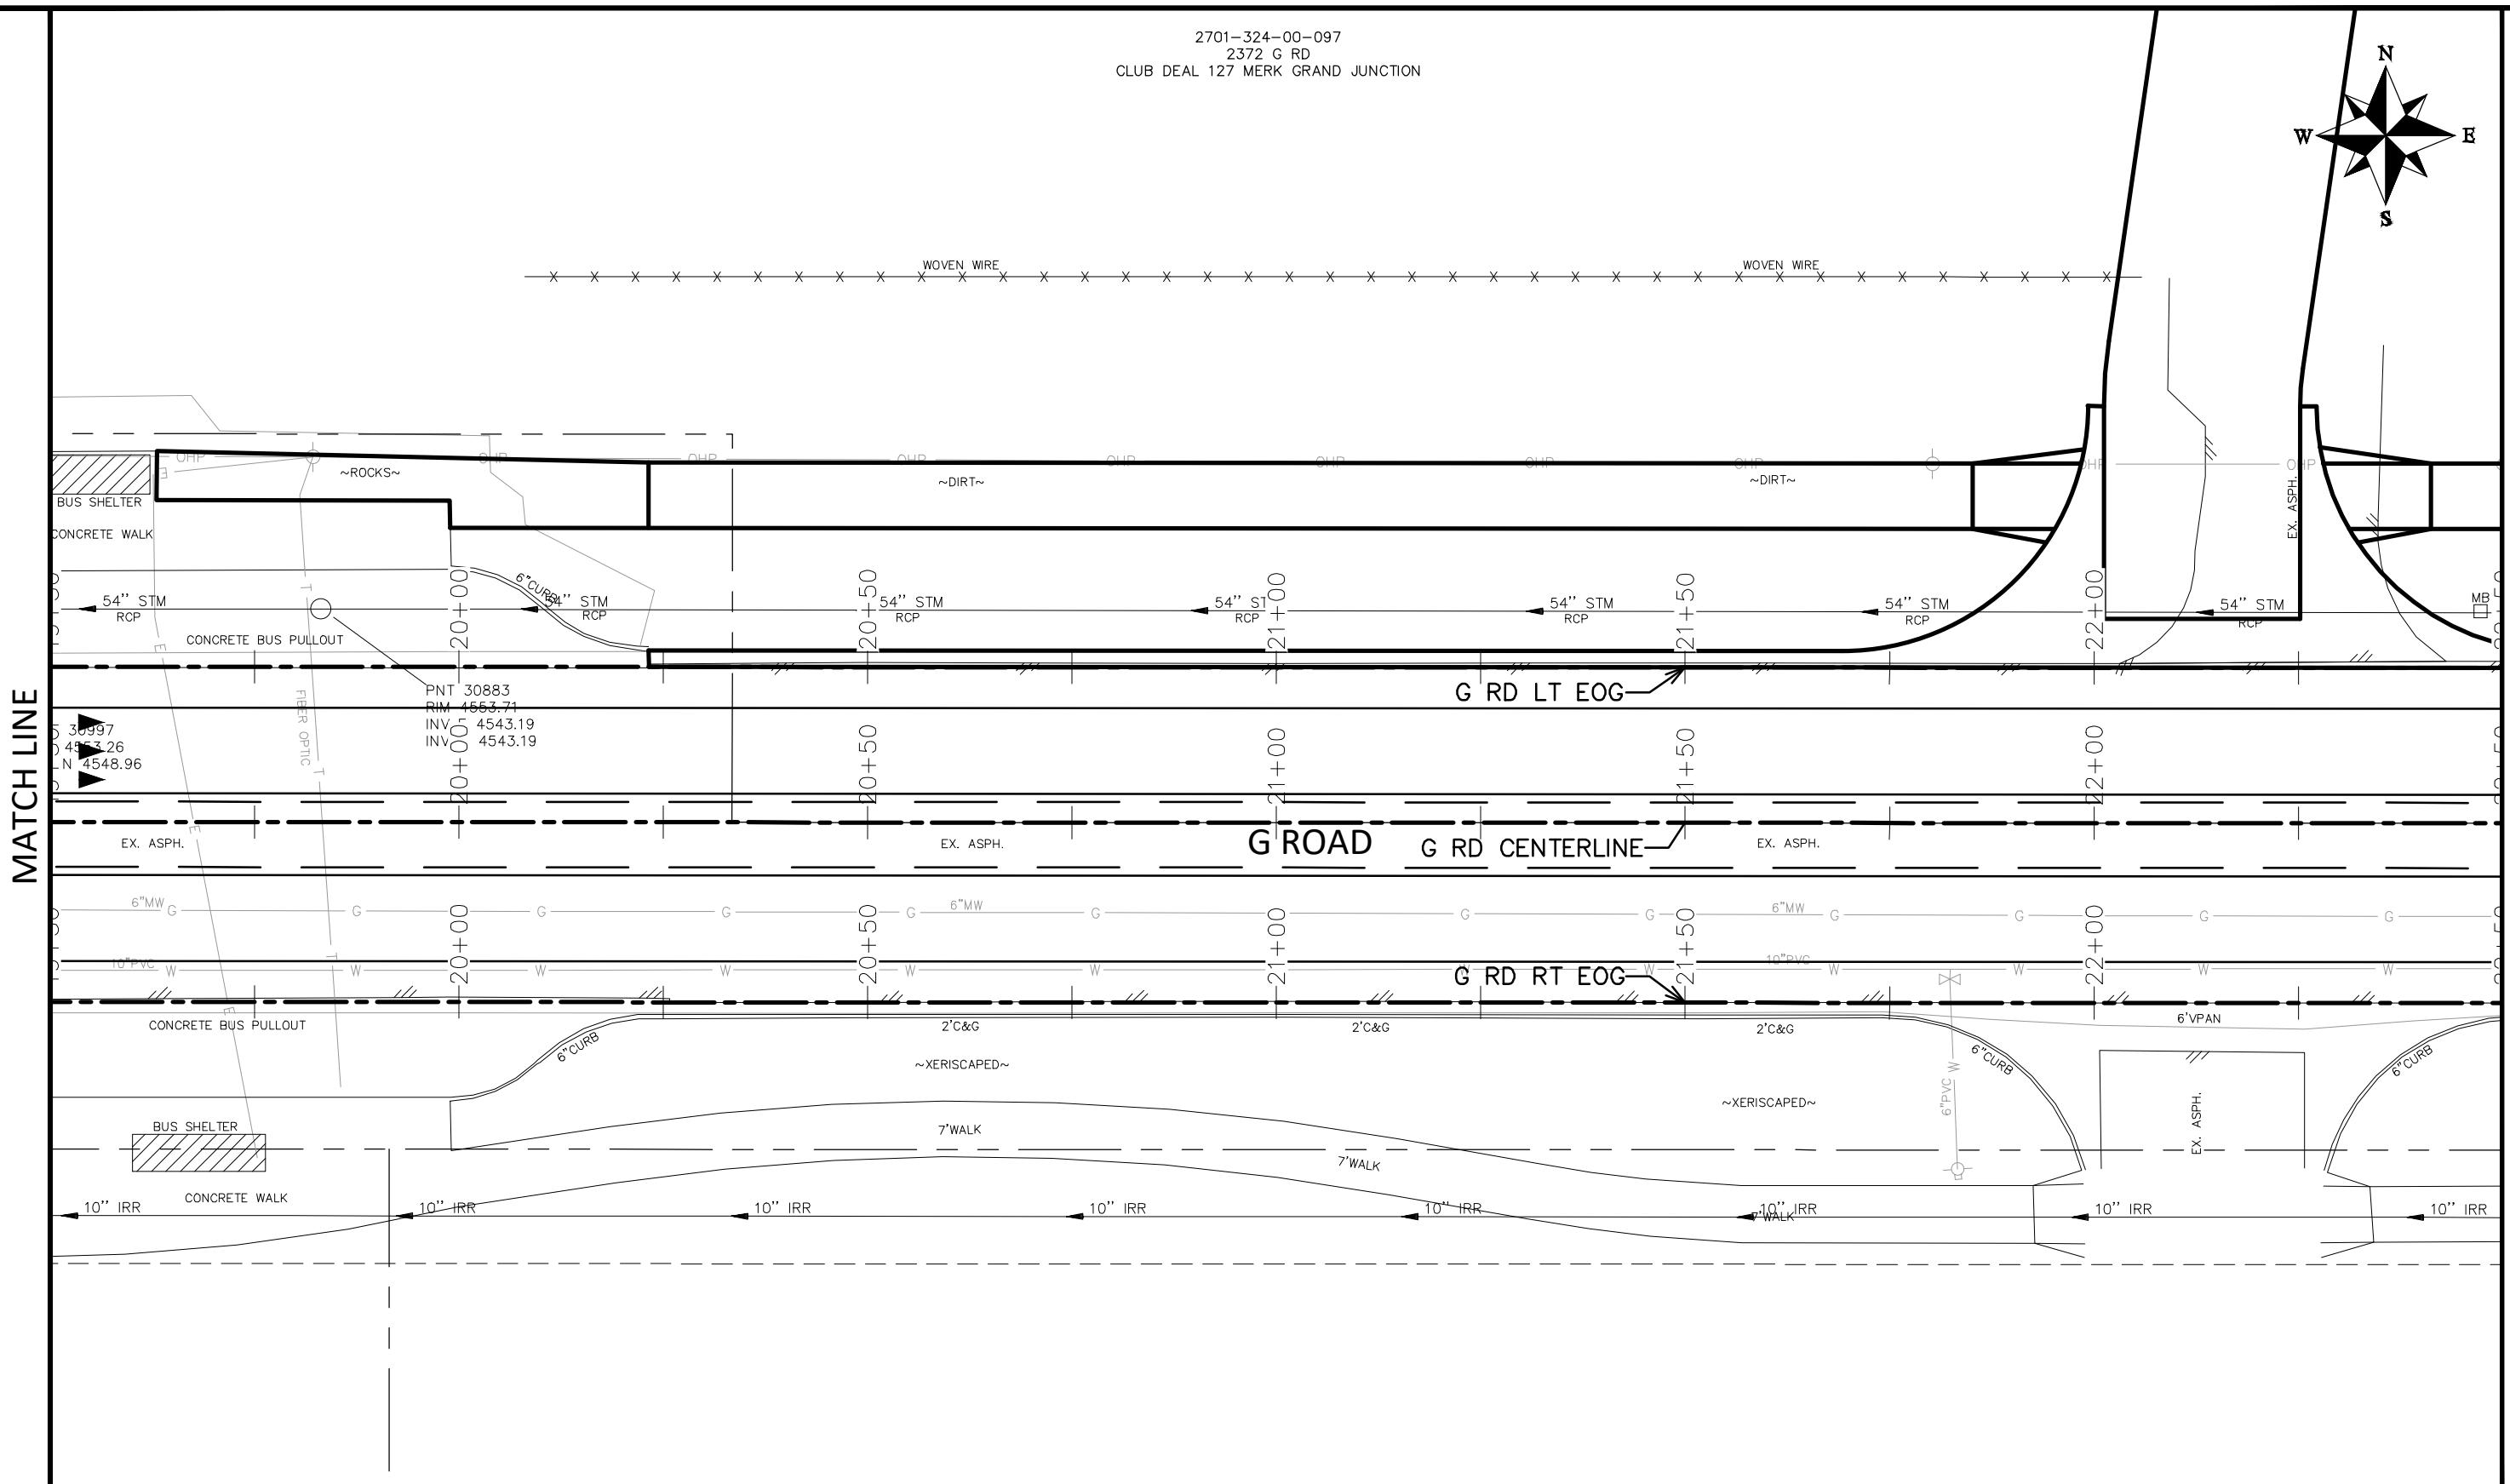

2945-051-17-002
2351 G RD
COLORADO WEST HEALTHCARE SYSTEM
COMMUNITY HOSPITAL

2945-051-17-001
2373 G RD
GAHC4 GRAND JUNCTION CO MOB LLC
CANYON VIEW MEDICAL PLAZA


DESCRIPTION	DATE
REVISION A REV 1	- DATE
REVISION A REV 2	- DATE
REVISION A REV 3	- DATE
REVISION A REV 4	- DATE

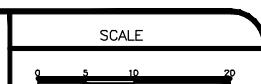

CITY OF
Grand Junction
COLORADO

PUBLIC WORKS
ENGINEERING DIVISION
PROJECT NO. 207-F1903

24 ROAD AND G ROAD
IMPROVEMENT PLAN - 029

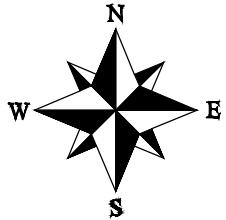


2701-324-00-097
2372 G RD
CLUB DEAL 127 MERK GRAND JUNCTION

2701-324-00-093
Northwest Corner of G and 24 Rd
USHER NV LLC


MATCH LINE

MATCHLINE


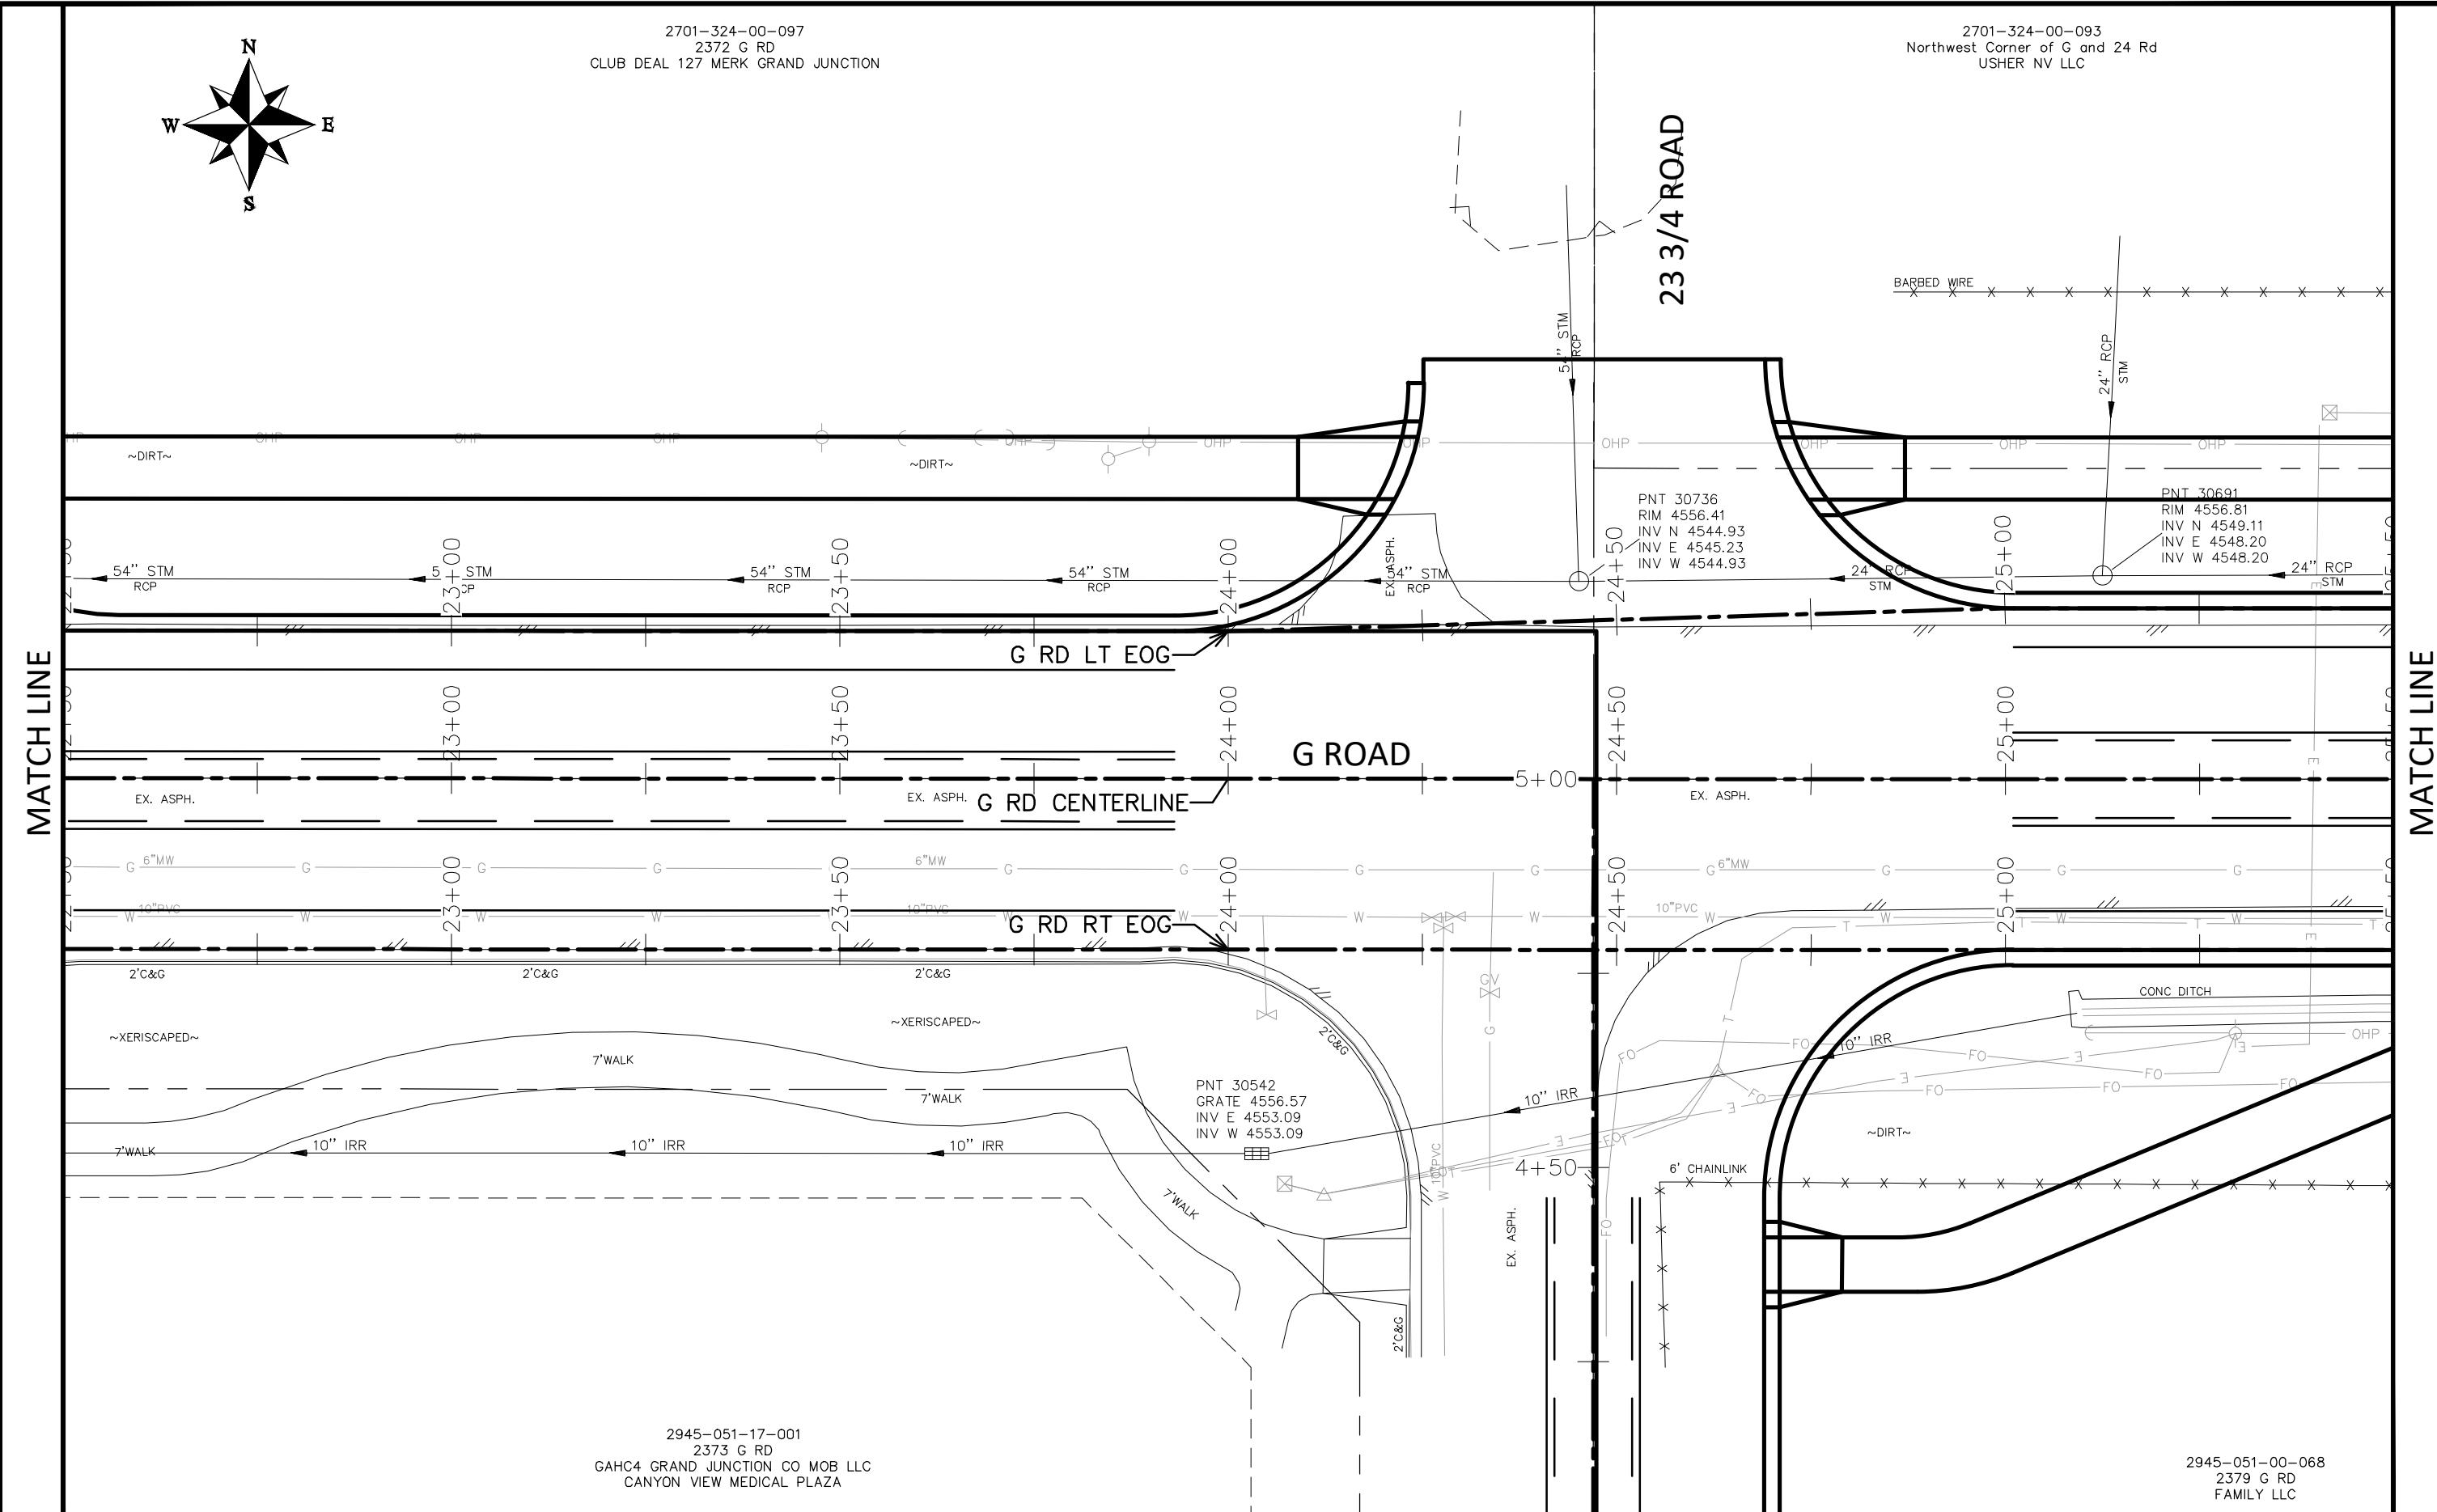


<u>DESCRIPTION</u>	<u>DATE</u>
REVISION A REV 1	DATE
REVISION A REV 2	DATE
REVISION A REV 3	DATE
REVISION A REV 4	DATE

DRAWN BY JCS DATE 2020 SC
DESIGNED BY JCS DATE 2020
CHECKED BY ALC DATE 2020
APPROVED BY JCS DATE 2020

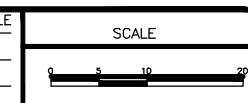


2701-324-00-093
Northwest Corner of G and 24 Rd
USHER NV LLC

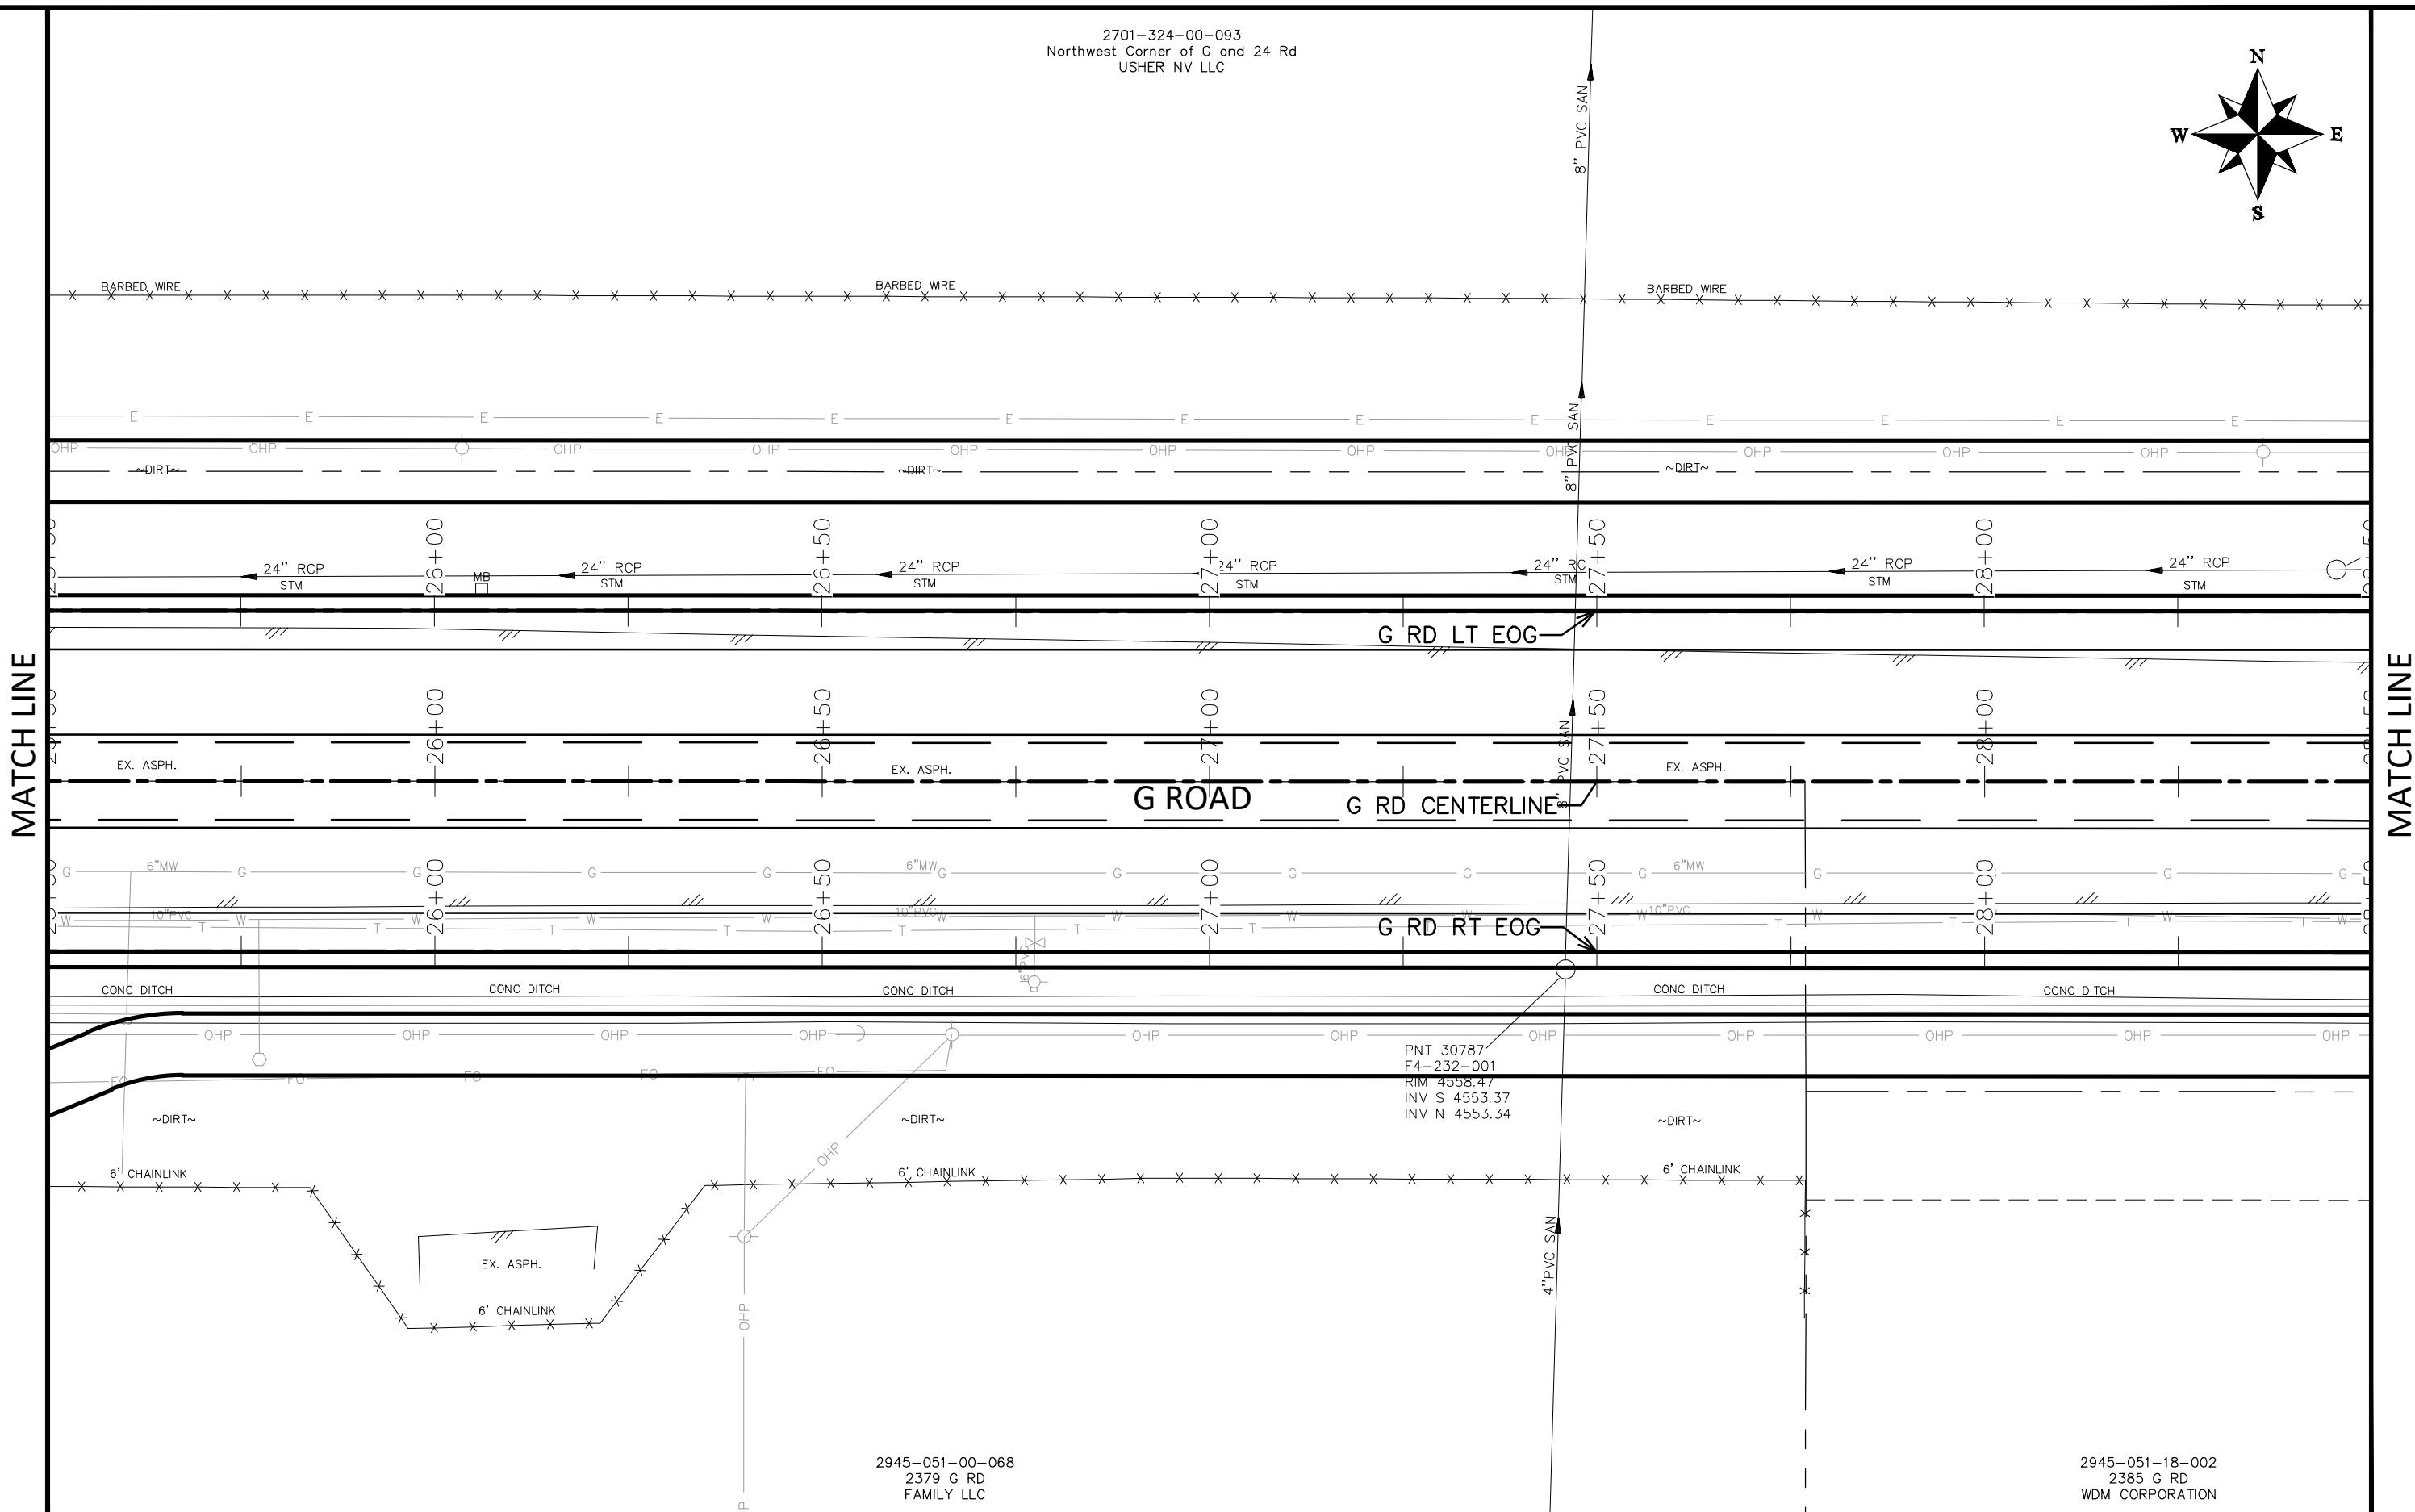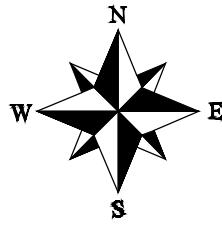

DESCRIPTION	DATE
REVISION A REV 1	- DATE
REVISION A REV 2	- DATE
REVISION A REV 3	- DATE
REVISION A REV 4	- DATE


DRAWN BY	JCS	DATE 2020	SCALE
DESIGNED BY	JCS	DATE 2020	
CHECKED BY	ALC	DATE 2020	
APPROVED BY	TCP	DATE 2020	

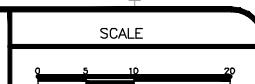

PUBLIC WORKS
ENGINEERING DIVISION
PROJECT NO. 207-F1903


24 ROAD AND G ROAD
IMPROVEMENT PLAN - 031

2945-051-18-002
2385 G RD
WDM CORPORATION

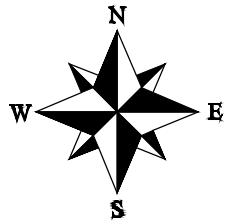

MATCH LINE


MATCH LINE

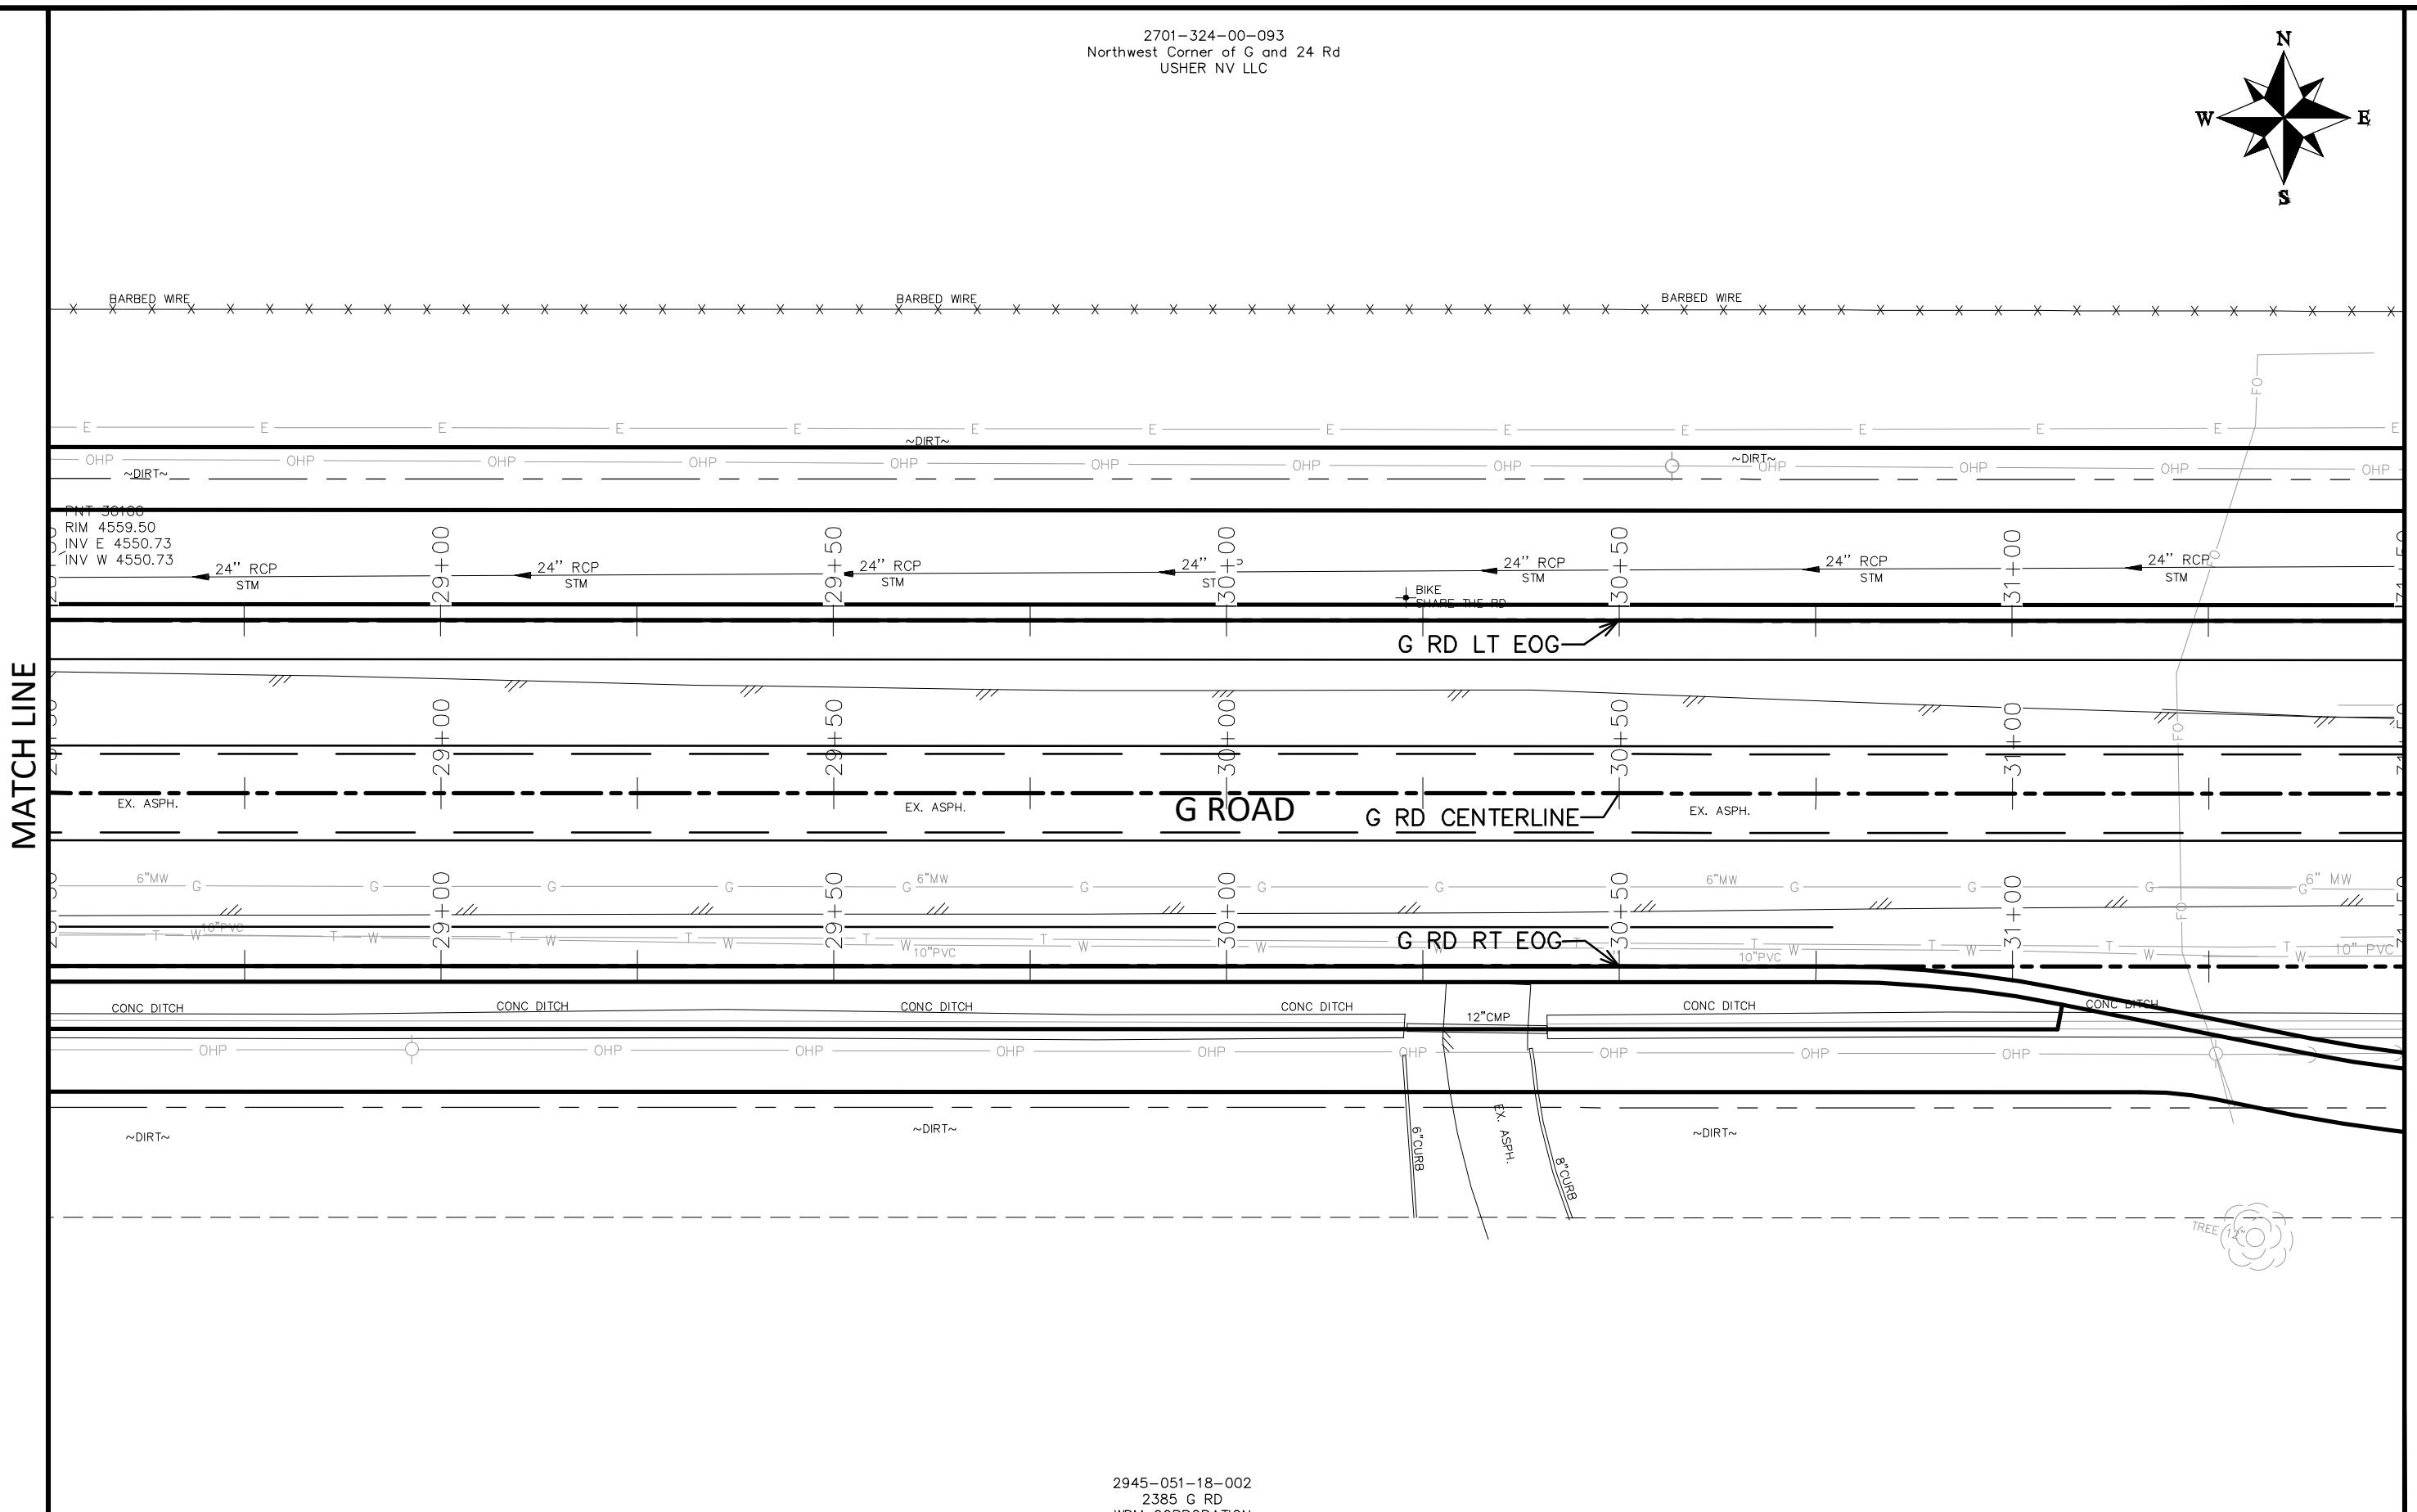

2945-051-18-002
2385 G RD
WDM CORPORATION

DESCRIPTION	DATE
REVISION A REV 1	- DATE
REVISION A REV 2	- DATE
REVISION A REV 3	- DATE
REVISION A REV 4	- DATE

DRAWN BY	JCS	DATE	2020	SCALE
DESIGNED BY	JCS	DATE	2020	
CHECKED BY	ALC	DATE	2020	
APPROVED BY	TCP	DATE	2020	

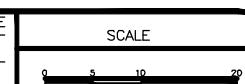


PUBLIC WORKS
ENGINEERING DIVISION
PROJECT NO. 207-F1903

24 ROAD AND G ROAD
IMPROVEMENT PLAN - 032

CONSTRUCTION NOTES


1 202 – REMOVAL OF ASPHALT MAT. CUT AND REMOVE ASPHALT AS SHOWN. (INDICATED BY DOT HATCH PATTERN)

2701-324-00-093
Northwest Corner of G and 24 R
USHER NV LLC

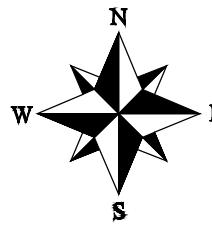

MATCH LINE

MATCHLINE

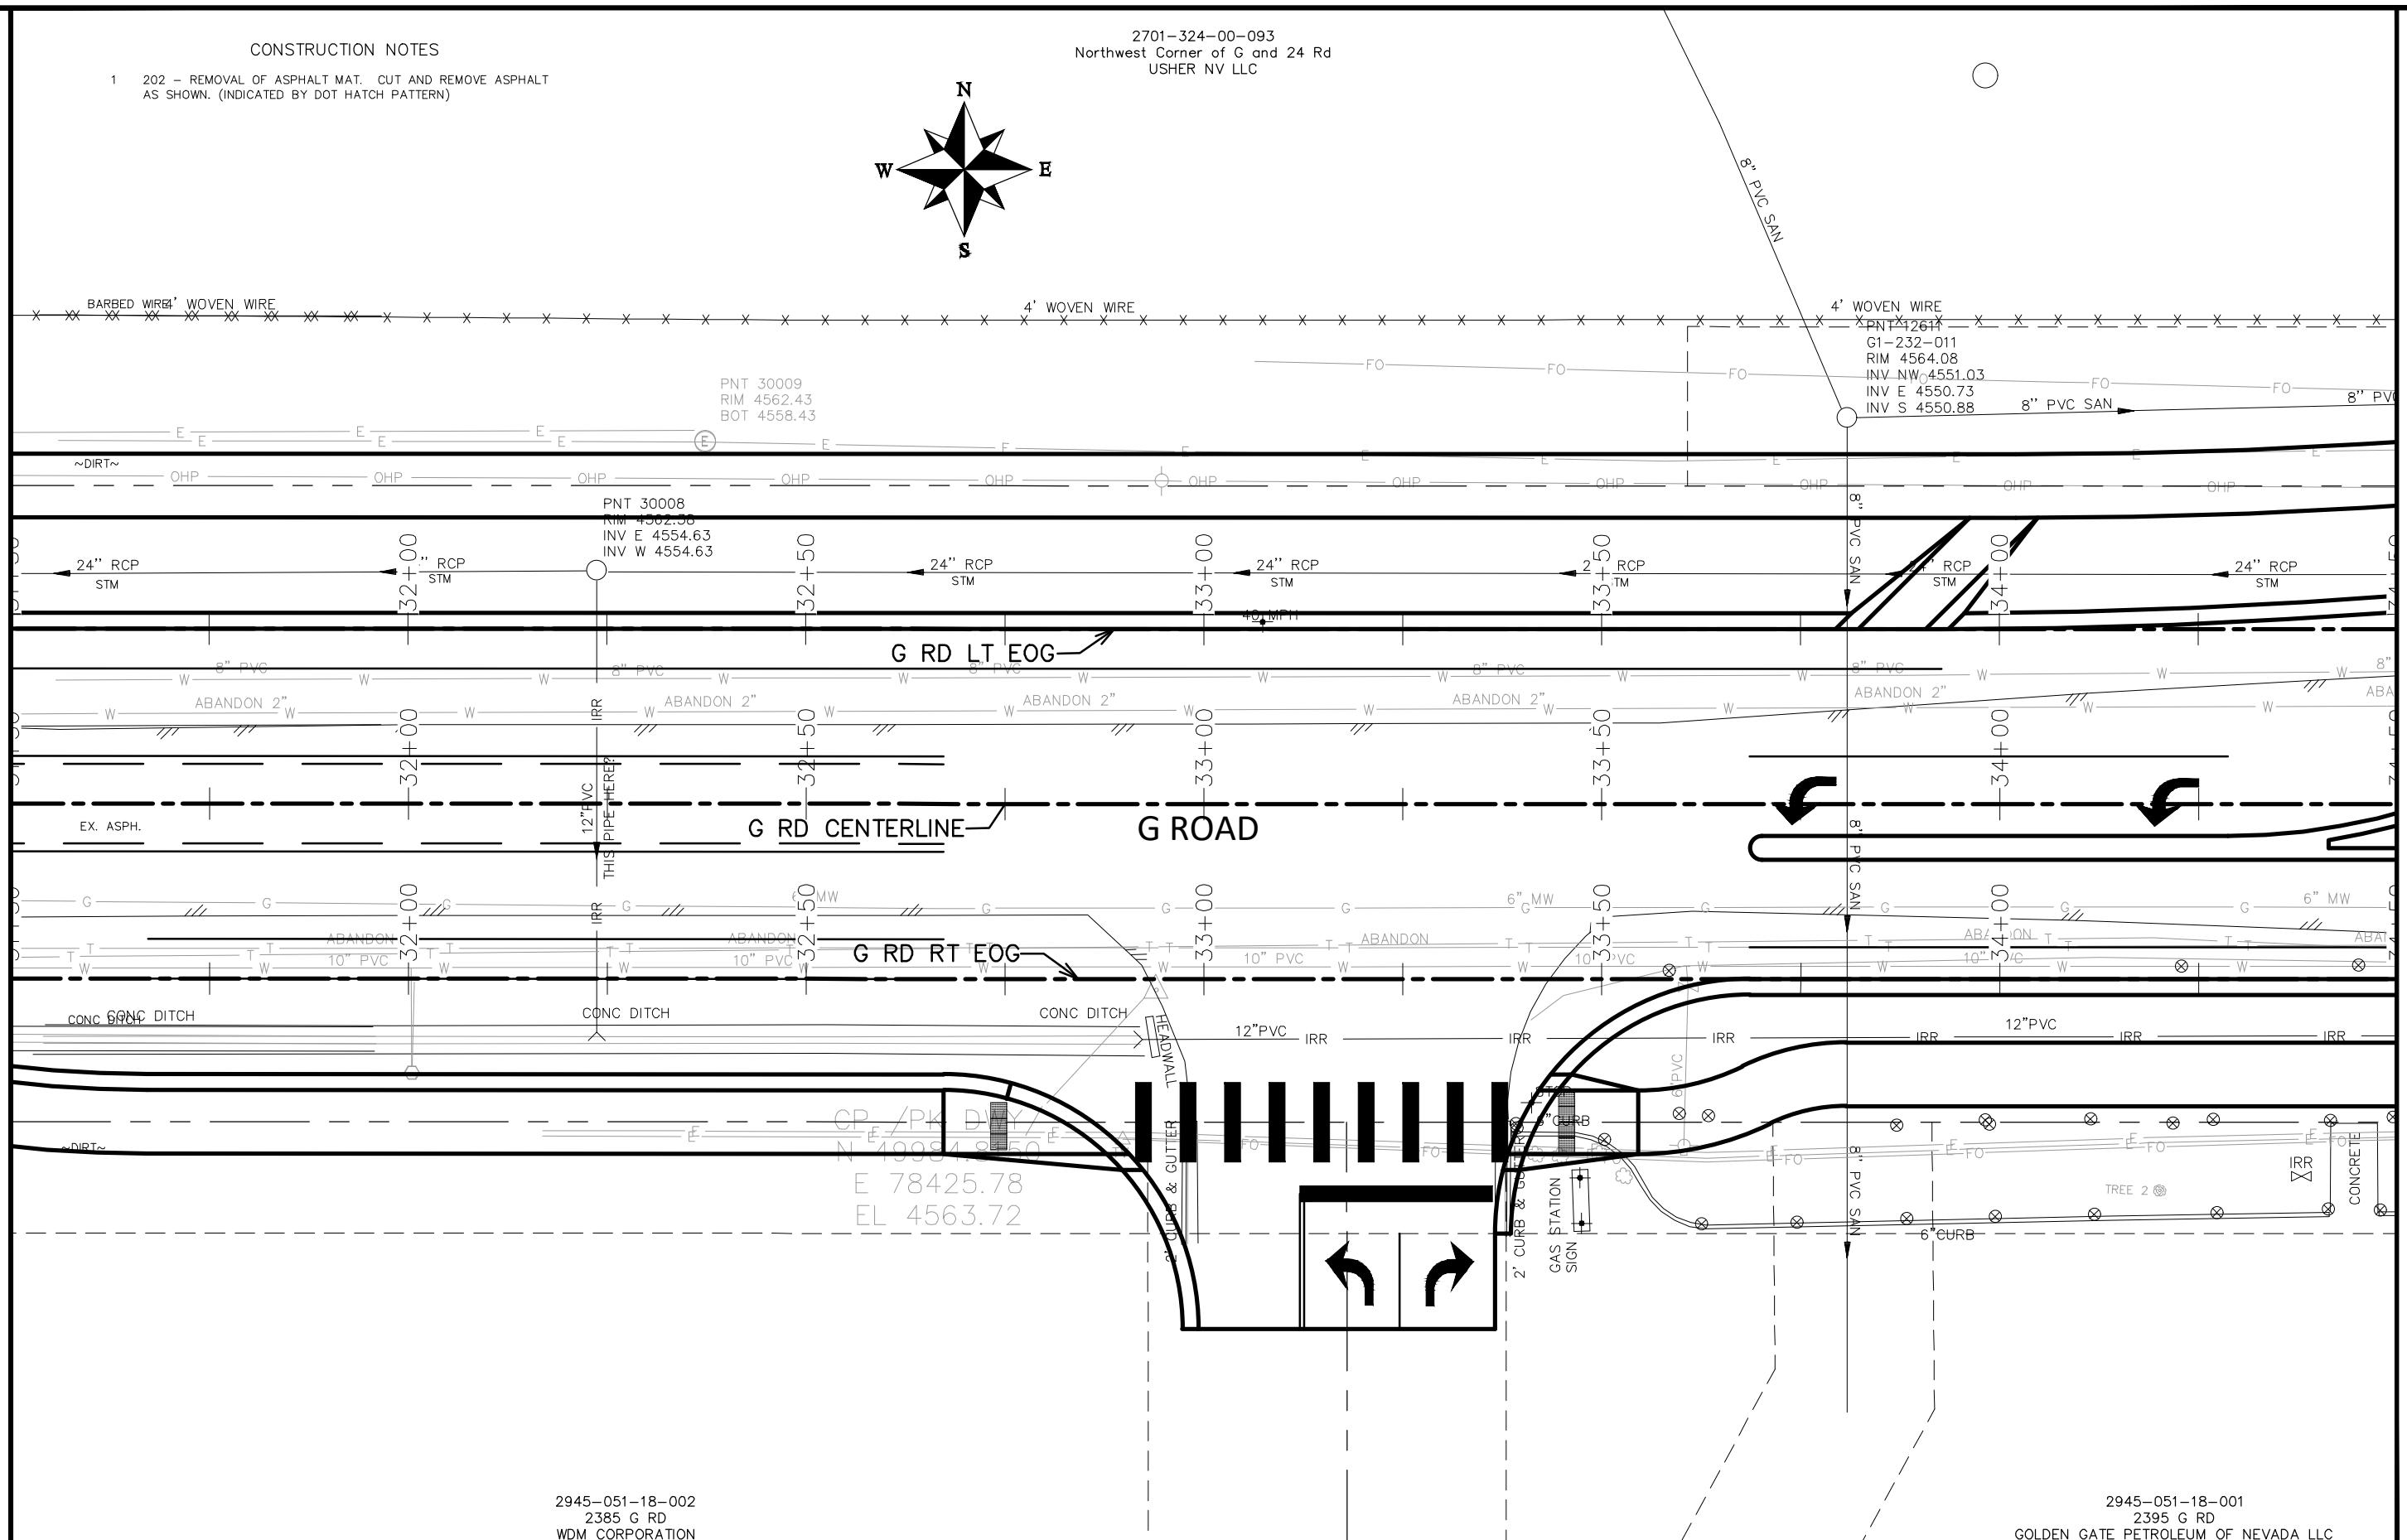


2945-051-18-001
2385 G RD
WDM CORPORATION

The logo for the City of Grand Junction, Colorado. It features the words "CITY OF" in a small, sans-serif font above the word "Grand Junction" in a large, bold, serif font. Below "Grand Junction" is the word "COLORADO" in a smaller, all-caps, sans-serif font. A stylized, grey, winding line graphic starts from the bottom left, goes up and around the letter "G", then down and around the letter "J", ending near the bottom right.


PUBLIC WORKS
ENGINEERING DIVISION
PROJECT NO.207-F1903

24 ROAD AND G ROAD
IMPROVEMENT PLAN - 033

<u>DESCRIPTION</u>	<u>DATE</u>	DRAWN BY <u>JCS</u>	DATE <u>2020</u>	SCALE
REVISION <u>A</u> REV 1	- DATE	DESIGNED BY <u>JCS</u>	DATE <u>2020</u>	
REVISION <u>A</u> REV 2	- DATE	CHECKED BY <u>ALC</u>	DATE <u>2020</u>	
REVISION <u>A</u> REV 3	- DATE	APPROVED BY <u>TCP</u>	DATE <u>2020</u>	
REVISION <u>A</u> REV 4	- DATE			

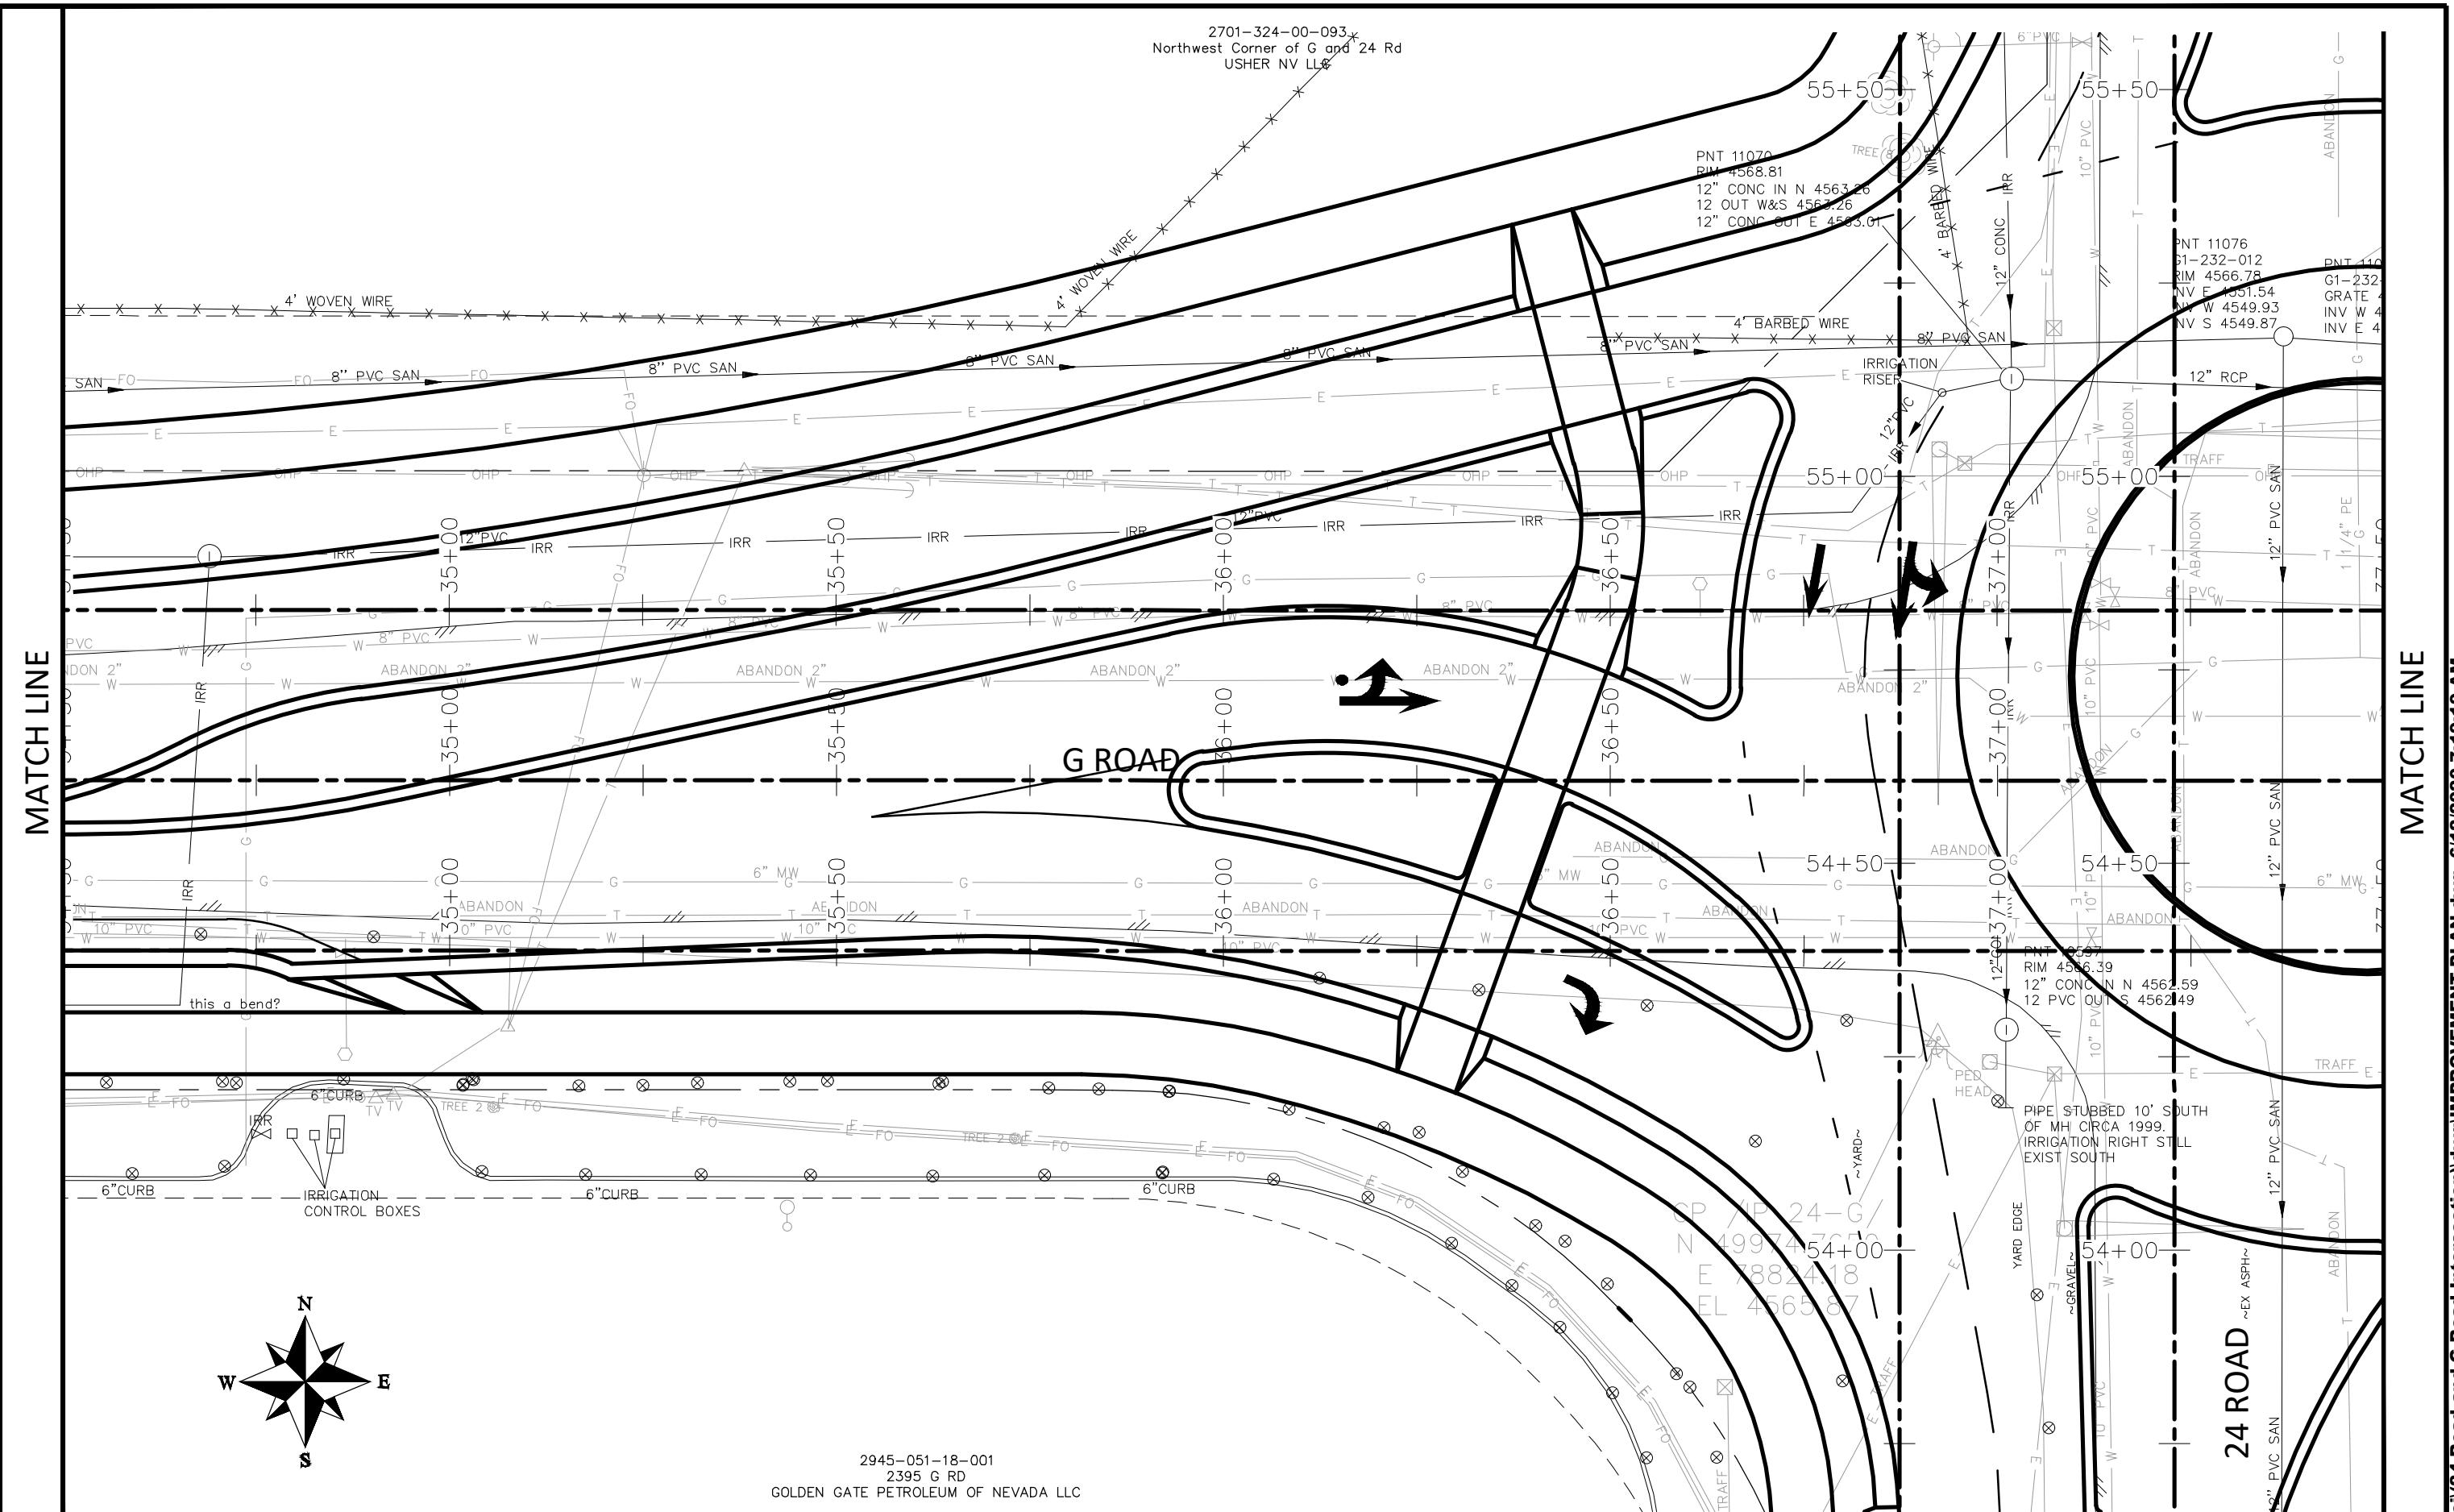

<u>DESCRIPTION</u>	<u>DATE</u>	<u>DRAWN BY</u>	<u>JCS</u>	<u>DATE</u>	<u>2020</u>
REVISION <u>A</u> REV 1	- DATE	DESIGNED BY	<u>JCS</u>	DATE	<u>2020</u>
REVISION <u>B</u> REV 2	- DATE	CHECKED BY	<u>ALC</u>	DATE	<u>2020</u>
REVISION <u>C</u> REV 3	- DATE	APPROVED BY	<u>TCP</u>	DATE	<u>2020</u>
REVISION <u>D</u> REV 4	- DATE				

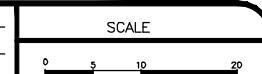


2945-051-18-001
2395 G RD
GOLDEN GATE PETROLEUM OF NEVADA LLC


CITY OF
Grand Junction
COLORADO

PUBLIC WORKS
ENGINEERING DIVISION
PROJECT NO.207-F1903

24 ROAD AND G ROAD
IMPROVEMENT PLAN - 034

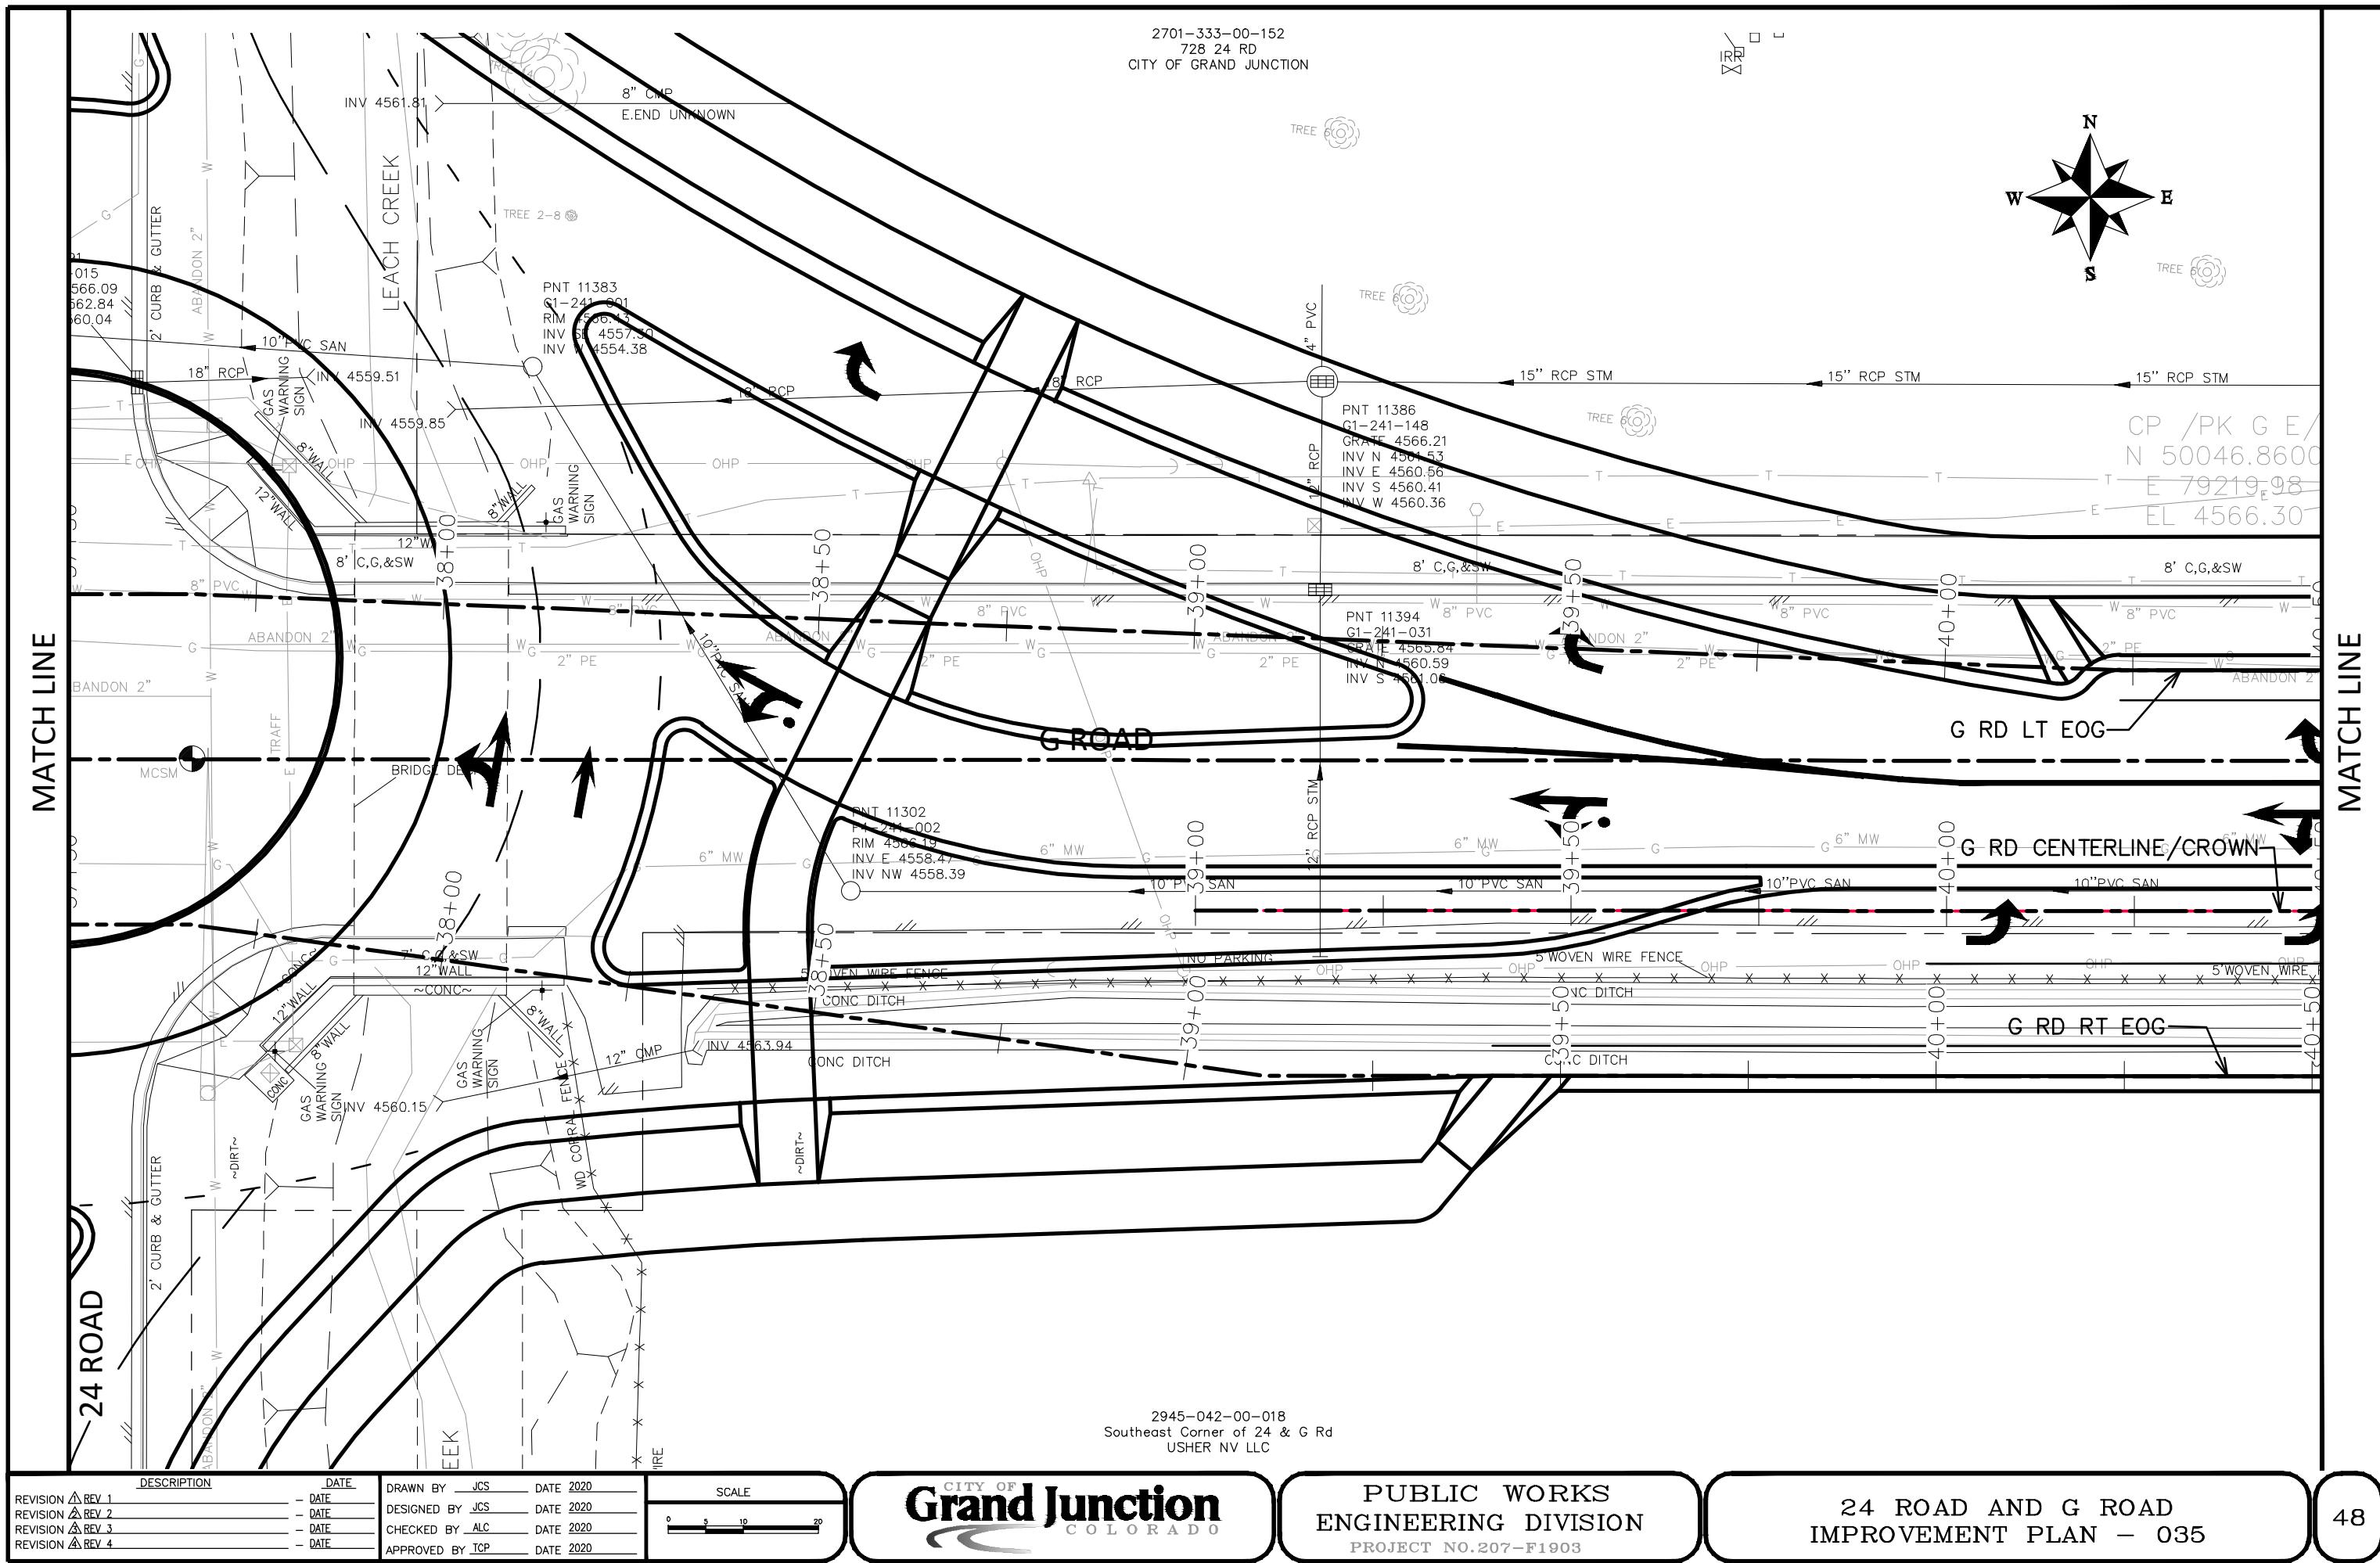


2701-333-00-152
728 24 RD
CITY OF GRAND JUNCTION

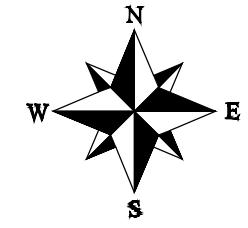

MATCH LINE

MATCH LINE

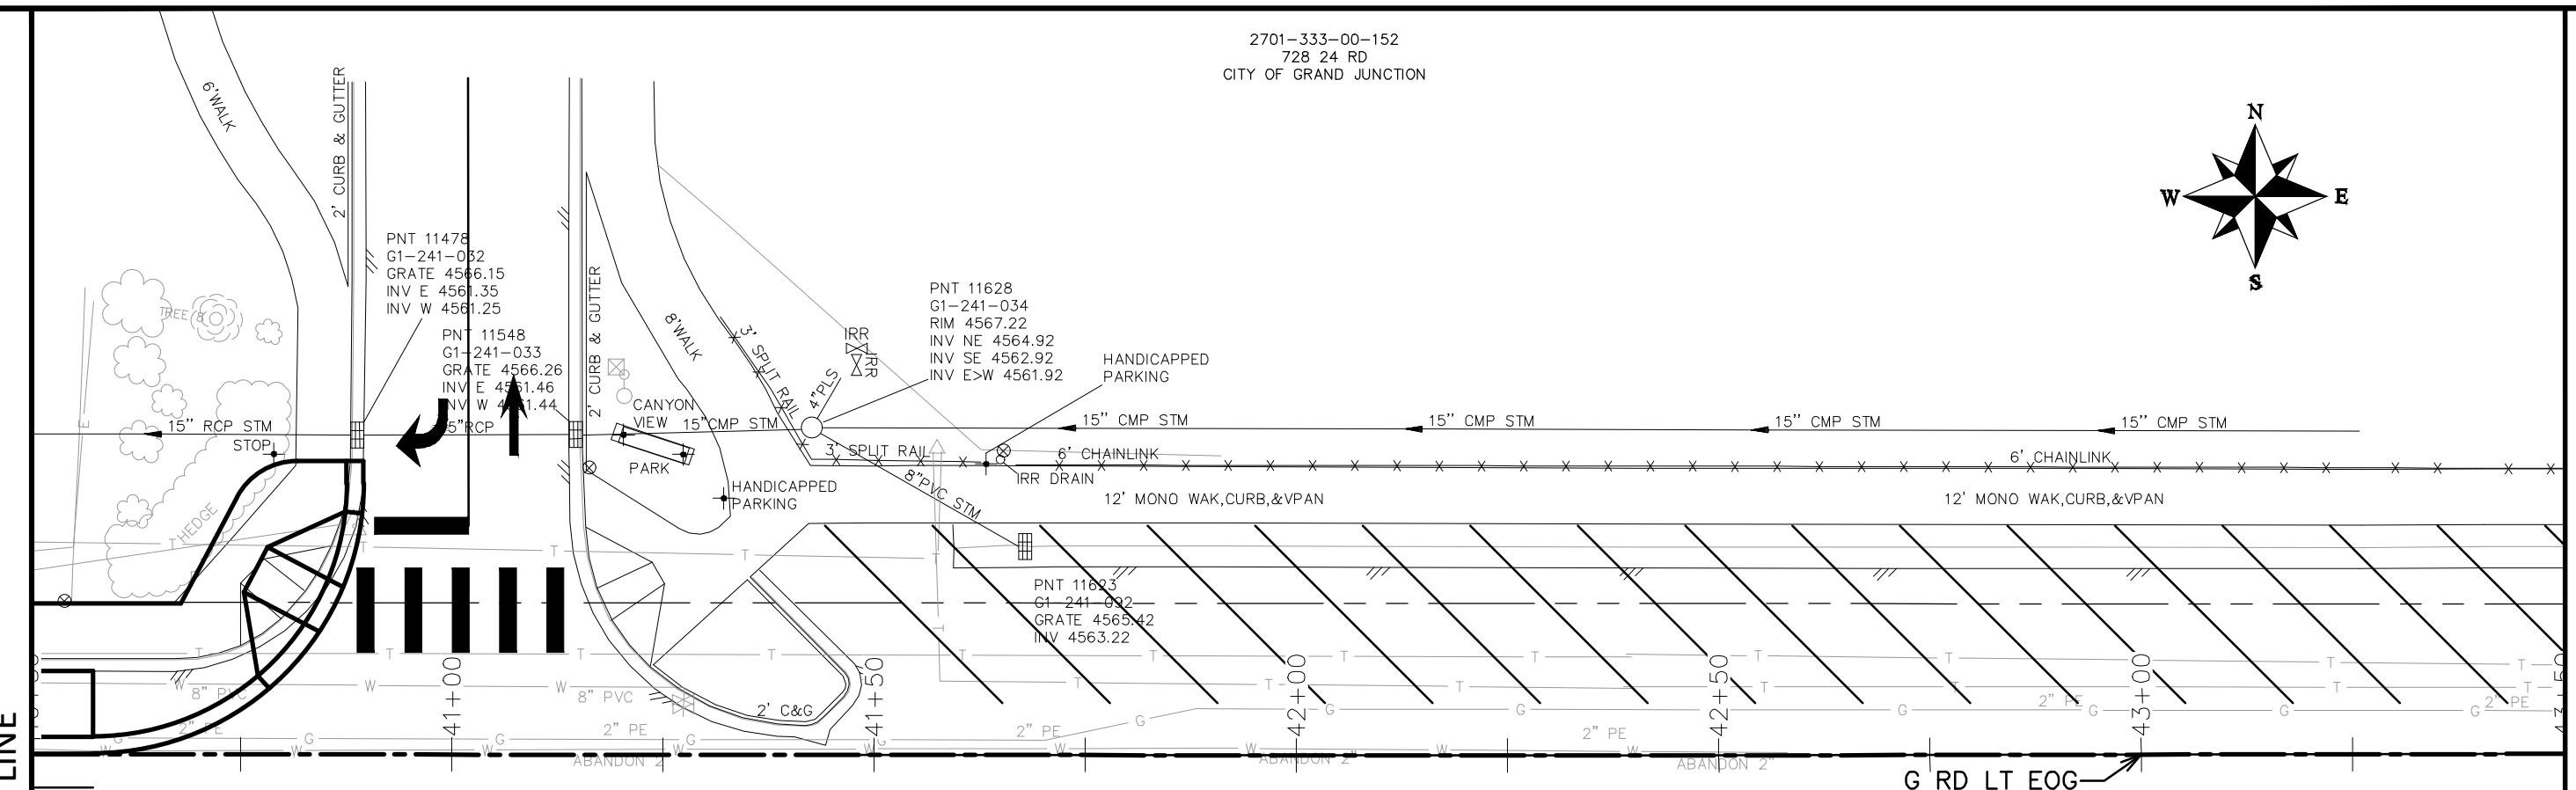

MATCH

MATCH

2945-042-00-018
Southeast Corner of 24 & G Rd
USHER NV LLC

<u>DESCRIPTION</u>	<u>DATE</u>	DRAWN BY <u>JCS</u> DATE <u>2020</u>
REVISION <u>A</u> REV <u>1</u>	- DATE	DESIGNED BY <u>JCS</u> DATE <u>2020</u>
REVISION <u>A</u> REV <u>2</u>	- DATE	CHECKED BY <u>ALC</u> DATE <u>2020</u>
REVISION <u>A</u> REV <u>3</u>	- DATE	APPROVED BY <u>TCP</u> DATE <u>2020</u>
REVISION <u>A</u> REV <u>4</u>	- DATE	



SCALE

**CITY OF
Grand Junction
COLORADO**

PUBLIC WORKS
ENGINEERING DIVISION
PROJECT NO. 207-F1903

24 ROAD AND G ROAD
IMPROVEMENT PLAN - 036

2701-333-00-152
728 24 RD
CITY OF GRAND JUNCTION

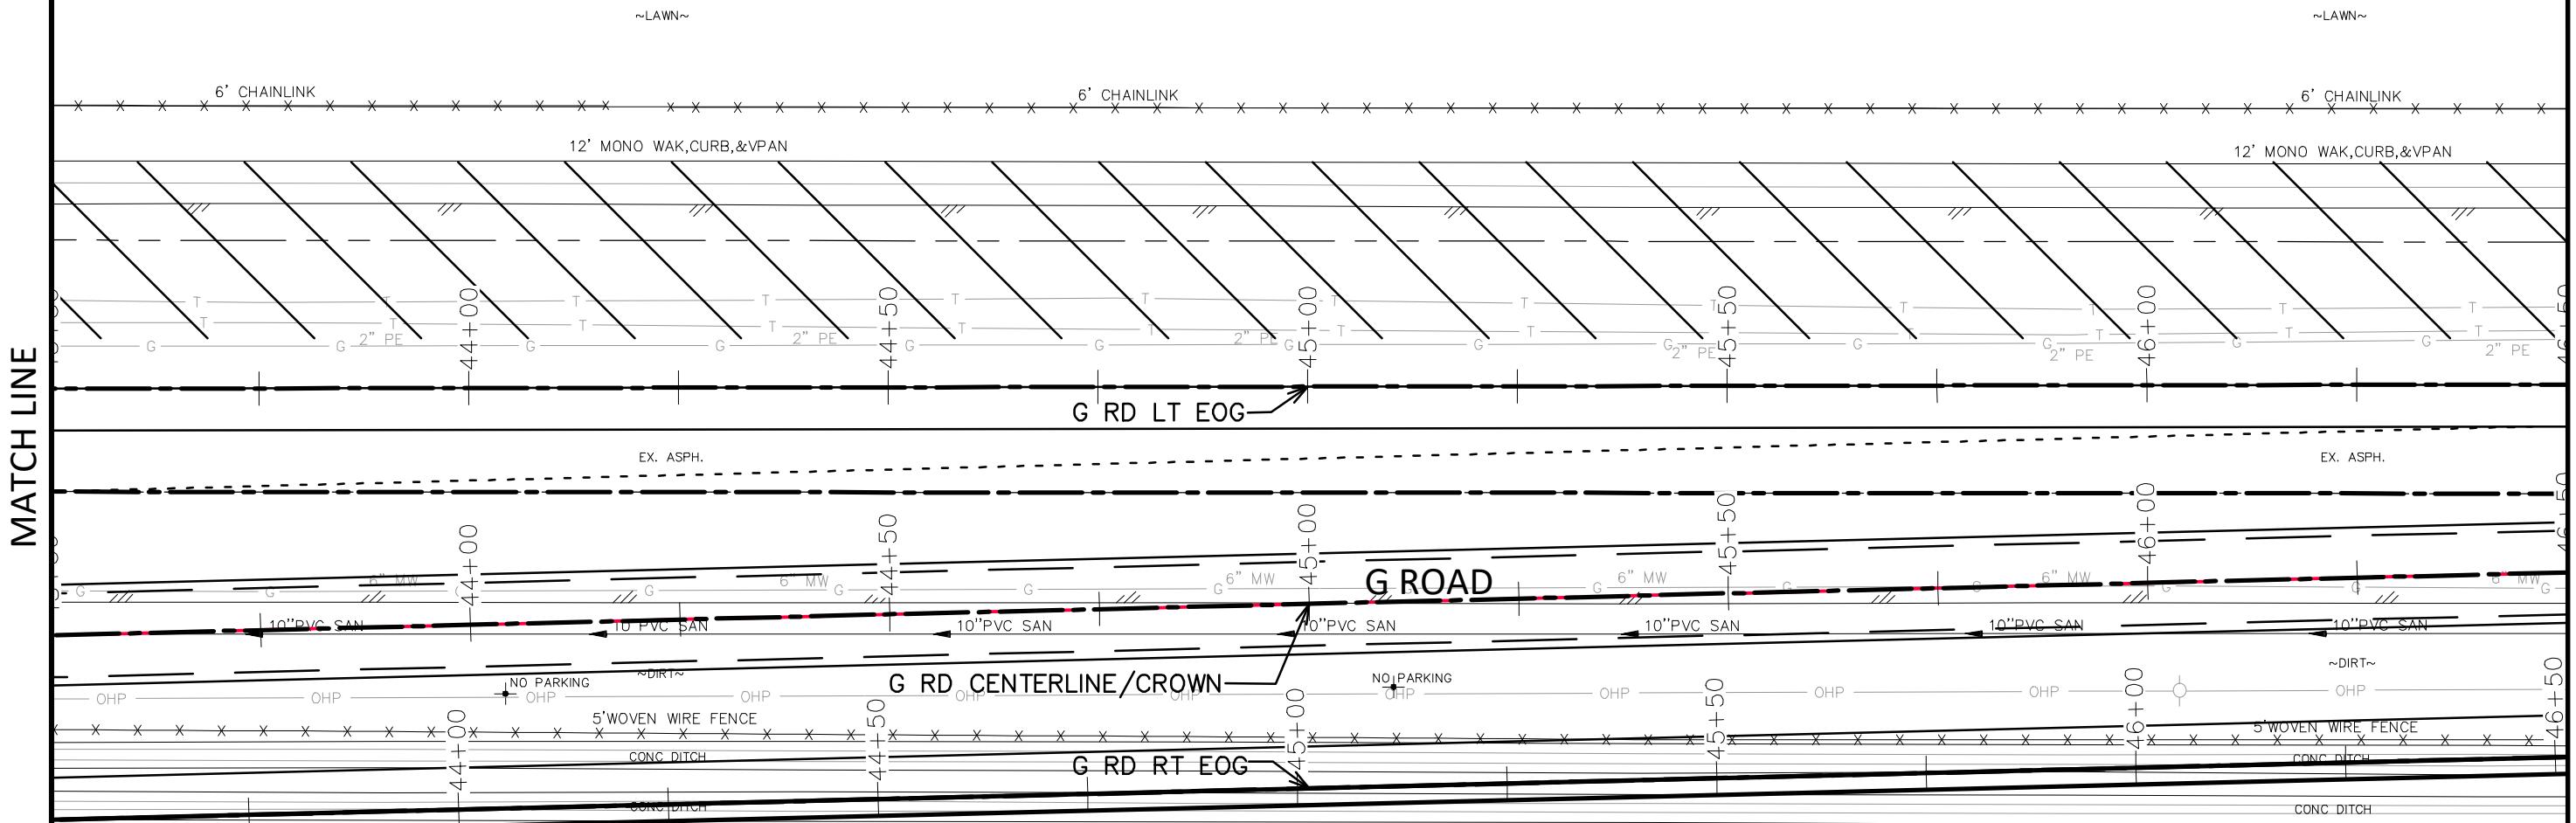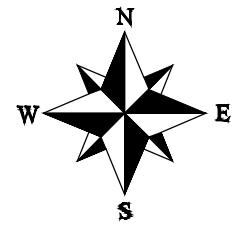

2945-042-00-018
Southeast Corner of 24 & G Rd
USHER NV LLC

DESCRIPTION	DATE
REVISION A REV 1	- DATE
REVISION A REV 2	- DATE
REVISION A REV 3	- DATE
REVISION A REV 4	- DATE



DRAWN BY	JCS	DATE	2020
DESIGNED BY	JCS	DATE	2020
CHECKED BY	ALC	DATE	2020
APPROVED BY	TCP	DATE	2020

SCALE
0 5 10 20

CITY OF
Grand Junction
COLORADO

PUBLIC WORKS
ENGINEERING DIVISION
PROJECT NO. 207-F1903

24 ROAD AND G ROAD
IMPROVEMENT PLAN - 037

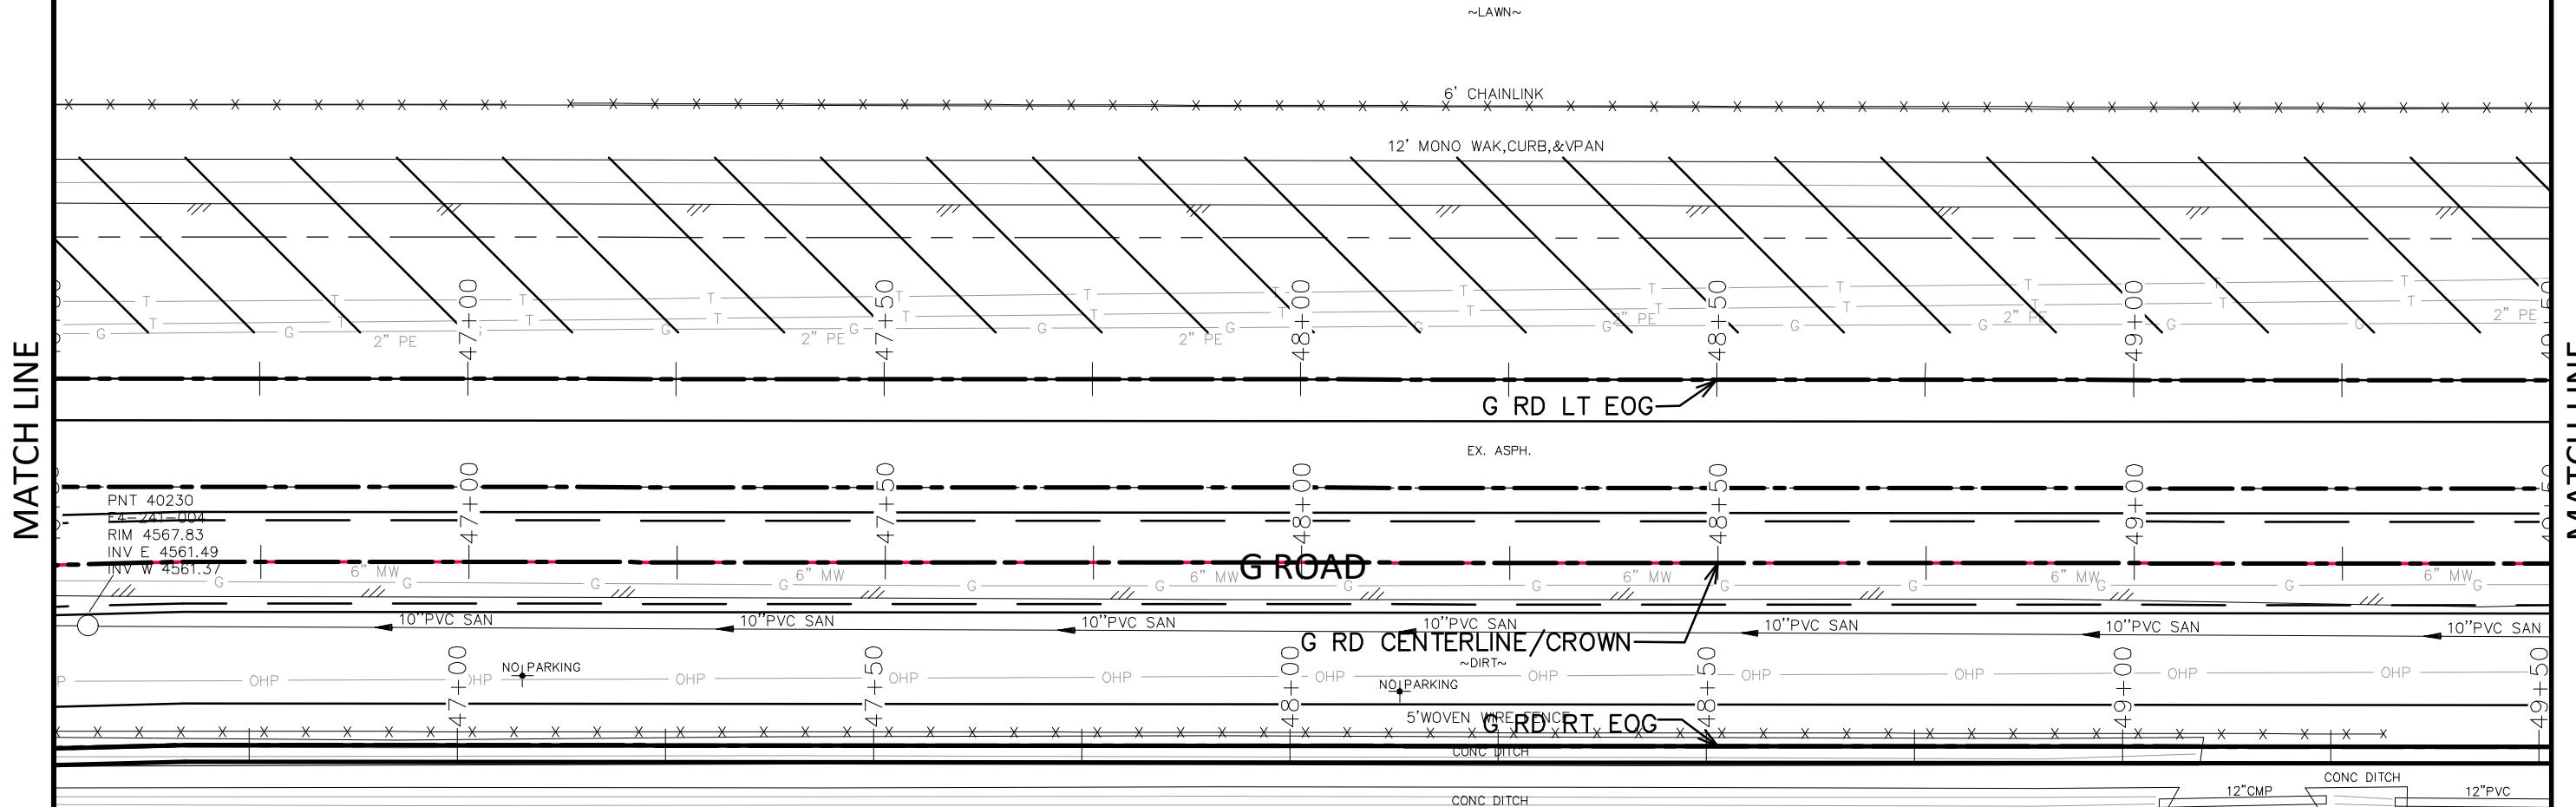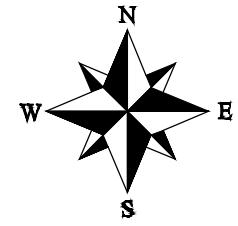

DESCRIPTION	DATE
REVISION A REV 1	- DATE
REVISION A REV 2	- DATE
REVISION A REV 3	- DATE
REVISION A REV 4	- DATE


DRAWN BY	JCS	DATE 2020
DESIGNED BY	JCS	DATE 2020
CHECKED BY	ALC	DATE 2020
APPROVED BY	TCP	DATE 2020

SCALE
0 5 10 20

Grand Junction
CITY OF COLORADO

PUBLIC WORKS
ENGINEERING DIVISION
PROJECT NO. 207-F1903

24 ROAD AND G ROAD
IMPROVEMENT PLAN - 038

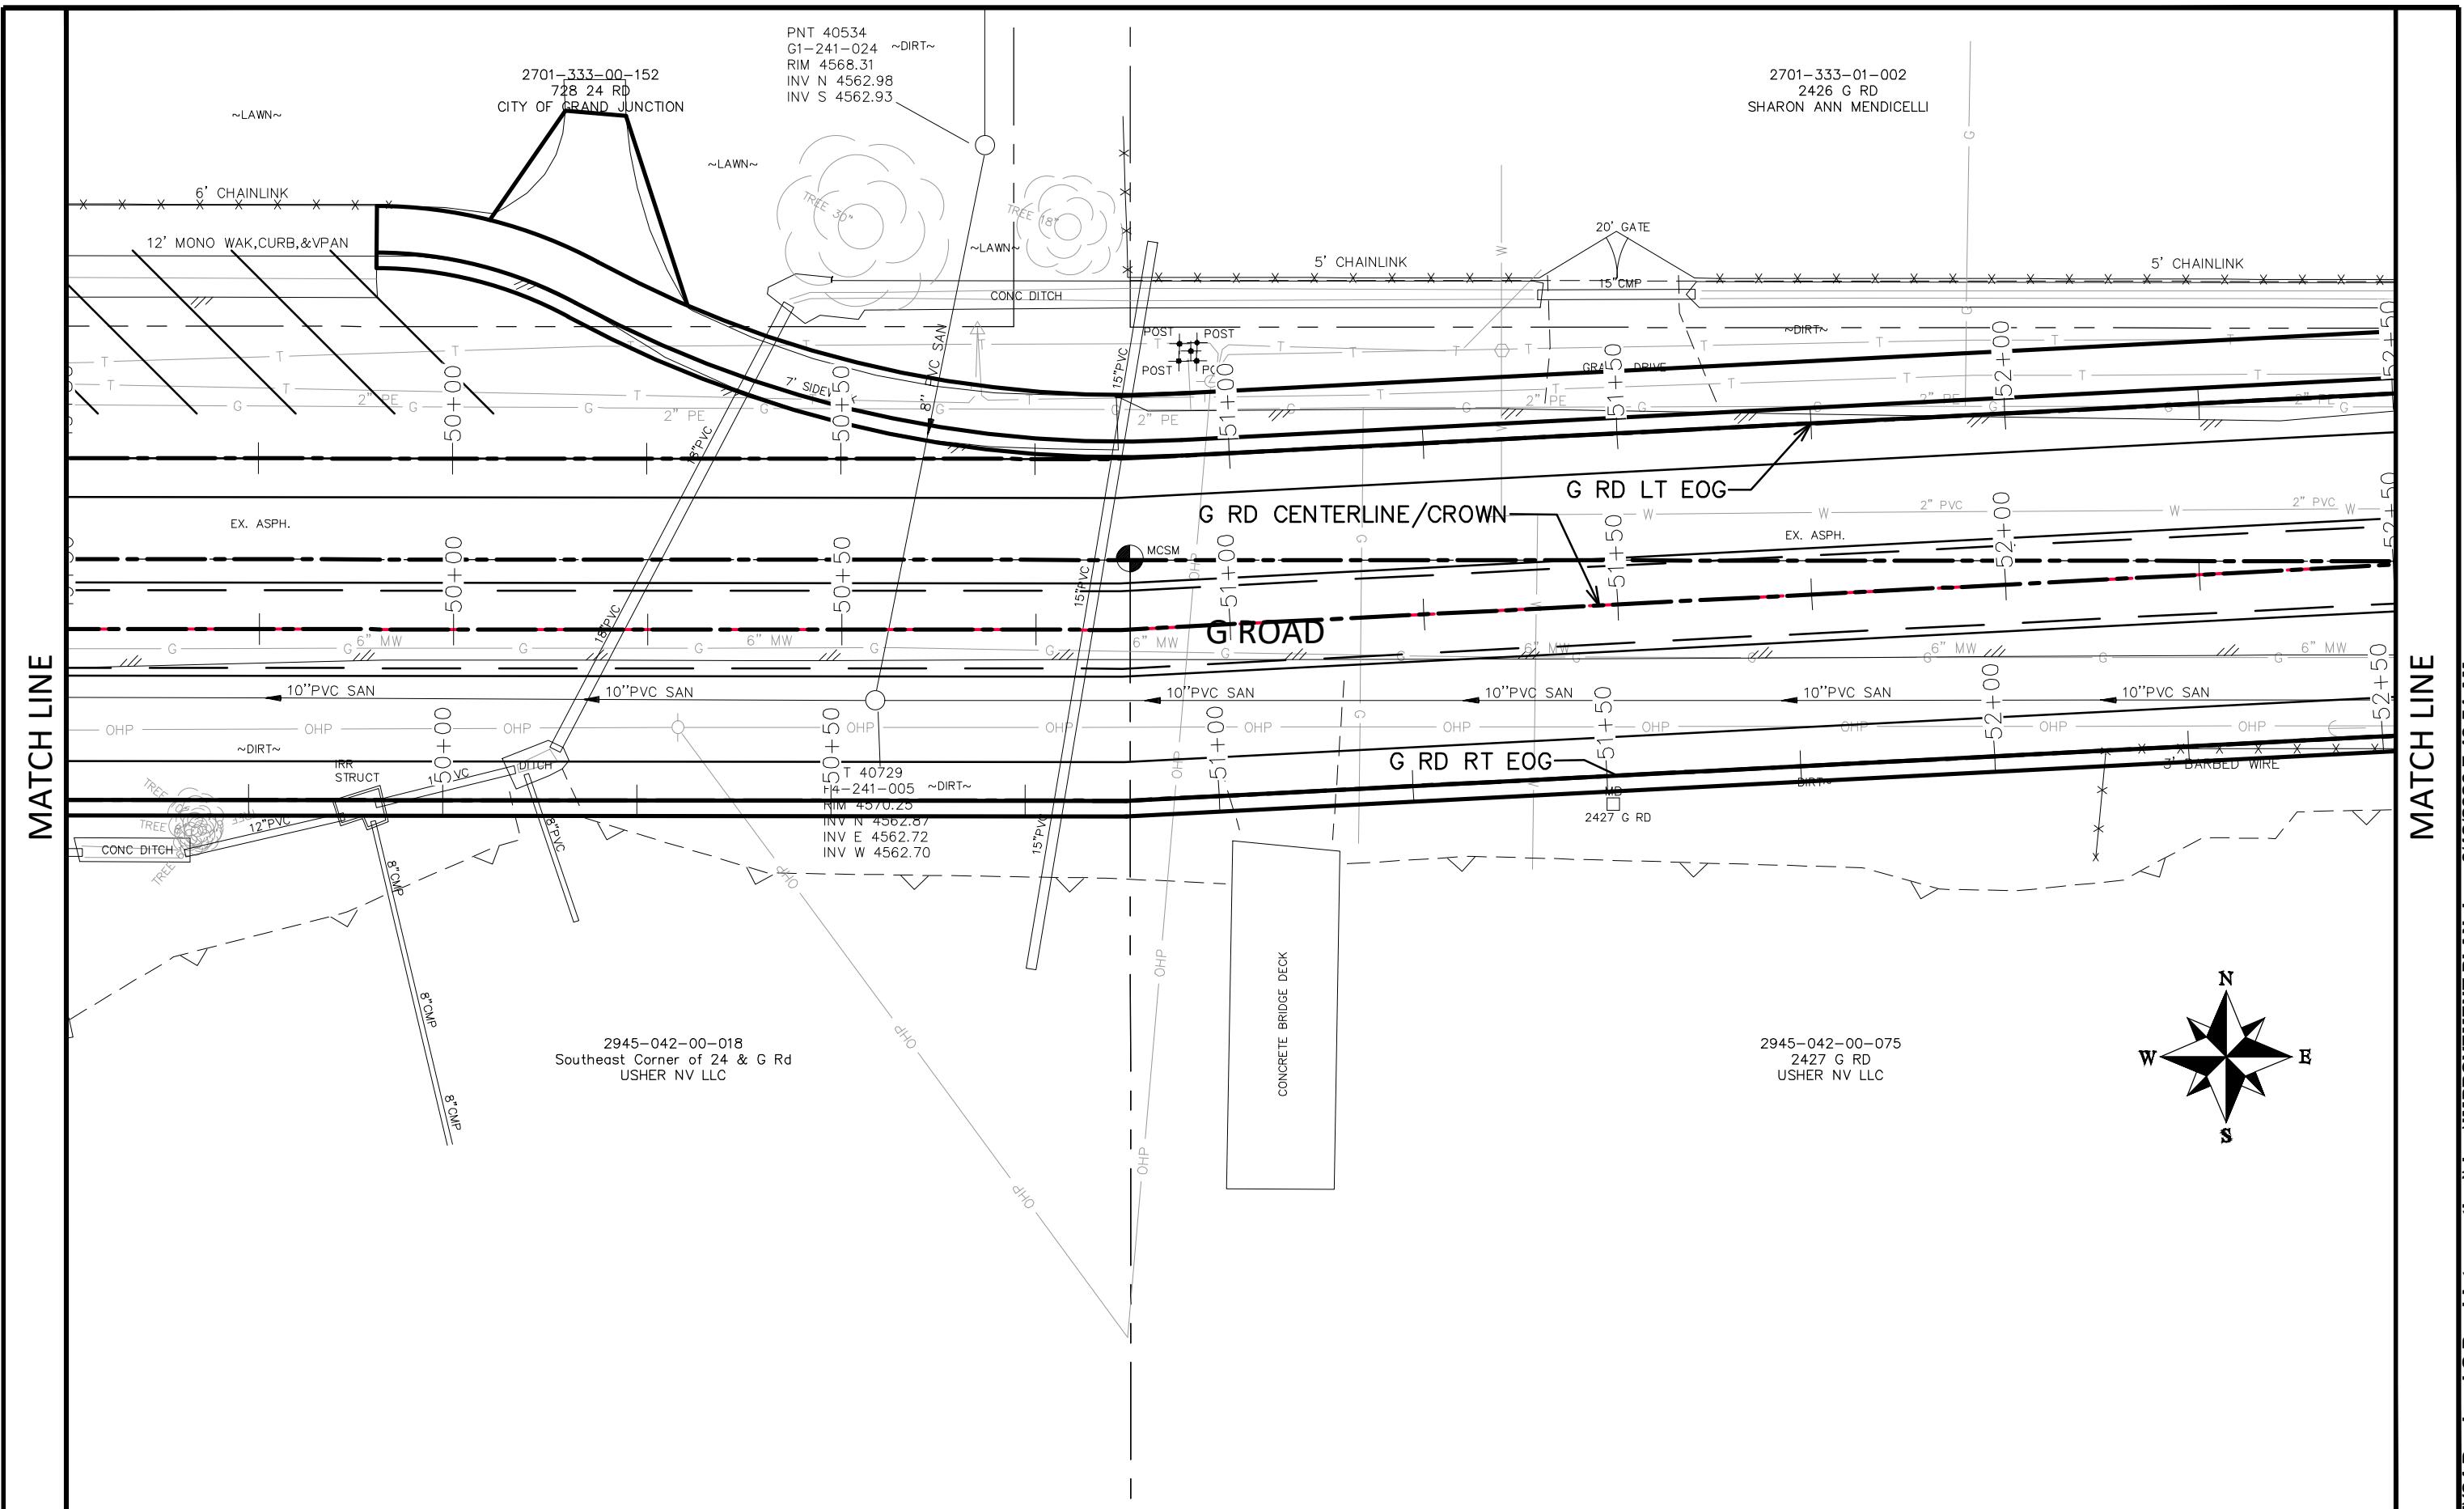

<u>DESCRIPTION</u>	<u>DATE</u>
REVISION A REV 1	— DATE
REVISION A REV 2	— DATE
REVISION A REV 3	— DATE
REVISION A REV 4	— DATE


DRAWN BY JCS DATE 2020
DESIGNED BY JCS DATE 2020
CHECKED BY ALC DATE 2020
APPROVED BY TCP DATE 2020

A horizontal scale bar with tick marks at 0, 5, 10, and 20.




PUBLIC WORKS
ENGINEERING DIVISION
PROJECT NO.207-F1903

24 ROAD AND G ROAD
IMPROVEMENT PLAN - 039

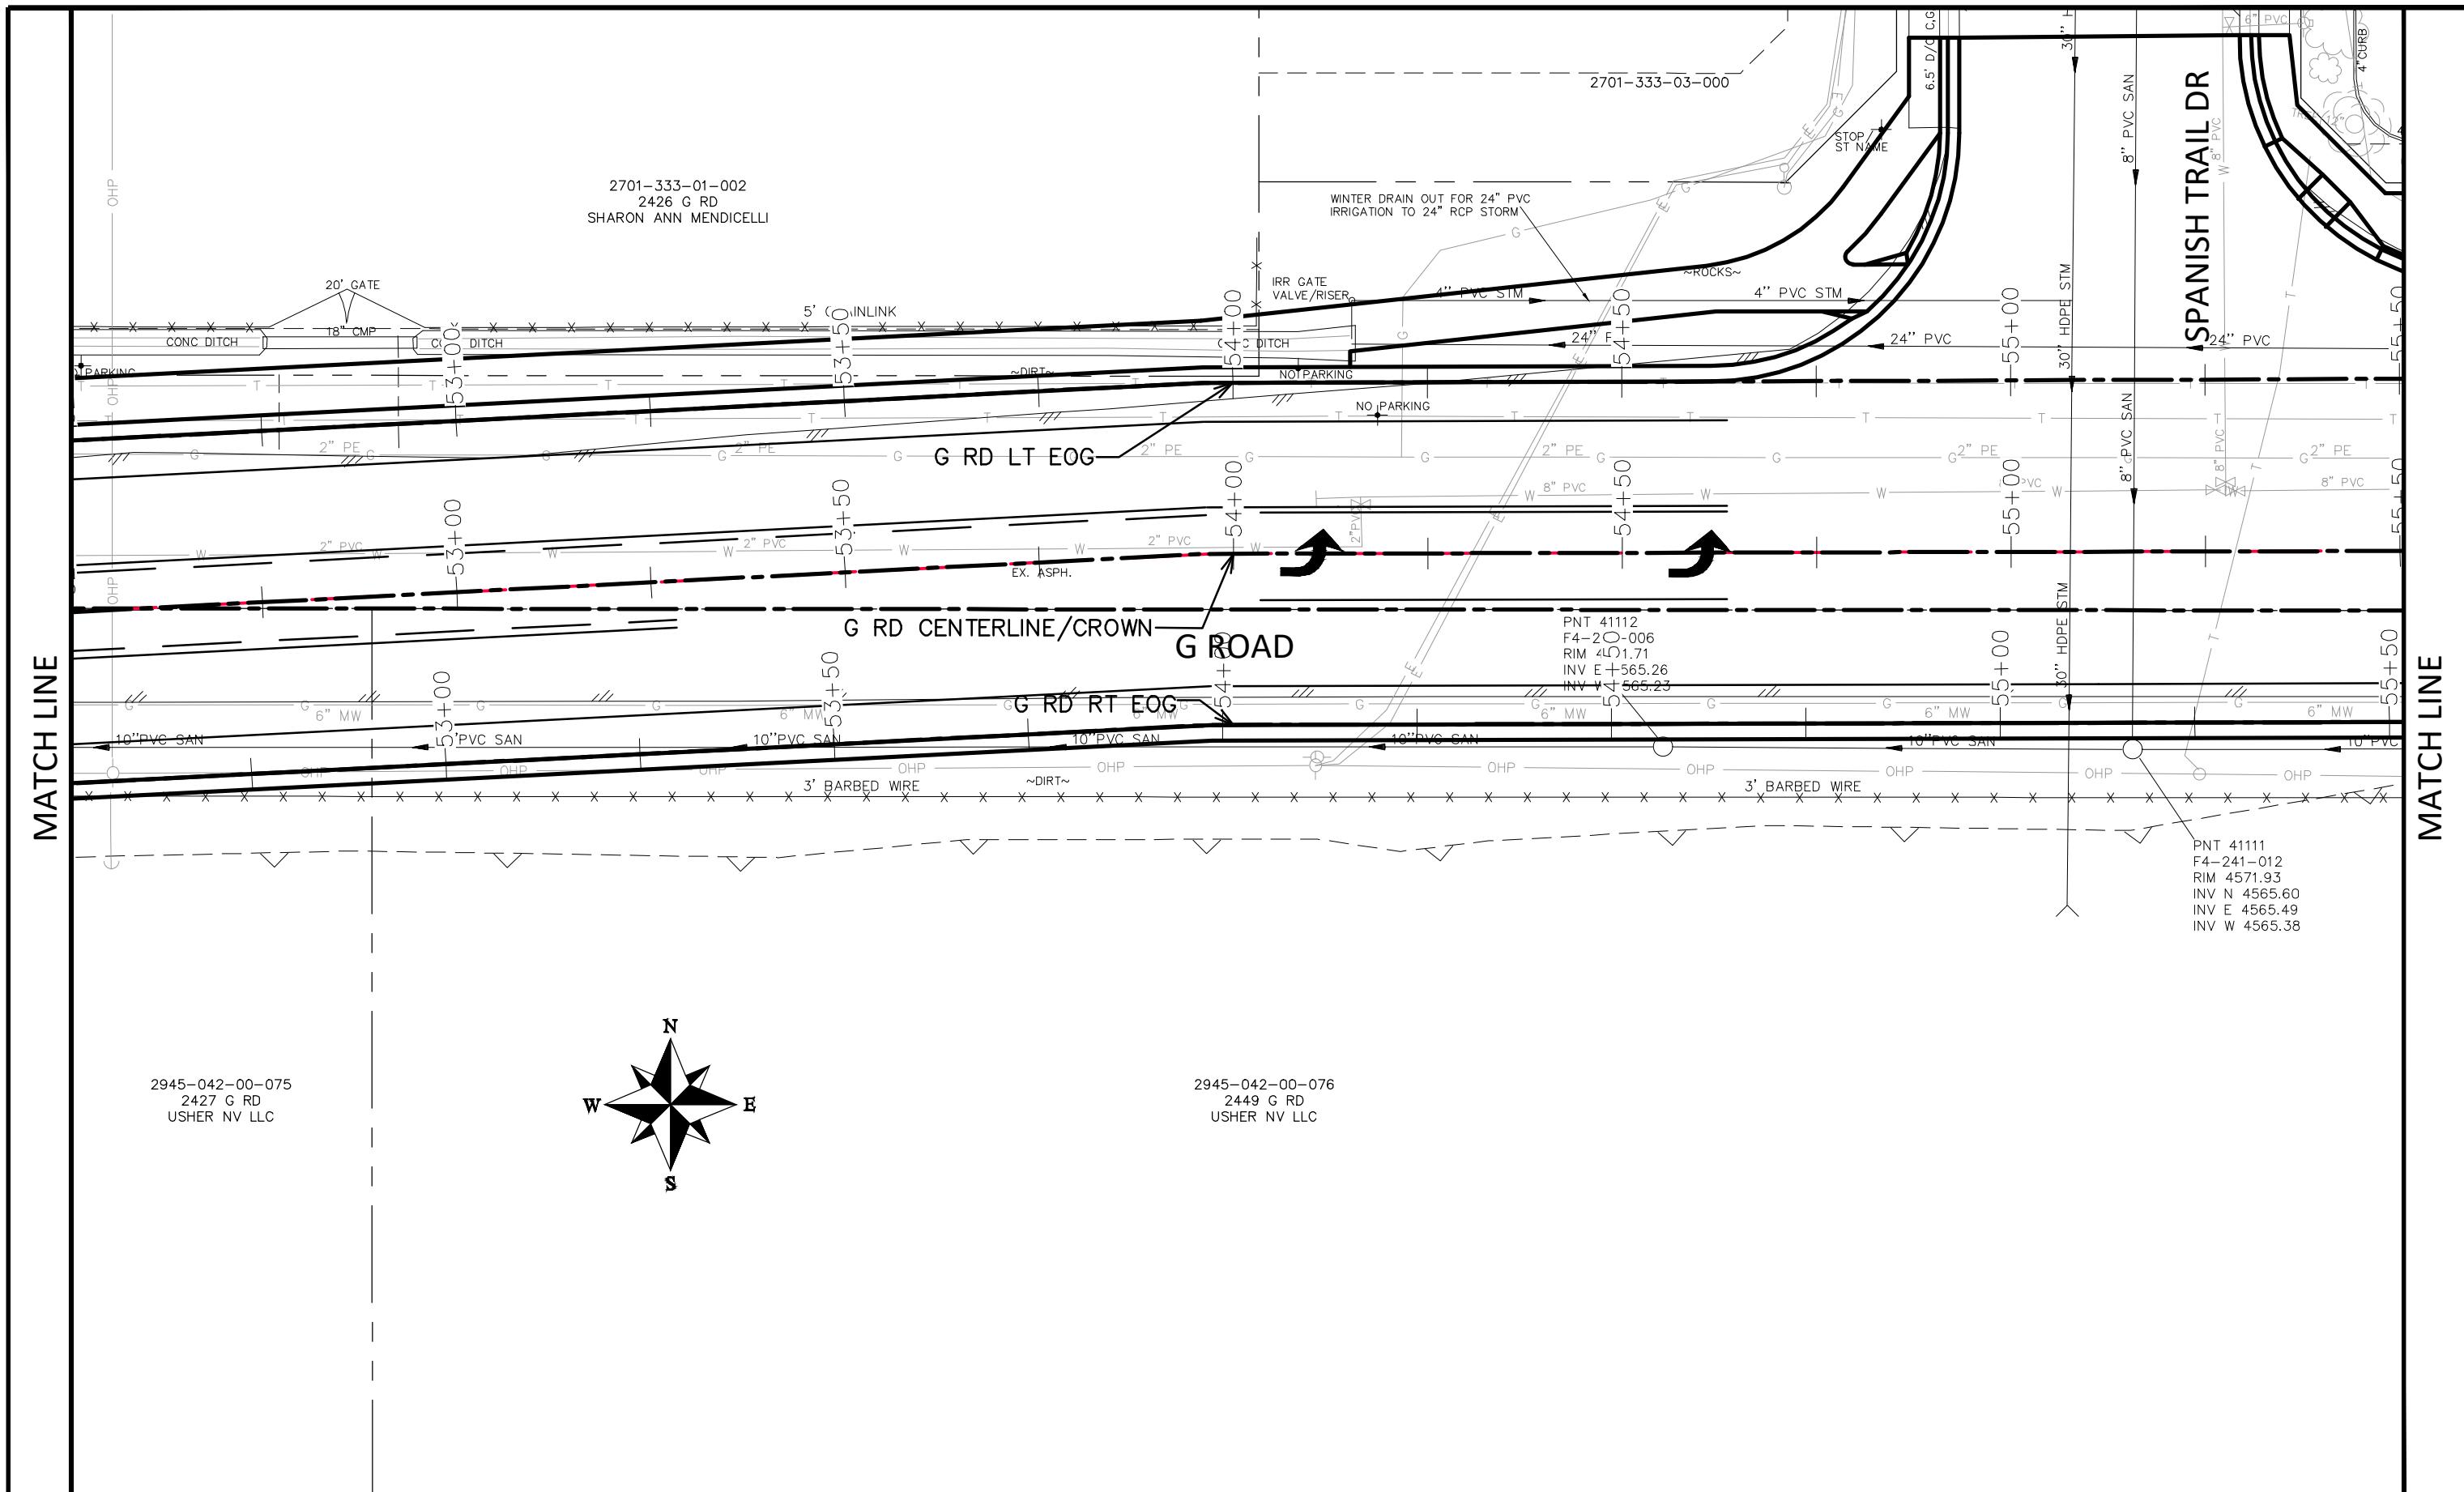

<u>DESCRIPTION</u>	<u>DATE</u>
REVISION A REV 1	- DATE
REVISION A REV 2	- DATE
REVISION A REV 3	- DATE
REVISION A REV 4	- DATE


DRAWN BY JCS DATE 2020
DESIGNED BY JCS DATE 2020
CHECKED BY ALC DATE 2020
APPROVED BY TCP DATE 2020

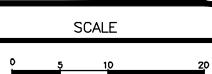

The logo for the City of Grand Junction, Colorado. It features the words "CITY OF" in a smaller, sans-serif font above the city's name. The name "Grand Junction" is written in a large, bold, black serif font. Below "Junction" is the word "COLORADO" in a smaller, all-caps, sans-serif font. A stylized, dark grey swoosh graphic starts from the bottom left and curves upwards towards the right, partially enclosing the word "Junction".


PUBLIC WORKS
ENGINEERING DIVISION
PROJECT NO. 207-E1203

24 ROAD AND G ROAD
IMPROVEMENT PLAN - 040

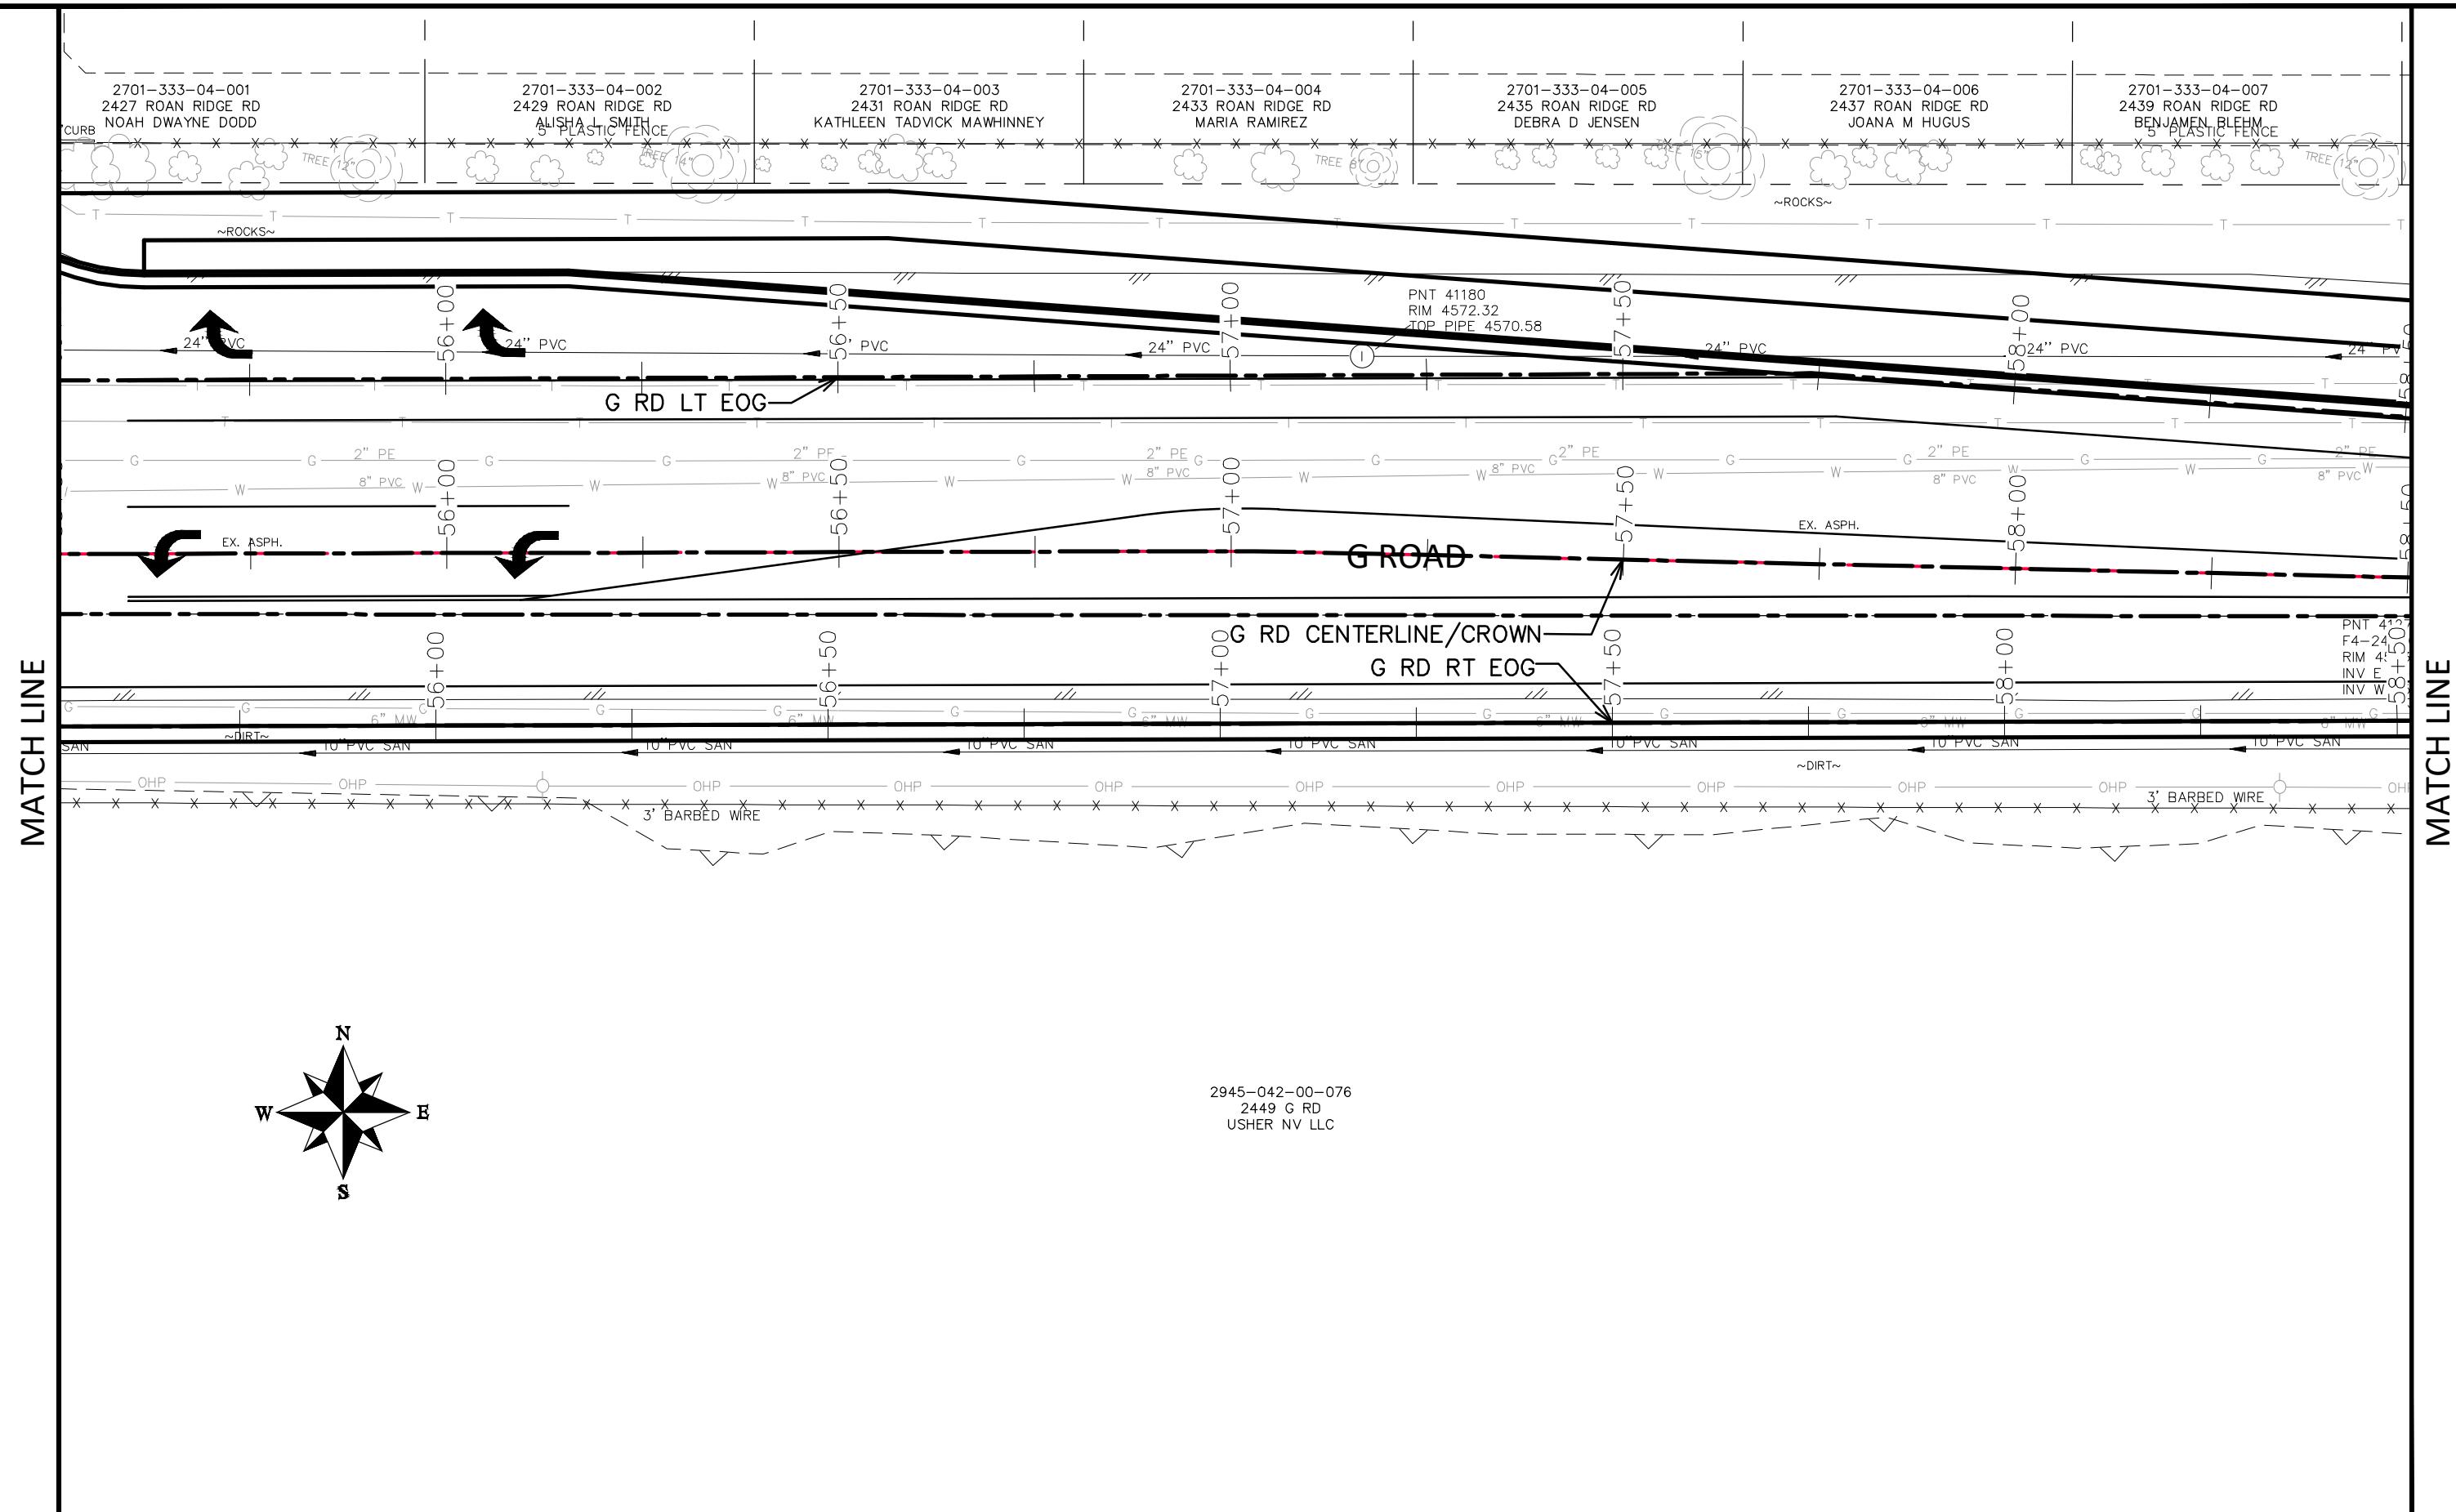

DESCRIPTION	DATE
REVISION A REV 1	- DATE
REVISION A REV 2	- DATE
REVISION A REV 3	- DATE
REVISION A REV 4	- DATE


DRAWN BY	JCS	DATE	2020
DESIGNED BY	JCS	DATE	2020
CHECKED BY	ALC	DATE	2020
APPROVED BY	TCP	DATE	2020

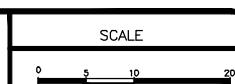

CITY OF
Grand Junction
COLORADO


PUBLIC WORKS
ENGINEERING DIVISION
PROJECT NO. 207-F1903

24 ROAD AND G ROAD
IMPROVEMENT PLAN - 041

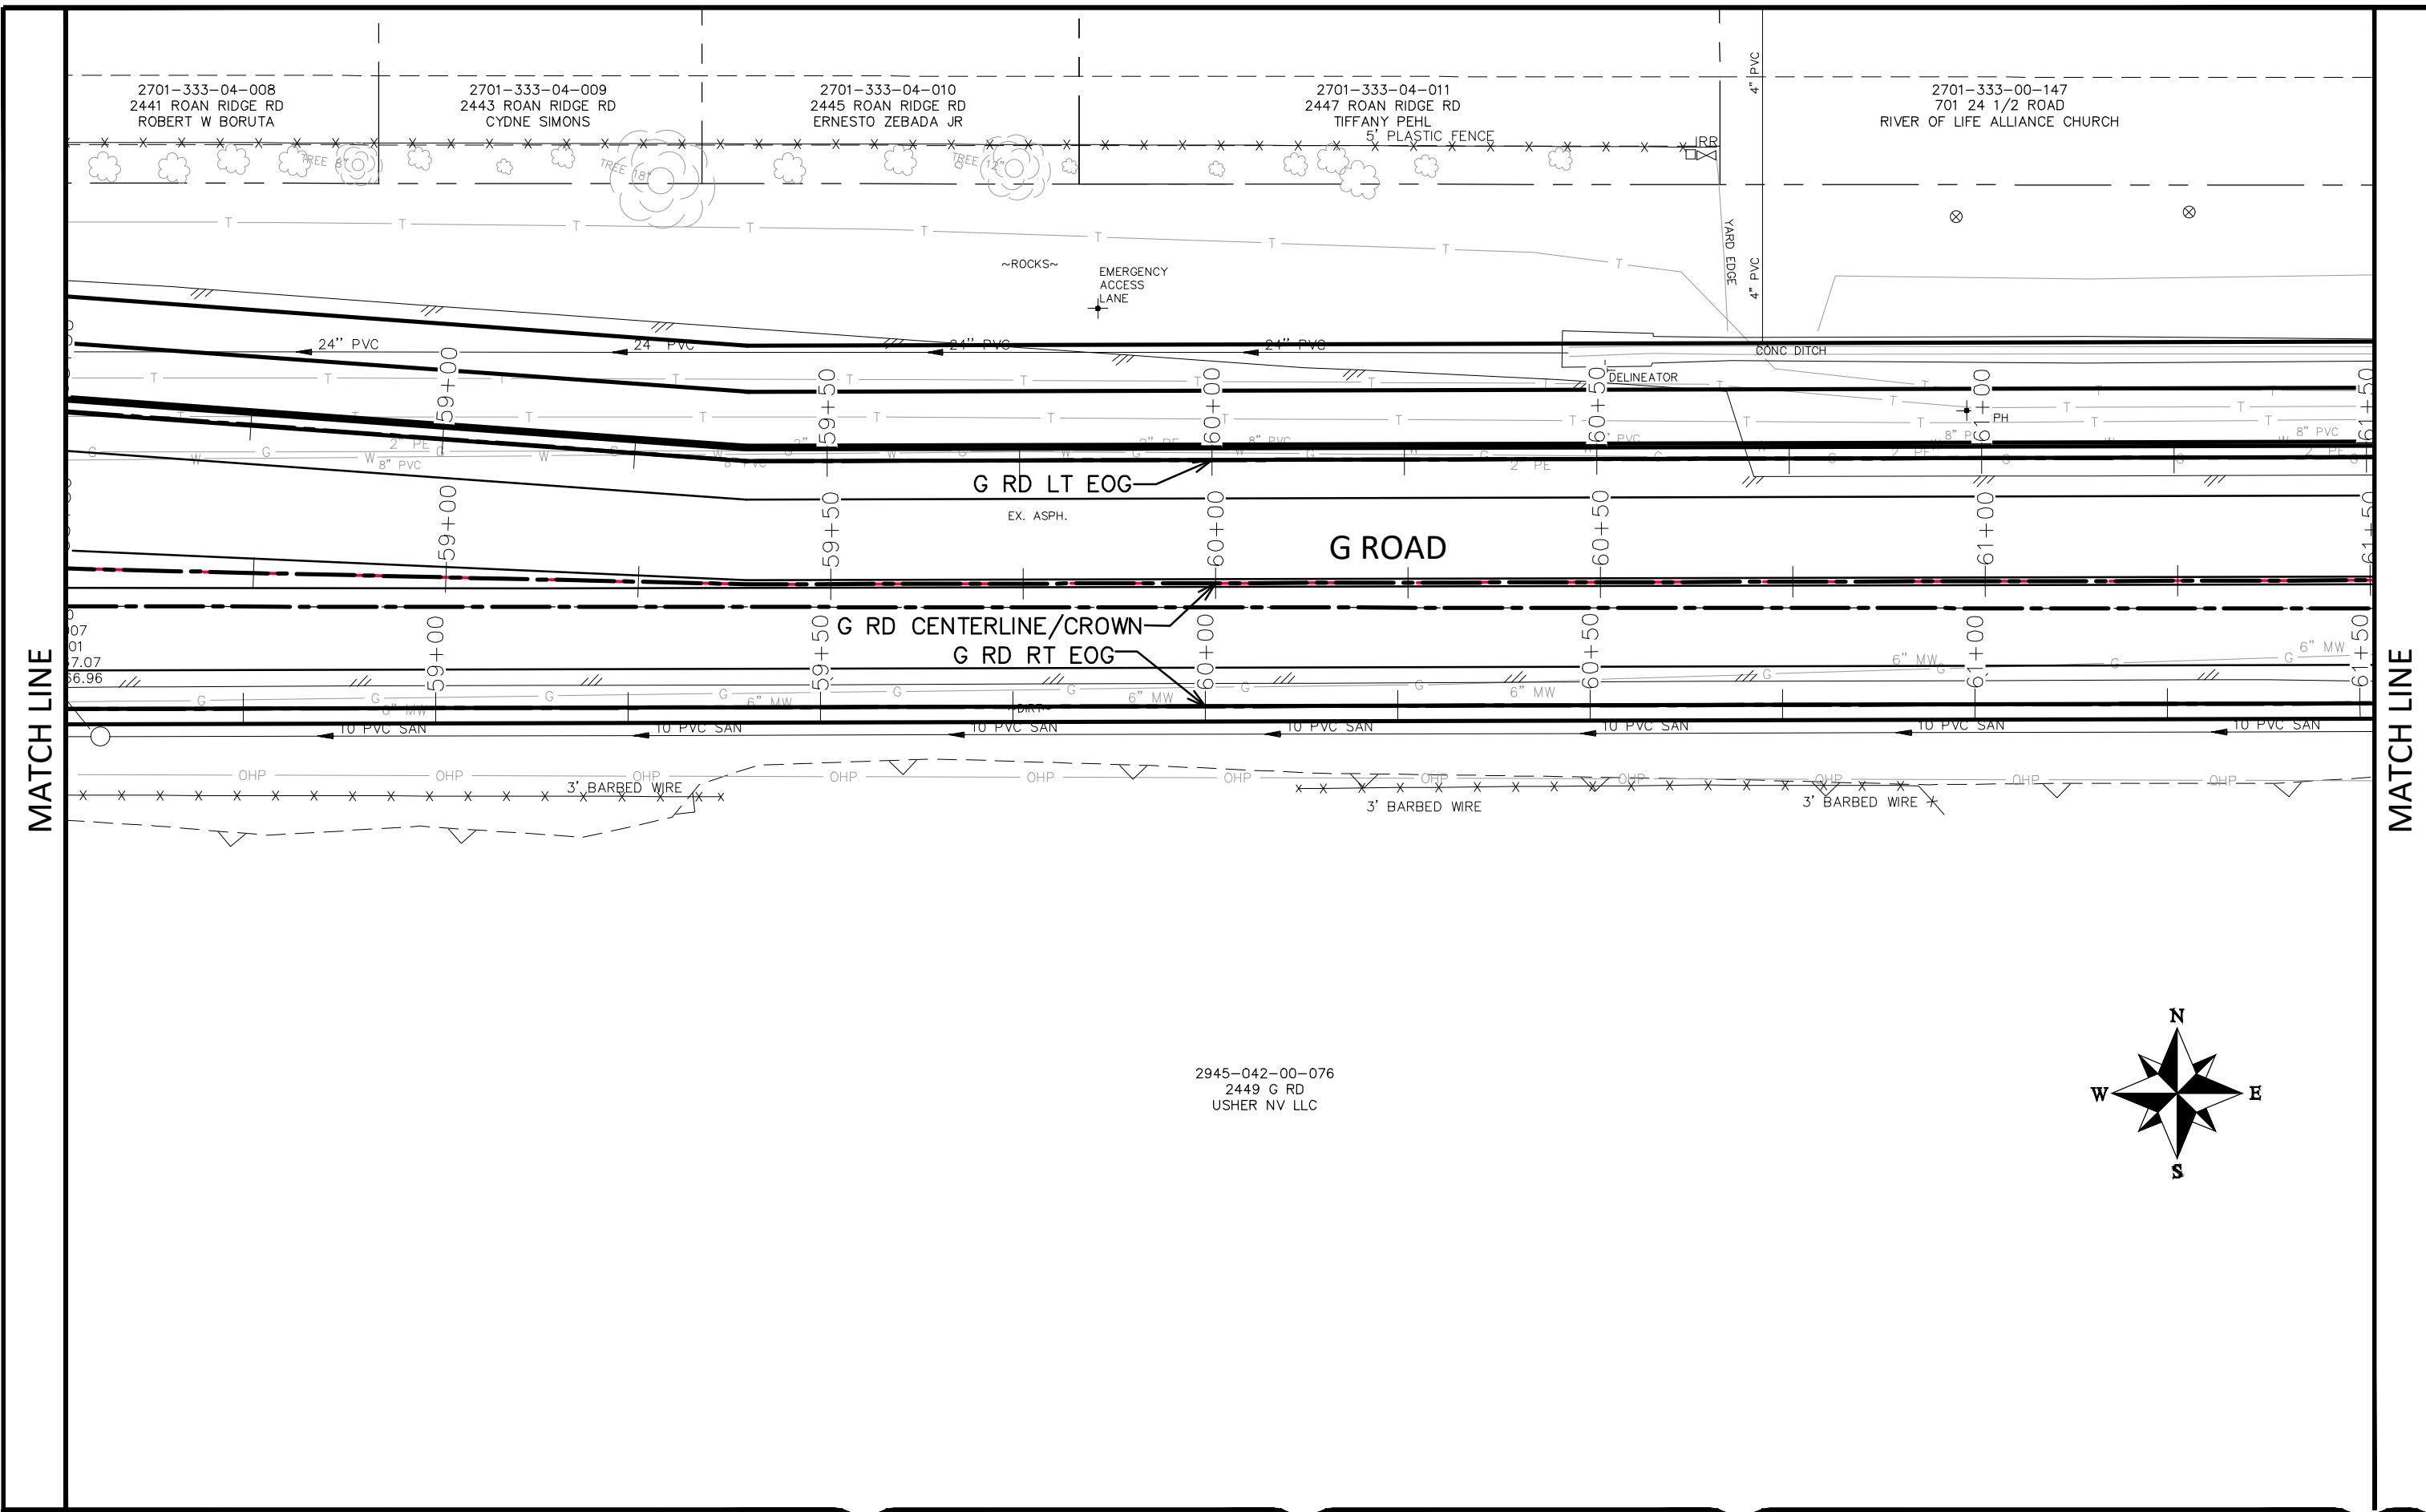

	<u>DESCRIPTION</u>	<u>DATE</u>
REVISION A	REV 1	DATE
REVISION B	REV 2	DATE
REVISION C	REV 3	DATE
REVISION D	REV 4	DATE


DRAWN BY JCS DATE 2020
DESIGNED BY JCS DATE 2020
CHECKED BY ALC DATE 2020
APPROVED BY TCP DATE 2020

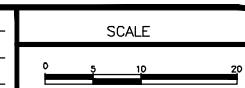

The logo for the City of Grand Junction, Colorado. It features the words "CITY OF" in a small, sans-serif font above the word "Grand" in a large, bold, serif font. Below "Grand" is the word "Junction" in a large, bold, serif font. Underneath "Junction" is the word "COLORADO" in a smaller, all-caps, sans-serif font. A stylized swoosh graphic is positioned below "Junction".


PUBLIC WORKS
ENGINEERING DIVISION
PROJECT NO.207-F1903

24 ROAD AND G ROAD
IMPROVEMENT PLAN - 042

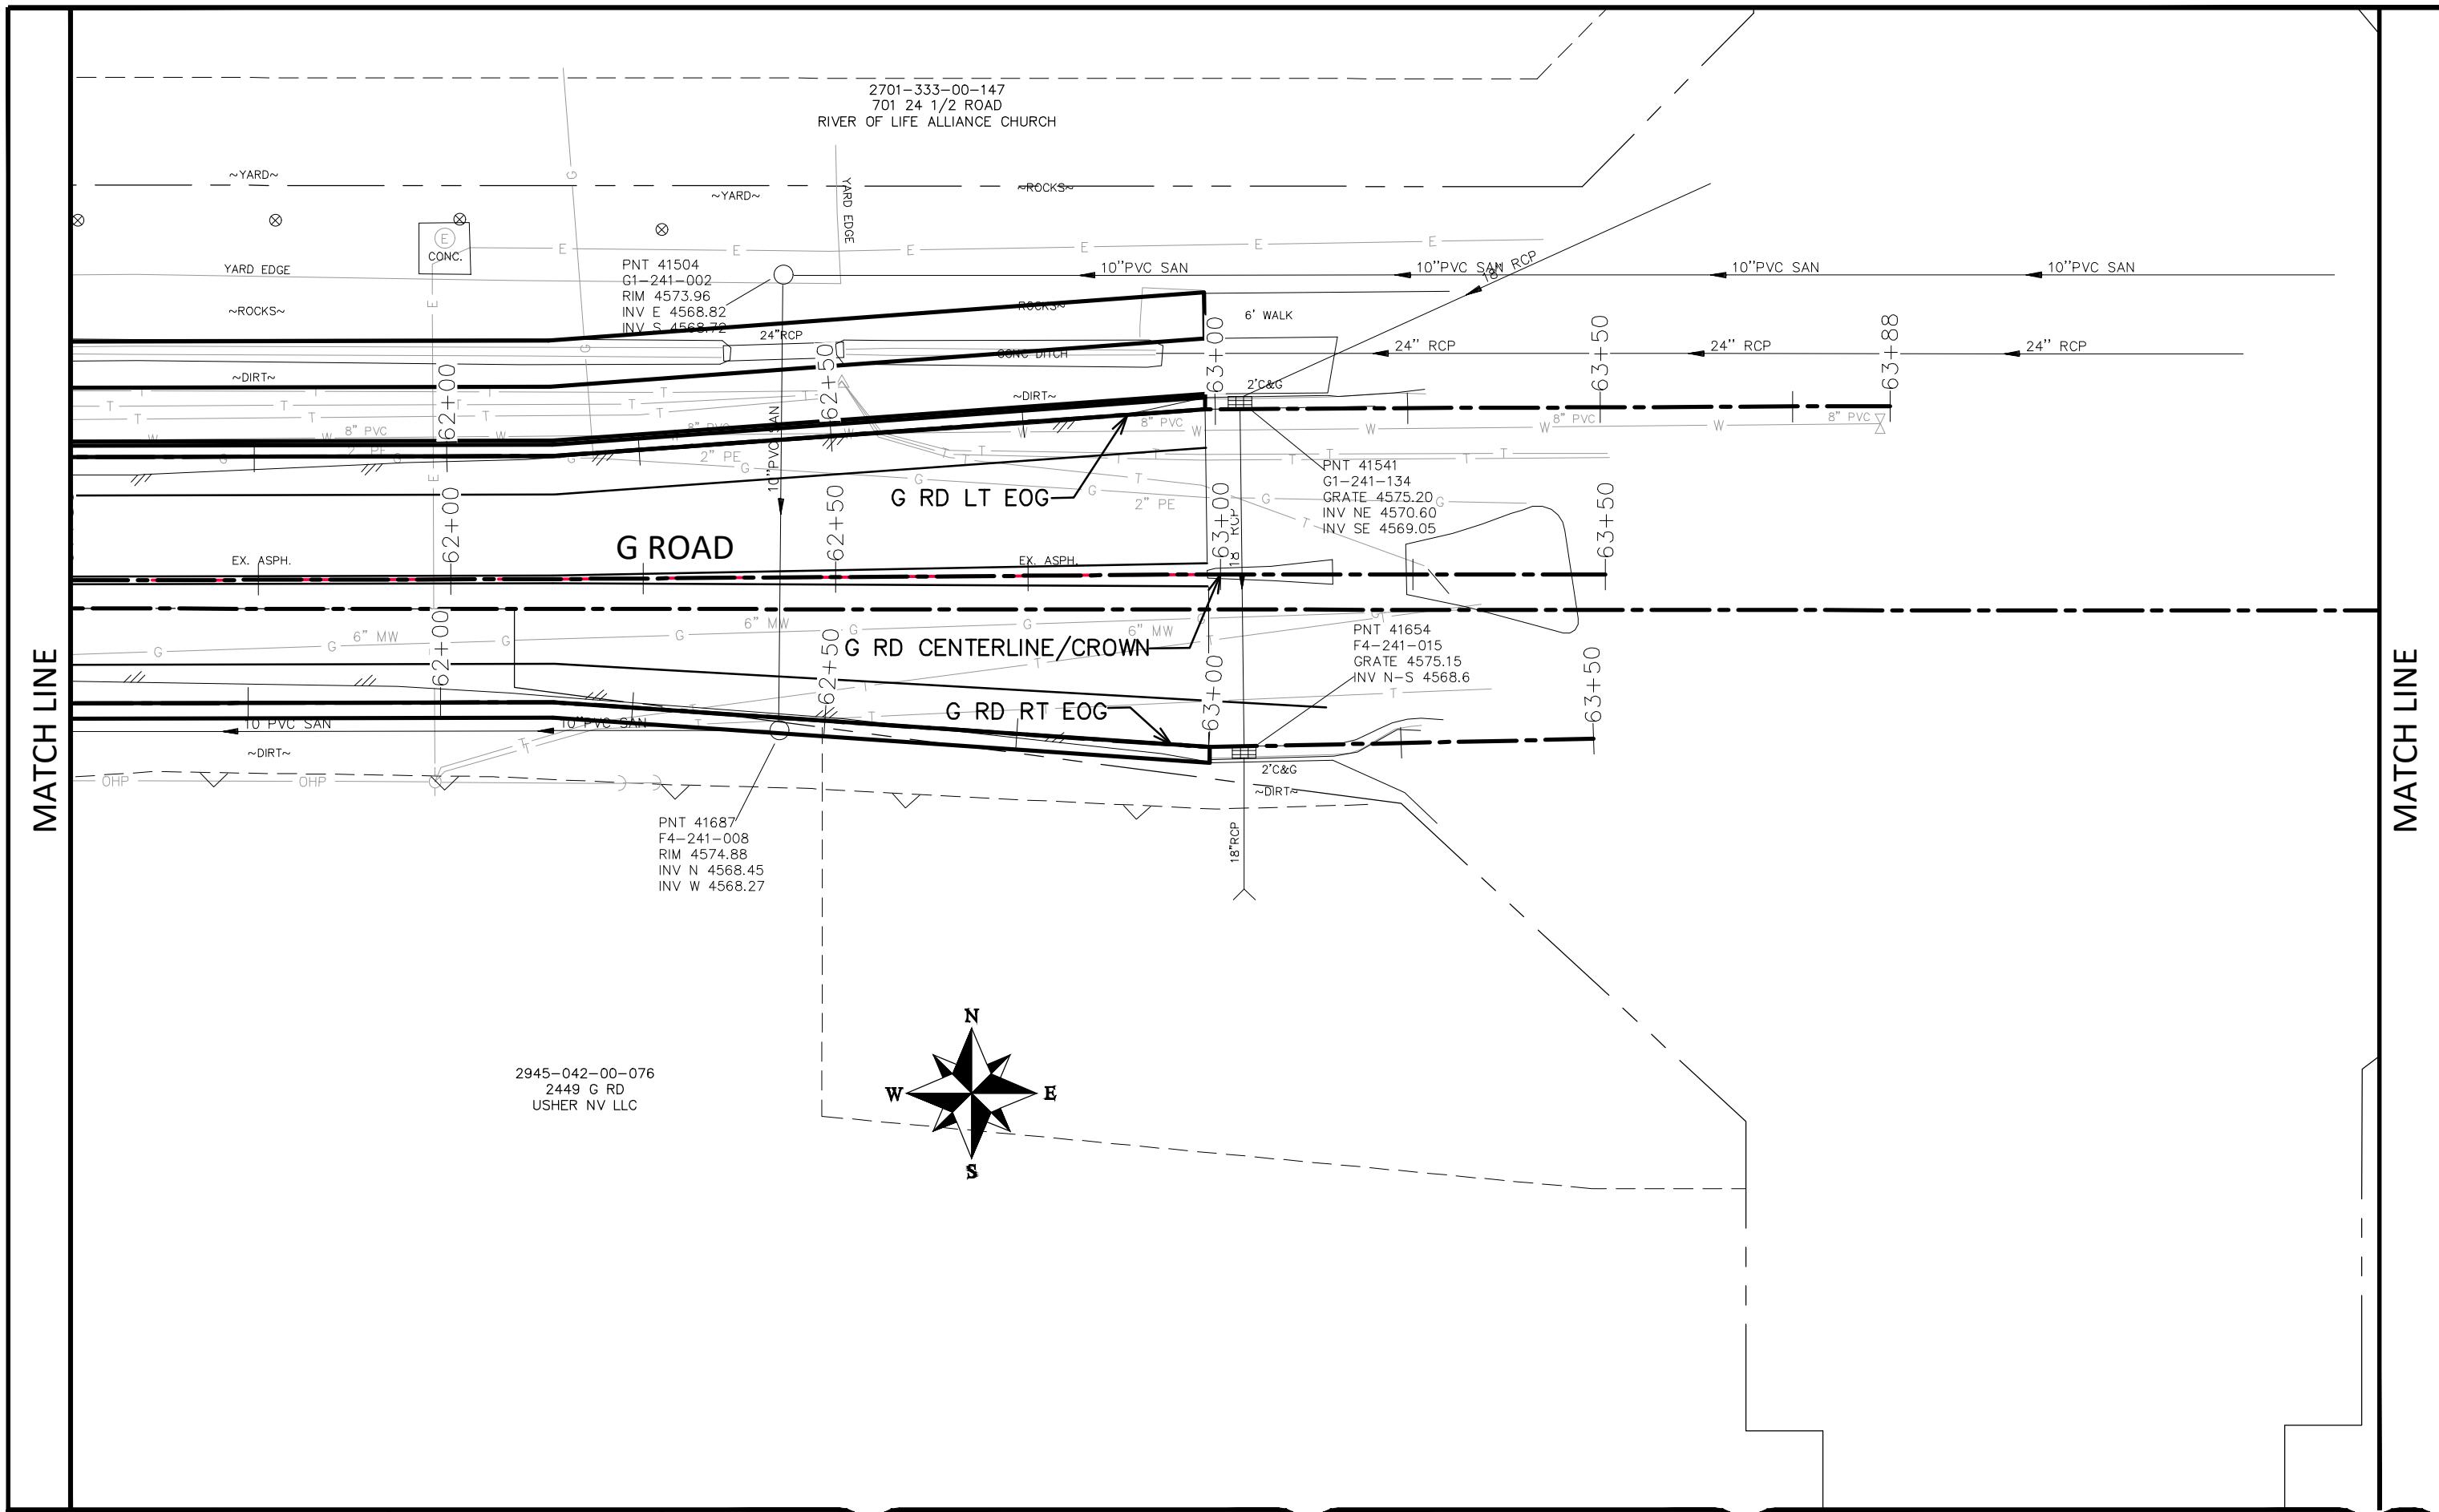

	<u>DESCRIPTION</u>	<u>DATE</u>
REVISION A	REV 1	- DATE
REVISION A	REV 2	- DATE
REVISION A	REV 3	- DATE
REVISION A	REV 4	- DATE

DRAWN BY JCS DATE 2020
DESIGNED BY JCS DATE 2020
CHECKED BY ALC DATE 2020
APPROVED BY TCP DATE 2020


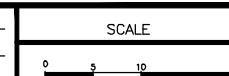


The logo for the City of Grand Junction, Colorado. It features the words "CITY OF" in a small, sans-serif font above the word "Grand" in a large, bold, serif font. Below "Grand" is "Junction" in a large, bold, sans-serif font. Underneath "Junction" is "COLORADO" in a smaller, all-caps, sans-serif font. A stylized, wavy line graphic starts from the bottom left and sweeps upwards and to the right, partially enclosing the word "Junction".

PUBLIC WORKS
ENGINEERING DIVISION
PROJECT NO.207-F1903

24 ROAD AND G ROAD
IMPROVEMENT PLAN - 043

2945-051-17-001
2373 G RD
GAHC4 GRAND JUNCTION CO MOB LLC
CANYON VIEW MEDICAL PLAZA

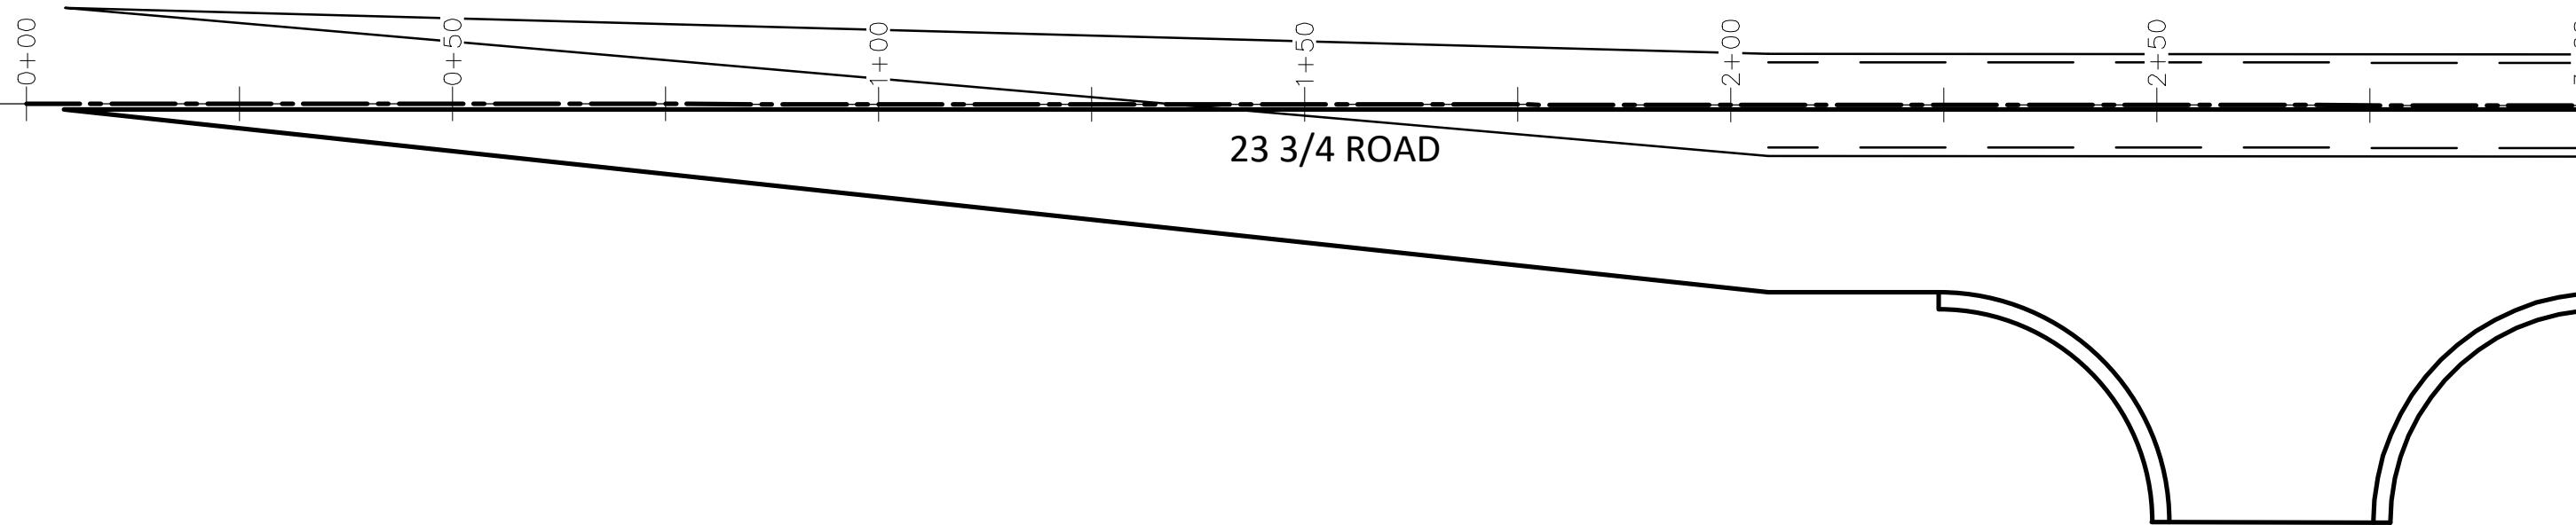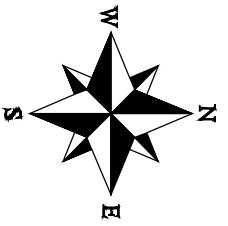

MATCH LINE

N:\Landproj\24 Road and G Road Intersection.dwg\IMPROVEMENT PLAN.cwg, 6/12/2020 7:20:24 AM

2945-051-00-068
2379 G RD
FAMILY LLC

DESCRIPTION	DATE
REVISION A REV 1	- DATE
REVISION A REV 2	- DATE
REVISION A REV 3	- DATE
REVISION A REV 4	- DATE


DRAWN BY	JCS	DATE	2020
DESIGNED BY	JCS	DATE	2020
CHECKED BY	ALC	DATE	2020
APPROVED BY	TCP	DATE	2020


SCALE
0 5 10 20



PUBLIC WORKS
ENGINEERING DIVISION
PROJECT NO. 207-F1903

24 ROAD AND G ROAD
IMPROVEMENT PLAN - 044

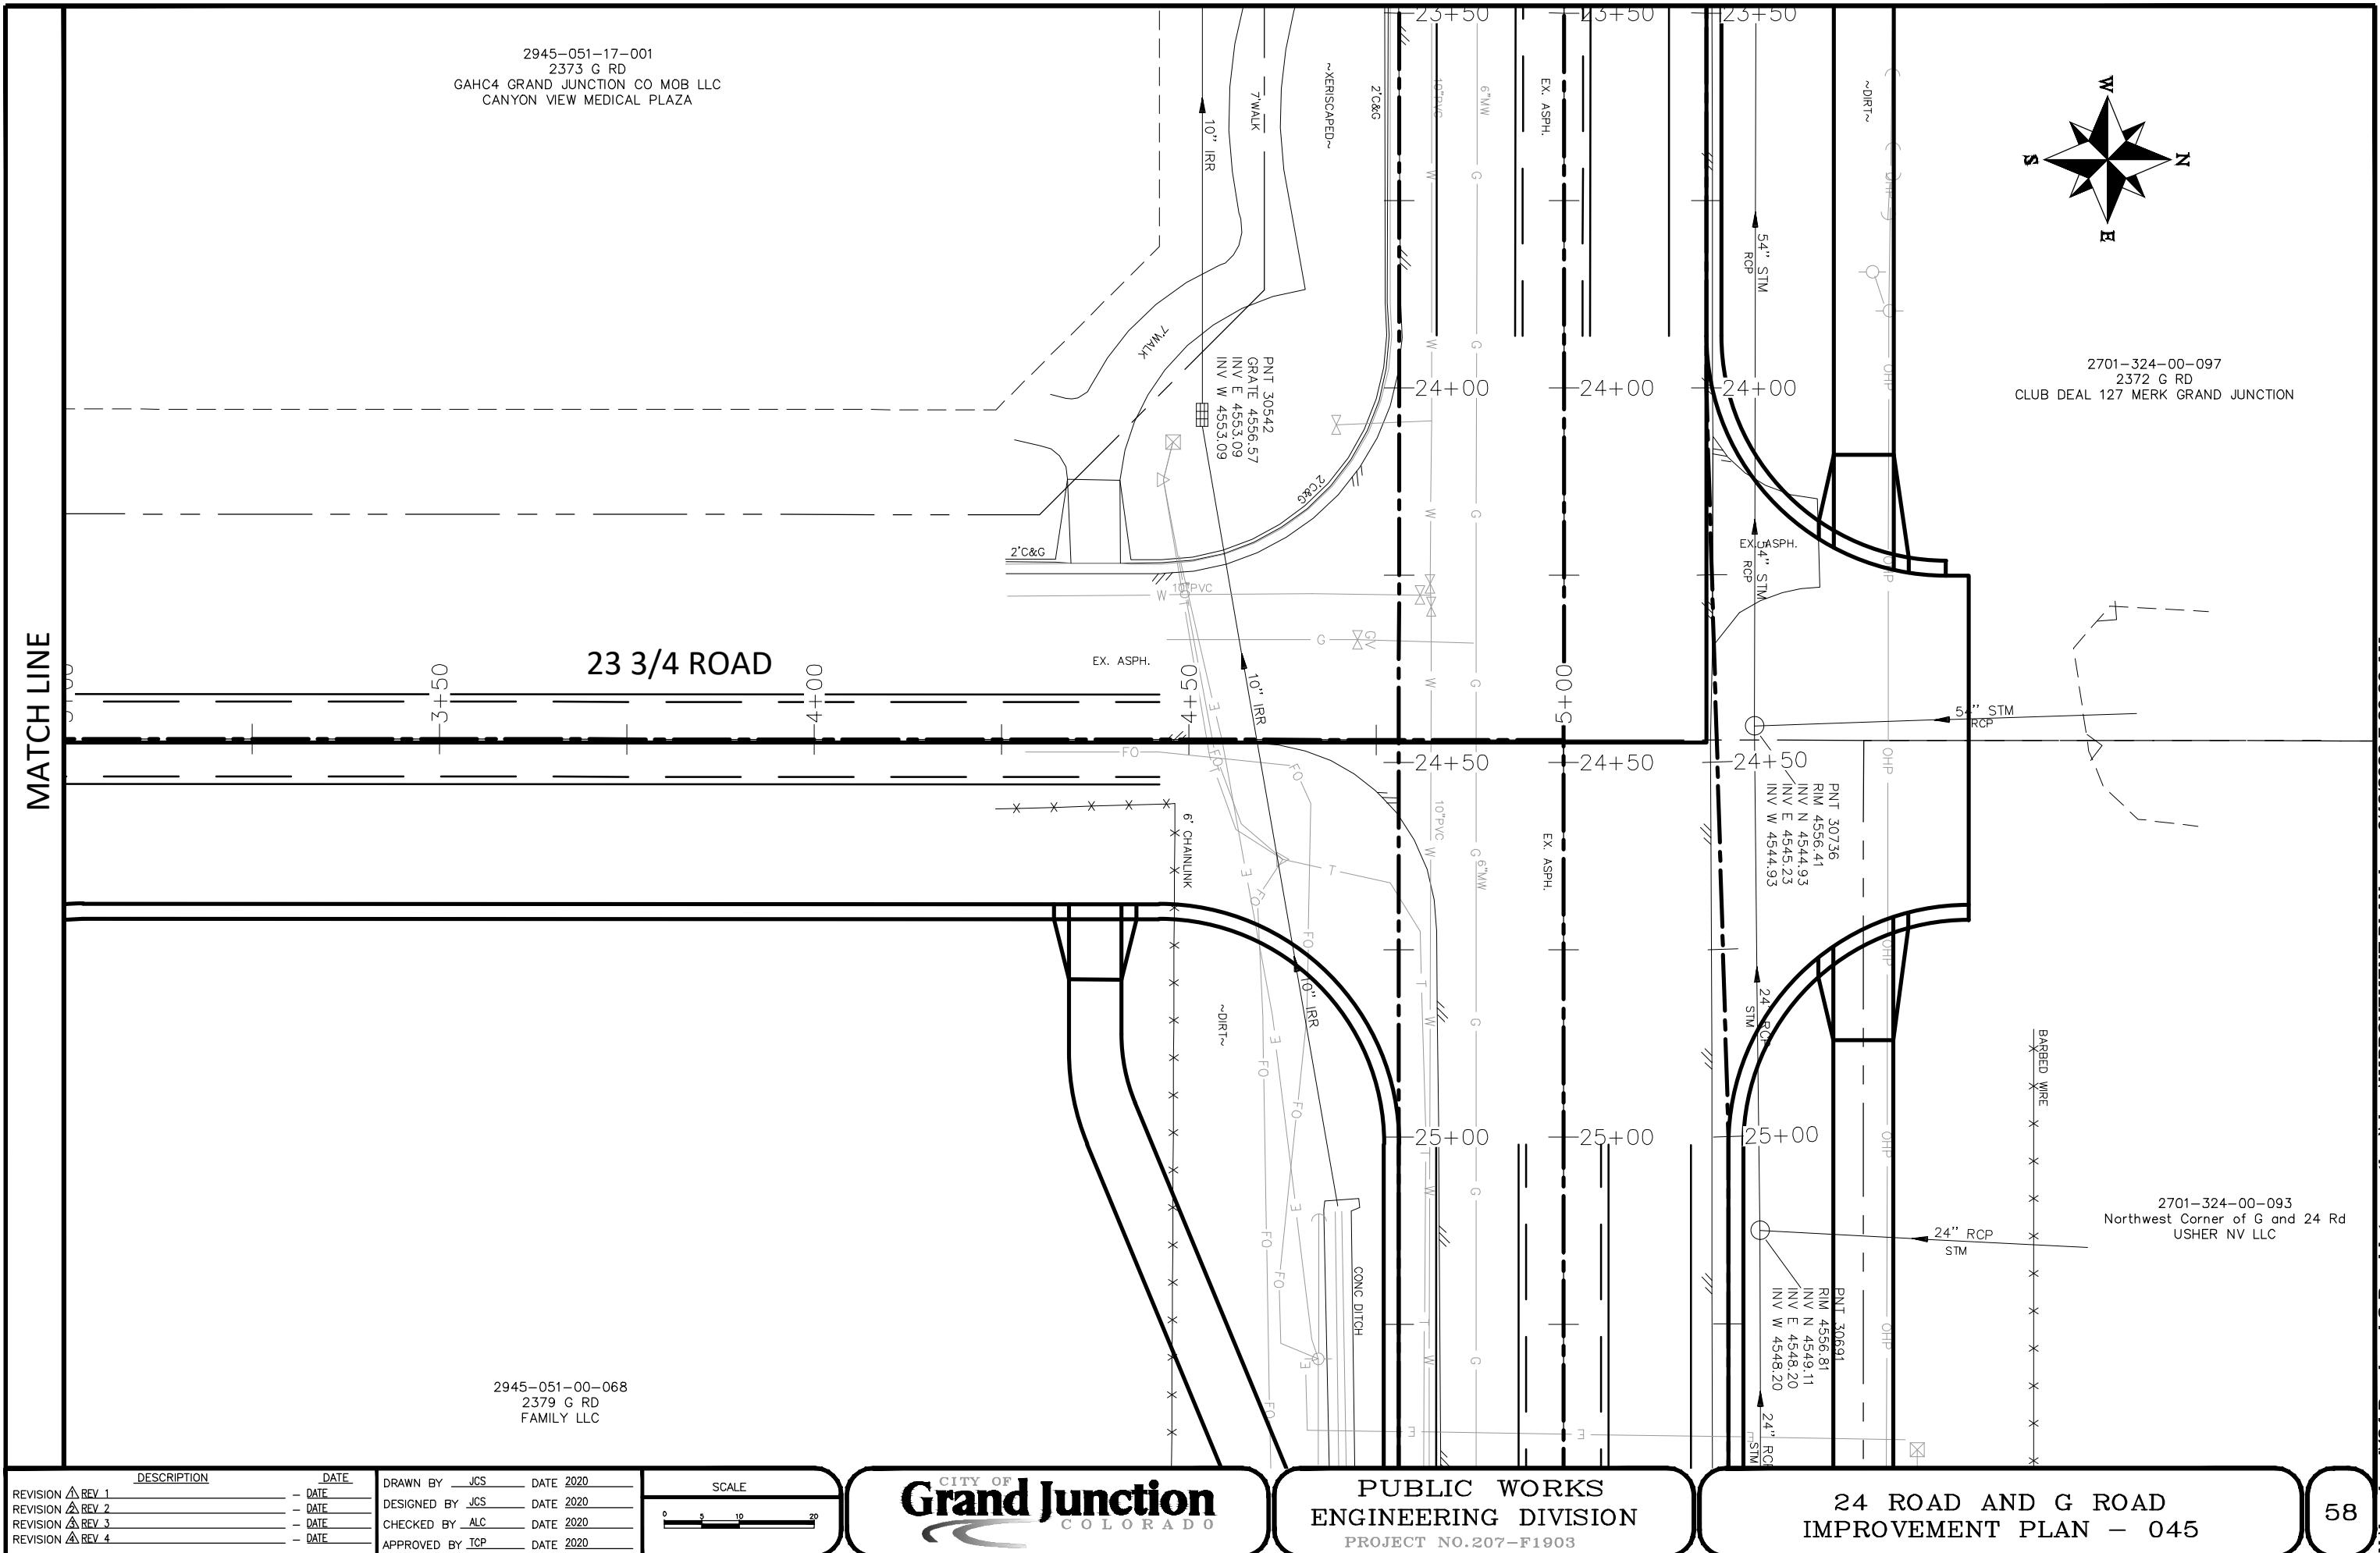

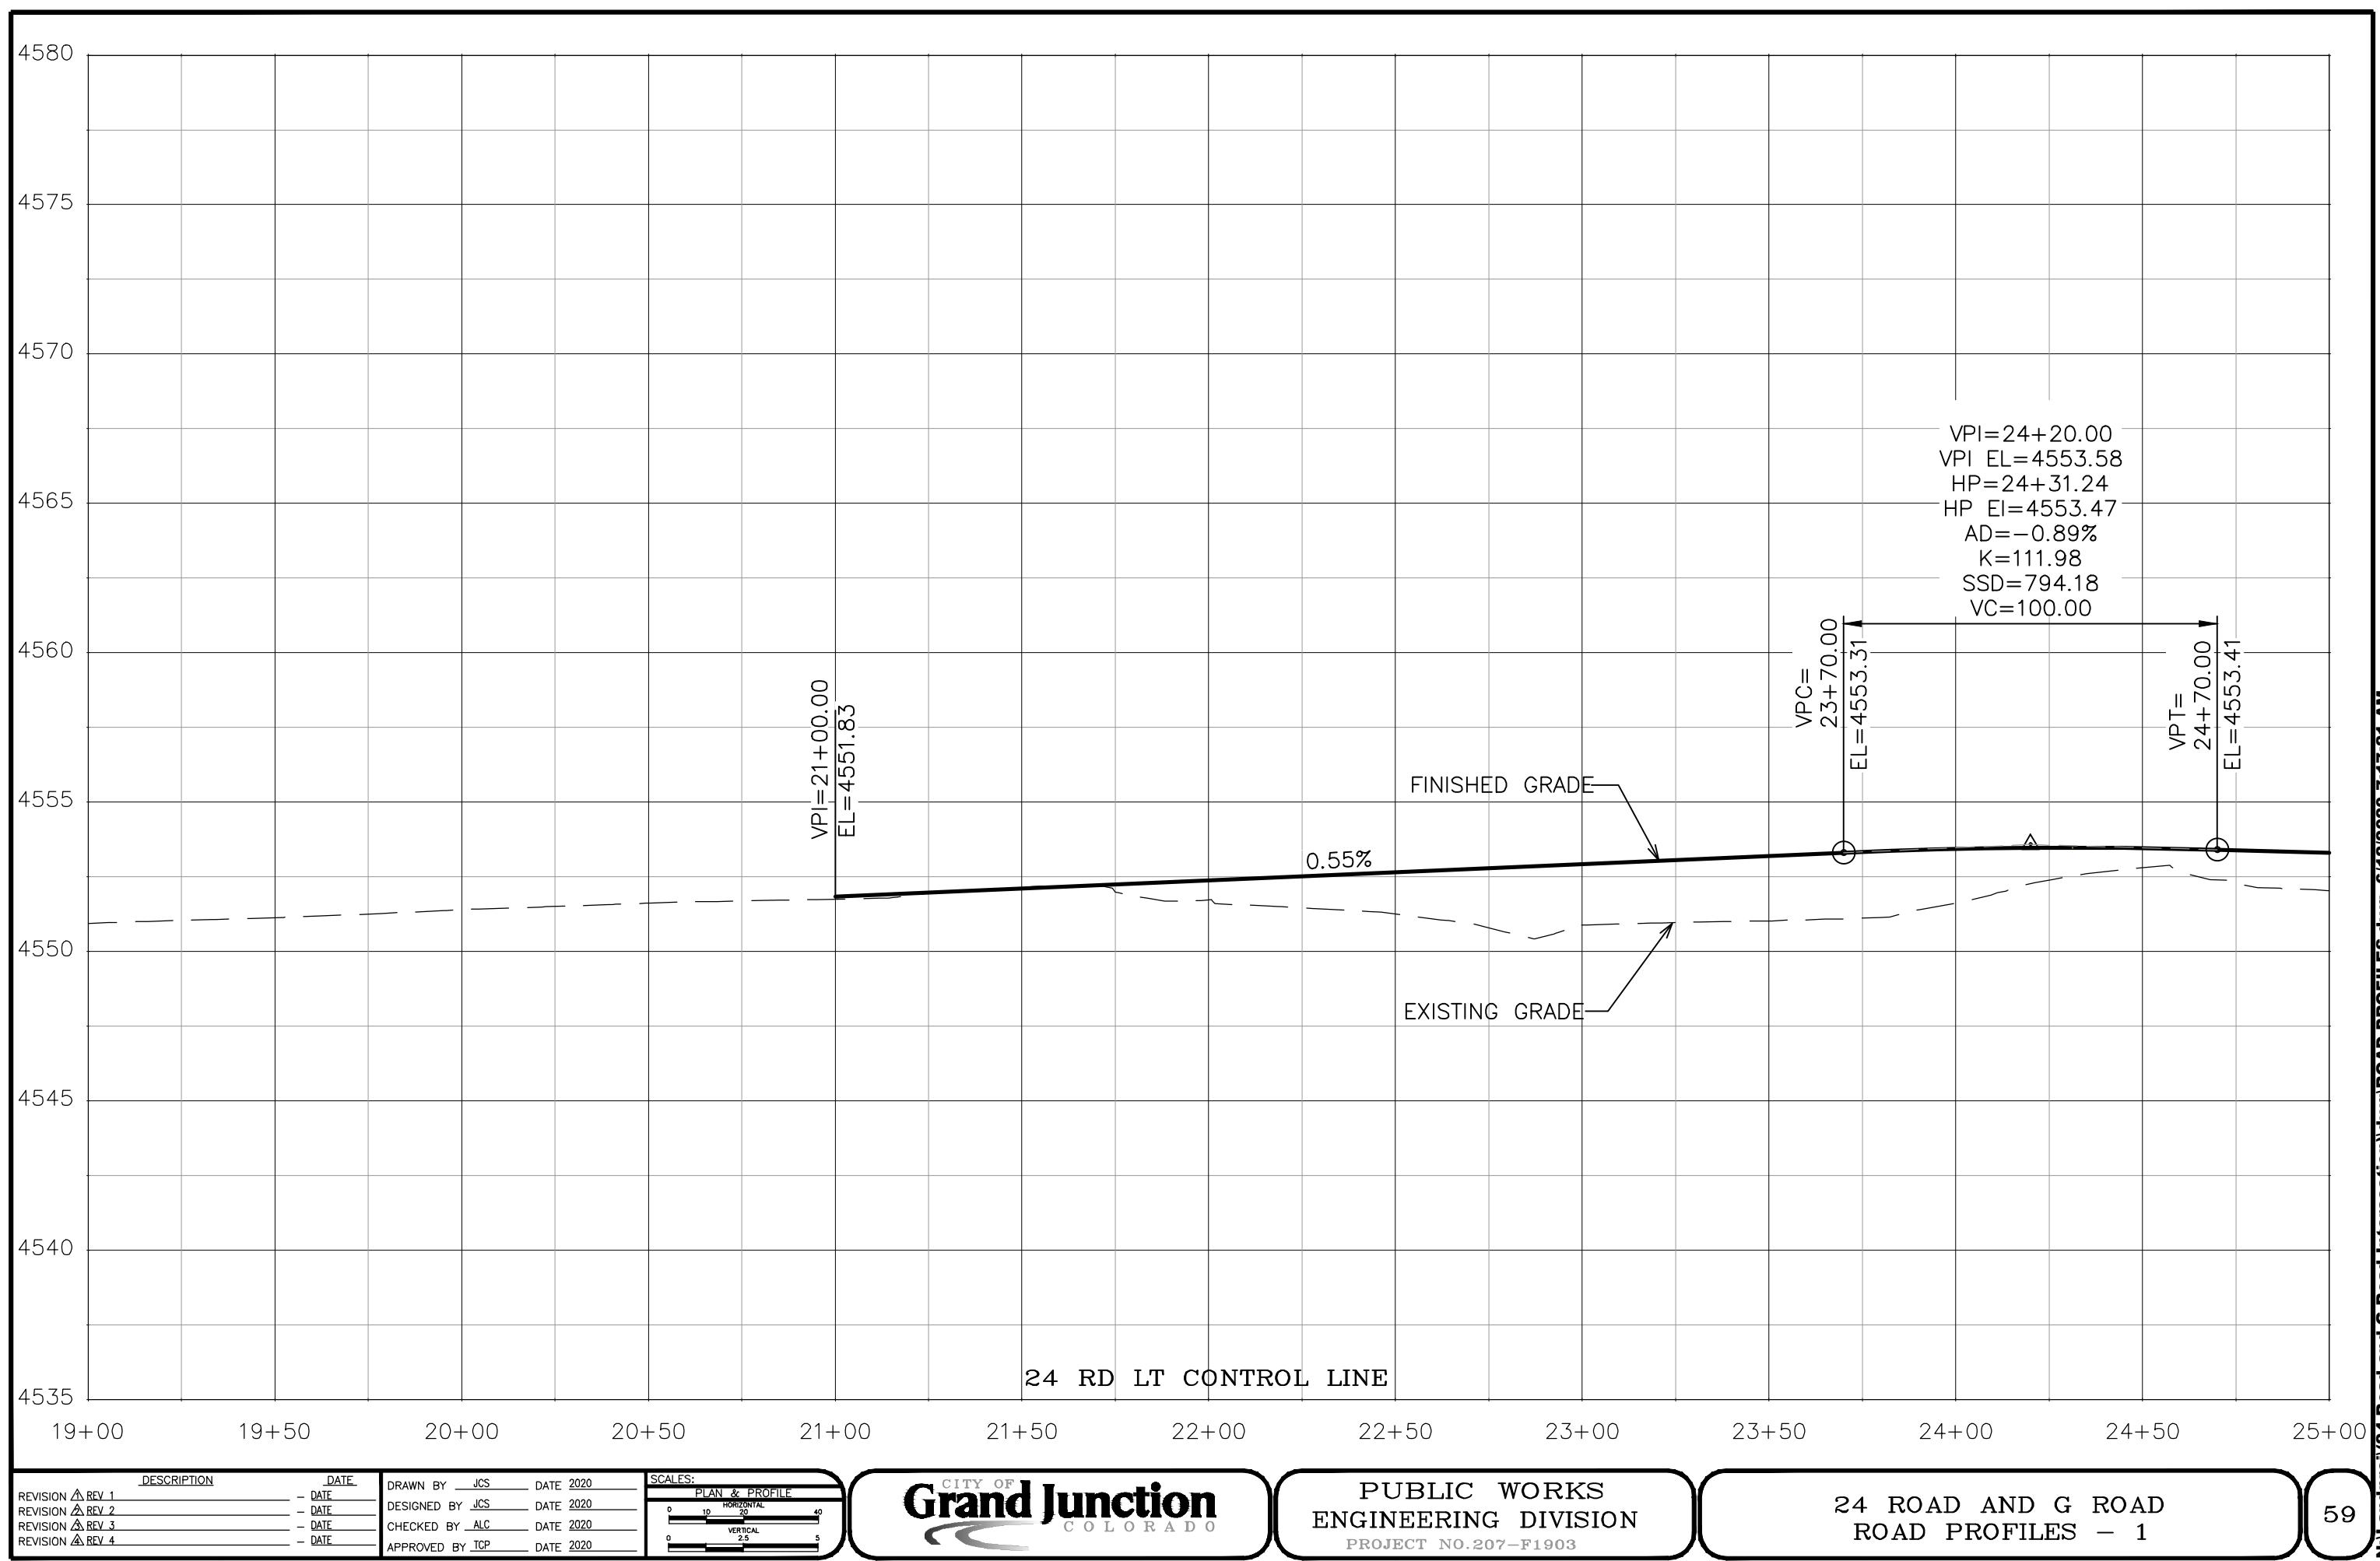

DESCRIPTION	DATE
REVISION A REV 1	- DATE
REVISION A REV 2	- DATE
REVISION A REV 3	- DATE
REVISION A REV 4	- DATE


DRAWN BY JCS	DATE 2020
DESIGNED BY JCS	DATE 2020
CHECKED BY ALC	DATE 2020
APPROVED BY TCP	DATE 2020

SCALES:	PLAN & PROFILE		
0	10	20	40
0	2.5	5	



PUBLIC WORKS
 ENGINEERING DIVISION
 PROJECT NO. 207-F1903

24 ROAD AND G ROAD
 ROAD PROFILES - 1

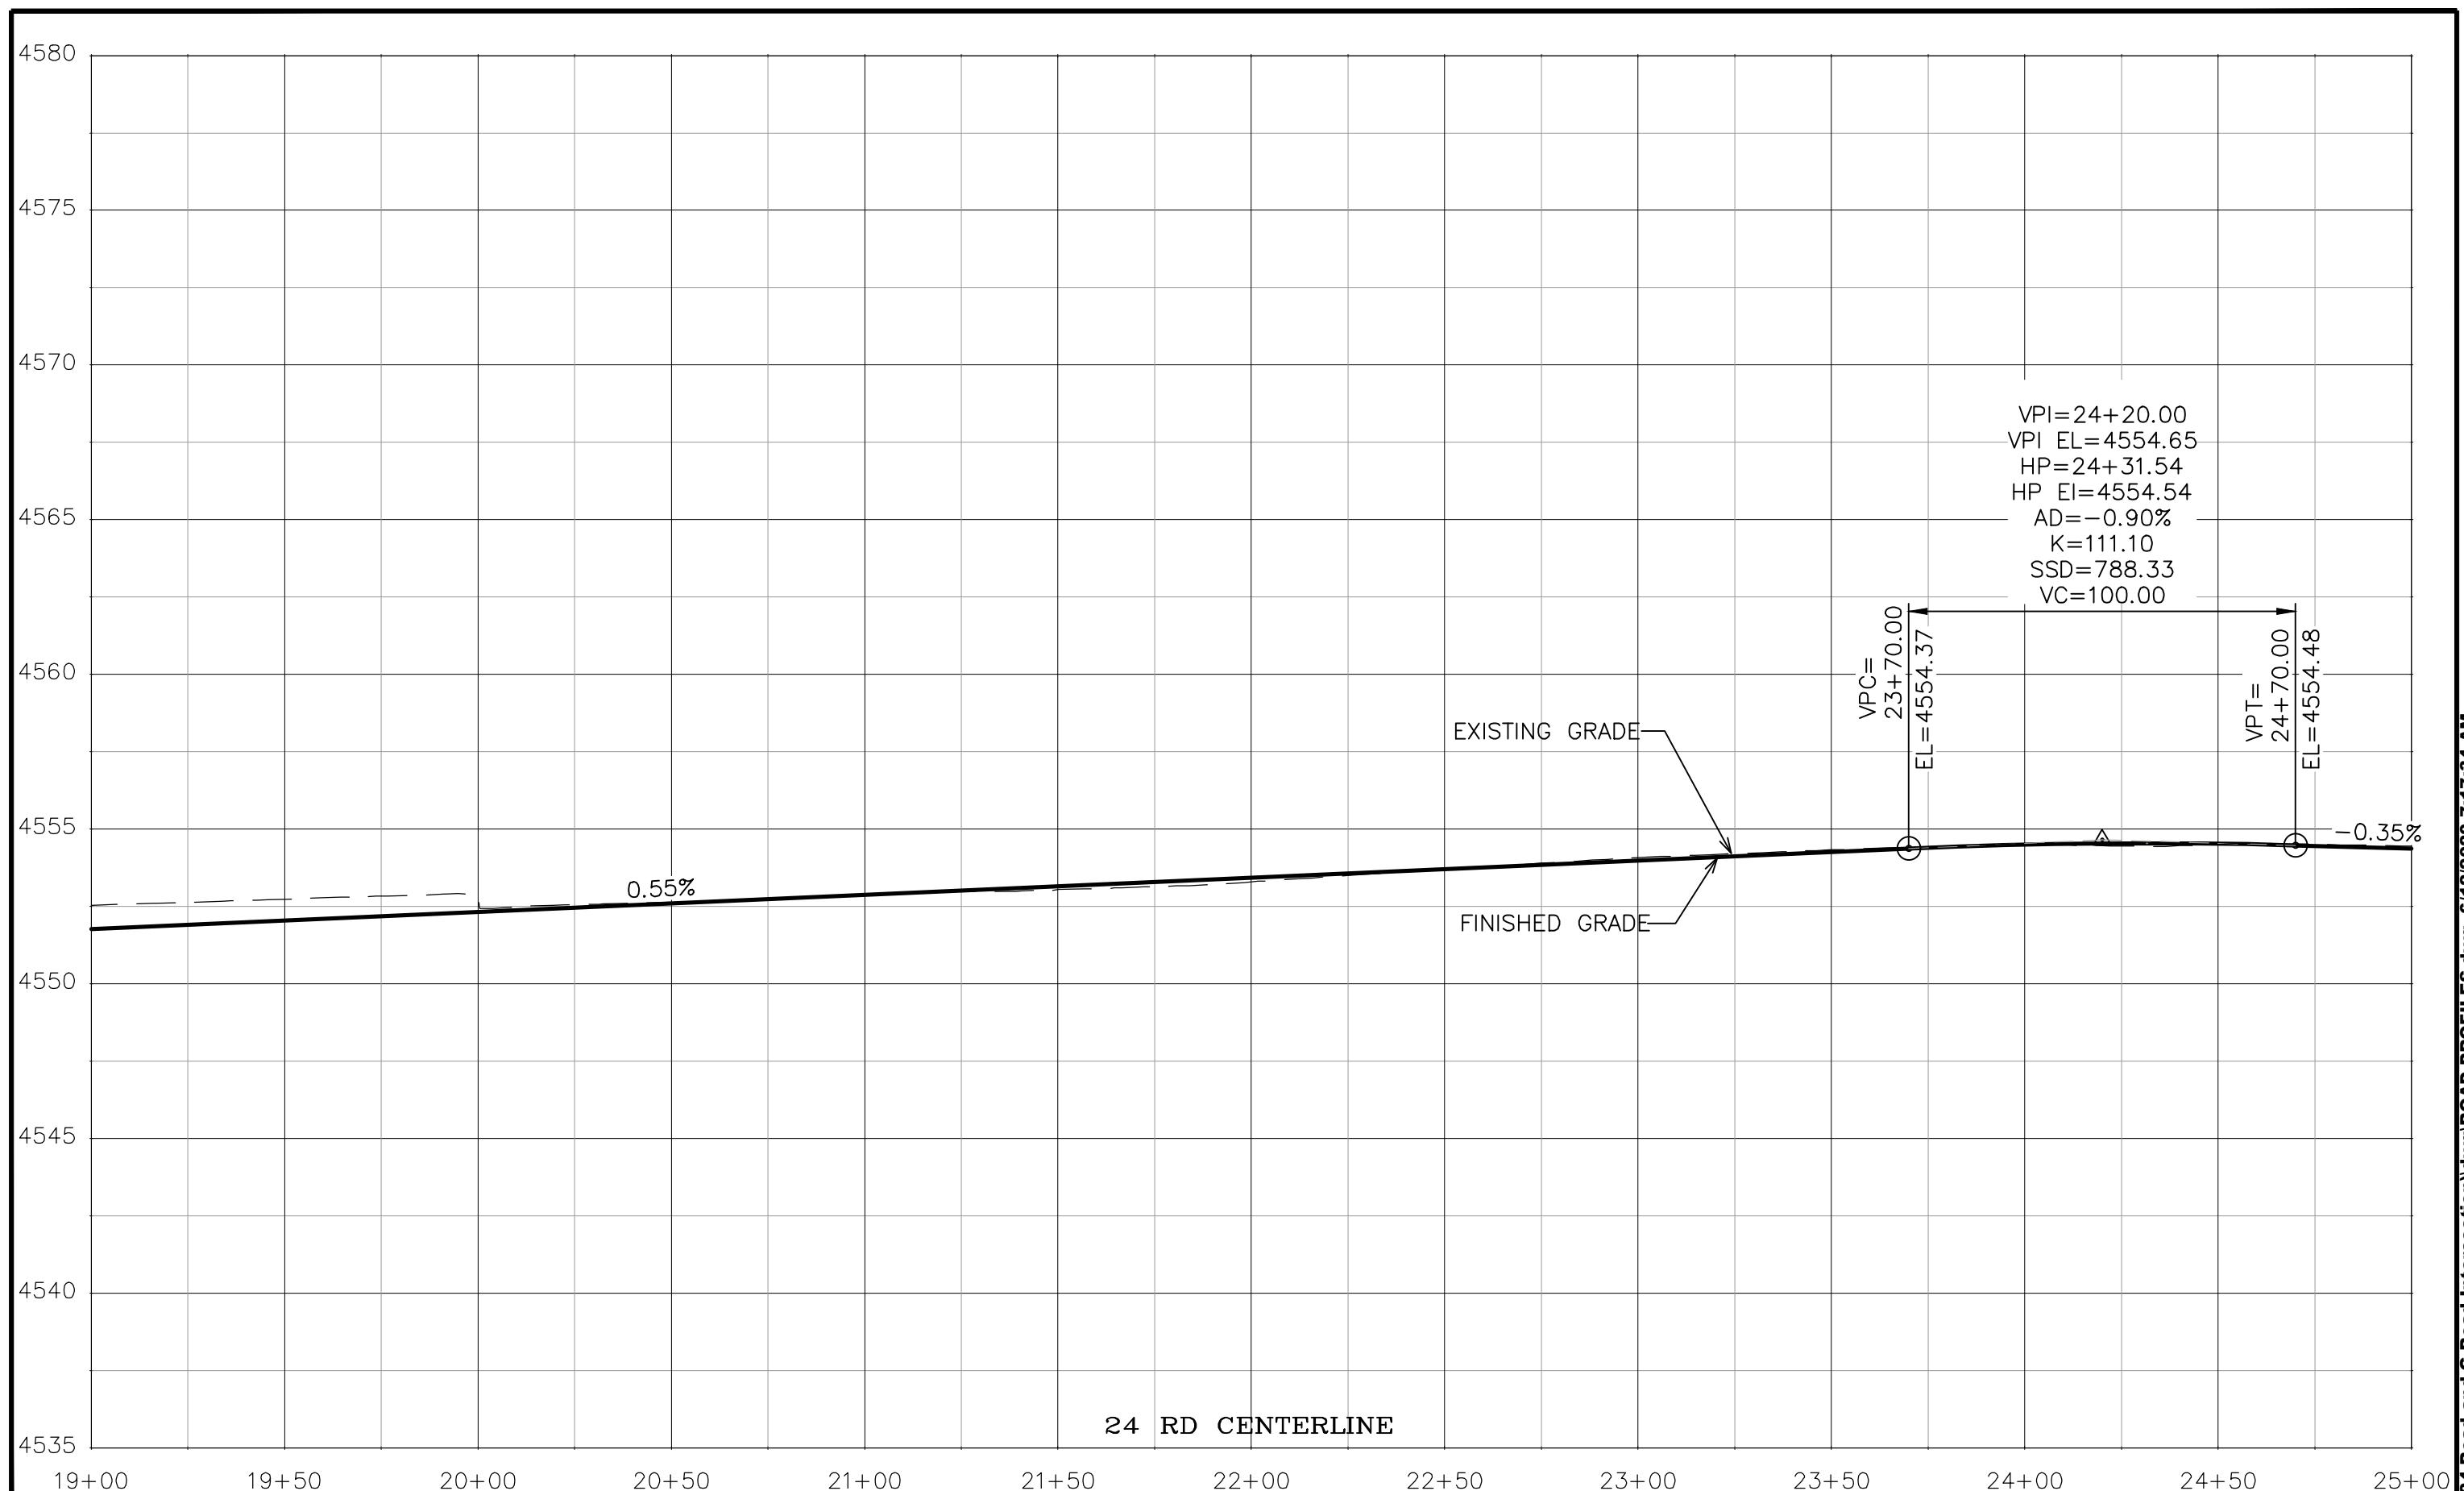

DESCRIPTION	DATE
REVISION ▲ REV 1	- DATE
REVISION ▲ REV 2	- DATE
REVISION ▲ REV 3	- DATE
REVISION ▲ REV 4	- DATE


DRAWN BY	JCS	DATE 2020
DESIGNED BY	JCS	DATE 2020
CHECKED BY	ALC	DATE 2020
APPROVED BY	TCP	DATE 2020


SCALES:	PLAN & PROFILE		
0	10	20	40
0	2.5	5	



PUBLIC WORKS
 ENGINEERING DIVISION
 PROJECT NO. 207-F1903

24 ROAD AND G ROAD
 ROAD PROFILES — 2

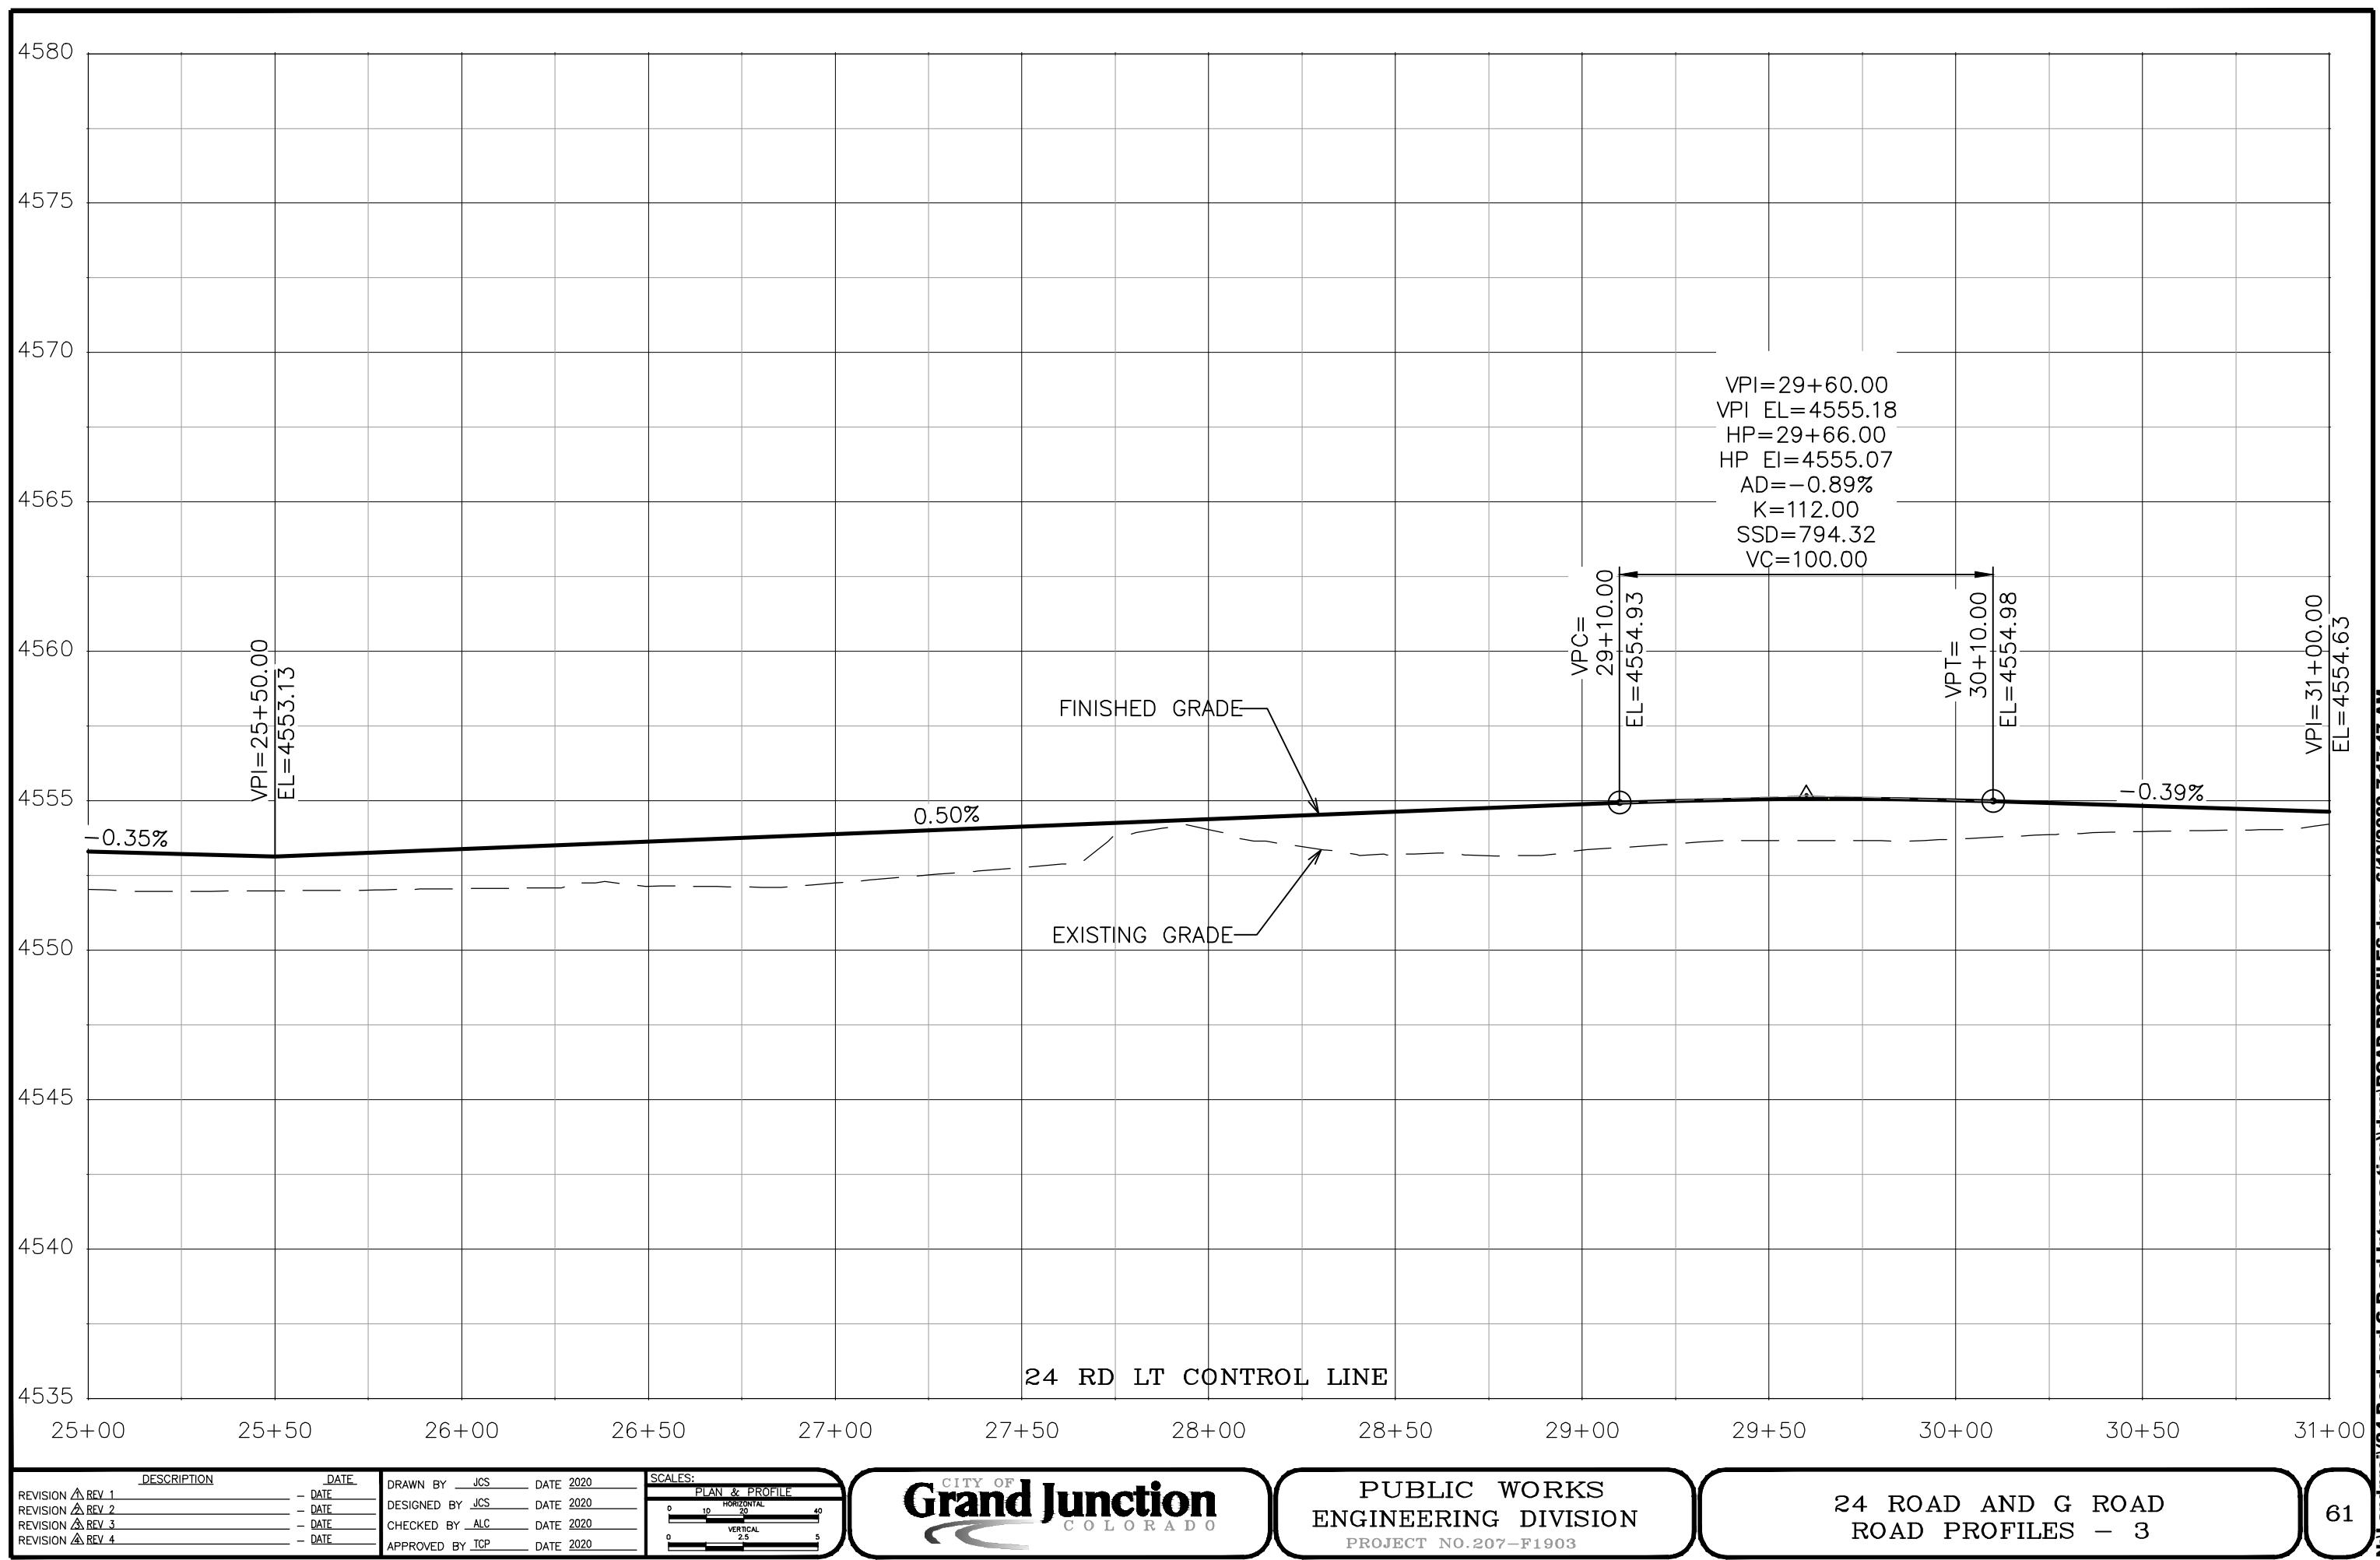

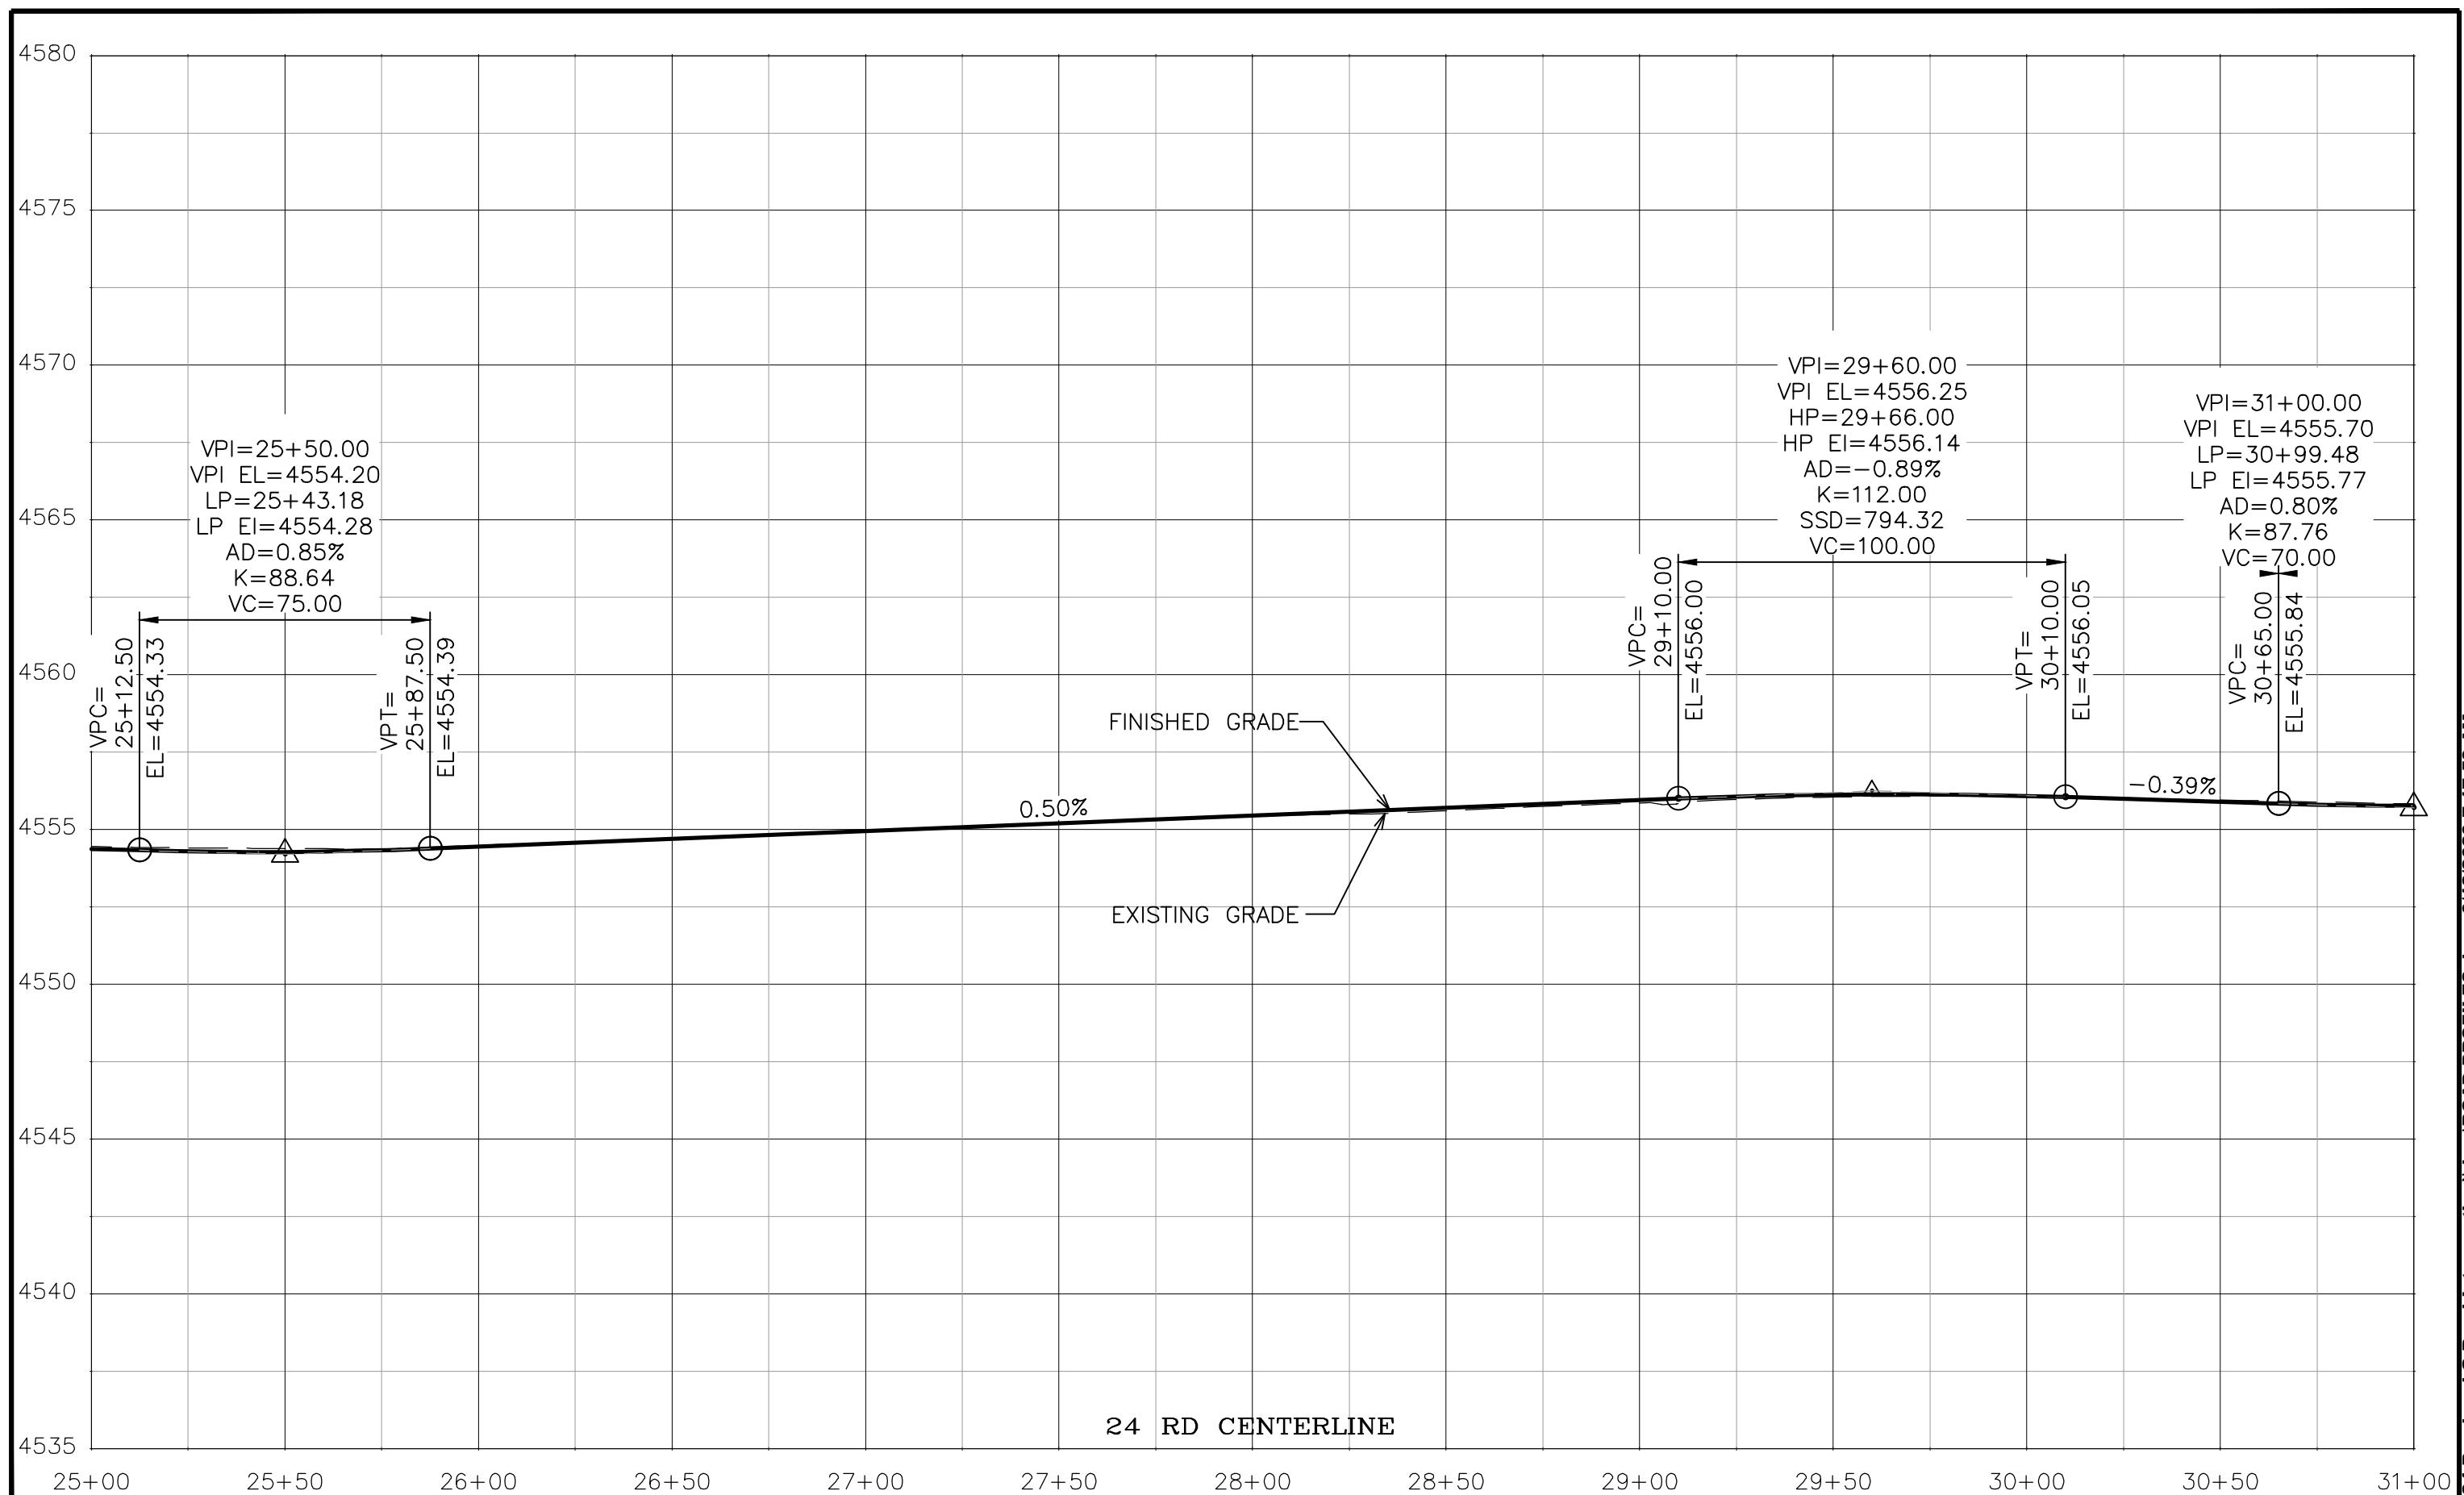

24 RD CENTERLINE

DESCRIPTION	DATE
REVISION ▲ REV 1	— DATE
REVISION ▲ REV 2	— DATE
REVISION ▲ REV 3	— DATE
REVISION ▲ REV 4	— DATE


DRAWN BY	JCS	DATE	2020
DESIGNED BY	JCS	DATE	2020
CHECKED BY	ALC	DATE	2020
APPROVED BY	TCP	DATE	2020


SCALES:			
PLAN & PROFILE			
0	10	20	40
0	2.5	5	



PUBLIC WORKS
ENGINEERING DIVISION
PROJECT NO. 207-F1903

24 ROAD AND G ROAD
ROAD PROFILES — 4

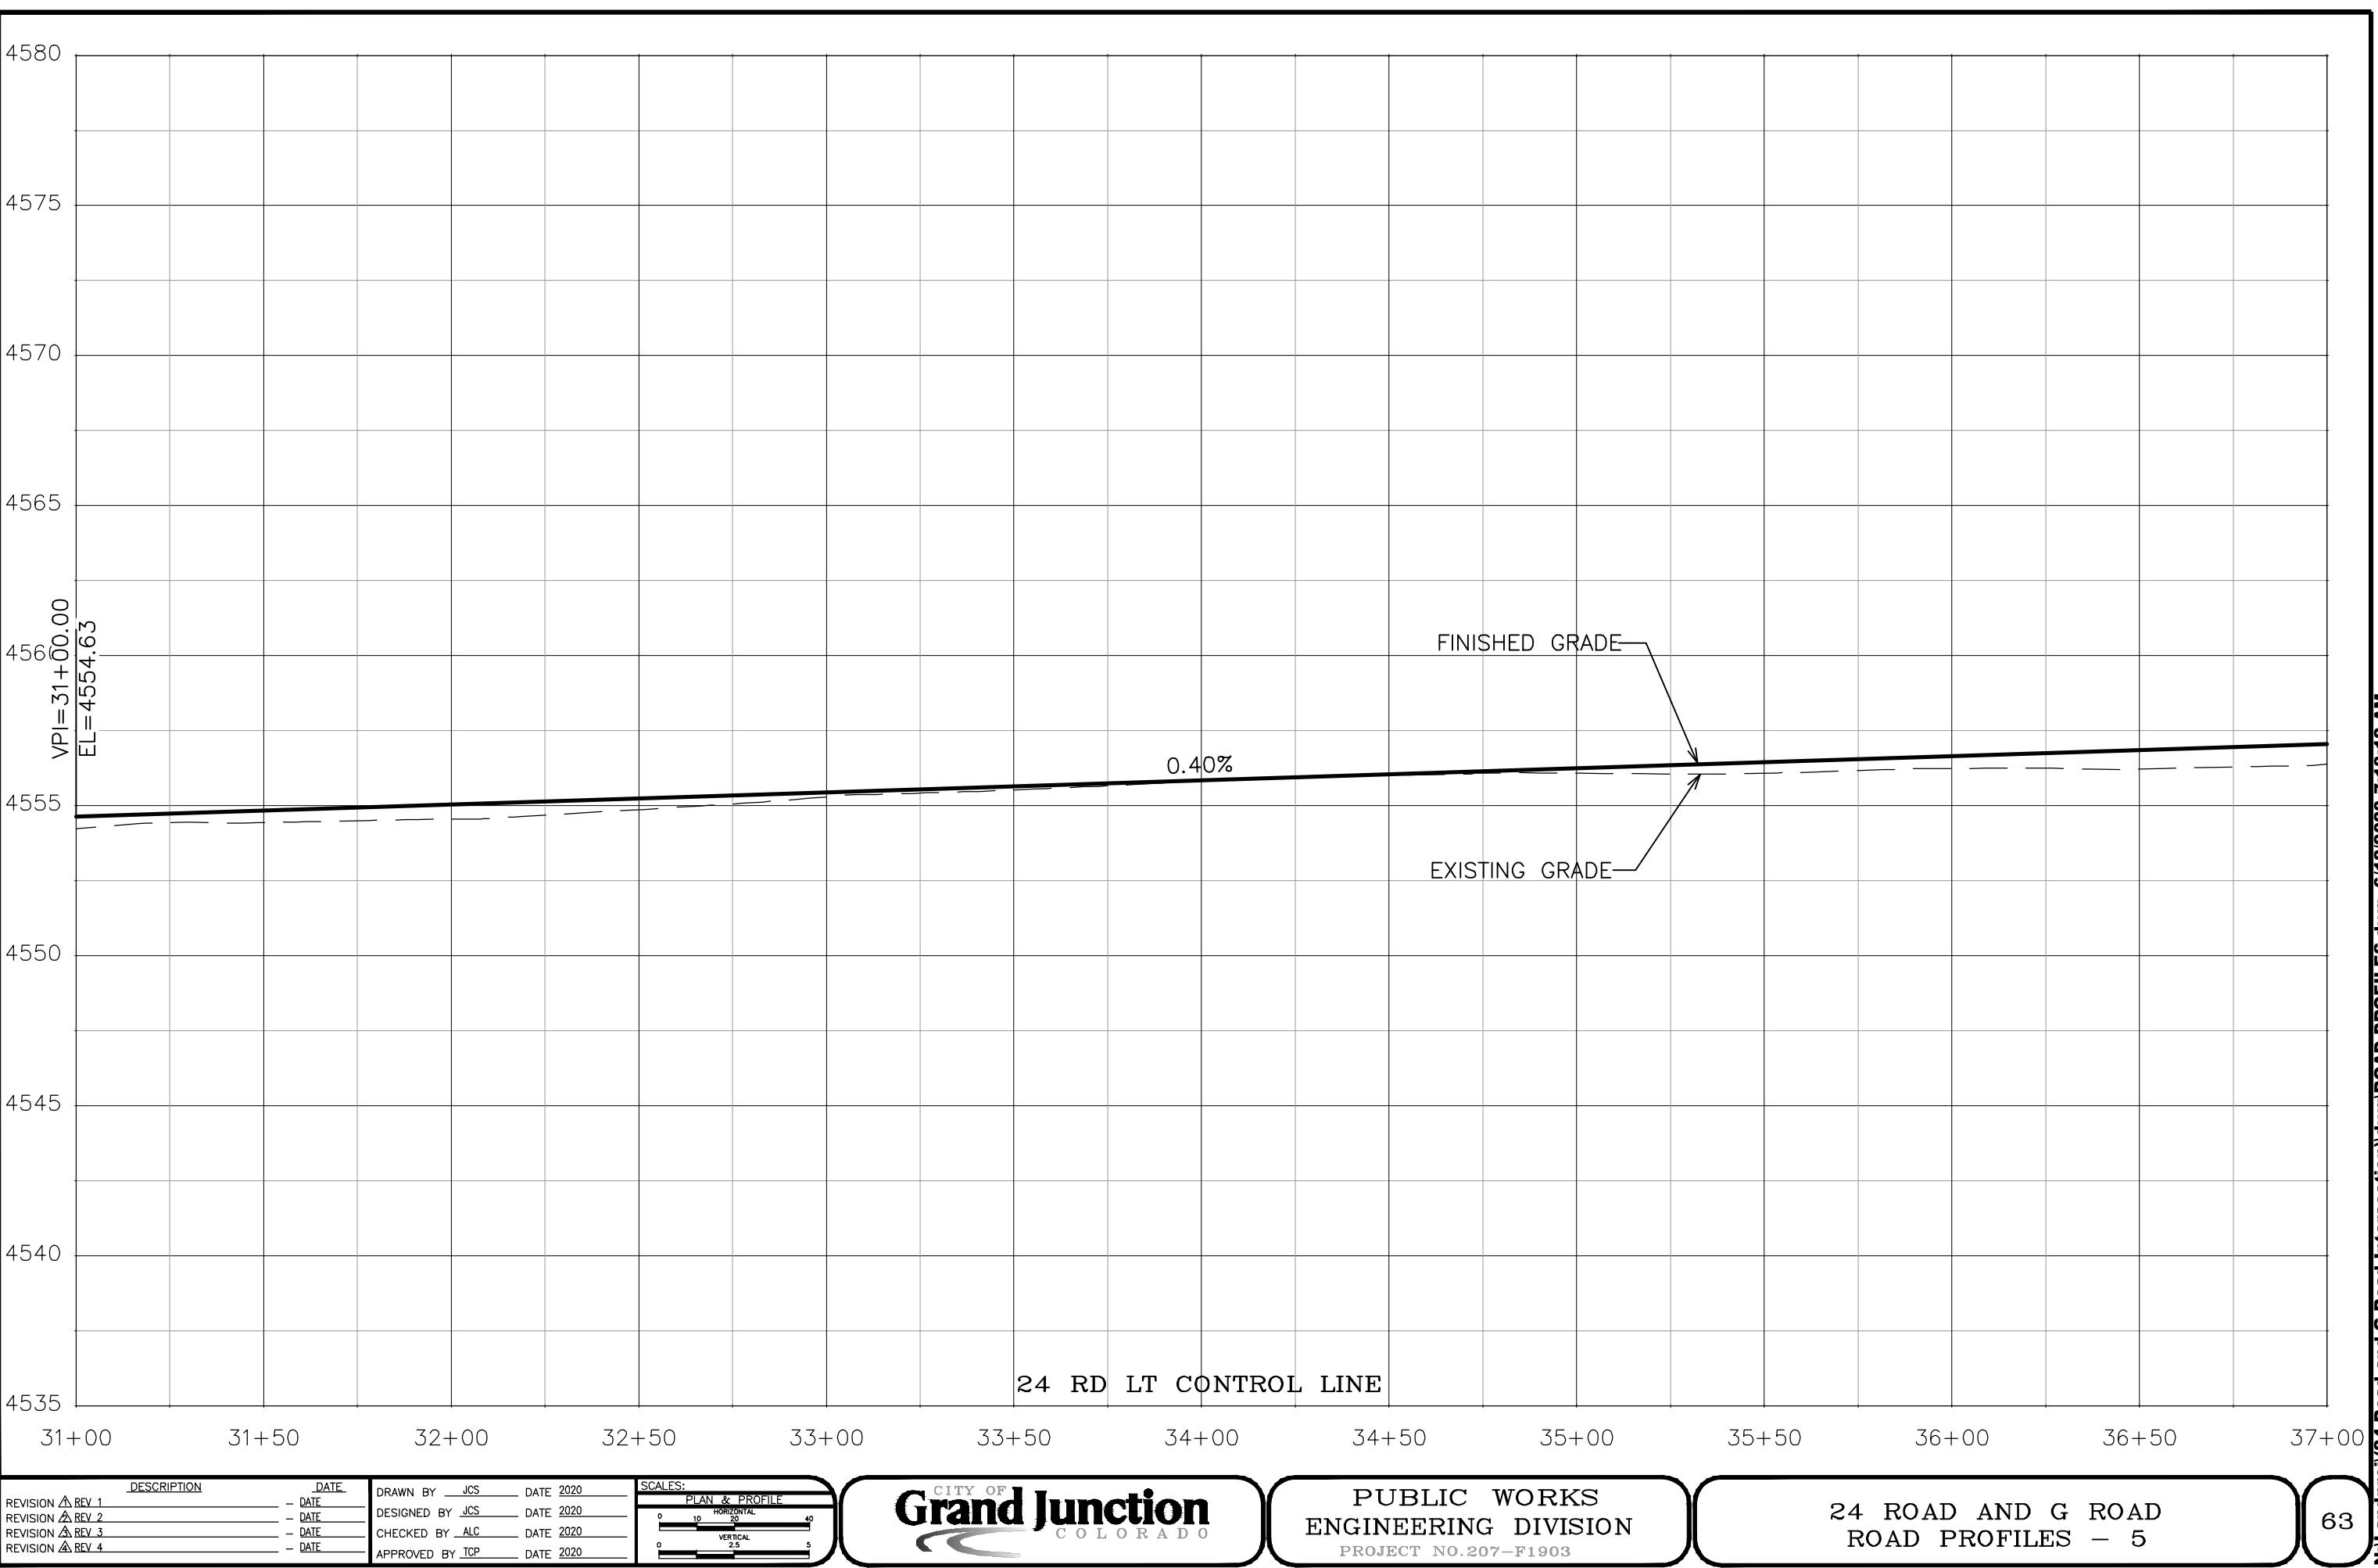

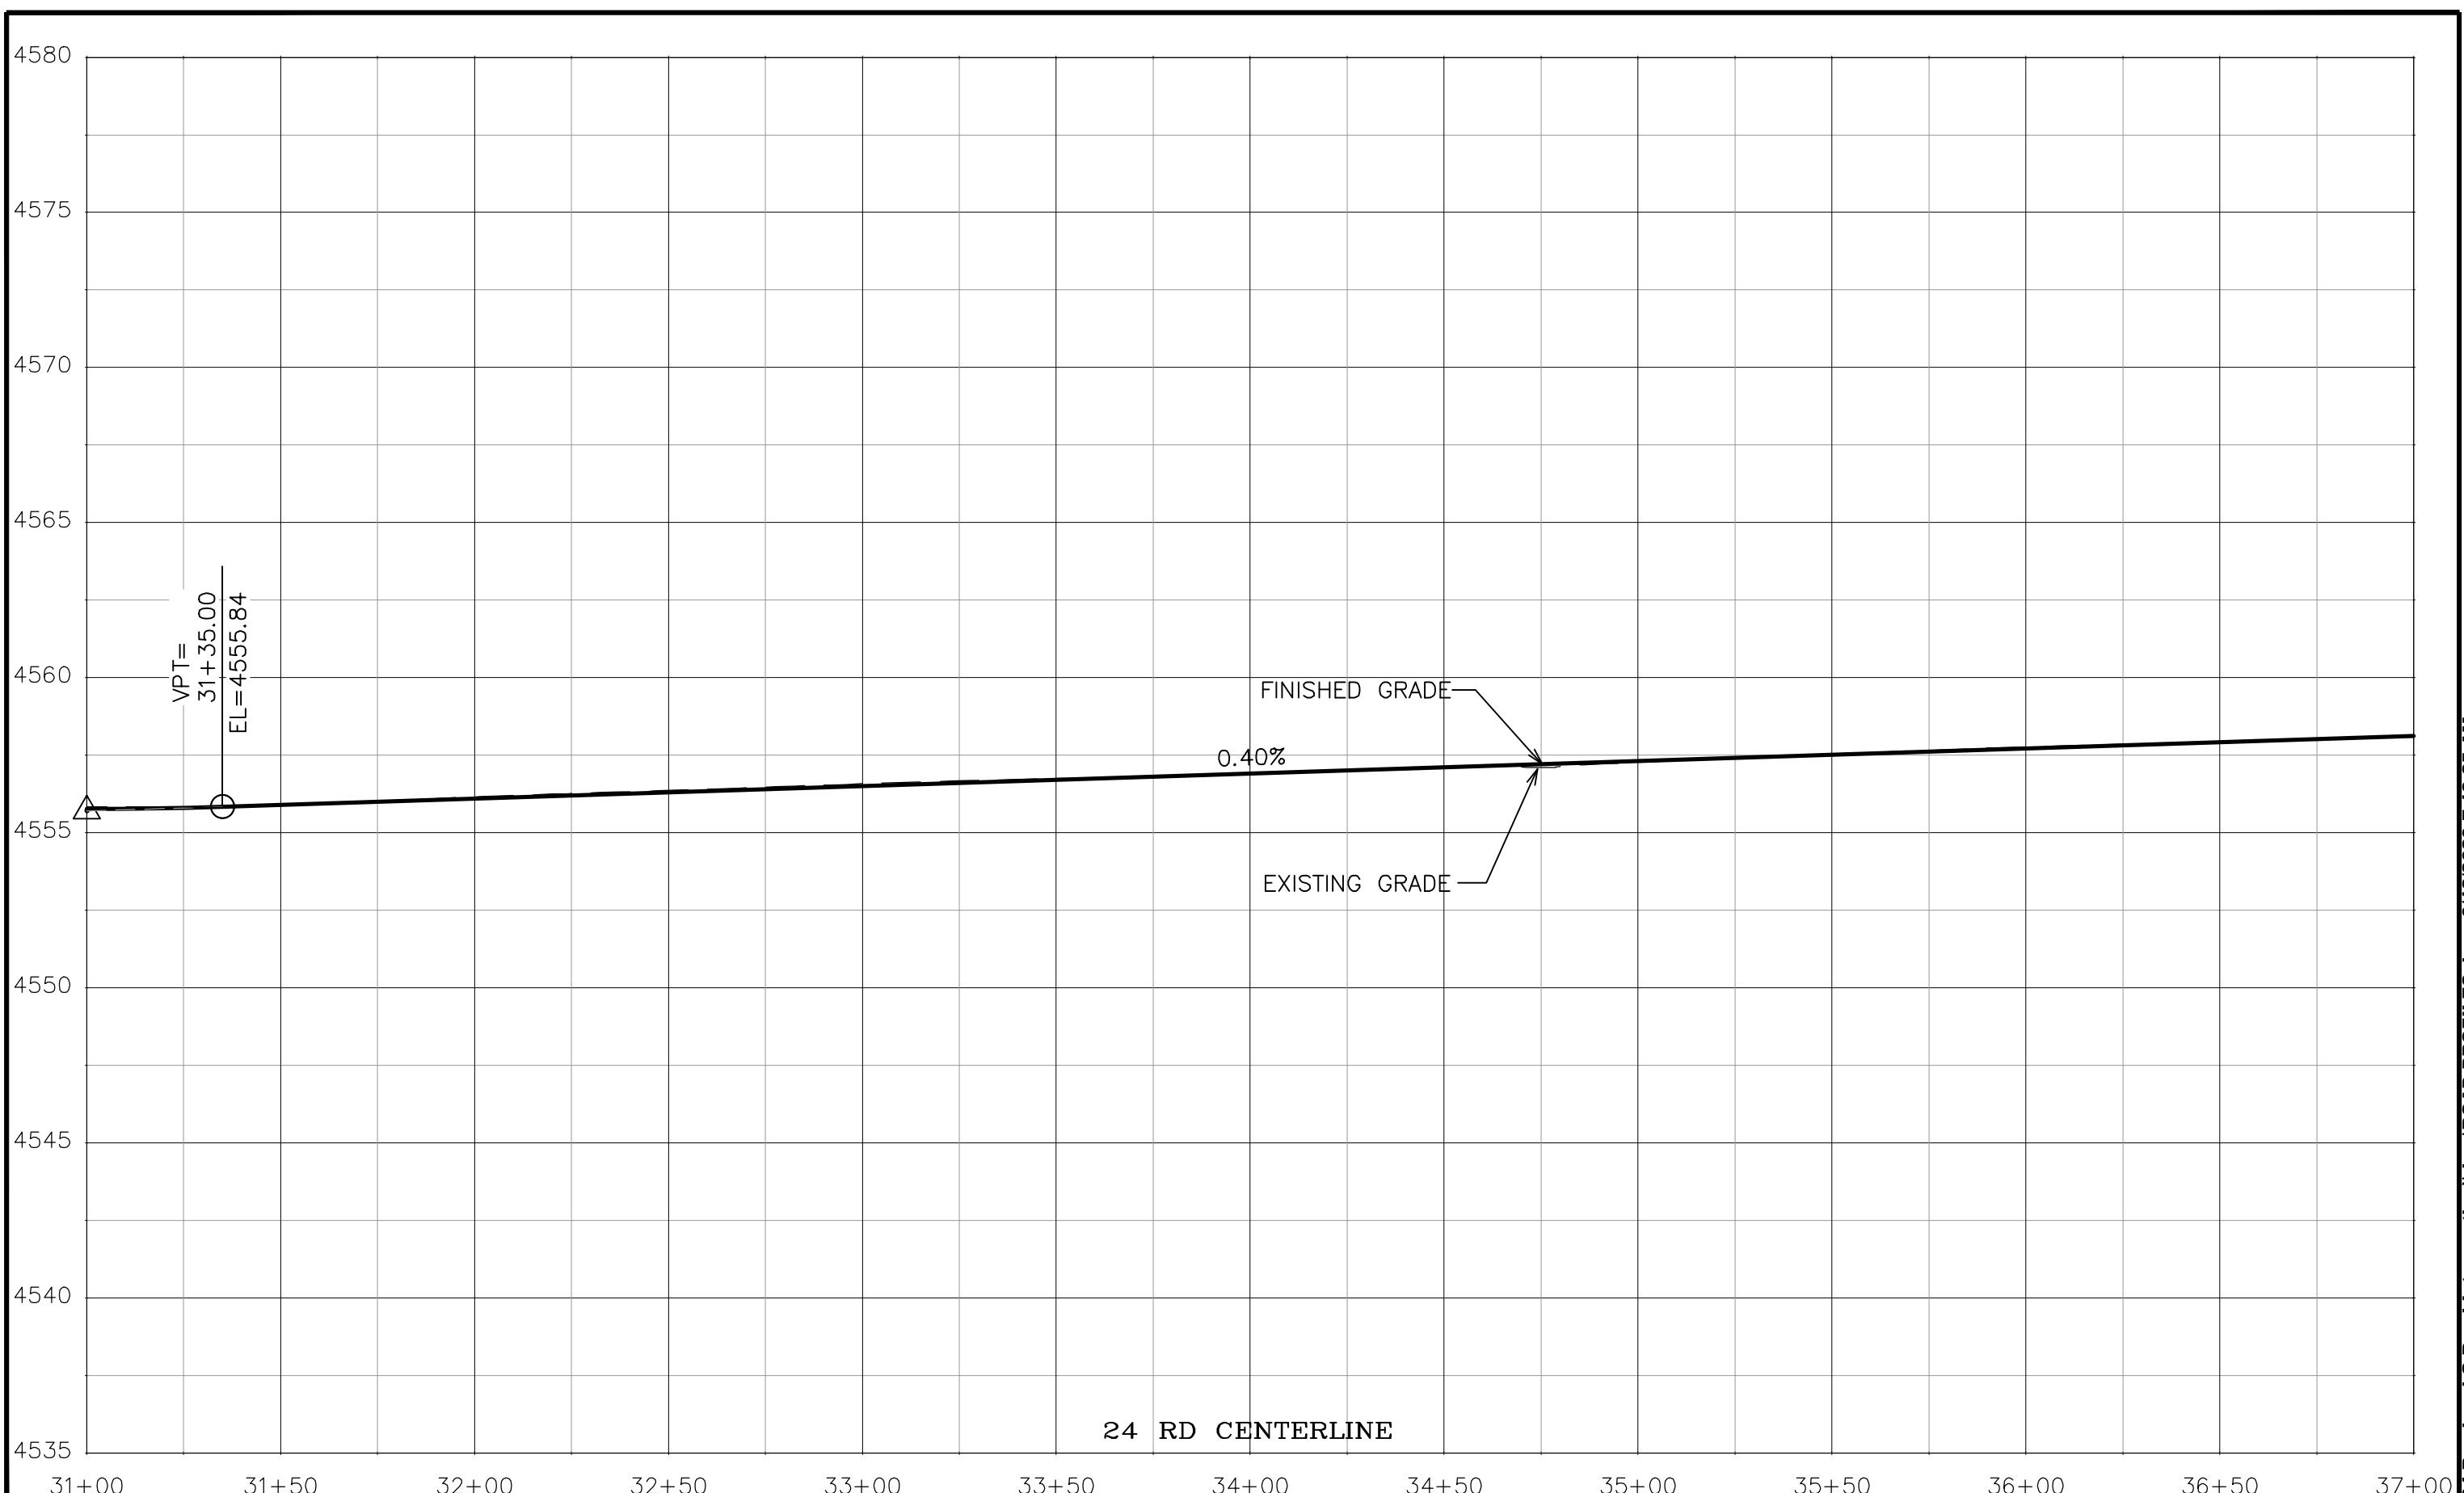

DESCRIPTION	DATE
REVISION ▲ REV 1	- DATE
REVISION ▲ REV 2	- DATE
REVISION ▲ REV 3	- DATE
REVISION ▲ REV 4	- DATE


DRAWN BY	JCS	DATE 2020
DESIGNED BY	JCS	DATE 2020
CHECKED BY	ALC	DATE 2020
APPROVED BY	TCP	DATE 2020

SCALES:	PLAN & PROFILE		
0	10	20	40
	HORIZONTAL		
0	2.5	5	
	VERTICAL		



PUBLIC WORKS
ENGINEERING DIVISION
PROJECT NO. 207-F1903

24 ROAD AND G ROAD
ROAD PROFILES — 6

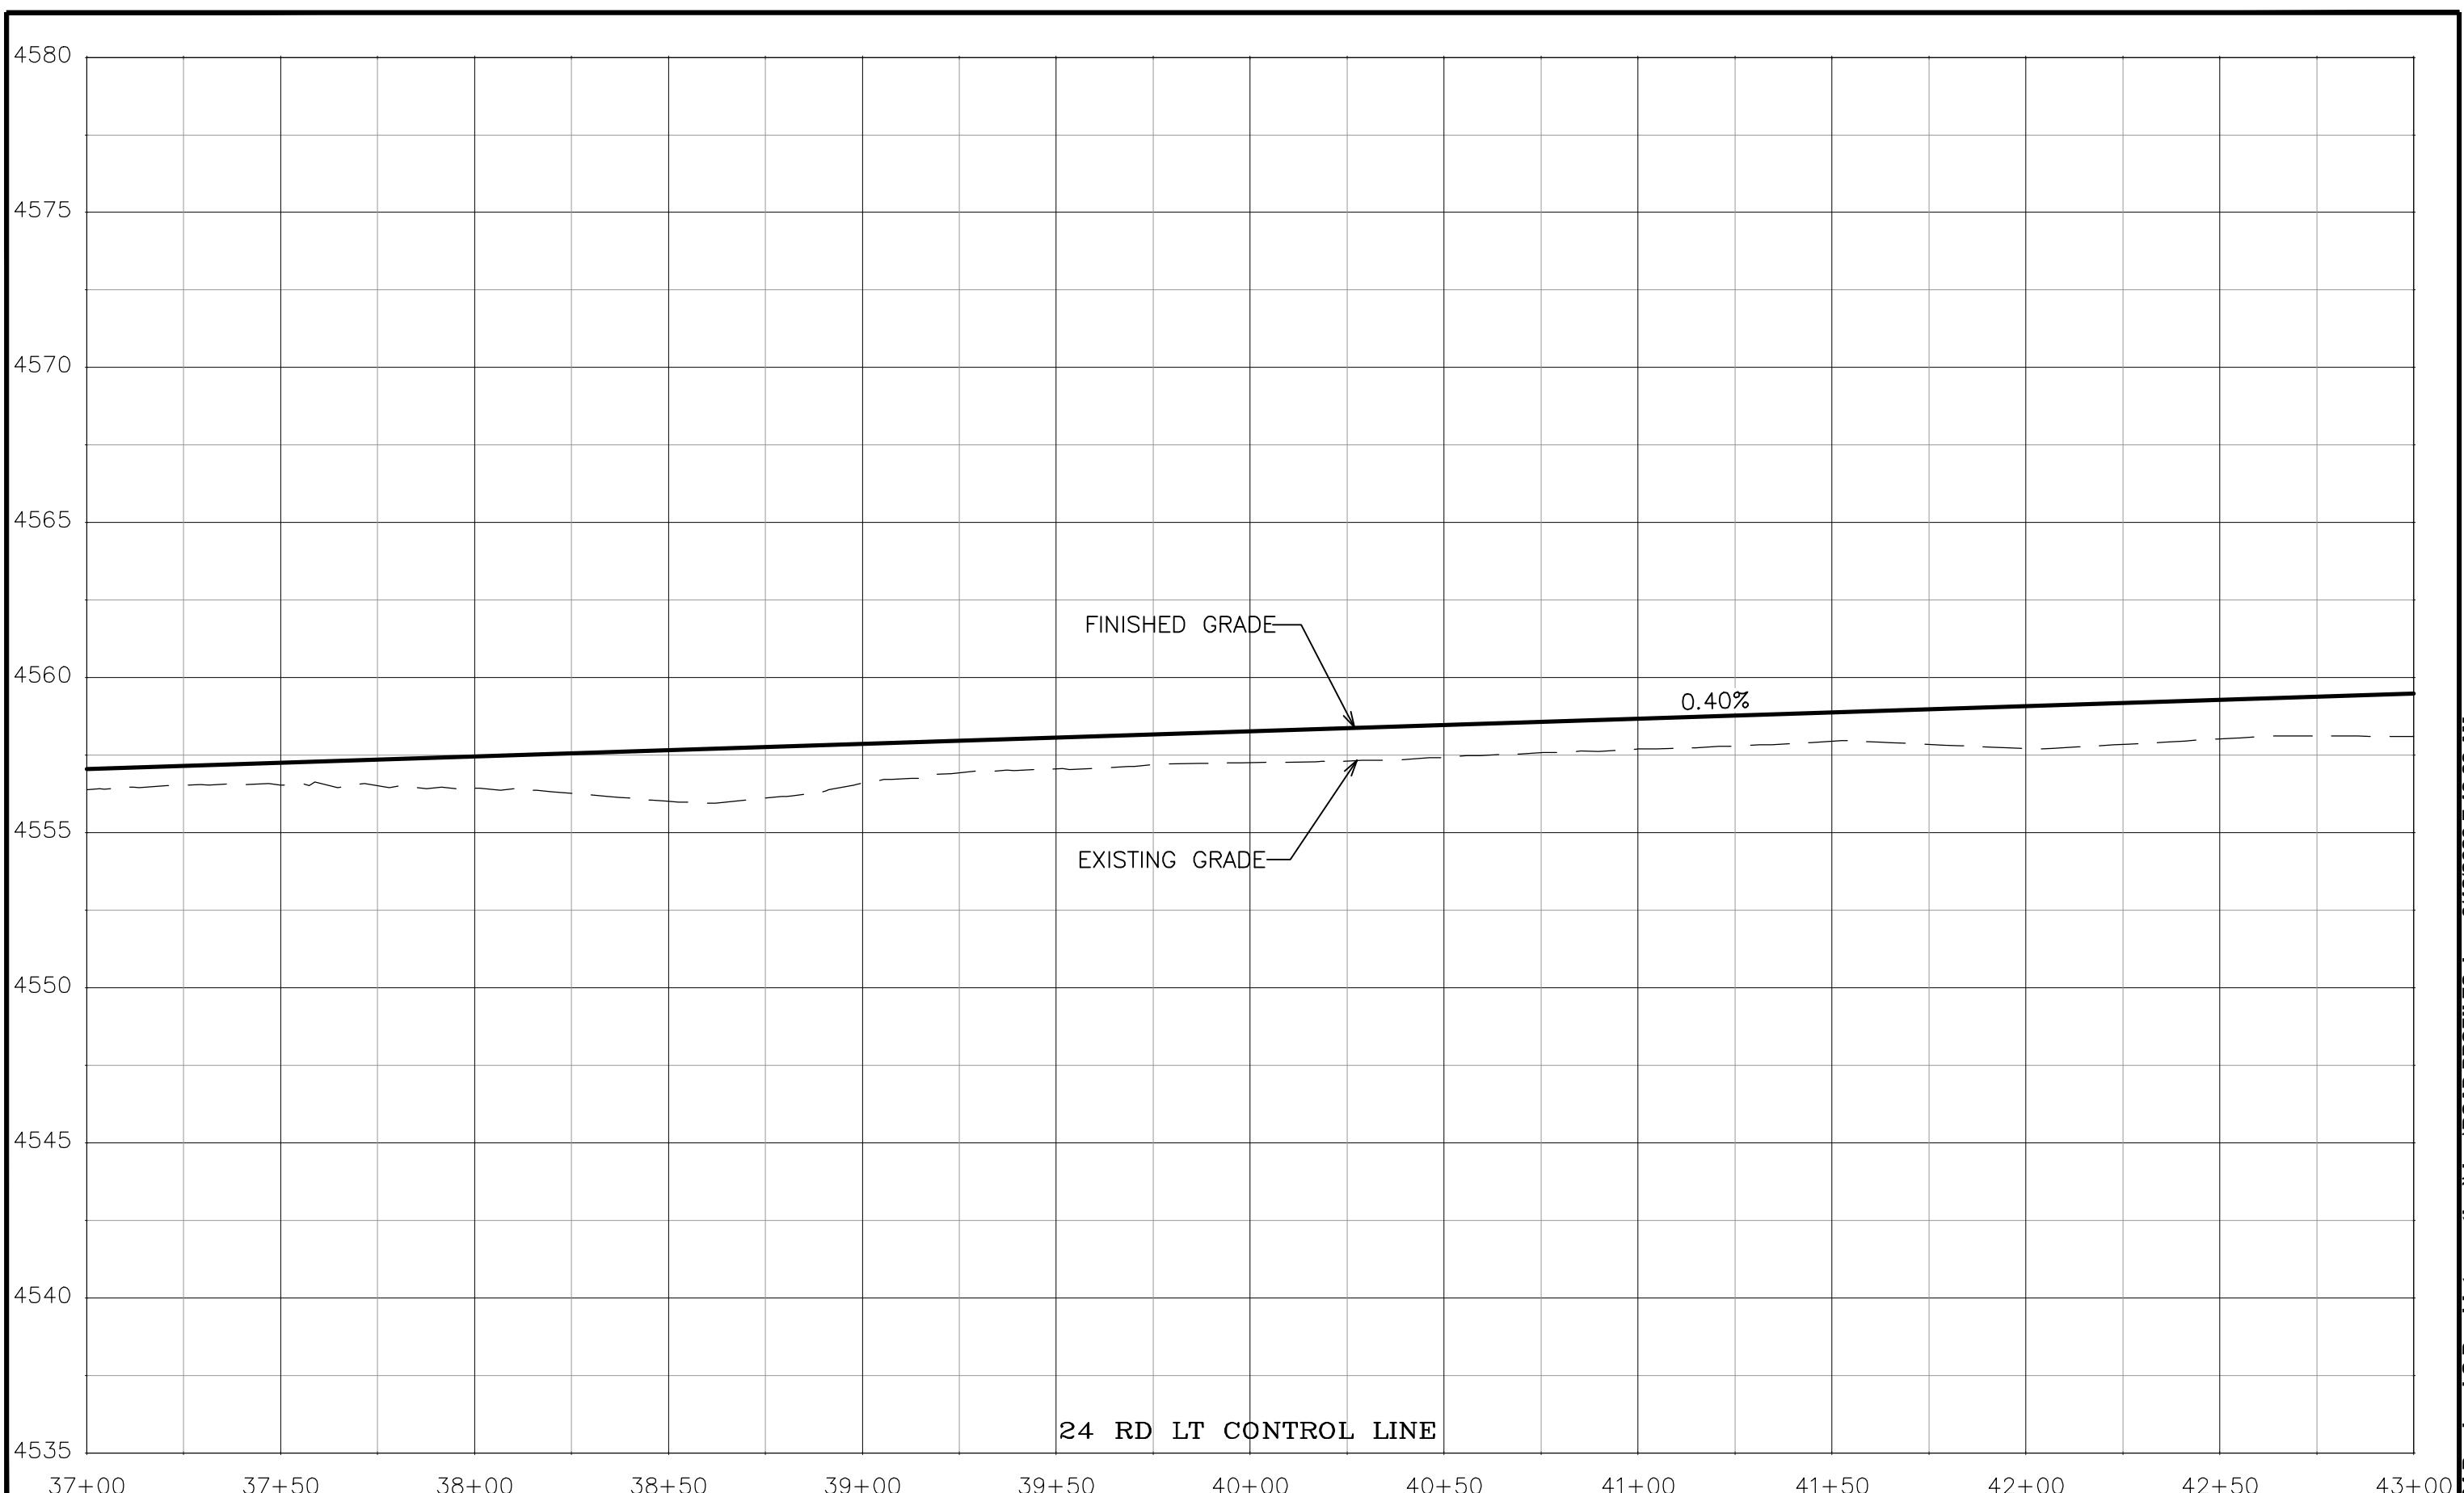

DESCRIPTION DATE
REVISION ▲ REV 1 - DATE
REVISION ▲ REV 2 - DATE
REVISION ▲ REV 3 - DATE
REVISION ▲ REV 4 - DATE


DRAWN BY JCS DATE 2020
DESIGNED BY JCS DATE 2020
CHECKED BY ALC DATE 2020
APPROVED BY TCP DATE 2020

SCALES:
PLAN & PROFILE
0 10 20 40
HORIZONTAL
0 2.5 5
VERTICAL



PUBLIC WORKS
ENGINEERING DIVISION
PROJECT NO. 207-F1903

24 ROAD AND G ROAD
ROAD PROFILES — 7

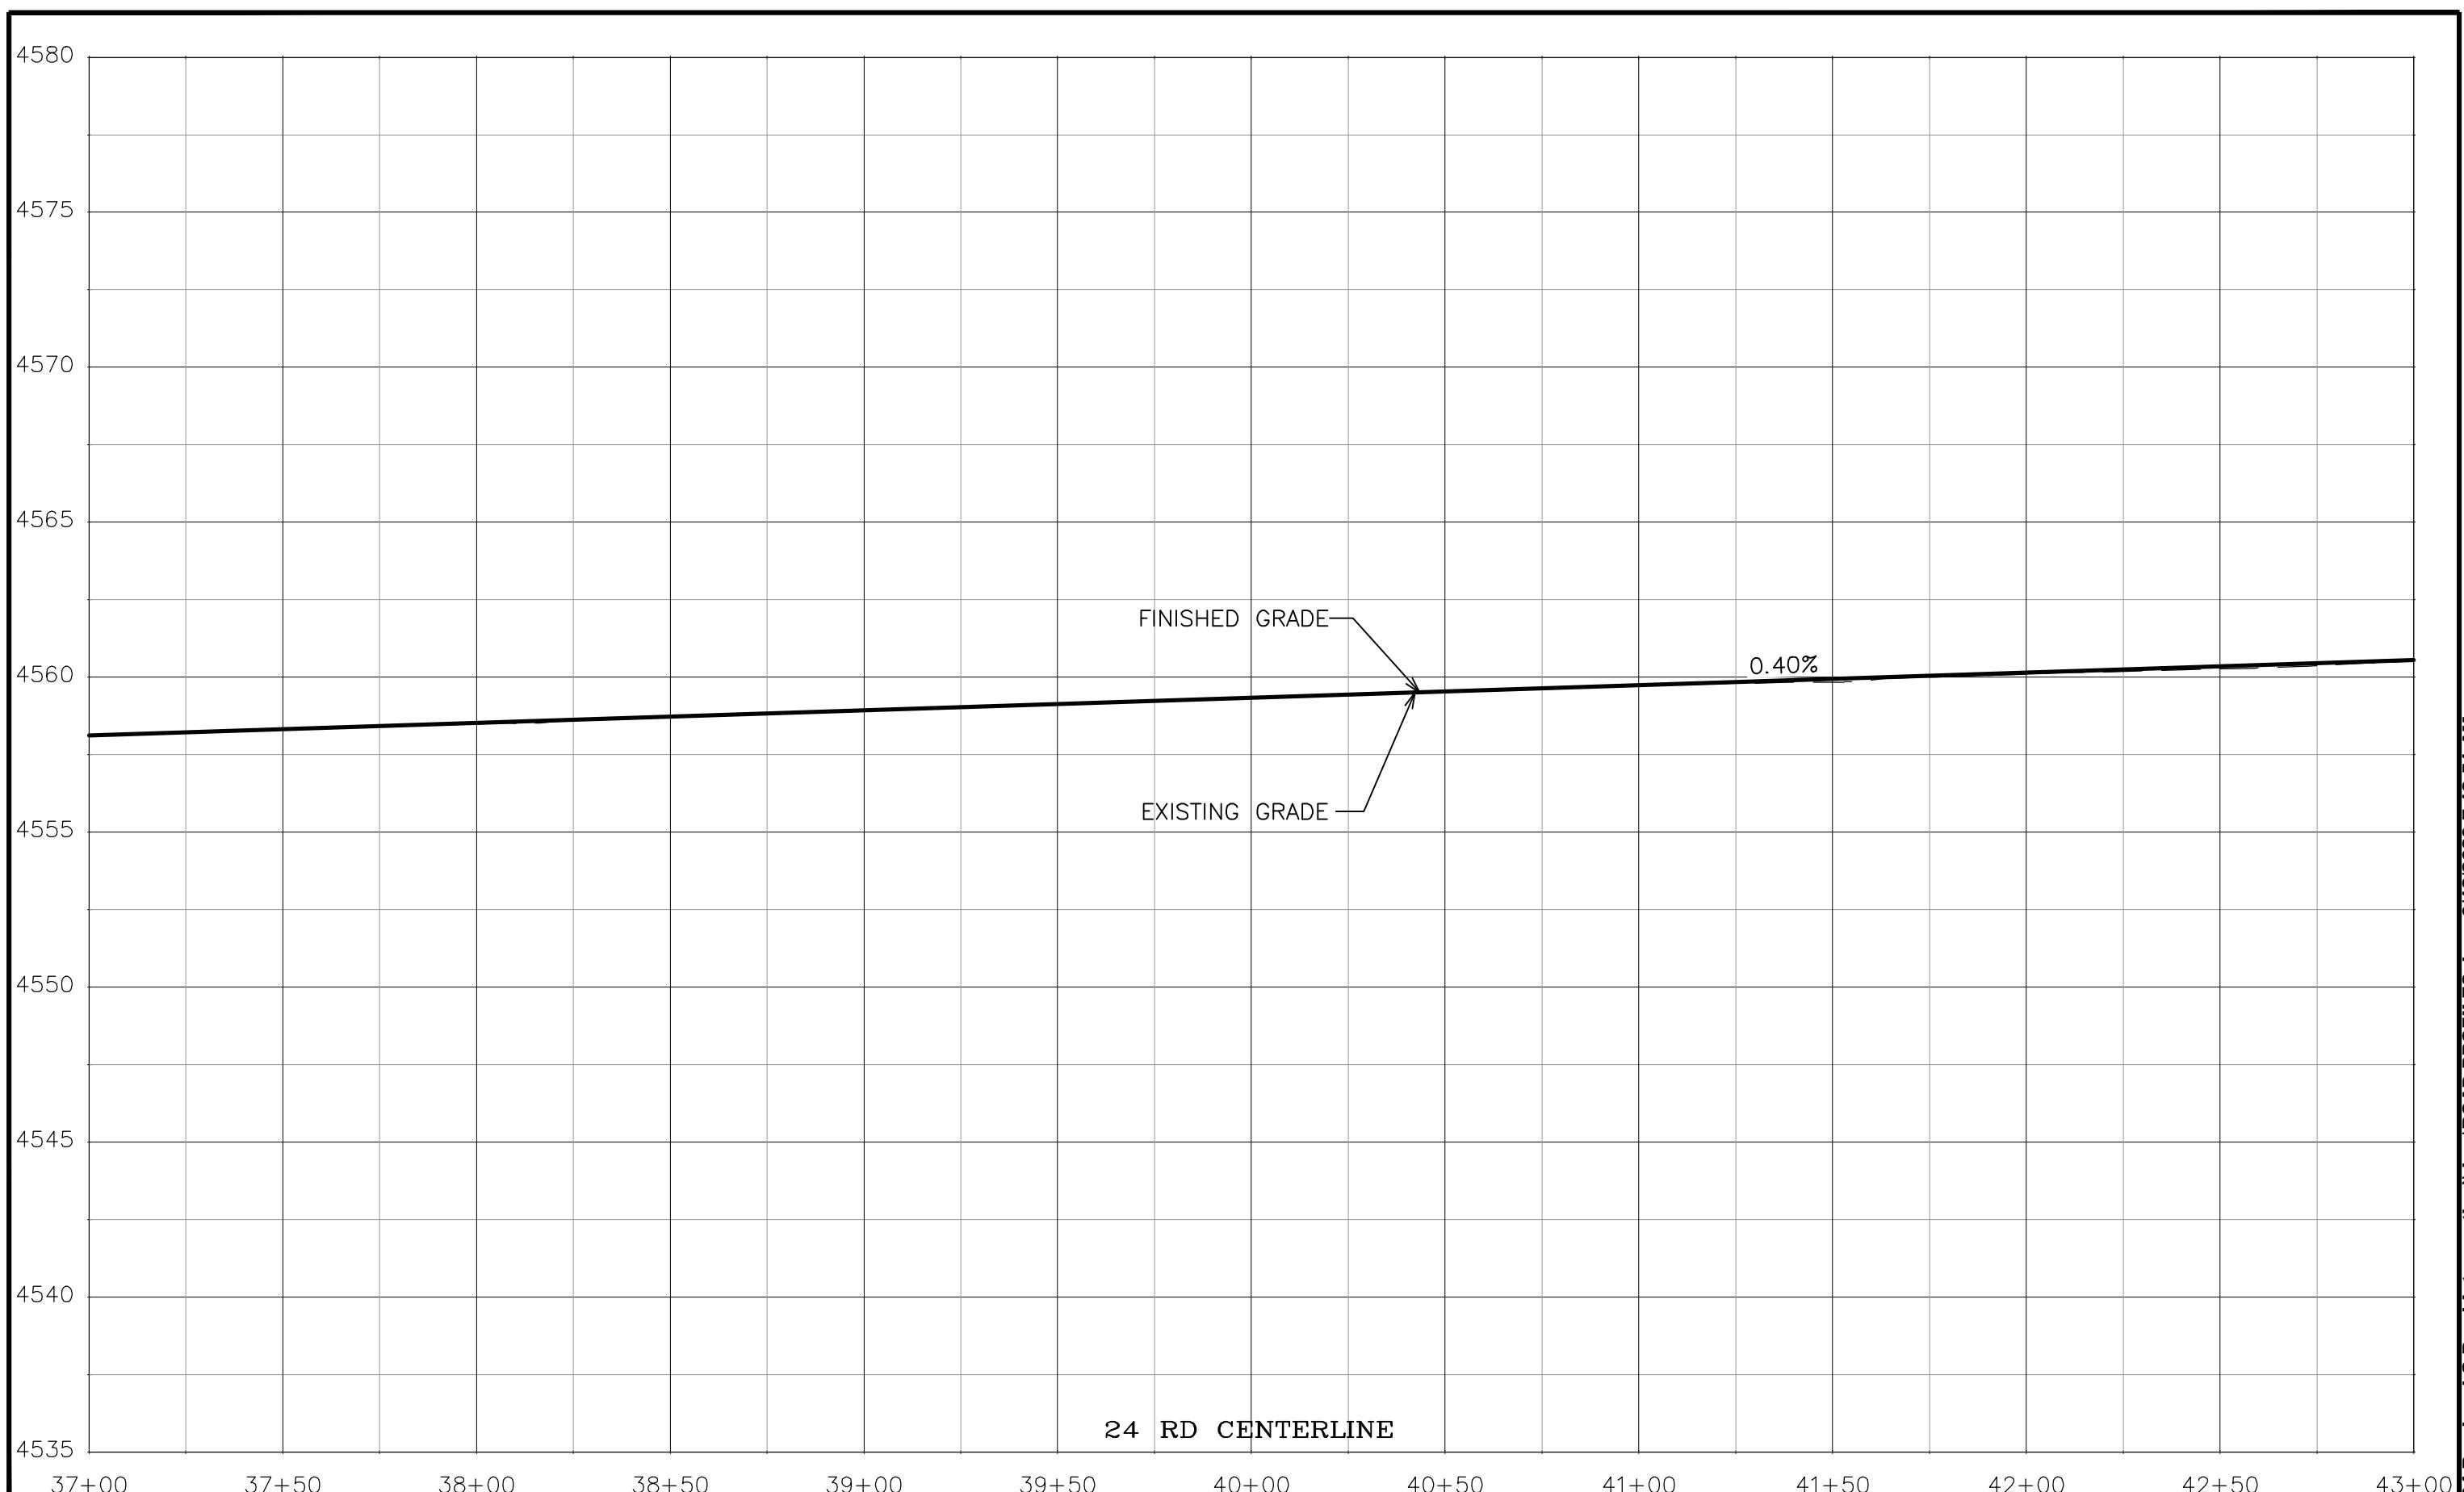

DESCRIPTION DATE
 REVISION ▲ REV 1 - DATE
 REVISION ▲ REV 2 - DATE
 REVISION ▲ REV 3 - DATE
 REVISION ▲ REV 4 - DATE


DRAWN BY JCS DATE 2020
 DESIGNED BY JCS DATE 2020
 CHECKED BY ALC DATE 2020
 APPROVED BY TCP DATE 2020

SCALES:
 PLAN & PROFILE
 HORIZONTAL: 0 10 20 40
 VERTICAL: 0 2.5 5



PUBLIC WORKS
 ENGINEERING DIVISION
 PROJECT NO. 207-F1903

24 ROAD AND G ROAD
 ROAD PROFILES — 8

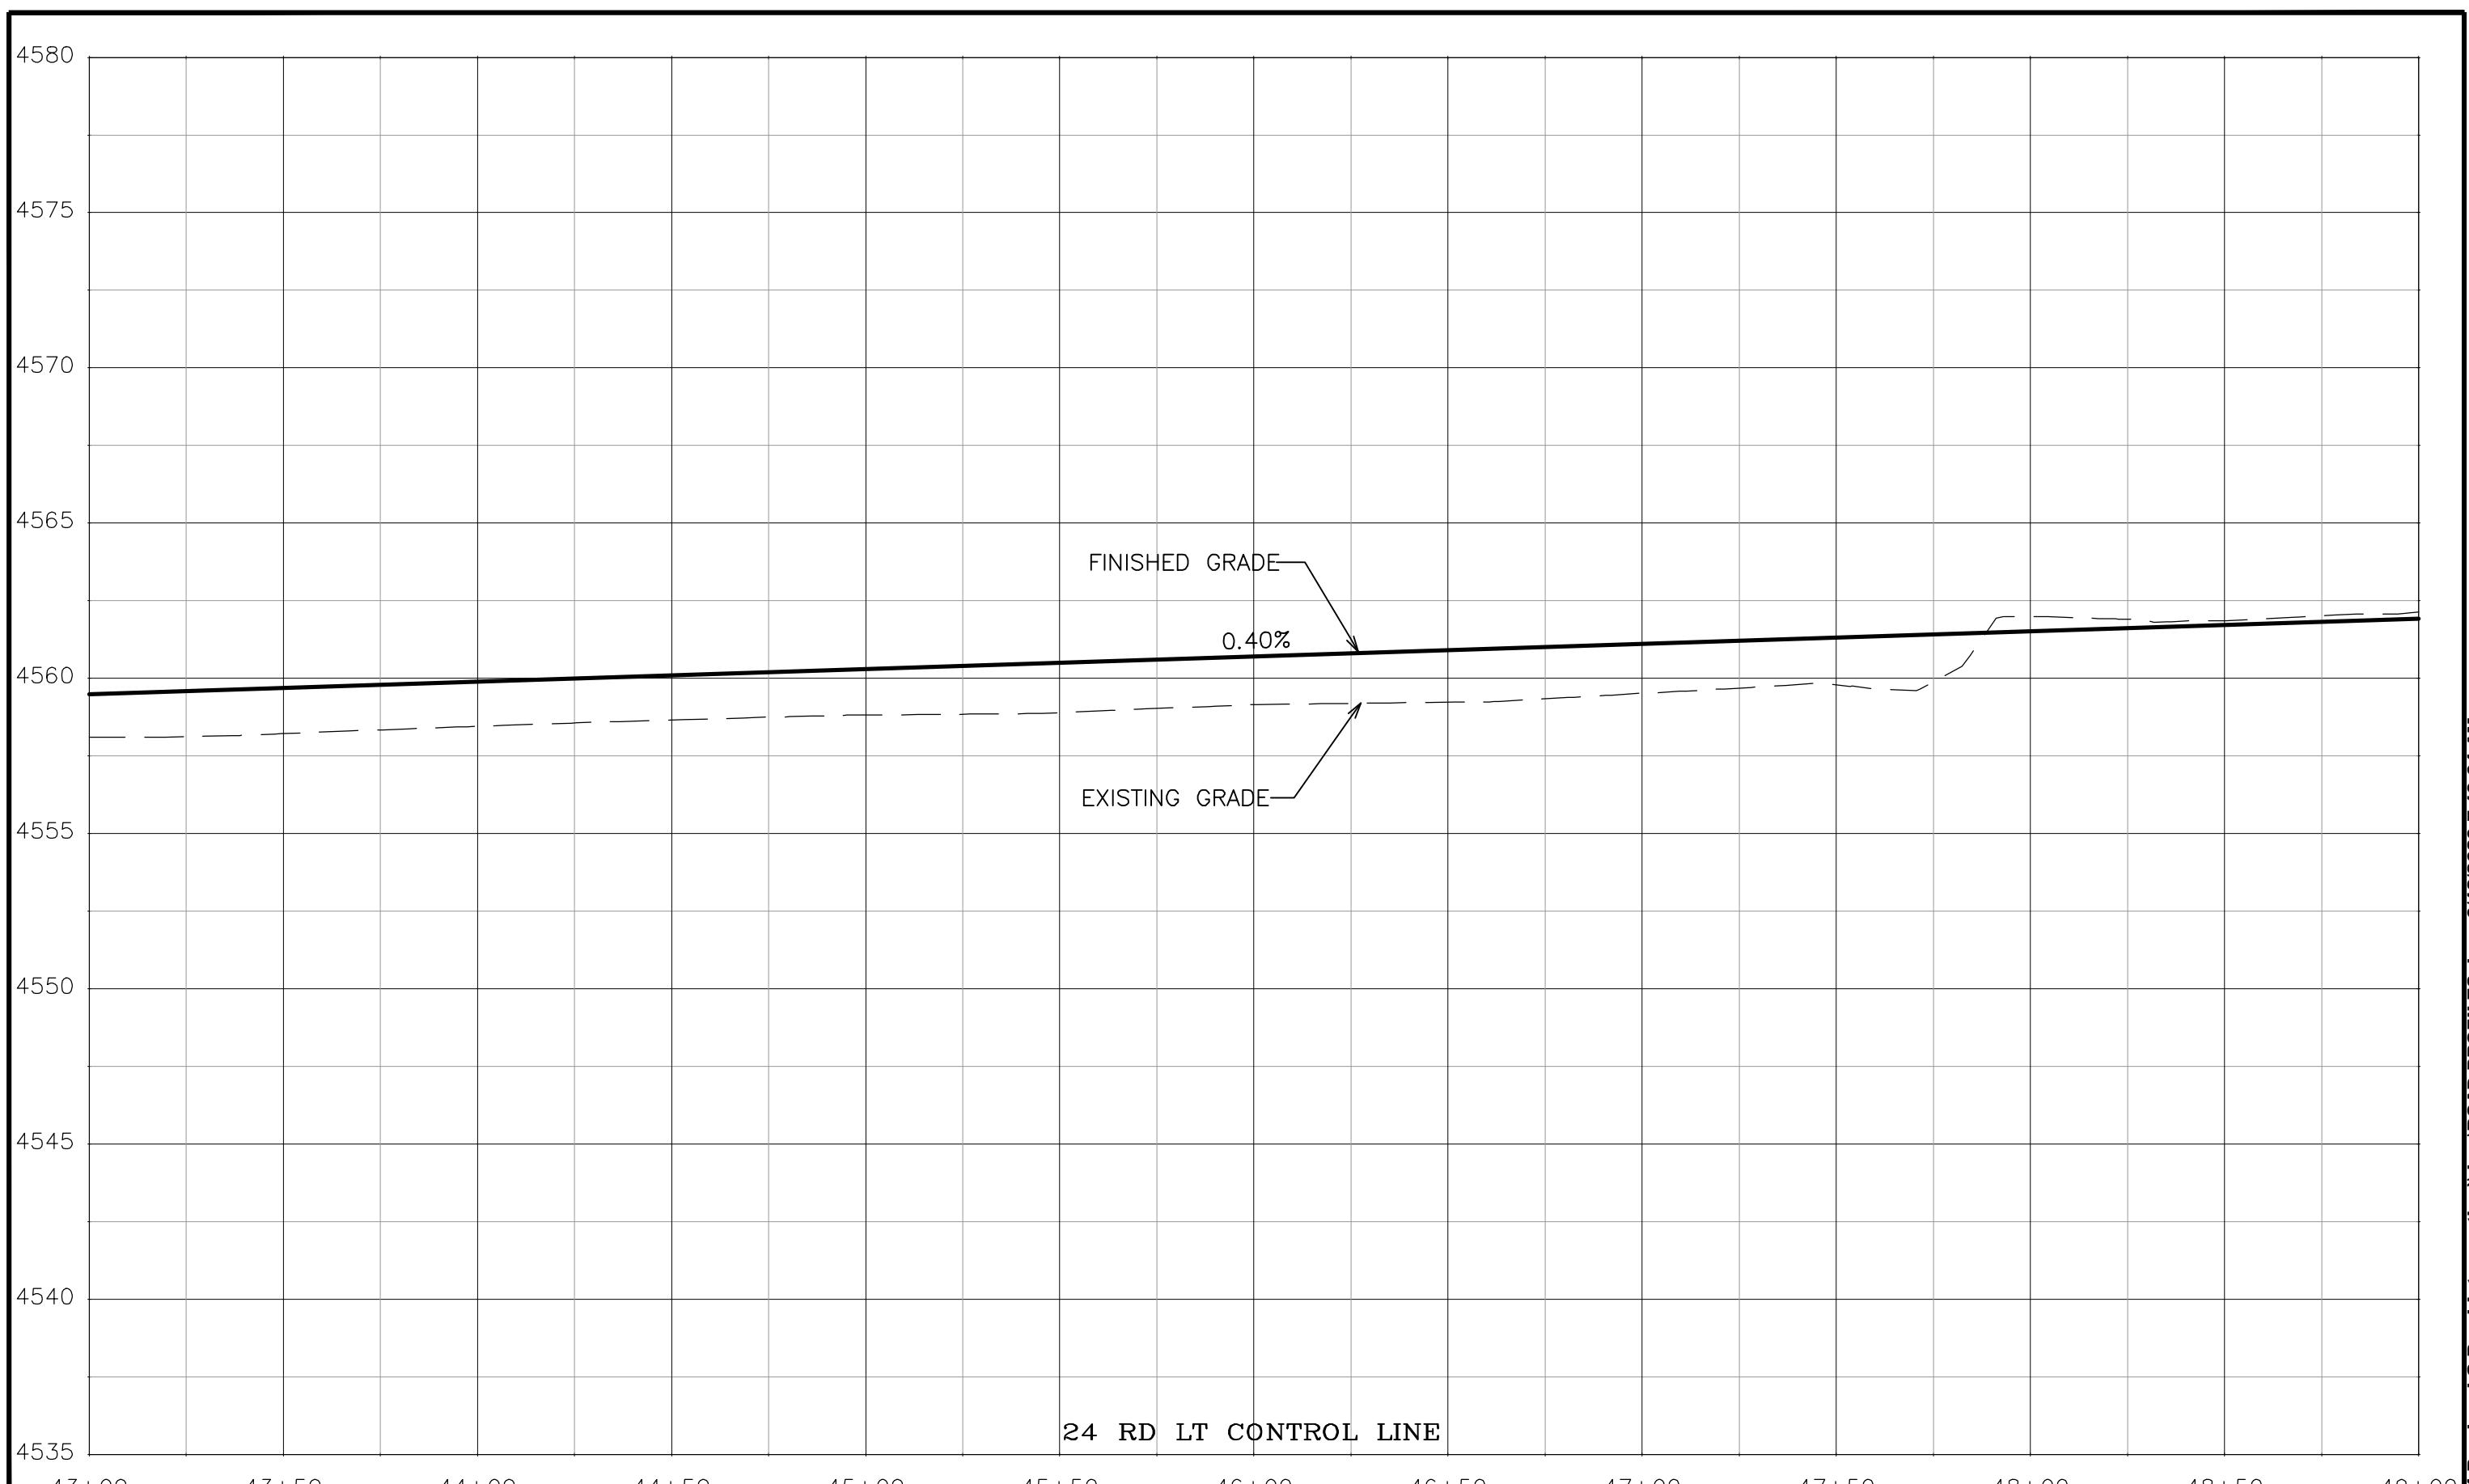

DESCRIPTION		DATE
REVISION ▲ REV 1	-	DATE
REVISION ▲ REV 2	-	DATE
REVISION ▲ REV 3	-	DATE
REVISION ▲ REV 4	-	DATE


DRAWN BY		JCS	DATE	2020
DESIGNED BY	JCS	DATE	2020	
CHECKED BY	ALC	DATE	2020	
APPROVED BY	TCP	DATE	2020	

SCALES:		PLAN & PROFILE
0	10	HORIZONTAL
2.5	40	
0	5	VERTICAL



PUBLIC WORKS
ENGINEERING DIVISION
PROJECT NO. 207-F1903

24 ROAD AND G ROAD
ROAD PROFILES — 9

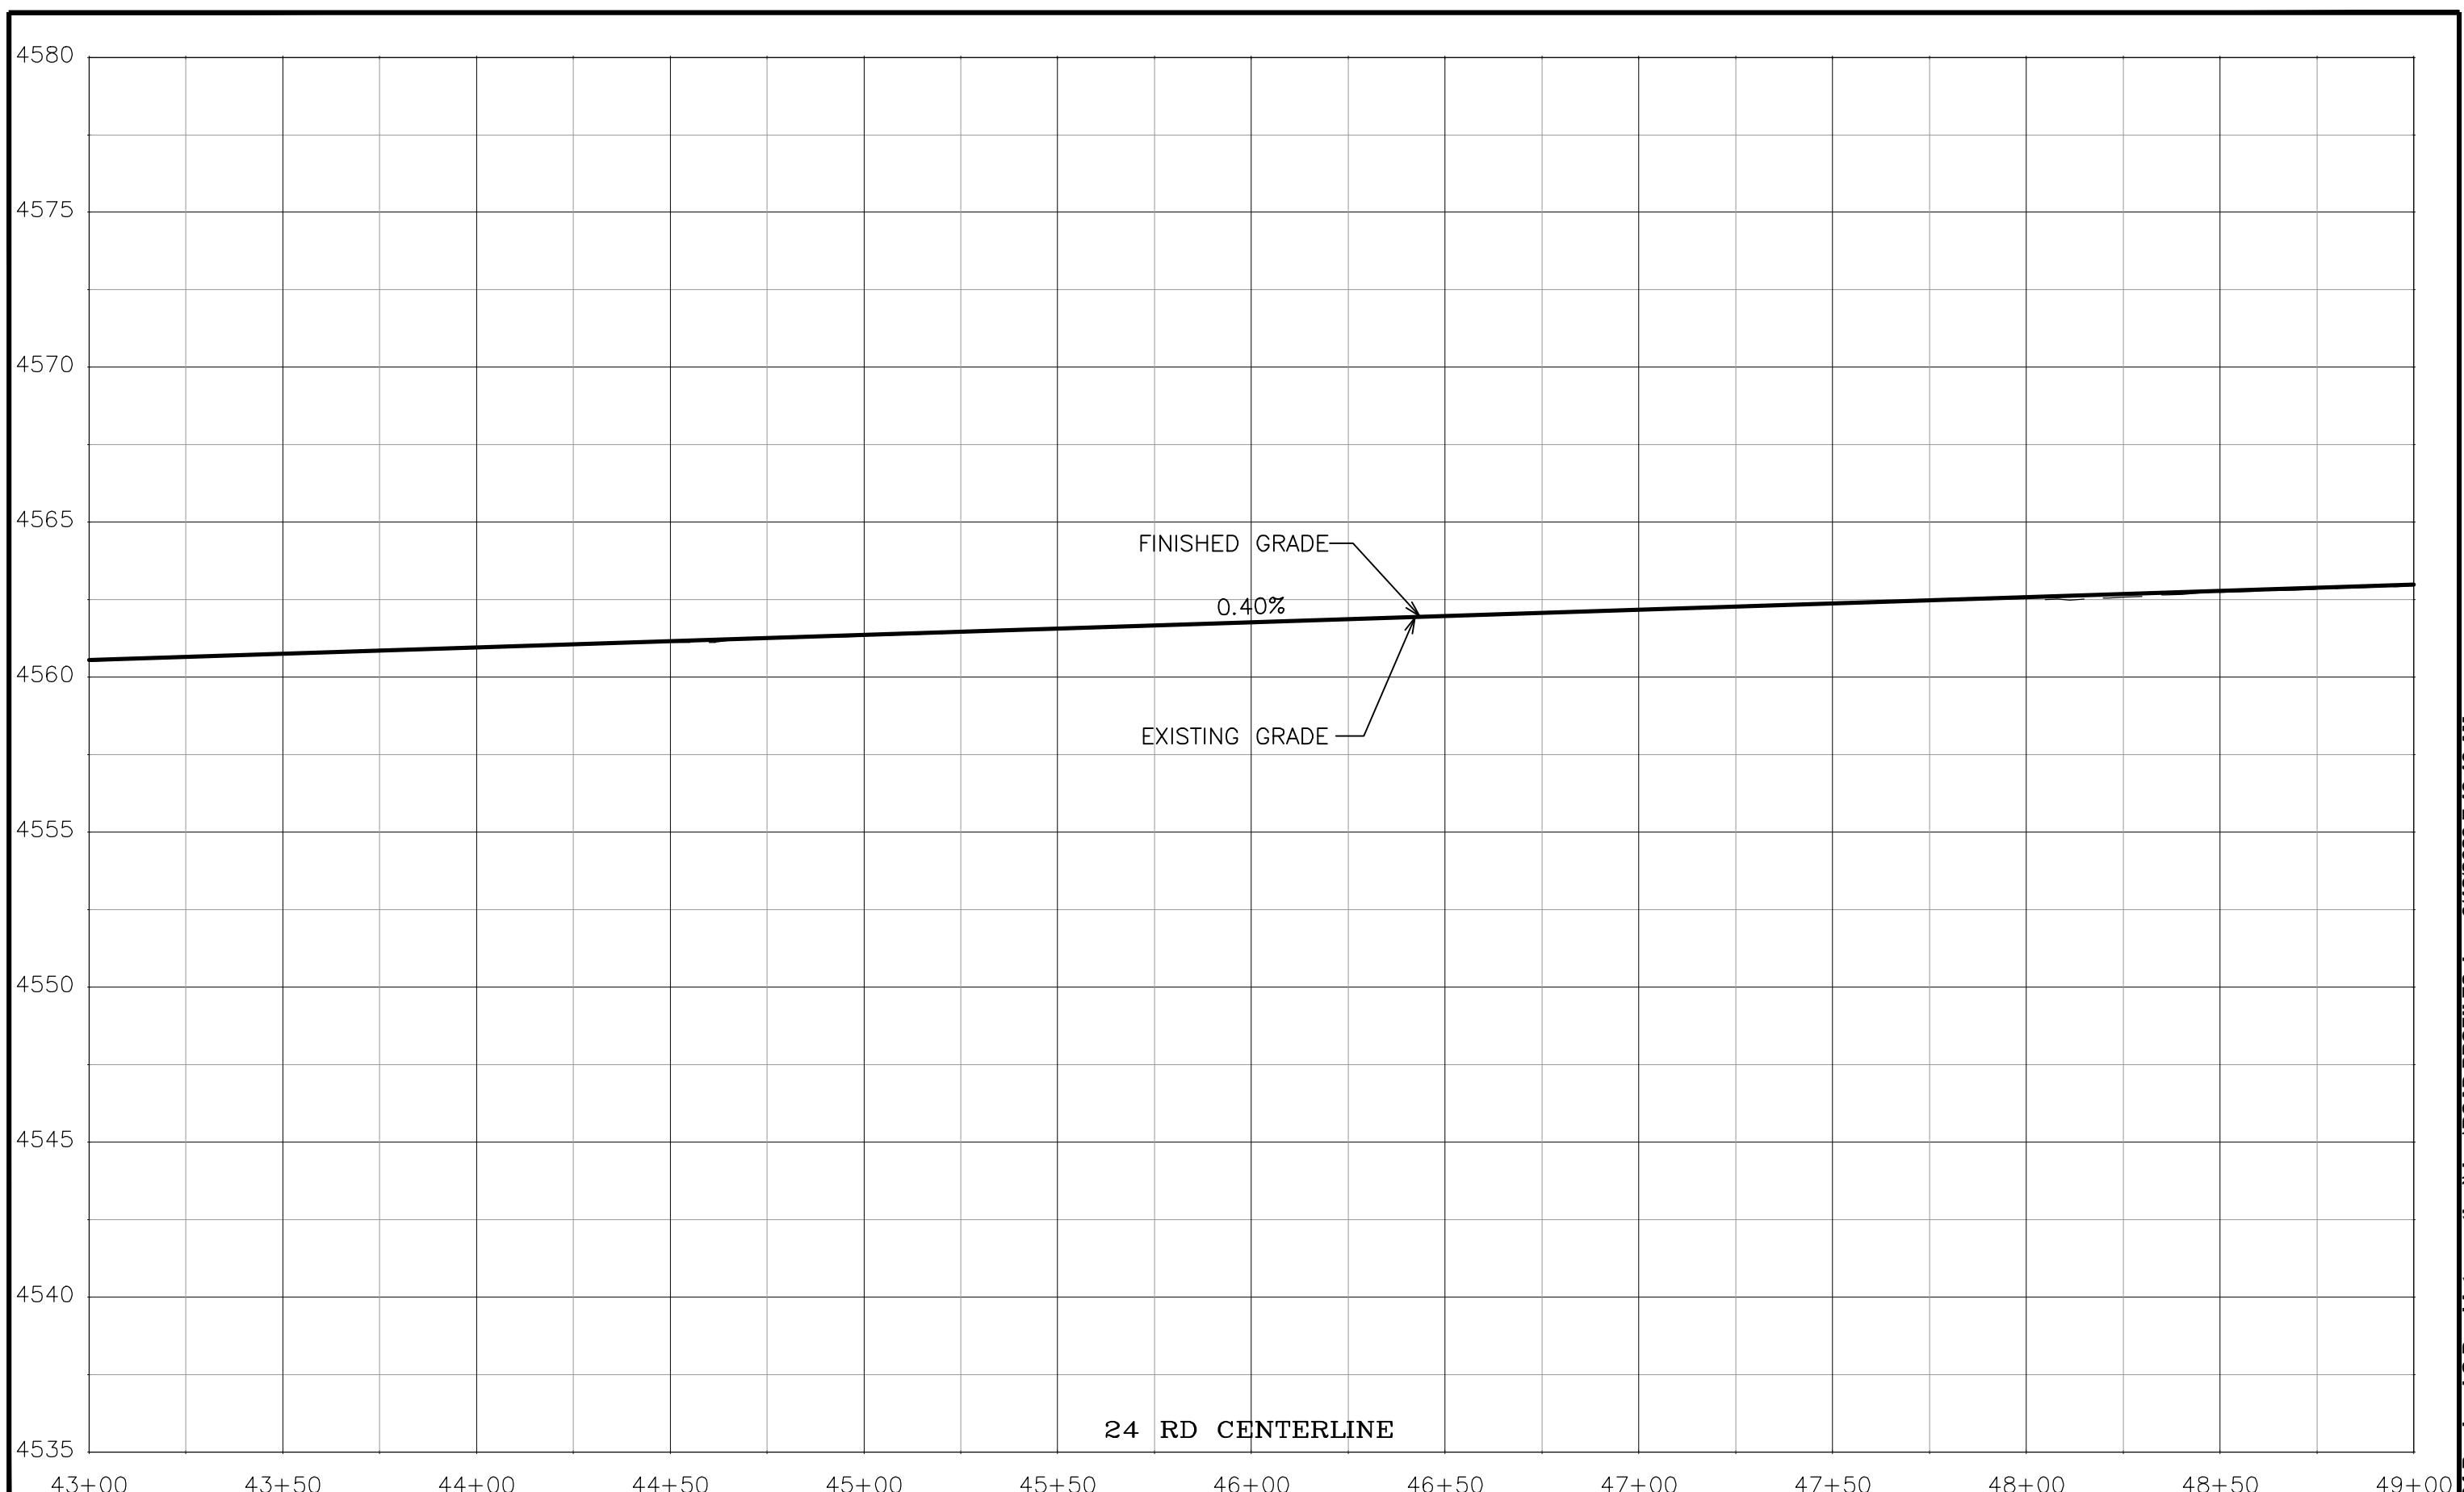

DESCRIPTION		DATE
REVISION ▲ REV 1	- DATE	DRAWN BY JCS DATE 2020
REVISION ▲ REV 2	- DATE	DESIGNED BY JCS DATE 2020
REVISION ▲ REV 3	- DATE	CHECKED BY ALC DATE 2020
REVISION ▲ REV 4	- DATE	APPROVED BY TCP DATE 2020


DRAWN BY JCS DATE 2020		DESIGNED BY JCS DATE 2020
REVISION ▲ REV 1	- DATE	CHECKED BY ALC DATE 2020
REVISION ▲ REV 2	- DATE	APPROVED BY TCP DATE 2020
REVISION ▲ REV 3	- DATE	
REVISION ▲ REV 4	- DATE	

SCALES:		
PLAN & PROFILE	HORIZONTAL	40
0	10	20
VERTICAL	2.5	5
0		



PUBLIC WORKS
ENGINEERING DIVISION
PROJECT NO. 207-F1903

24 ROAD AND G ROAD
ROAD PROFILES - 10

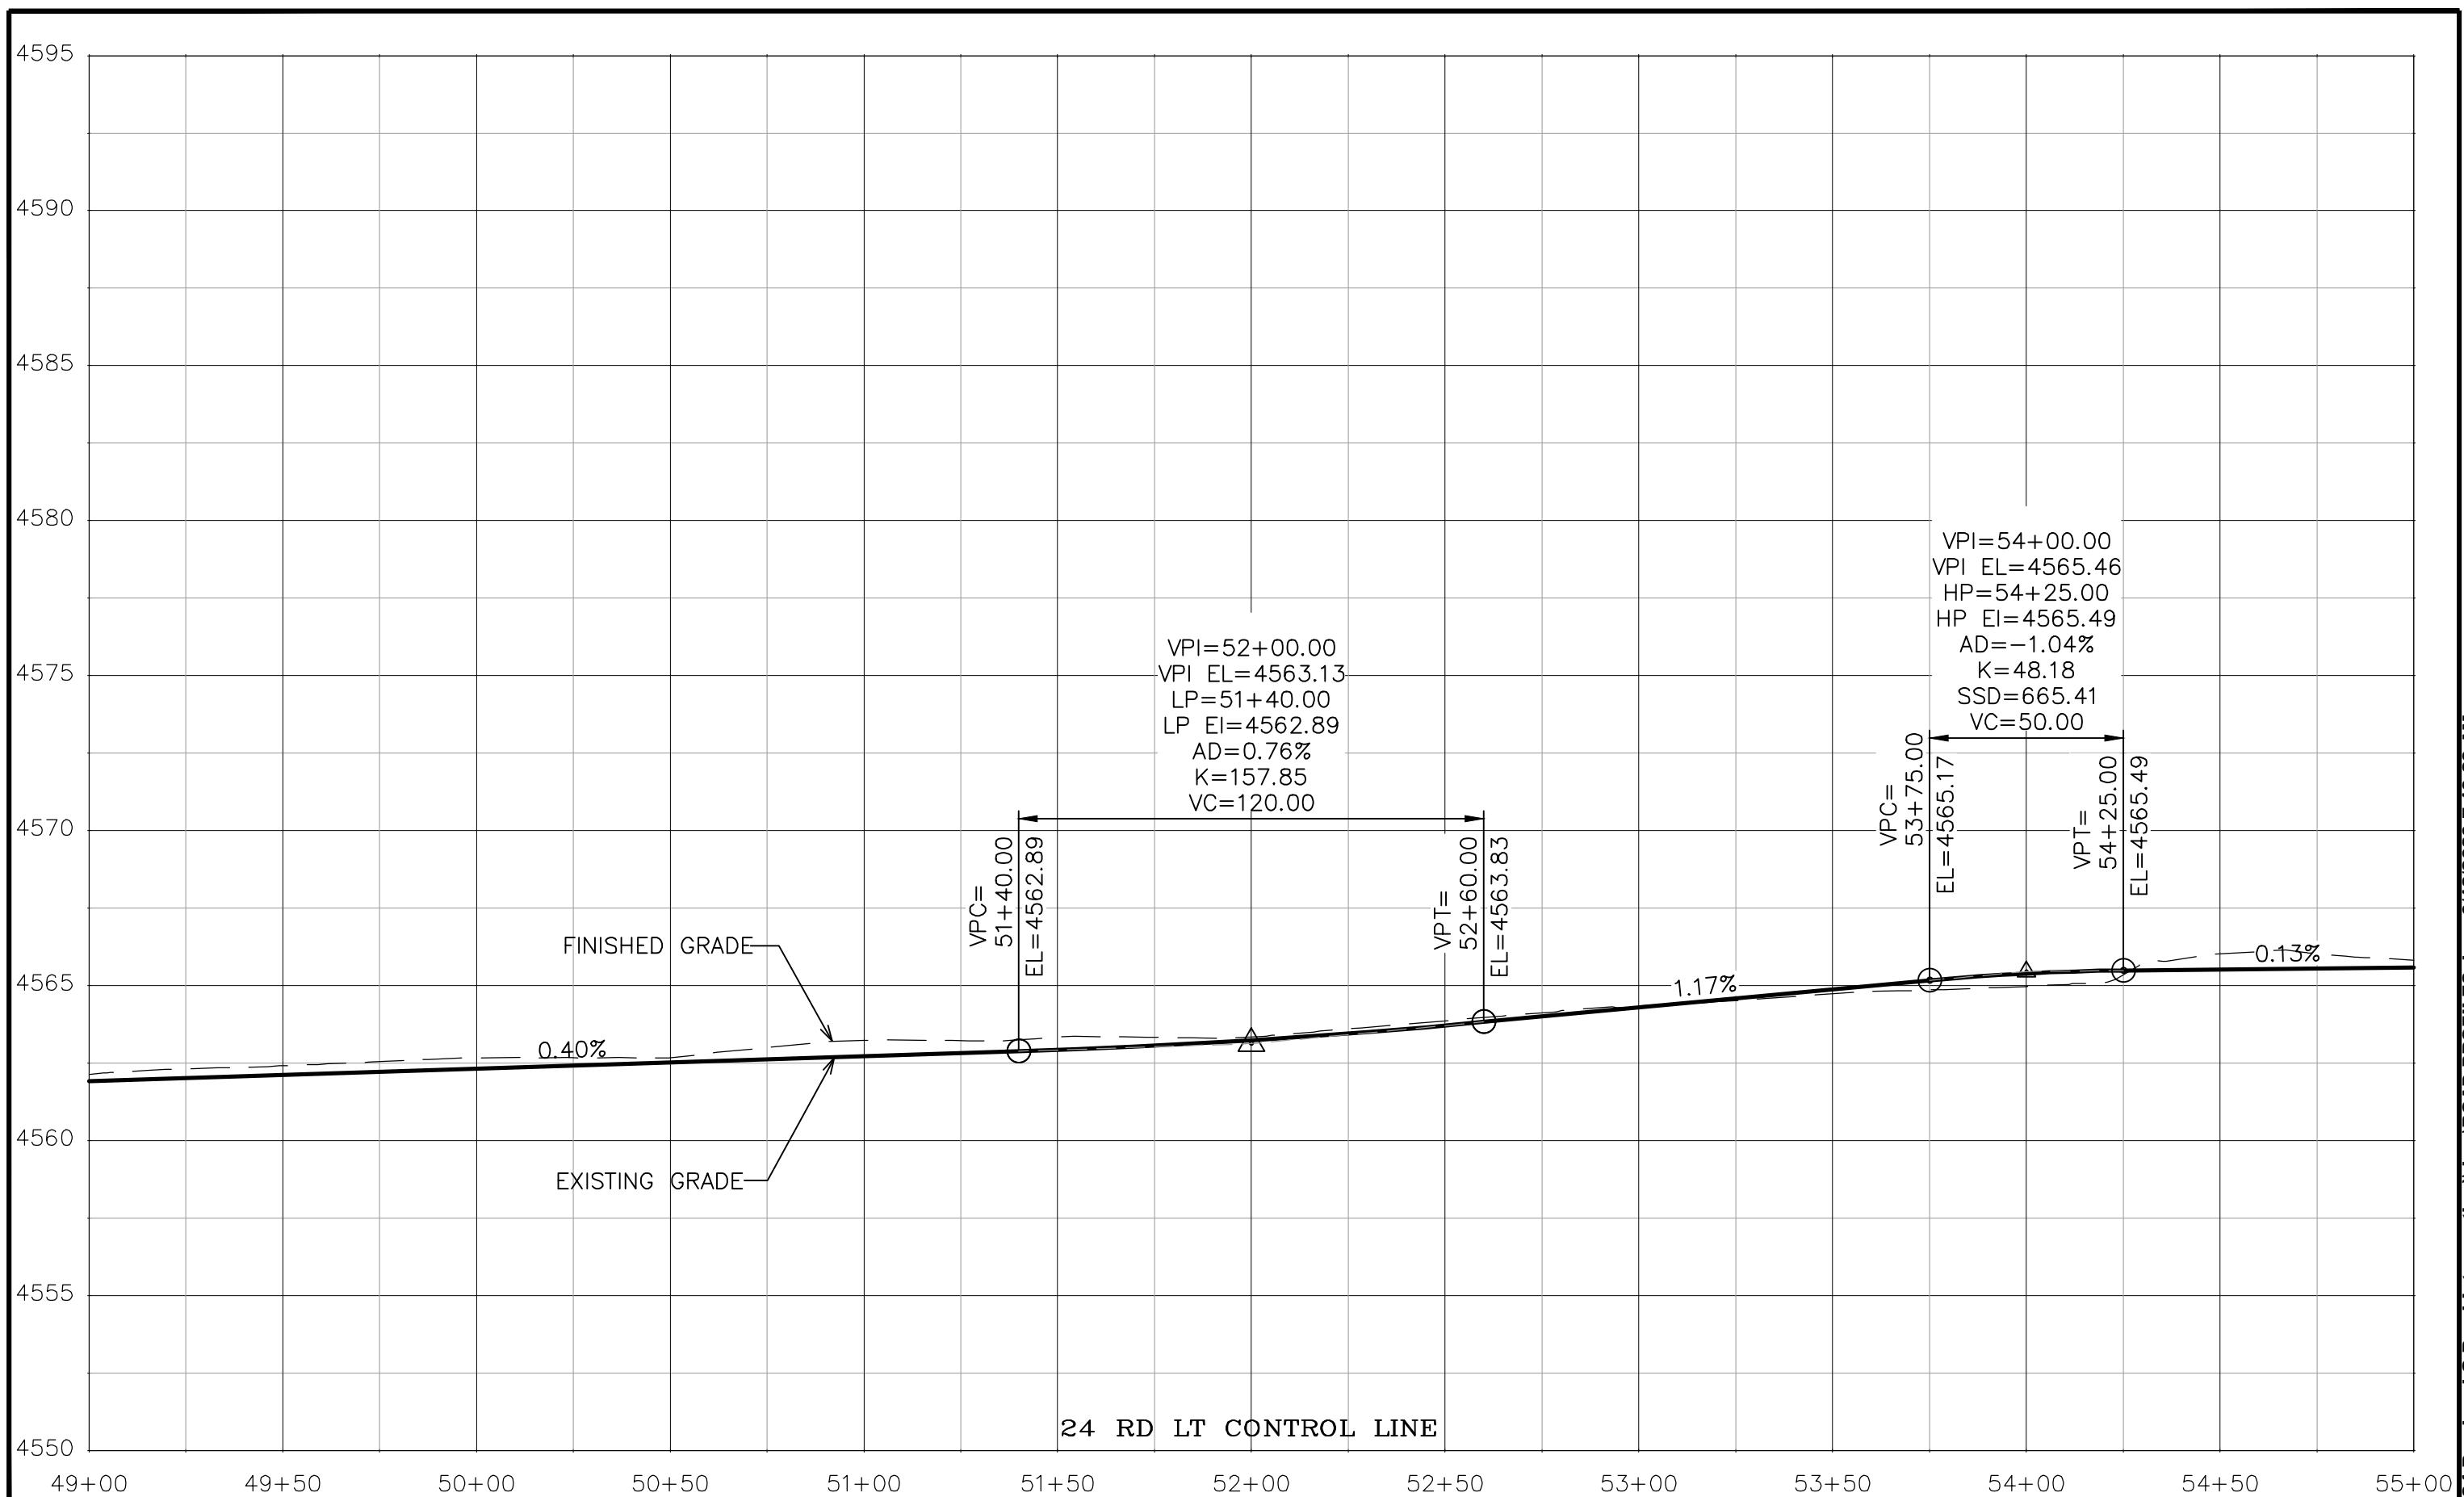

DESCRIPTION	DATE
REVISION ▲ REV 1	- DATE
REVISION ▲ REV 2	- DATE
REVISION ▲ REV 3	- DATE
REVISION ▲ REV 4	- DATE


DRAWN BY JCS	DATE 2020
DESIGNED BY JCS	DATE 2020
CHECKED BY ALC	DATE 2020
APPROVED BY TCP	DATE 2020

SCALES:	
PLAN & PROFILE	
0	10
20	40
0	2.5
5	
HORIZONTAL	
VERTICAL	



PUBLIC WORKS
ENGINEERING DIVISION
PROJECT NO. 207-F1903

24 ROAD AND G ROAD
ROAD PROFILES - 11

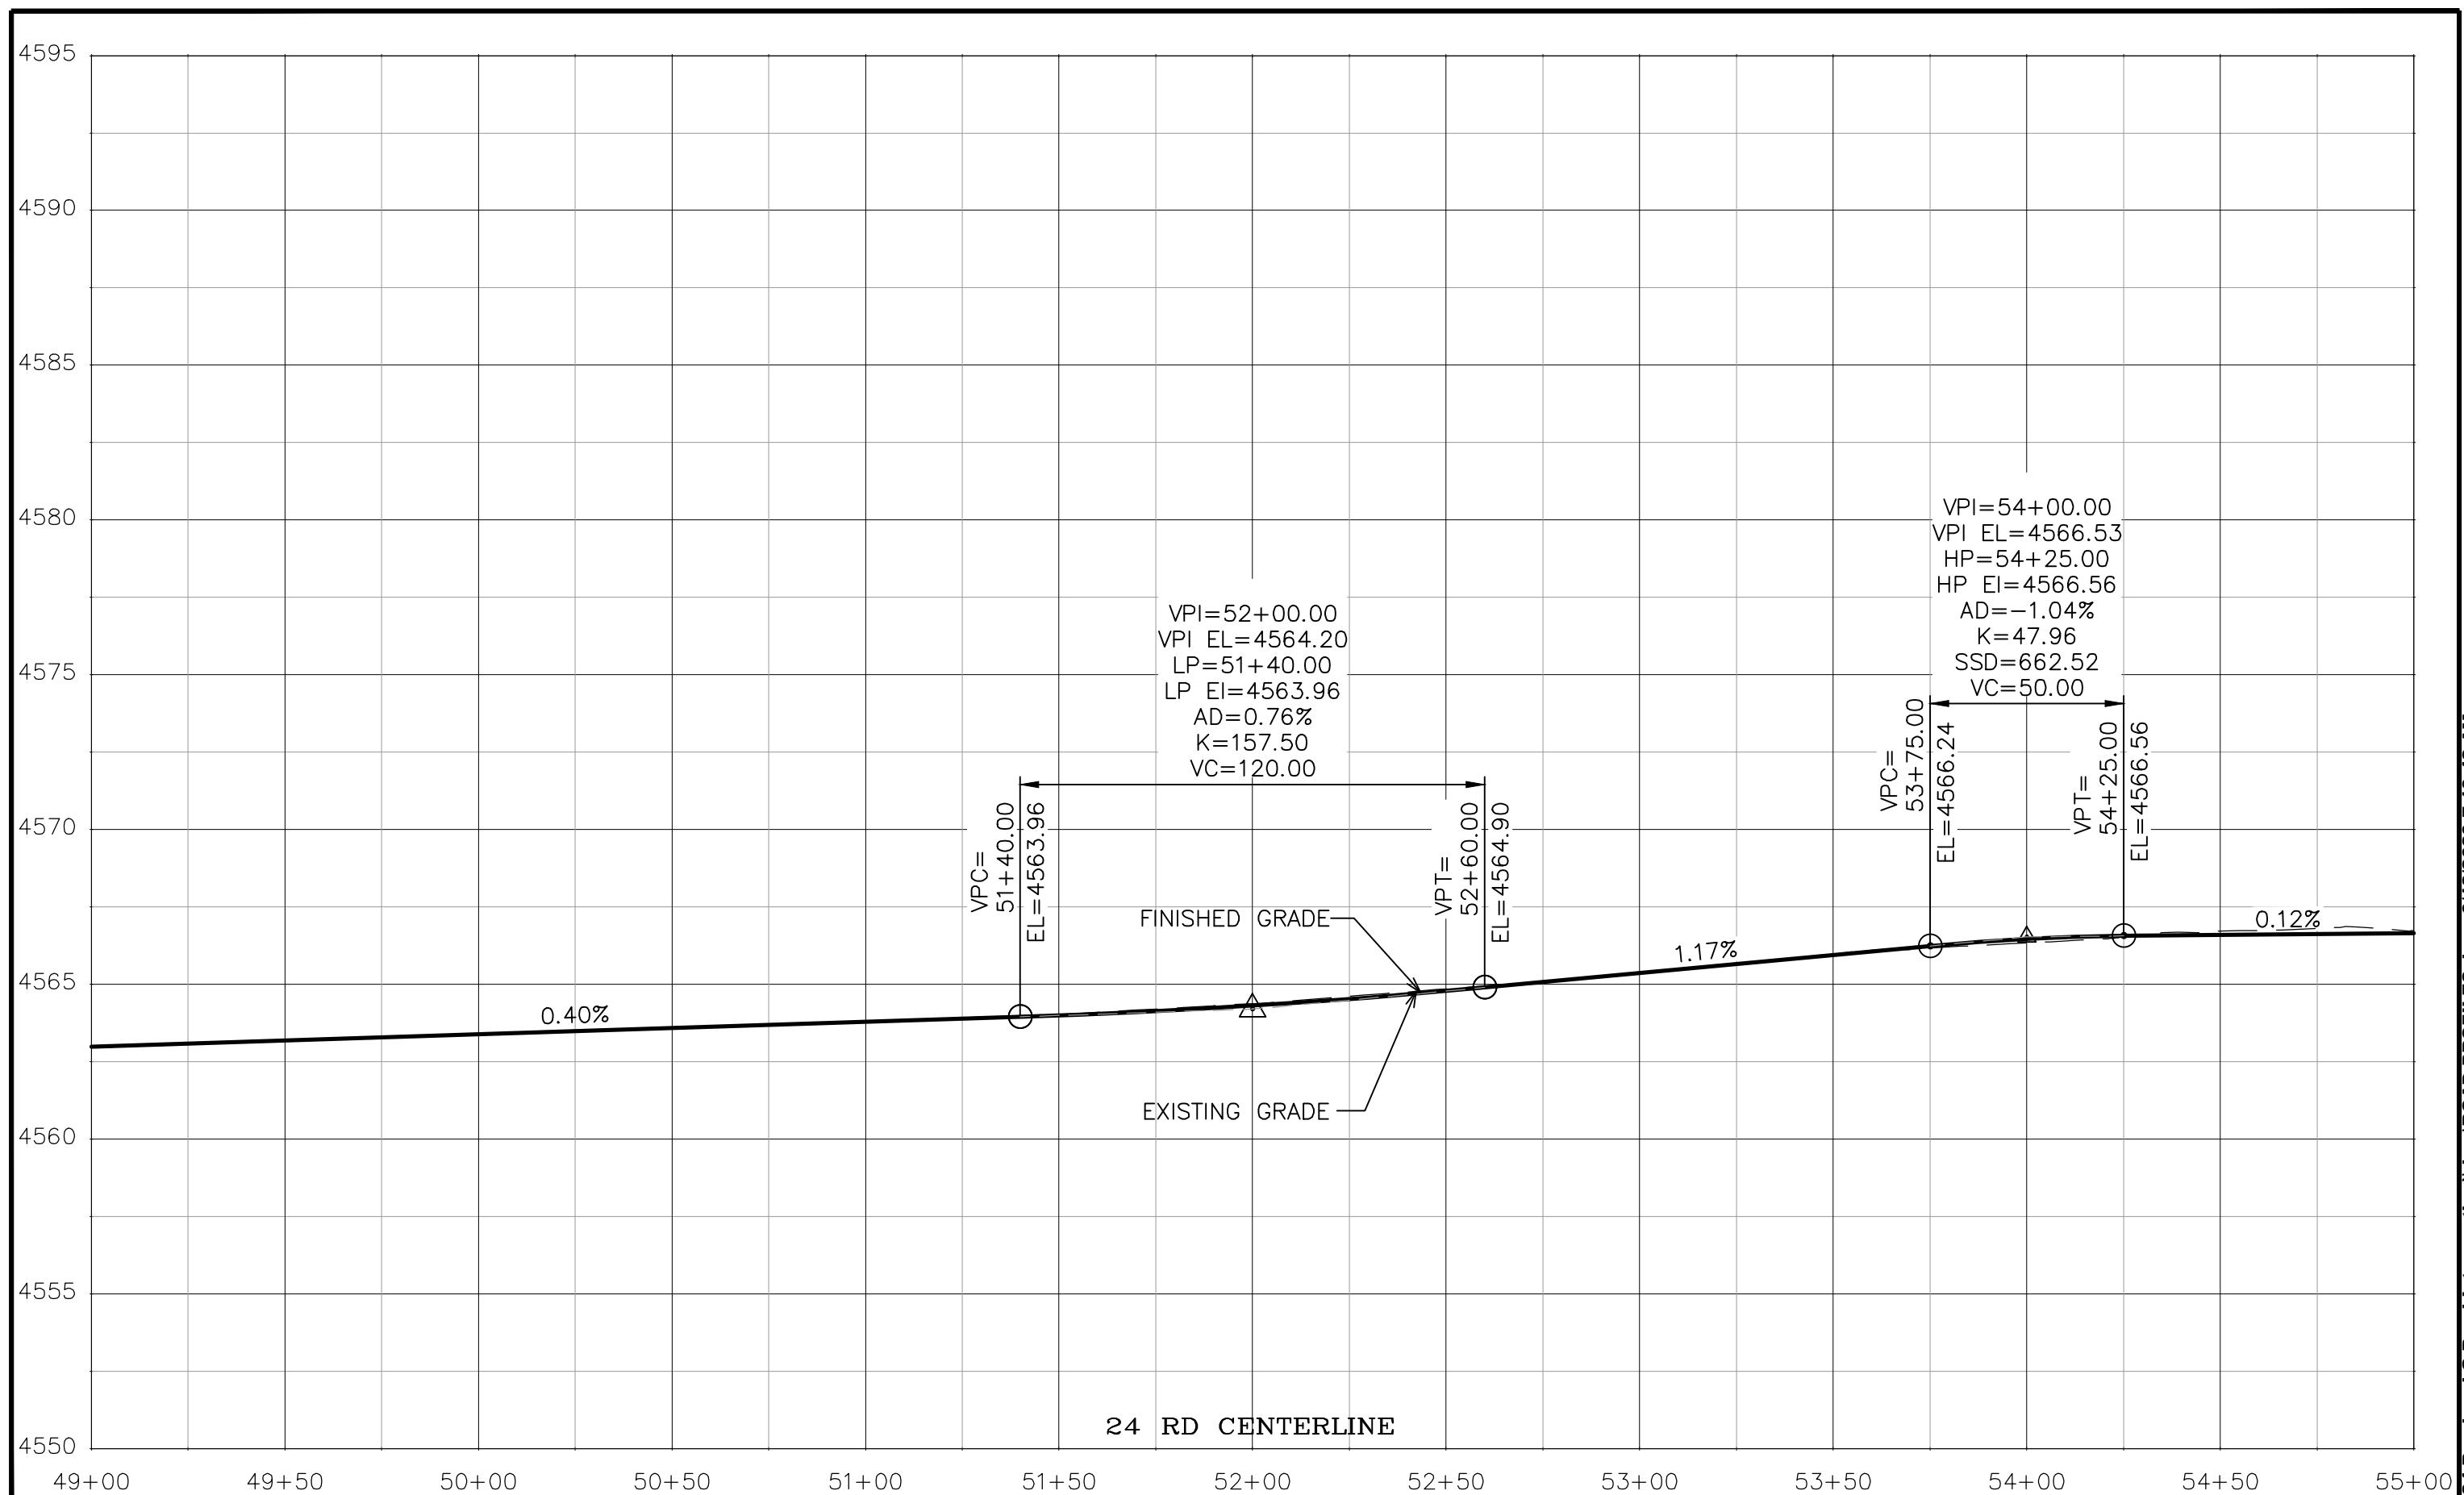

DESCRIPTION DATE
 REVISION A REV 1 - DATE
 REVISION A REV 2 - DATE
 REVISION A REV 3 - DATE
 REVISION A REV 4 - DATE


DRAWN BY JCS DATE 2020
 DESIGNED BY JCS DATE 2020
 CHECKED BY ALC DATE 2020
 APPROVED BY TCP DATE 2020

SCALES:
 PLAN & PROFILE
 HORIZONTAL: 0 10 20 40
 VERTICAL: 0 2.5 5



PUBLIC WORKS
ENGINEERING DIVISION
PROJECT NO. 207-F1903

24 ROAD AND G ROAD
ROAD PROFILES - 12

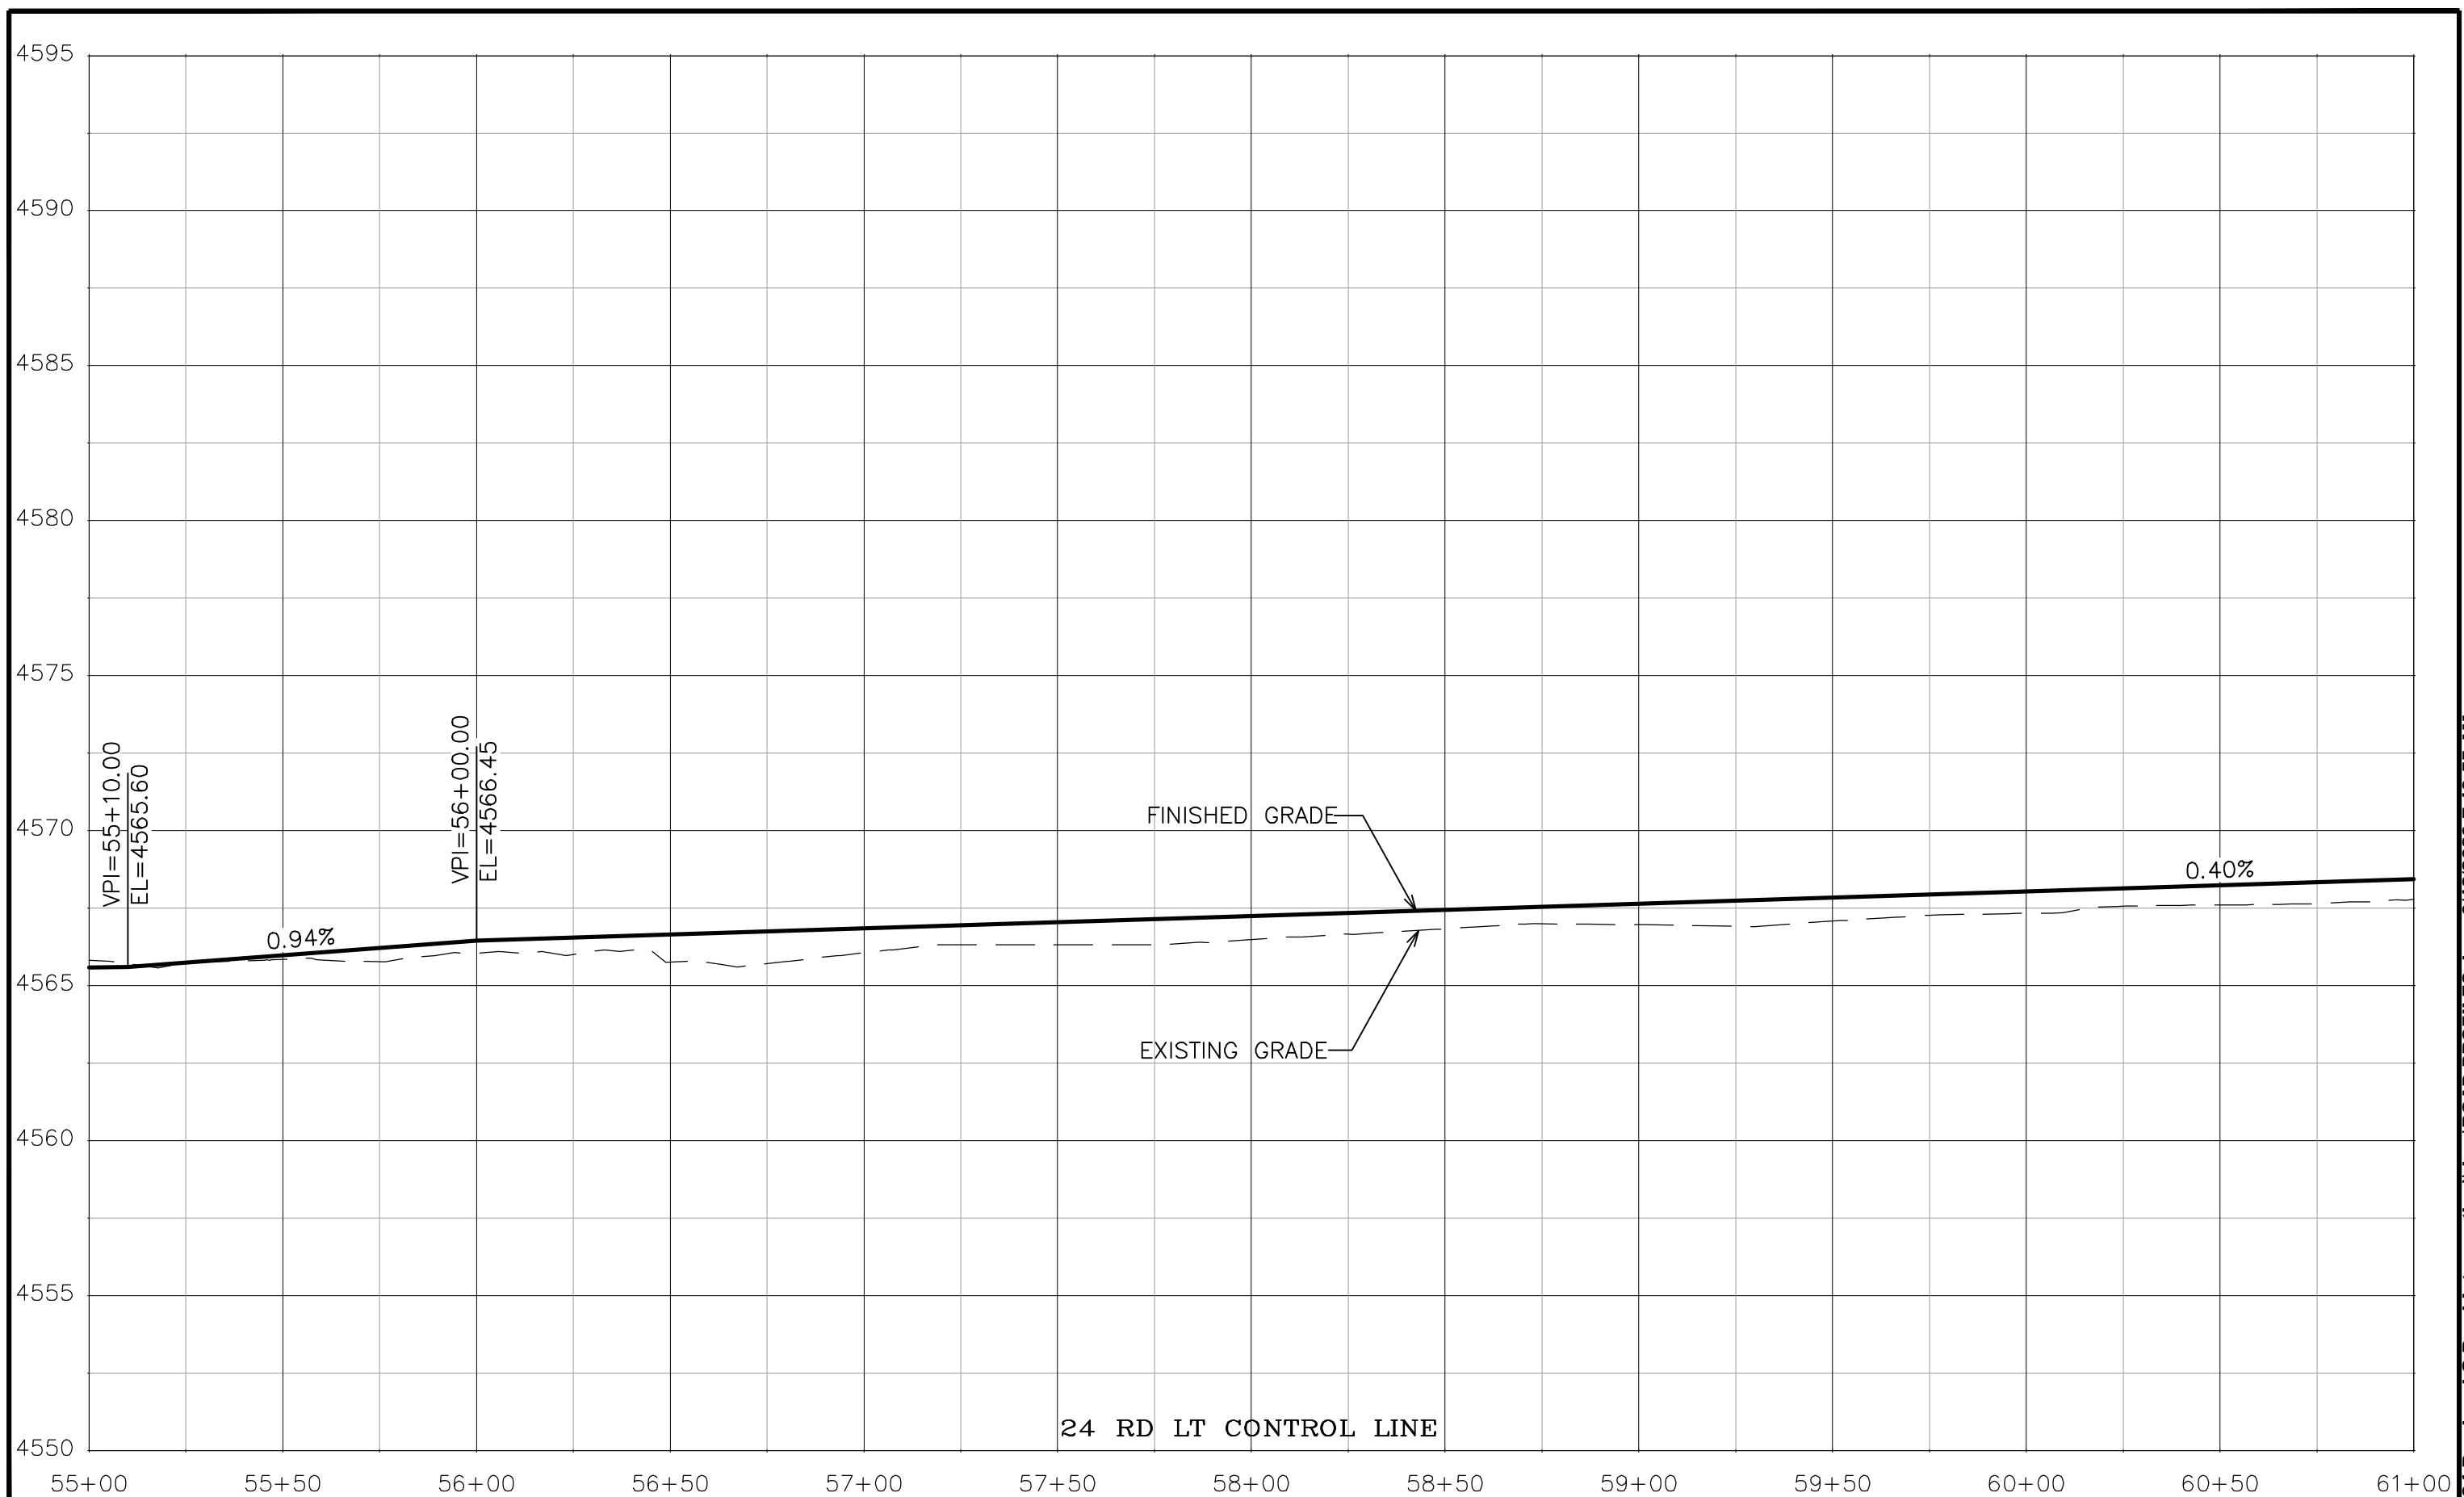

DESCRIPTION		DATE
REVISION ▲ REV 1	-	DATE
REVISION ▲ REV 2	-	DATE
REVISION ▲ REV 3	-	DATE
REVISION ▲ REV 4	-	DATE

DRAWN BY	JCS	DATE	2020
DESIGNED BY	JCS	DATE	2020
CHECKED BY	ALC	DATE	2020
APPROVED BY	TCP	DATE	2020

SCALES:


PLAN & PROFILE			
0	10	20	40
0	2.5	5	

HORIZONTAL
VERTICAL



PUBLIC WORKS
ENGINEERING DIVISION
PROJECT NO. 207-F1903

24 ROAD AND G ROAD
ROAD PROFILES - 13

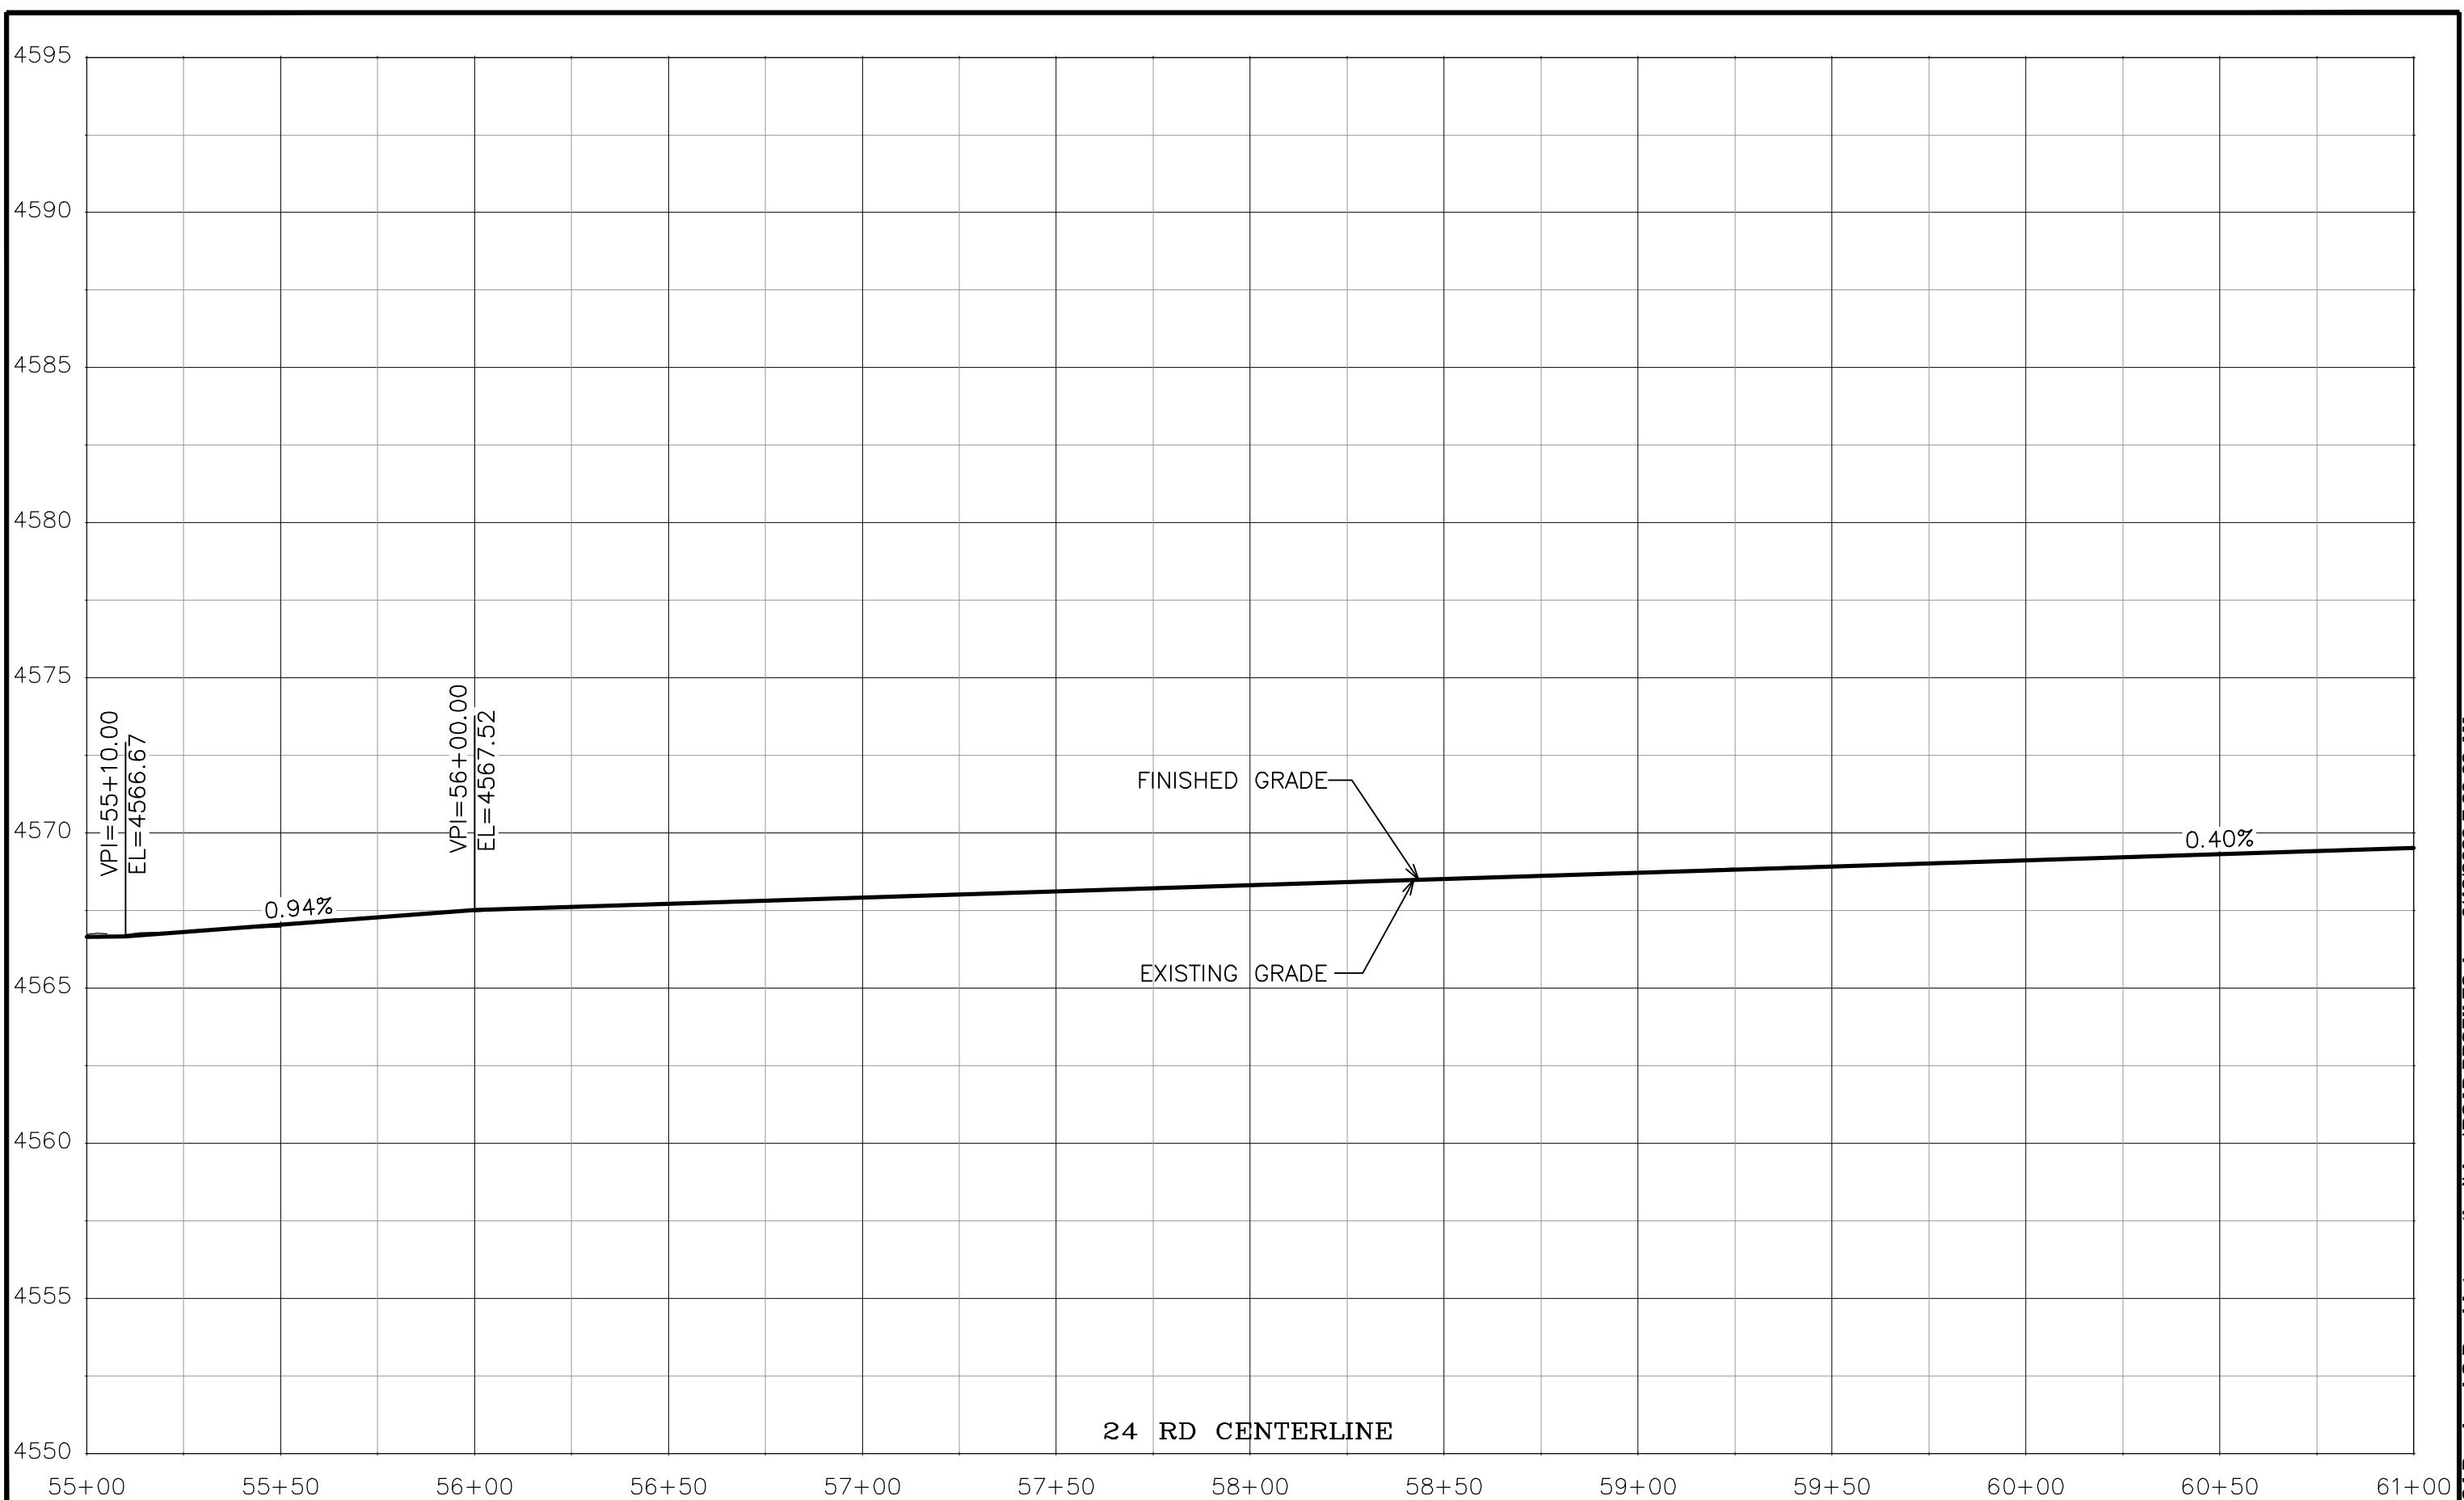

DESCRIPTION		DATE
REVISION ▲ REV 1	-	DATE
REVISION ▲ REV 2	-	DATE
REVISION ▲ REV 3	-	DATE
REVISION ▲ REV 4	-	DATE


DRAWN BY	JCS	DATE	2020
DESIGNED BY	JCS	DATE	2020
CHECKED BY	ALC	DATE	2020
APPROVED BY	TCP	DATE	2020

SCALES:			
PLAN & PROFILE			
0	10	20	40
HORIZONTAL			
0	2.5	5	
VERTICAL			



PUBLIC WORKS
ENGINEERING DIVISION
PROJECT NO. 207-F1903

24 ROAD AND G ROAD
ROAD PROFILES - 14

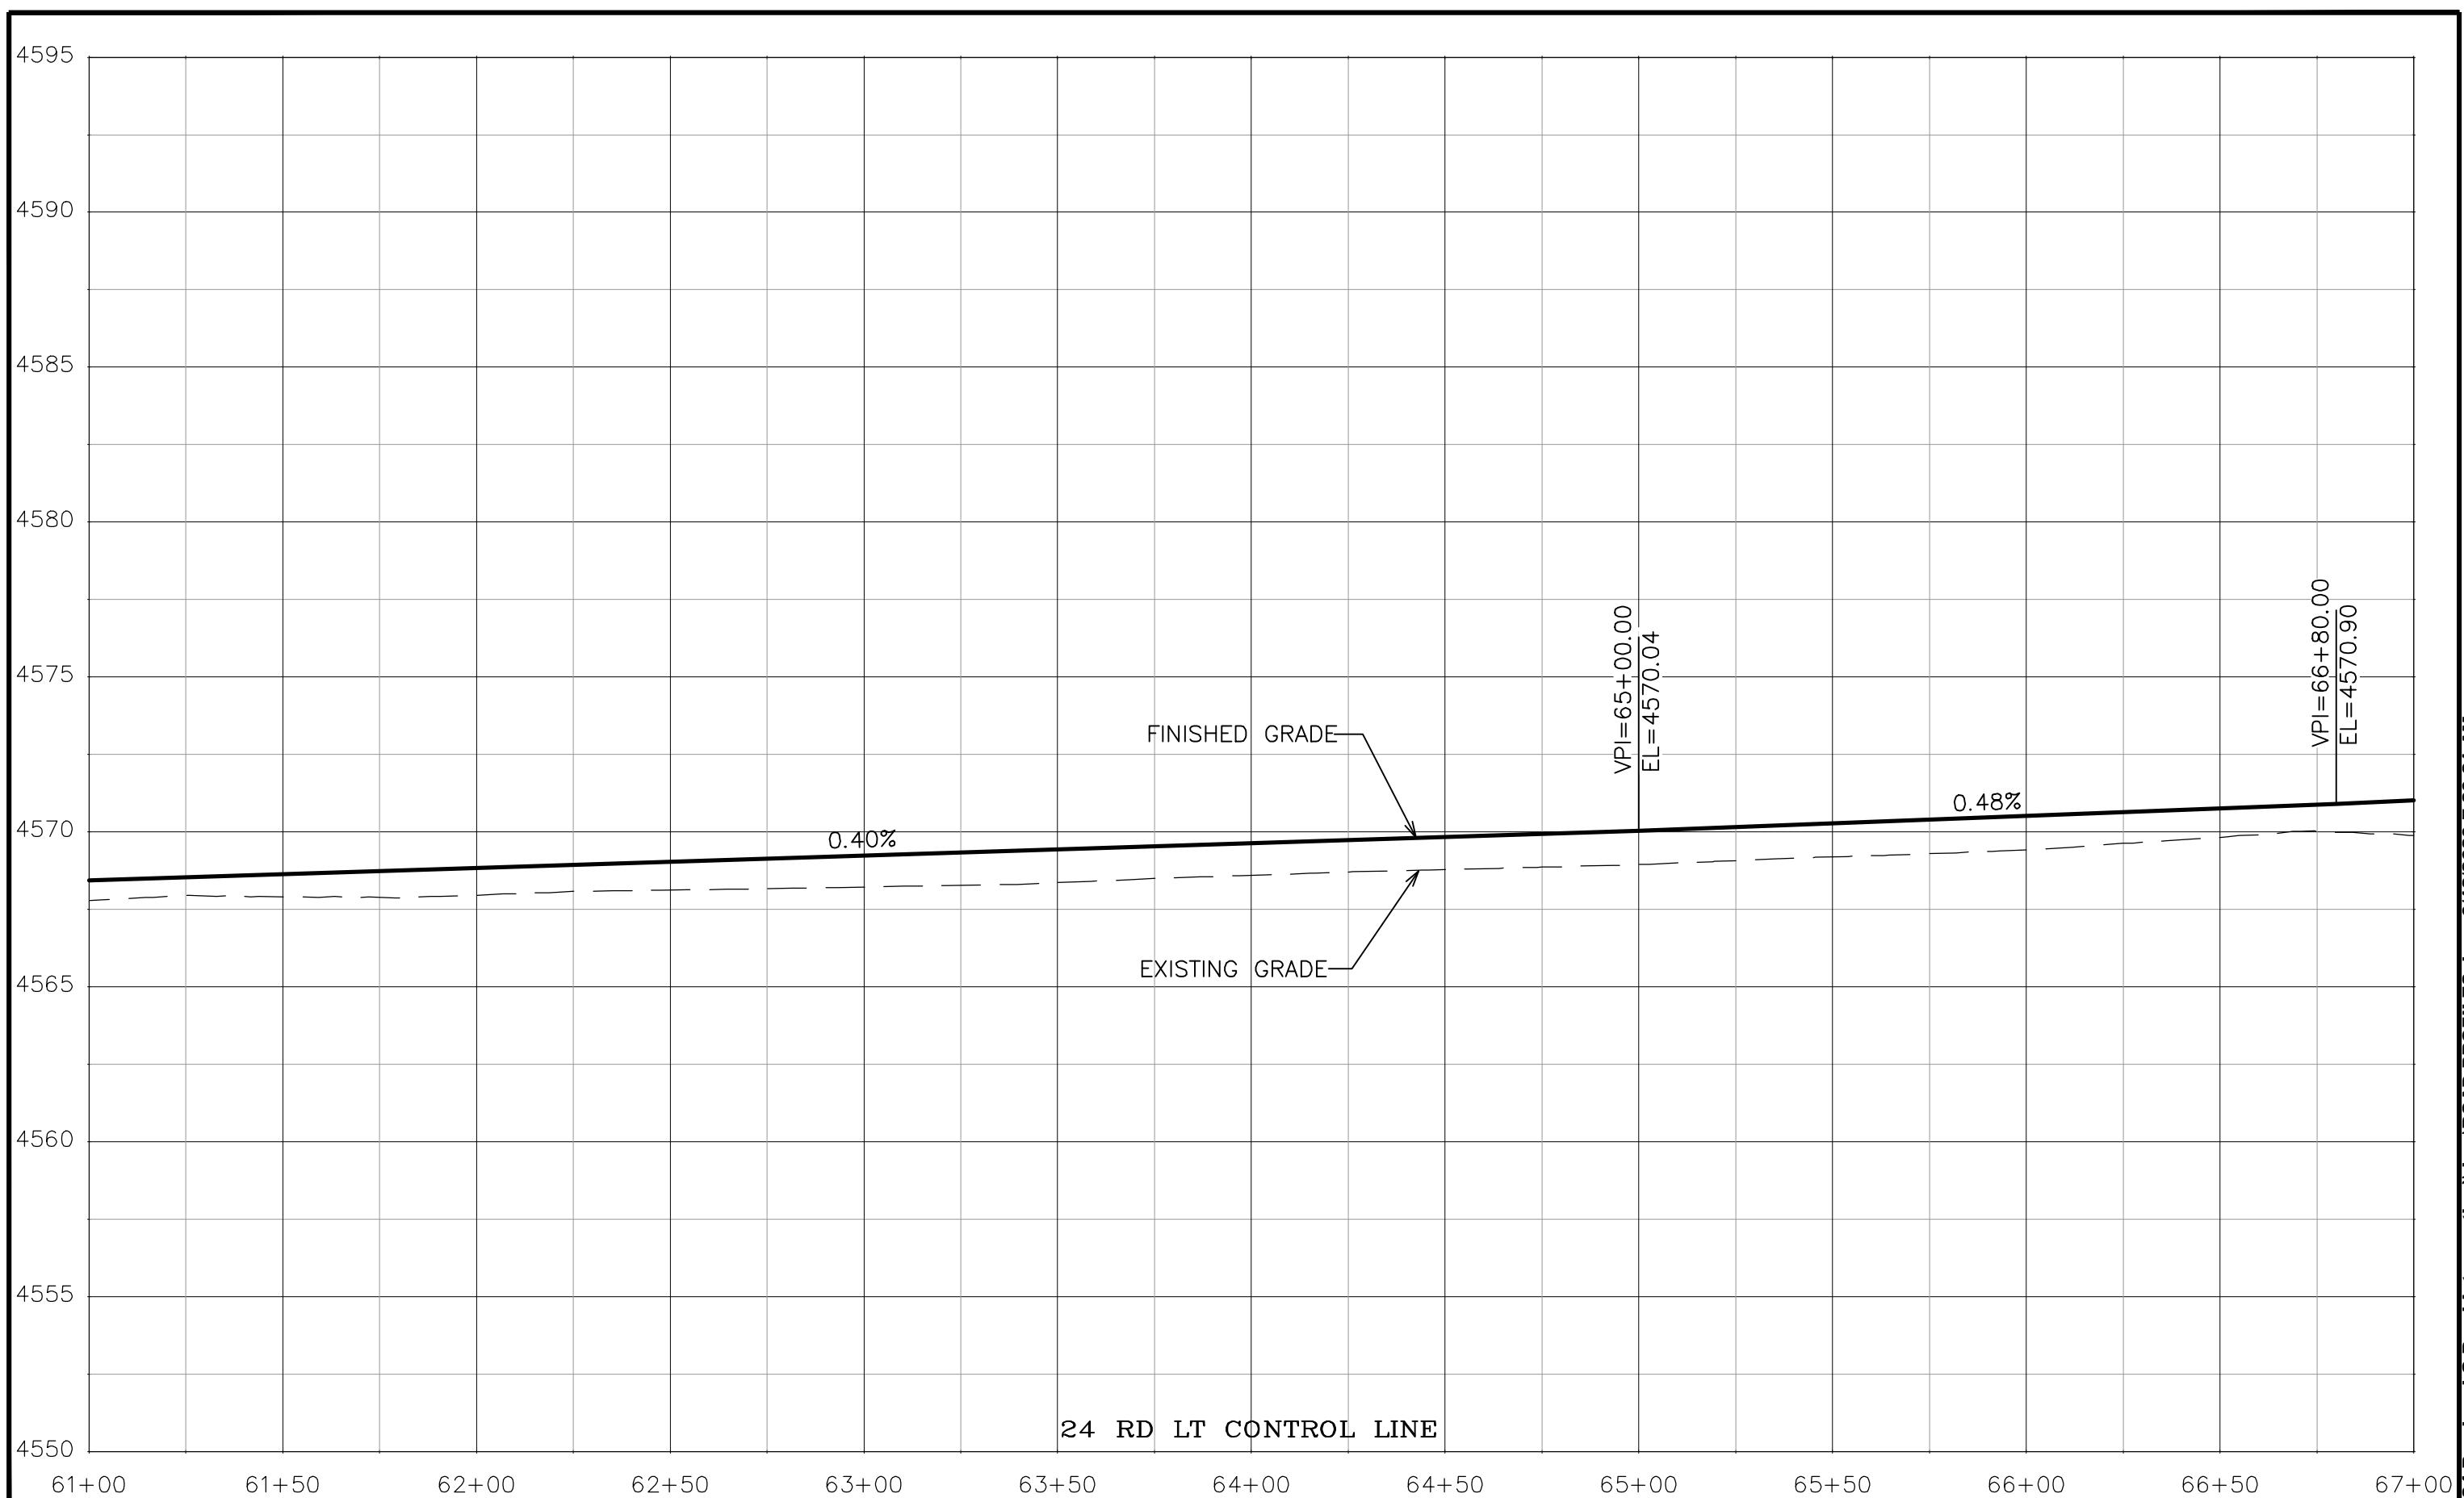

DESCRIPTION		DATE
REVISION ▲ REV 1	- DATE	DRAWN BY JCS DATE 2020
REVISION ▲ REV 2	- DATE	DESIGNED BY JCS DATE 2020
REVISION ▲ REV 3	- DATE	CHECKED BY ALC DATE 2020
REVISION ▲ REV 4	- DATE	APPROVED BY TCP DATE 2020


DRAWN BY JCS DATE 2020		SCALES:
DESIGNED BY JCS DATE 2020	CHECKED BY ALC DATE 2020	PLAN & PROFILE
APPROVED BY TCP DATE 2020		0 10 20 40

SCALES:	PLAN & PROFILE
	0 10 20 40
	VERTICAL 2.5 5



PUBLIC WORKS
ENGINEERING DIVISION
PROJECT NO. 207-F1903

24 ROAD AND G ROAD
ROAD PROFILES - 15

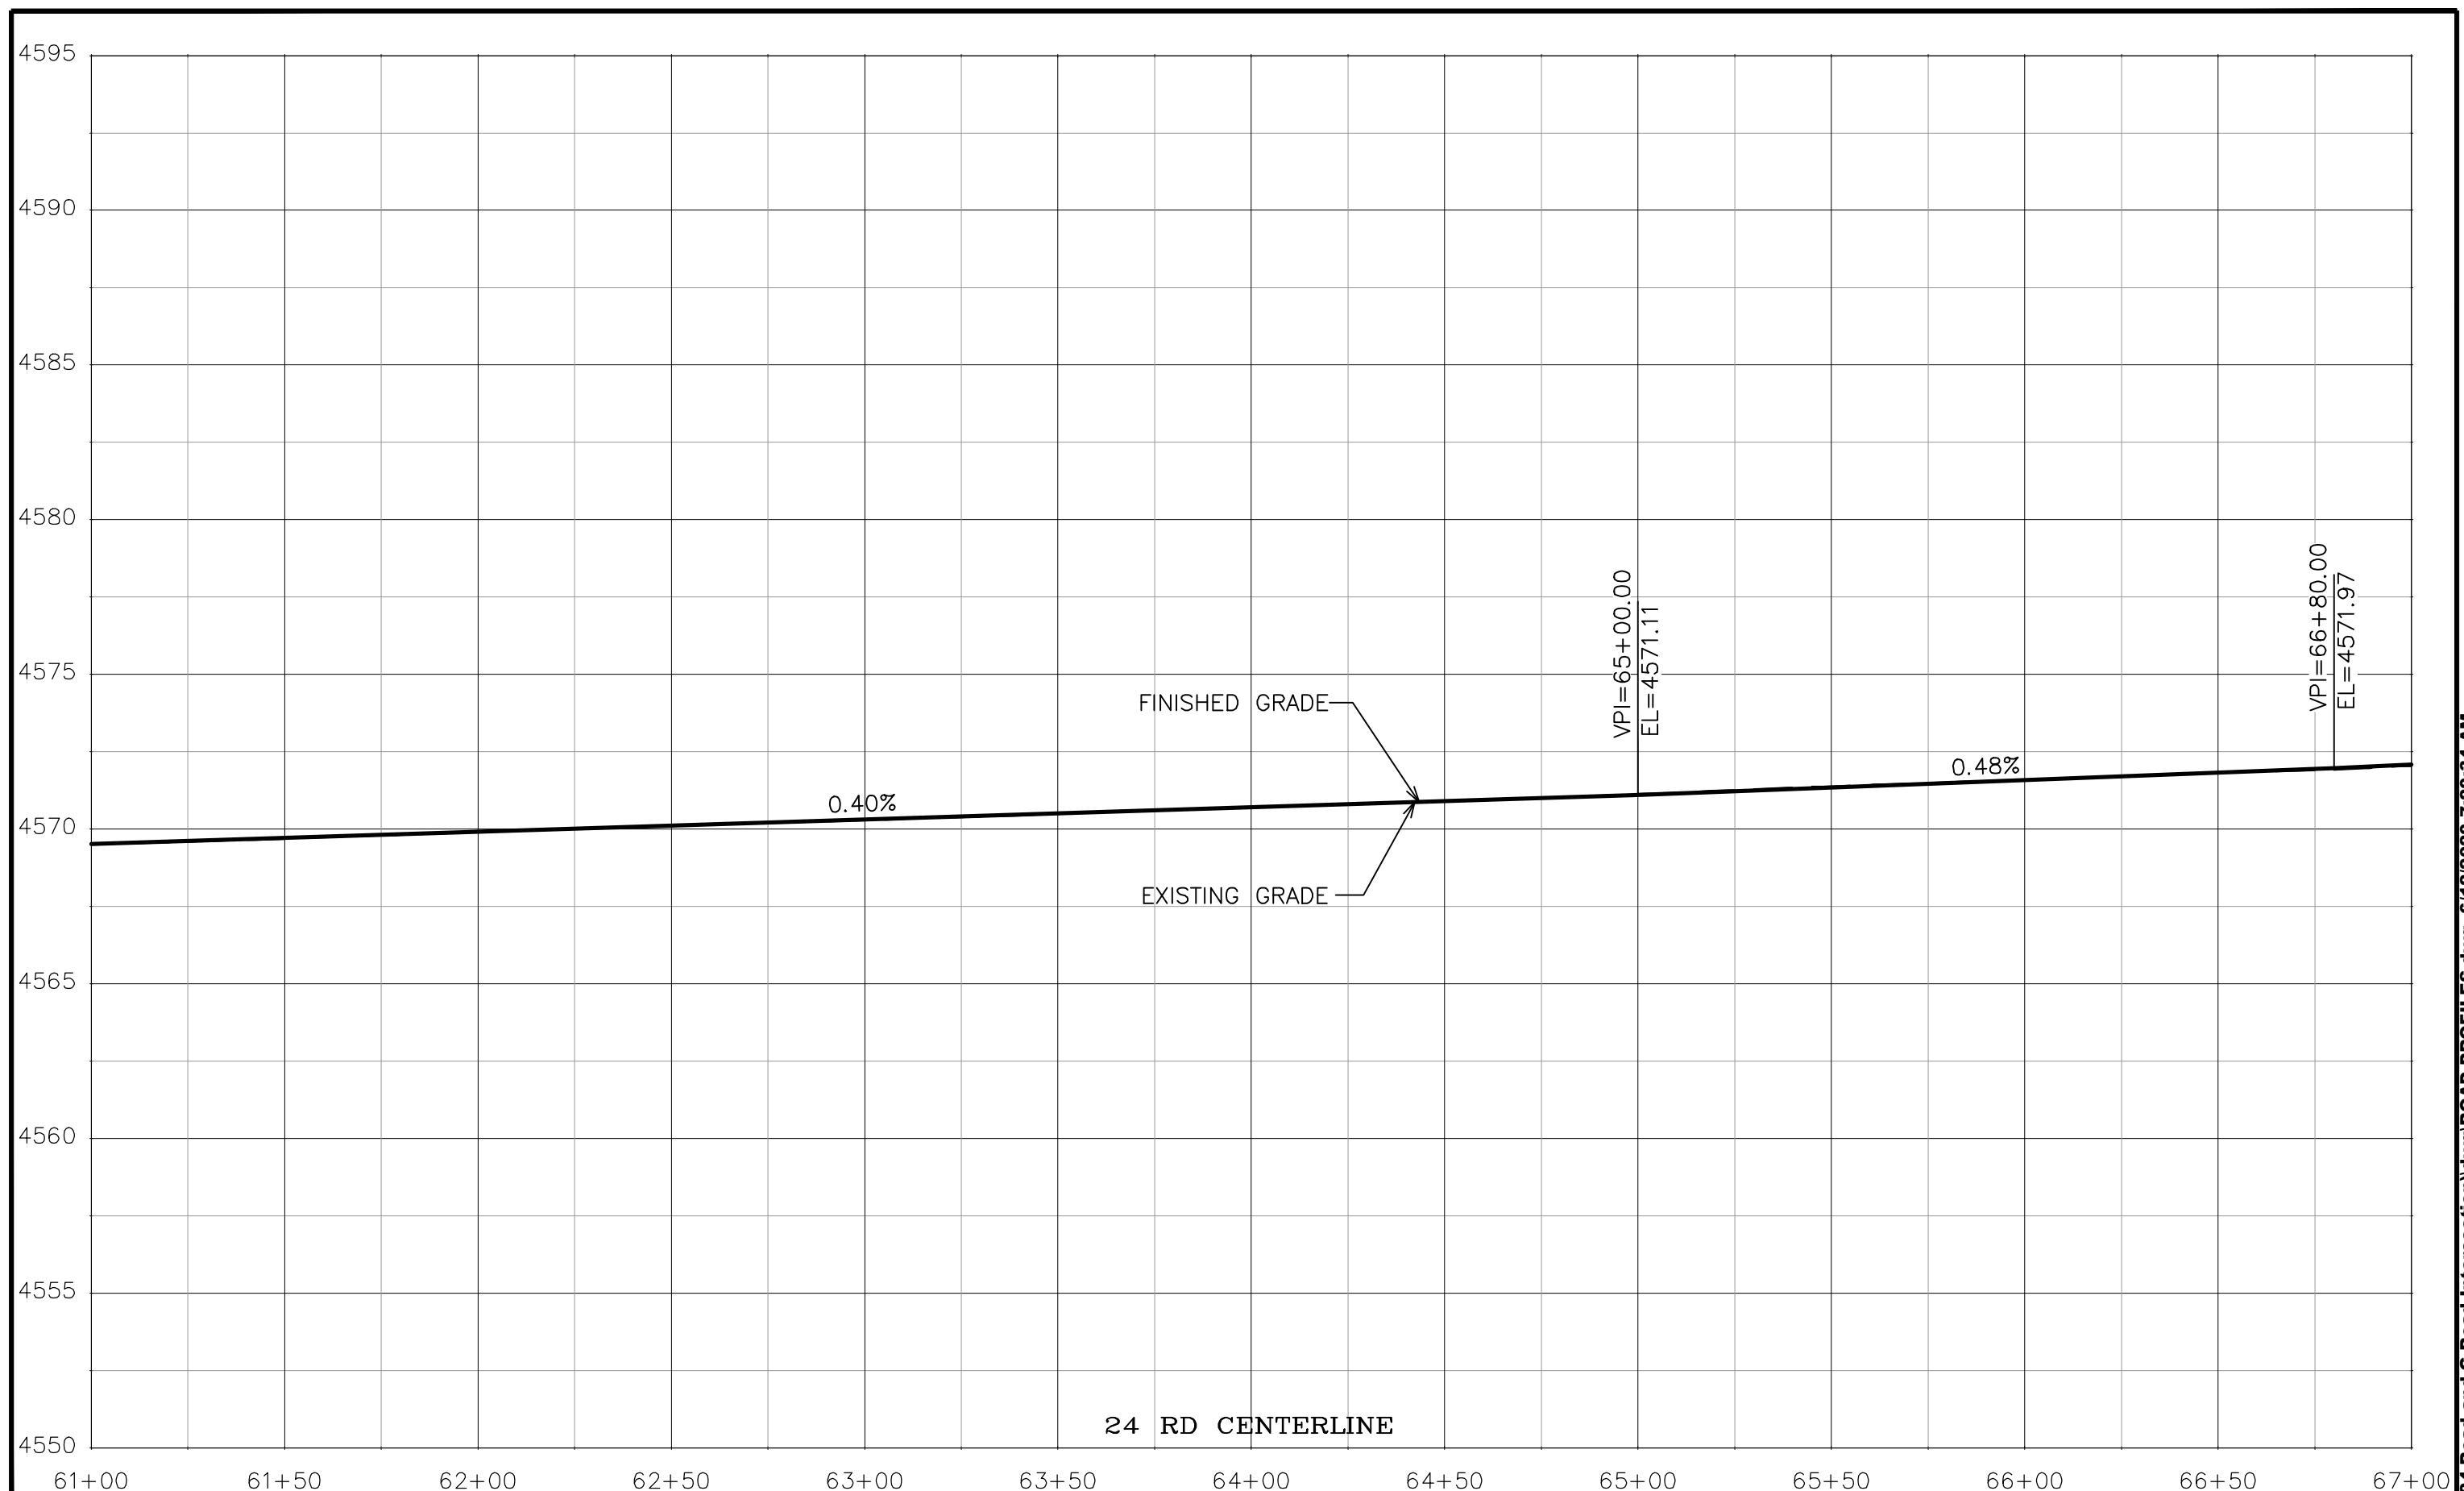

DESCRIPTION	DATE
REVISION ▲ REV 1	- DATE
REVISION ▲ REV 2	- DATE
REVISION ▲ REV 3	- DATE
REVISION ▲ REV 4	- DATE


DRAWN BY	JCS	DATE 2020
DESIGNED BY	JCS	DATE 2020
CHECKED BY	ALC	DATE 2020
APPROVED BY	TCP	DATE 2020

SCALES:	PLAN & PROFILE		
0	10	20	40
	HORIZONTAL		
0	2.5	5	
	VERTICAL		



PUBLIC WORKS
ENGINEERING DIVISION
PROJECT NO. 207-F1903

24 ROAD AND G ROAD
ROAD PROFILES - 16

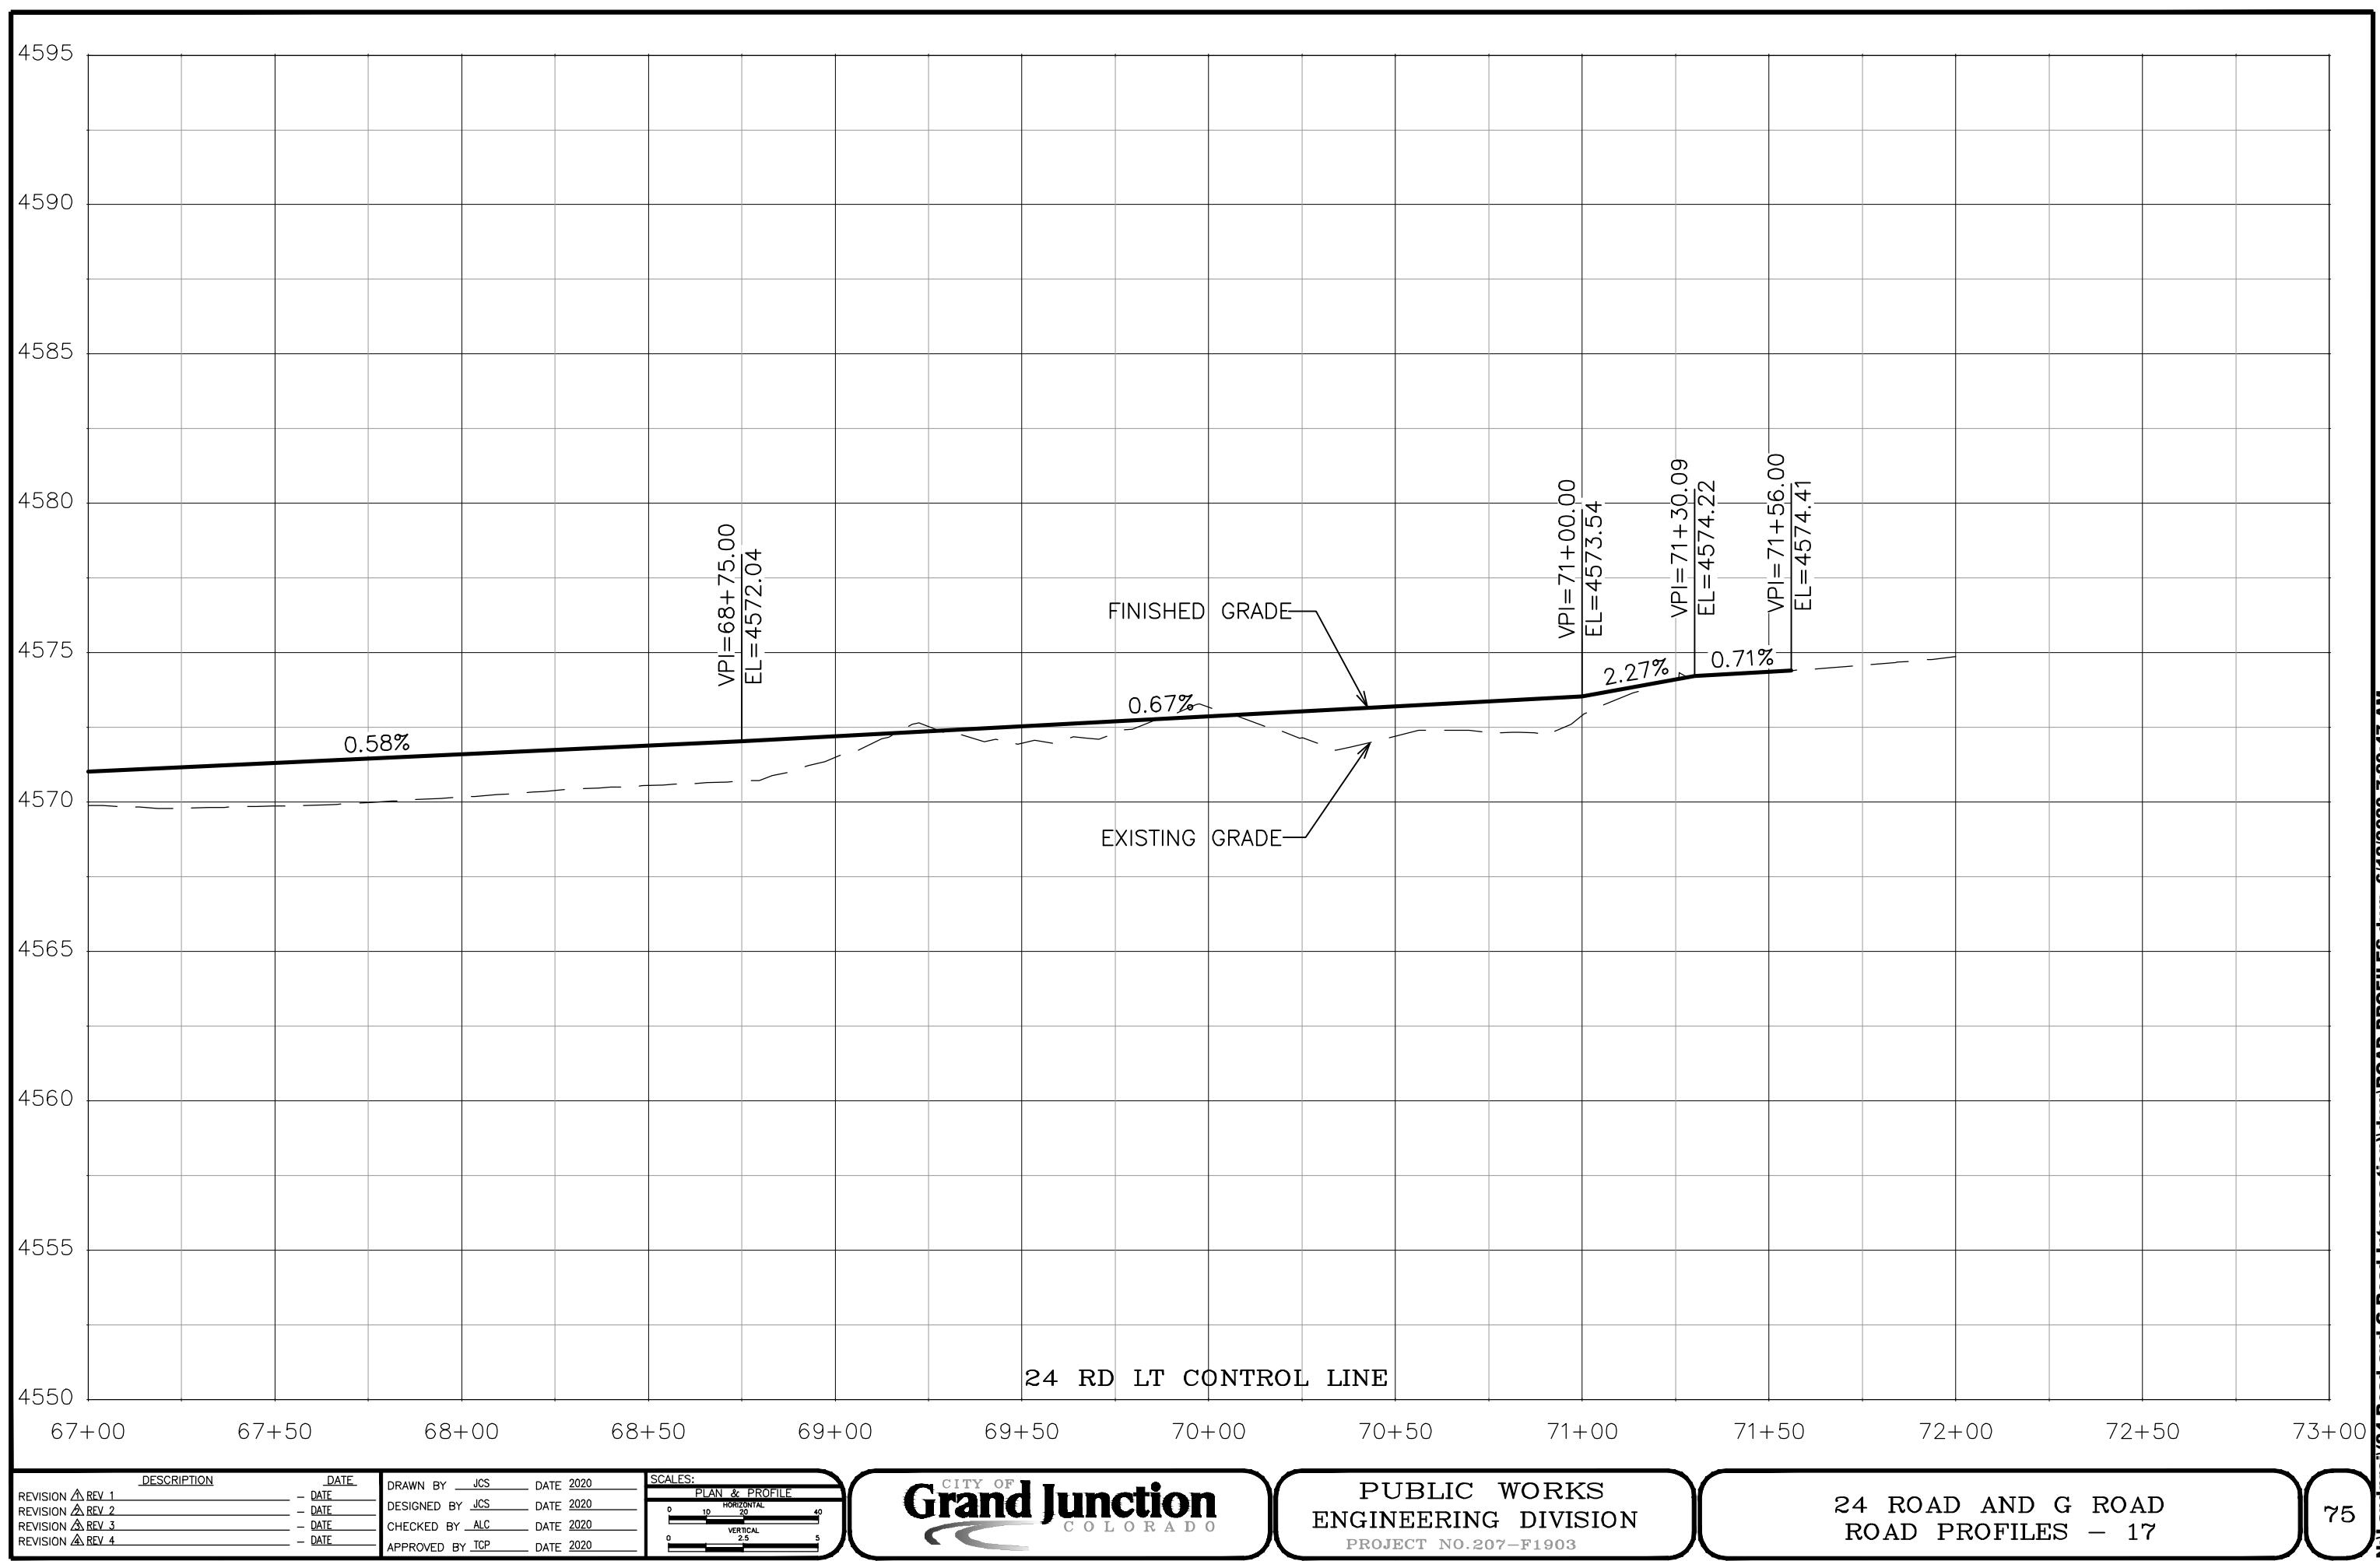

DESCRIPTION DATE
REVISION ▲ REV 1 - DATE
REVISION ▲ REV 2 - DATE
REVISION ▲ REV 3 - DATE
REVISION ▲ REV 4 - DATE


DRAWN BY JCS DATE 2020
DESIGNED BY JCS DATE 2020
CHECKED BY ALC DATE 2020
APPROVED BY TCP DATE 2020

SCALES:
PLAN & PROFILE
0 10 20 40
HORIZONTAL
0 2.5 5
VERTICAL



PUBLIC WORKS
ENGINEERING DIVISION
PROJECT NO. 207-F1903

24 ROAD AND G ROAD
ROAD PROFILES — 17

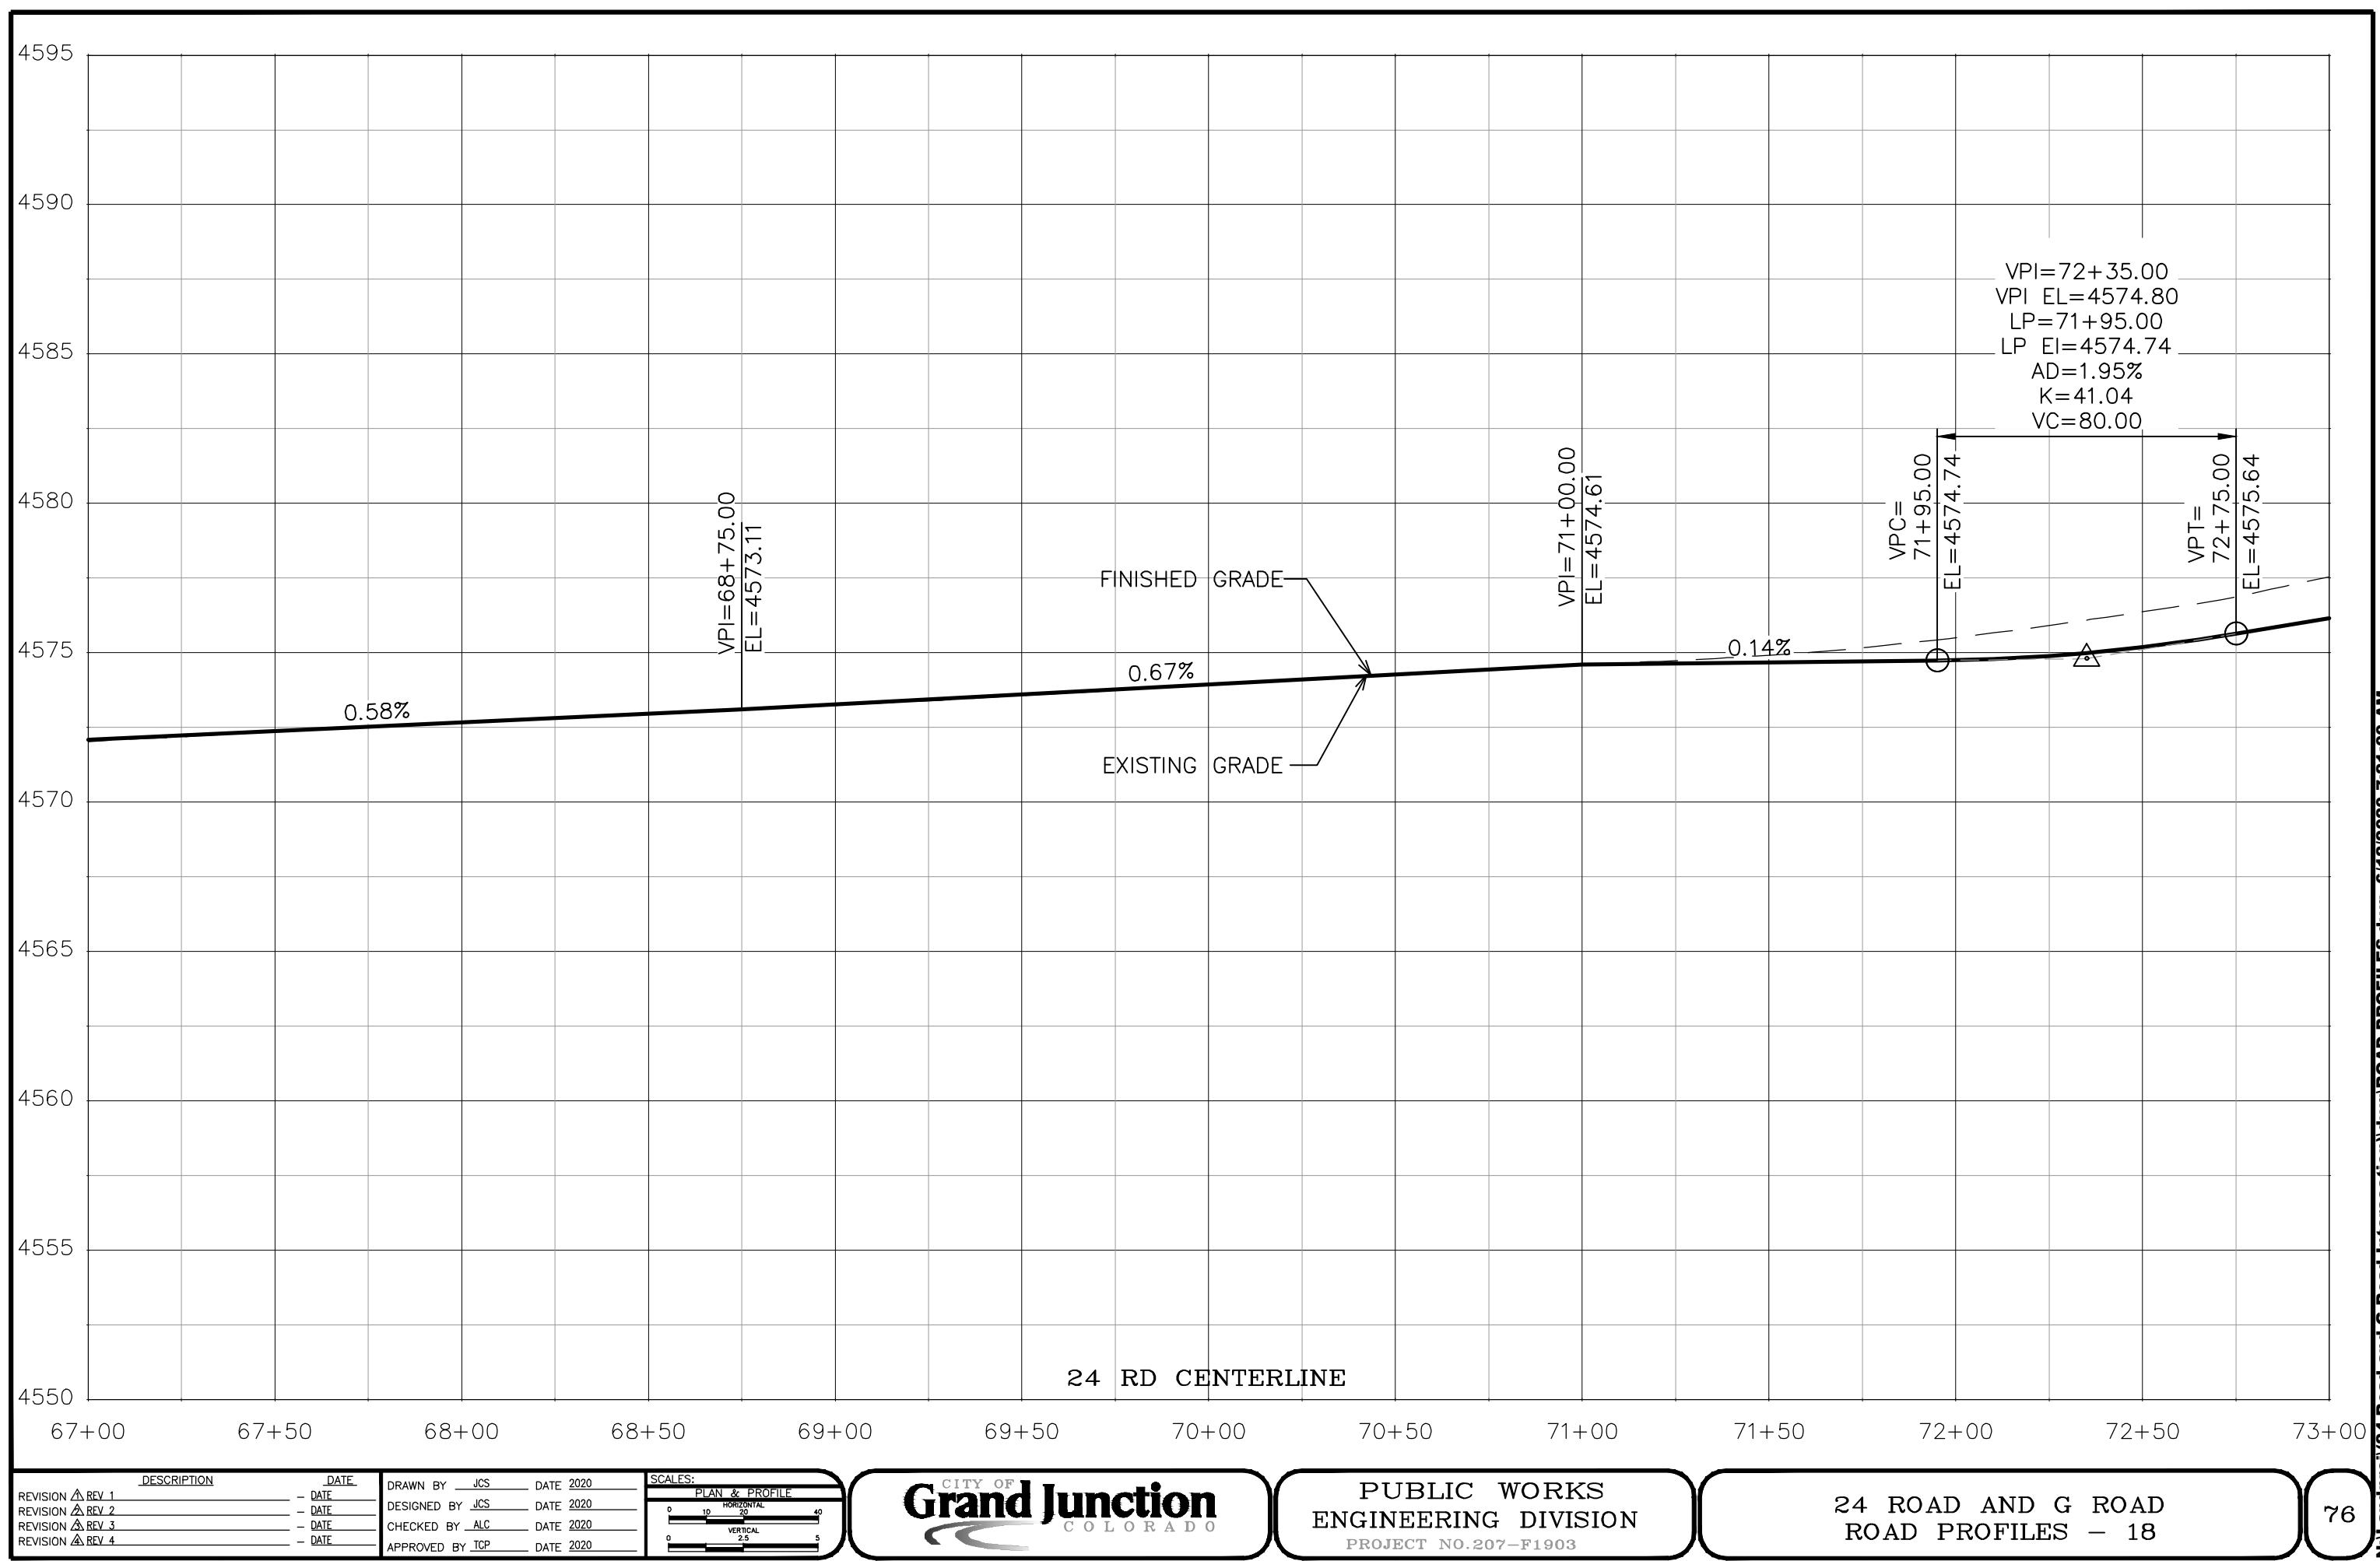

DESCRIPTION	DATE
REVISION A REV 1	- DATE
REVISION A REV 2	- DATE
REVISION A REV 3	- DATE
REVISION A REV 4	- DATE


DRAWN BY	JCS	DATE 2020
DESIGNED BY	JCS	DATE 2020
CHECKED BY	ALC	DATE 2020
APPROVED BY	TCP	DATE 2020

SCALES:		
PLAN & PROFILE		
0	10	20
0	2.5	5



PUBLIC WORKS
ENGINEERING DIVISION
PROJECT NO. 207-F1903

24 ROAD AND G ROAD
ROAD PROFILES - 18

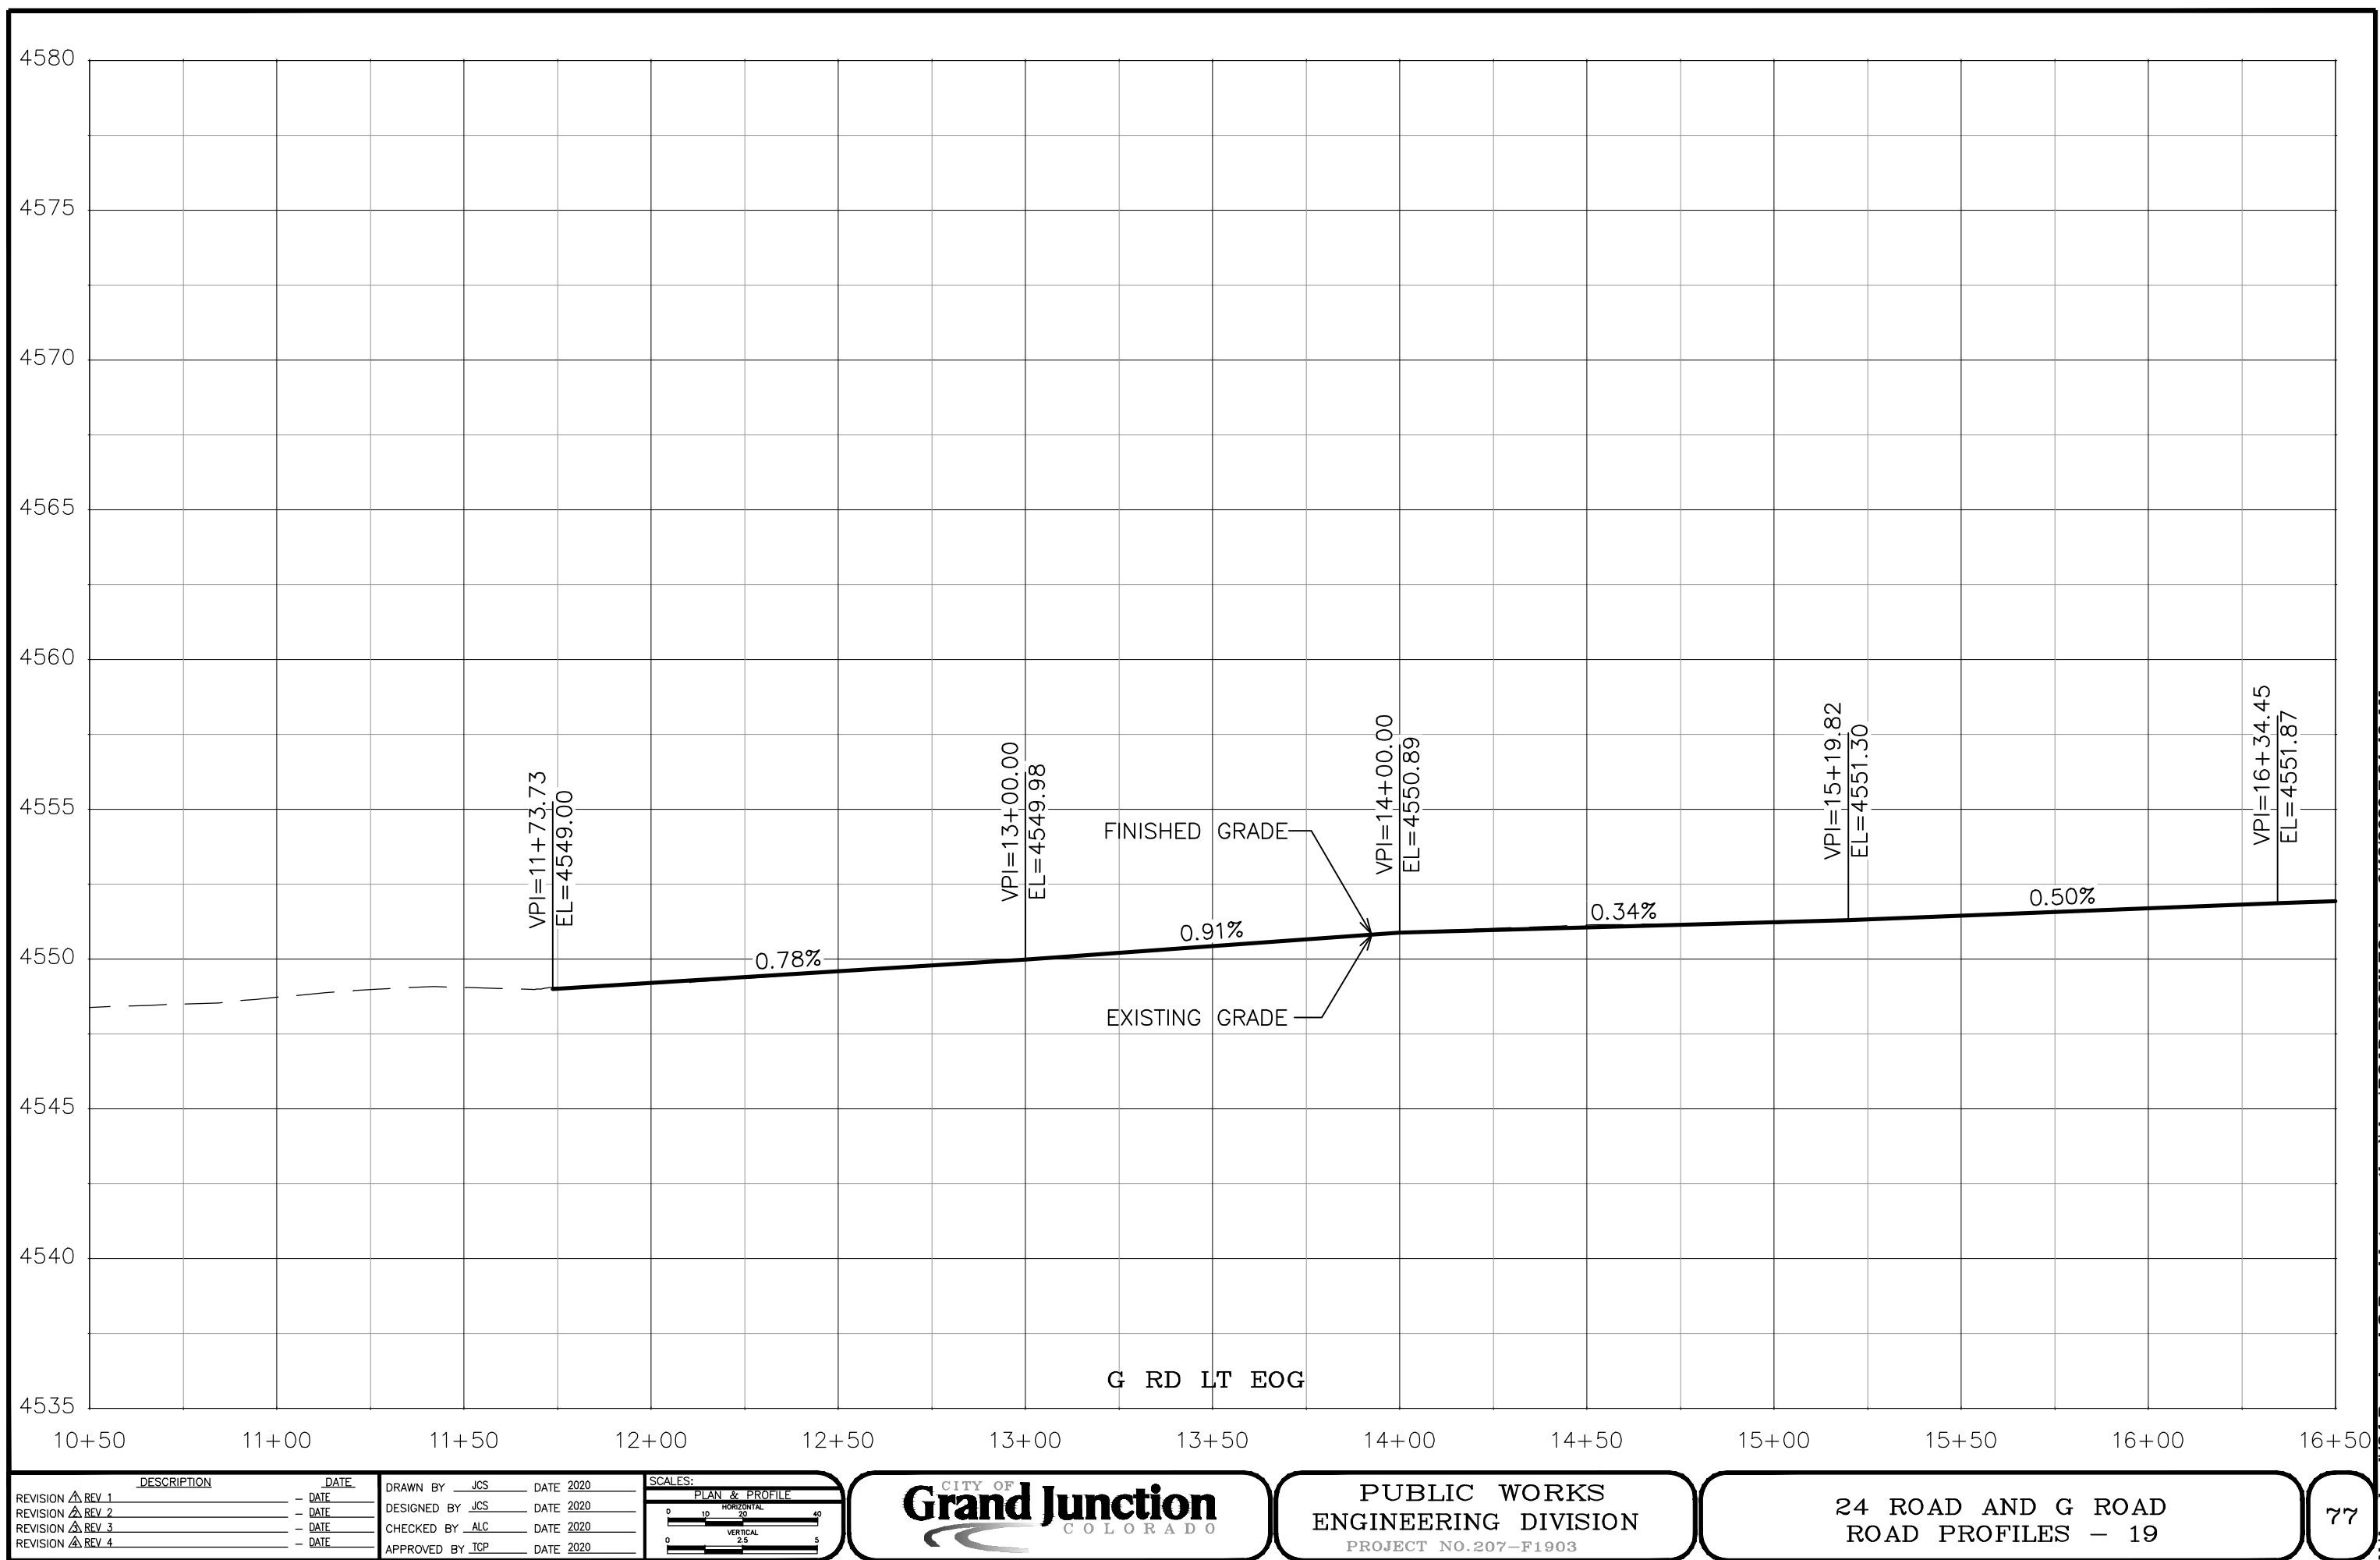

DESCRIPTION		DATE
REVISION ▲ REV 1		- DATE
REVISION ▲ REV 2		- DATE
REVISION ▲ REV 3		- DATE
REVISION ▲ REV 4		- DATE


DRAWN BY	JCS	DATE 2020
DESIGNED BY	JCS	DATE 2020
CHECKED BY	ALC	DATE 2020
APPROVED BY	TCP	DATE 2020

SCALES:		
PLAN & PROFILE		
0	10	20
HORIZONTAL		
0	2.5	5
VERTICAL		



PUBLIC WORKS
ENGINEERING DIVISION
PROJECT NO. 207-F1903

24 ROAD AND G ROAD
ROAD PROFILES — 19

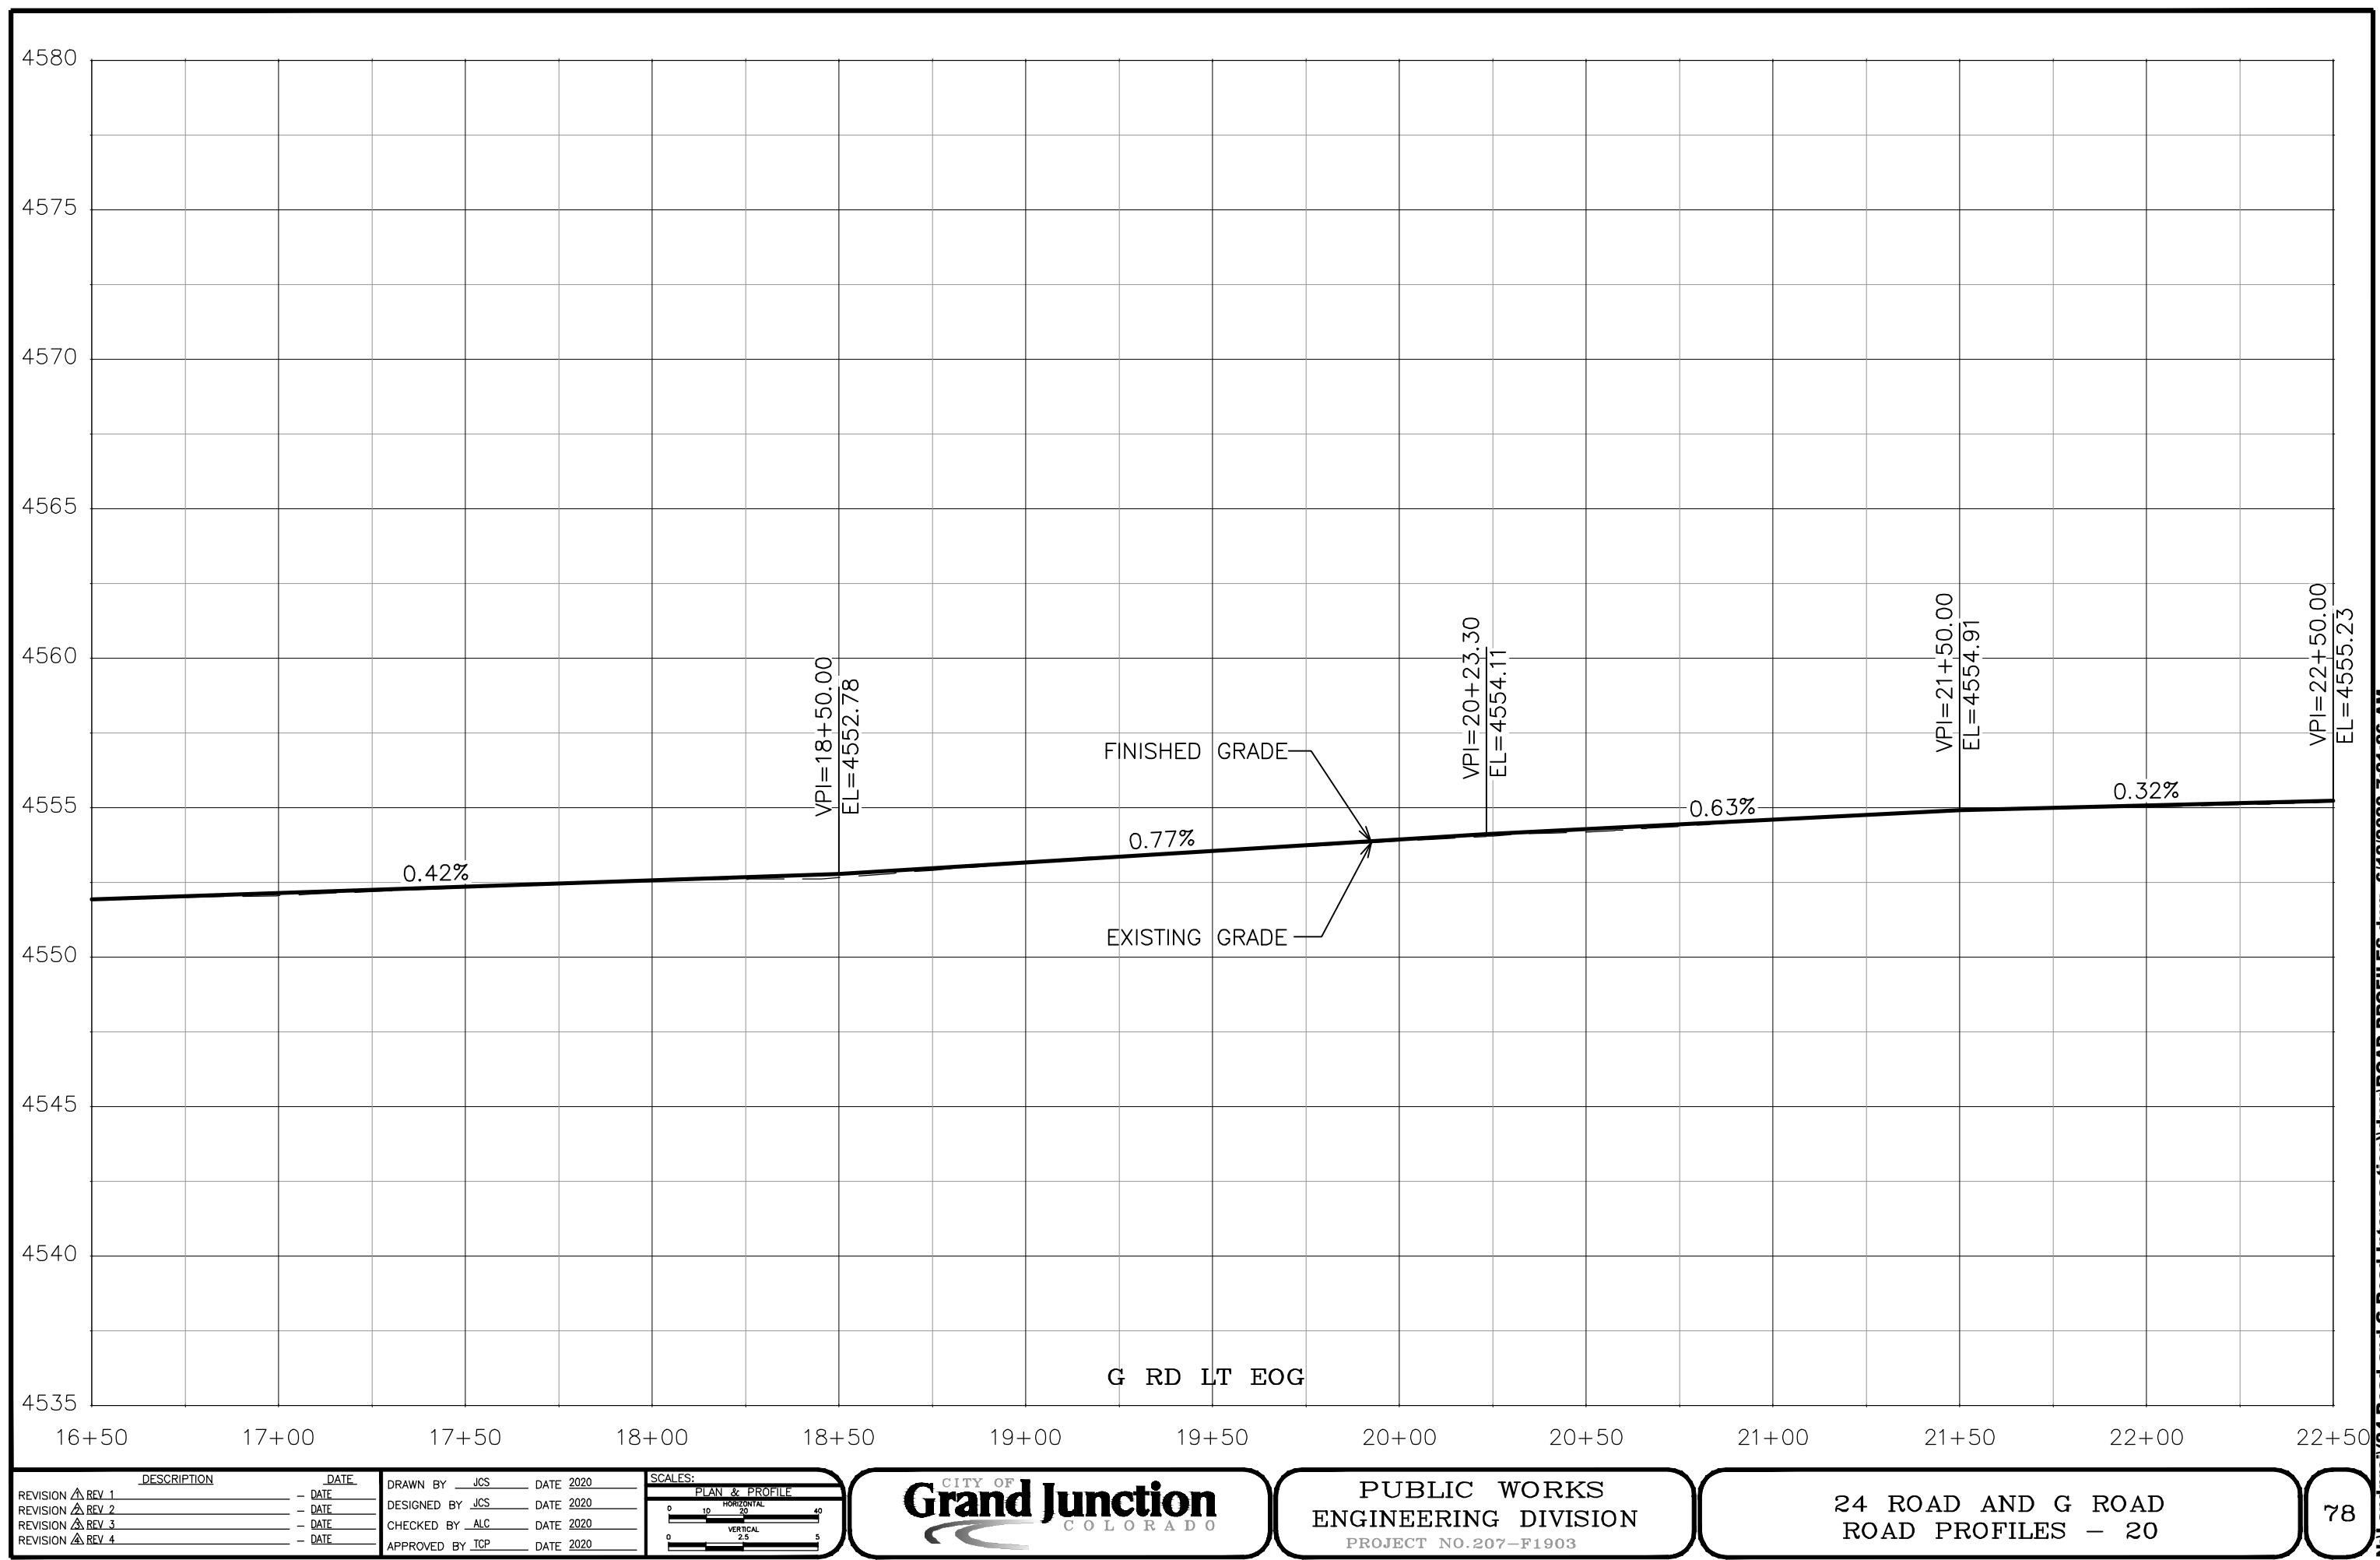

DESCRIPTION	DATE
REVISION ▲ REV 1	- DATE
REVISION ▲ REV 2	- DATE
REVISION ▲ REV 3	- DATE
REVISION ▲ REV 4	- DATE


DRAWN BY	JCS	DATE 2020
DESIGNED BY	JCS	DATE 2020
CHECKED BY	ALC	DATE 2020
APPROVED BY	TCP	DATE 2020

SCALES:		
PLAN & PROFILE		
0	10	20
HORIZONTAL		
0	2.5	5
VERTICAL		



PUBLIC WORKS
 ENGINEERING DIVISION
 PROJECT NO. 207-F1903

24 ROAD AND G ROAD
 ROAD PROFILES - 20

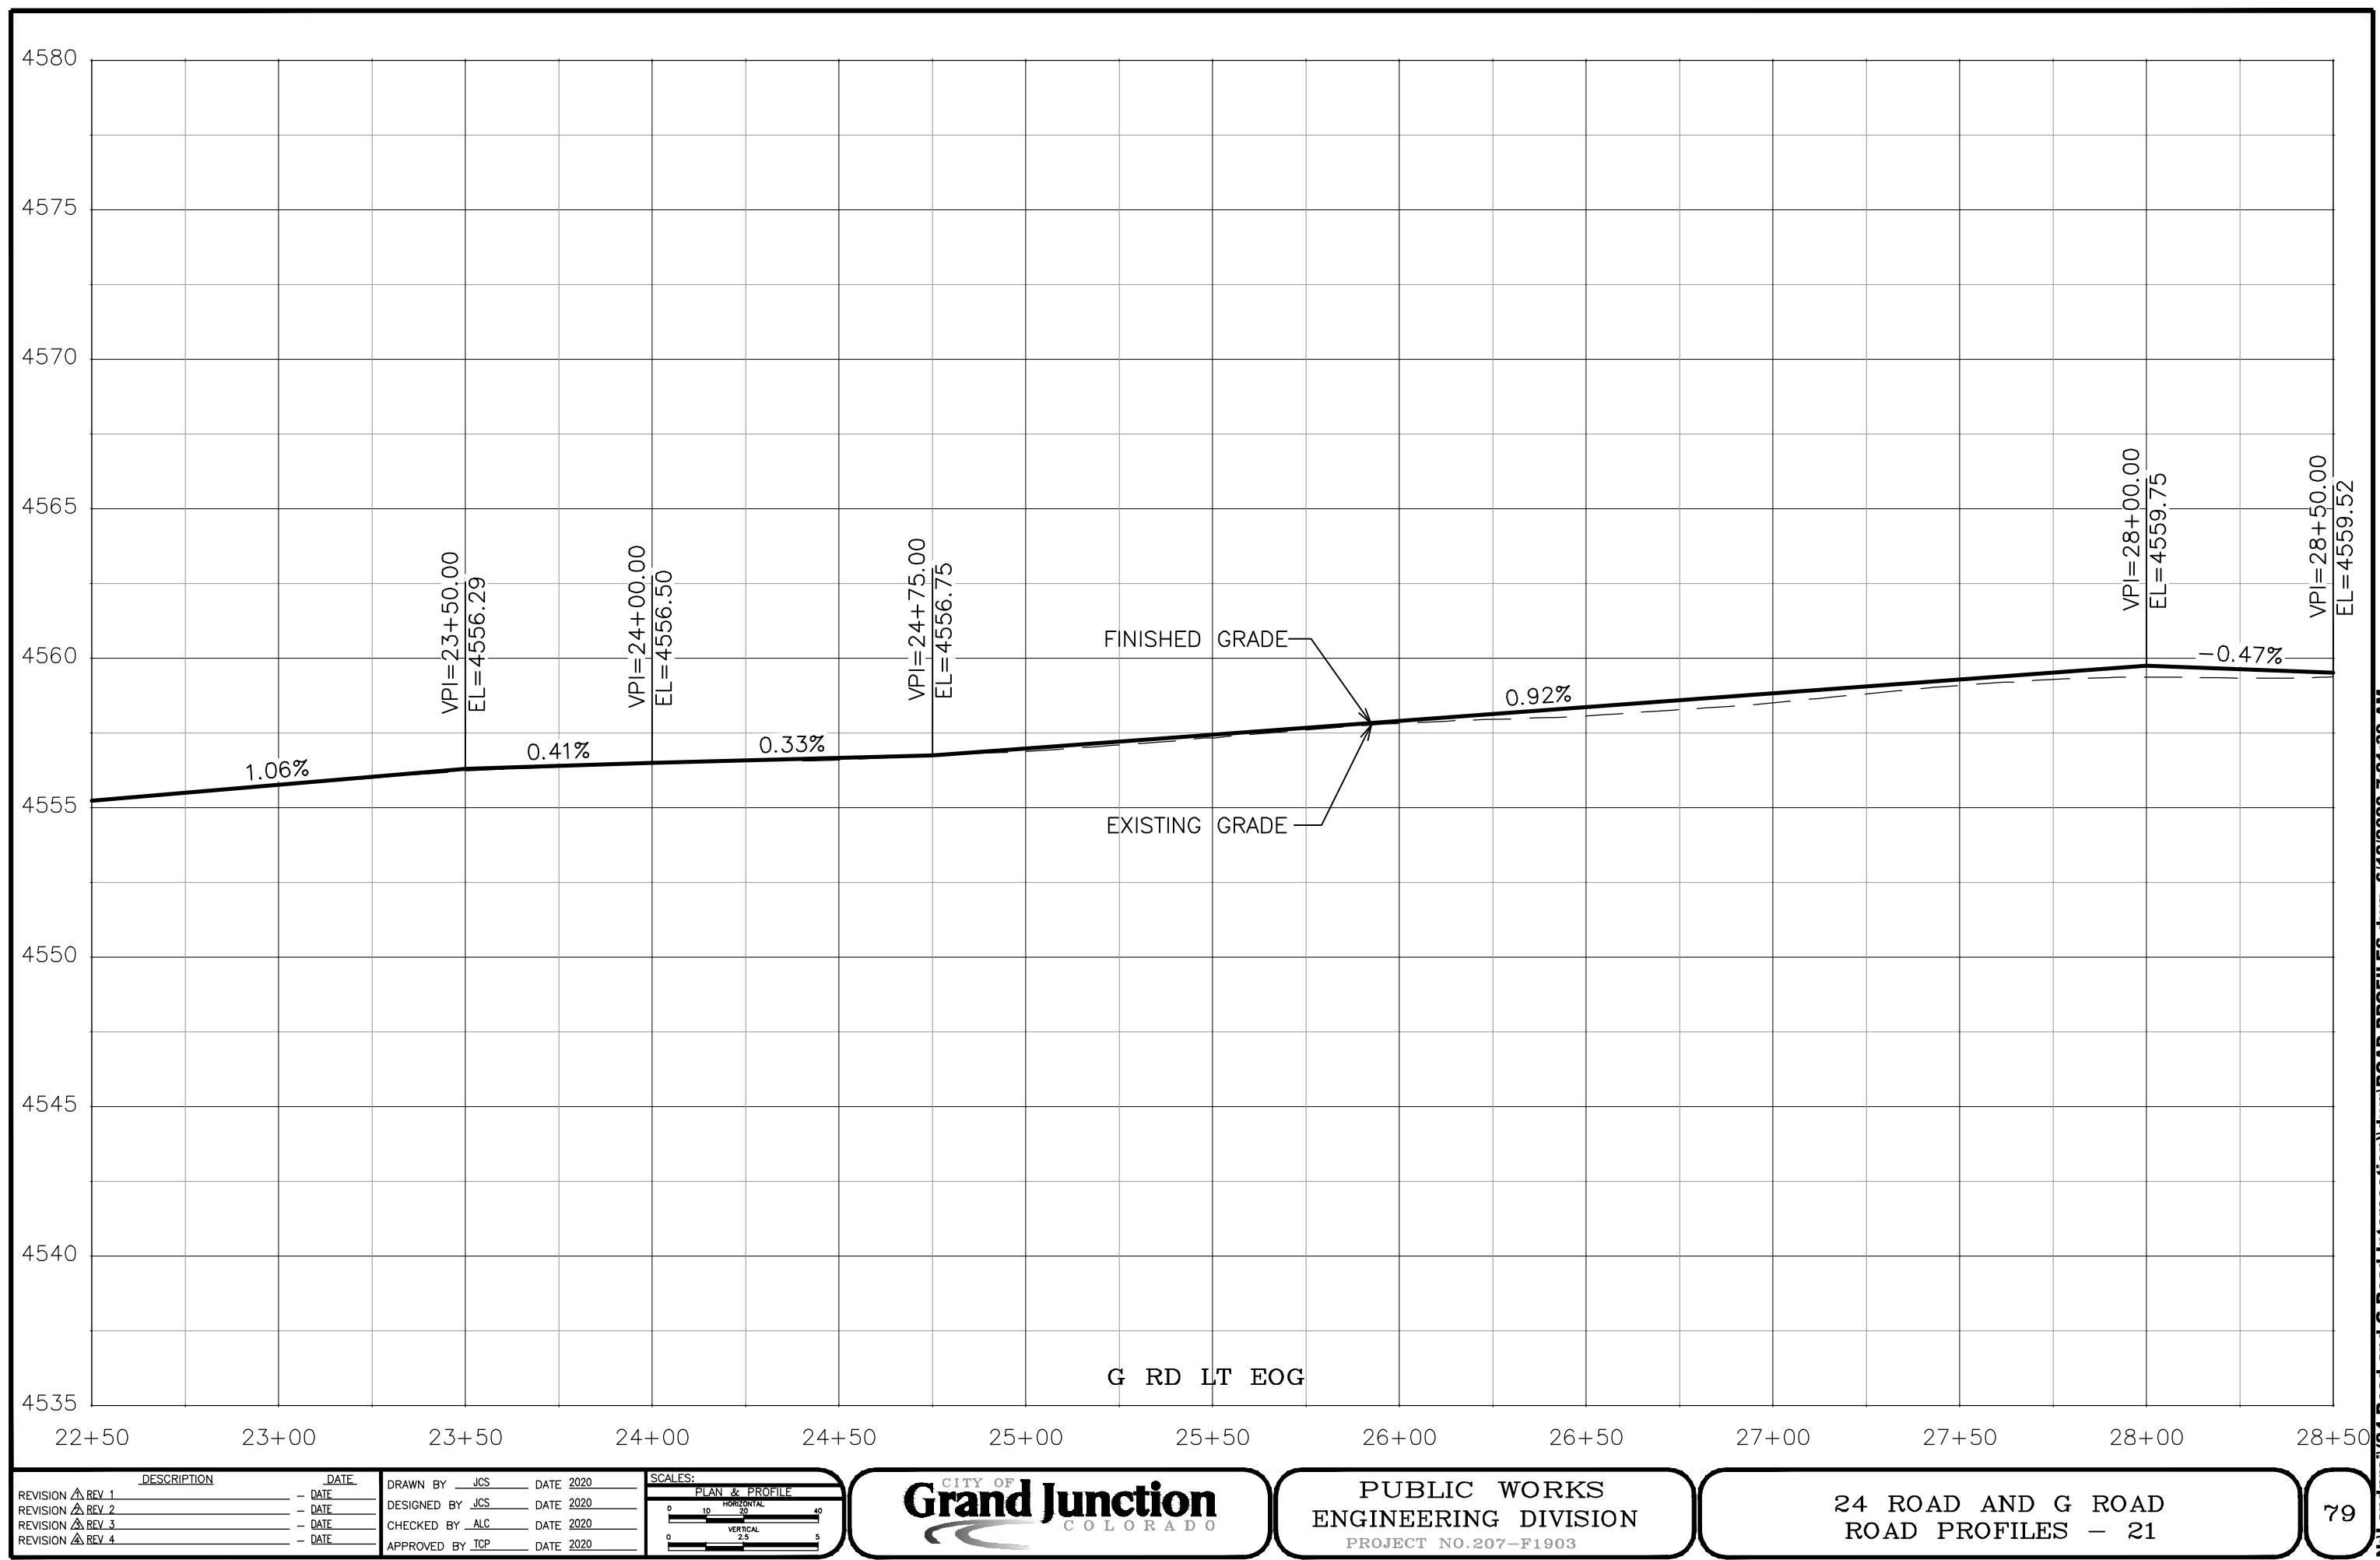

DESCRIPTION	DATE
REVISION ▲ REV 1	- DATE
REVISION ▲ REV 2	- DATE
REVISION ▲ REV 3	- DATE
REVISION ▲ REV 4	- DATE


DRAWN BY	JCS	DATE 2020
DESIGNED BY	JCS	DATE 2020
CHECKED BY	ALC	DATE 2020
APPROVED BY	TCP	DATE 2020

SCALES:	PLAN & PROFILE		
0	10	20	40
0	2.5	5	



PUBLIC WORKS
ENGINEERING DIVISION
PROJECT NO. 207-F1903

24 ROAD AND G ROAD
ROAD PROFILES — 21

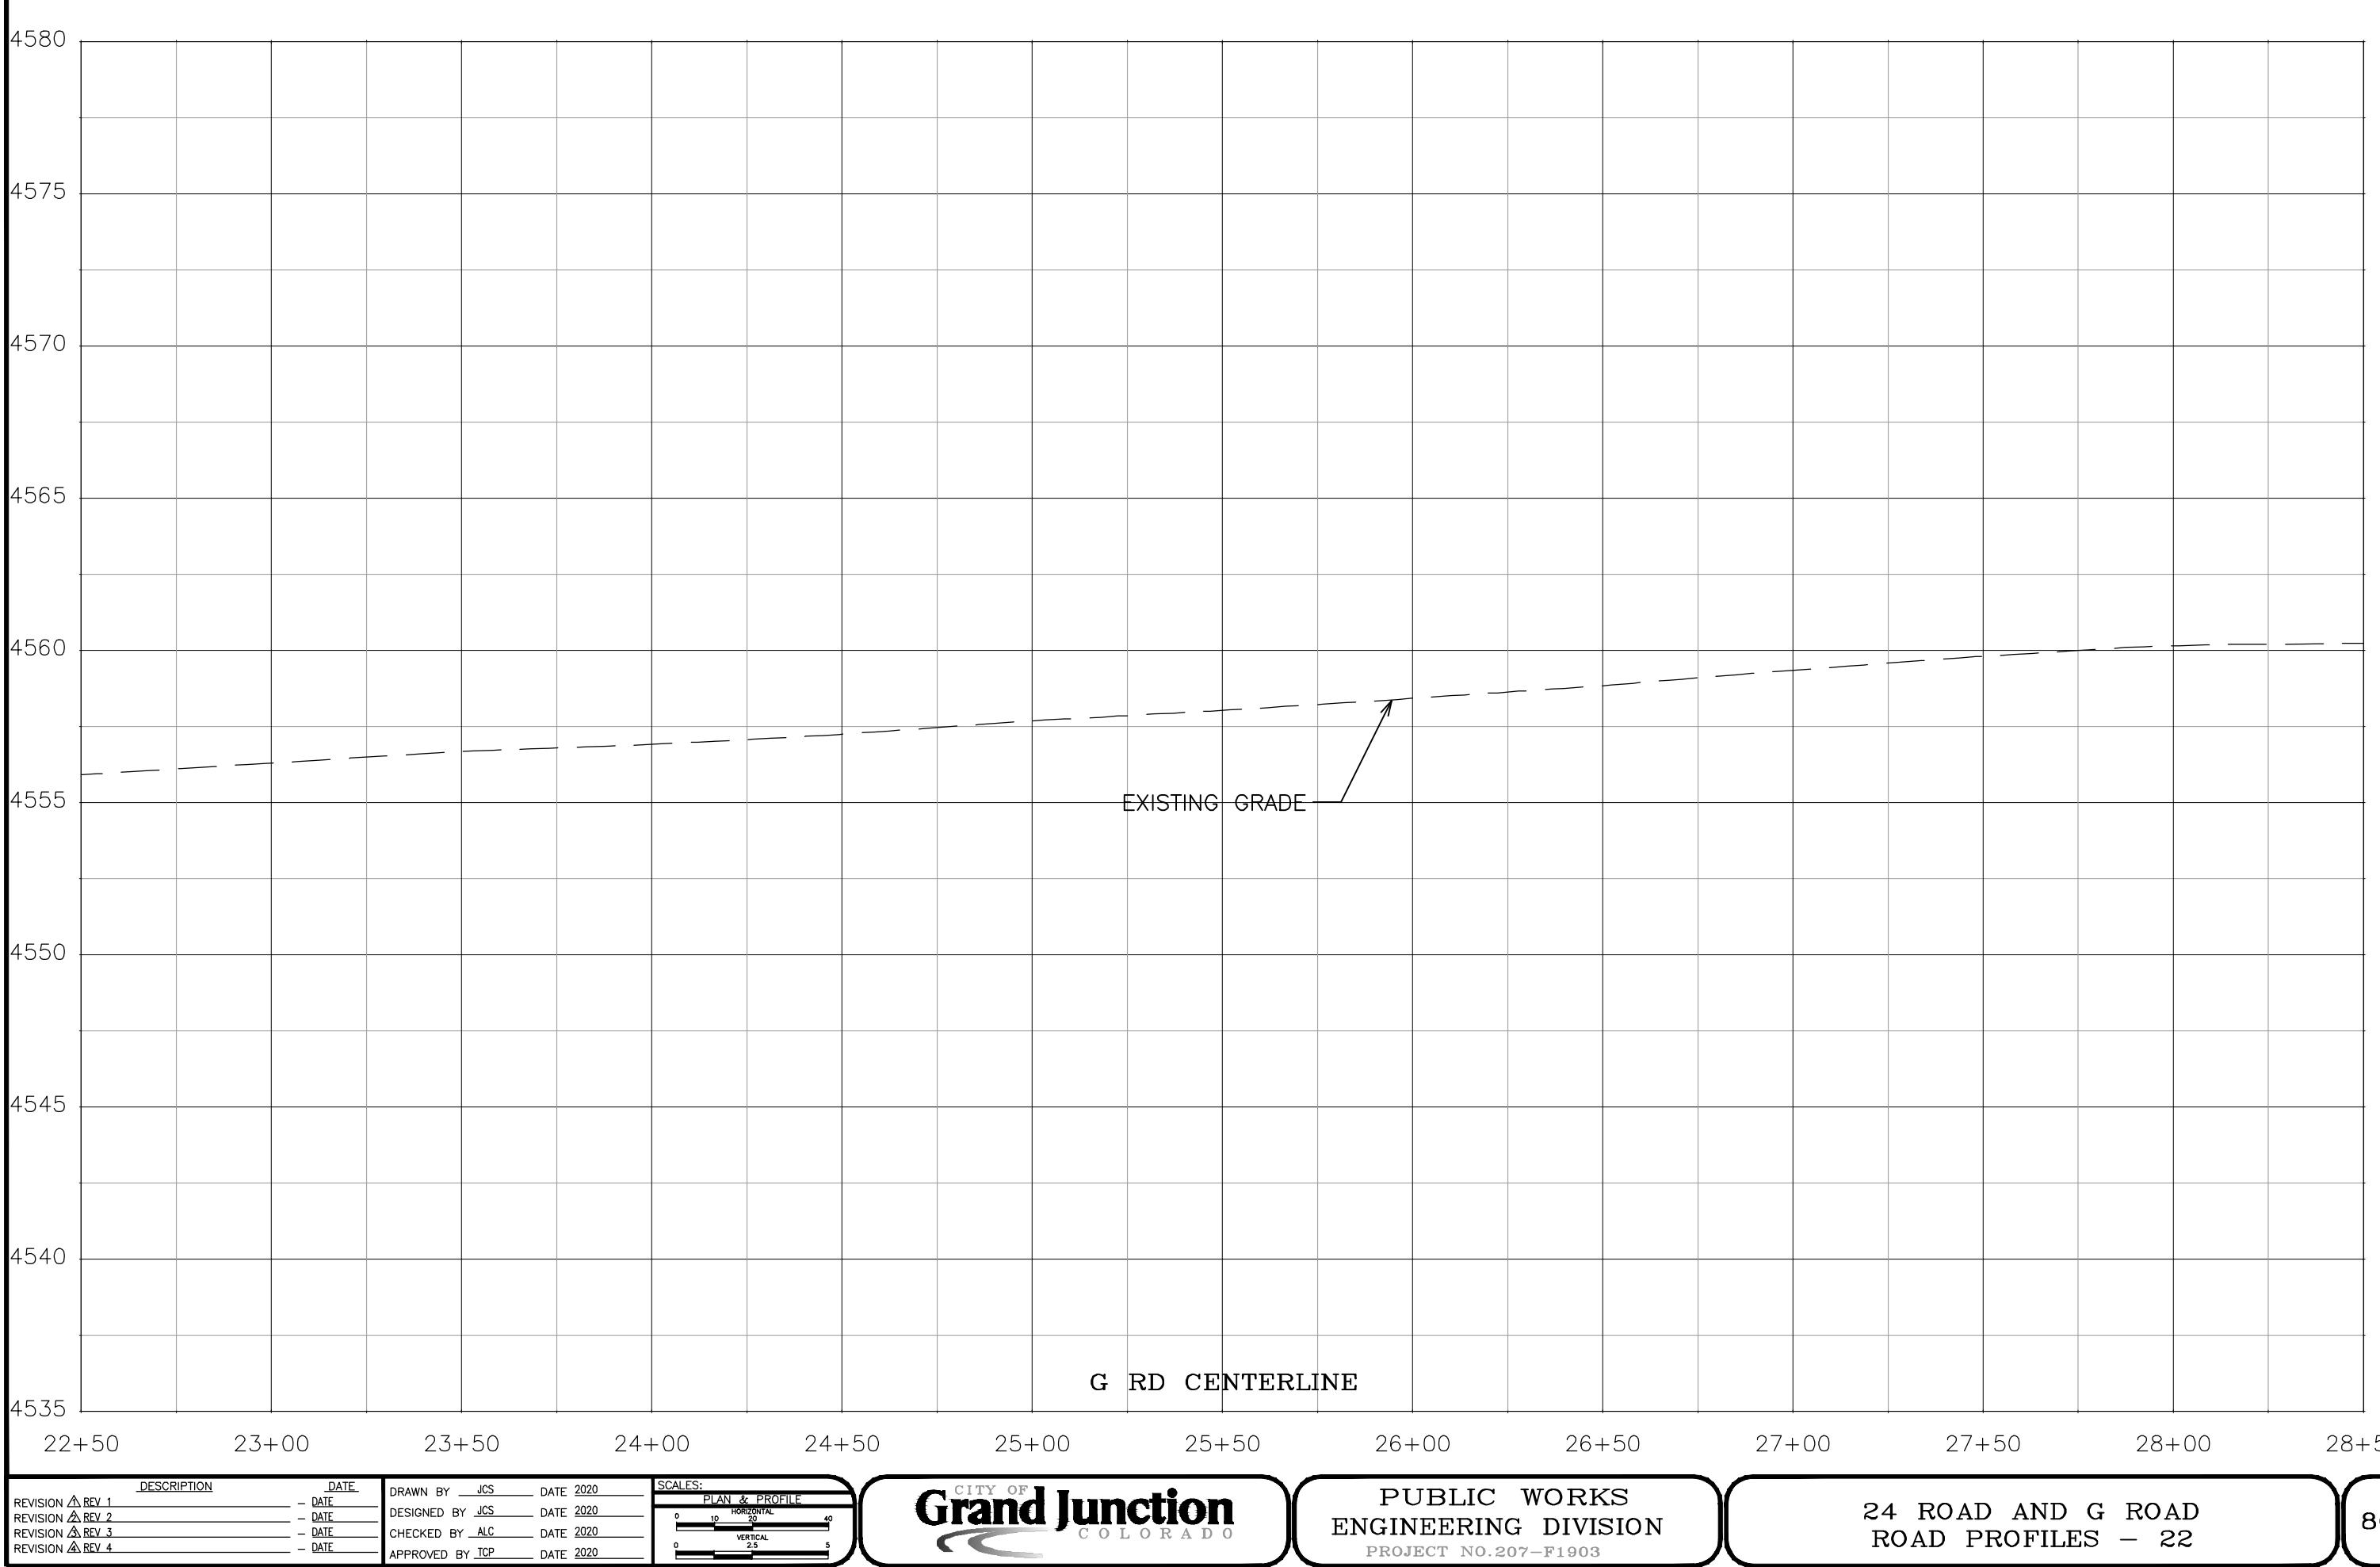

REVISION ▲ REV 1	DESCRIPTION	DATE
REVISION ▲ REV 2		
REVISION ▲ REV 3		
REVISION ▲ REV 4		


DRAWN BY	JCS	DATE 2020
DESIGNED BY	JCS	DATE 2020
CHECKED BY	ALC	DATE 2020
APPROVED BY	TCP	DATE 2020

SCALES:	PLAN & PROFILE		
0	10	20	40
	HORIZONTAL		
0	2.5	5	
	VERTICAL		



PUBLIC WORKS
ENGINEERING DIVISION
PROJECT NO. 207-F1903

24 ROAD AND G ROAD
ROAD PROFILES — 22

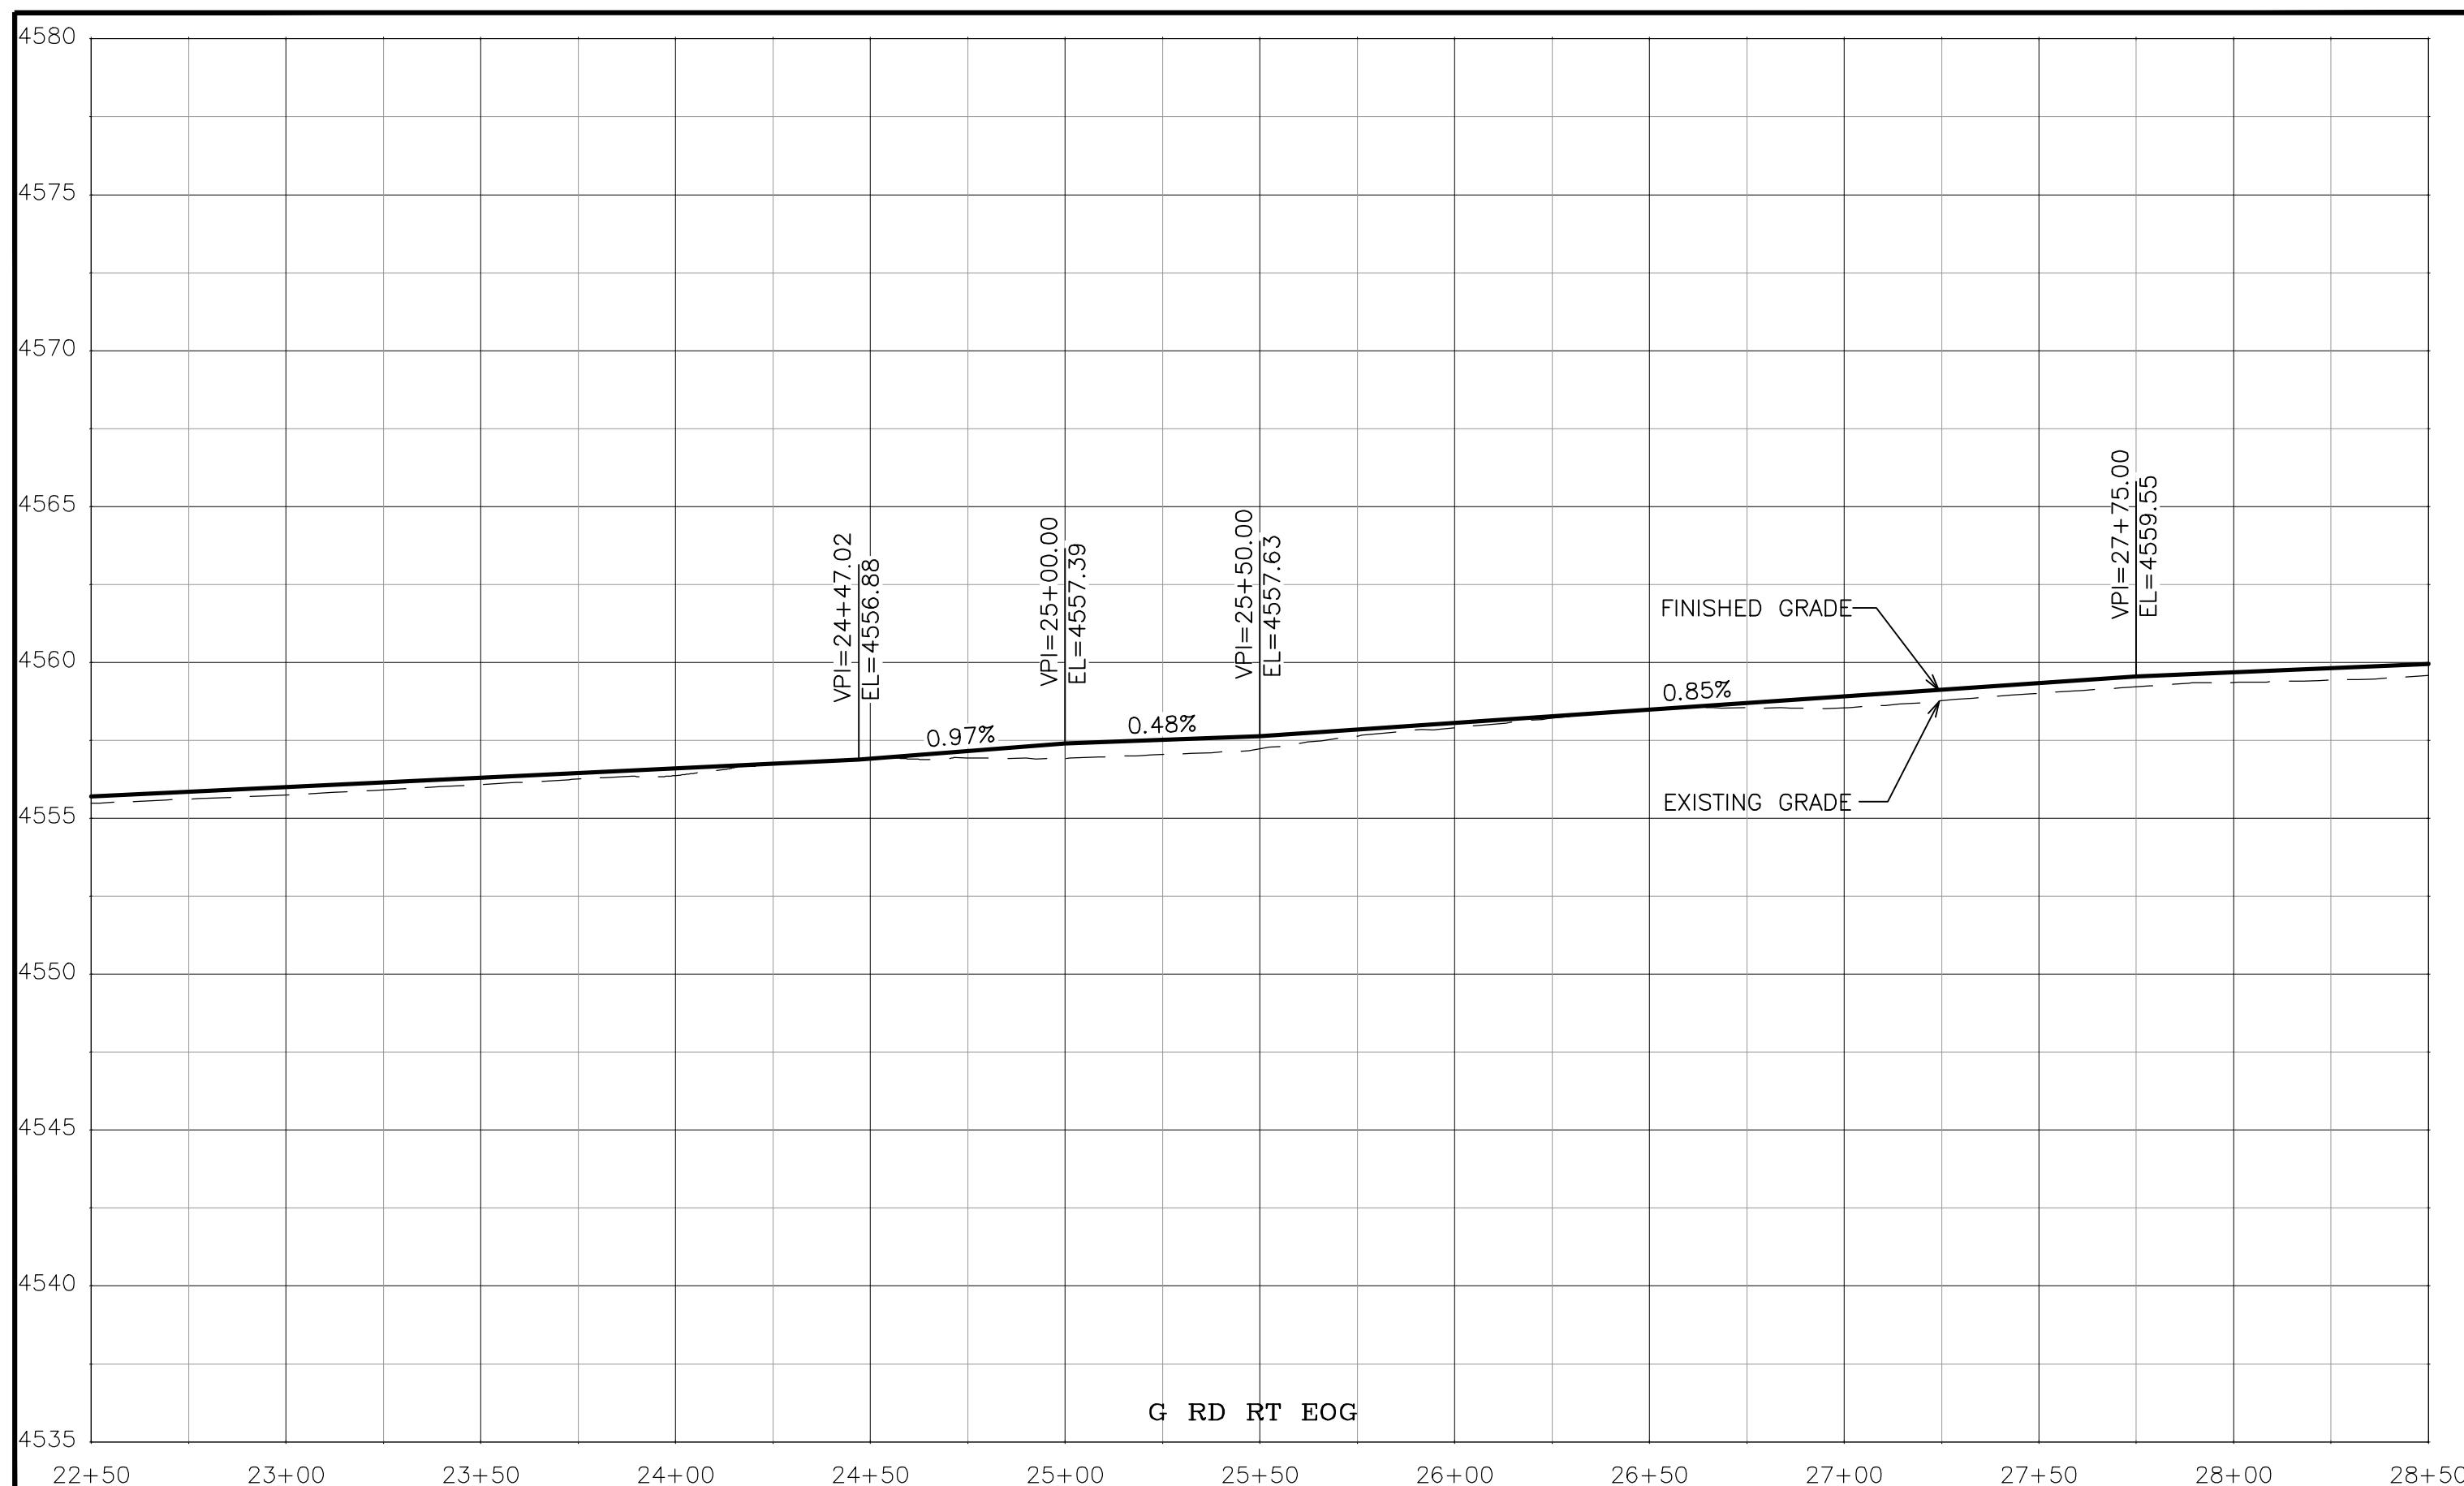

DESCRIPTION	DATE
REVISION A REV 1	- DATE
REVISION A REV 2	- DATE
REVISION A REV 3	- DATE
REVISION A REV 4	- DATE


DRAWN BY JCS	DATE 2020
DESIGNED BY JCS	DATE 2020
CHECKED BY ALC	DATE 2020
APPROVED BY TCP	DATE 2020

SCALES:	
PLAN & PROFILE	
0	10
20	40
0	2.5
5	
HORIZONTAL	
VERTICAL	



PUBLIC WORKS
ENGINEERING DIVISION
PROJECT NO. 207-F1903

24 ROAD AND G ROAD
ROAD PROFILES - 23

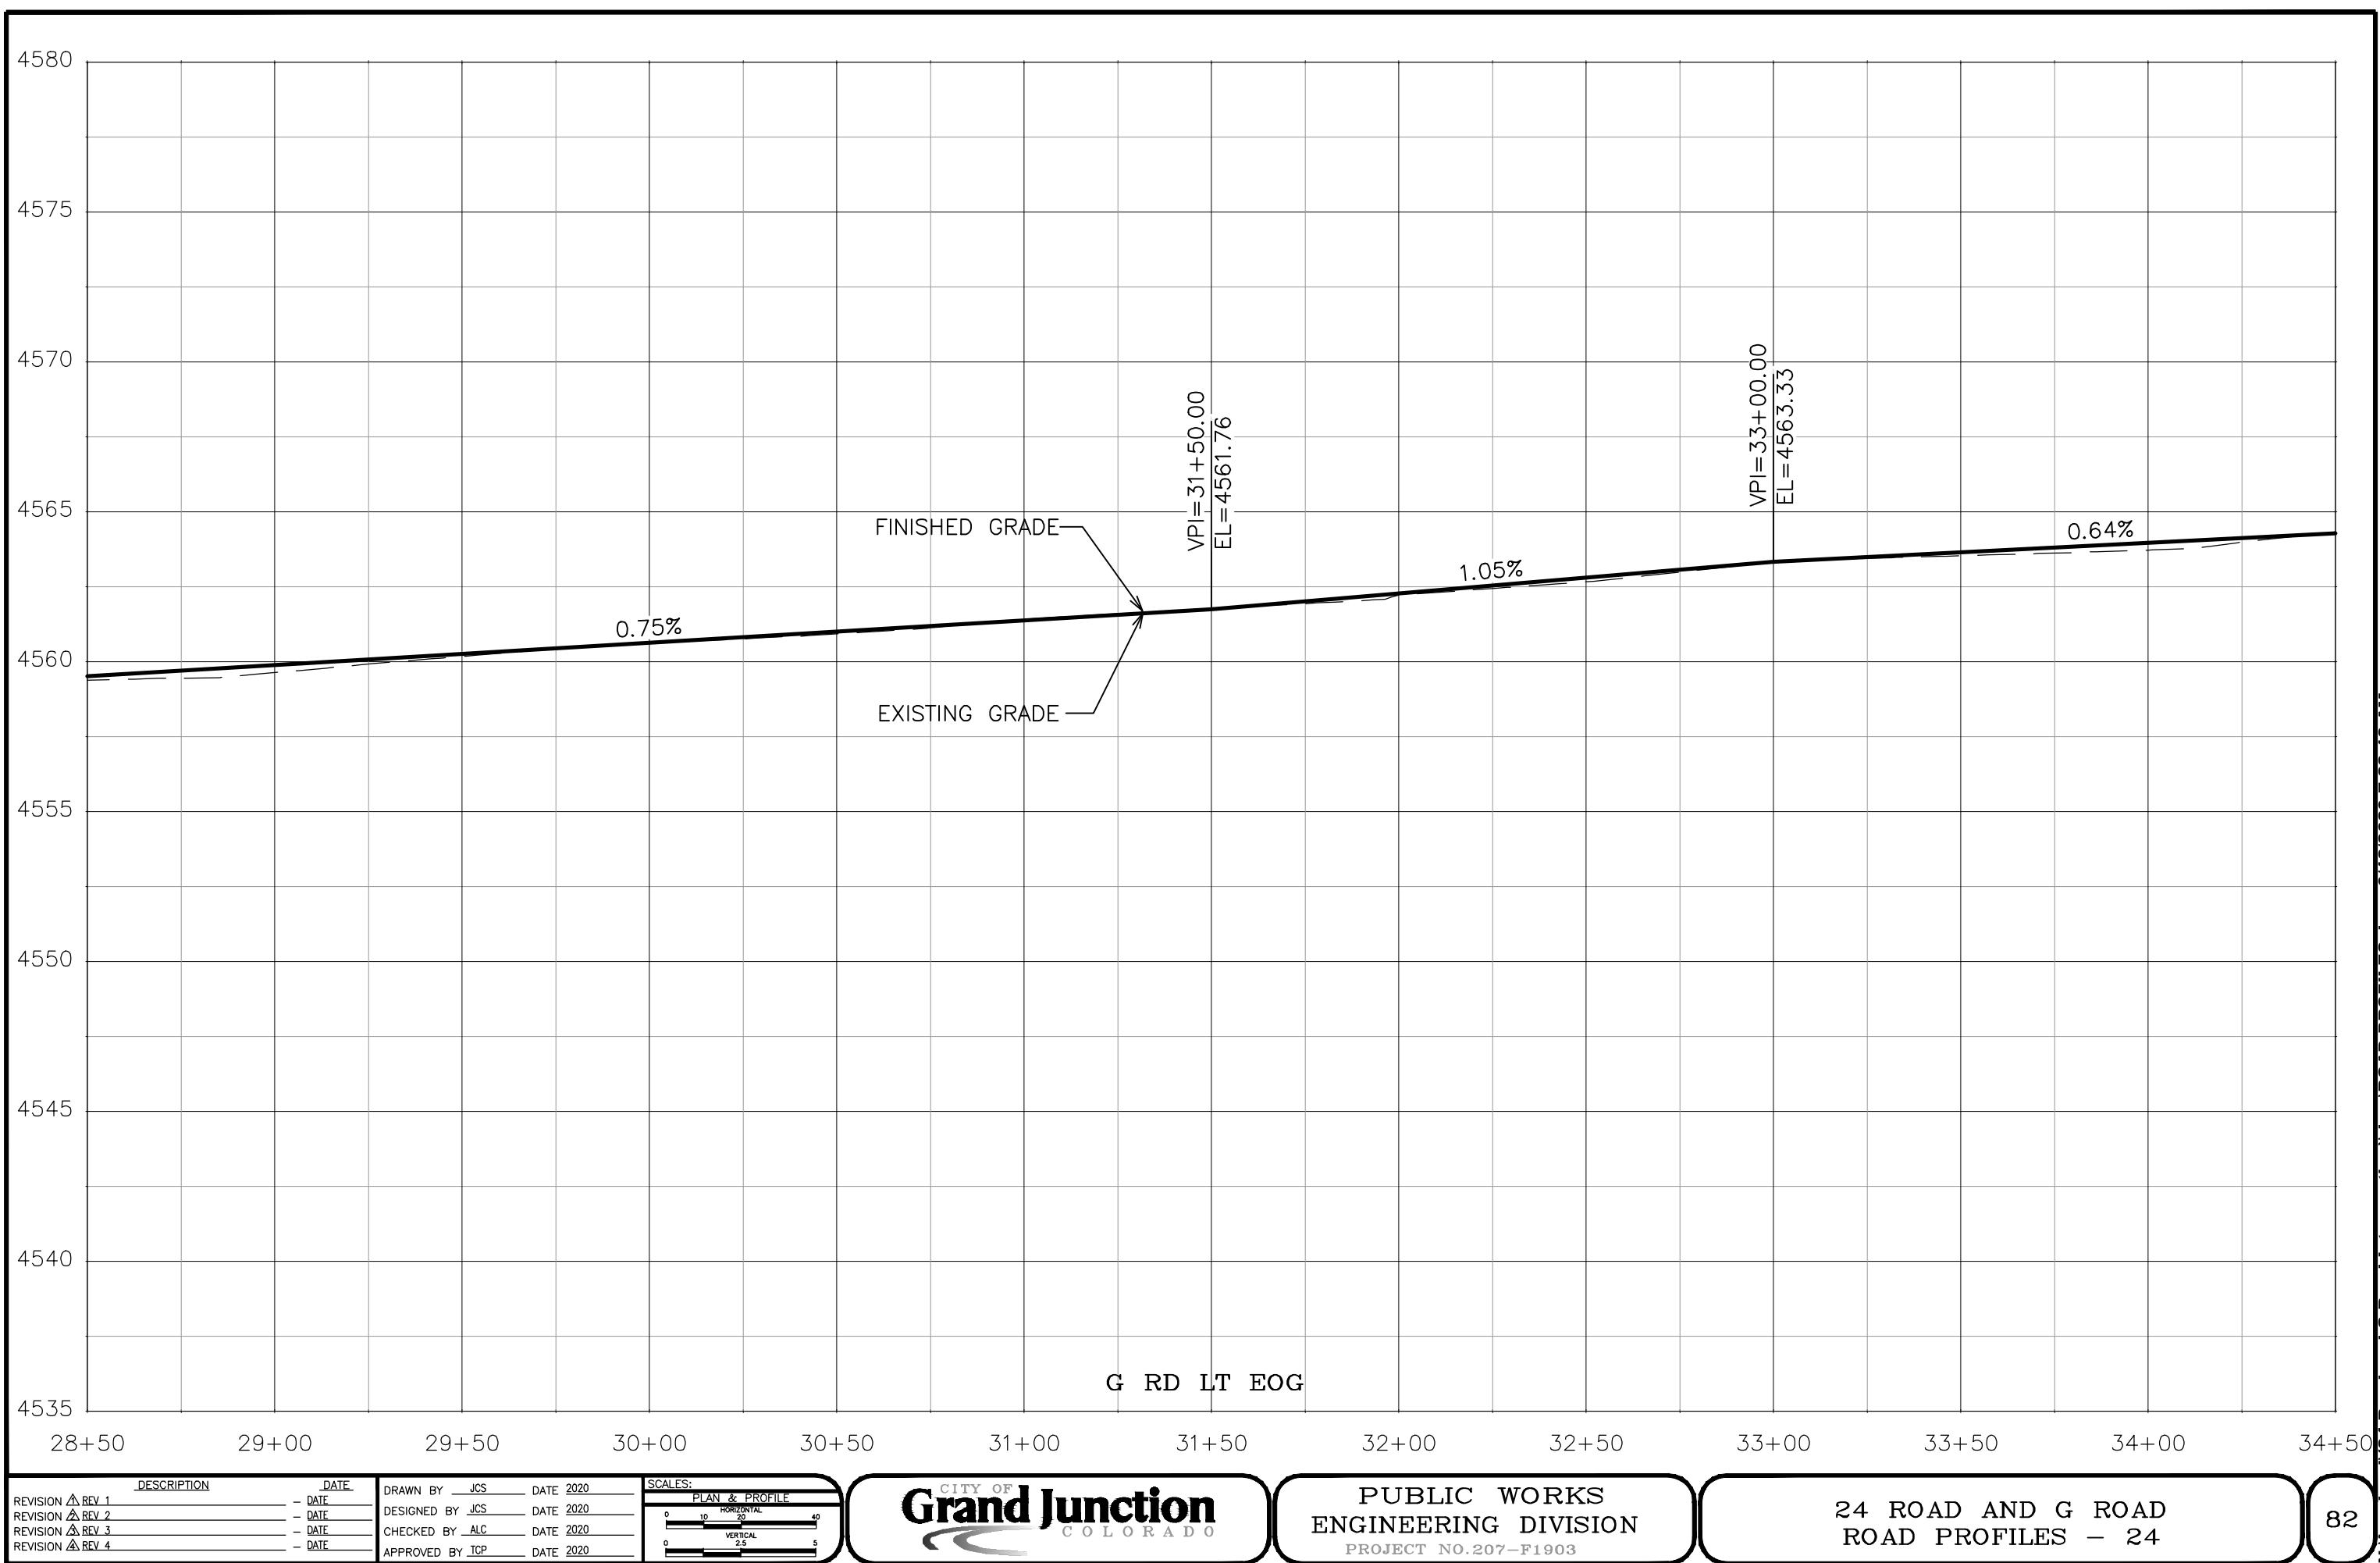

DESCRIPTION	DATE
REVISION ▲ REV 1	- DATE
REVISION ▲ REV 2	- DATE
REVISION ▲ REV 3	- DATE
REVISION ▲ REV 4	- DATE


DRAWN BY	JCS	DATE 2020
DESIGNED BY	JCS	DATE 2020
CHECKED BY	ALC	DATE 2020
APPROVED BY	TCP	DATE 2020

SCALES:	PLAN & PROFILE		
0	10	20	40
HORIZONTAL			
0	2.5	5	
VERTICAL			



PUBLIC WORKS
ENGINEERING DIVISION
PROJECT NO. 207-F1903

24 ROAD AND G ROAD
ROAD PROFILES - 24

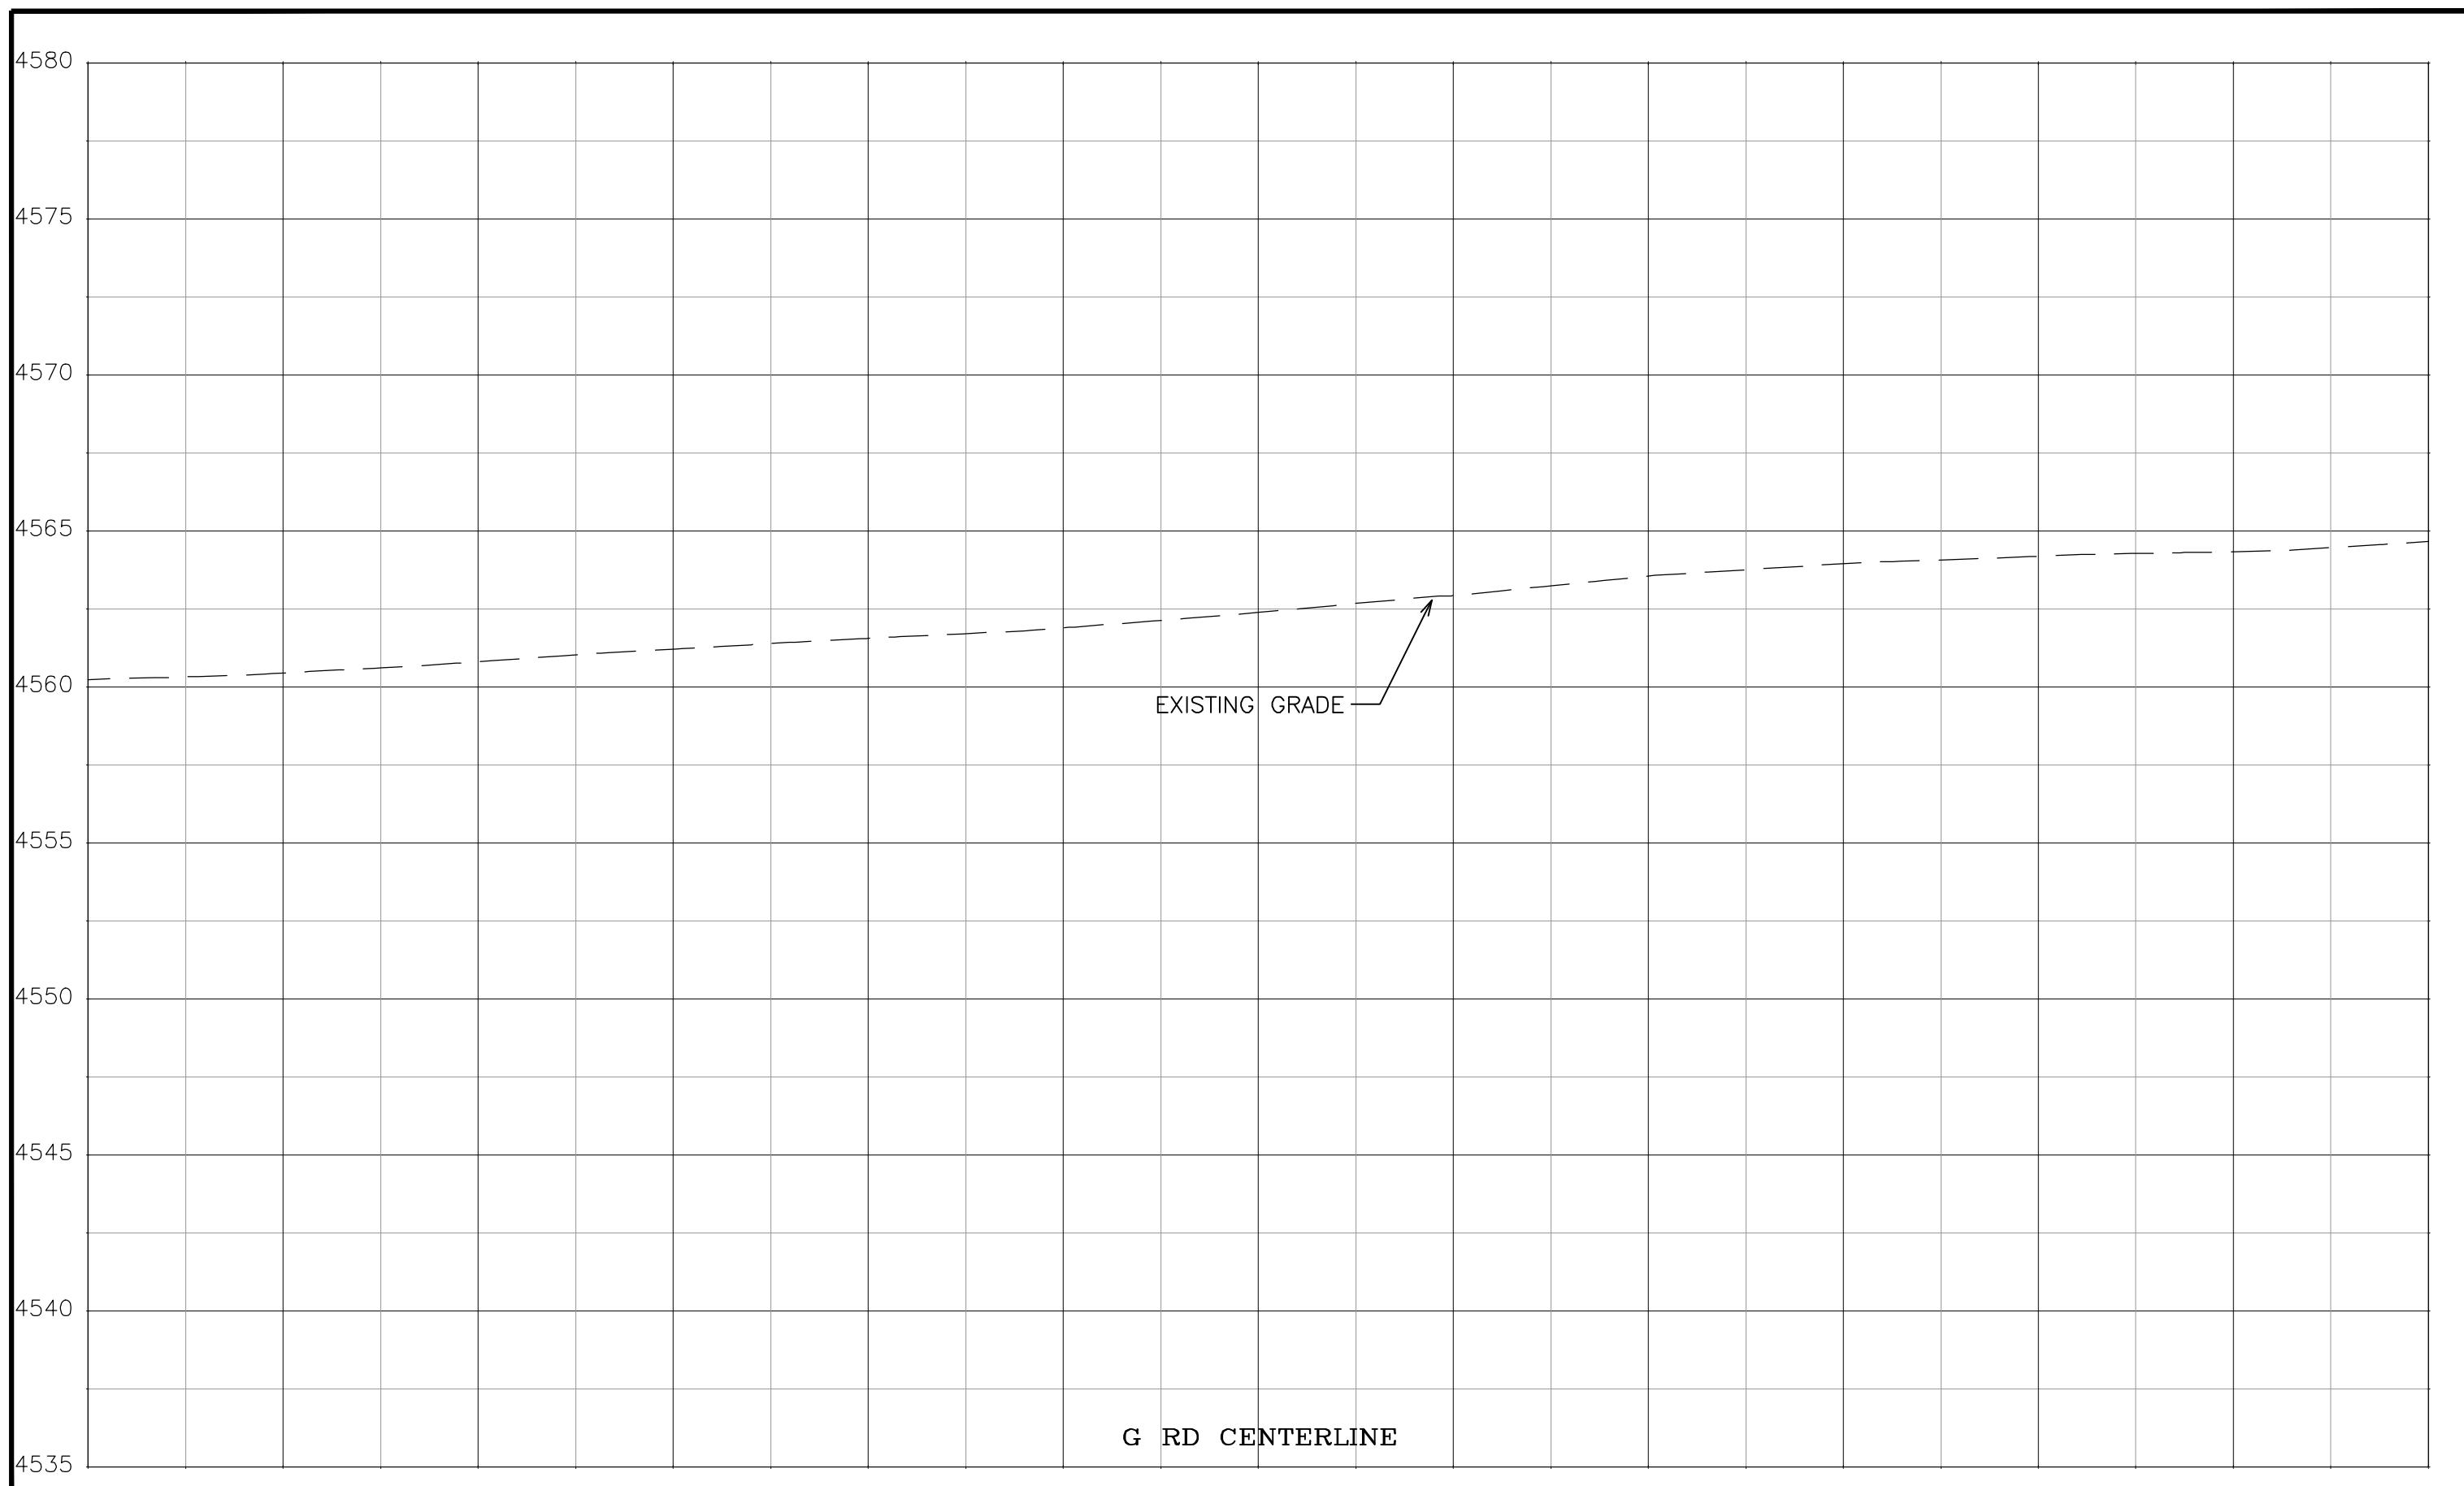

DESCRIPTION		DATE
REVISION ▲ REV 1	- DATE	DRAWN BY JCS DATE 2020
REVISION ▲ REV 2	- DATE	DESIGNED BY JCS DATE 2020
REVISION ▲ REV 3	- DATE	CHECKED BY ALC DATE 2020
REVISION ▲ REV 4	- DATE	APPROVED BY TCP DATE 2020


DESCRIPTION		DATE
REVISION ▲ REV 1	- DATE	DRAWN BY JCS DATE 2020
REVISION ▲ REV 2	- DATE	DESIGNED BY JCS DATE 2020
REVISION ▲ REV 3	- DATE	CHECKED BY ALC DATE 2020
REVISION ▲ REV 4	- DATE	APPROVED BY TCP DATE 2020

SCALES:		
PLAN & PROFILE		
0	10	20
		40
HORIZONTAL		
0	2.5	5
		10
VERTICAL		



PUBLIC WORKS
ENGINEERING DIVISION
PROJECT NO. 207-F1903

24 ROAD AND G ROAD
ROAD PROFILES - 25

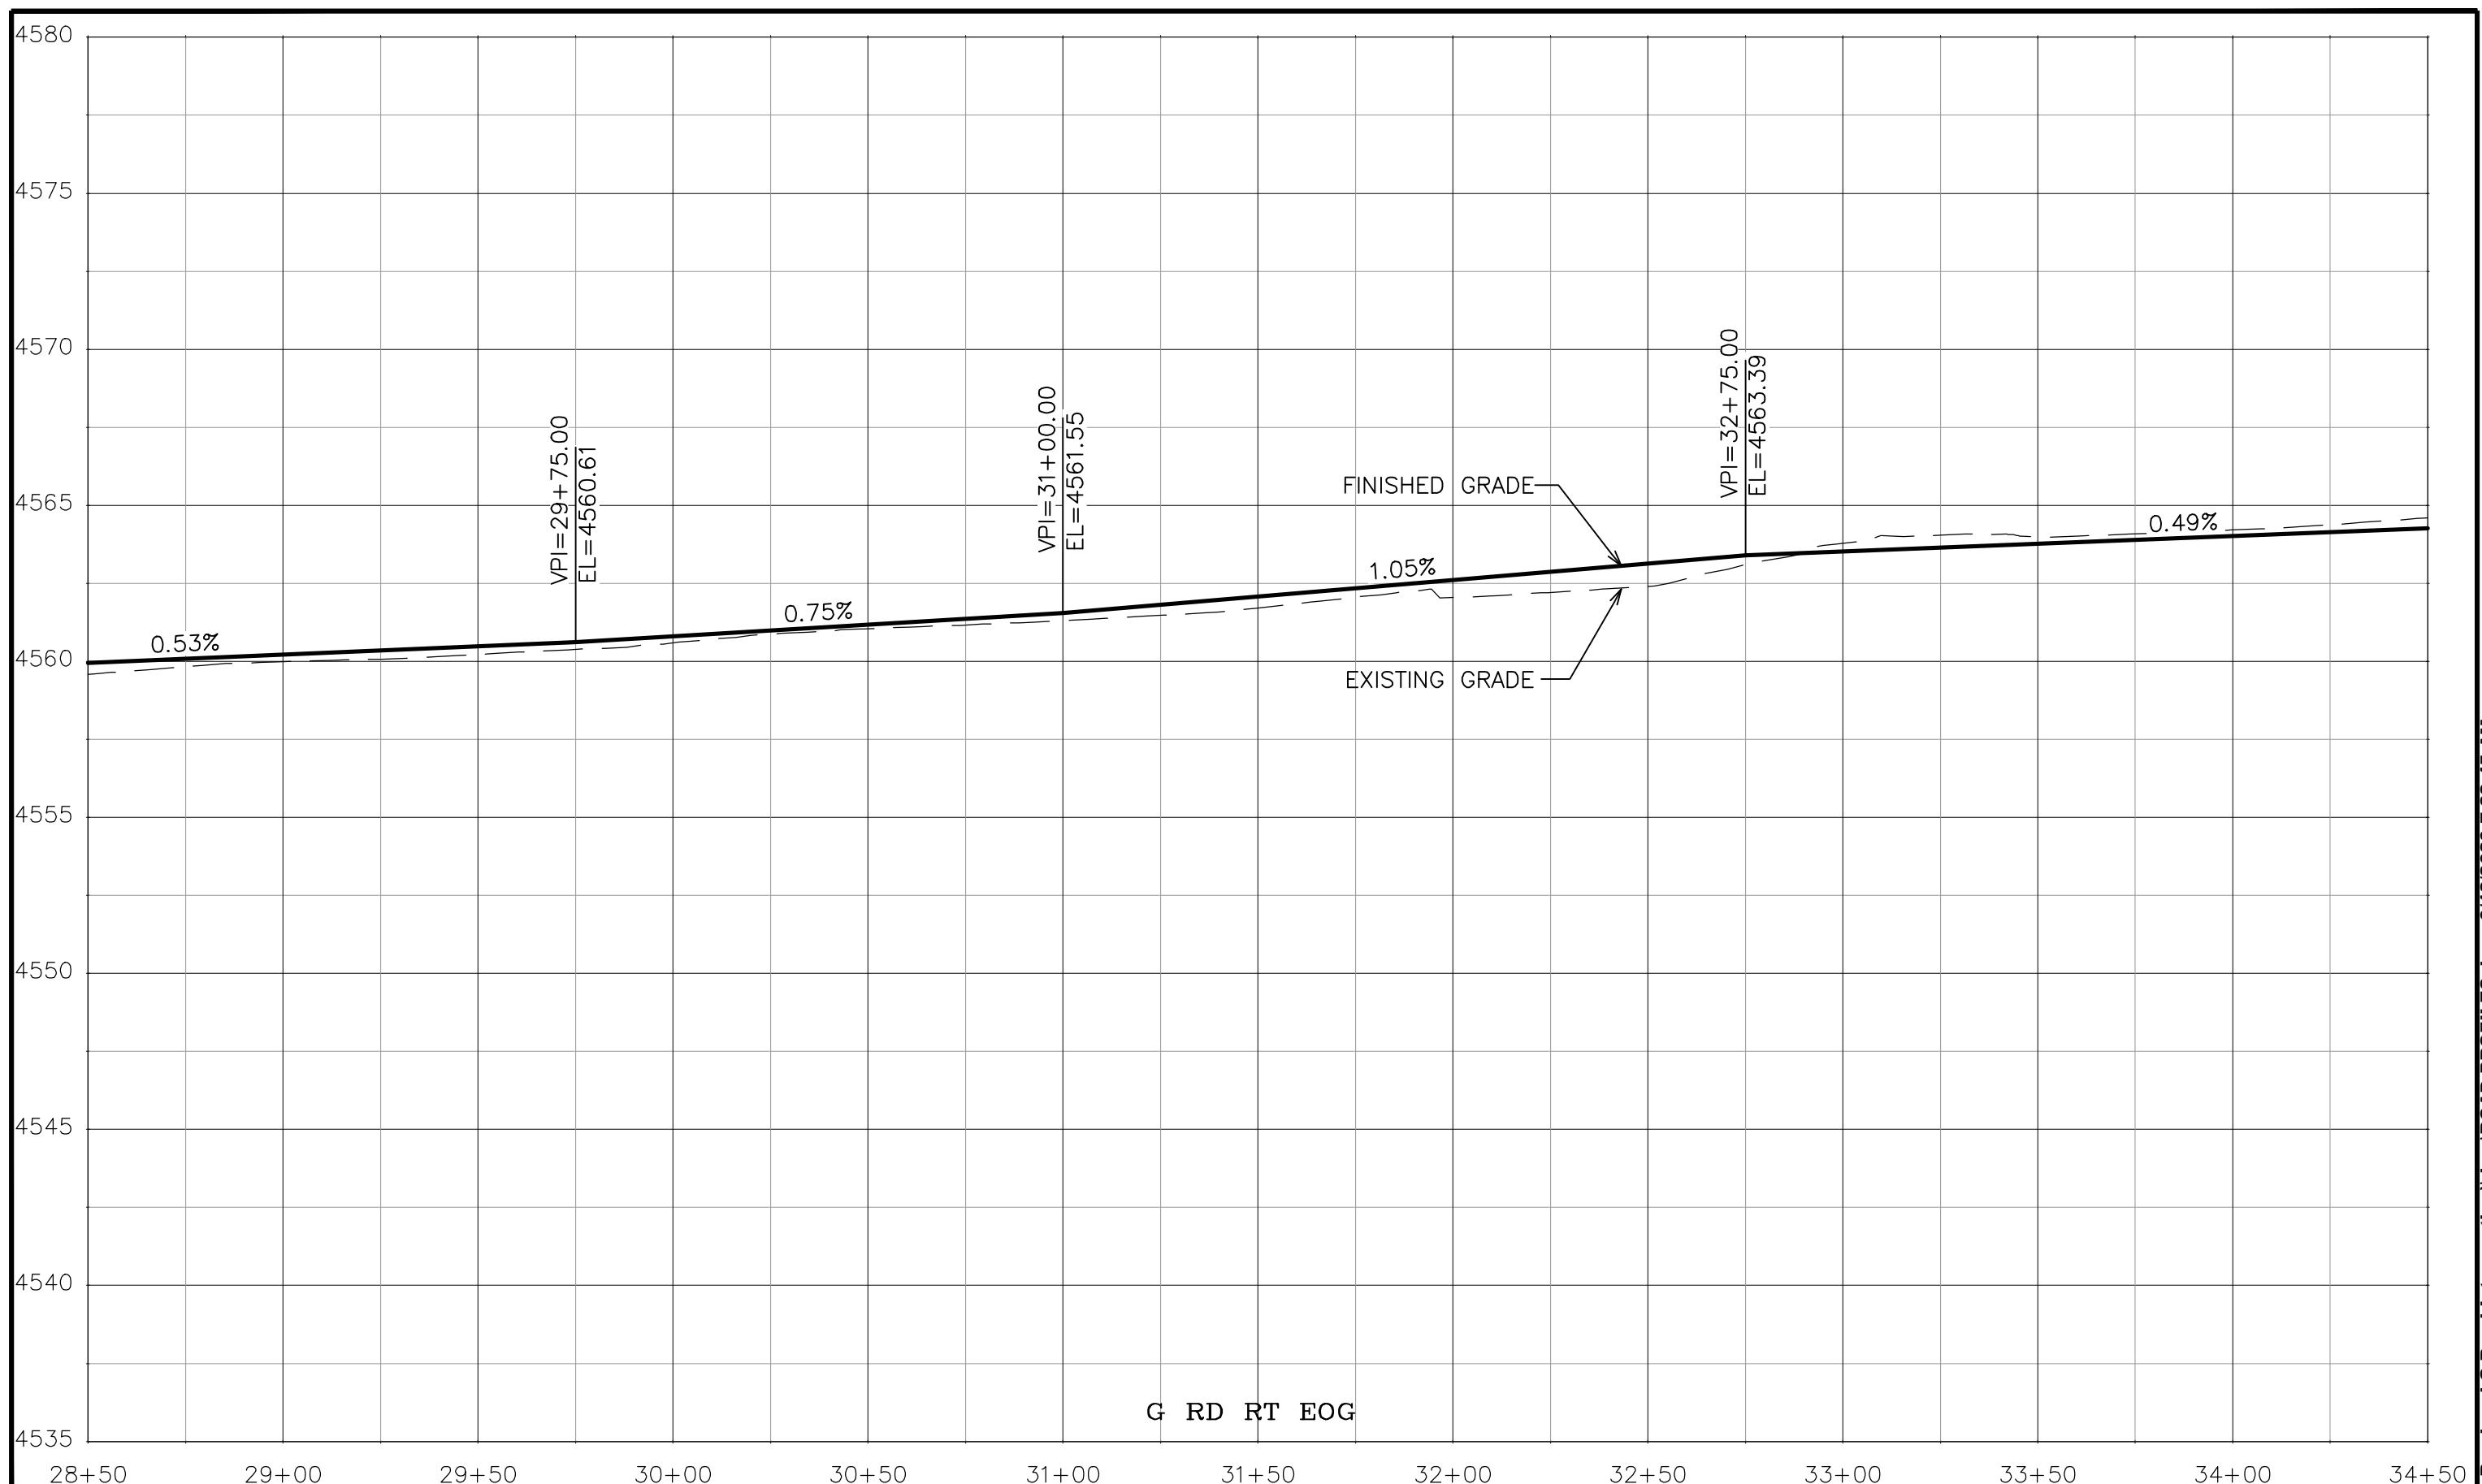

DESCRIPTION	DATE
REVISION ▲ REV 1	- DATE
REVISION ▲ REV 2	- DATE
REVISION ▲ REV 3	- DATE
REVISION ▲ REV 4	- DATE


DRAWN BY JCS	DATE 2020
DESIGNED BY JCS	DATE 2020
CHECKED BY ALC	DATE 2020
APPROVED BY TCP	DATE 2020

SCALES:	
PLAN & PROFILE	
0	10
20	40
HORIZONTAL	
0	2.5
5	
VERTICAL	



PUBLIC WORKS
ENGINEERING DIVISION
PROJECT NO. 207-F1903

24 ROAD AND G ROAD
ROAD PROFILES - 26

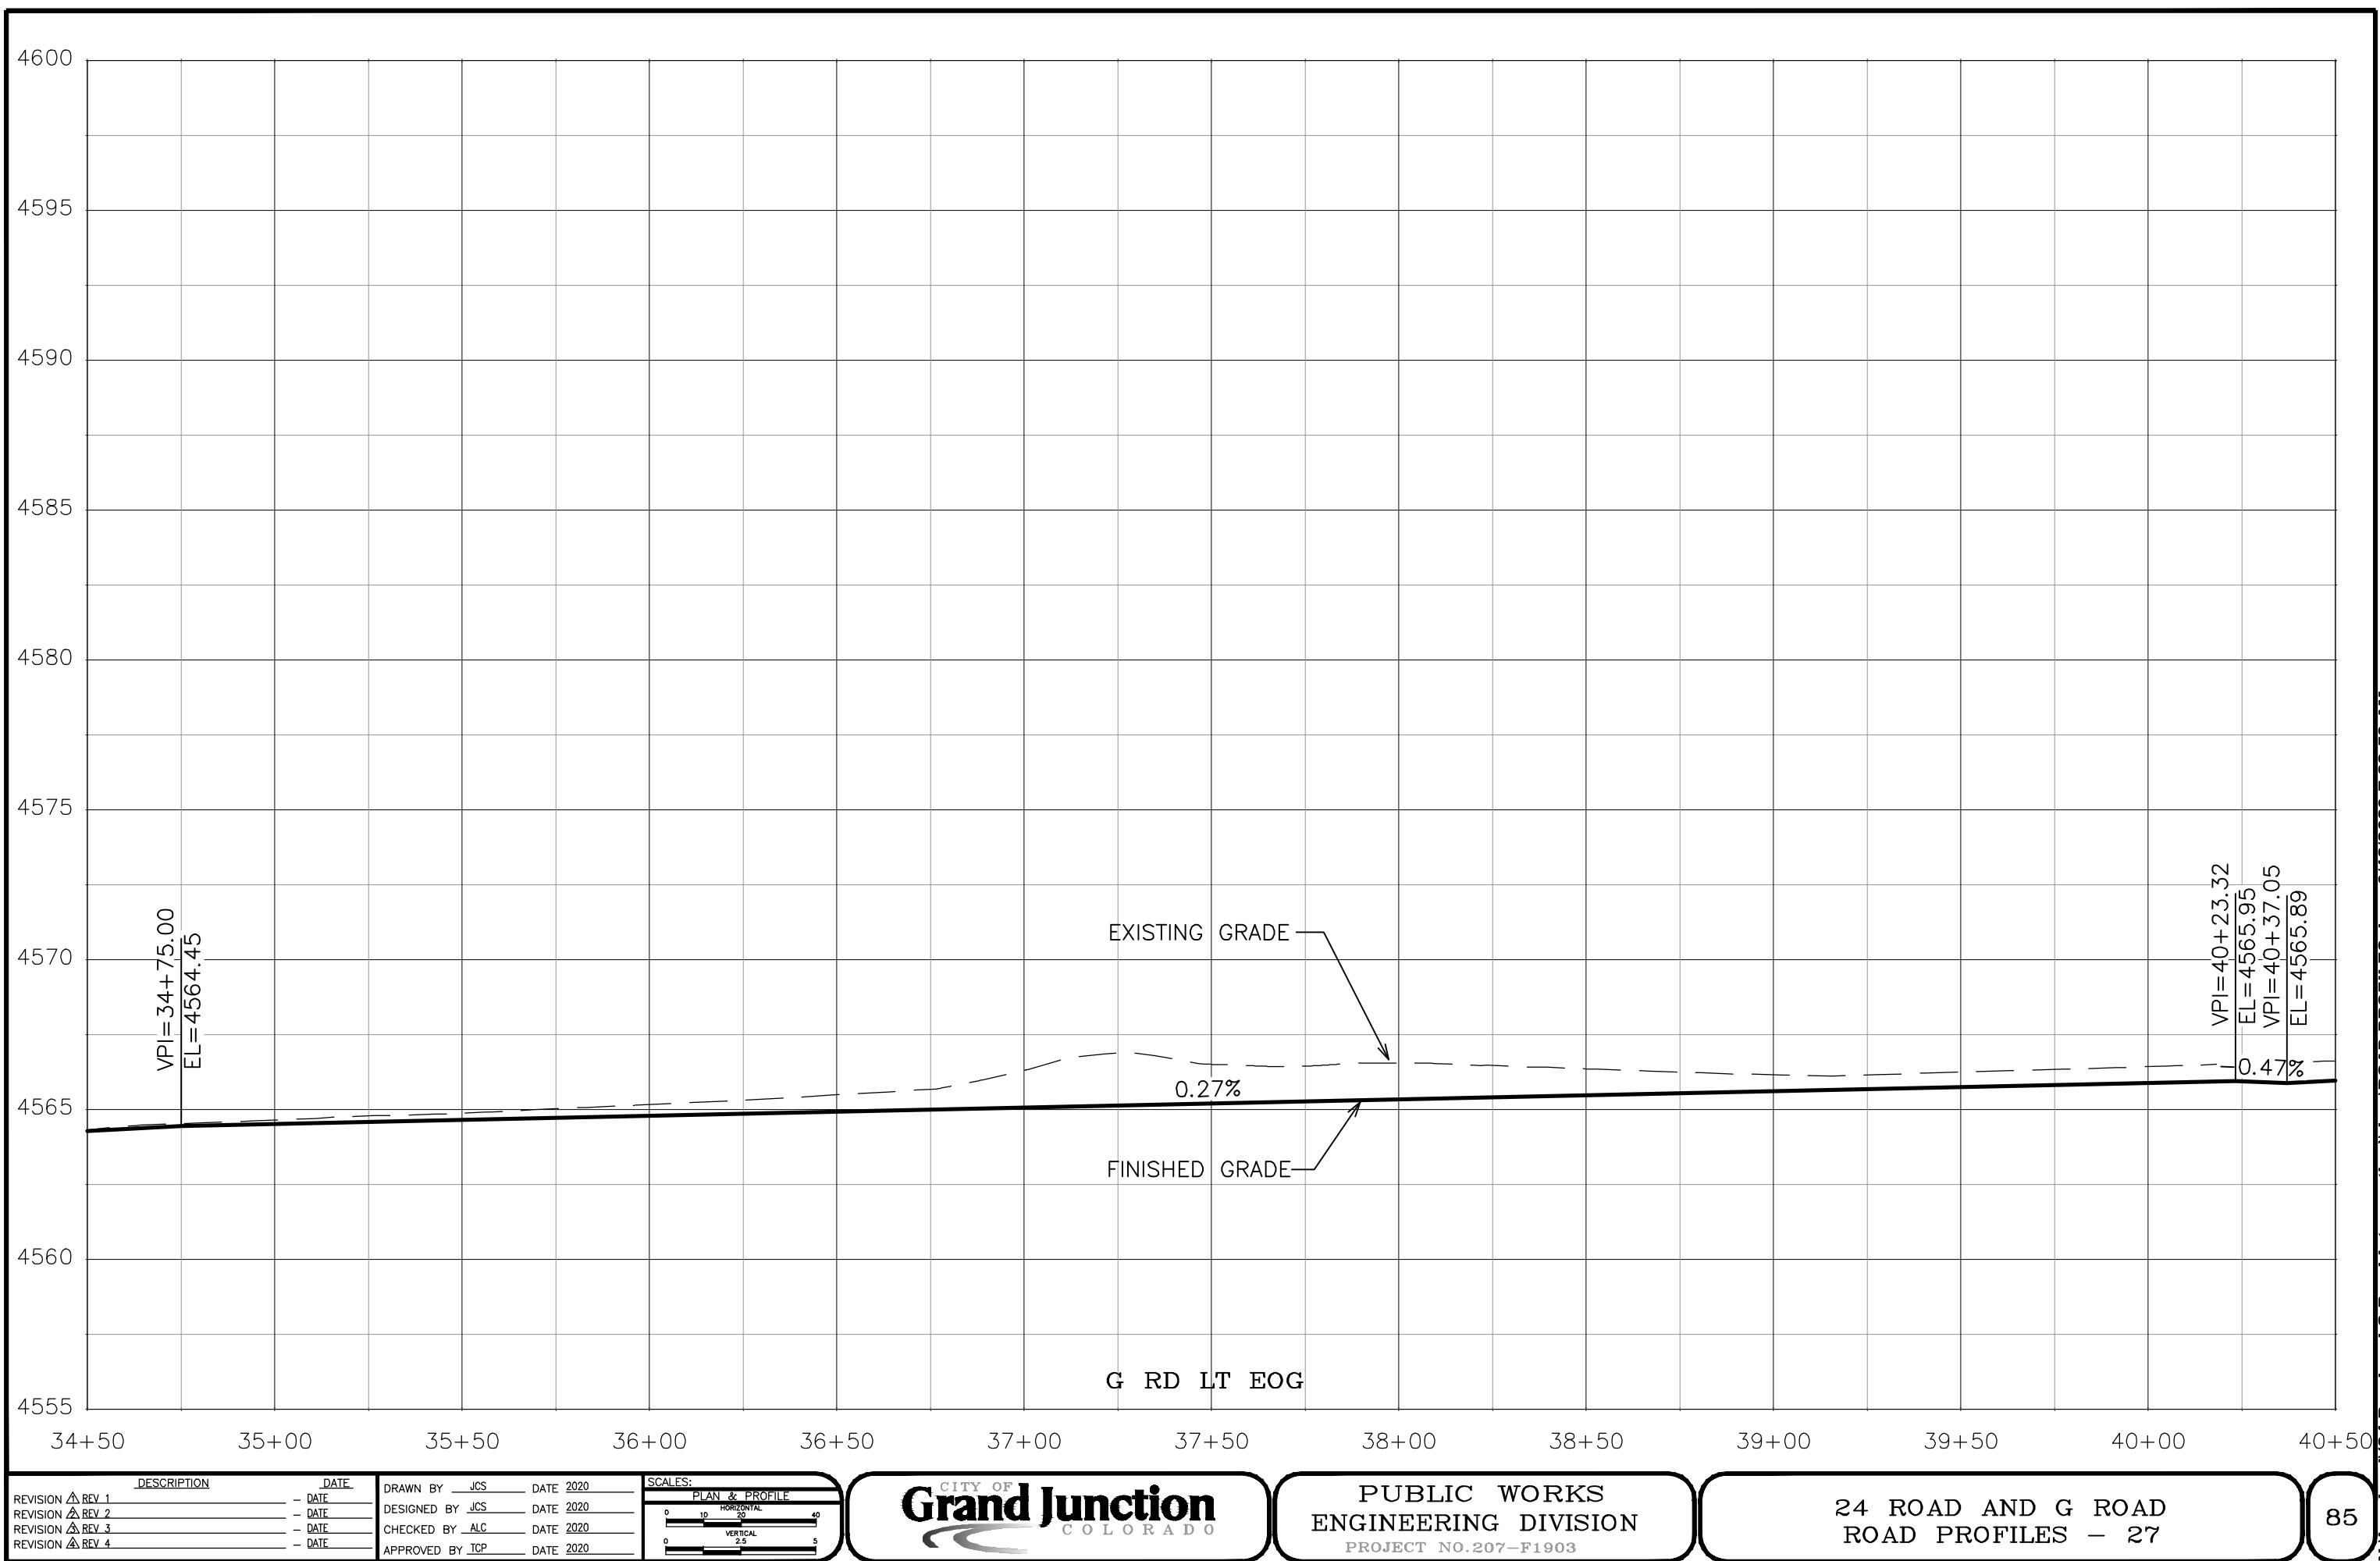

DESCRIPTION	DATE
REVISION ▲ REV 1	- DATE
REVISION ▲ REV 2	- DATE
REVISION ▲ REV 3	- DATE
REVISION ▲ REV 4	- DATE


DRAWN BY	JCS	DATE 2020
DESIGNED BY	JCS	DATE 2020
CHECKED BY	ALC	DATE 2020
APPROVED BY	TCP	DATE 2020

SCALES:	PLAN & PROFILE		
0	10	20	40
	HORIZONTAL		
0	2.5	5	
	VERTICAL		



PUBLIC WORKS
 ENGINEERING DIVISION
 PROJECT NO. 207-F1903

24 ROAD AND G ROAD
 ROAD PROFILES - 27

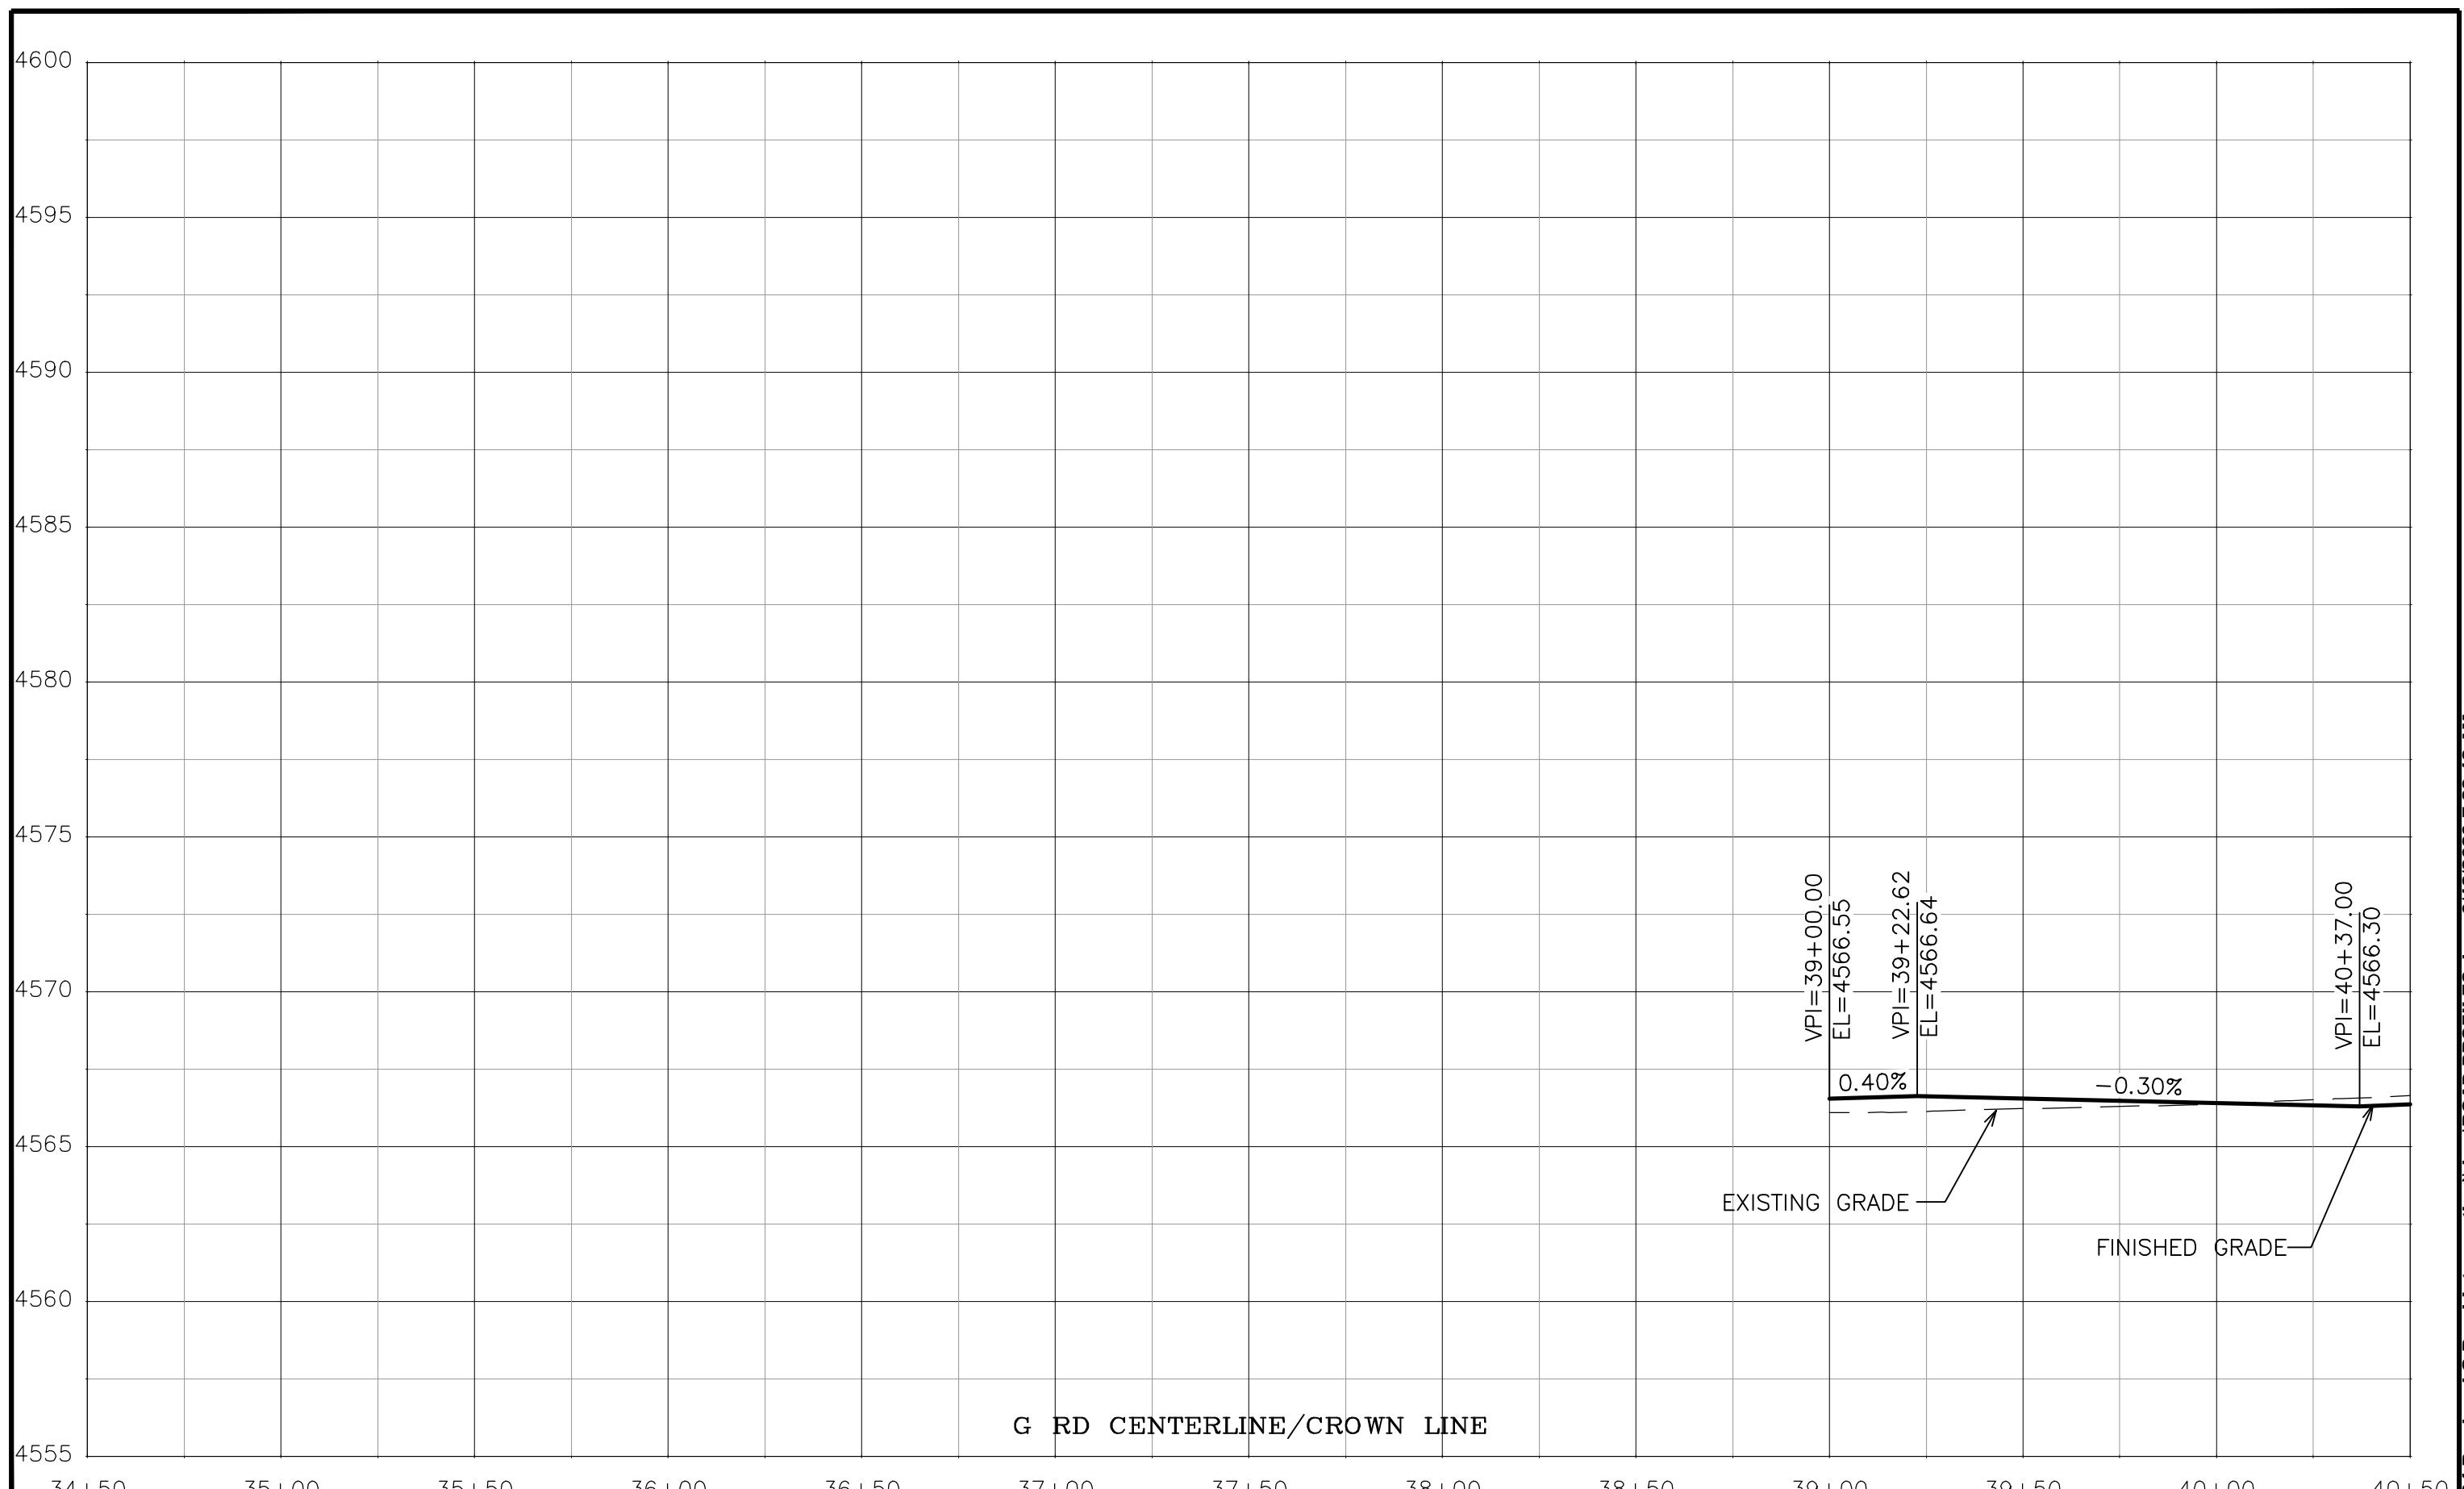

DESCRIPTION DATE
REVISION ▲ REV 1 - DATE
REVISION ▲ REV 2 - DATE
REVISION ▲ REV 3 - DATE
REVISION ▲ REV 4 - DATE


DRAWN BY JCS DATE 2020
DESIGNED BY JCS DATE 2020
CHECKED BY ALC DATE 2020
APPROVED BY TCP DATE 2020

SCALES:
PLAN & PROFILE
0 10 20 40
HORIZONTAL
0 2.5 5
VERTICAL



PUBLIC WORKS
ENGINEERING DIVISION
PROJECT NO. 207-F1903

24 ROAD AND G ROAD
ROAD PROFILES — 28

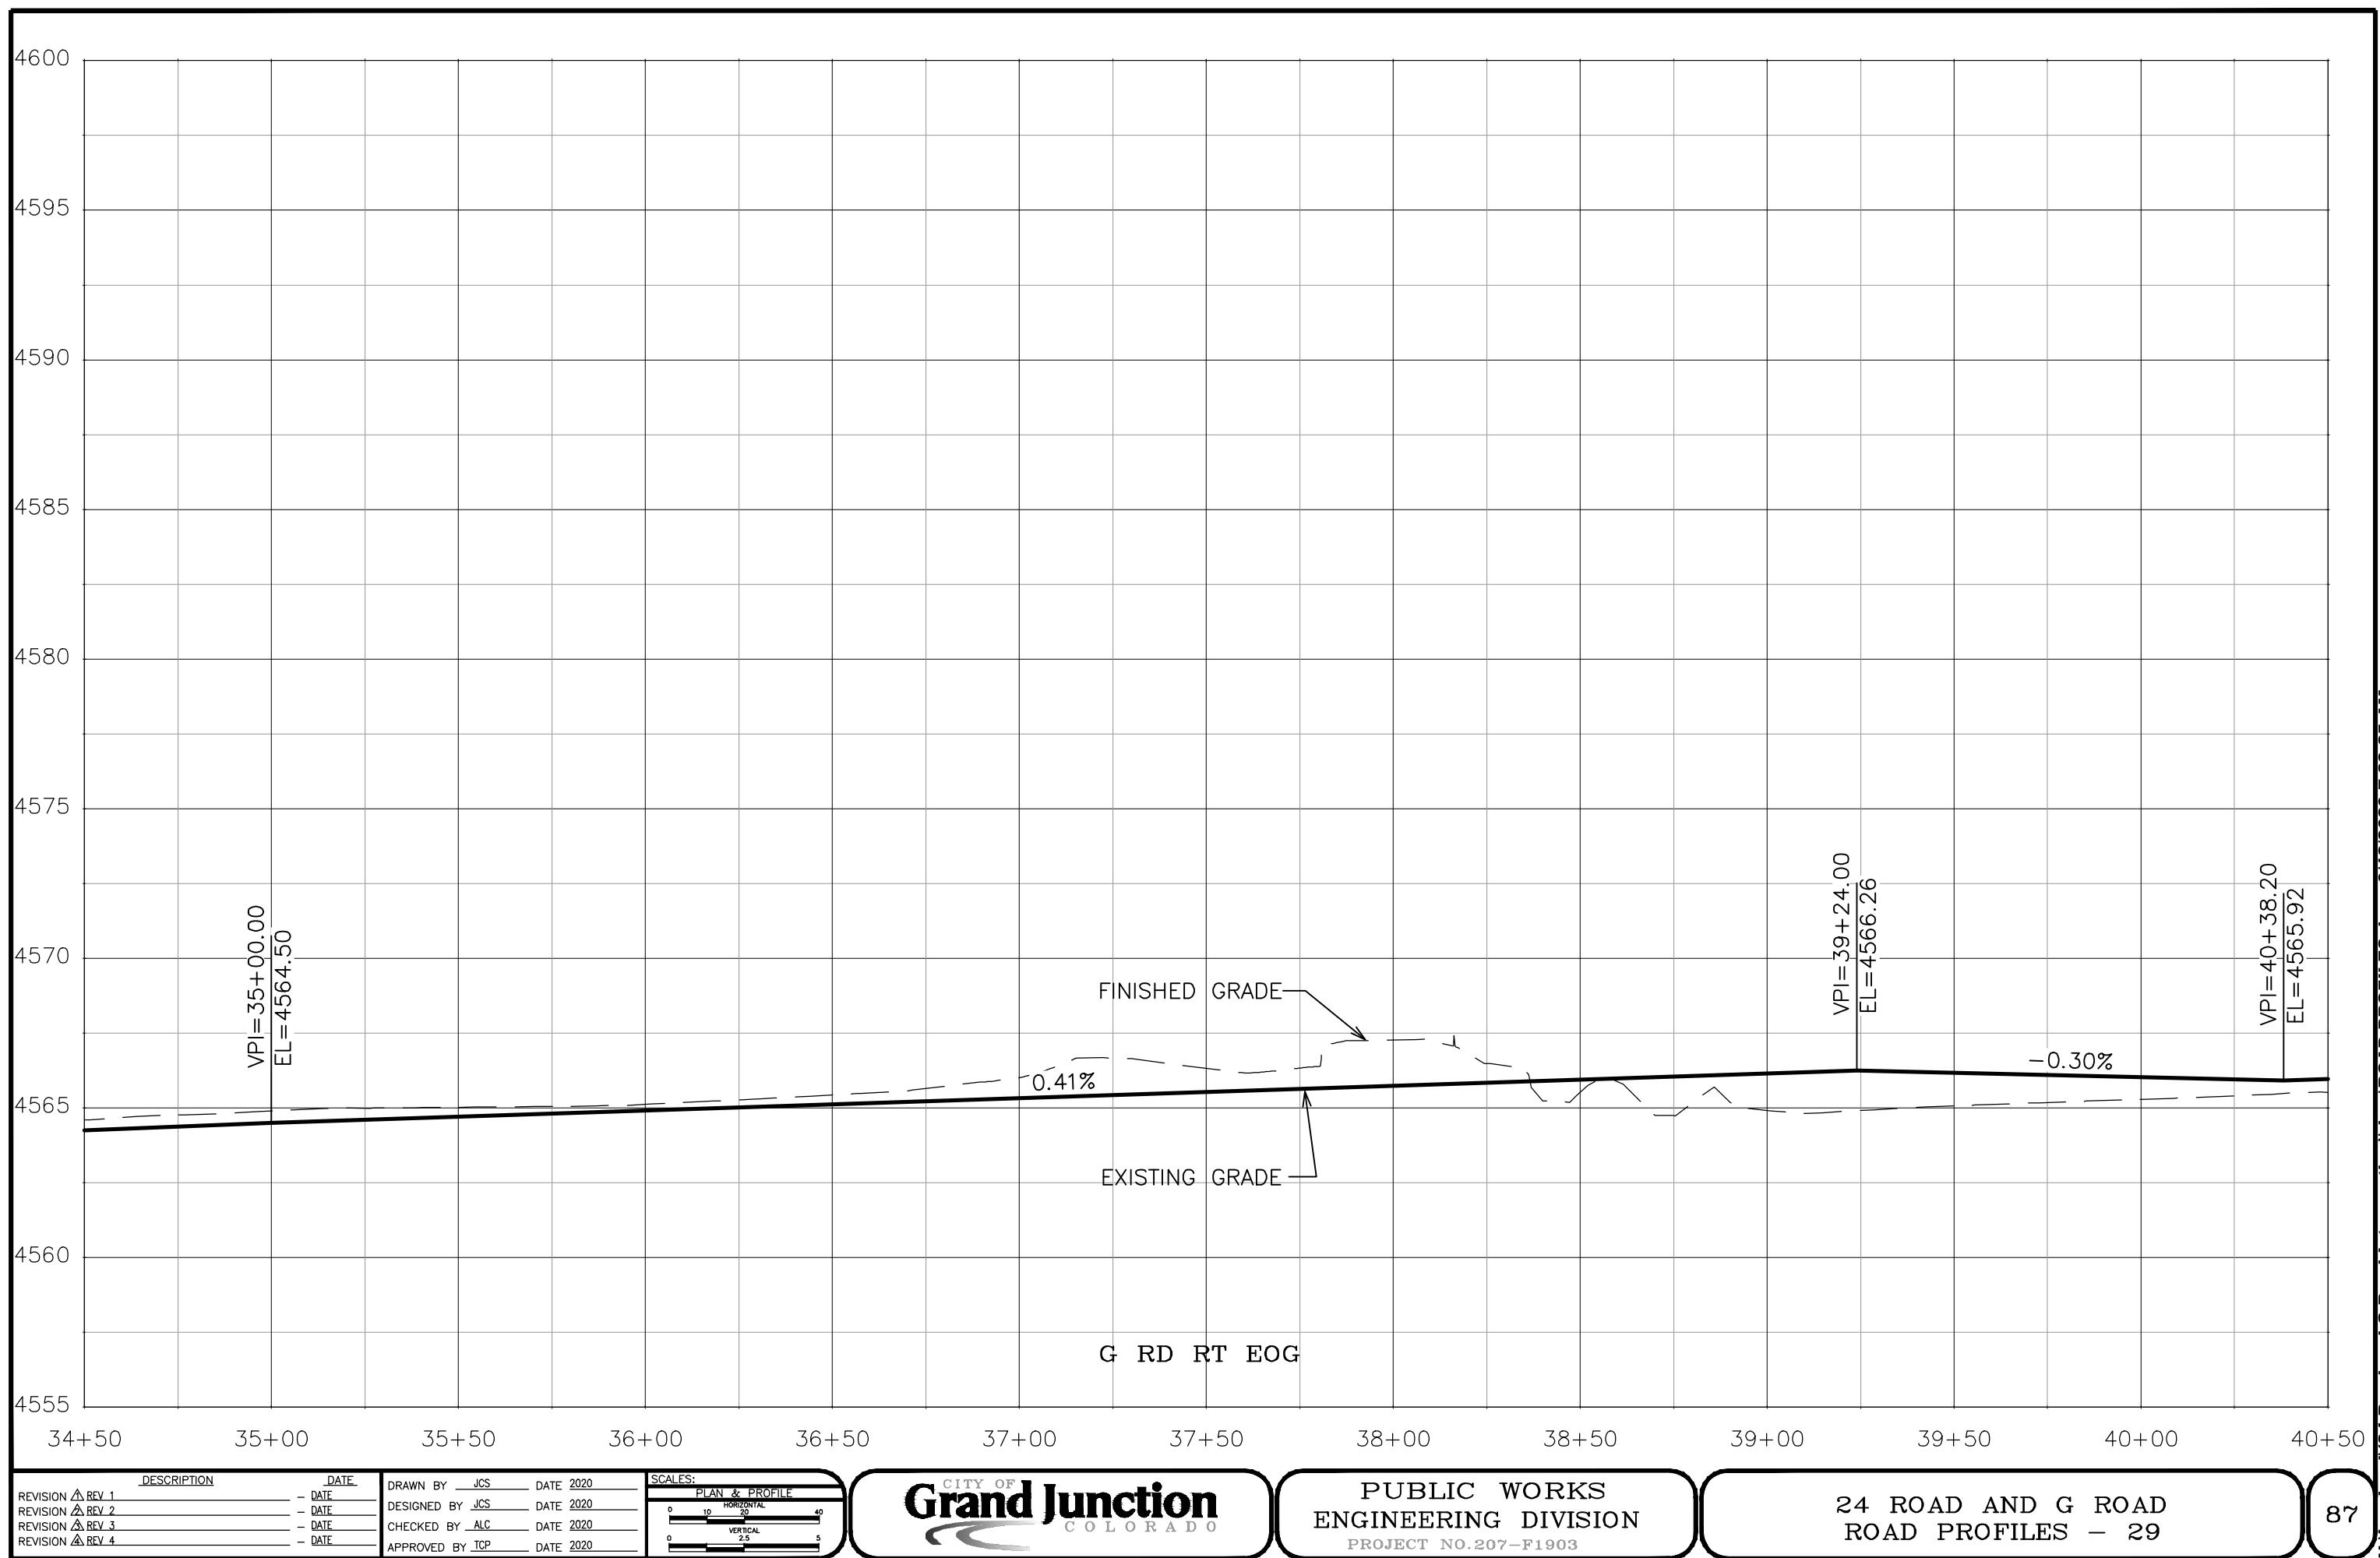

DESCRIPTION	DATE
REVISION ▲ REV 1	- DATE
REVISION ▲ REV 2	- DATE
REVISION ▲ REV 3	- DATE
REVISION ▲ REV 4	- DATE


DRAWN BY	JCS	DATE 2020
DESIGNED BY	JCS	DATE 2020
CHECKED BY	ALC	DATE 2020
APPROVED BY	TCP	DATE 2020


SCALES:		
PLAN & PROFILE		
0	10	20
HORIZONTAL		
0	2.5	5
VERTICAL		



PUBLIC WORKS
 ENGINEERING DIVISION
 PROJECT NO. 207-F1903

24 ROAD AND G ROAD
 ROAD PROFILES - 29

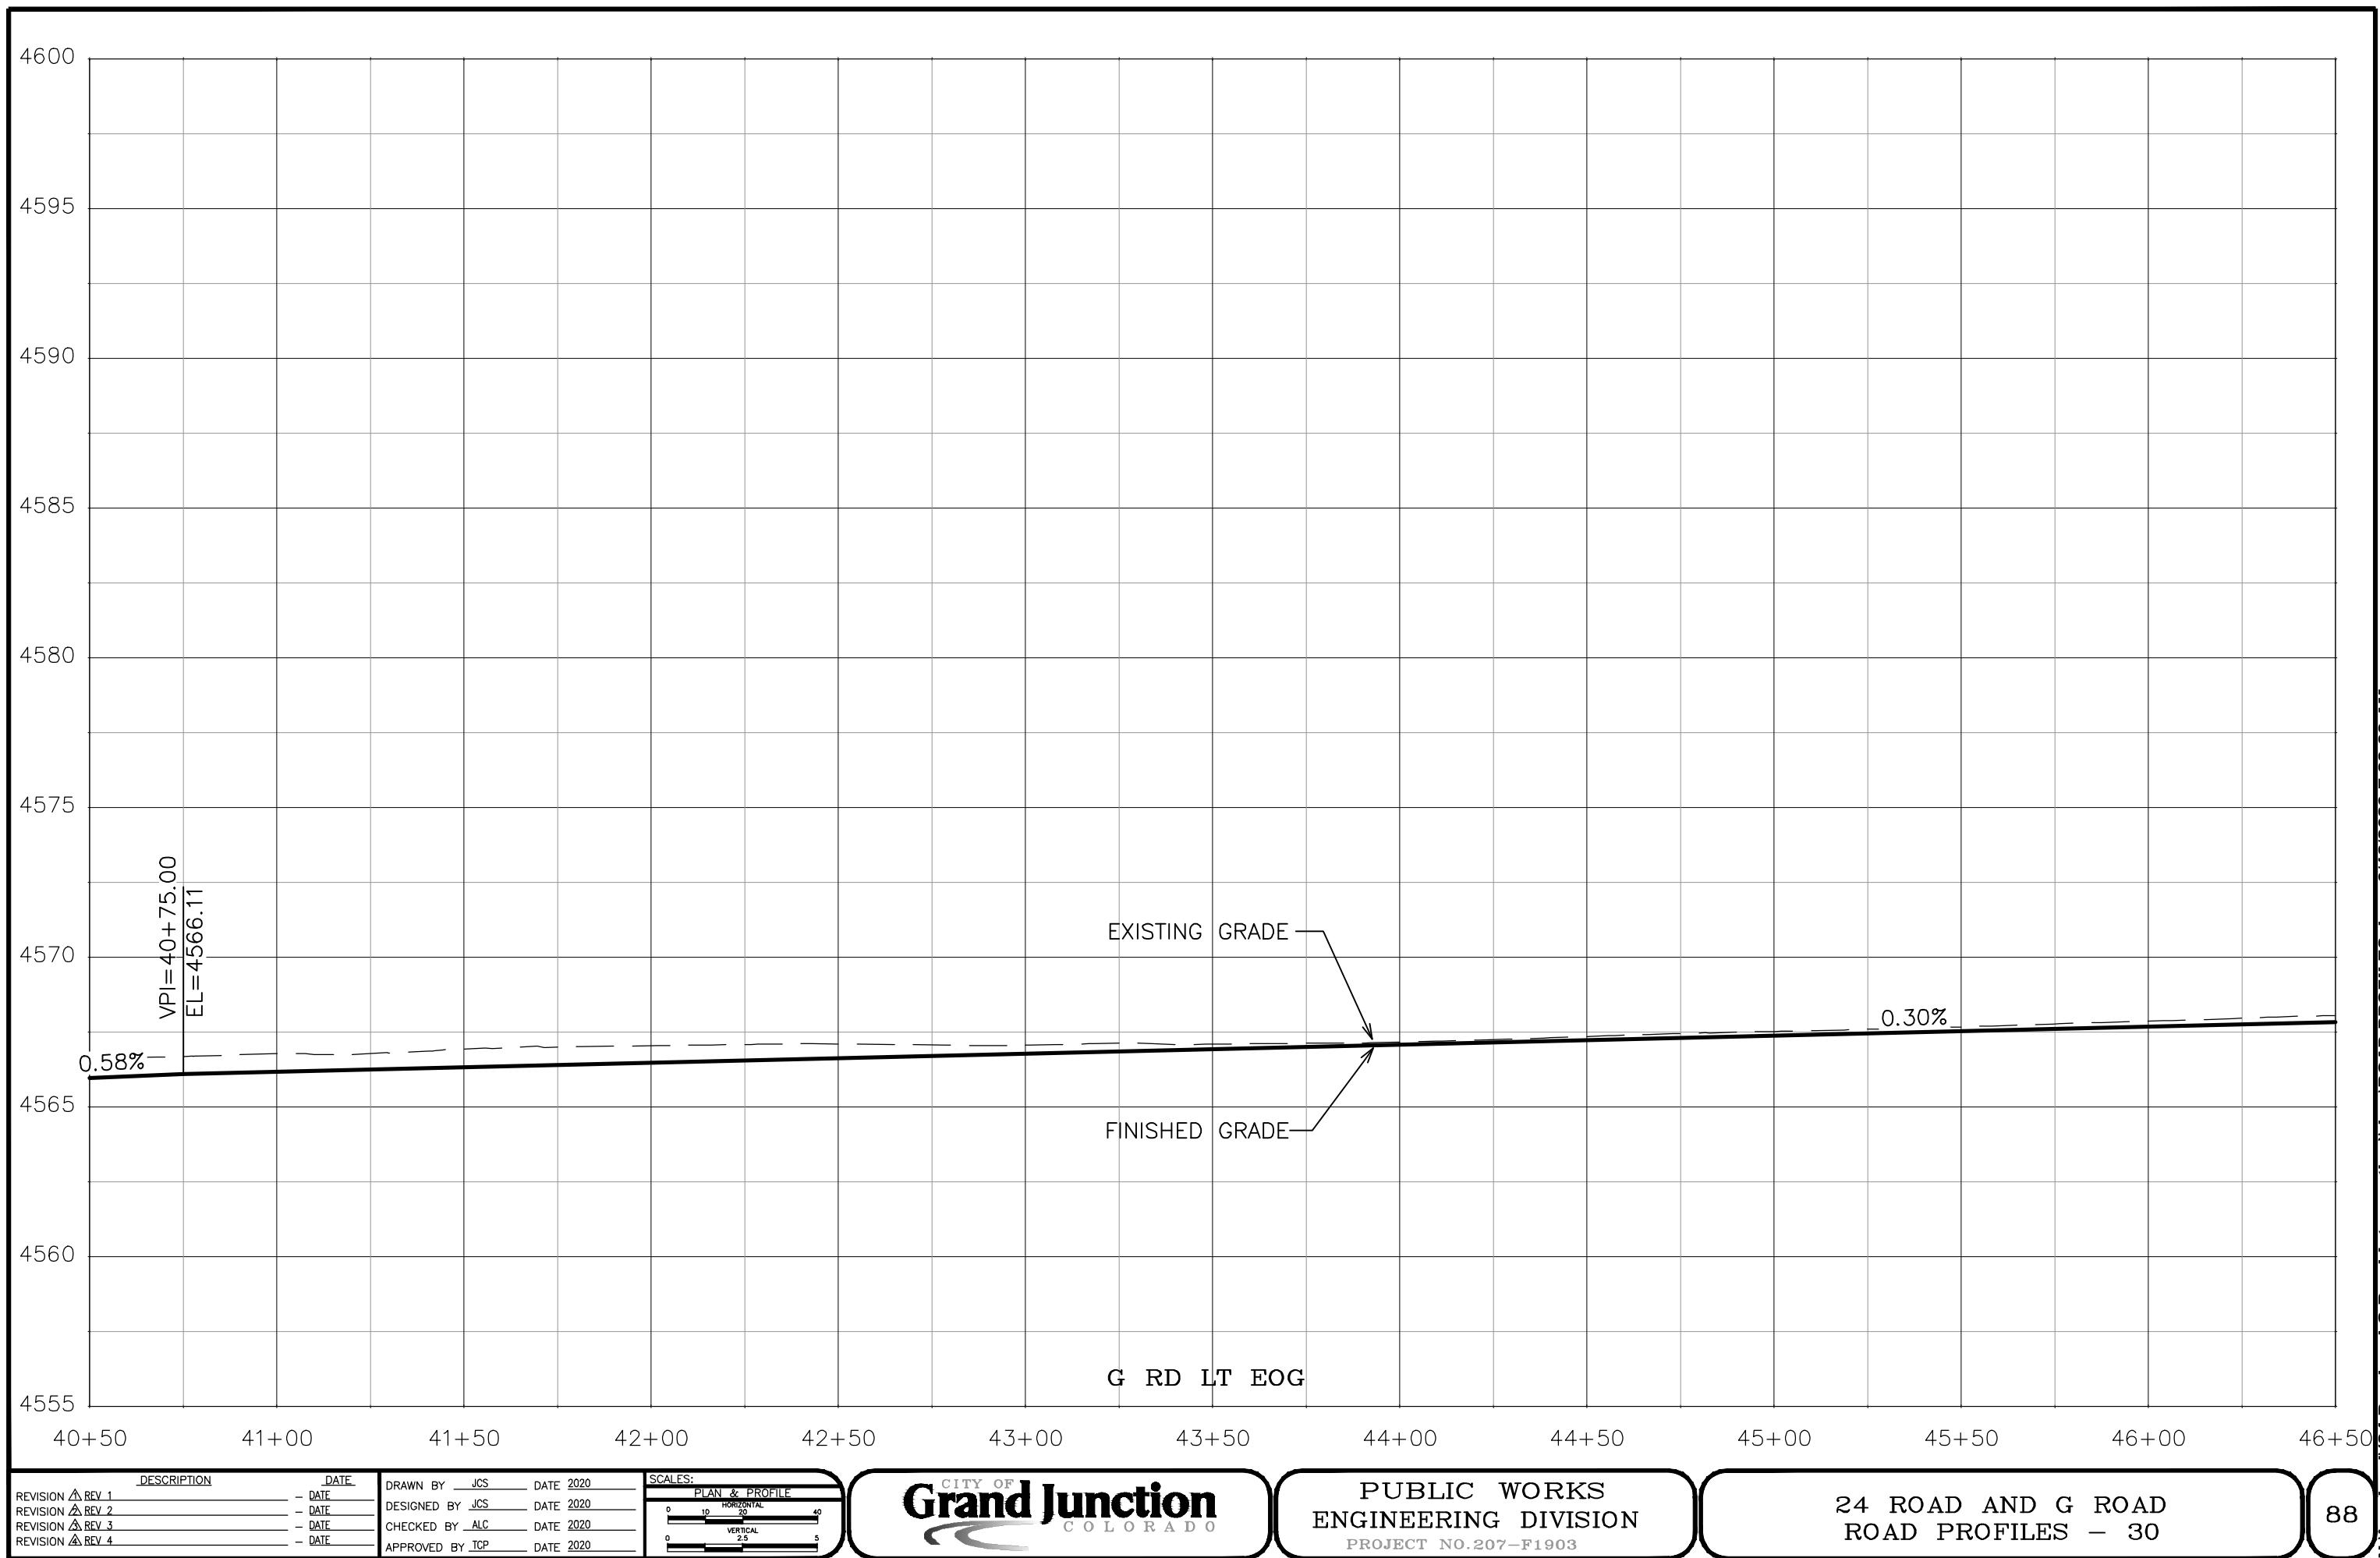

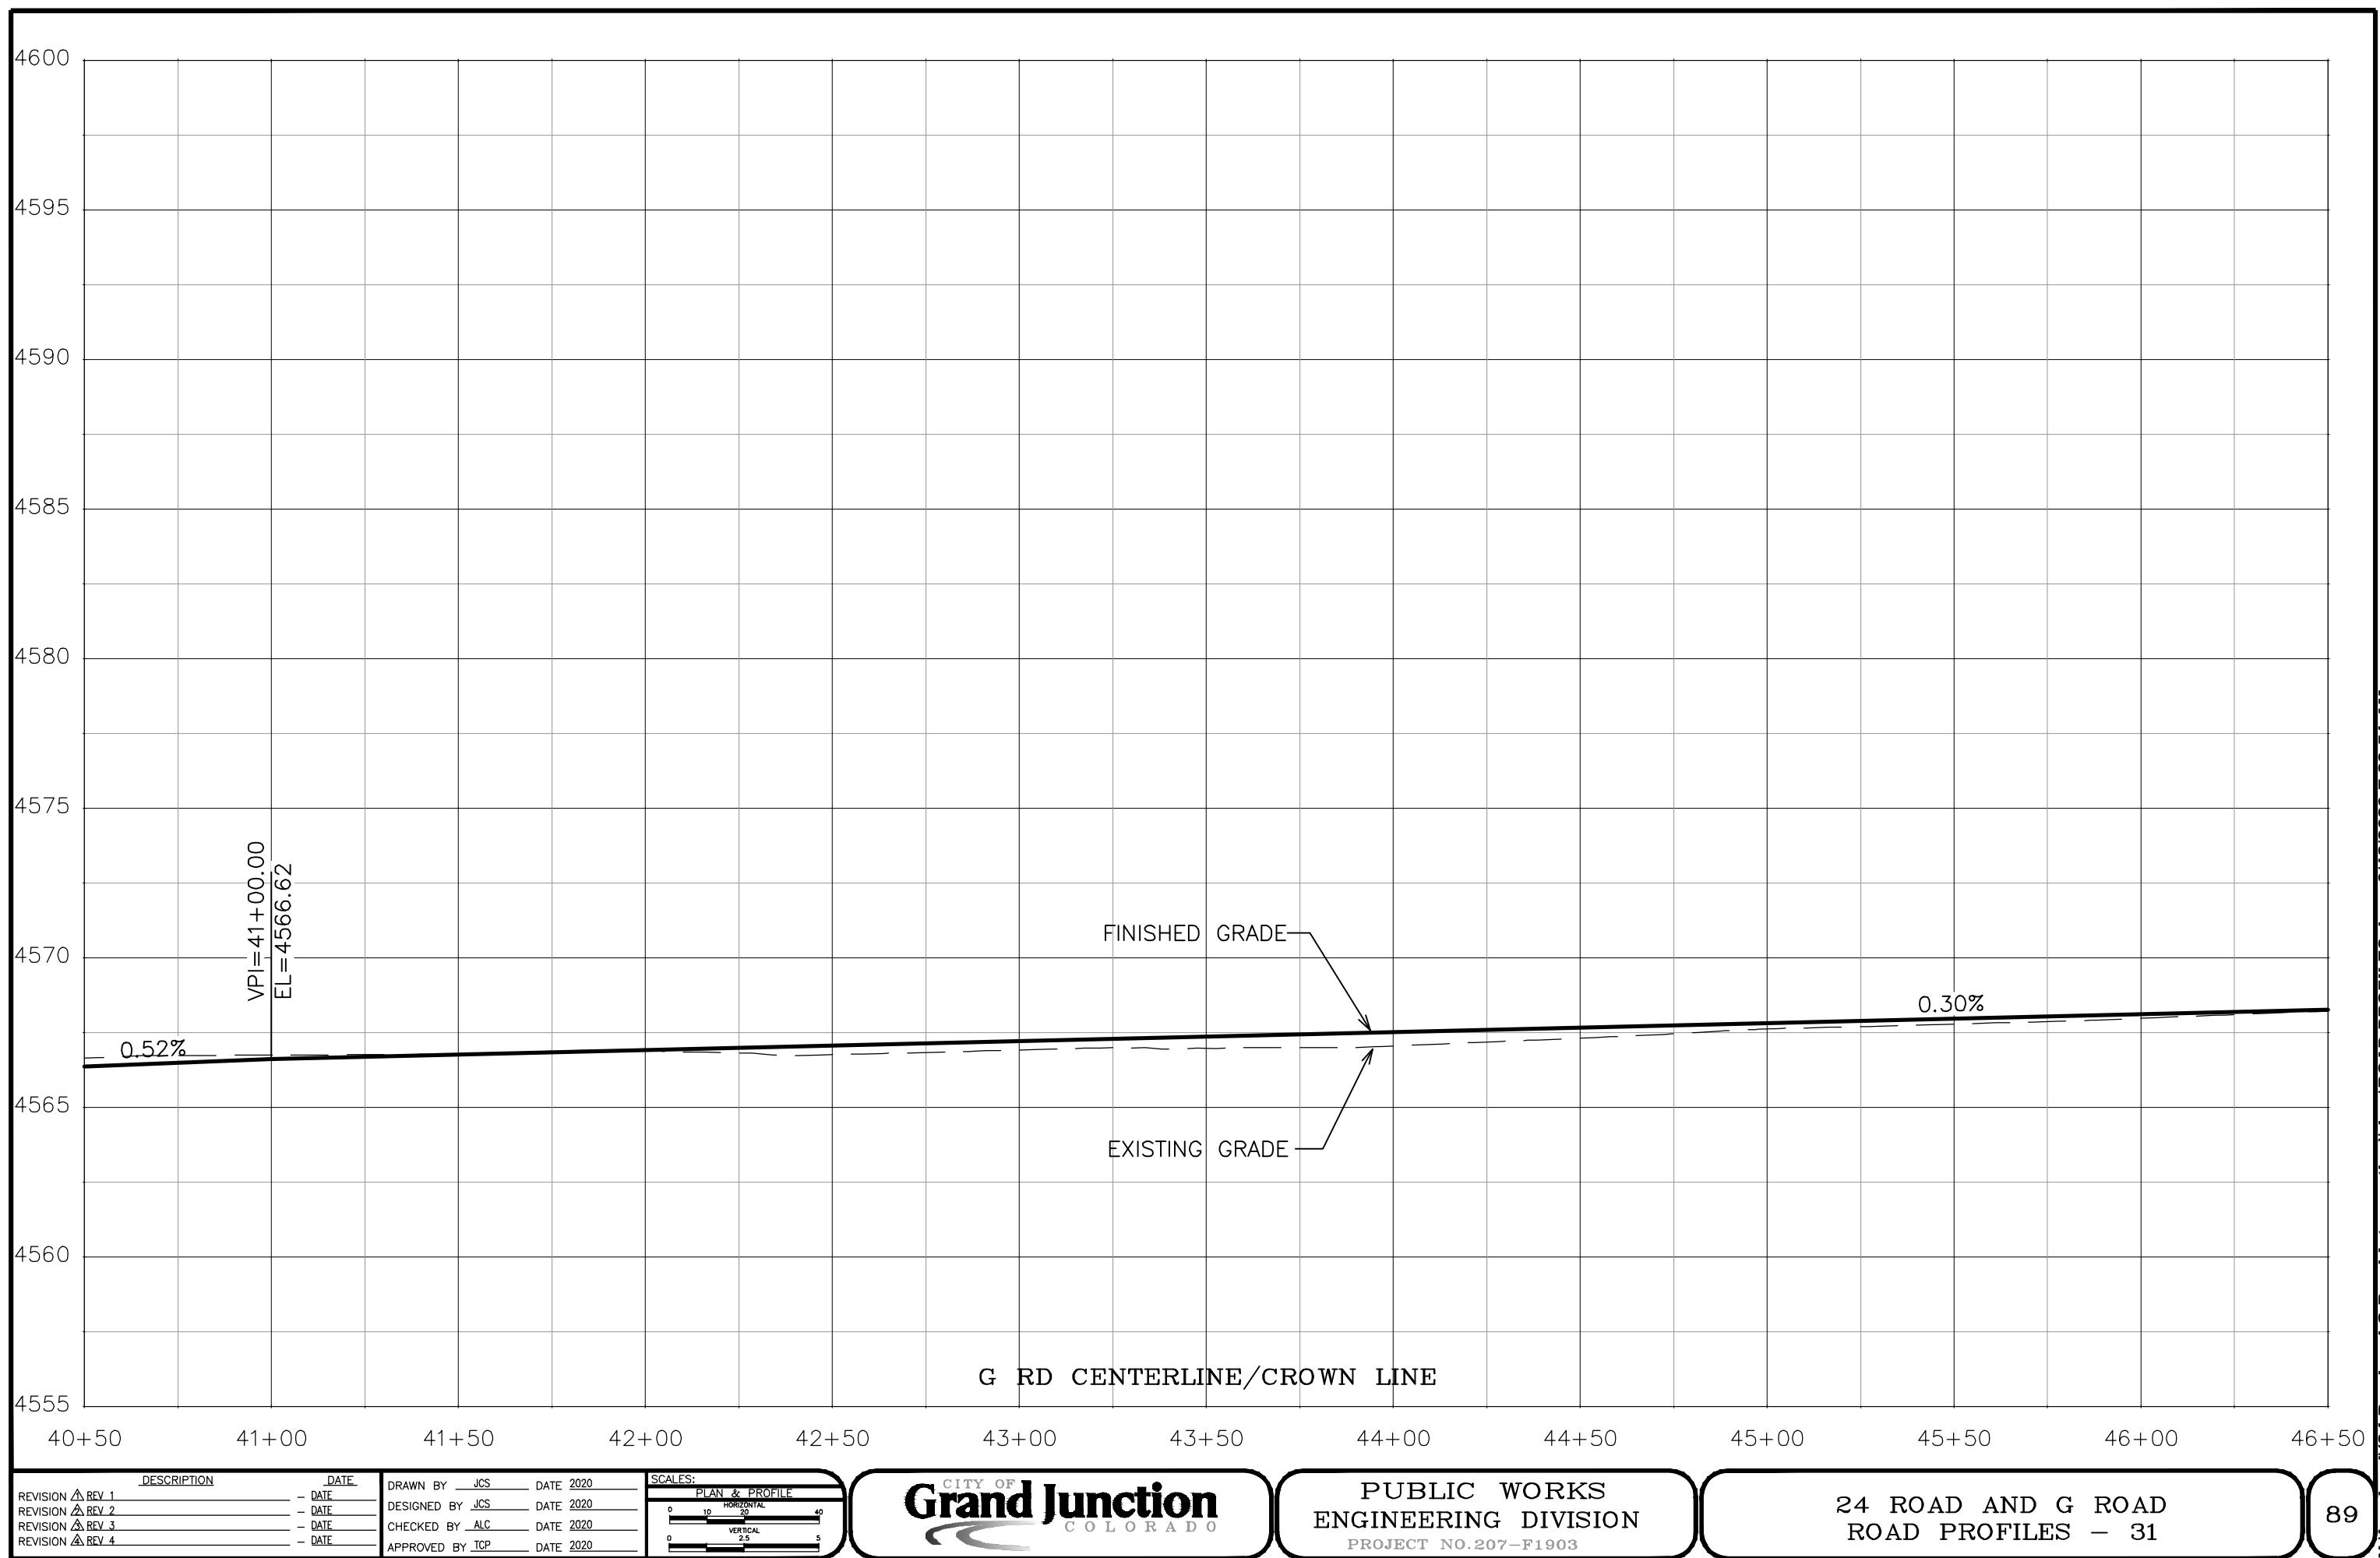

DESCRIPTION	DATE
REVISION ▲ REV 1	- DATE
REVISION ▲ REV 2	- DATE
REVISION ▲ REV 3	- DATE
REVISION ▲ REV 4	- DATE


DRAWN BY	JCS	DATE 2020
DESIGNED BY	JCS	DATE 2020
CHECKED BY	ALC	DATE 2020
APPROVED BY	TCP	DATE 2020

SCALES:		
PLAN & PROFILE		
0	10	20
HORIZONTAL		
0	2.5	5
VERTICAL		



PUBLIC WORKS
 ENGINEERING DIVISION
 PROJECT NO. 207-F1903

24 ROAD AND G ROAD
 ROAD PROFILES - 31

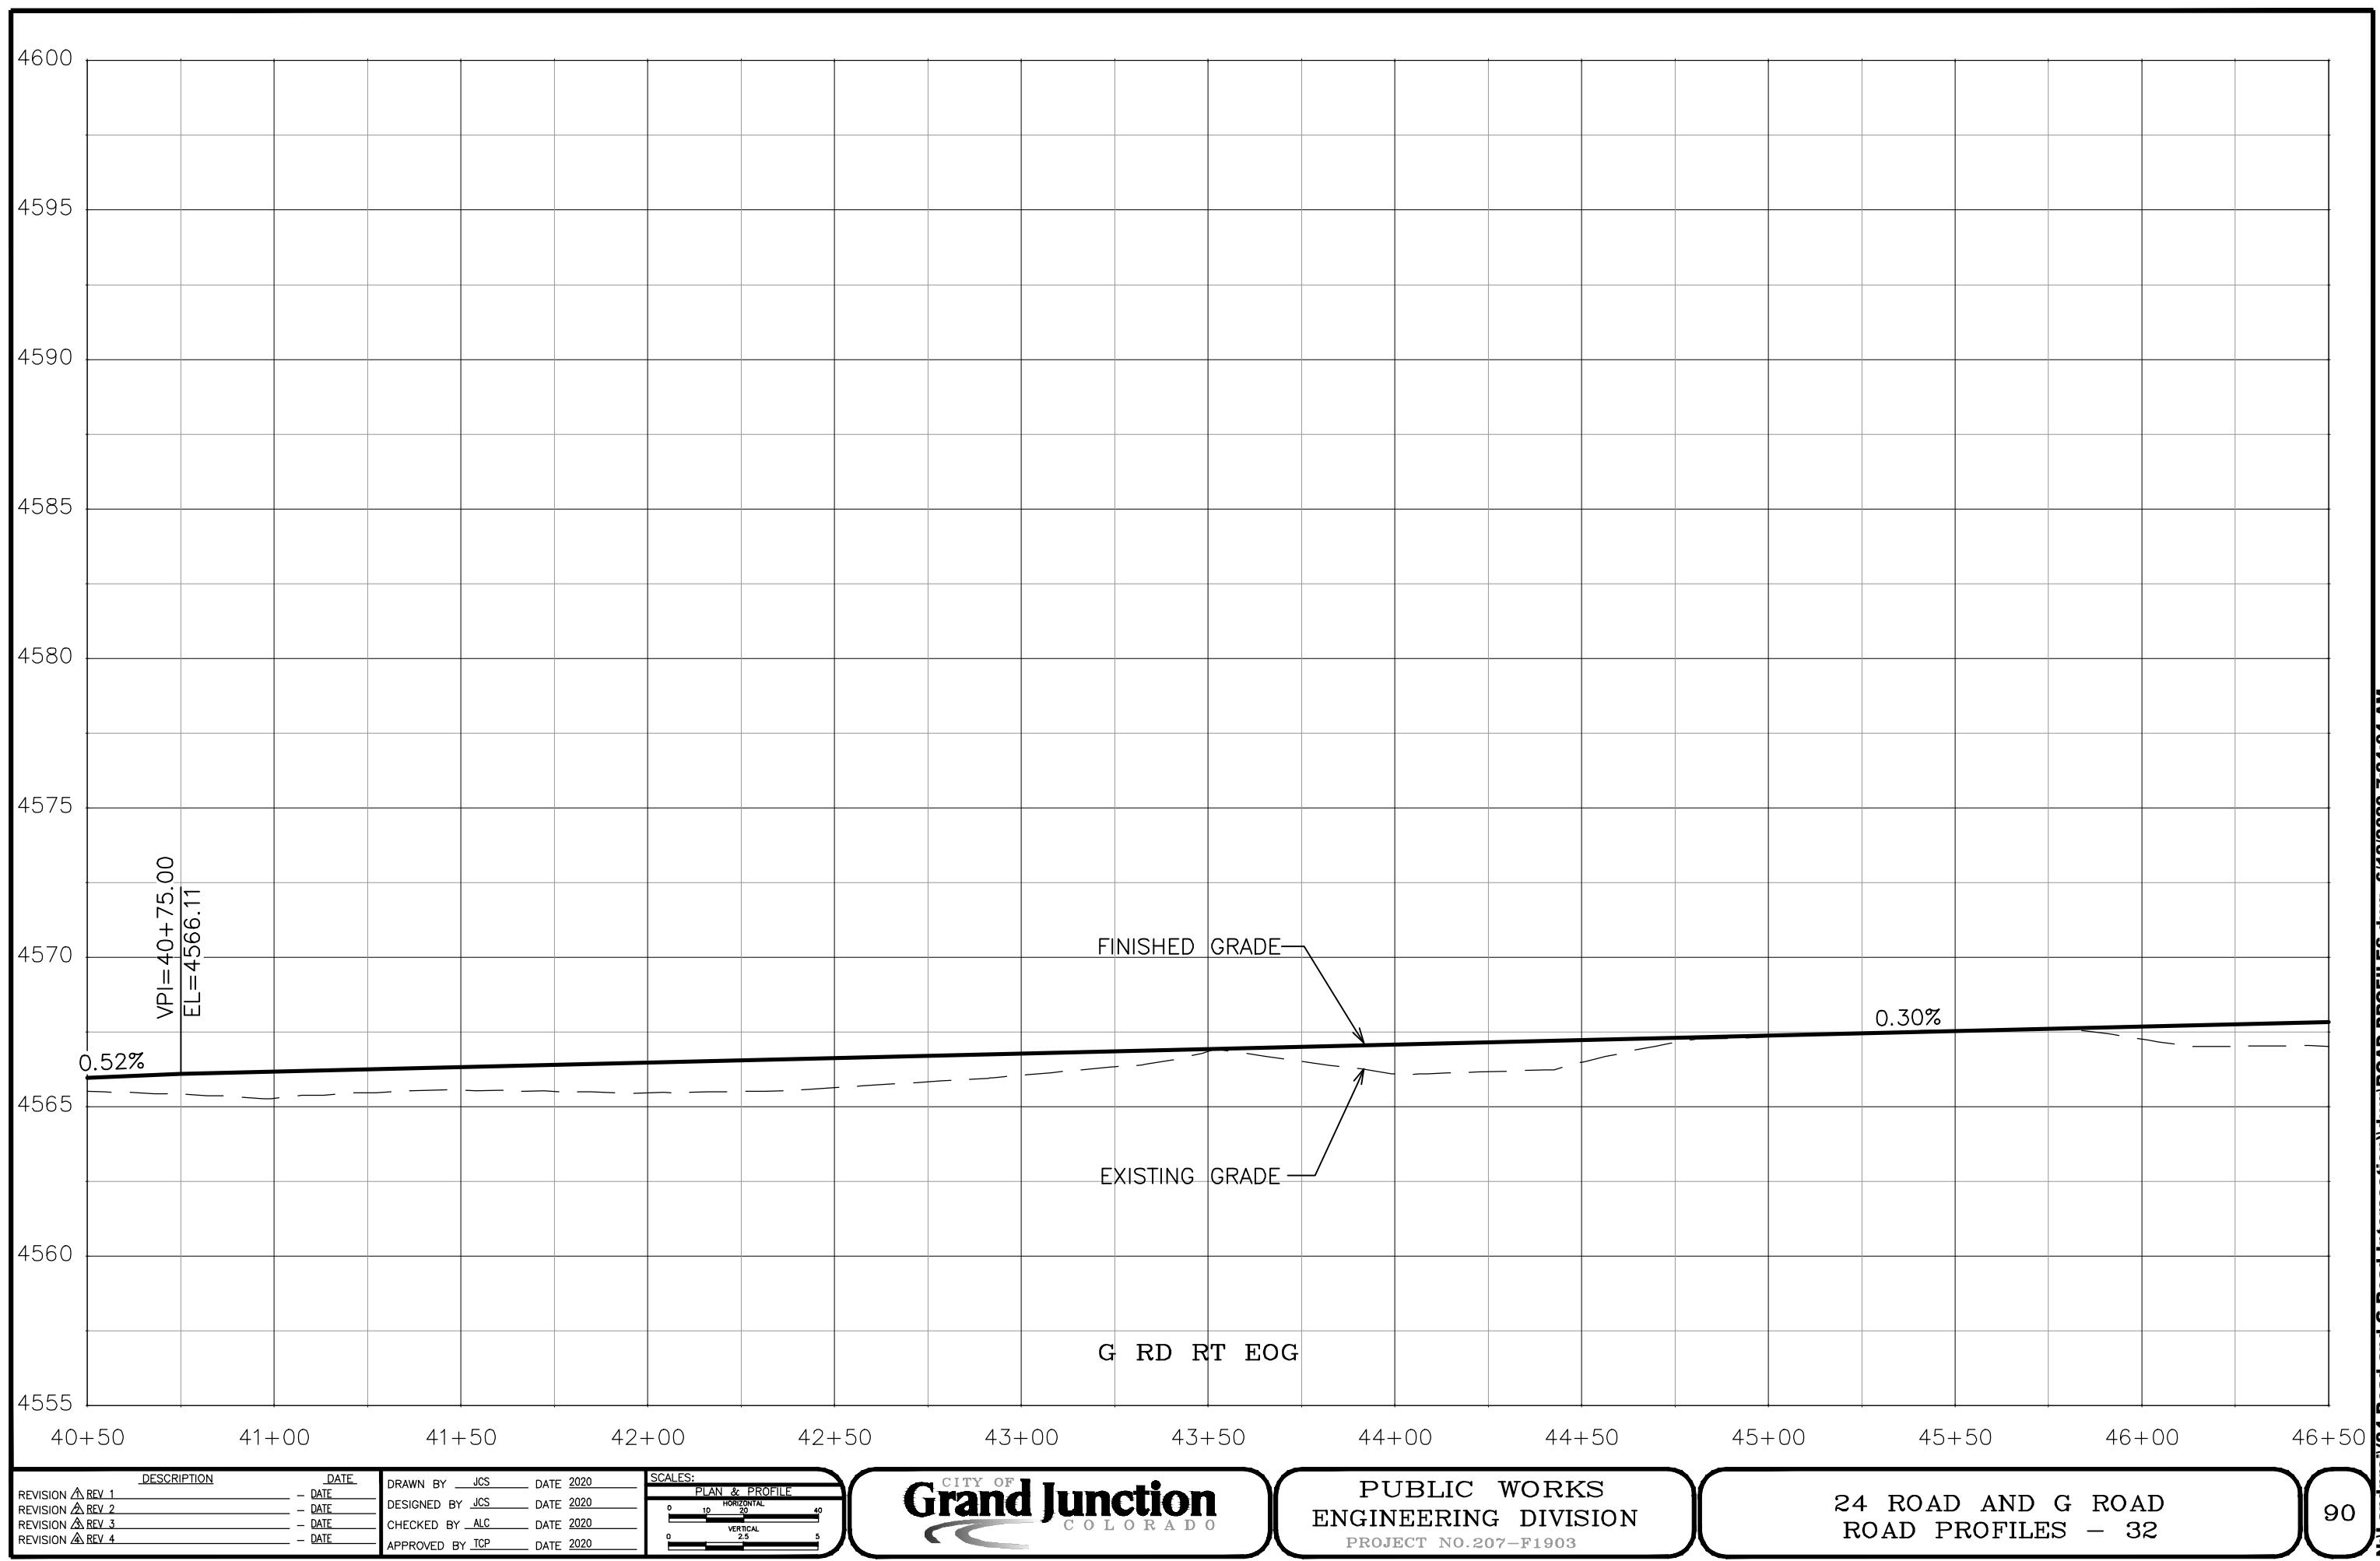

DESCRIPTION	DATE
REVISION ▲ REV 1	- DATE
REVISION ▲ REV 2	- DATE
REVISION ▲ REV 3	- DATE
REVISION ▲ REV 4	- DATE


DRAWN BY	JCS	DATE 2020
DESIGNED BY	JCS	DATE 2020
CHECKED BY	ALC	DATE 2020
APPROVED BY	TCP	DATE 2020

SCALES:	PLAN & PROFILE		
0	10	20	40
	HORIZONTAL		
0	2.5	5	
	VERTICAL		



PUBLIC WORKS
ENGINEERING DIVISION
PROJECT NO. 207-F1903

24 ROAD AND G ROAD
ROAD PROFILES - 32

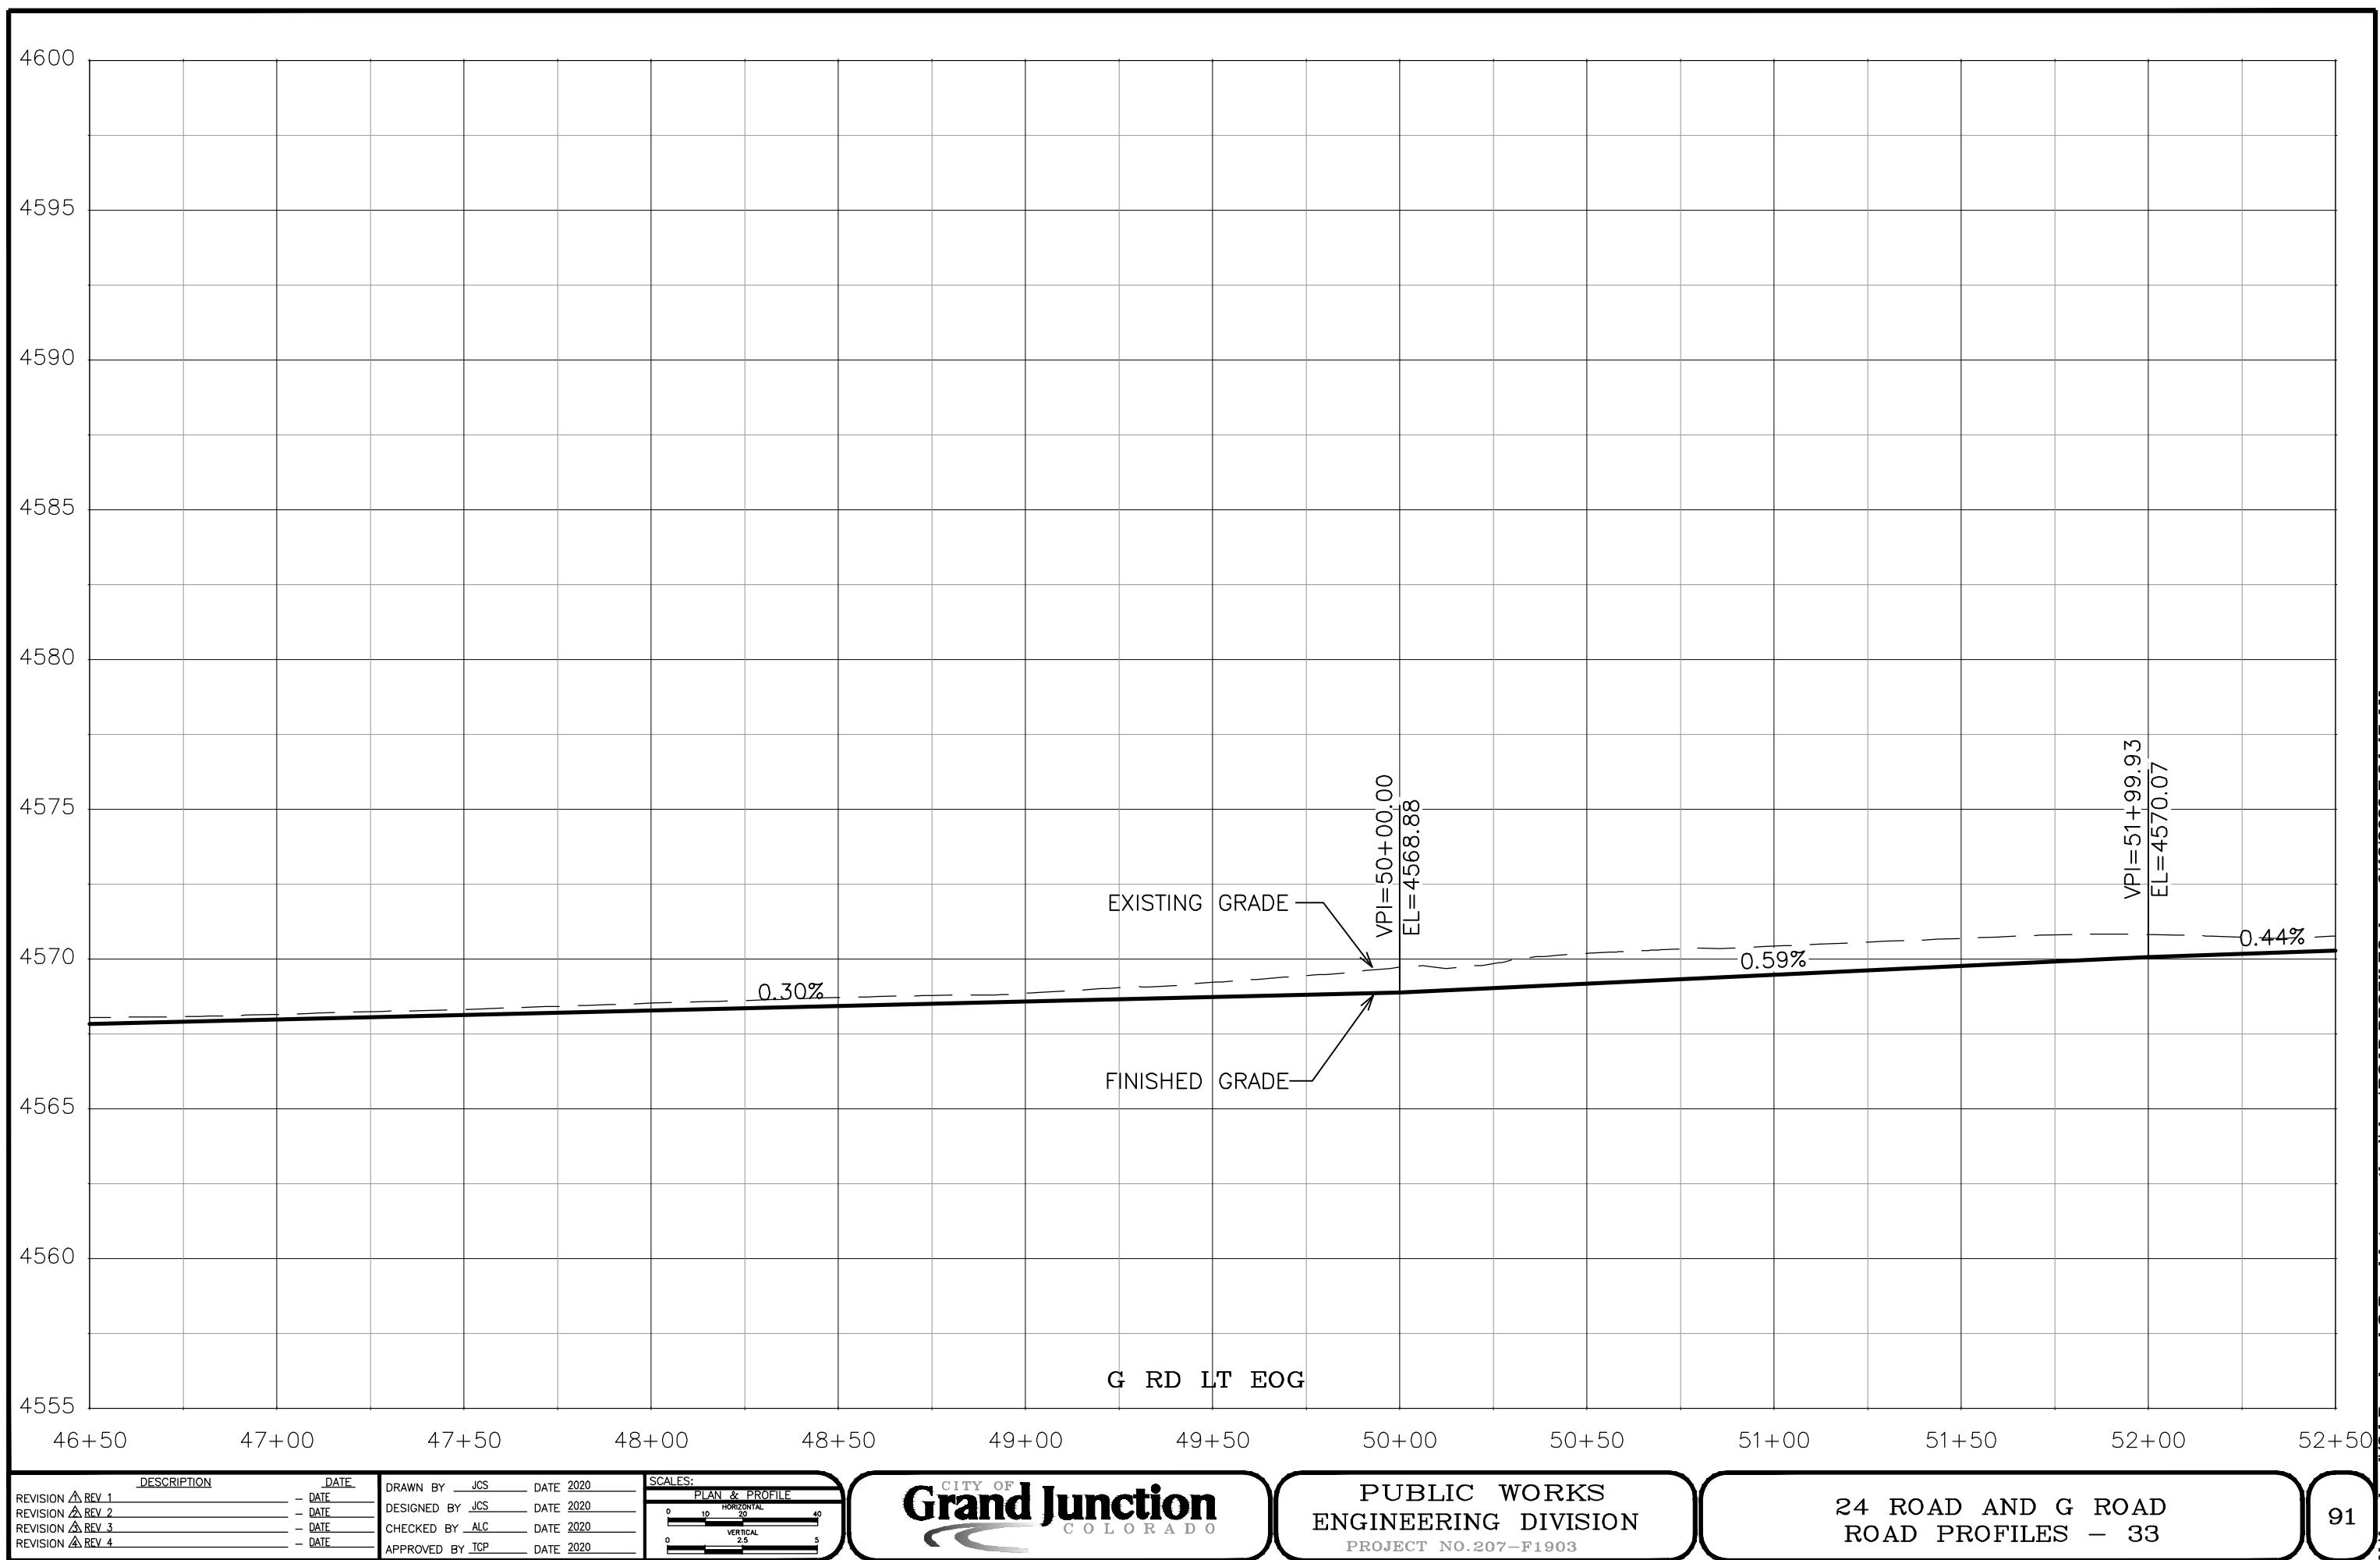

DESCRIPTION	DATE
REVISION ▲ REV 1	- DATE
REVISION ▲ REV 2	- DATE
REVISION ▲ REV 3	- DATE
REVISION ▲ REV 4	- DATE


DRAWN BY	JCS	DATE 2020
DESIGNED BY	JCS	DATE 2020
CHECKED BY	ALC	DATE 2020
APPROVED BY	TCP	DATE 2020

SCALES:	PLAN & PROFILE		
0	10	20	40
	HORIZONTAL		
0	2.5	5	
	VERTICAL		



PUBLIC WORKS
ENGINEERING DIVISION
PROJECT NO. 207-F1903

24 ROAD AND G ROAD
ROAD PROFILES - 33

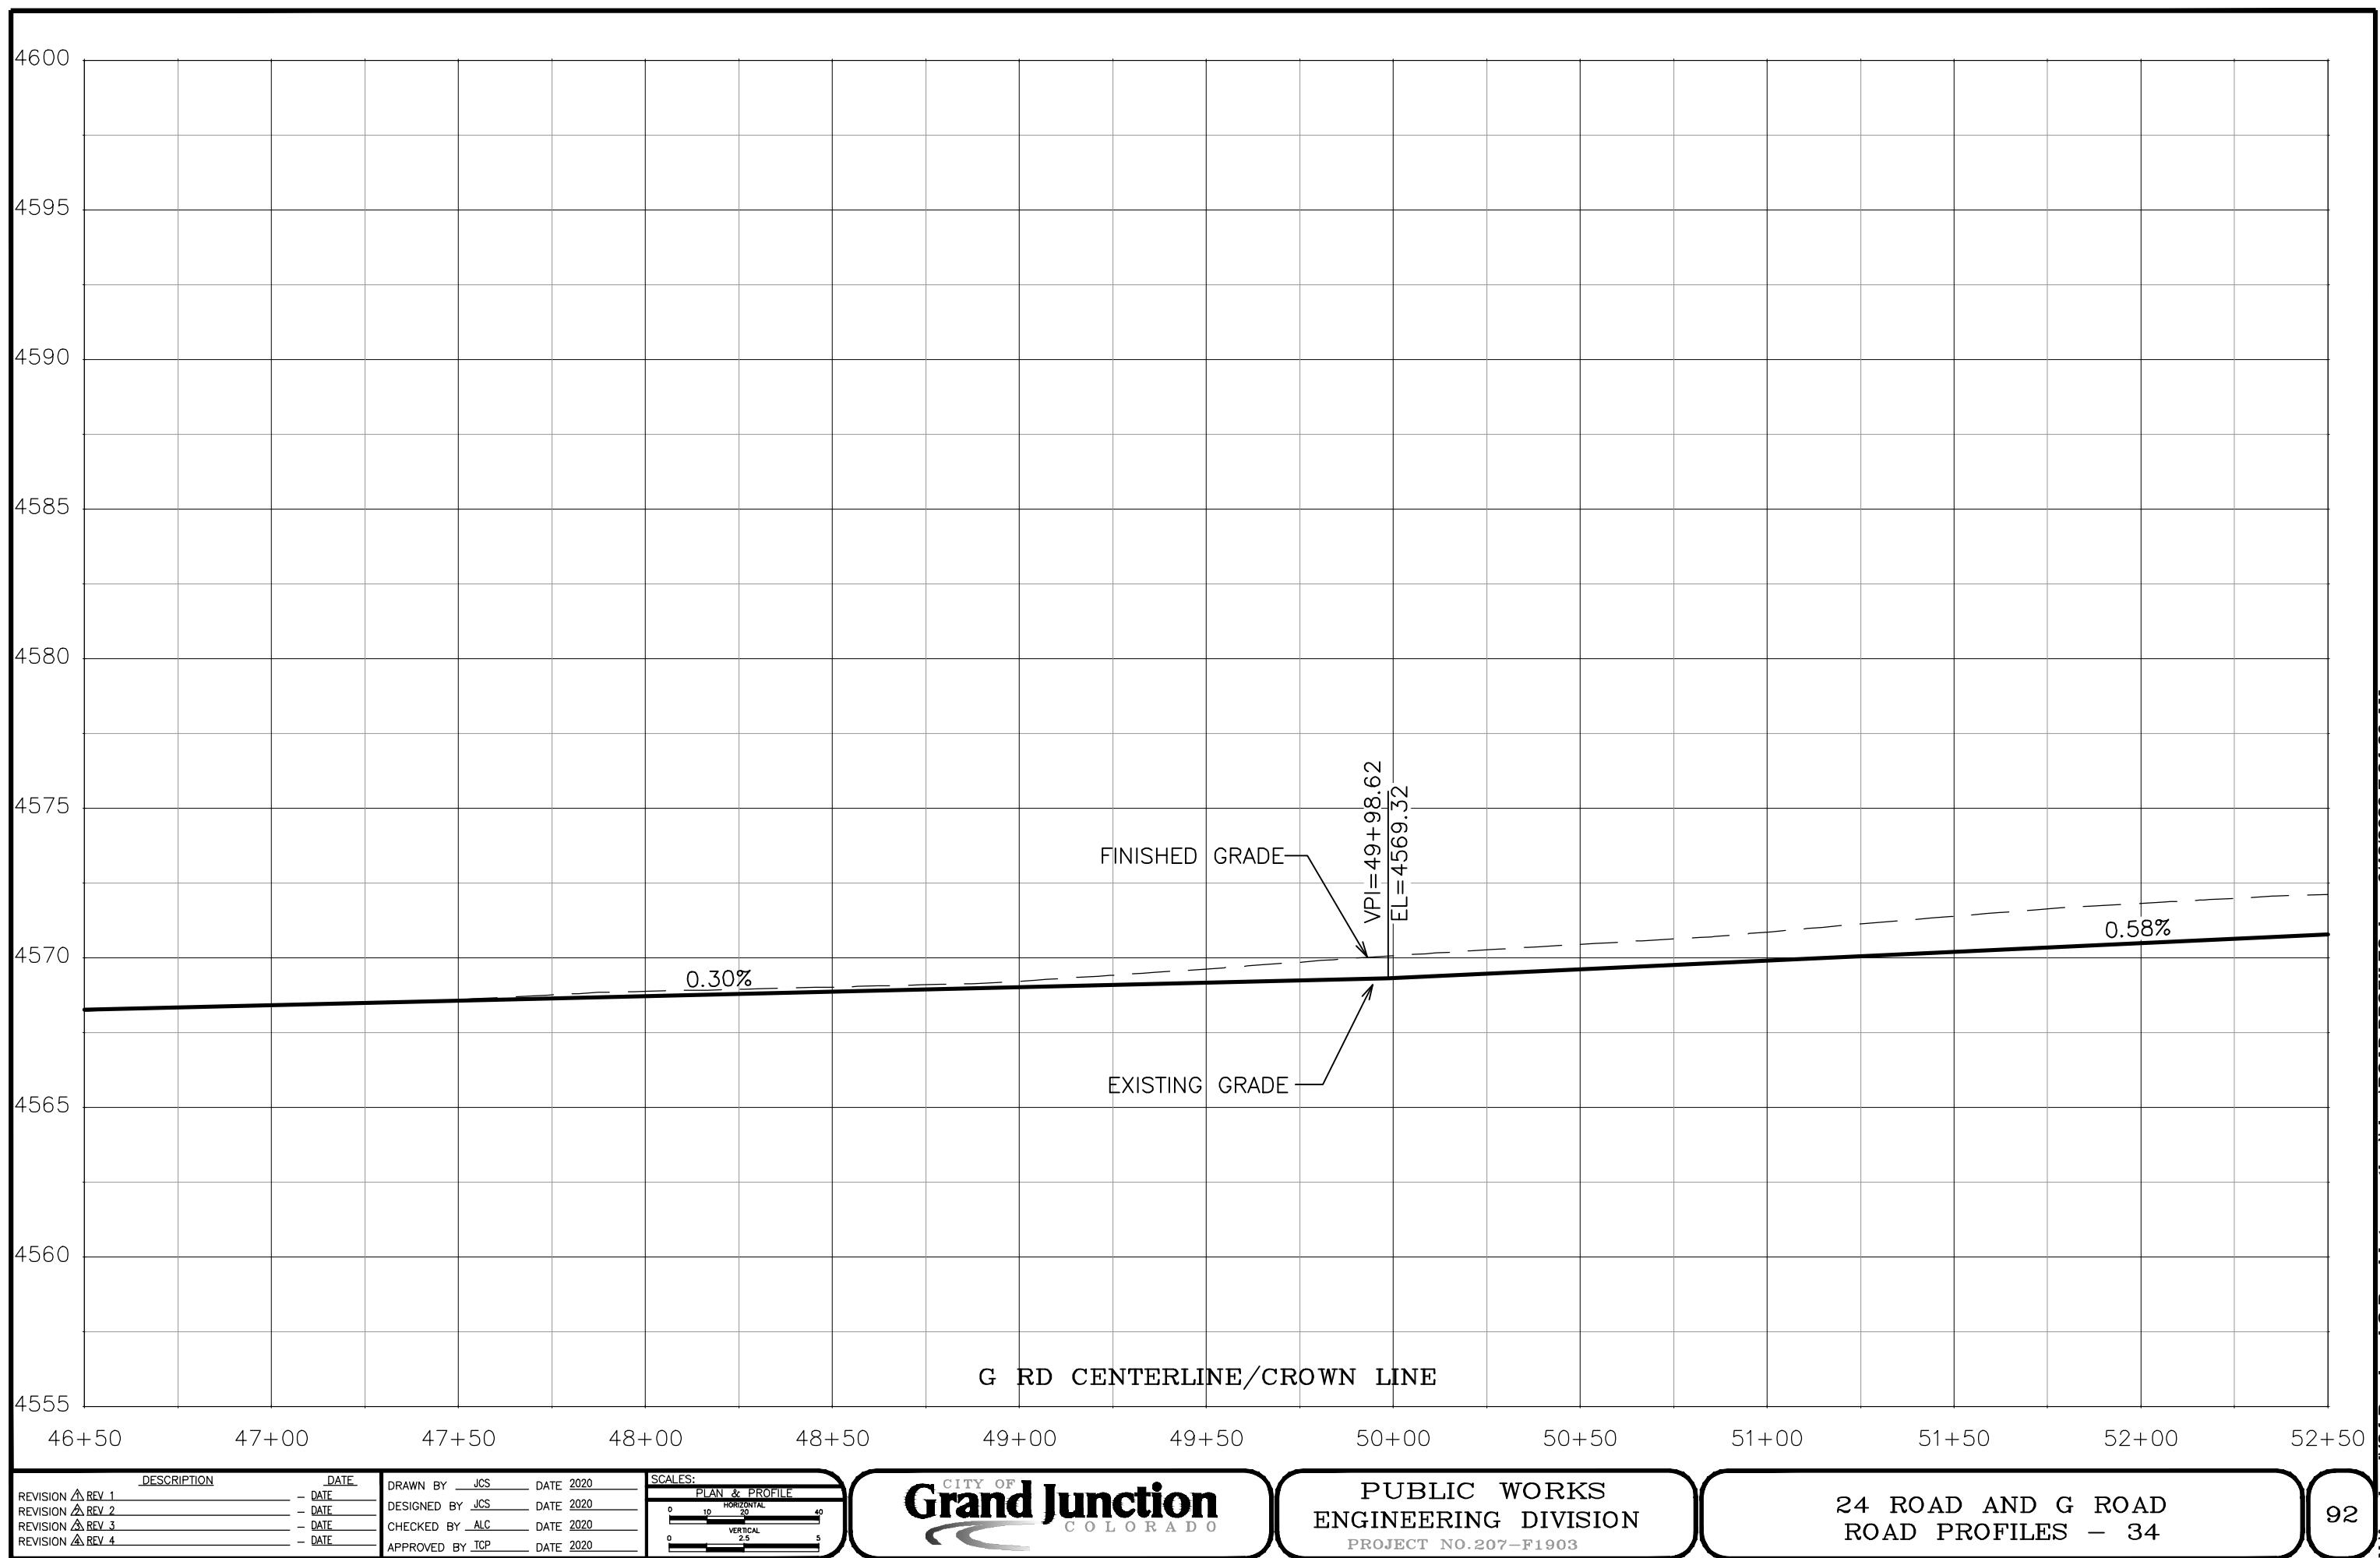

DESCRIPTION	DATE
REVISION ▲ REV 1	- DATE
REVISION ▲ REV 2	- DATE
REVISION ▲ REV 3	- DATE
REVISION ▲ REV 4	- DATE


DRAWN BY	JCS	DATE 2020
DESIGNED BY	JCS	DATE 2020
CHECKED BY	ALC	DATE 2020
APPROVED BY	TCP	DATE 2020

SCALES:		
PLAN & PROFILE		
0	10	20
HORIZONTAL		
0	2.5	5
VERTICAL		



PUBLIC WORKS
ENGINEERING DIVISION
PROJECT NO. 207-F1903

24 ROAD AND G ROAD
ROAD PROFILES - 34

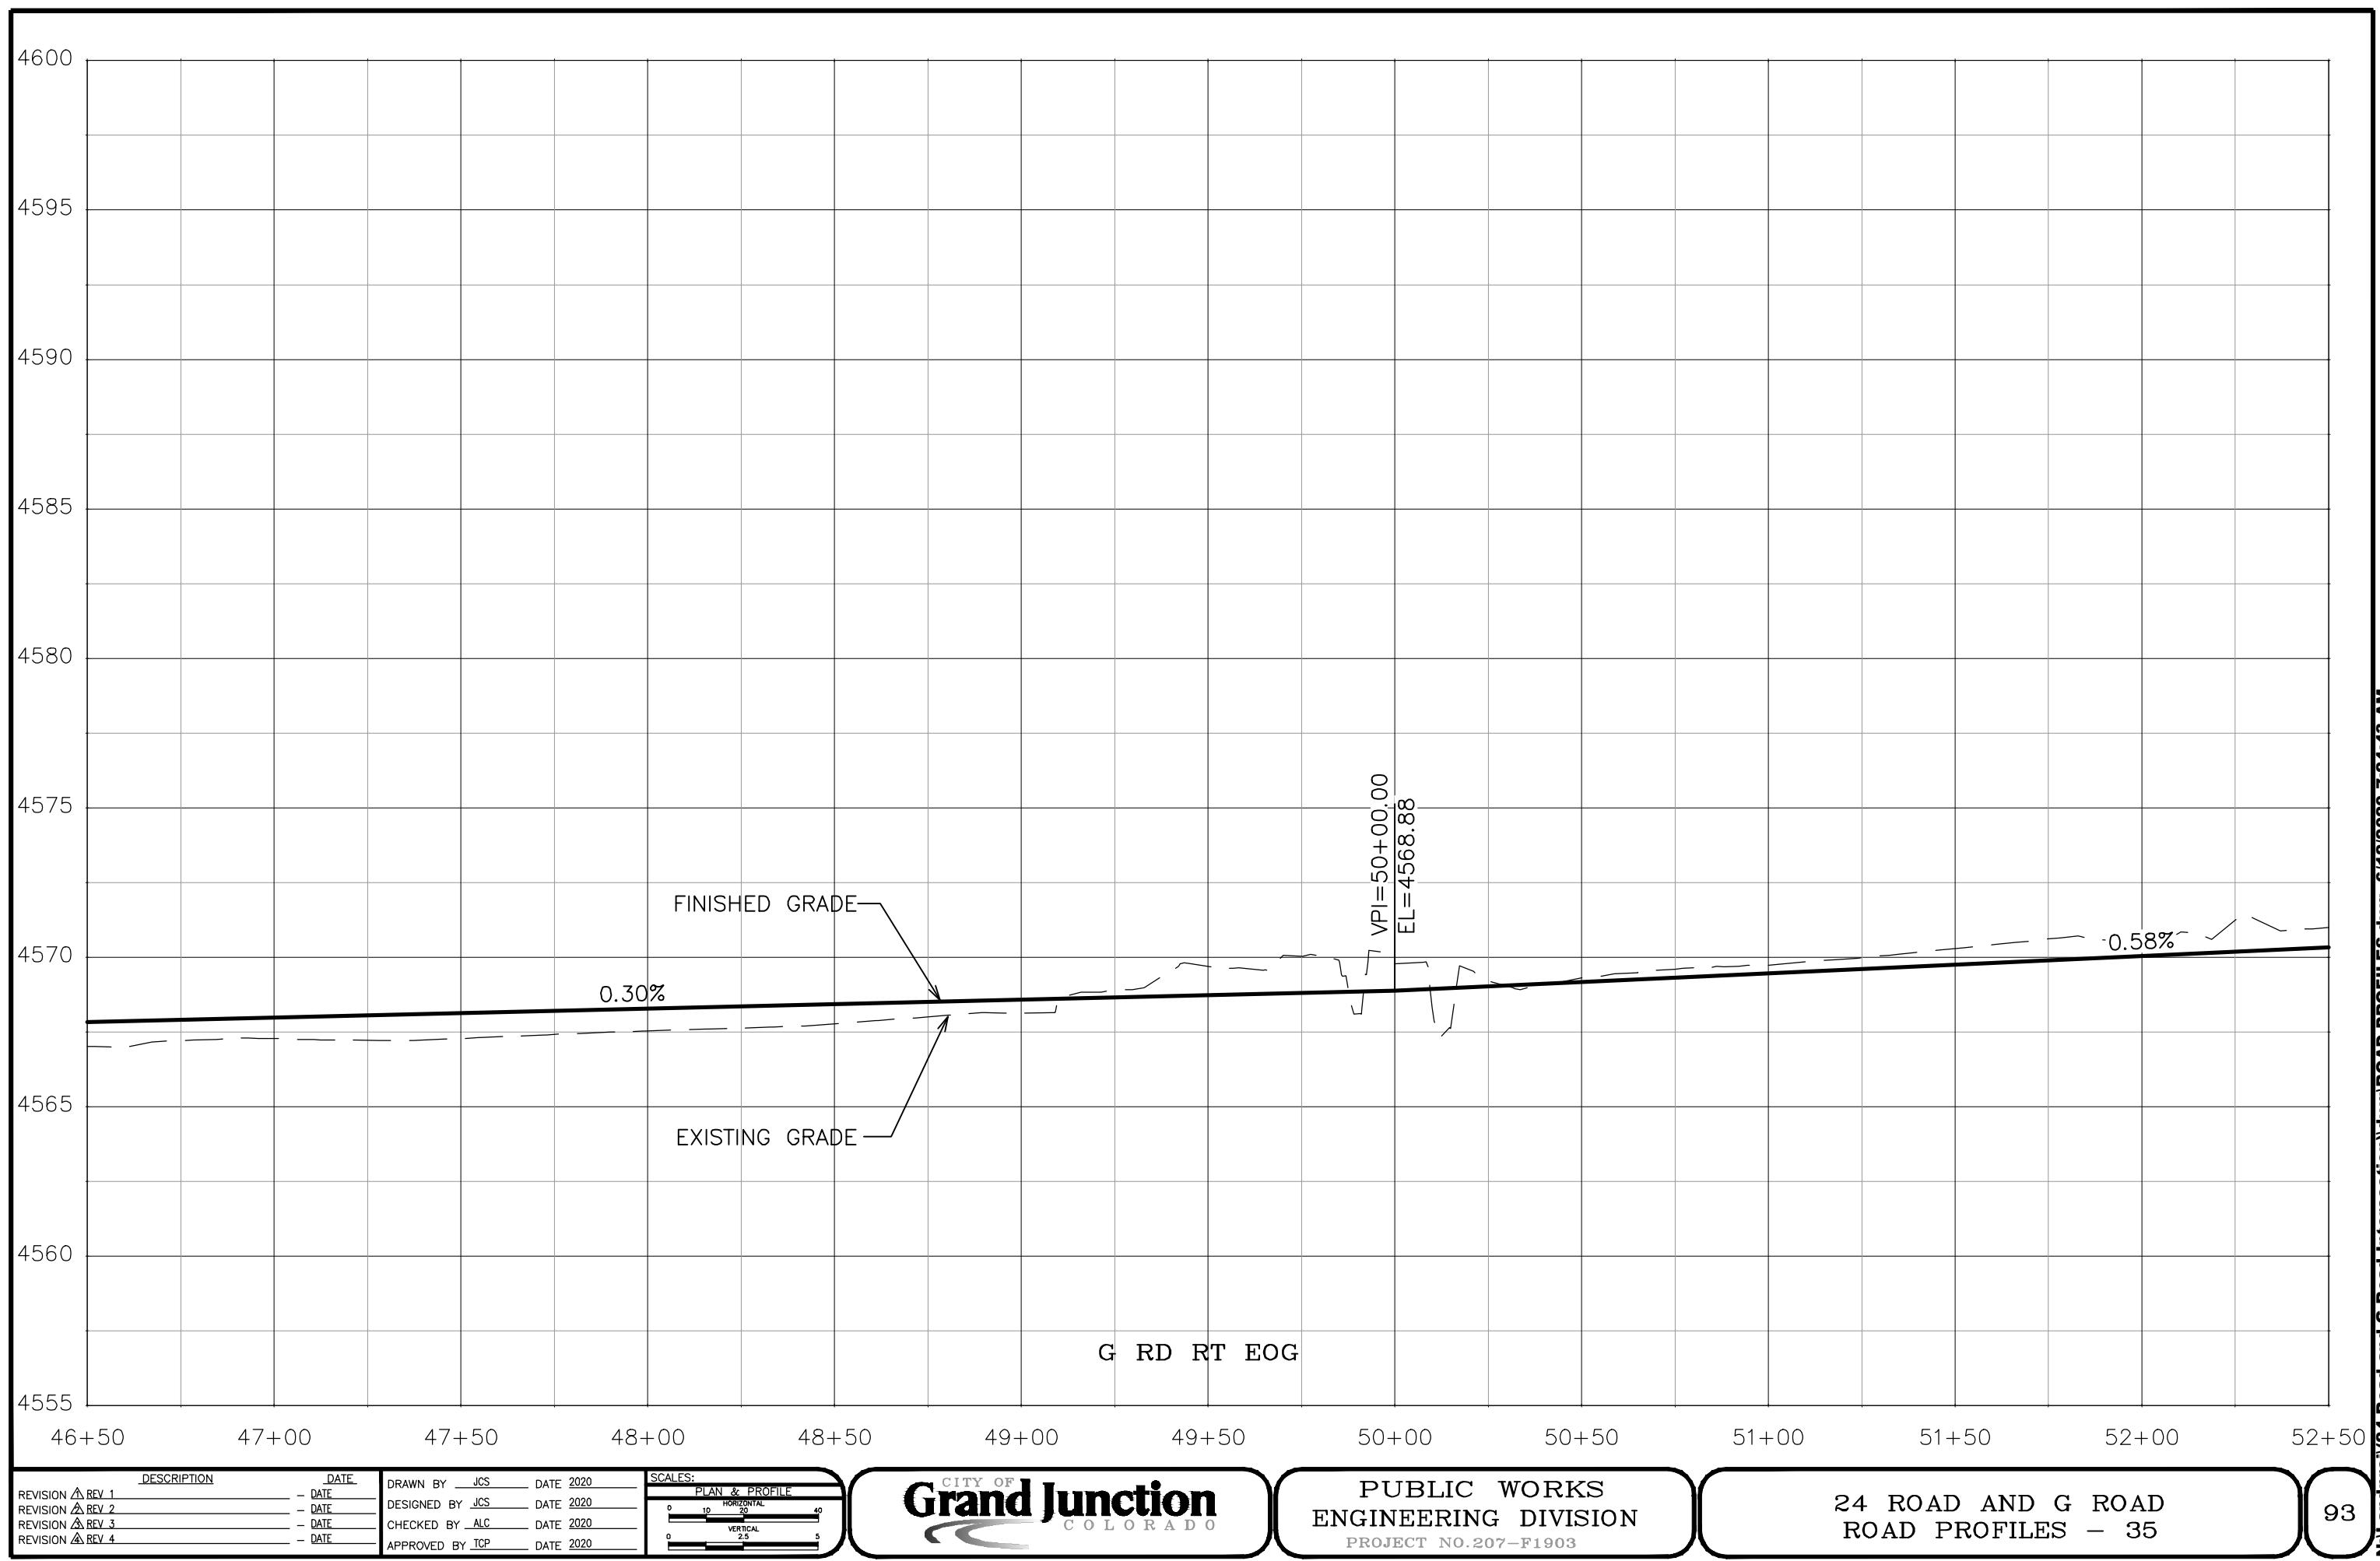

DESCRIPTION	DATE
REVISION ▲ REV 1	- DATE
REVISION ▲ REV 2	- DATE
REVISION ▲ REV 3	- DATE
REVISION ▲ REV 4	- DATE


DRAWN BY	JCS	DATE 2020
DESIGNED BY	JCS	DATE 2020
CHECKED BY	ALC	DATE 2020
APPROVED BY	TCP	DATE 2020

SCALES:	PLAN & PROFILE		
0	10	20	40
	HORIZONTAL		
0	2.5	5	
	VERTICAL		



PUBLIC WORKS
ENGINEERING DIVISION
PROJECT NO. 207-F1903

24 ROAD AND G ROAD
ROAD PROFILES - 35

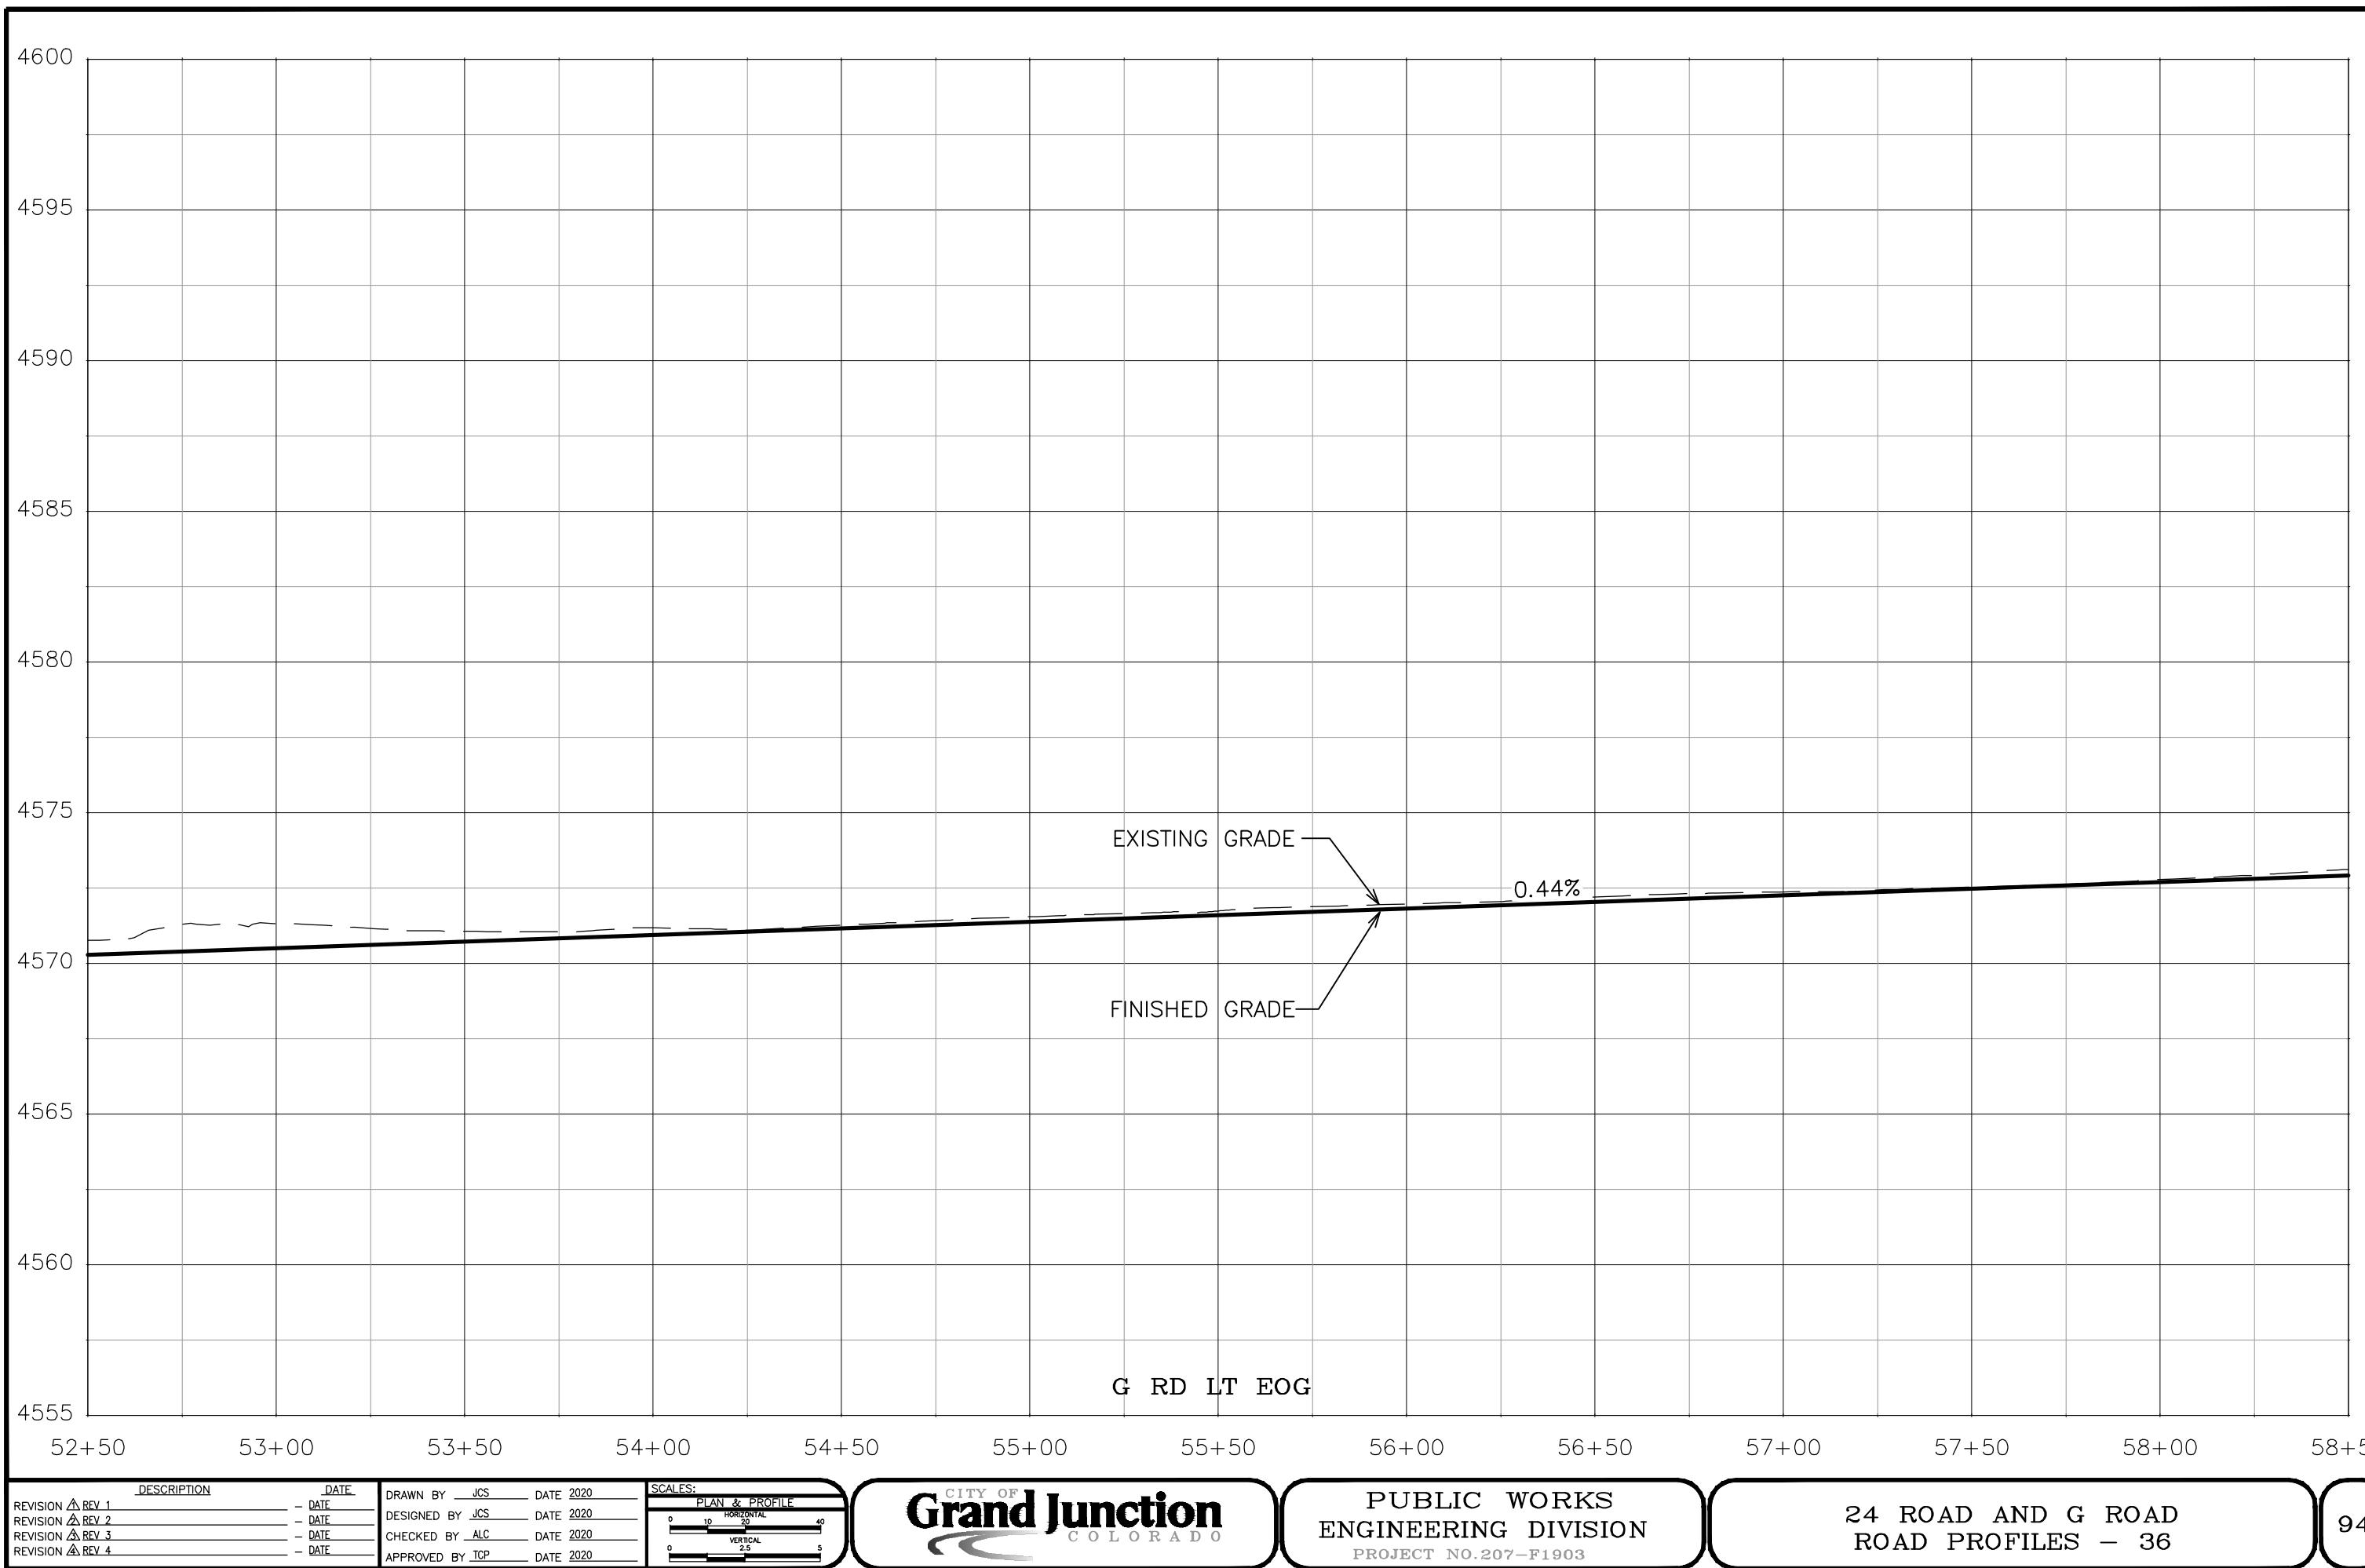

DESCRIPTION	DATE
REVISION ▲ REV 1	- DATE
REVISION ▲ REV 2	- DATE
REVISION ▲ REV 3	- DATE
REVISION ▲ REV 4	- DATE


DRAWN BY	JCS	DATE 2020
DESIGNED BY	JCS	DATE 2020
CHECKED BY	ALC	DATE 2020
APPROVED BY	TCP	DATE 2020

SCALES:		
PLAN & PROFILE		
0	10	20
HORIZONTAL		
0	2.5	5
VERTICAL		



PUBLIC WORKS
ENGINEERING DIVISION
PROJECT NO. 207-F1903

24 ROAD AND G ROAD
ROAD PROFILES - 36

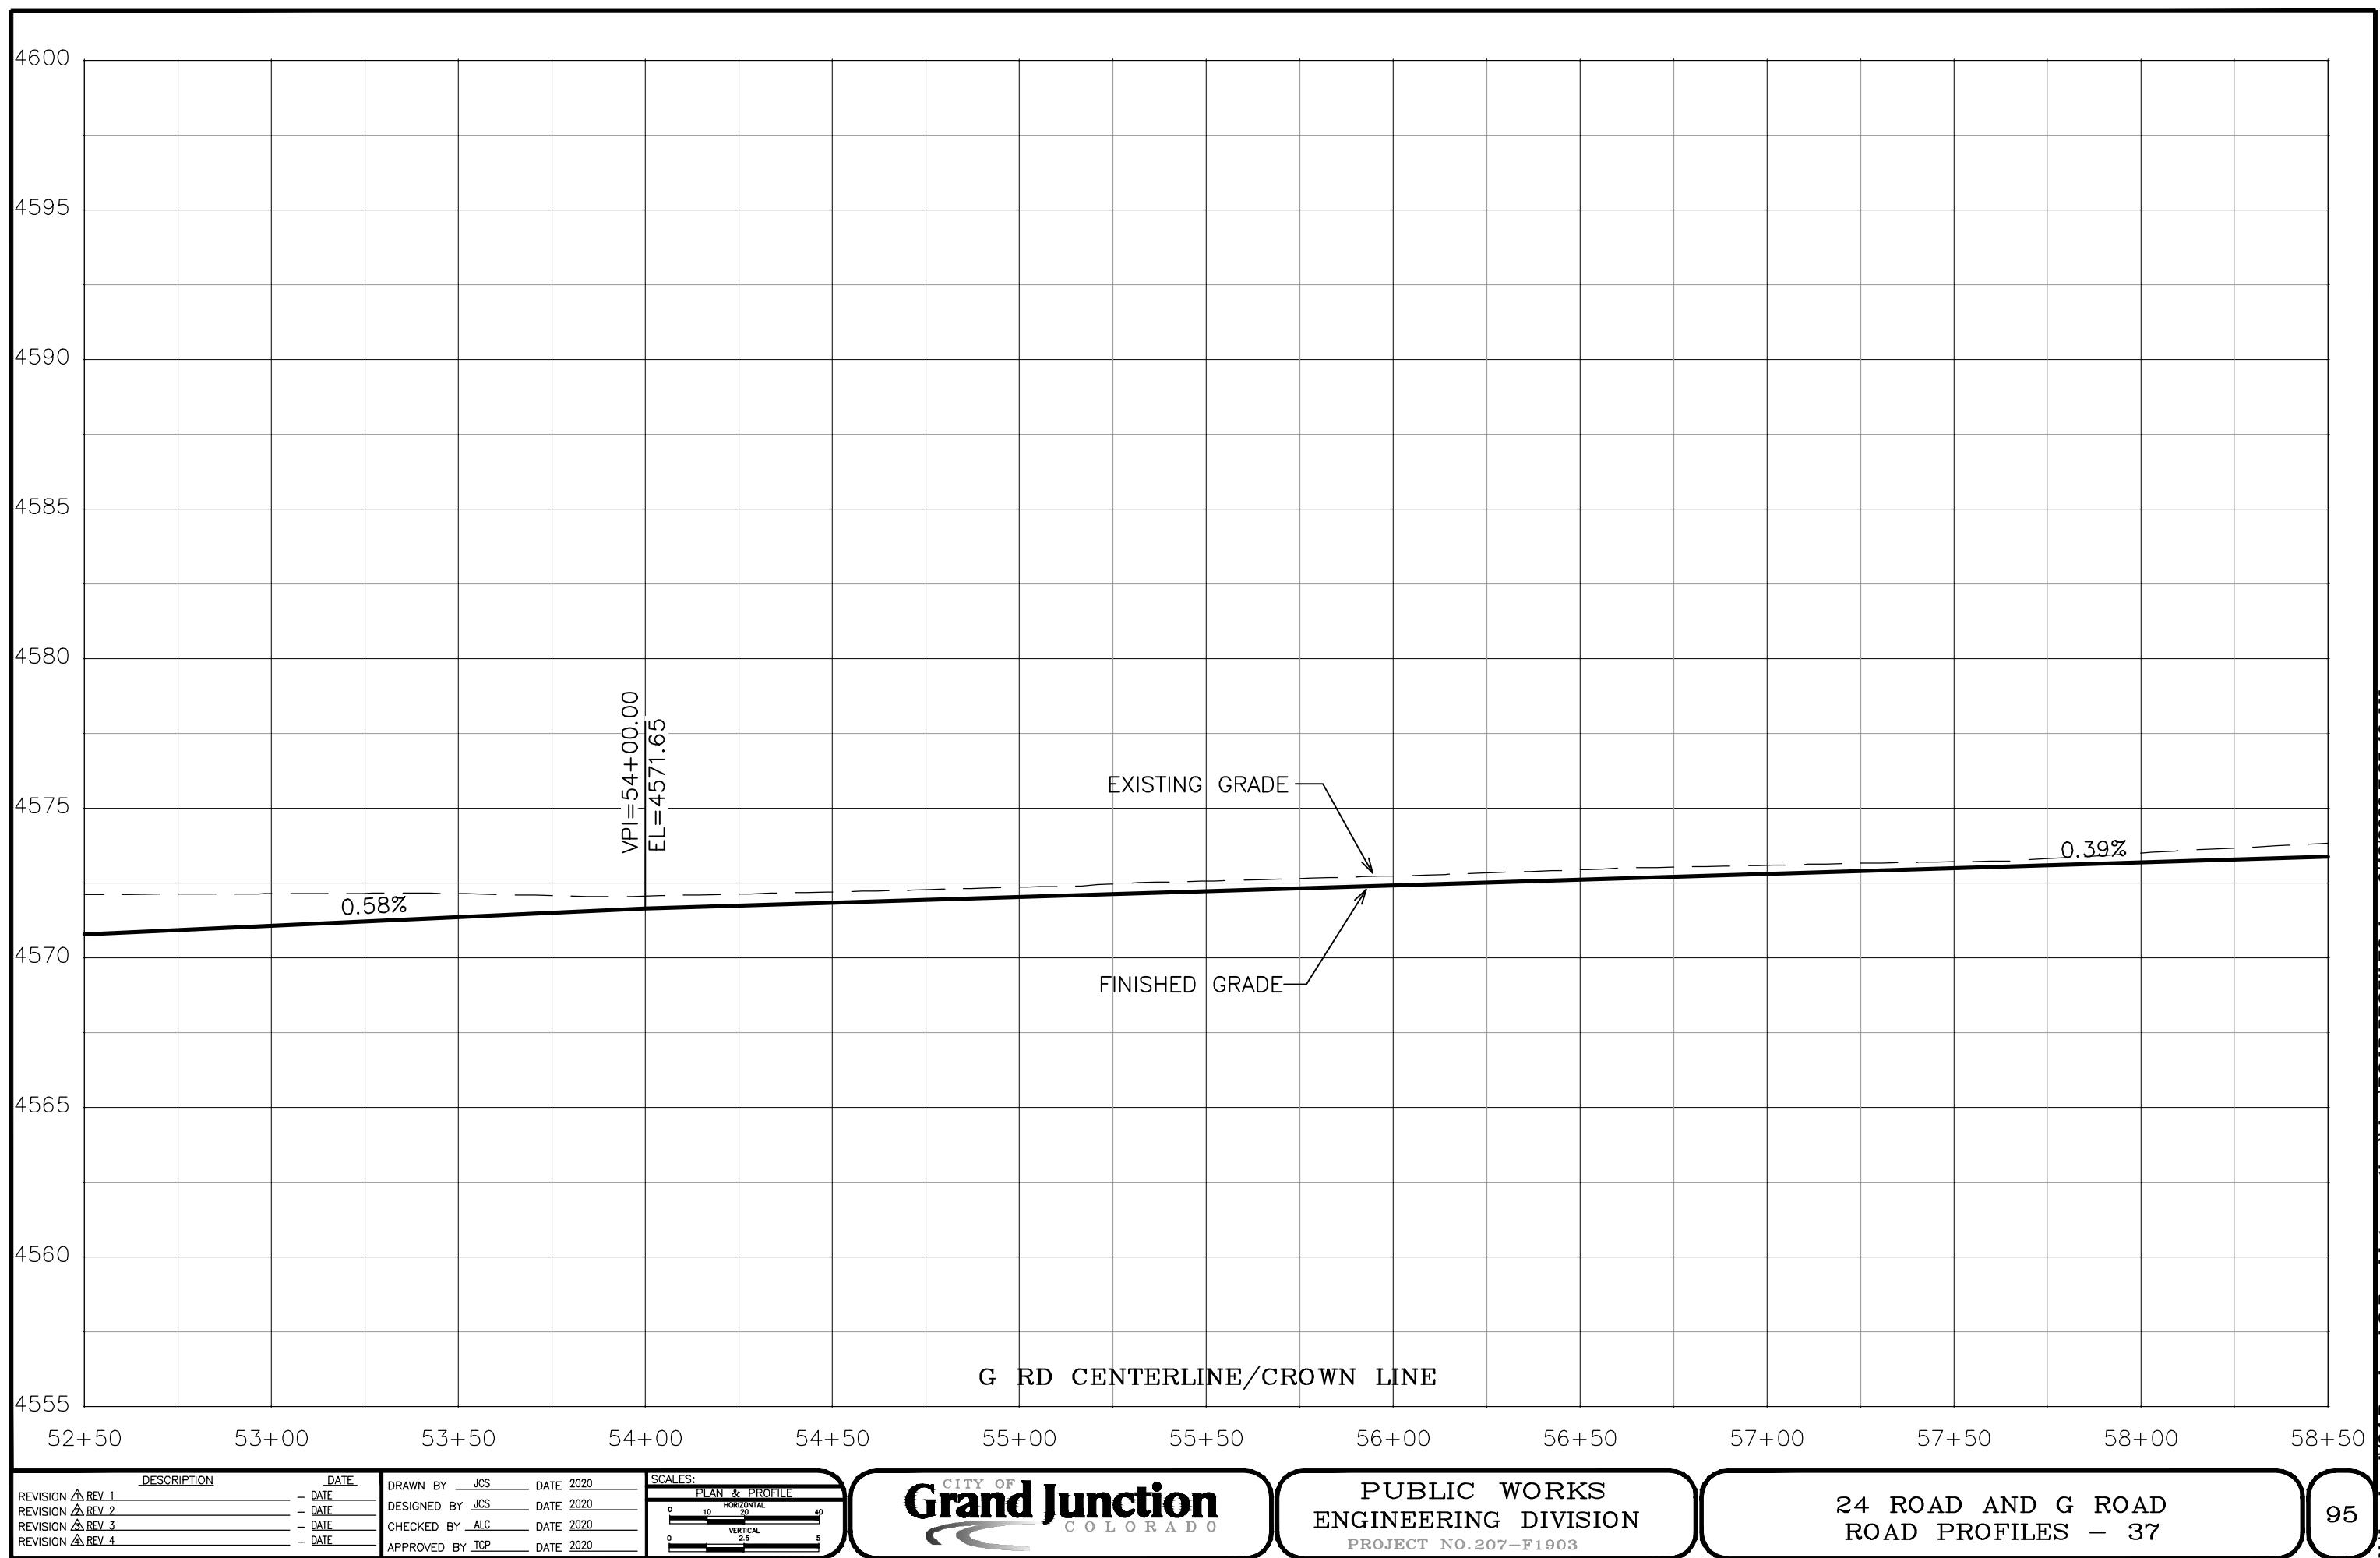

DESCRIPTION DATE
 REVISION ▲ REV 1 - DATE
 REVISION ▲ REV 2 - DATE
 REVISION ▲ REV 3 - DATE
 REVISION ▲ REV 4 - DATE


DRAWN BY JCS DATE 2020
 DESIGNED BY JCS DATE 2020
 CHECKED BY ALC DATE 2020
 APPROVED BY TCP DATE 2020

SCALES:
 PLAN & PROFILE
 HORIZONTAL: 0 10 20 40
 VERTICAL: 0 2.5 5



PUBLIC WORKS
 ENGINEERING DIVISION
 PROJECT NO. 207-F1903

24 ROAD AND G ROAD
 ROAD PROFILES — 37

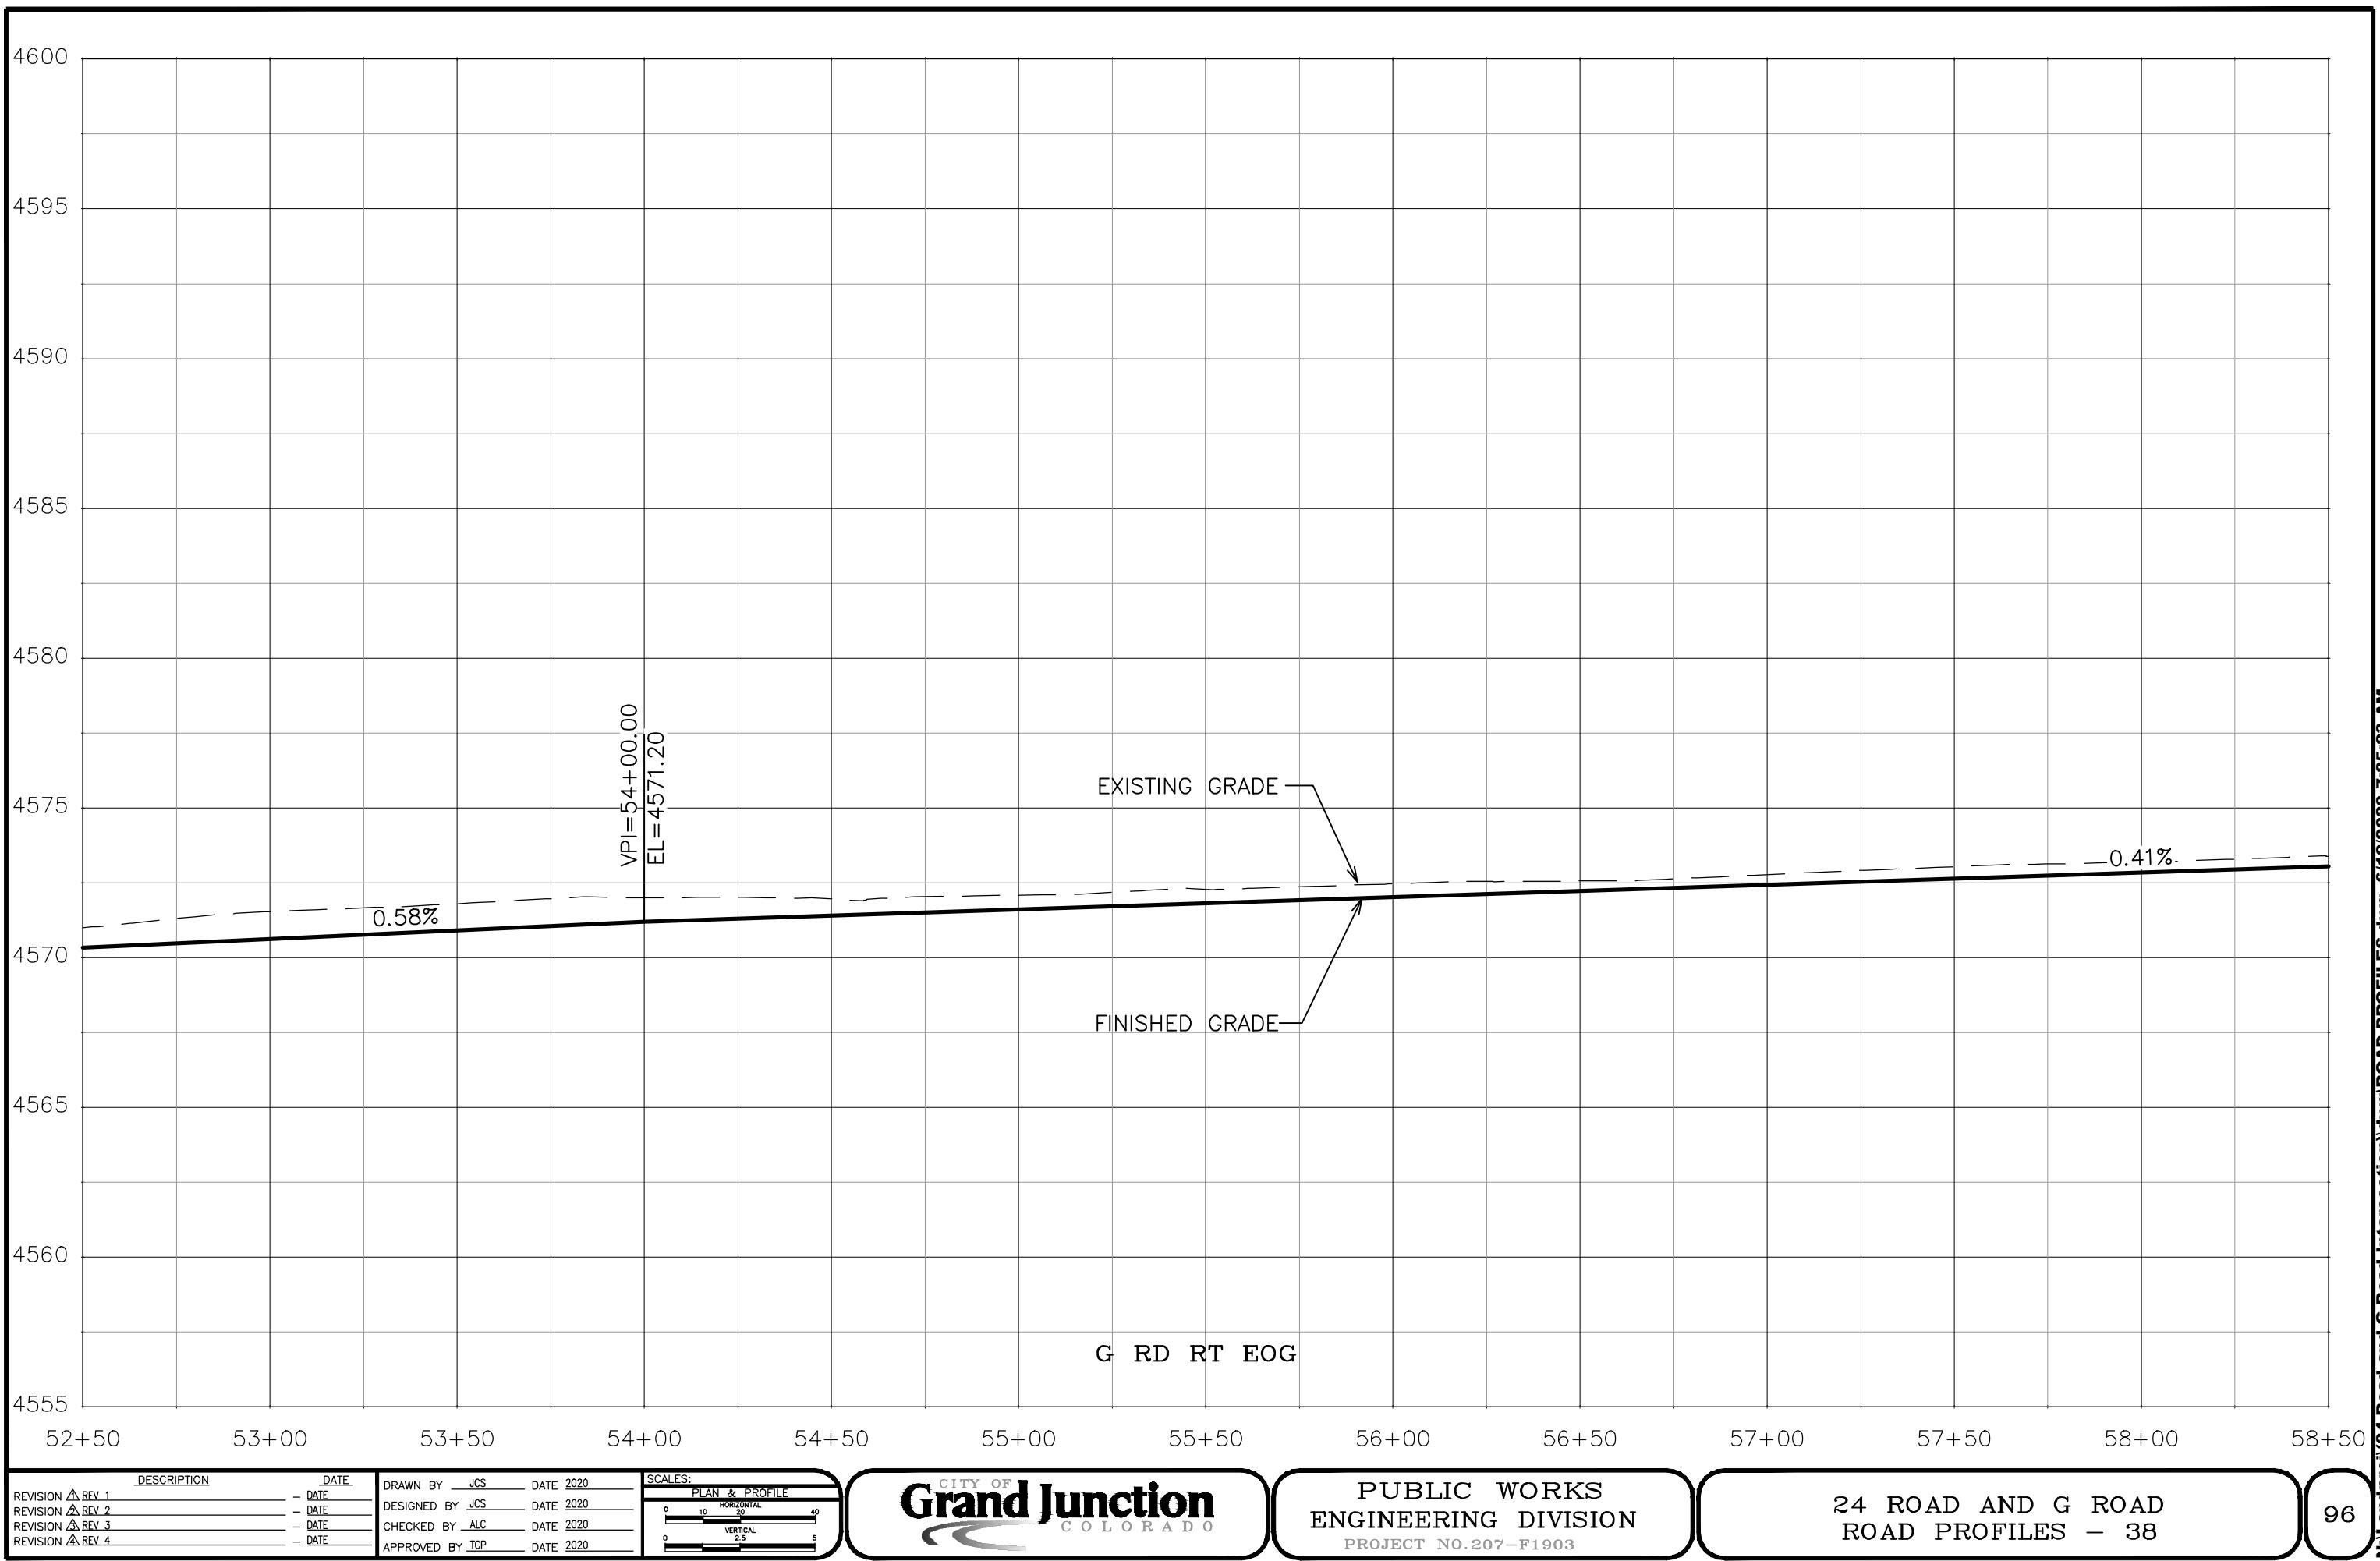

DESCRIPTION	DATE
REVISION ▲ REV 1	- DATE
REVISION ▲ REV 2	- DATE
REVISION ▲ REV 3	- DATE
REVISION ▲ REV 4	- DATE


DRAWN BY	JCS	DATE 2020
DESIGNED BY	JCS	DATE 2020
CHECKED BY	ALC	DATE 2020
APPROVED BY	TCP	DATE 2020

SCALES:		
PLAN & PROFILE		
0	10	20
HORIZONTAL		
0	2.5	5
VERTICAL		



PUBLIC WORKS
 ENGINEERING DIVISION
 PROJECT NO. 207-F1903

24 ROAD AND G ROAD
 ROAD PROFILES - 38

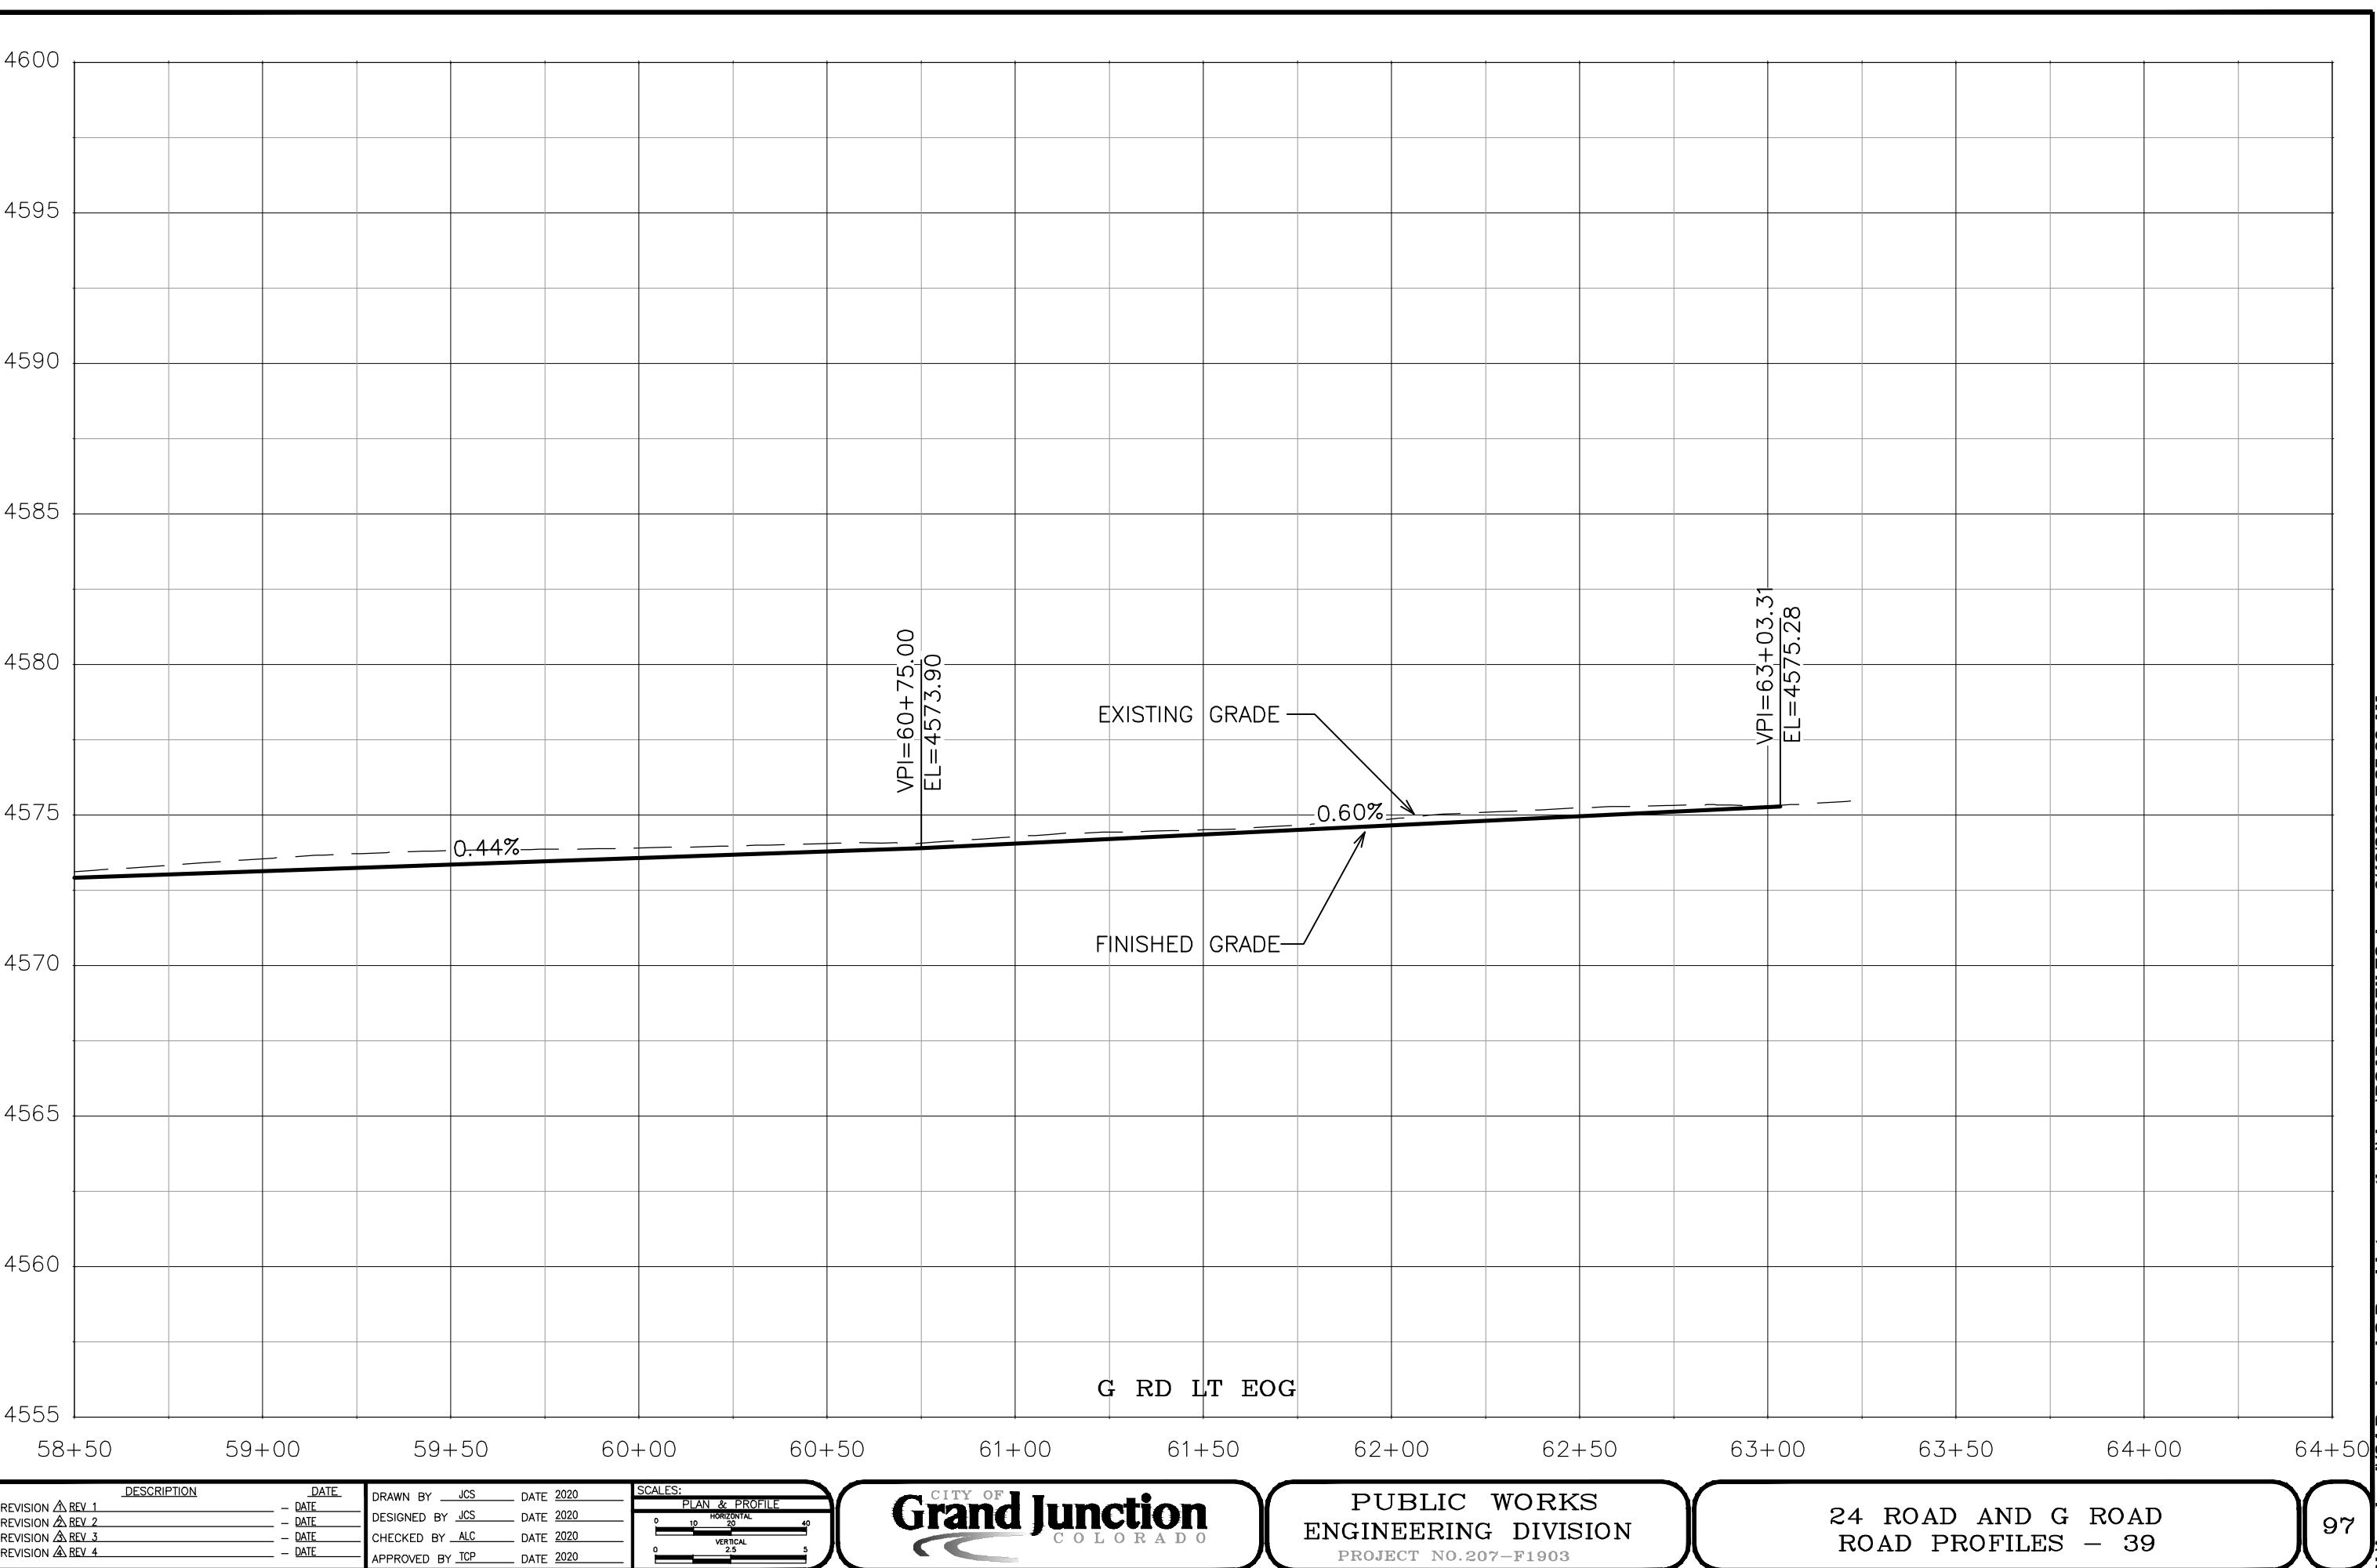

DESCRIPTION	DATE
REVISION ▲ REV 1	- DATE
REVISION ▲ REV 2	- DATE
REVISION ▲ REV 3	- DATE
REVISION ▲ REV 4	- DATE


DRAWN BY	JCS	DATE 2020
DESIGNED BY	JCS	DATE 2020
CHECKED BY	ALC	DATE 2020
APPROVED BY	TCP	DATE 2020

SCALES:		
PLAN & PROFILE		
0	10	20
HORIZONTAL		
0	2.5	5
VERTICAL		



PUBLIC WORKS
ENGINEERING DIVISION
PROJECT NO. 207-F1903

24 ROAD AND G ROAD
ROAD PROFILES - 39

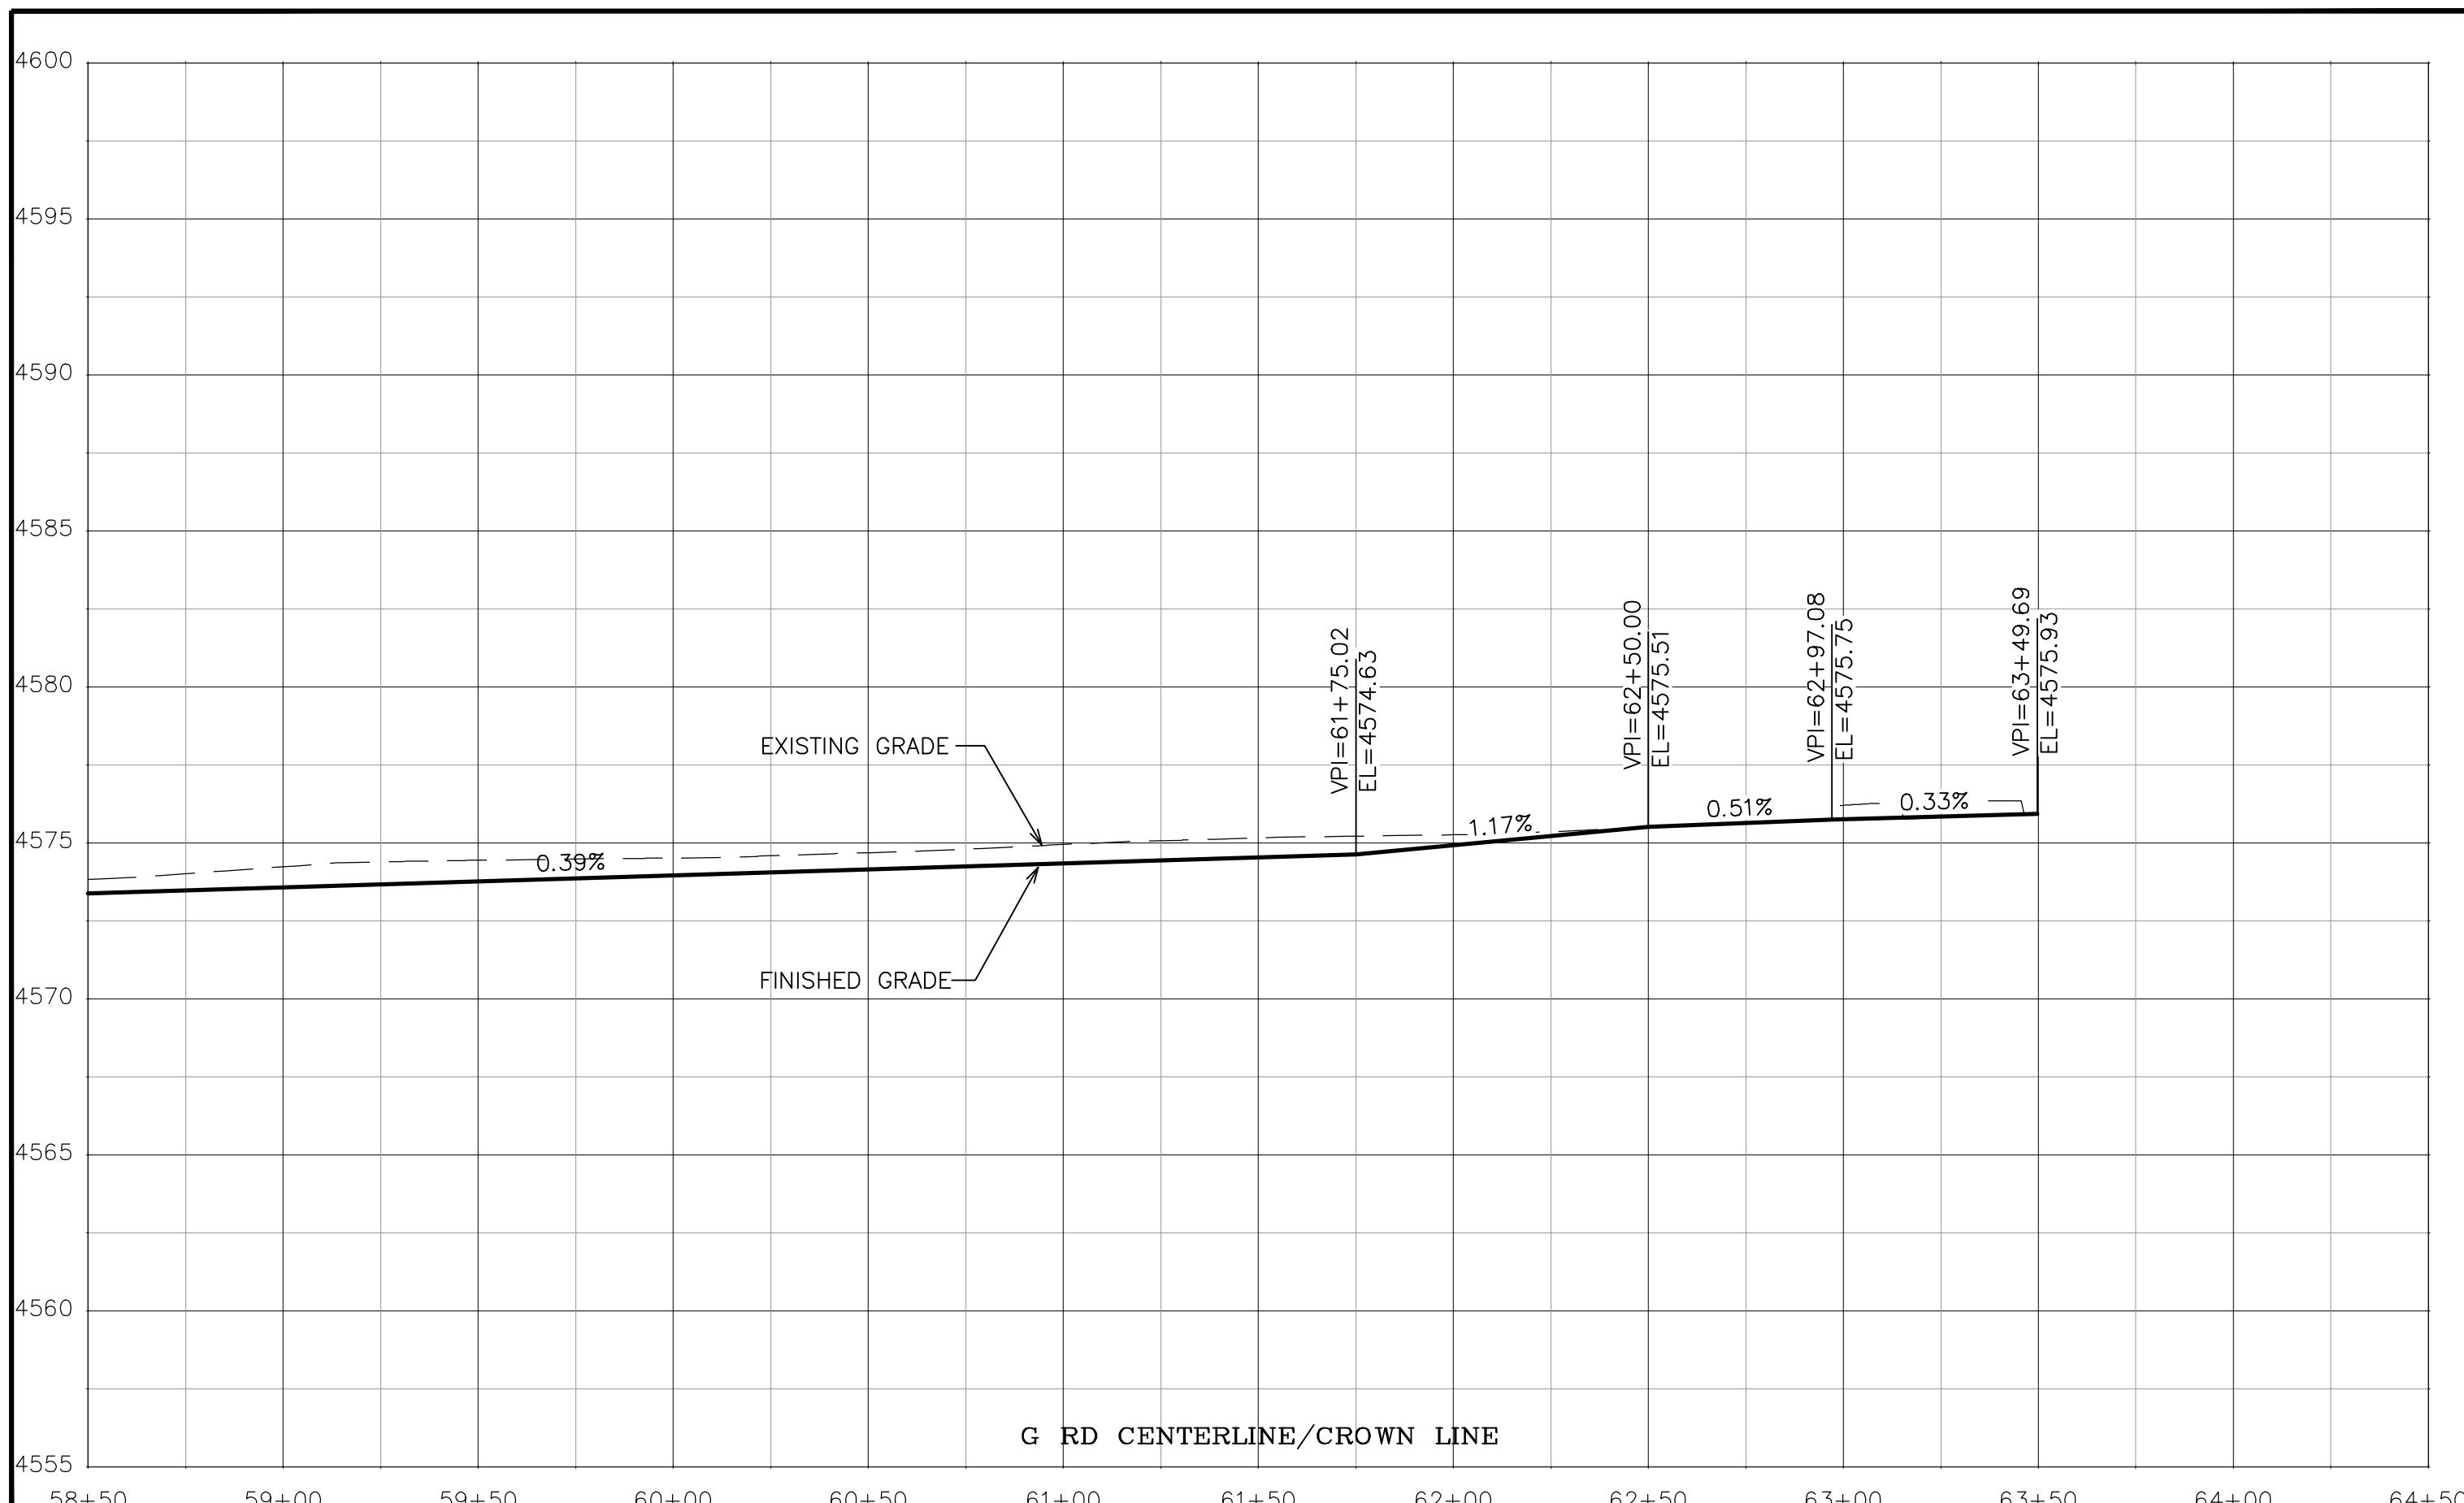

DESCRIPTION DATE
 REVISION ▲ REV 1 - DATE
 REVISION ▲ REV 2 - DATE
 REVISION ▲ REV 3 - DATE
 REVISION ▲ REV 4 - DATE


DRAWN BY JCS DATE 2020
 DESIGNED BY JCS DATE 2020
 CHECKED BY ALC DATE 2020
 APPROVED BY TCP DATE 2020

SCALES:
 PLAN & PROFILE
 HORIZONTAL 10 20 40
 VERTICAL 2.5 5



PUBLIC WORKS
 ENGINEERING DIVISION
 PROJECT NO. 207-F1903

24 ROAD AND G ROAD
 ROAD PROFILES - 40

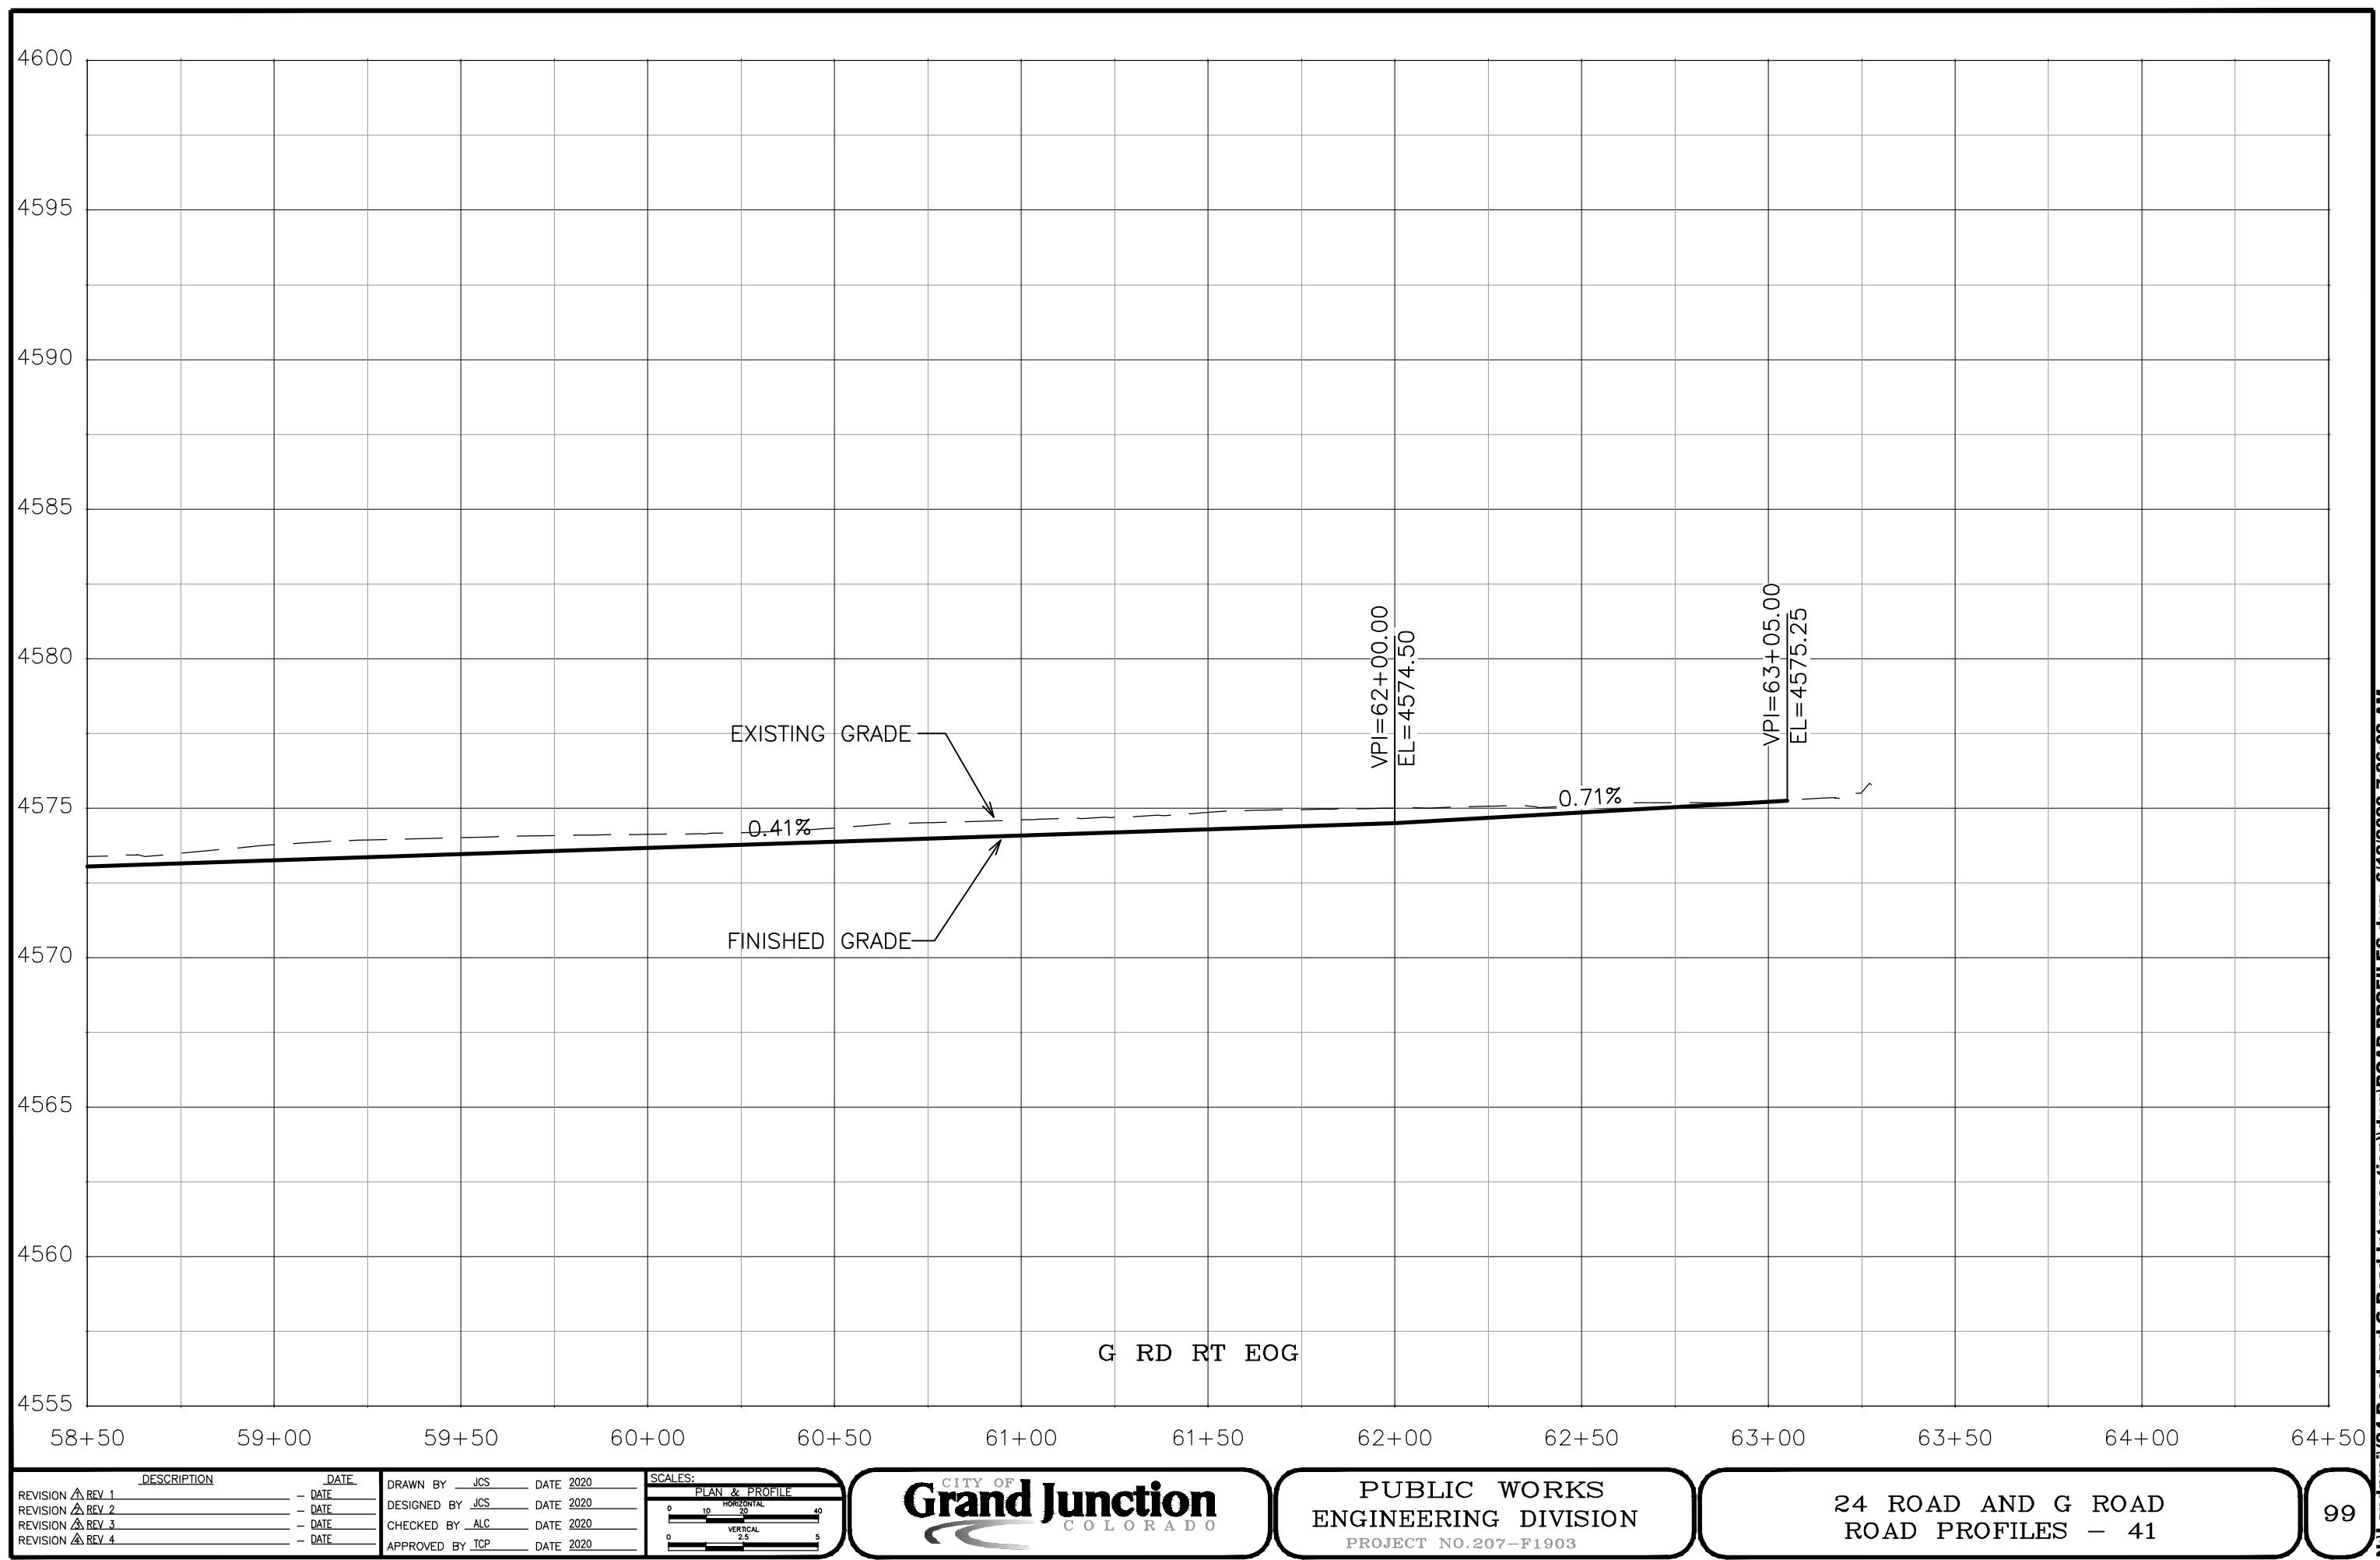

DESCRIPTION	DATE
REVISION ▲ REV 1	- DATE
REVISION ▲ REV 2	- DATE
REVISION ▲ REV 3	- DATE
REVISION ▲ REV 4	- DATE











DRAWN BY	JCS	DATE 2020
DESIGNED BY	JCS	DATE 2020
CHECKED BY	ALC	DATE 2020
APPROVED BY	TCP	DATE 2020

SCALES:		
PLAN & PROFILE		
0	10	20
HORIZONTAL		
0	2.5	5
VERTICAL		



PUBLIC WORKS
ENGINEERING DIVISION
PROJECT NO. 207-F1903

24 ROAD AND G ROAD
ROAD PROFILES - 41

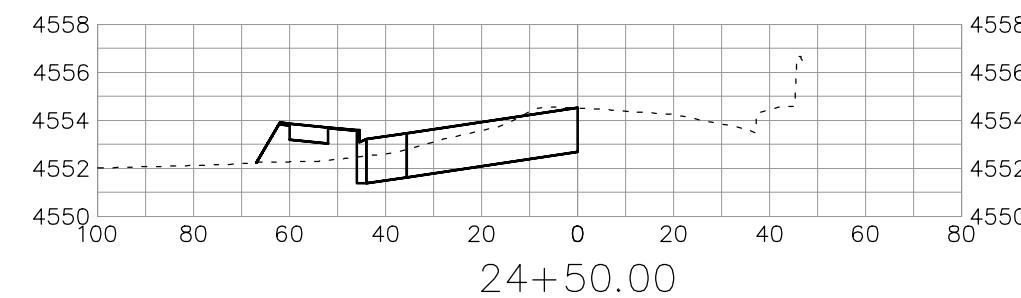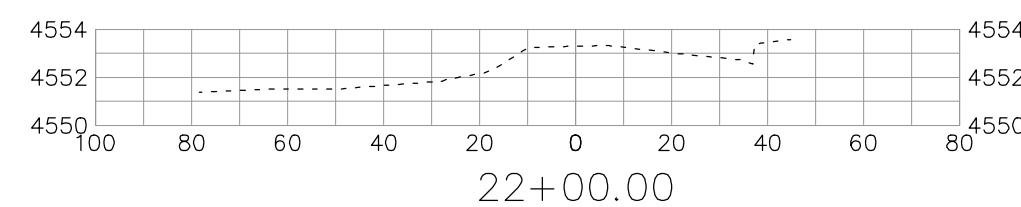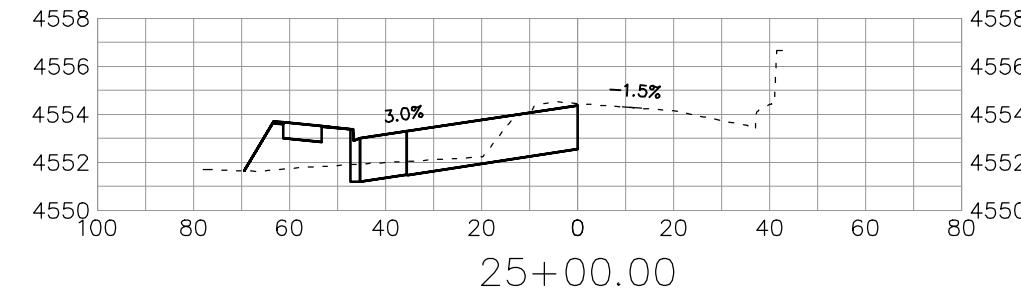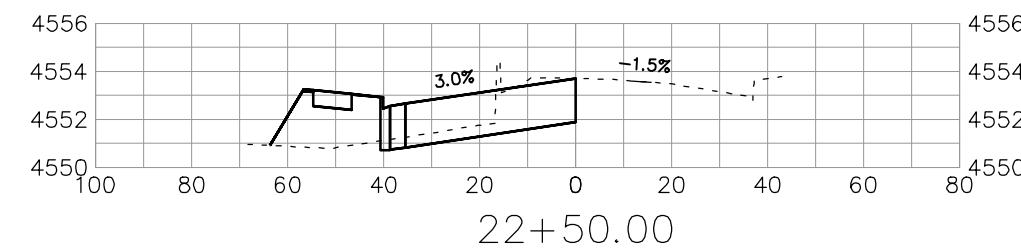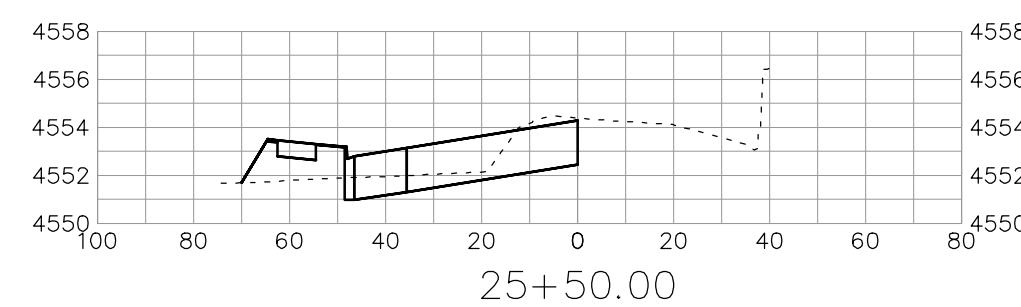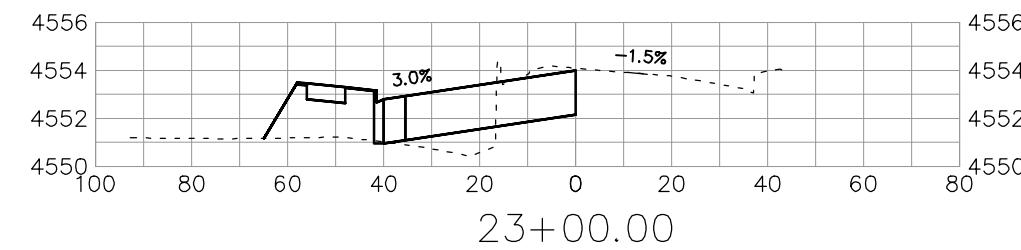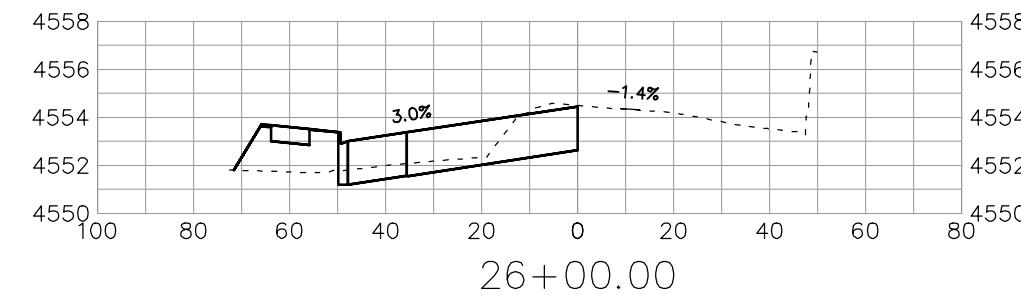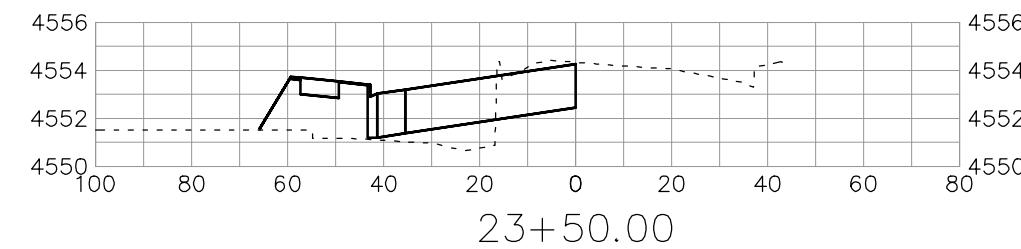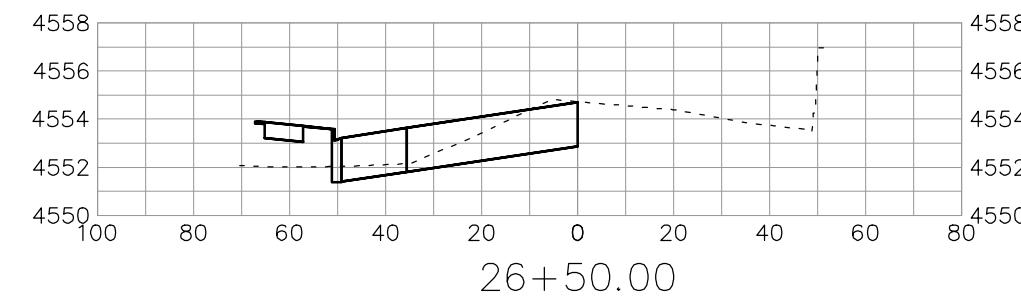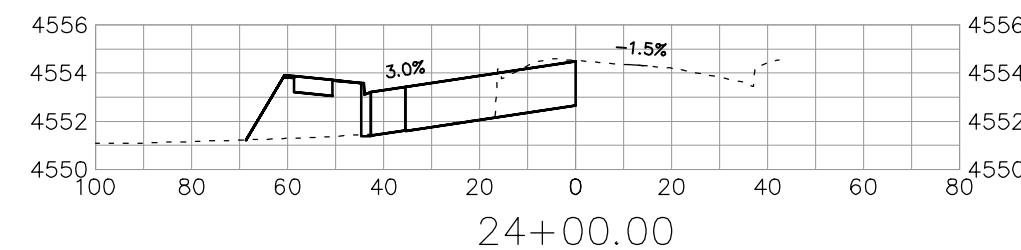

DESCRIPTION	DATE
REVISION ▲ REV 1	- DATE
REVISION ▲ REV 2	- DATE
REVISION ▲ REV 3	- DATE
REVISION ▲ REV 4	- DATE

DRAWN BY JCS DATE 2020
DESIGNED BY JCS DATE 2020
CHECKED BY ALC DATE 2020
APPROVED BY TCP DATE 2020









SCALES:
PLAN & PROFILE
0 10 20 40
HORIZONTAL
0 4 8
VERTICAL



PUBLIC WORKS
ENGINEERING DIVISION
PROJECT NO. 207-F1903

24 ROAD AND G ROAD
ROAD CROSS SECTIONS - 24 RD 1

100

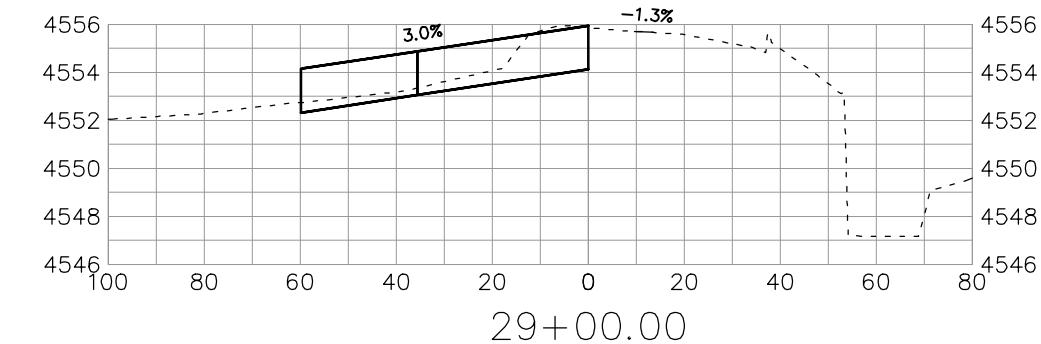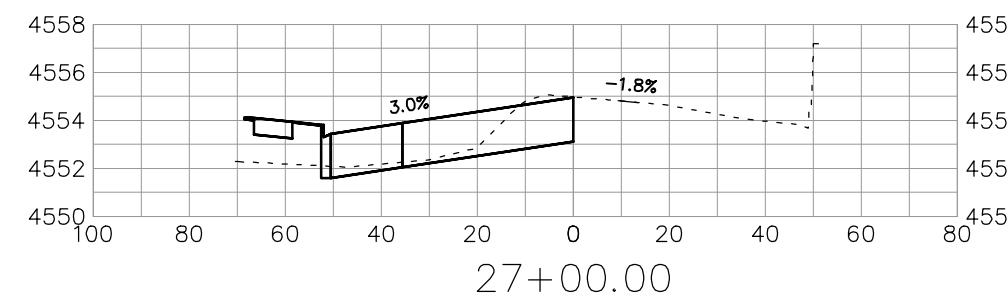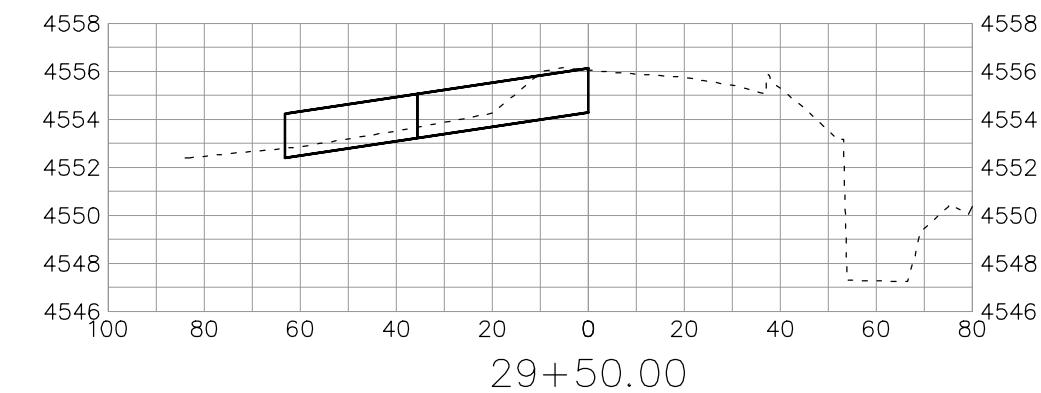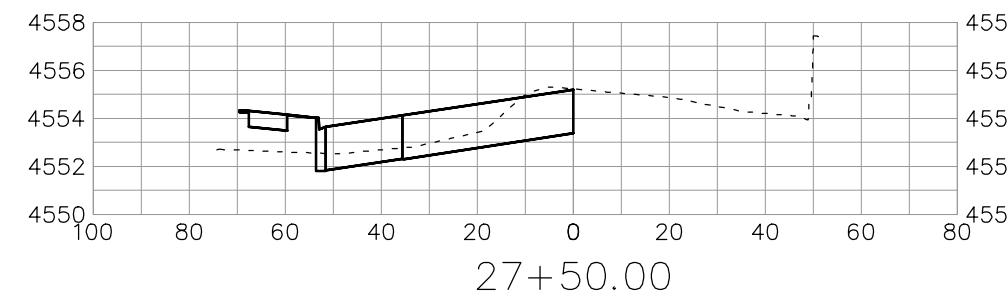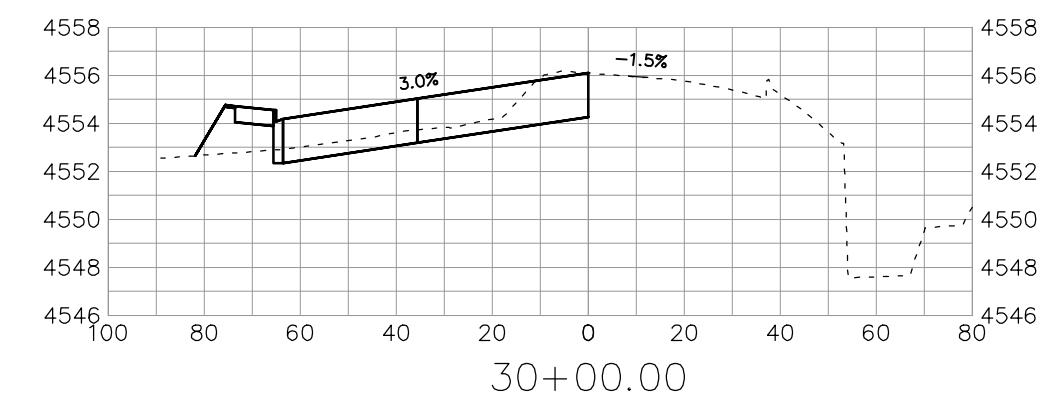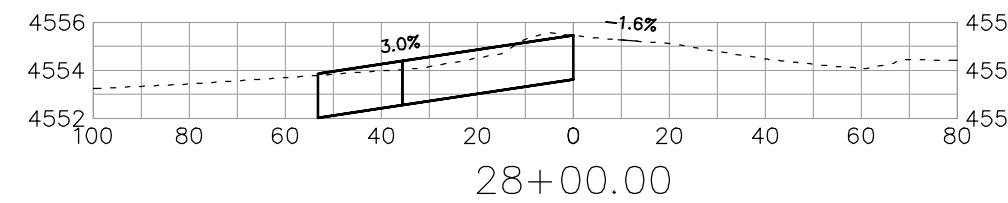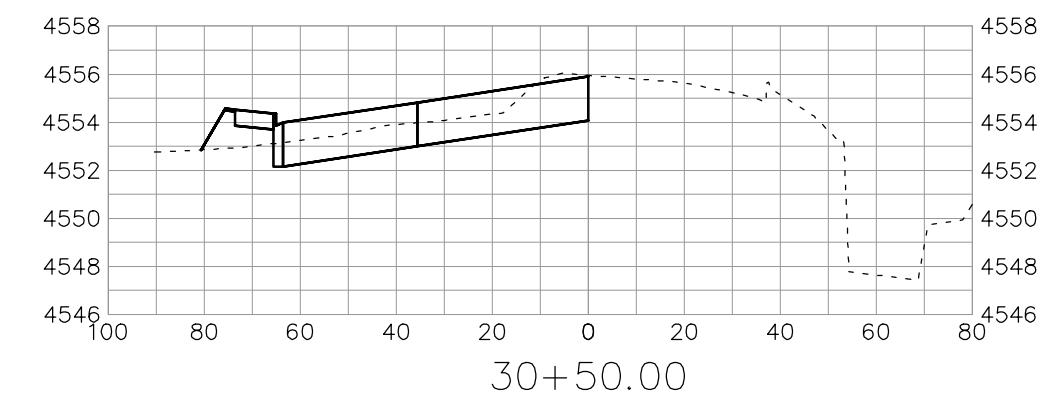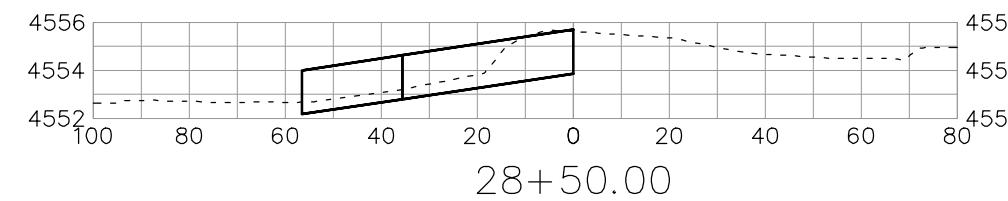

DESCRIPTION	DATE
REVISION ▲ REV 1	- DATE
REVISION ▲ REV 2	- DATE
REVISION ▲ REV 3	- DATE
REVISION ▲ REV 4	- DATE













DRAWN BY	JCS	DATE 2020
DESIGNED BY	JCS	DATE 2020
CHECKED BY	ALC	DATE 2020
APPROVED BY	TCP	DATE 2020

SCALES:	PLAN & PROFILE		
0	10	20	40
	HORIZONTAL		
0	4	8	12
	VERTICAL		



PUBLIC WORKS
ENGINEERING DIVISION
PROJECT NO. 207-F1903

24 ROAD AND G ROAD
ROAD CROSS SECTIONS — 24 RD 2

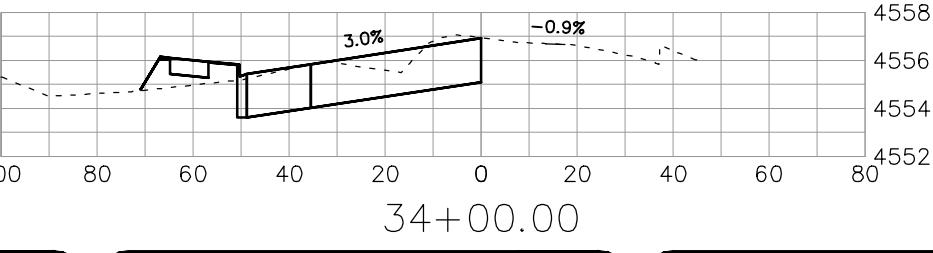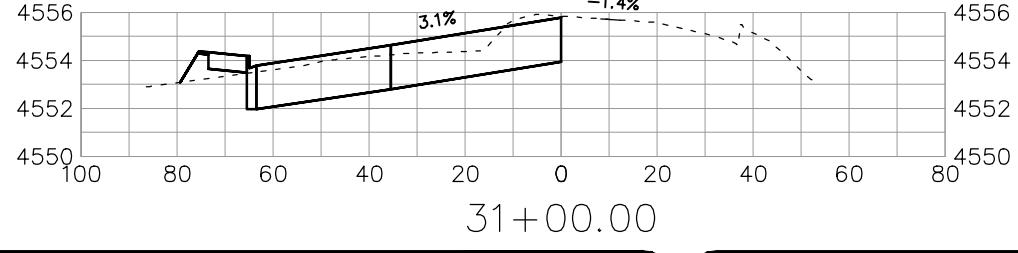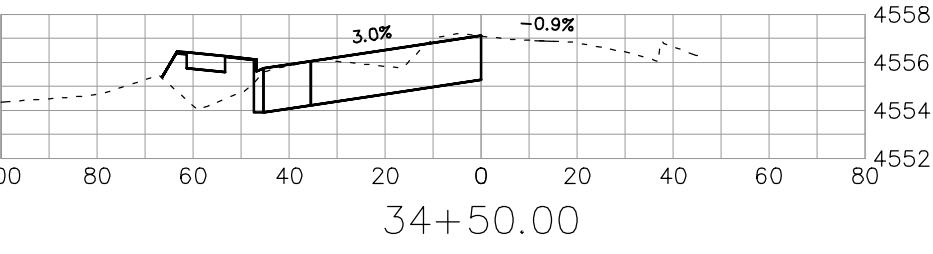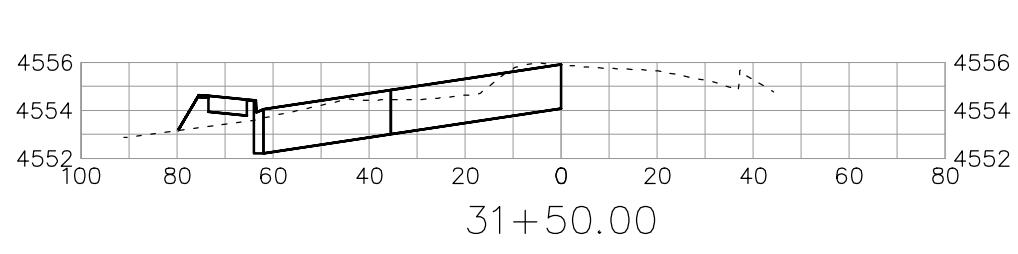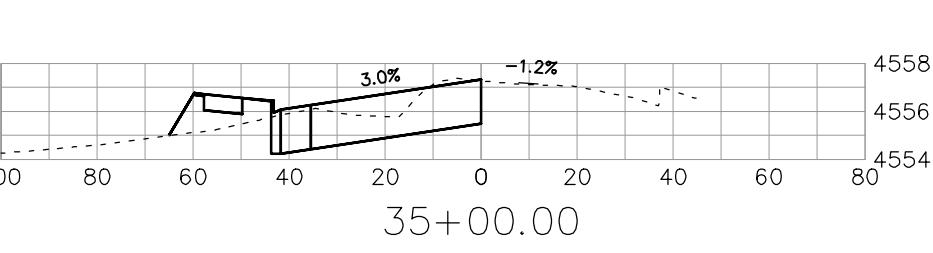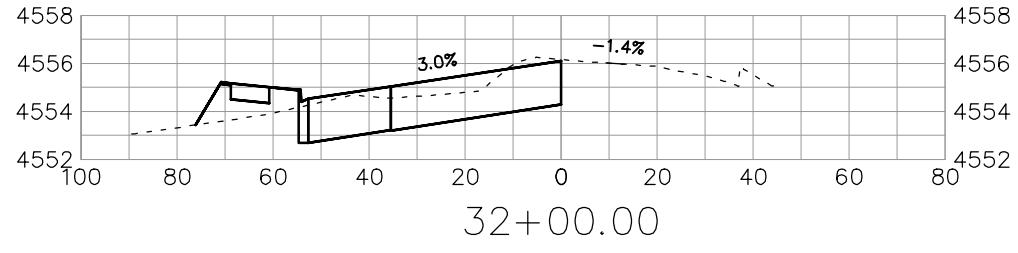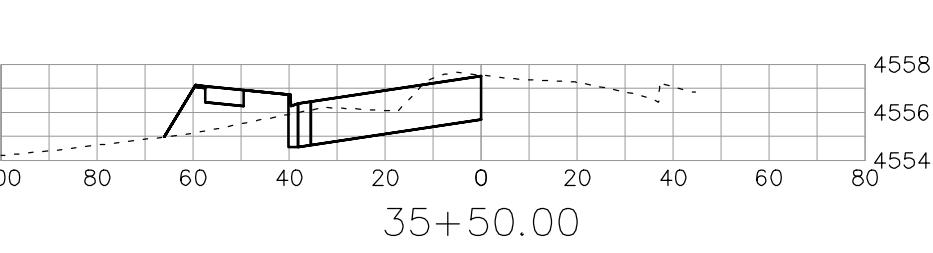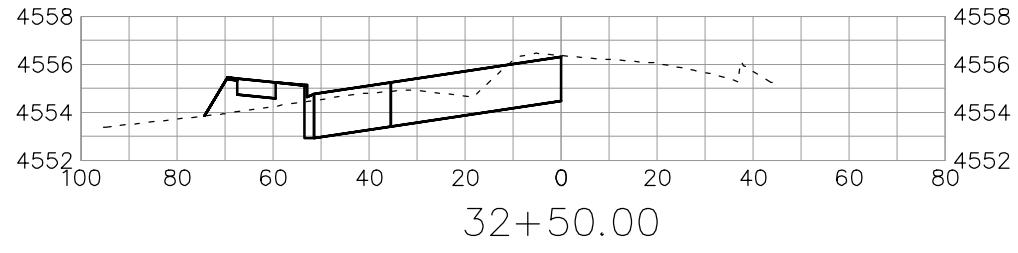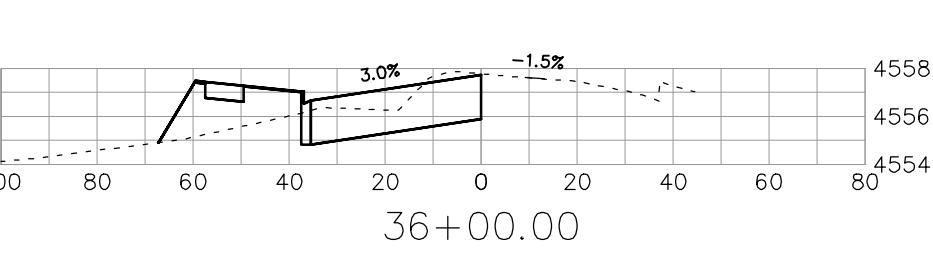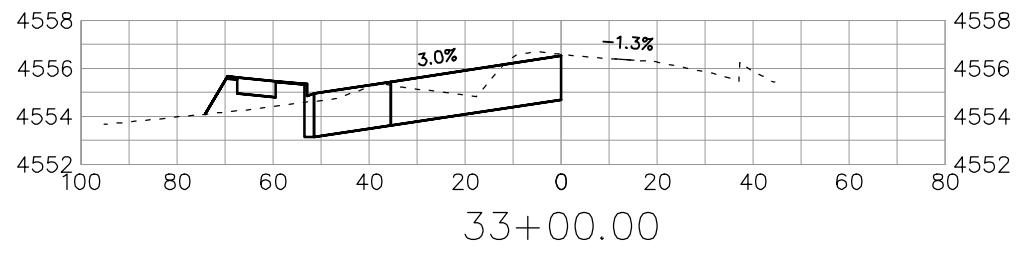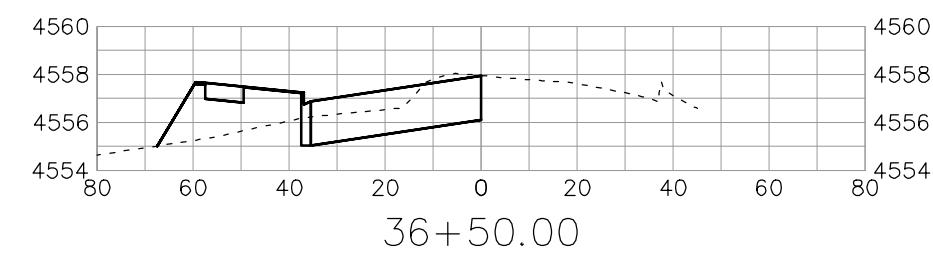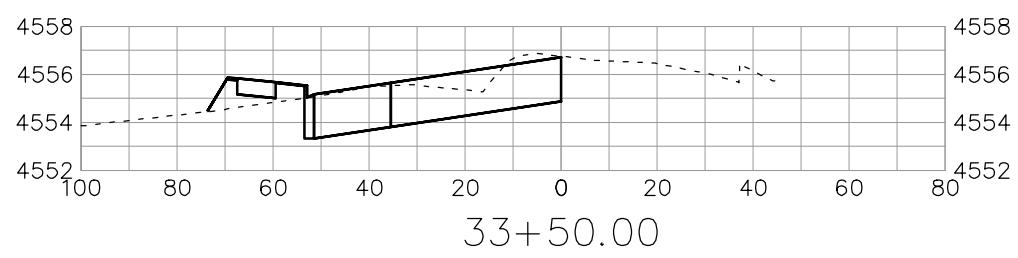

DESCRIPTION	DATE
REVISION ▲ REV 1	- DATE
REVISION ▲ REV 2	- DATE
REVISION ▲ REV 3	- DATE
REVISION ▲ REV 4	- DATE


DRAWN BY JCS DATE 2020
 DESIGNED BY JCS DATE 2020
 CHECKED BY ALC DATE 2020
 APPROVED BY TCP DATE 2020

SCALES:
 PLAN & PROFILE
 HORIZONTAL
 0 10 20 40
 VERTICAL
 0 4 8



PUBLIC WORKS
 ENGINEERING DIVISION
 PROJECT NO. 207-F1903

24 ROAD AND G ROAD
 ROAD CROSS SECTIONS — 24 RD 3

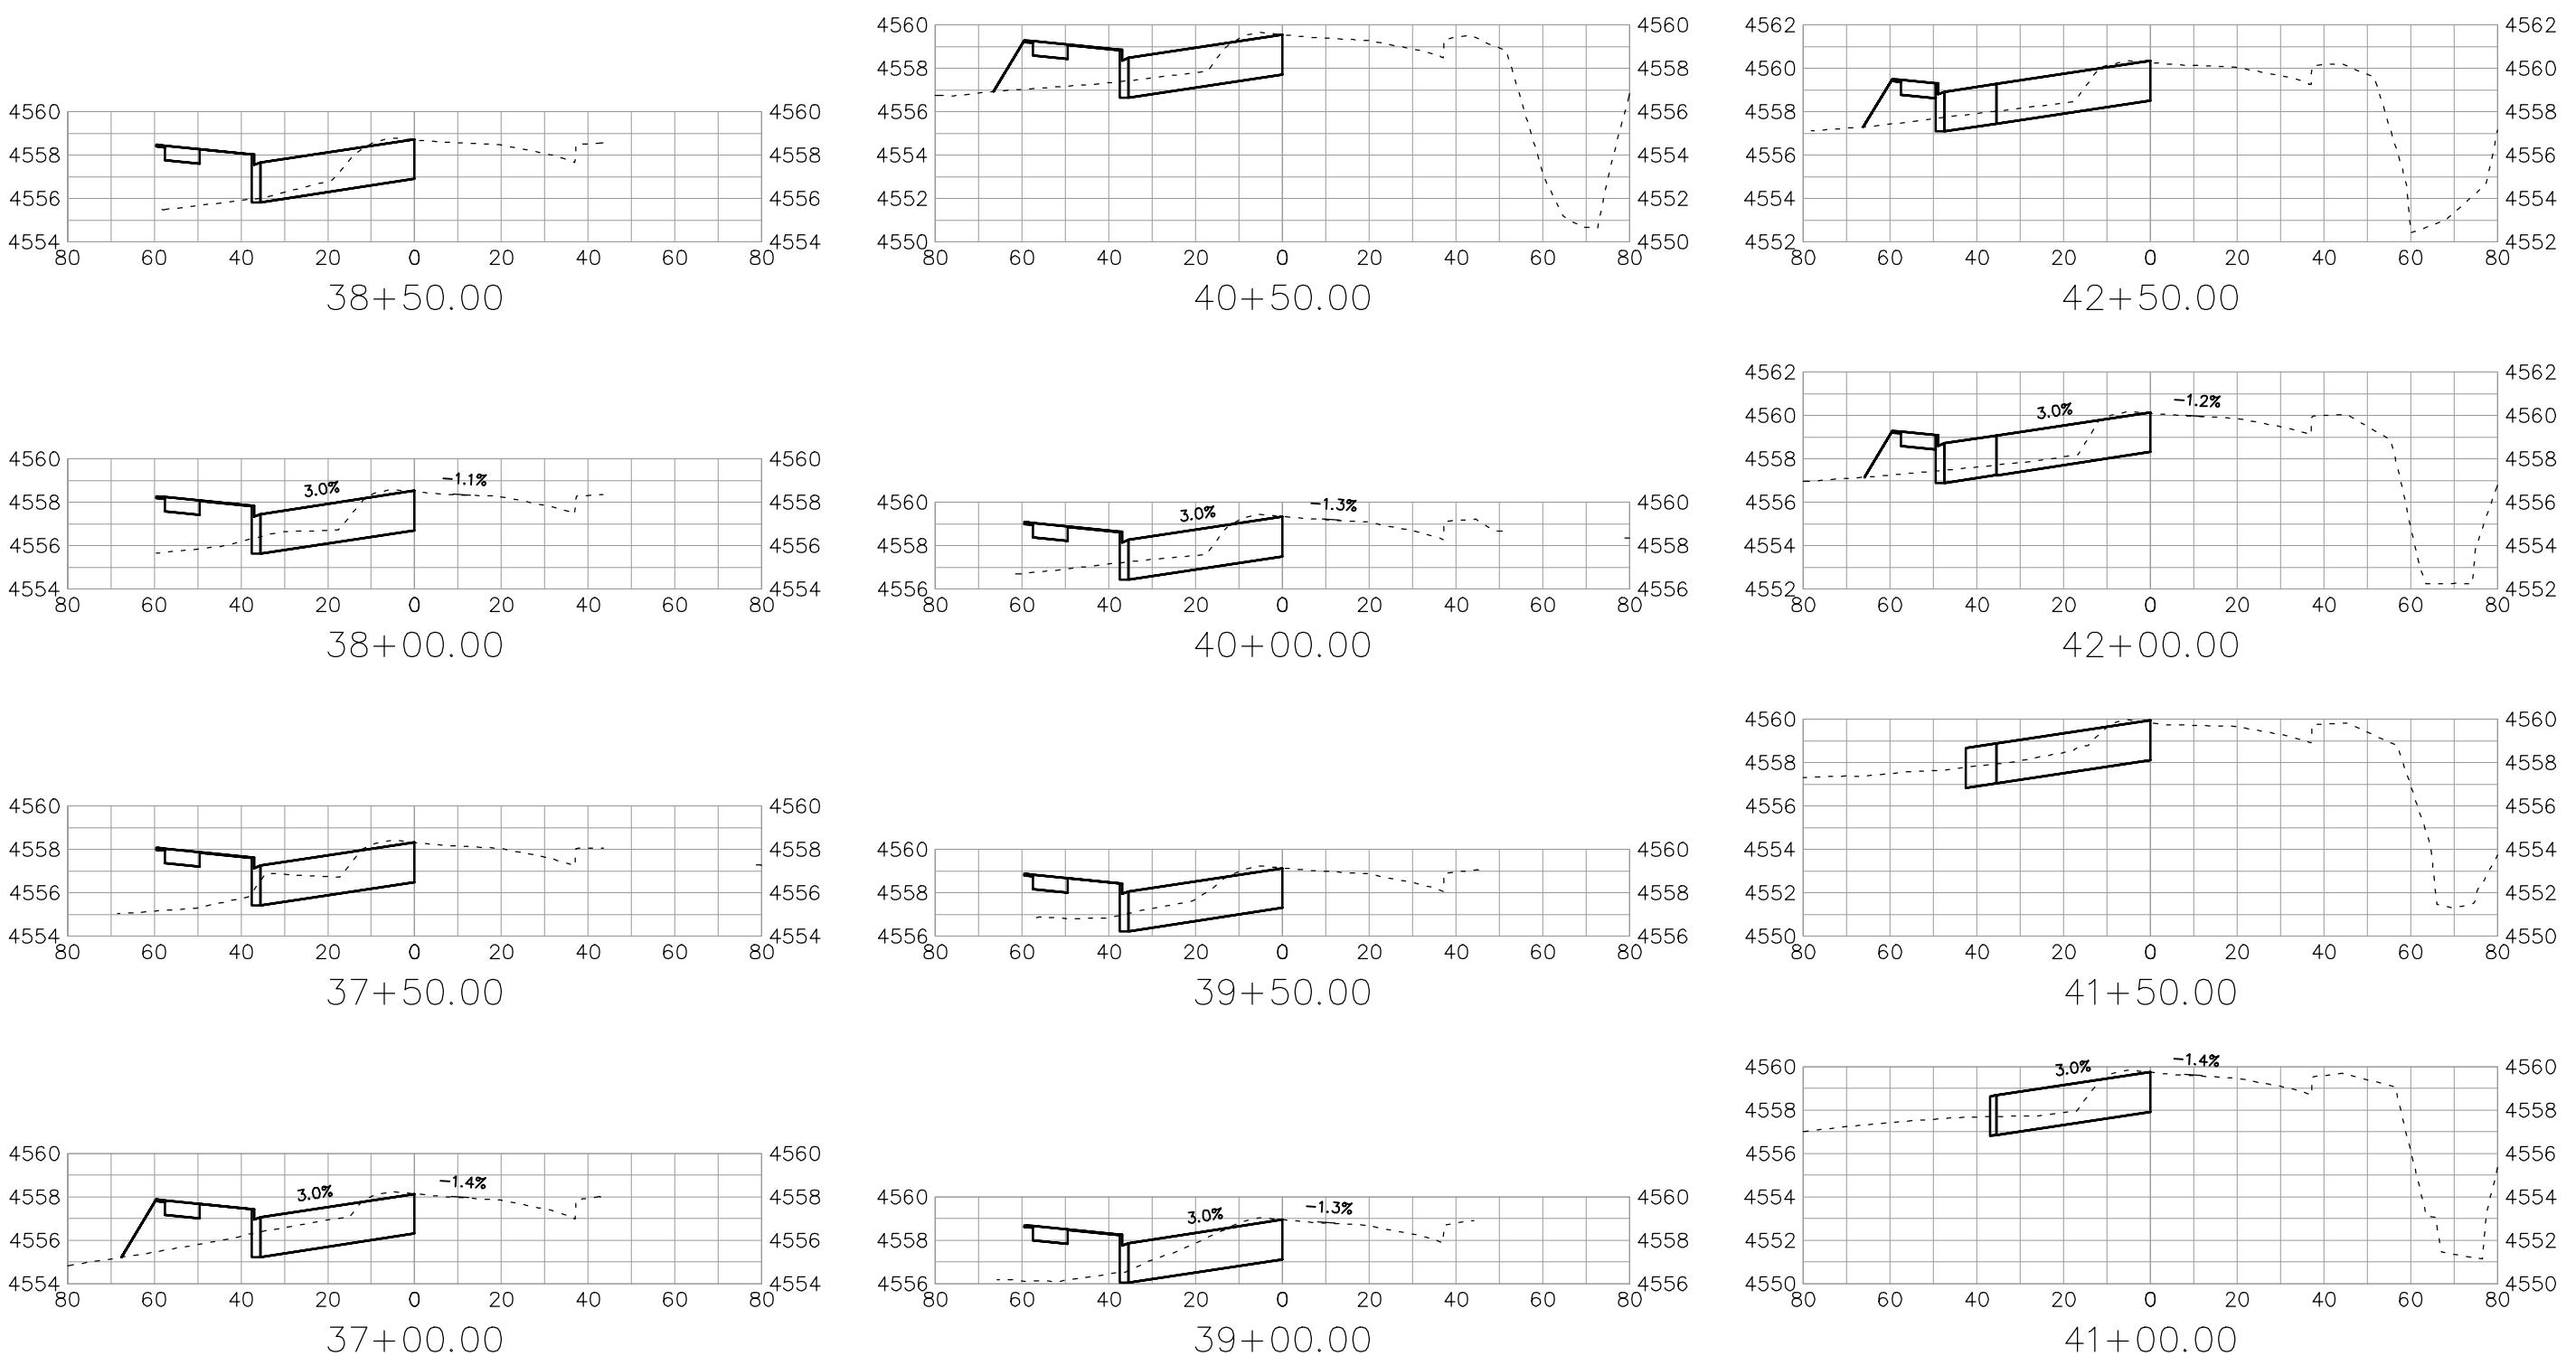

REVISION ▲ REV 1	DESCRIPTION	DATE
REVISION ▲ REV 2		
REVISION ▲ REV 3		
REVISION ▲ REV 4		
















DRAWN BY JCS	DATE 2020
DESIGNED BY JCS	DATE 2020
CHECKED BY ALC	DATE 2020
APPROVED BY TCP	DATE 2020

SCALES:
PLAN & PROFILE
0 10 20 40
HORIZONTAL
0 4
VERTICAL



PUBLIC WORKS
ENGINEERING DIVISION
PROJECT NO. 207-F1903

24 ROAD AND G ROAD
ROAD CROSS SECTIONS — 24 RD 4

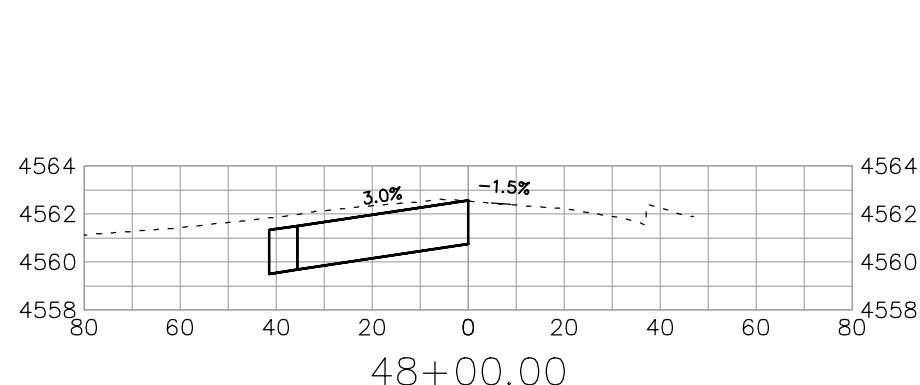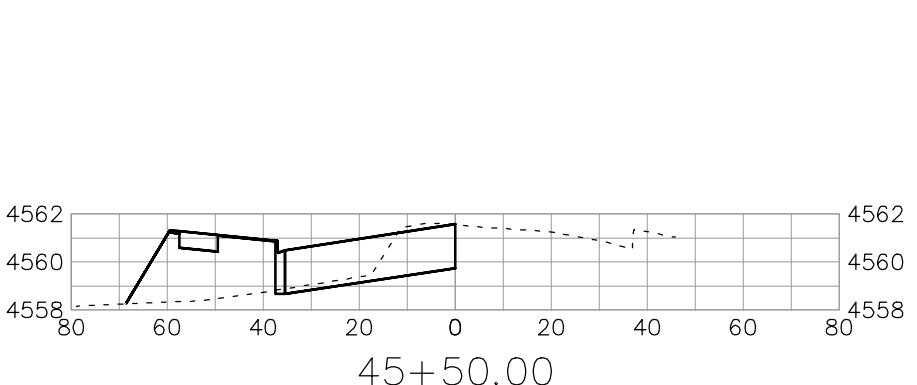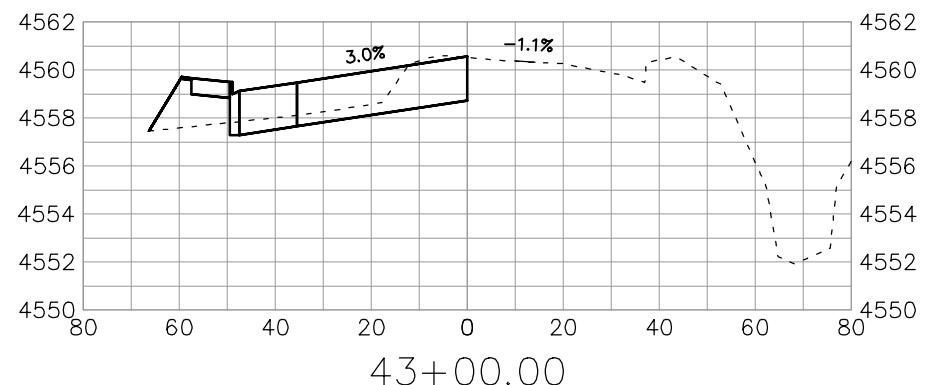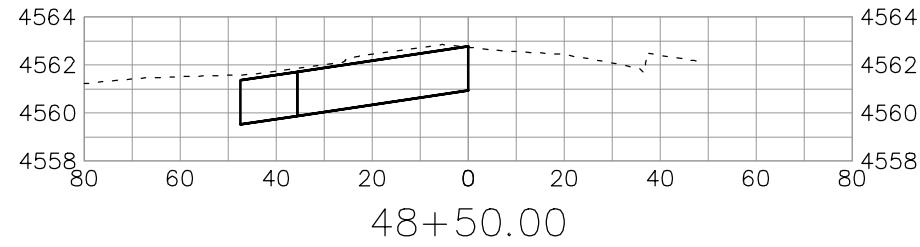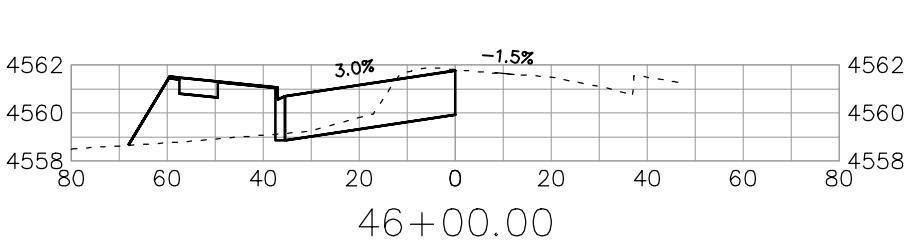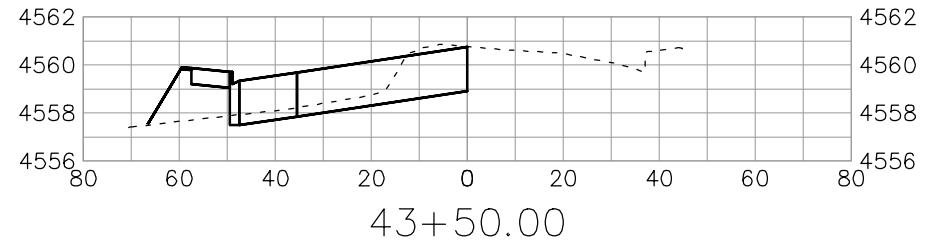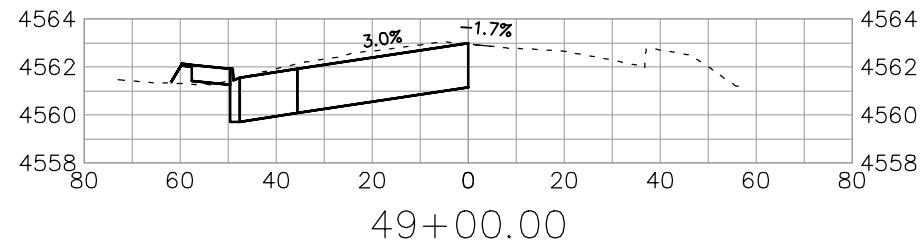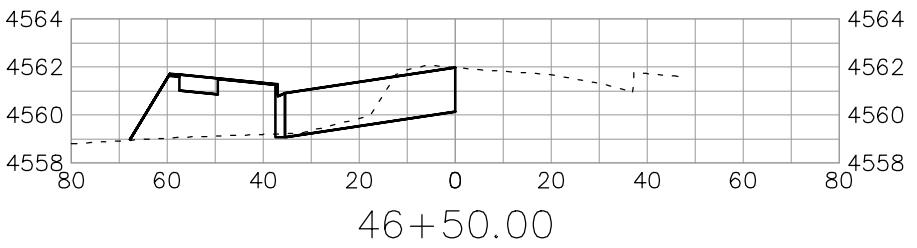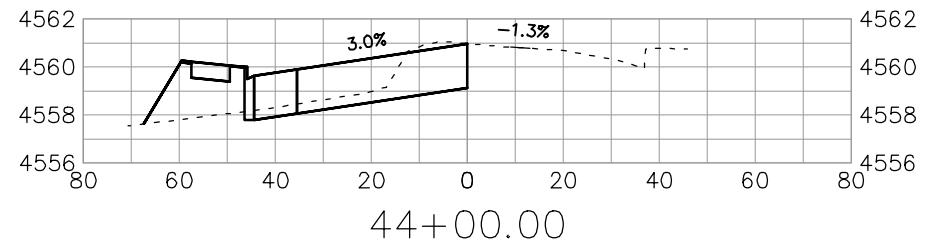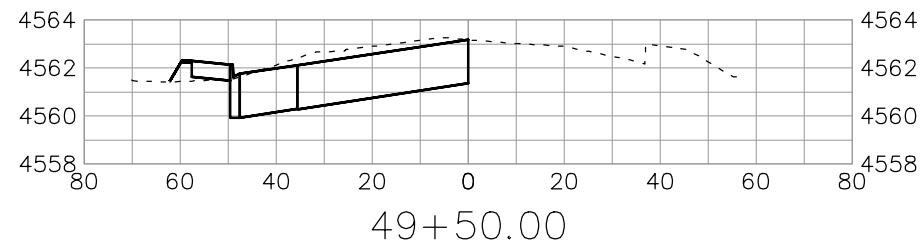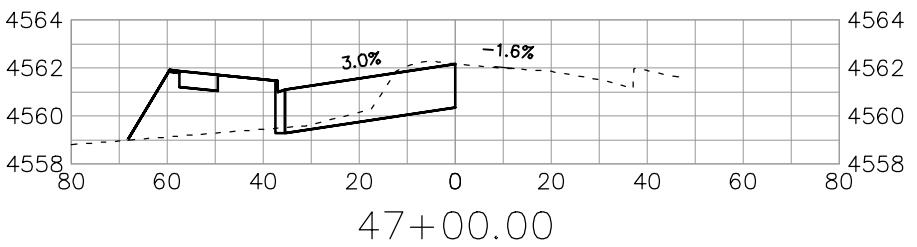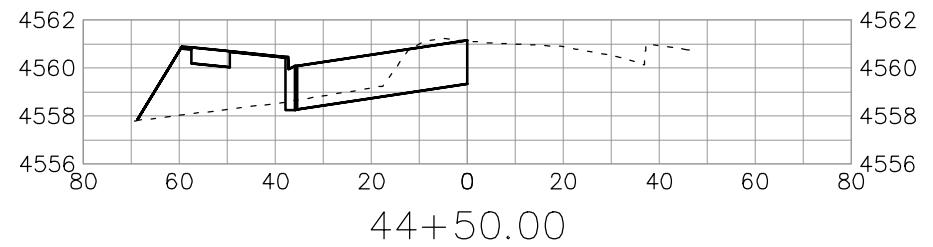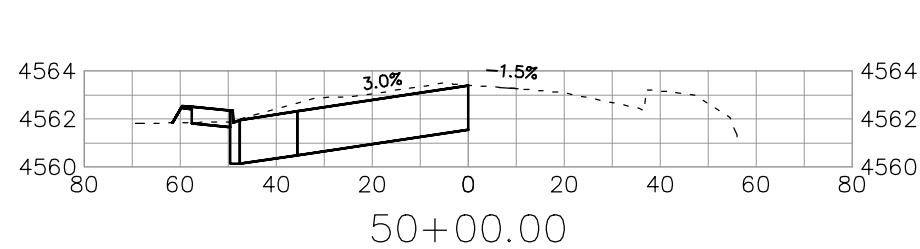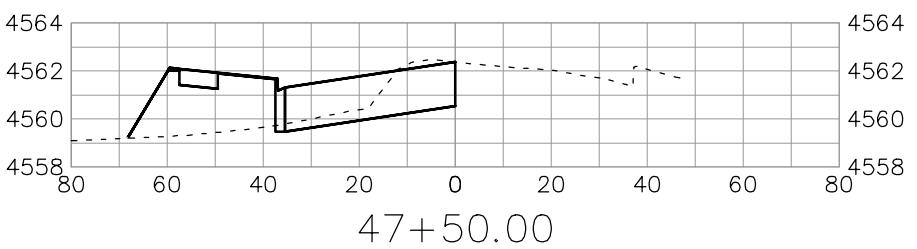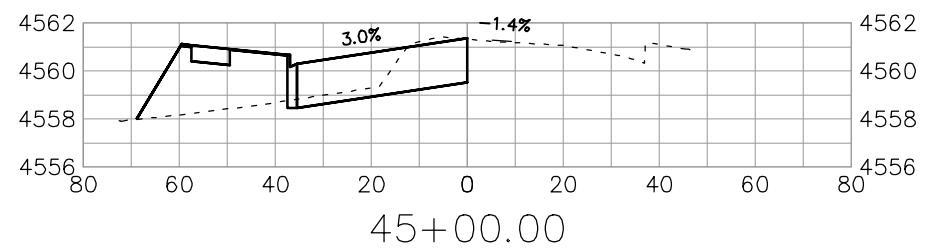

REVISION ▲ REV 1	DESCRIPTION	DATE
REVISION ▲ REV 2		
REVISION ▲ REV 3		
REVISION ▲ REV 4		










DRAWN BY JCS DATE 2020
DESIGNED BY JCS DATE 2020
CHECKED BY ALC DATE 2020
APPROVED BY TCP DATE 2020

SCALES:
PLAN & PROFILE
0 10 20 40
HORIZONTAL
0 4 8
VERTICAL



PUBLIC WORKS
ENGINEERING DIVISION
PROJECT NO. 207-F1903

24 ROAD AND G ROAD
ROAD CROSS SECTIONS — 24 RD 5

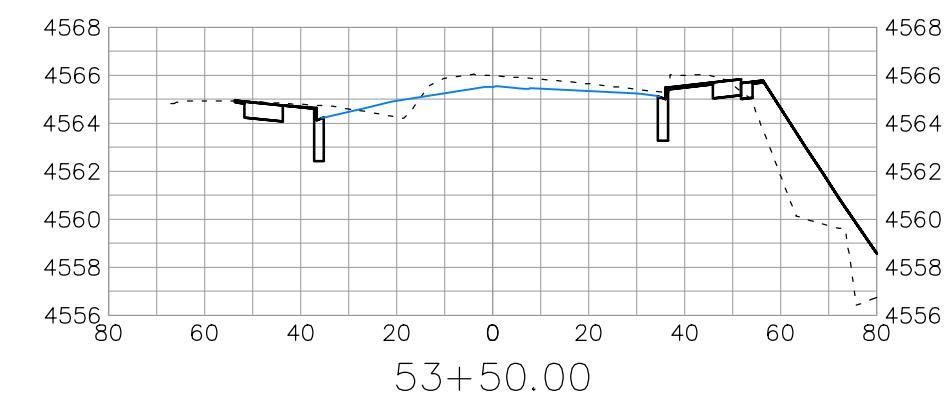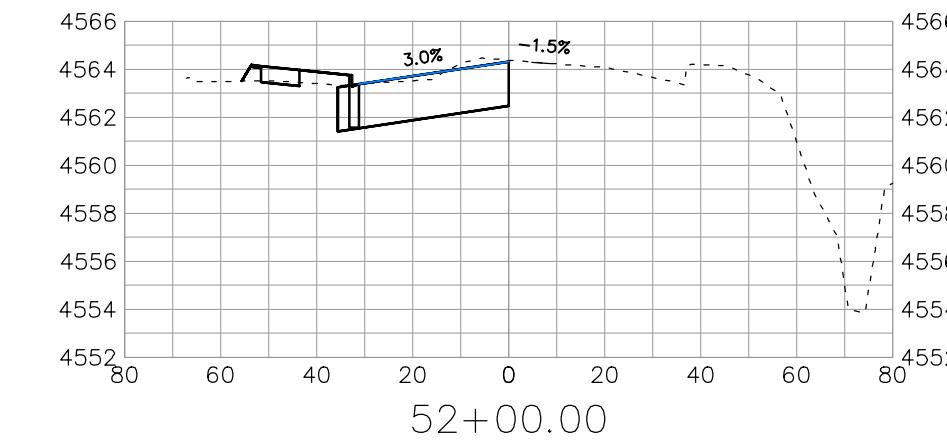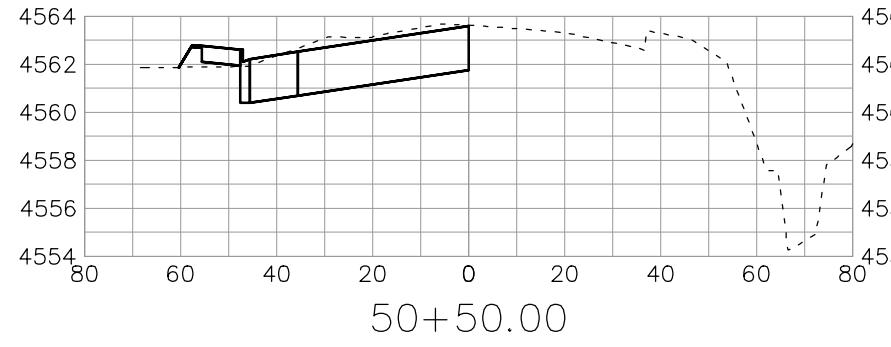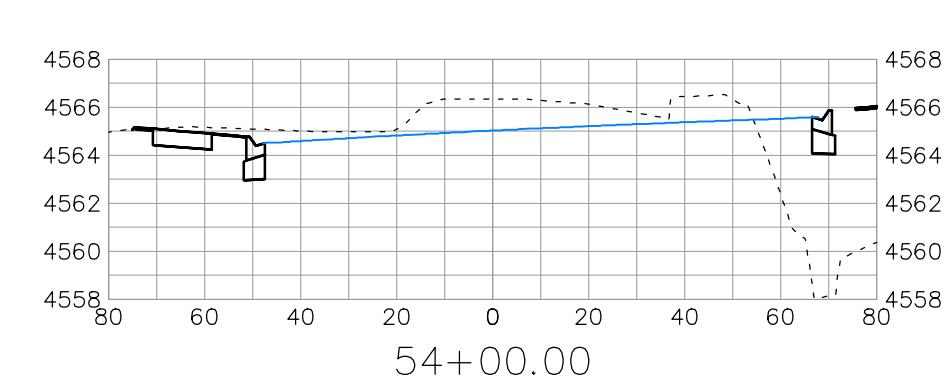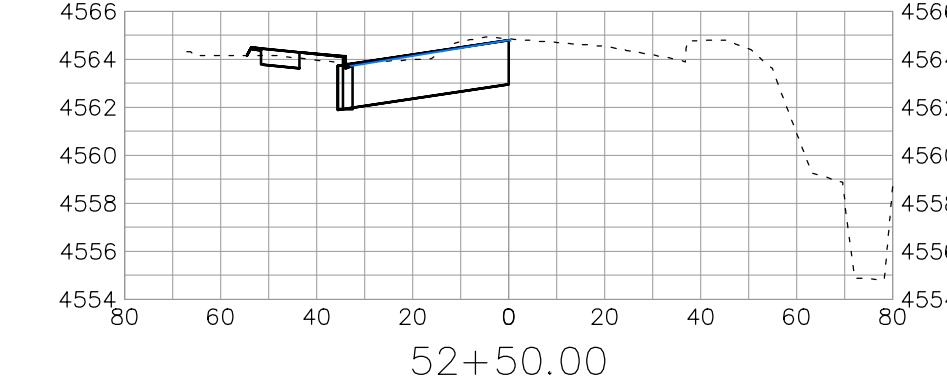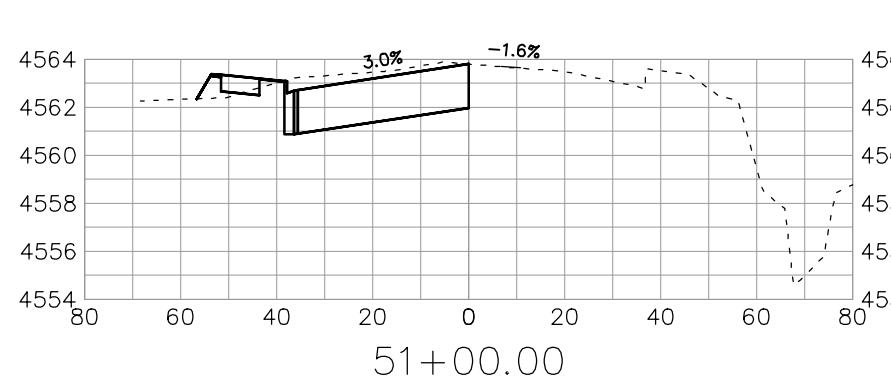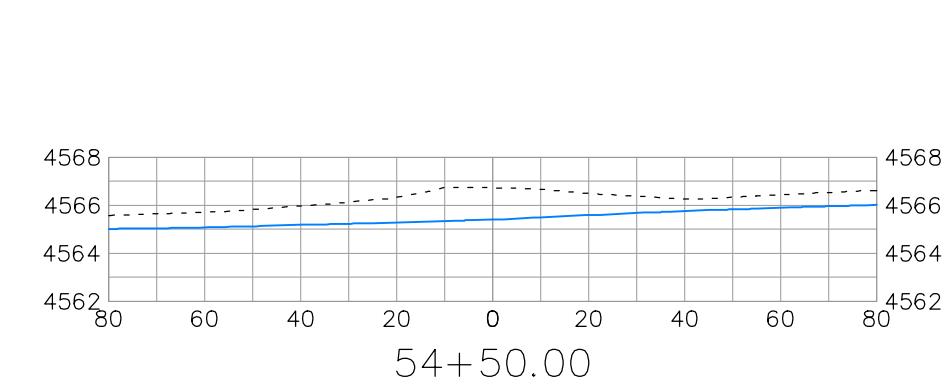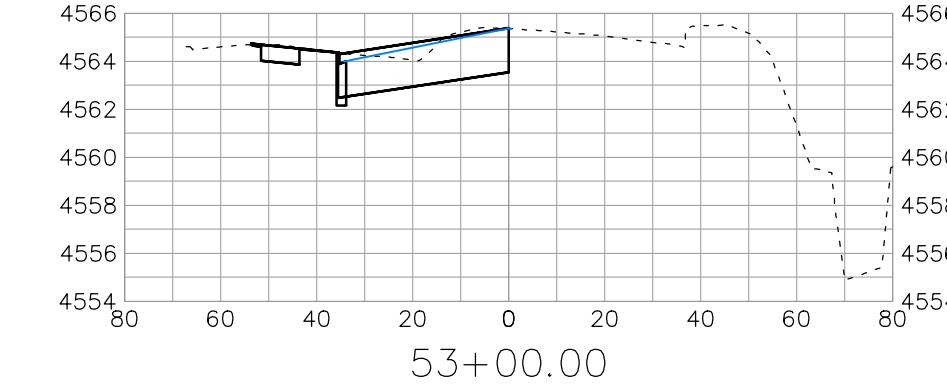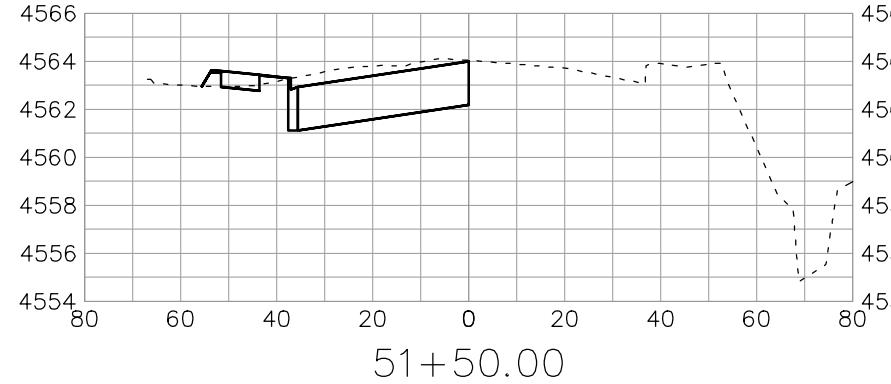

REVISION ▲ REV 1	DESCRIPTION	DATE
REVISION ▲ REV 2		
REVISION ▲ REV 3		
REVISION ▲ REV 4		













DRAWN BY JCS DATE 2020
DESIGNED BY JCS DATE 2020
CHECKED BY ALC DATE 2020
APPROVED BY TCP DATE 2020

SCALES:
PLAN & PROFILE
0 10 20 40
HORIZONTAL
0 4 8
VERTICAL



PUBLIC WORKS
ENGINEERING DIVISION
PROJECT NO. 207-F1903

24 ROAD AND G ROAD
ROAD CROSS SECTIONS — 24 RD 6

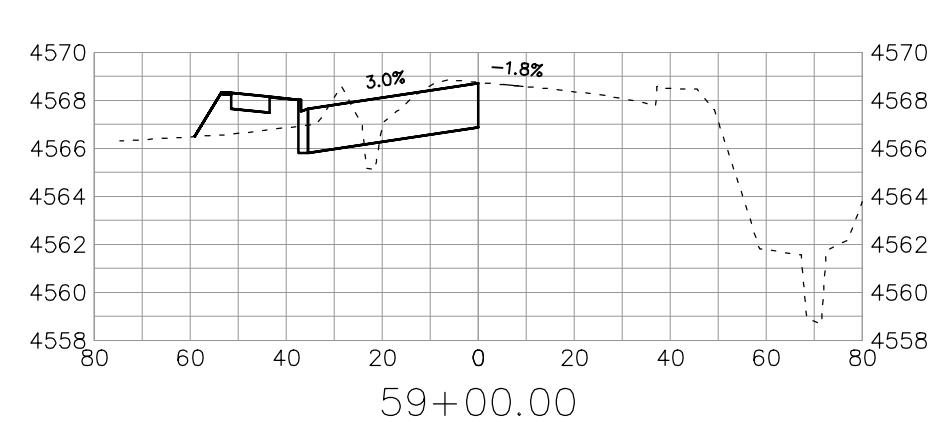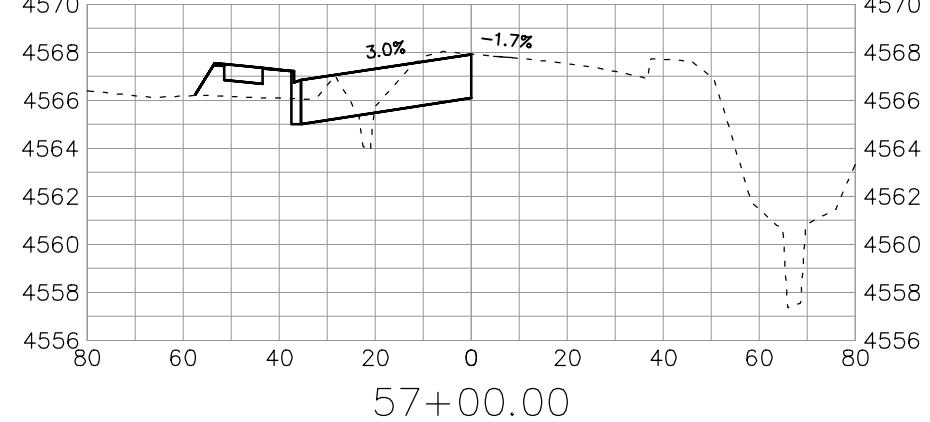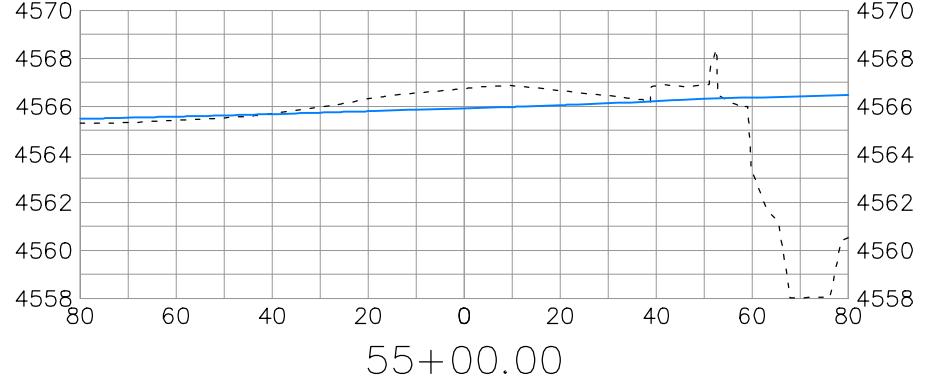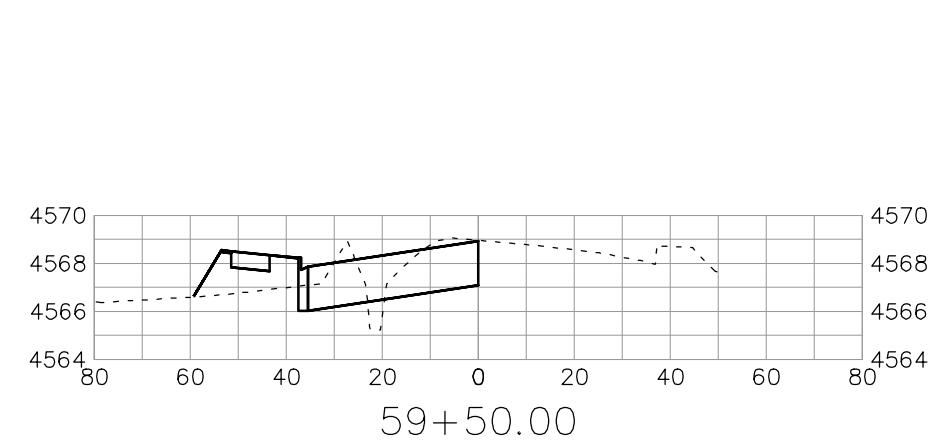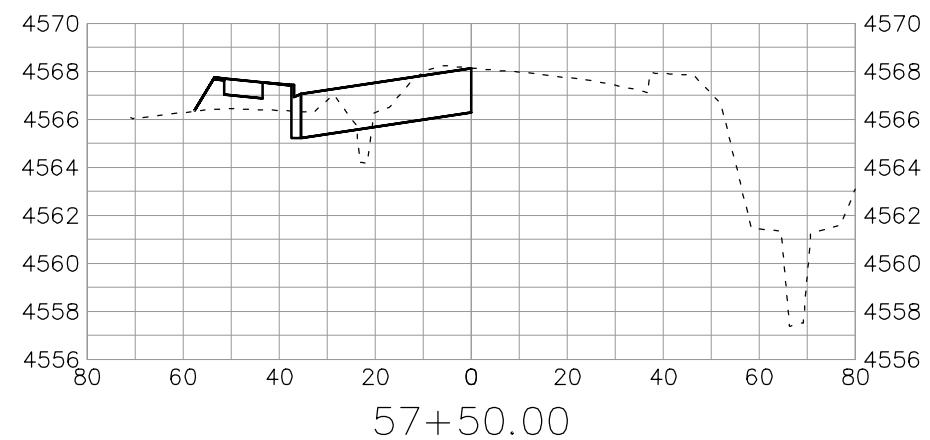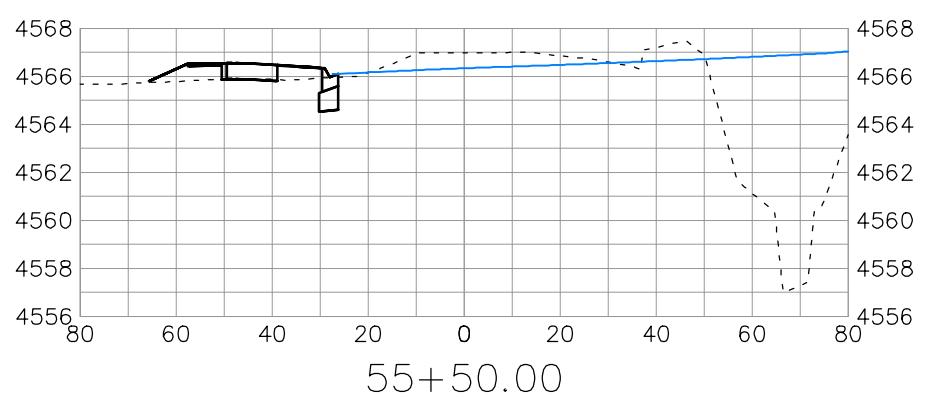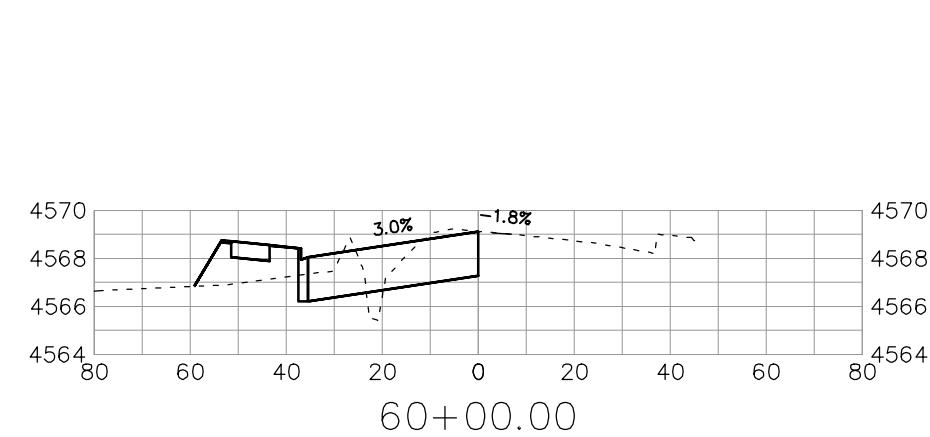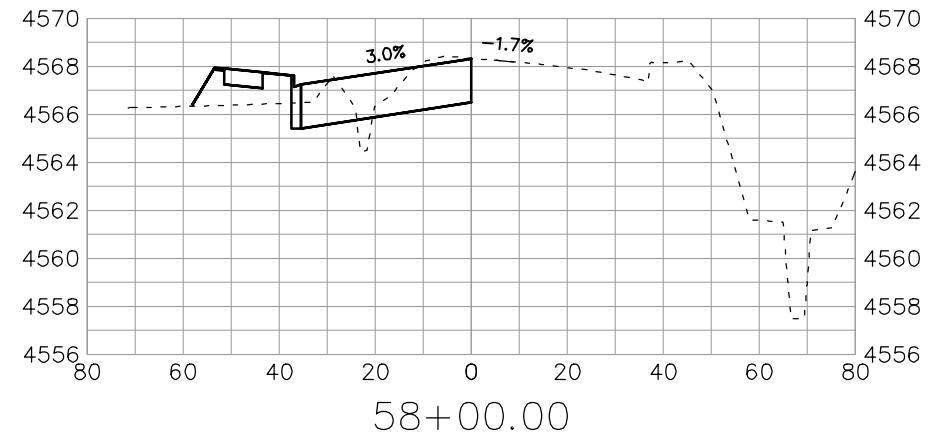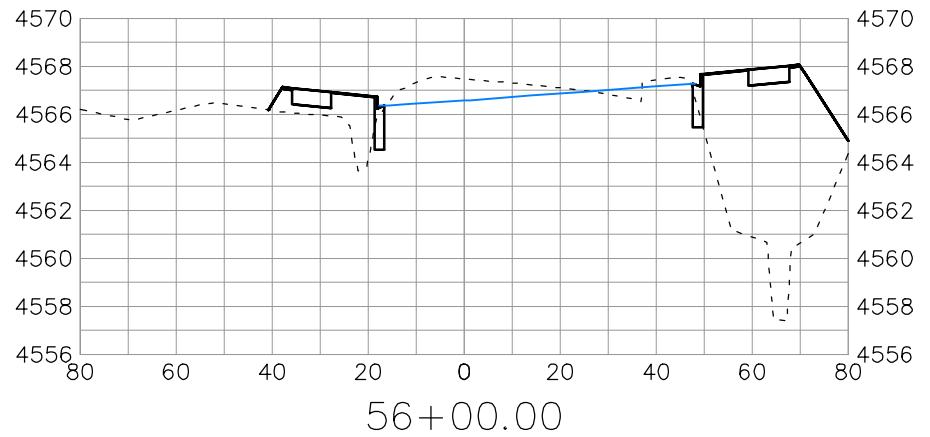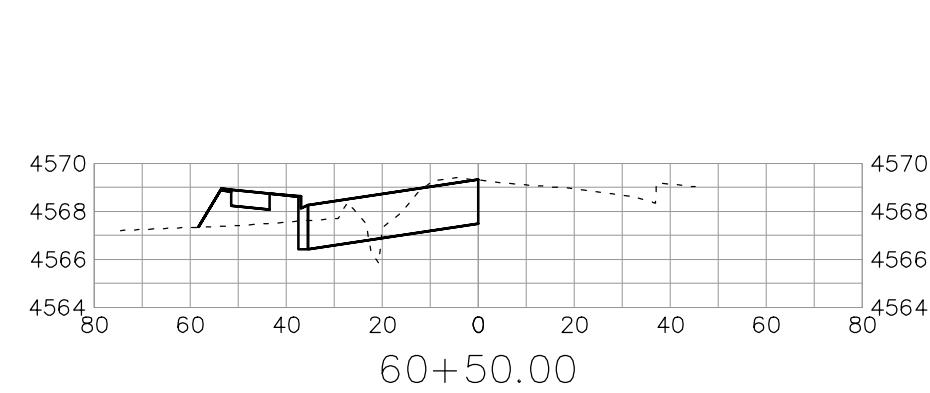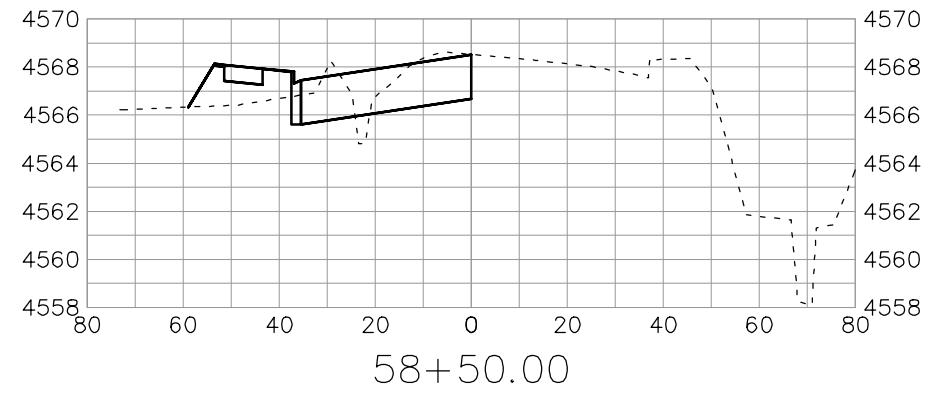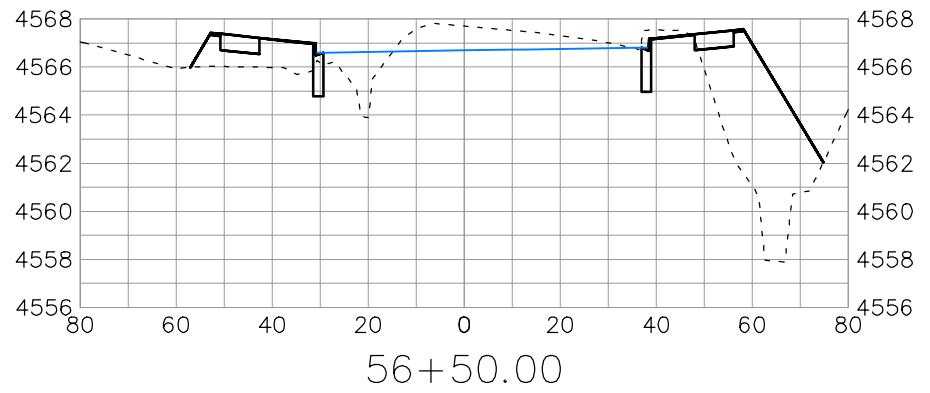

DESCRIPTION	DATE
REVISION ▲ REV 1	DATE
REVISION ▲ REV 2	DATE
REVISION ▲ REV 3	DATE
REVISION ▲ REV 4	DATE



















DRAWN BY	JCS	DATE 2020
DESIGNED BY	JCS	DATE 2020
CHECKED BY	ALC	DATE 2020
APPROVED BY	TCP	DATE 2020

SCALES:
PLAN & PROFILE
0 10 20 40
HORIZONTAL
0 4 8
VERTICAL

CITY OF
Grand Junction
COLORADO

PUBLIC WORKS
ENGINEERING DIVISION
PROJECT NO. 207-F1903

24 ROAD AND G ROAD
ROAD CROSS SECTIONS — 24 RD 7

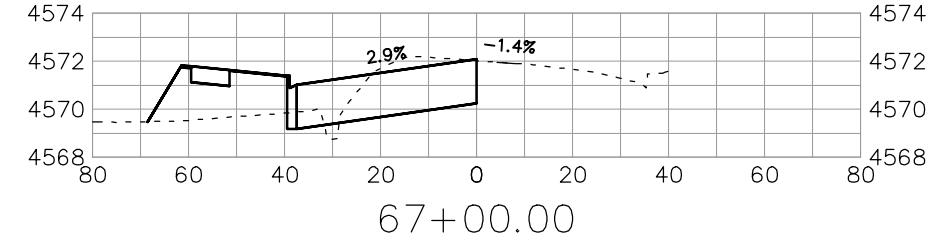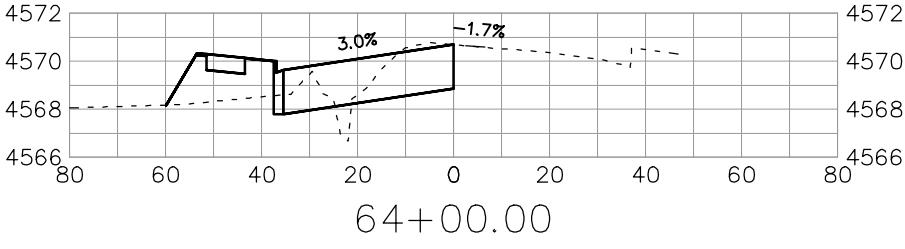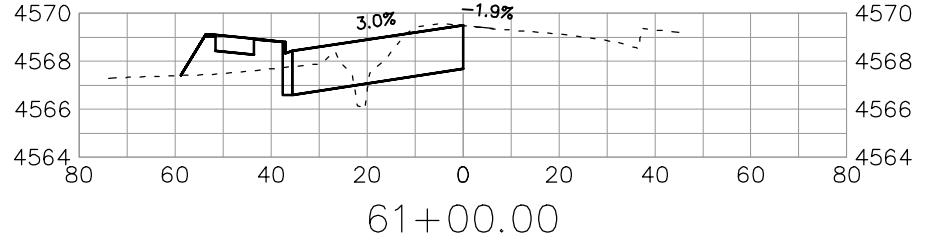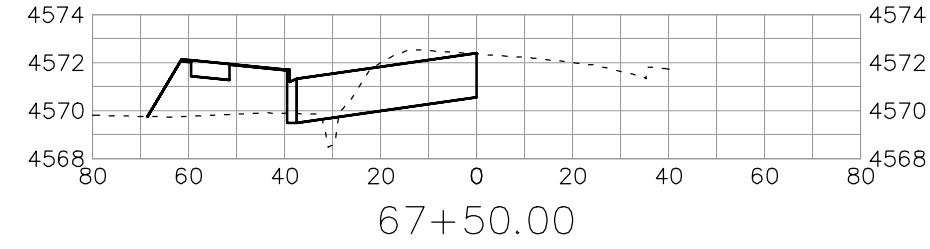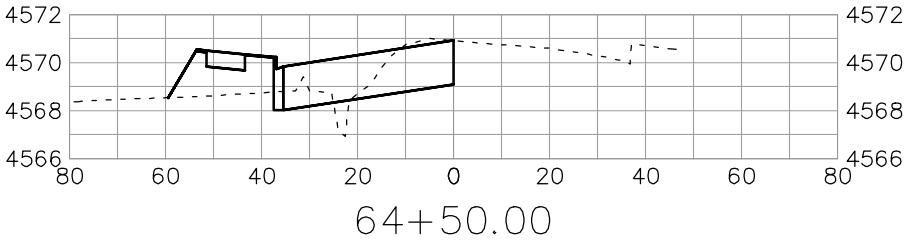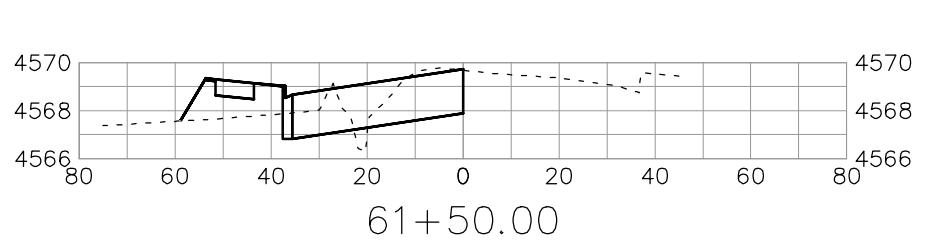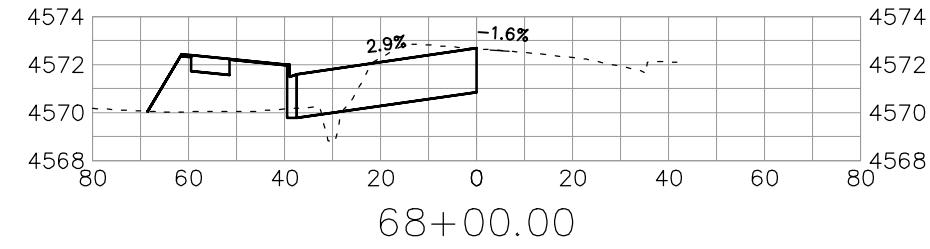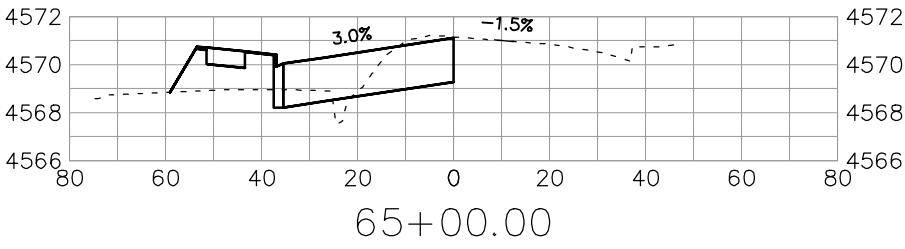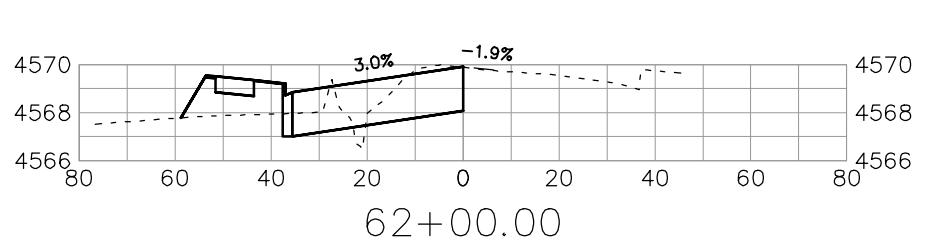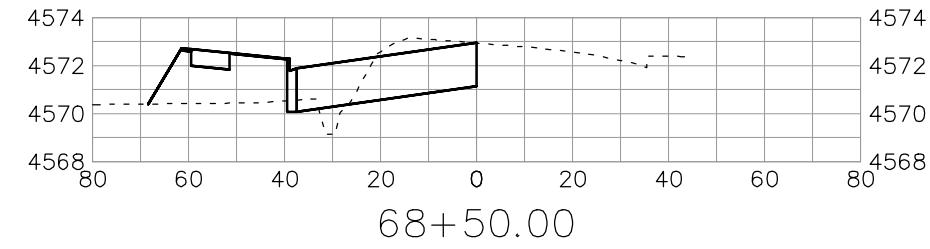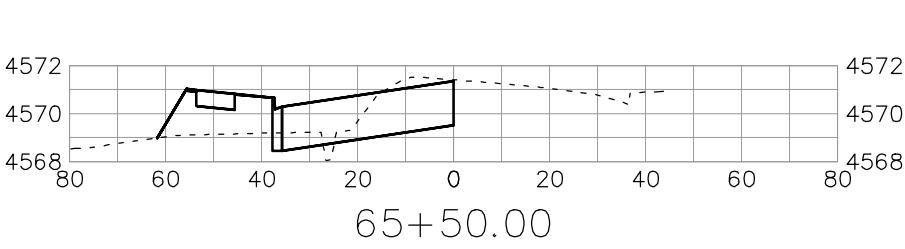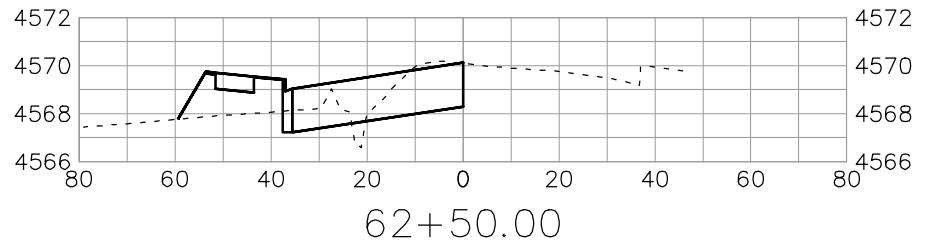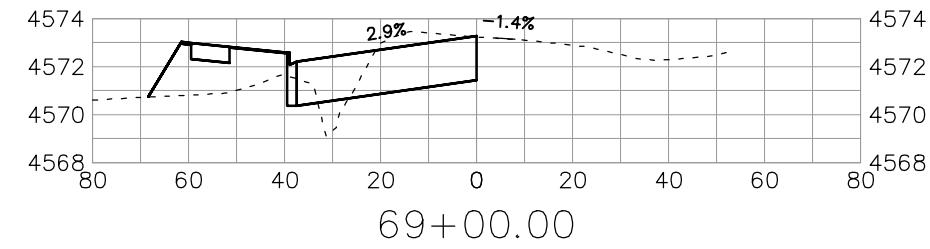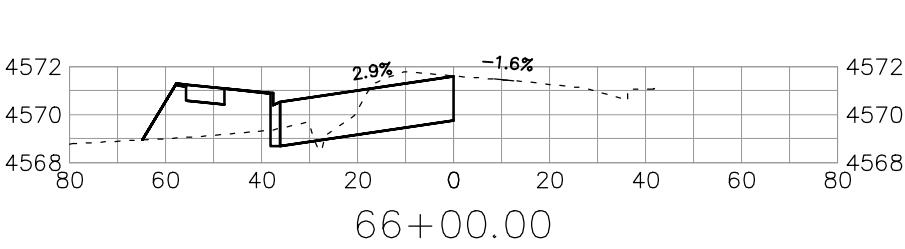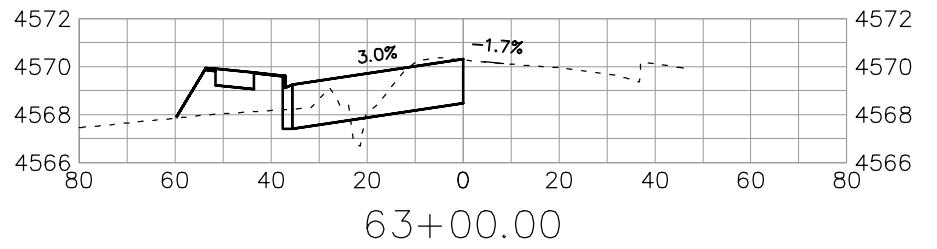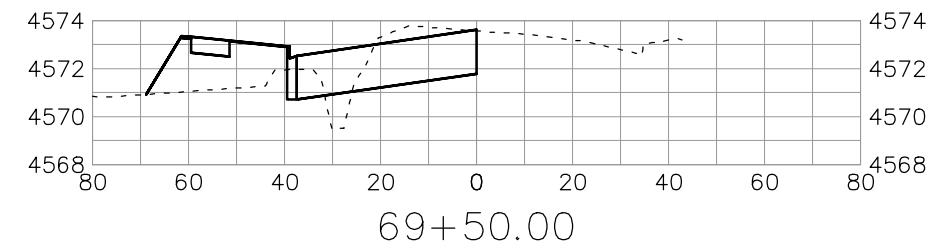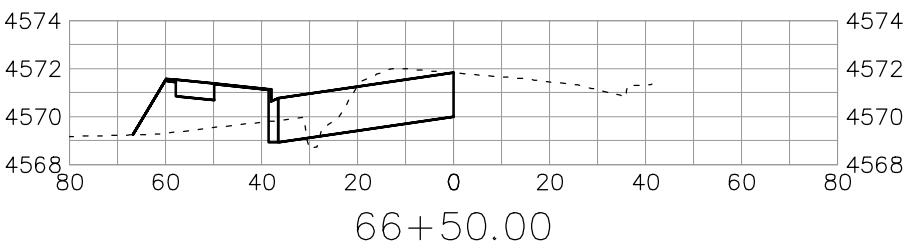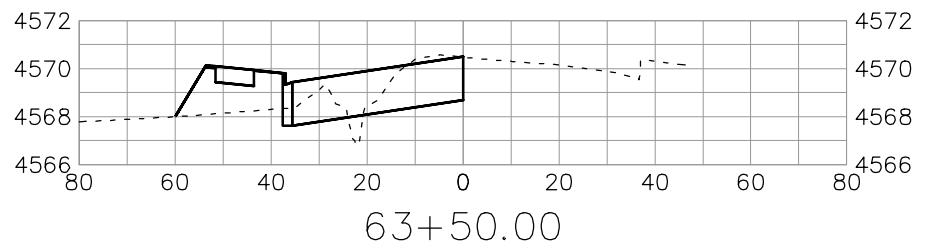

DESCRIPTION	DATE
REVISION A REV 1	DATE
REVISION A REV 2	DATE
REVISION A REV 3	DATE
REVISION A REV 4	DATE




DRAWN BY JCS	DATE 2020
DESIGNED BY JCS	DATE 2020
CHECKED BY ALC	DATE 2020
APPROVED BY TCP	DATE 2020

SCALES:
PLAN & PROFILE
0 10 20 40
HORIZONTAL
0 4
VERTICAL



PUBLIC WORKS
ENGINEERING DIVISION
PROJECT NO. 207-F1903

24 ROAD AND G ROAD
ROAD CROSS SECTIONS — 24 RD 8

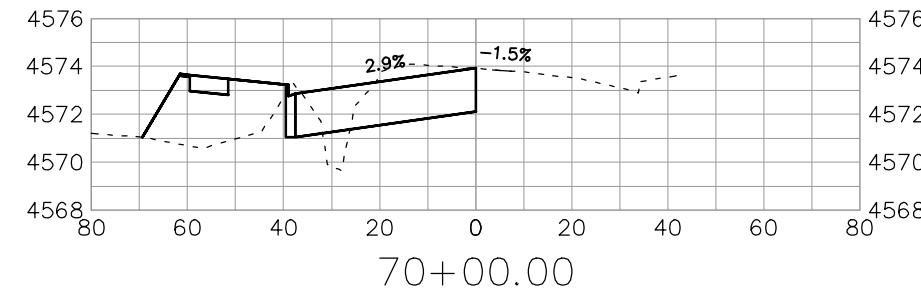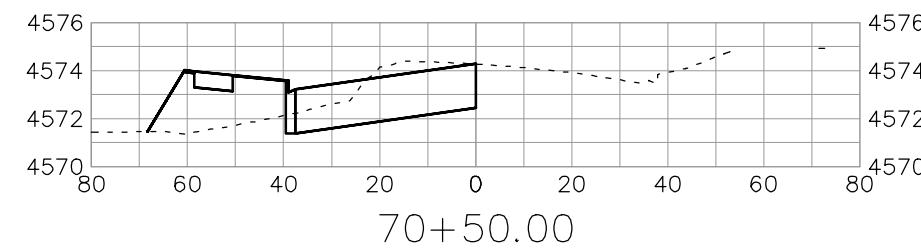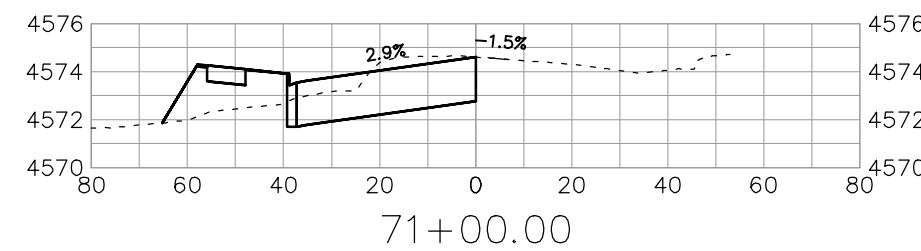



















REVISION ▲ REV 1	DESCRIPTION	DATE
	DRAWN BY JCS	DATE 2020
REVISION ▲ REV 2		— DATE
REVISION ▲ REV 3		— DATE
REVISION ▲ REV 4		— DATE

SCALES:
PLAN & PROFILE
HORIZONTAL
0 10 20 40
VERTICAL
0 4 8

CITY OF
Grand Junction
COLORADO

PUBLIC WORKS
ENGINEERING DIVISION
PROJECT NO. 207-F1903

24 ROAD AND G ROAD
ROAD CROSS SECTIONS — 24 RD 9

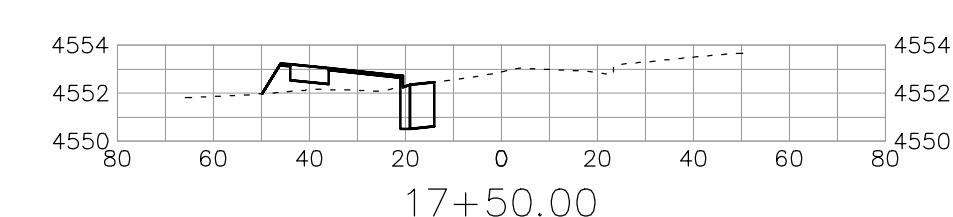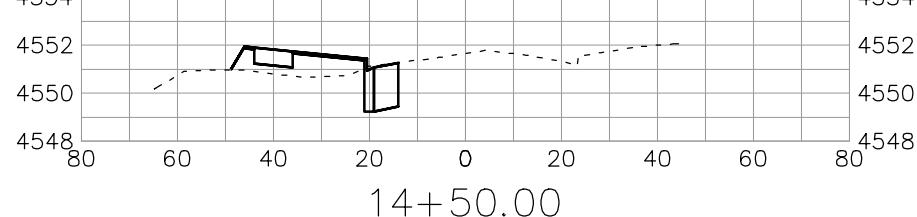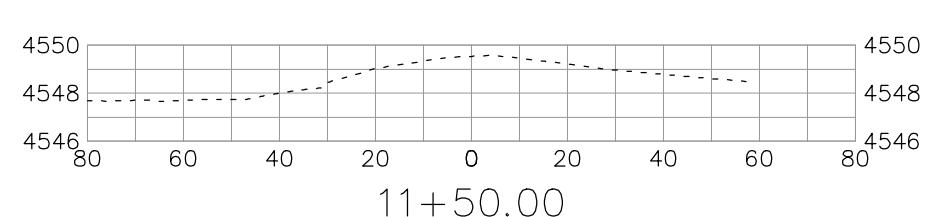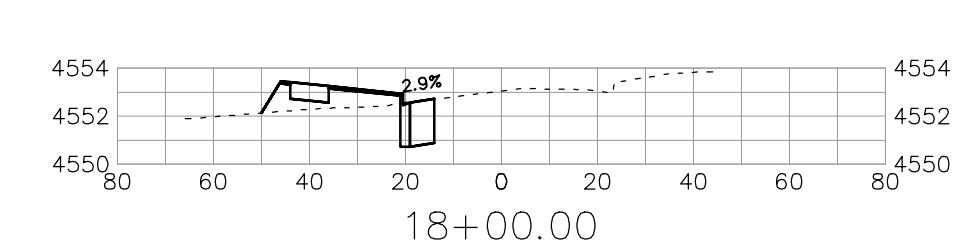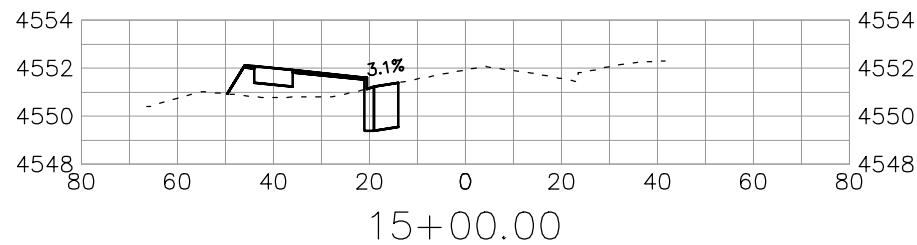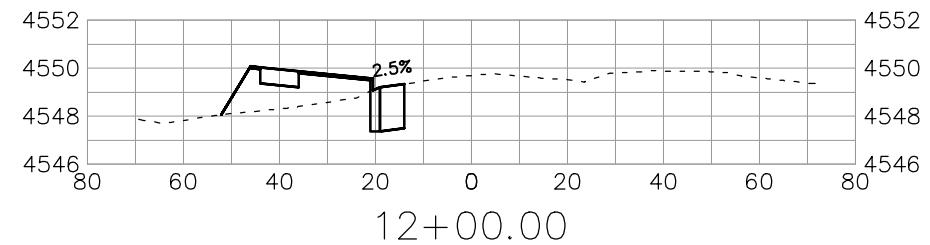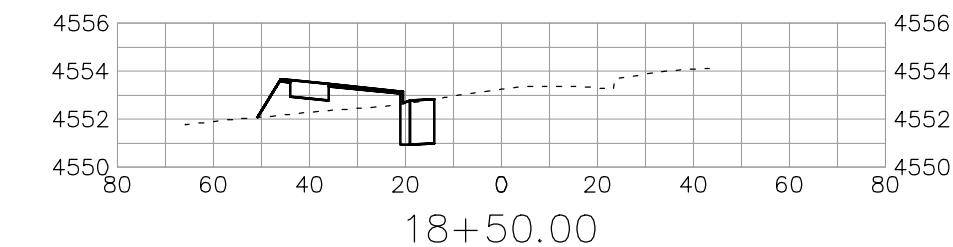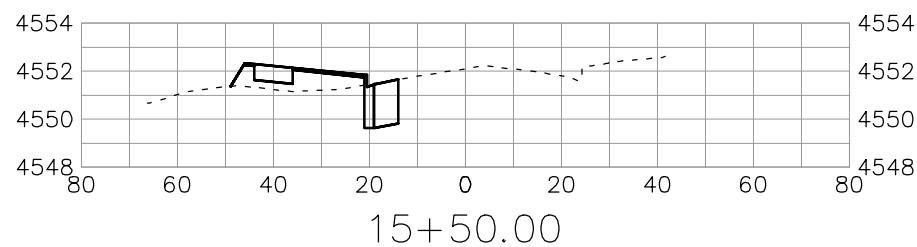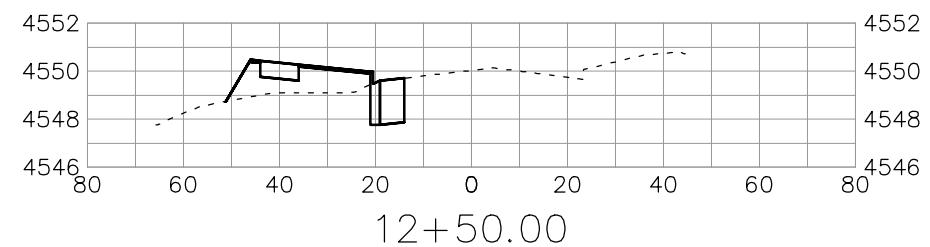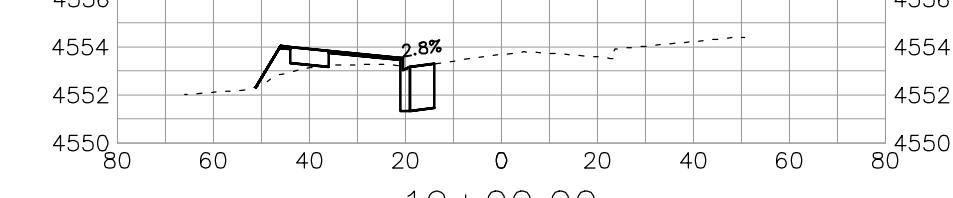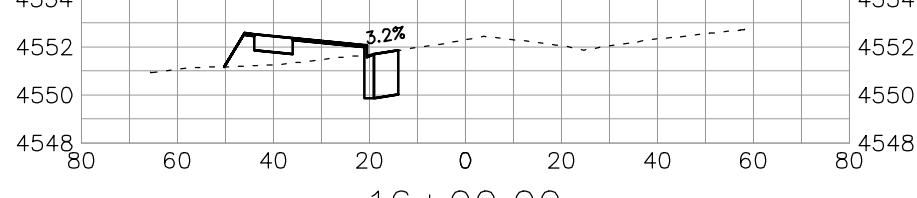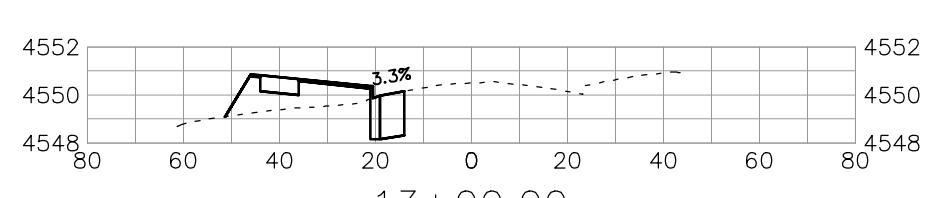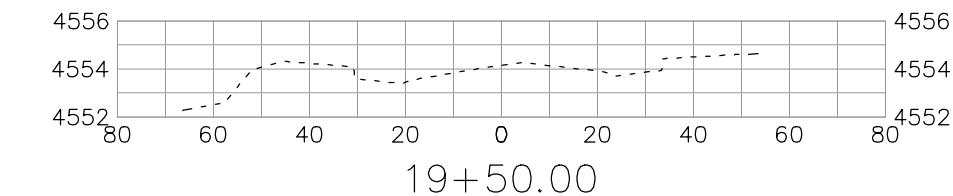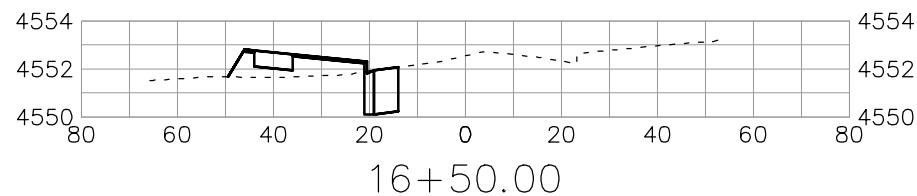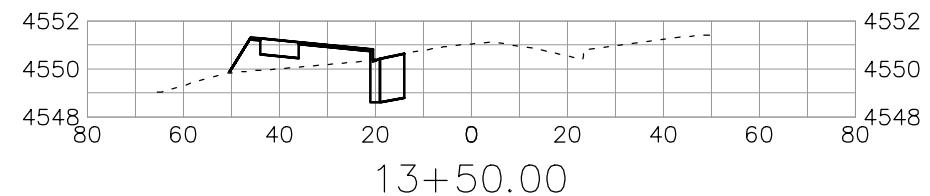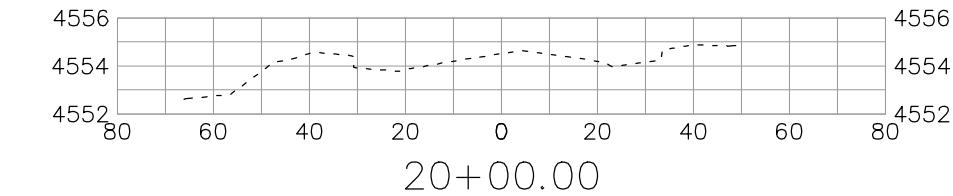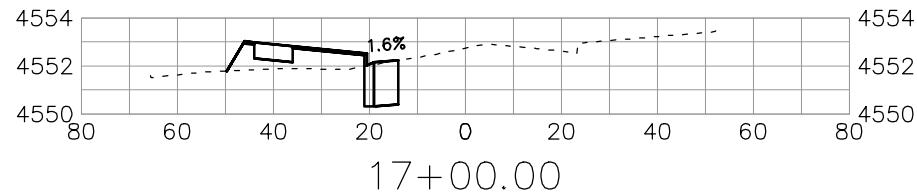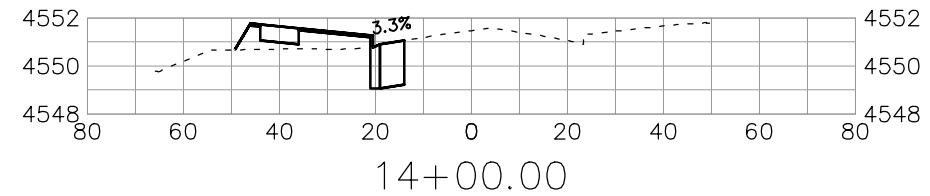



















DESCRIPTION	DATE
DRAWN BY JCS	DATE 2020
DESIGNED BY JCS	DATE 2020
CHECKED BY ALC	DATE 2020
APPROVED BY TCP	DATE 2020

SCALES:
PLAN & PROFILE
0 10 20 40
HORIZONTAL
0 4
VERTICAL

CITY OF
Grand Junction
COLORADO

PUBLIC WORKS
ENGINEERING DIVISION
PROJECT NO. 207-F1903

24 ROAD AND G ROAD
ROAD CROSS SECTIONS — G RD 1

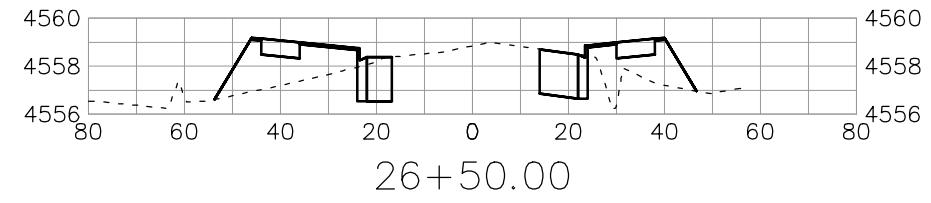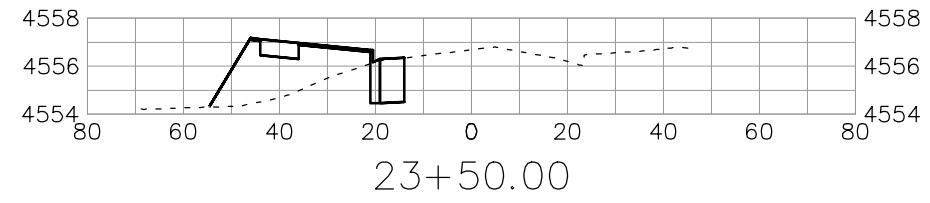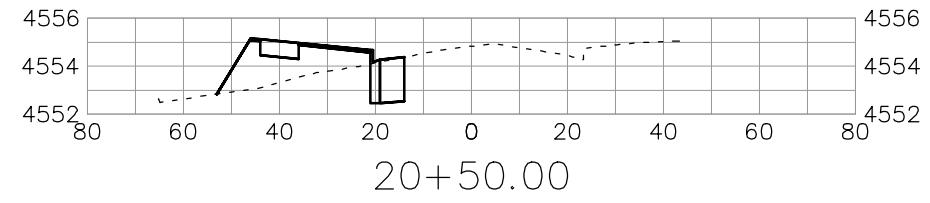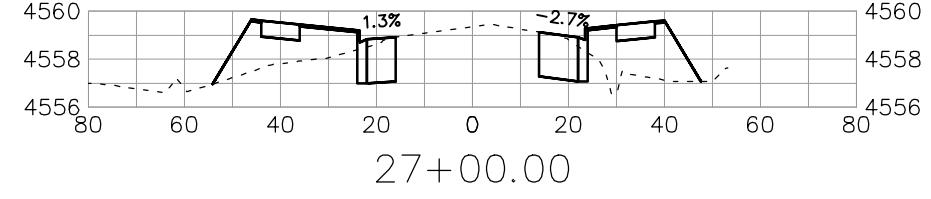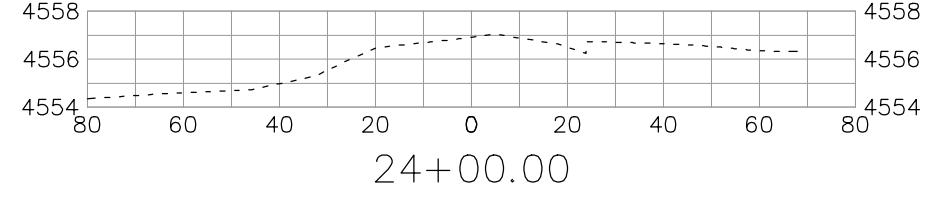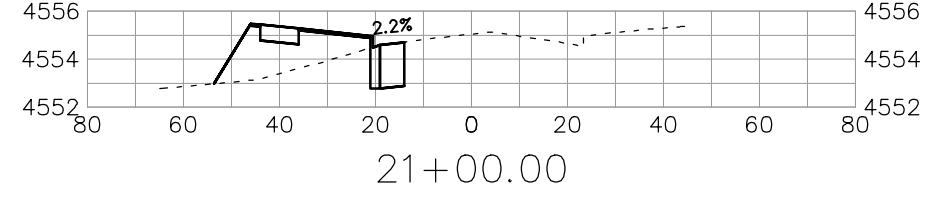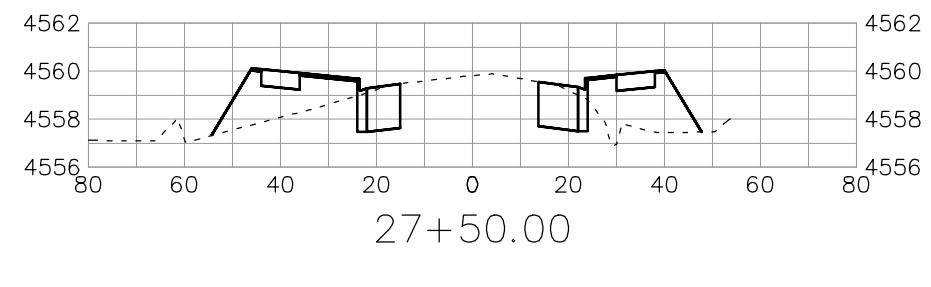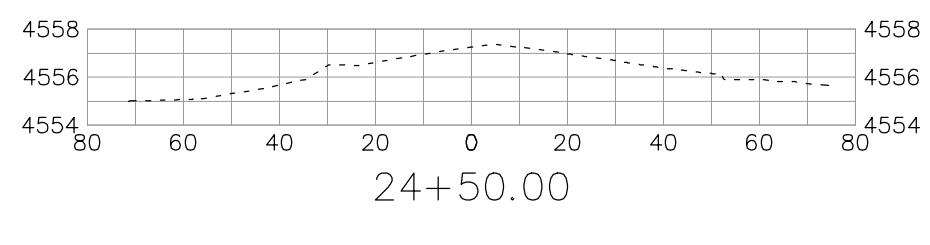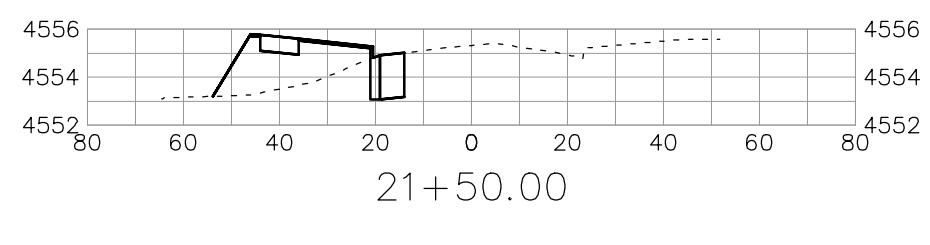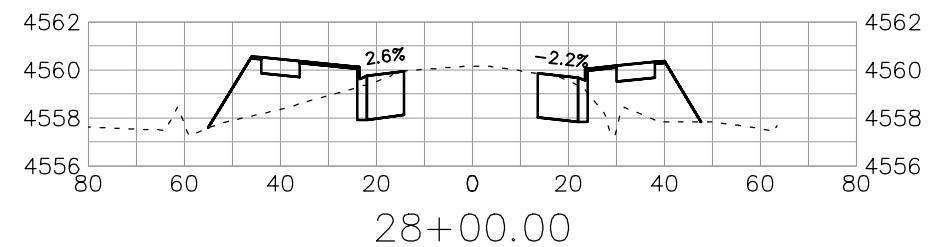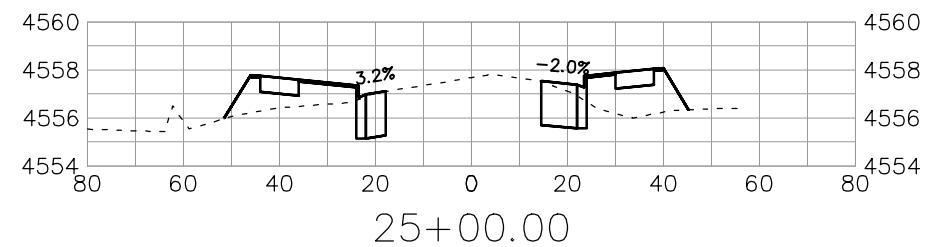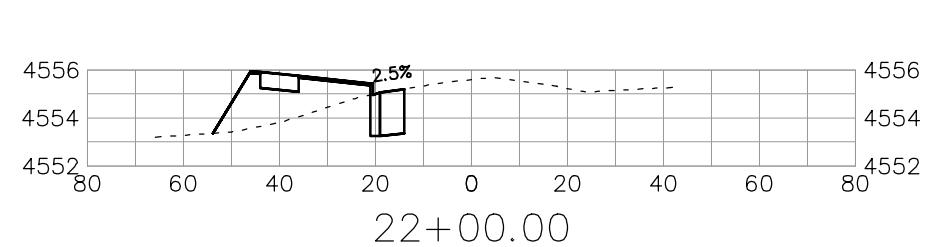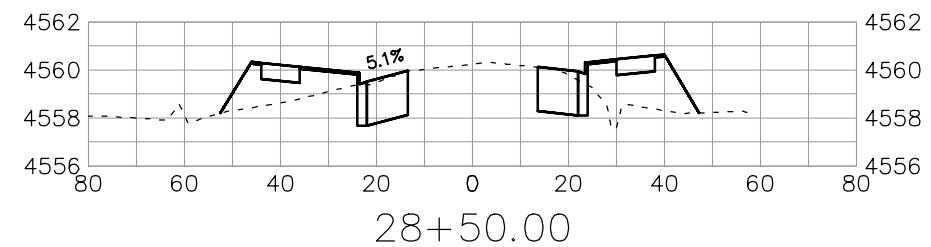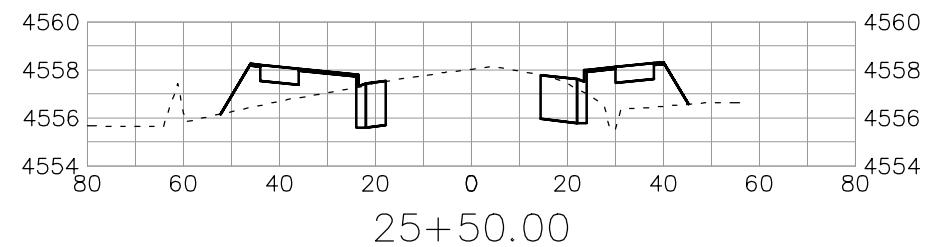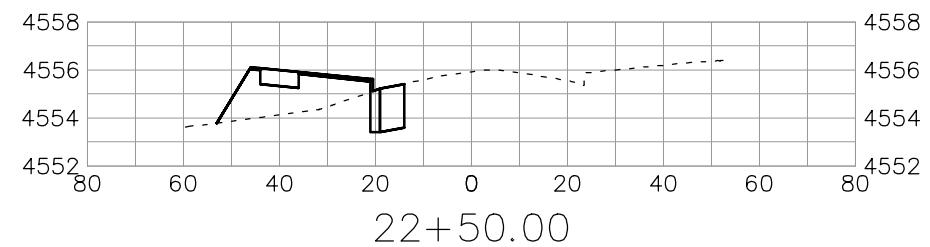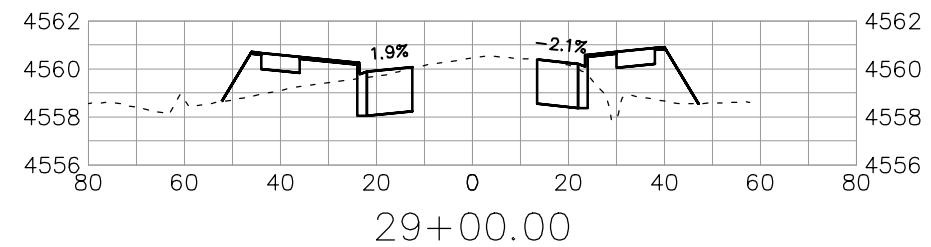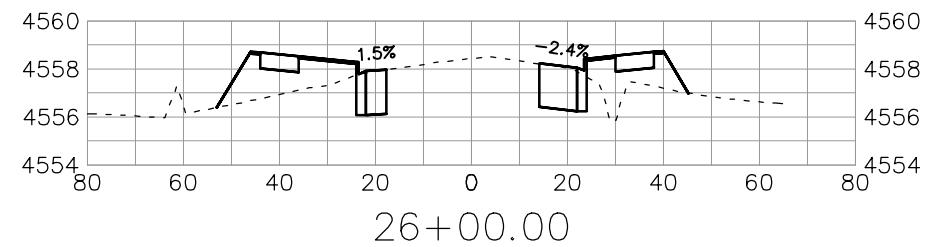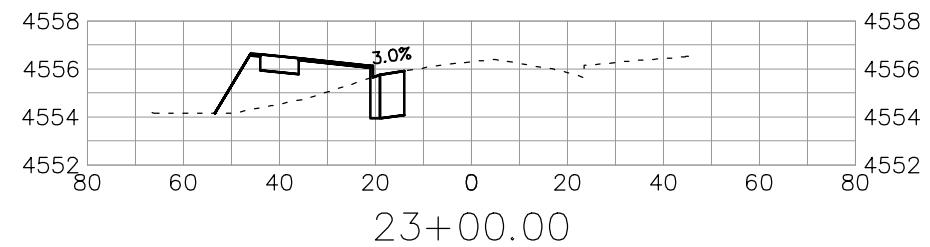


















DESCRIPTION	DATE
DRAWN BY JCS	DATE 2020
DESIGNED BY JCS	DATE 2020
CHECKED BY ALC	DATE 2020
APPROVED BY TCP	DATE 2020

SCALES:	PLAN & PROFILE		
0	10	20	40
	HORIZONTAL		
0	4	5	
	VERTICAL		



PUBLIC WORKS
ENGINEERING DIVISION
PROJECT NO. 207-F1903

24 ROAD AND G ROAD
ROAD CROSS SECTIONS — G RD 2

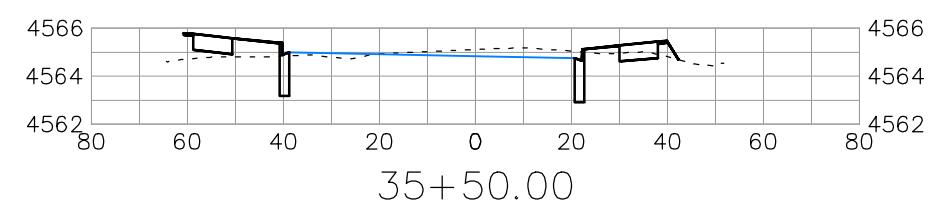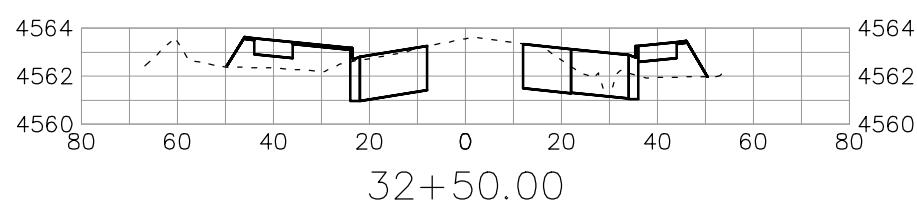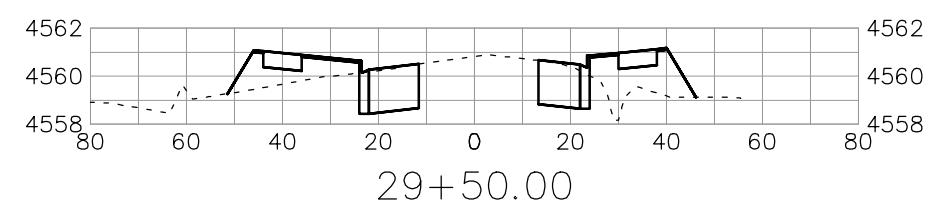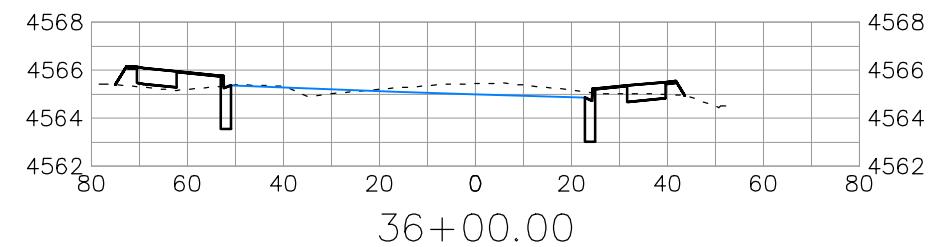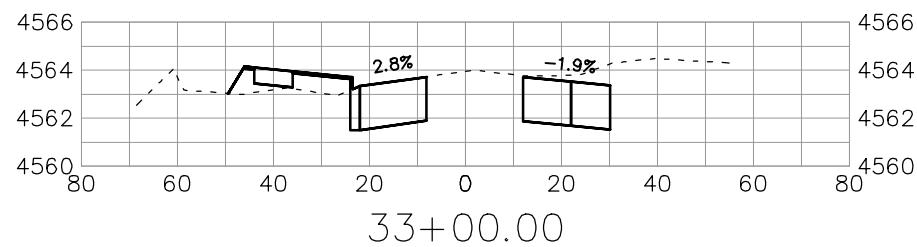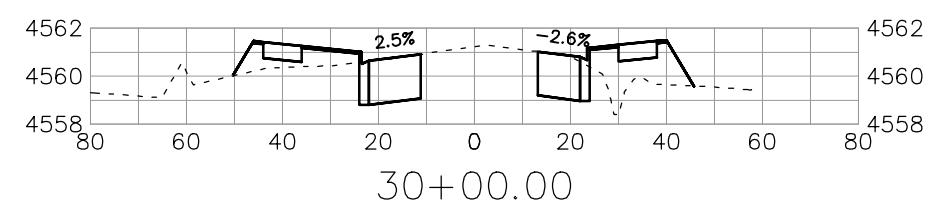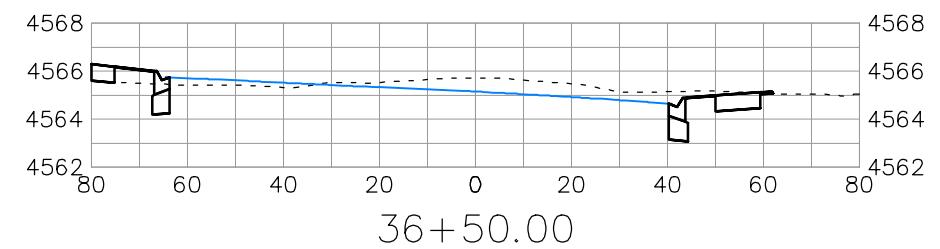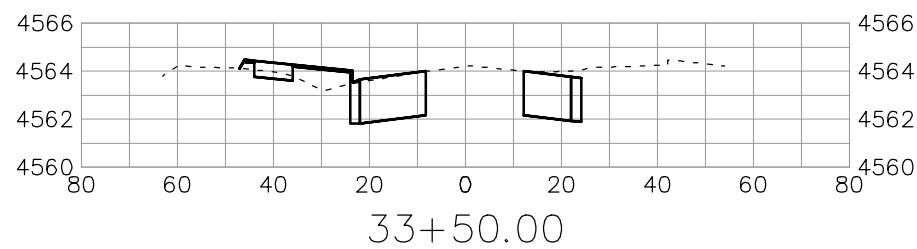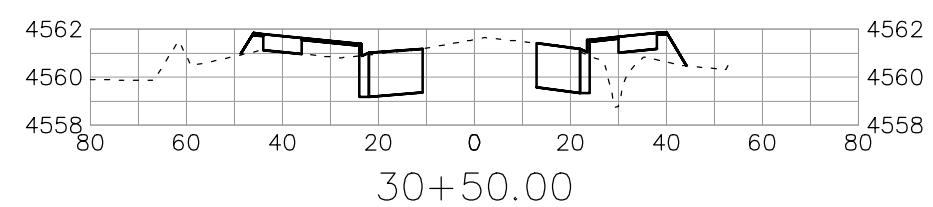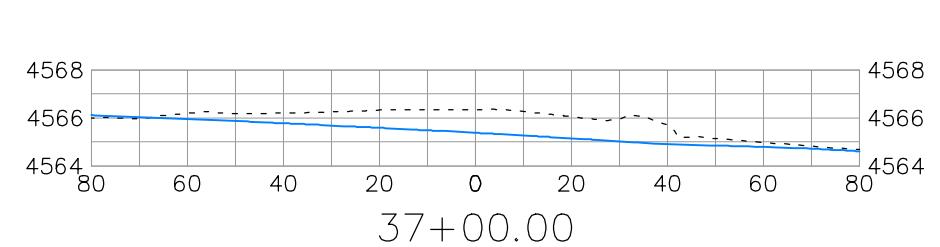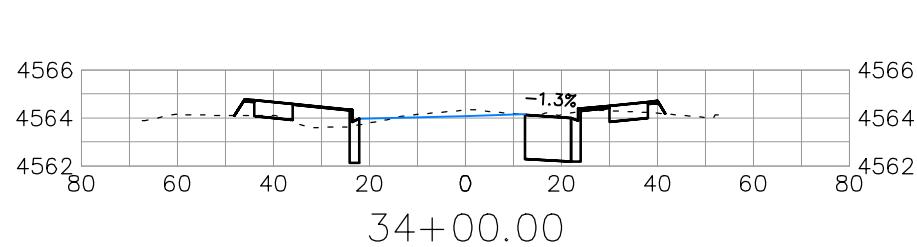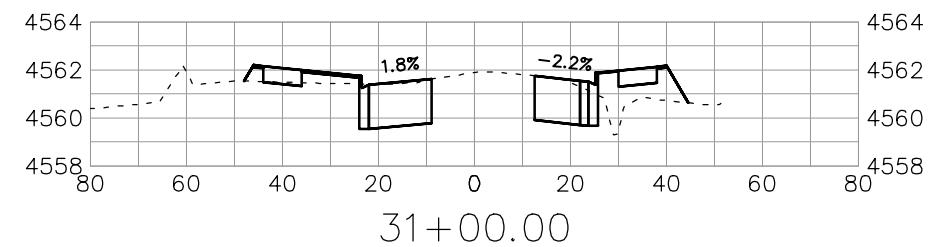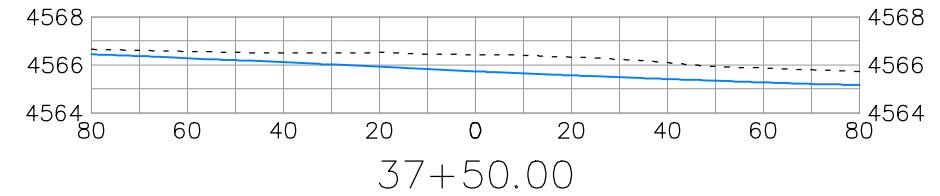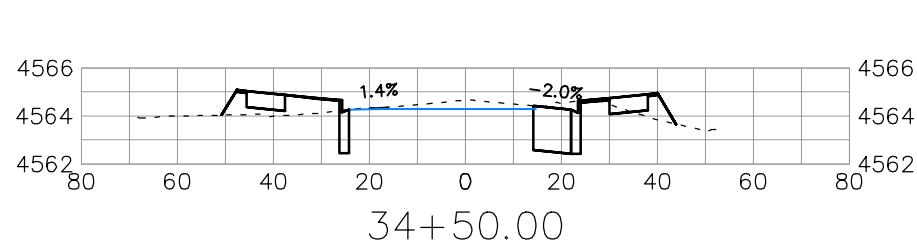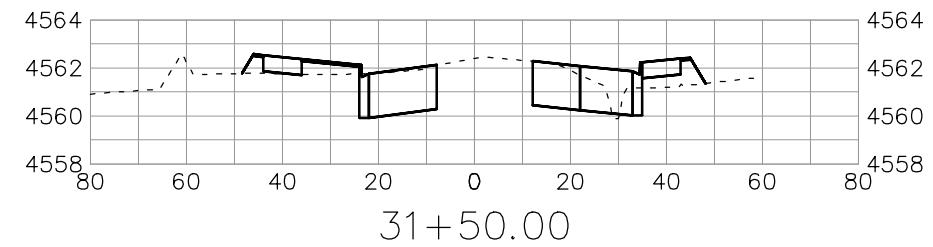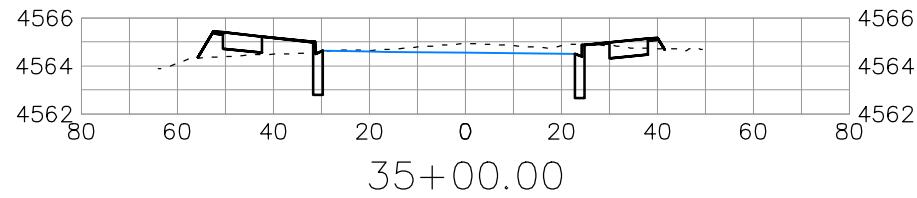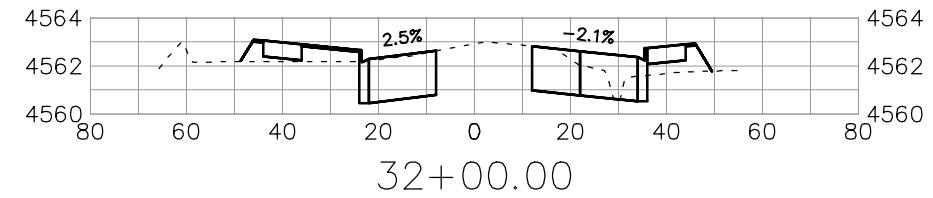
















REVISION ▲ REV 1	DATE	DRAWN BY JCS DATE 2020
REVISION ▲ REV 2	DATE	DESIGNED BY JCS DATE 2020
REVISION ▲ REV 3	DATE	CHECKED BY ALC DATE 2020
REVISION ▲ REV 4	DATE	APPROVED BY TCP DATE 2020

SCALES:
PLAN & PROFILE
0 10 20 40
HORIZONTAL
0 4 8
VERTICAL



PUBLIC WORKS
ENGINEERING DIVISION
PROJECT NO. 207-F1903

24 ROAD AND G ROAD
ROAD CROSS SECTIONS — G RD 3

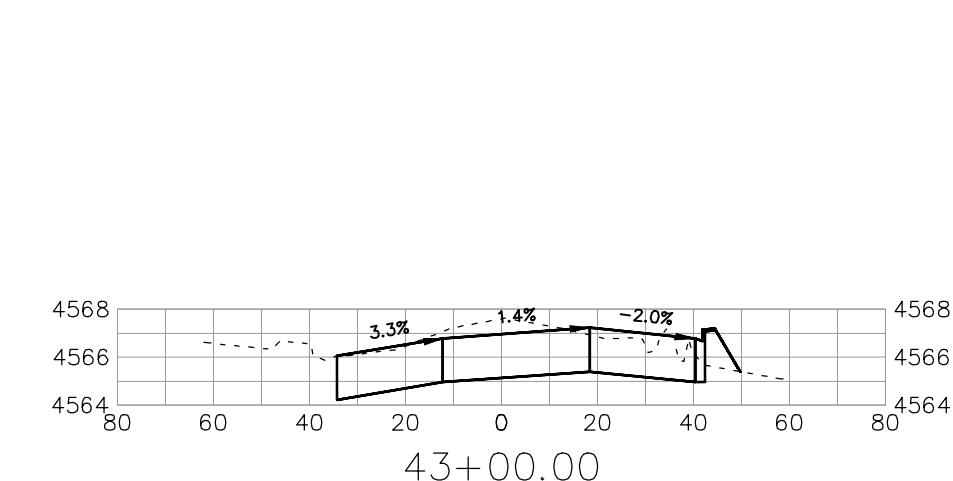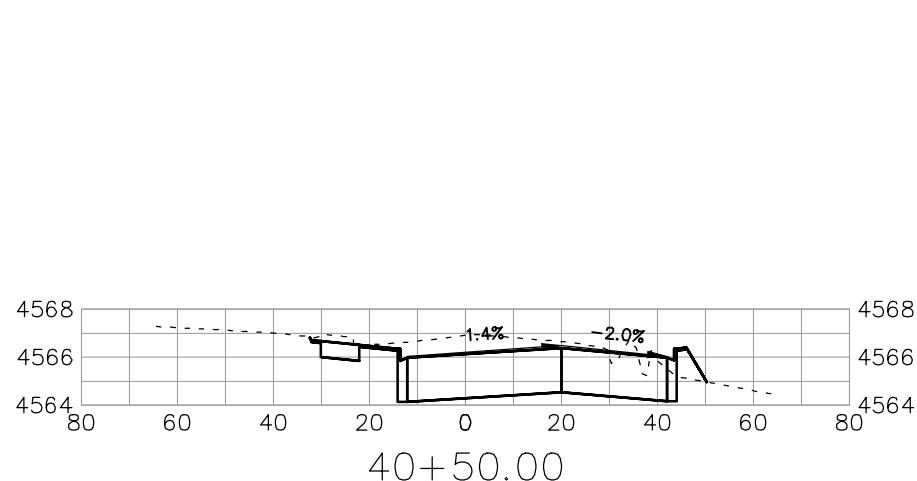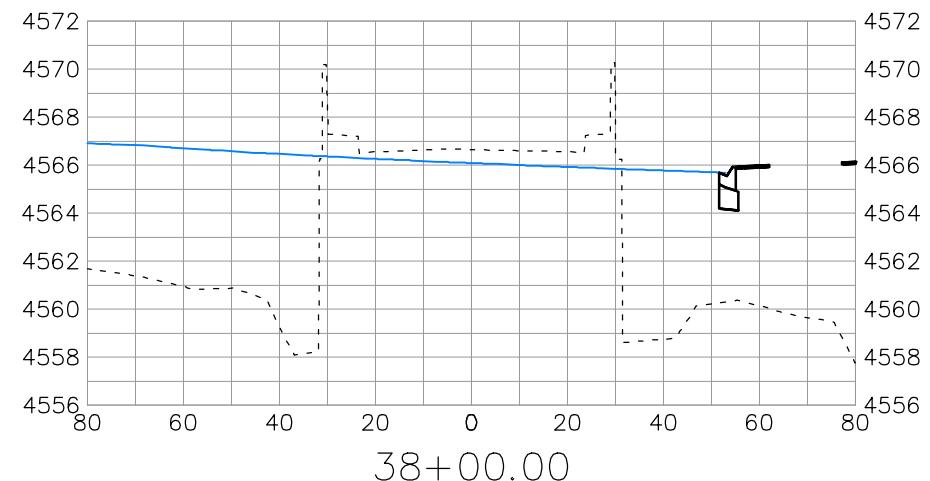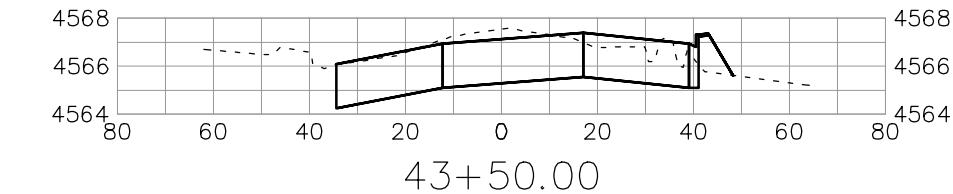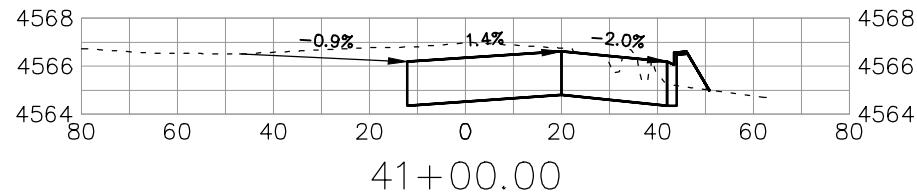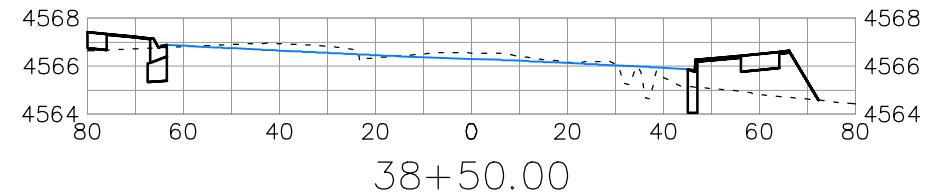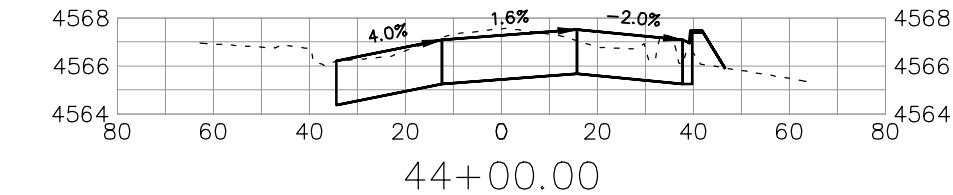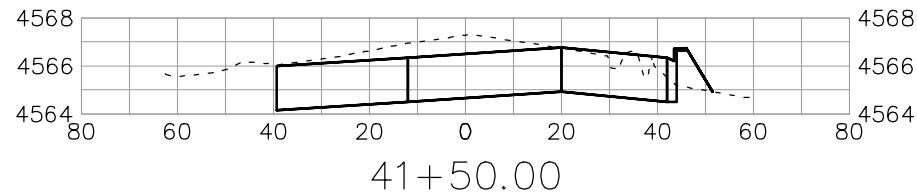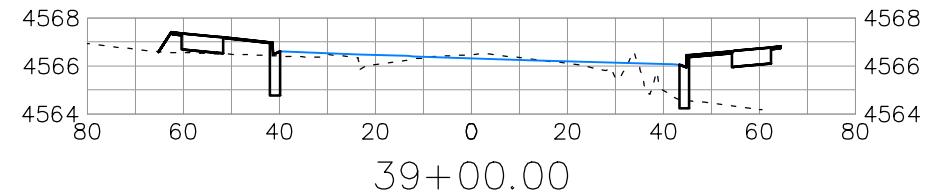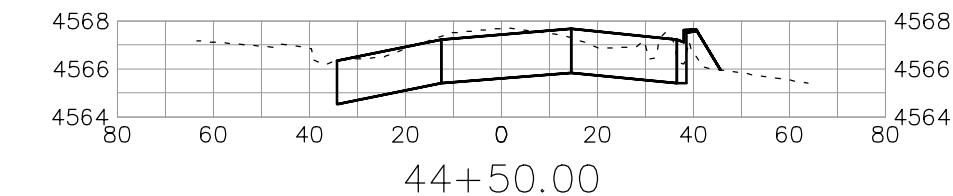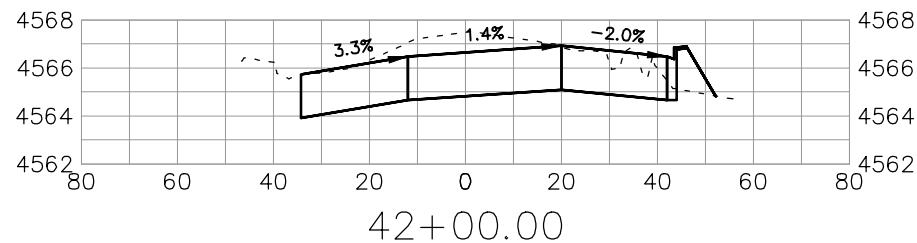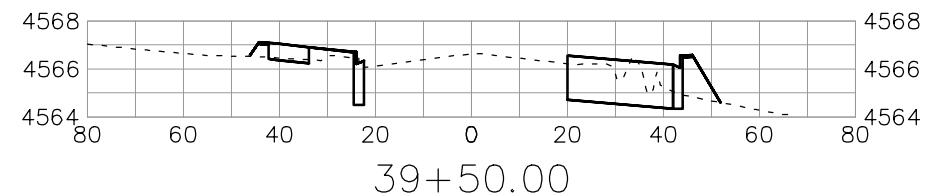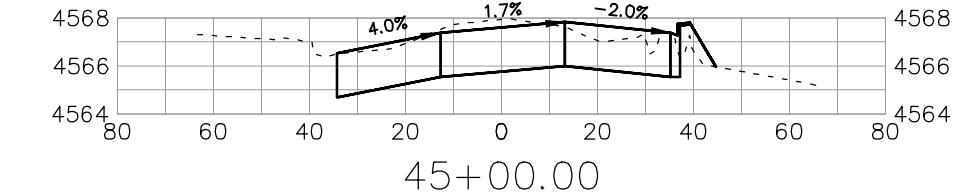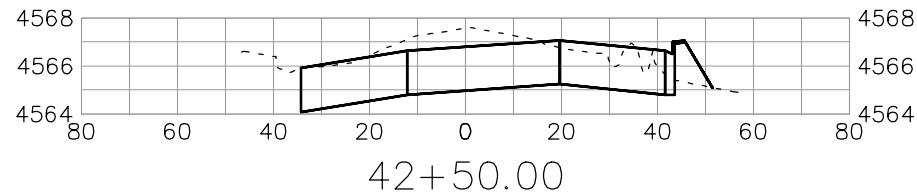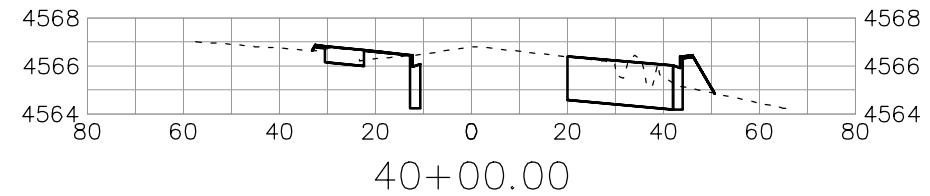

DESCRIPTION DATE
DRAWN BY JCS DATE 2020
DESIGNED BY JCS DATE 2020
CHECKED BY ALC DATE 2020
APPROVED BY TCP DATE 2020



















REVISION ▲ REV 1 DATE
REVISION ▲ REV 2 DATE
REVISION ▲ REV 3 DATE
REVISION ▲ REV 4 DATE

SCALES:
PLAN & PROFILE
0 10 20 40
HORIZONTAL
0 4 8
VERTICAL

CITY OF
Grand Junction
COLORADO

PUBLIC WORKS
ENGINEERING DIVISION
PROJECT NO. 207-F1903

24 ROAD AND G ROAD
ROAD CROSS SECTIONS — G RD 4

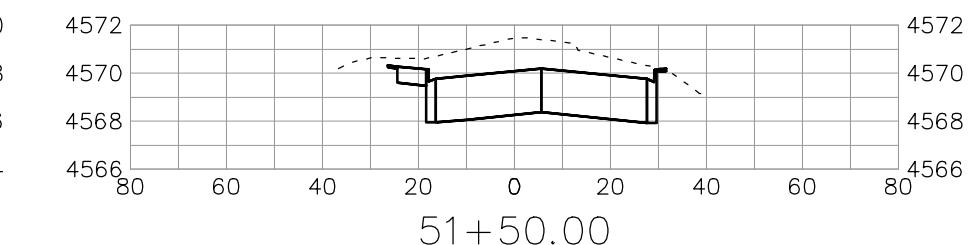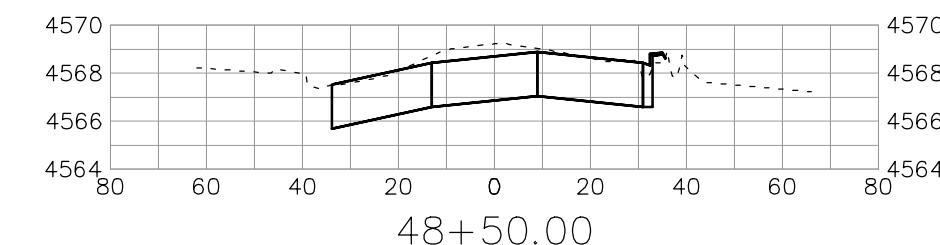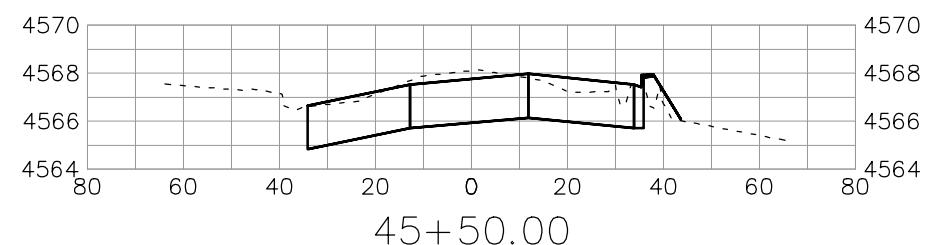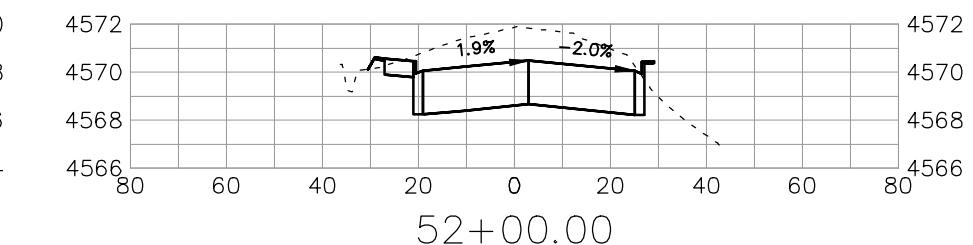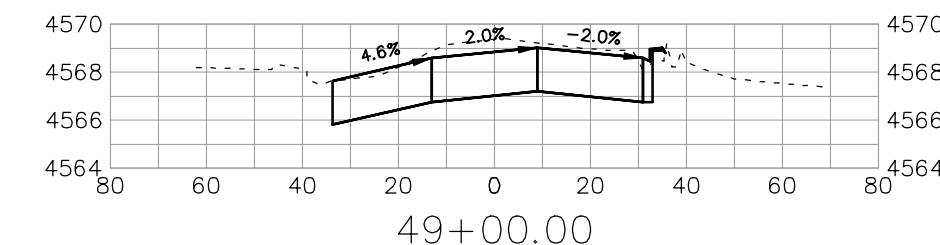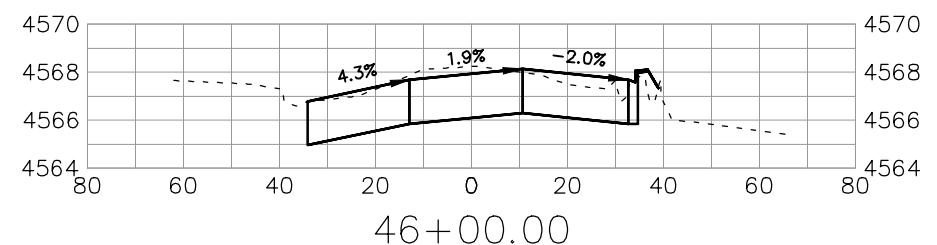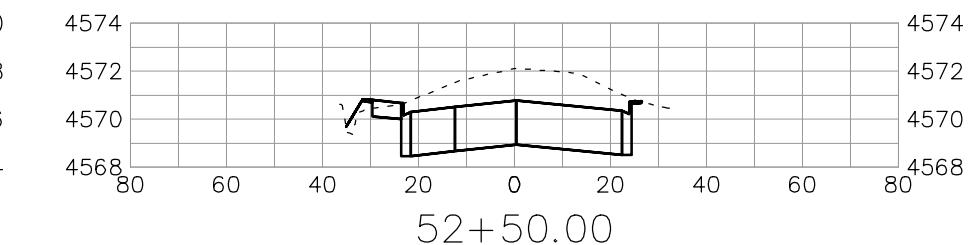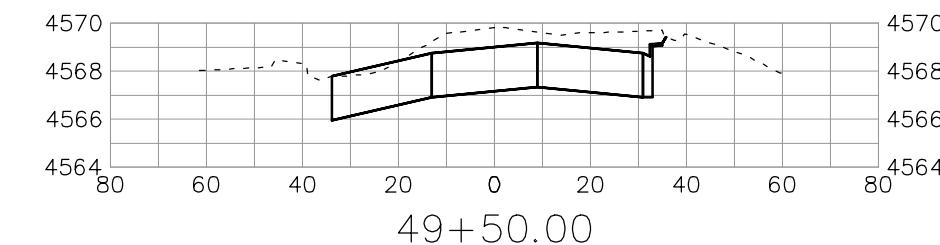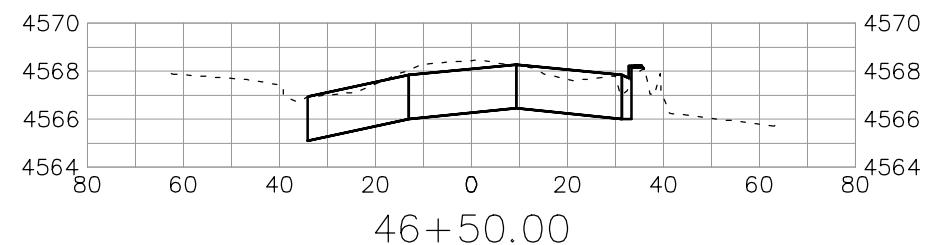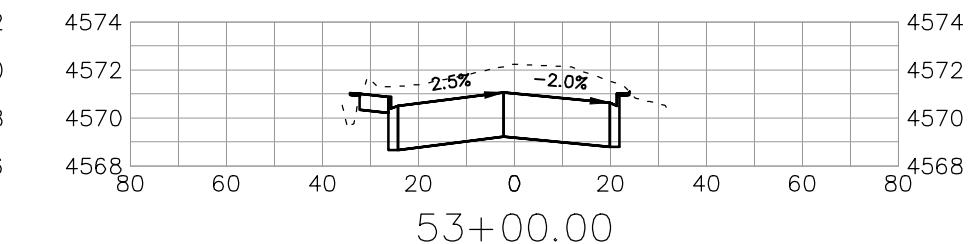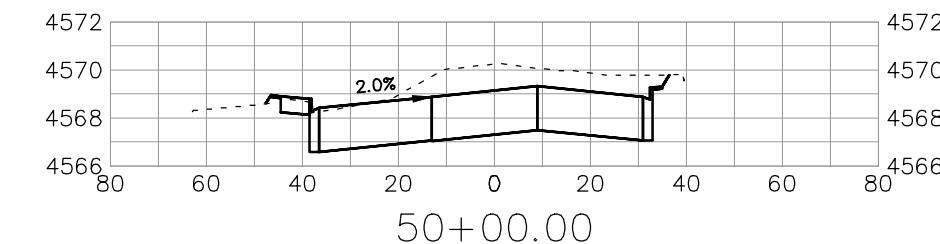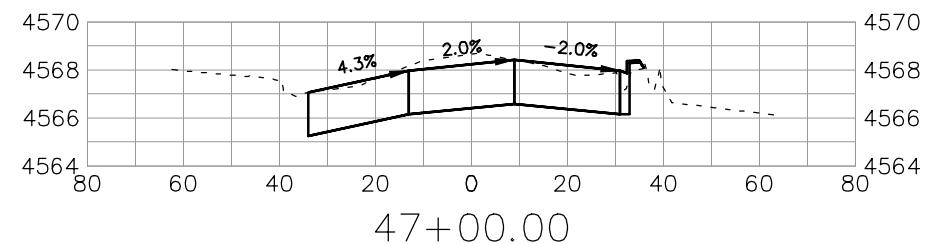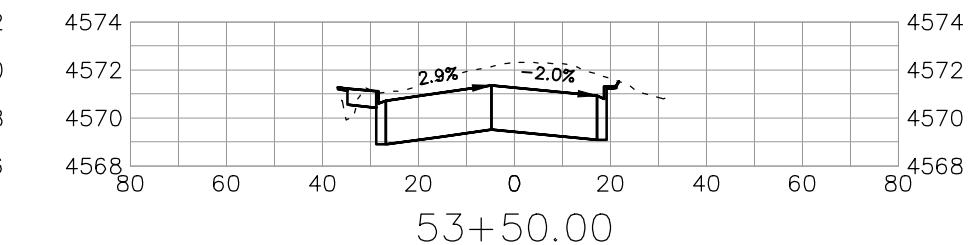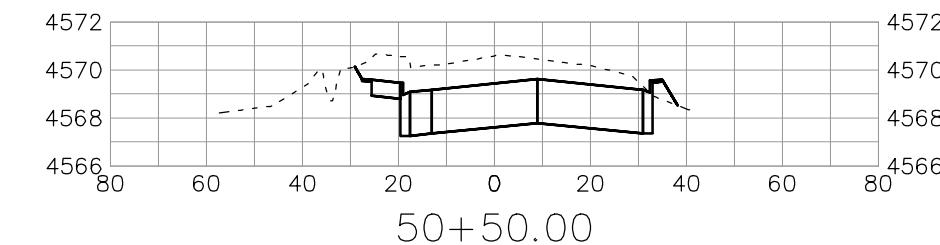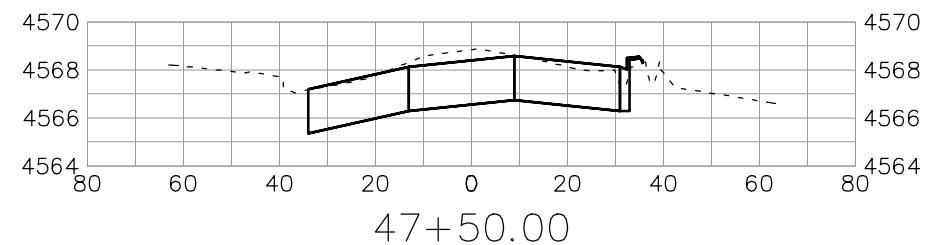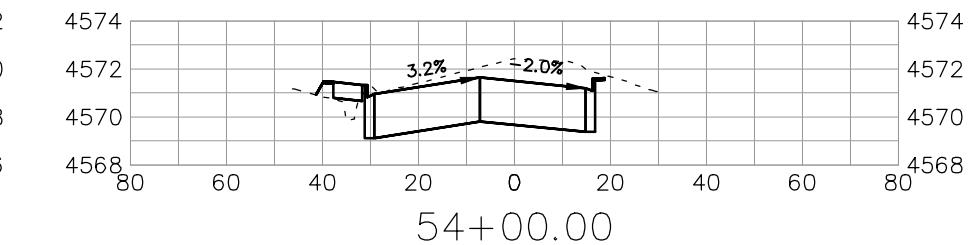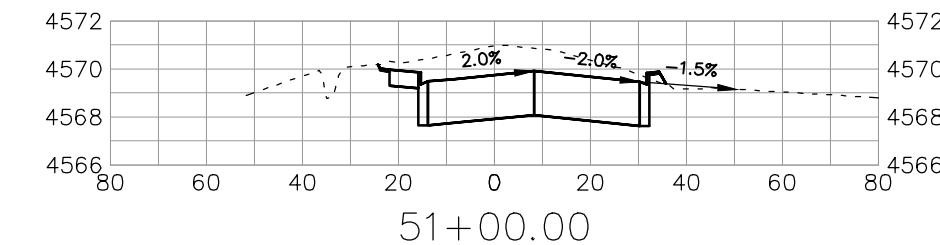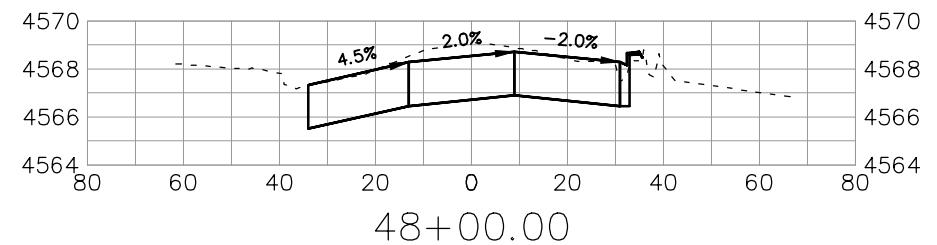

DESCRIPTION	DATE
REVISION A REV 1	DATE
REVISION A REV 2	DATE
REVISION A REV 3	DATE
REVISION A REV 4	DATE



















DRAWN BY JCS	DATE 2020
DESIGNED BY JCS	DATE 2020
CHECKED BY ALC	DATE 2020
APPROVED BY TCP	DATE 2020

SCALES:
PLAN & PROFILE
0 10 20 40
HORIZONTAL
0 4
VERTICAL



PUBLIC WORKS
ENGINEERING DIVISION
PROJECT NO. 207-F1903

24 ROAD AND G ROAD
ROAD CROSS SECTIONS — G RD 5

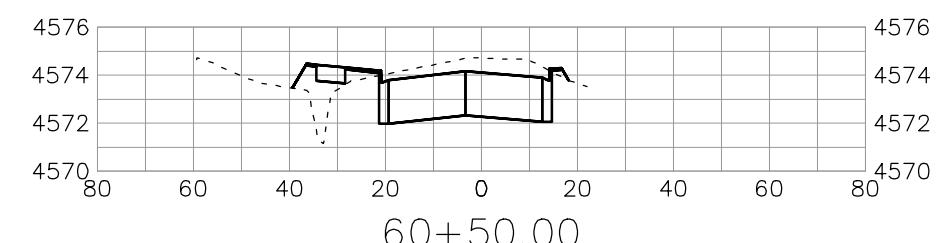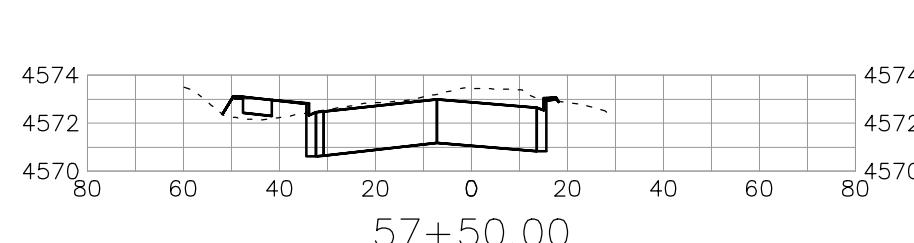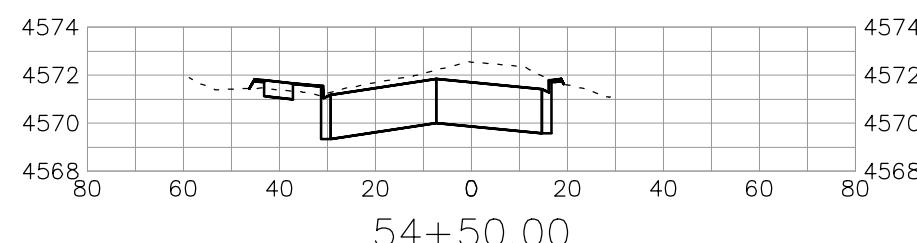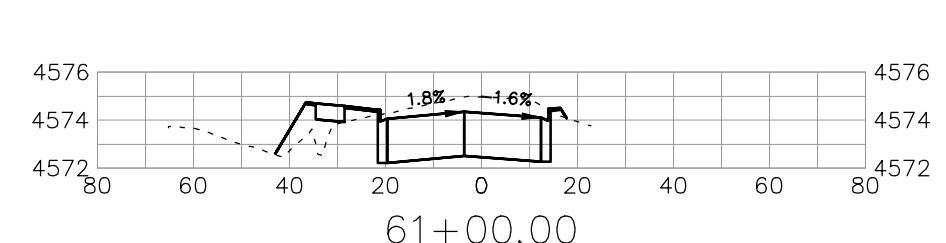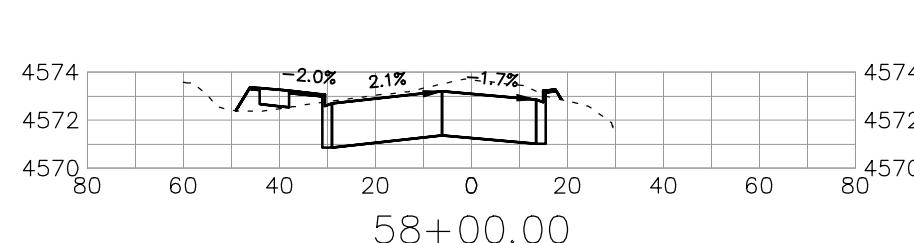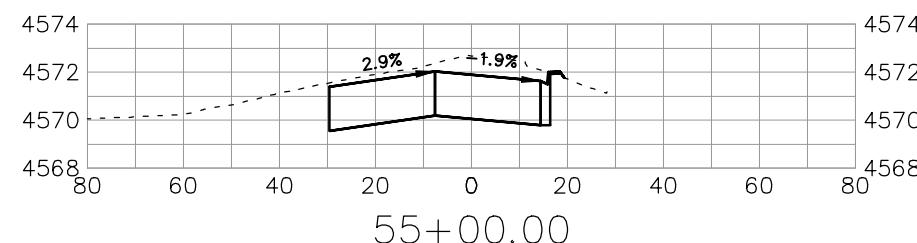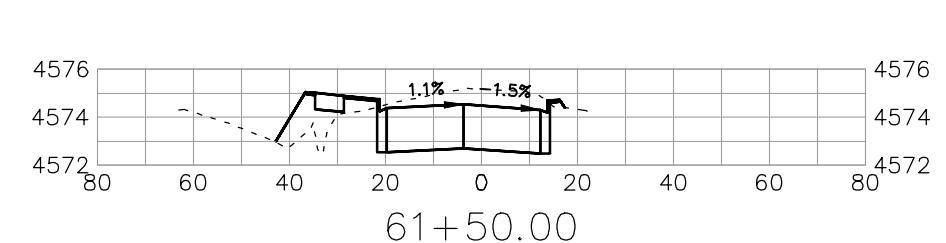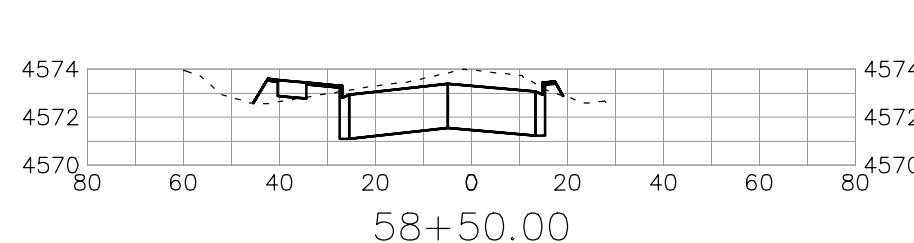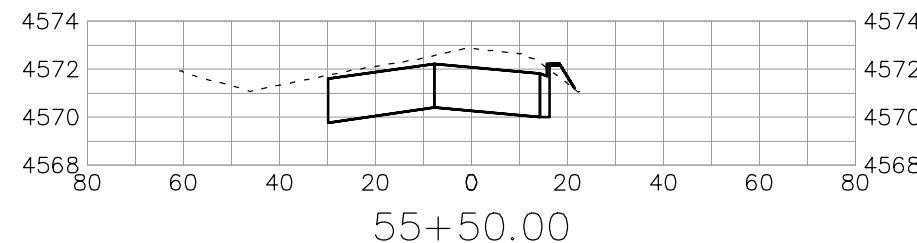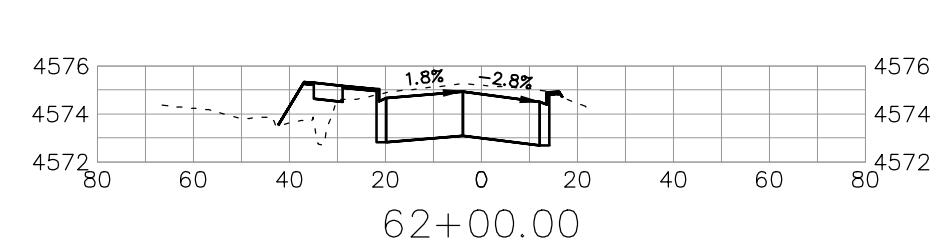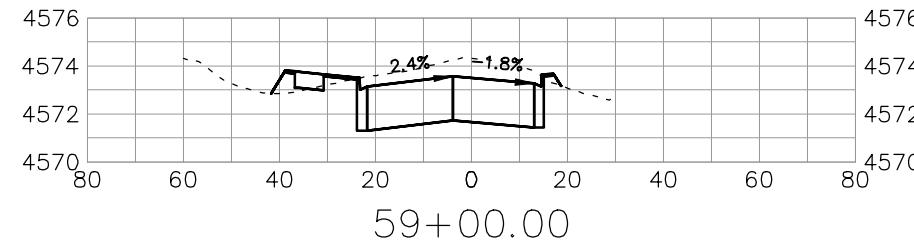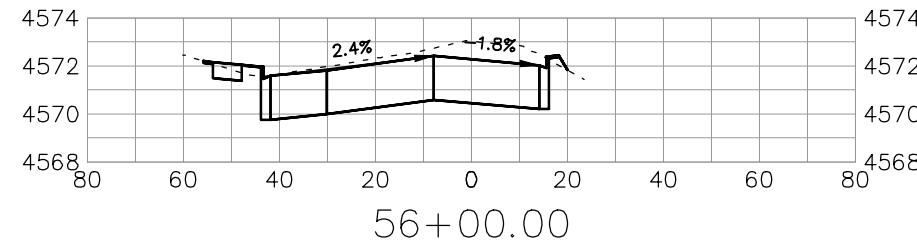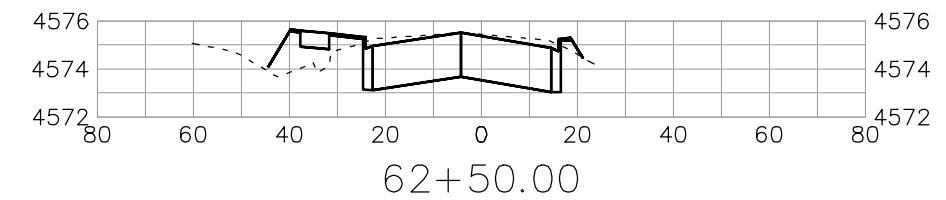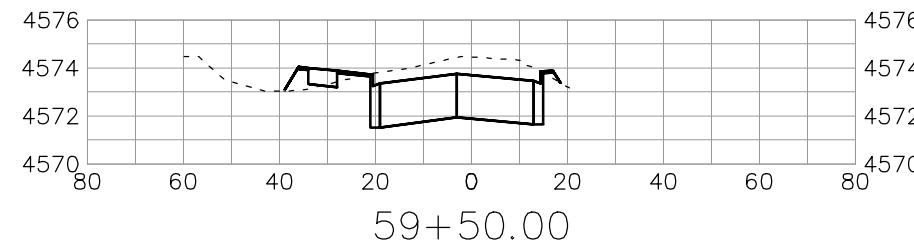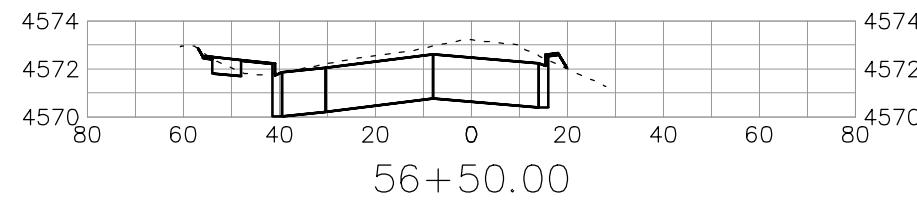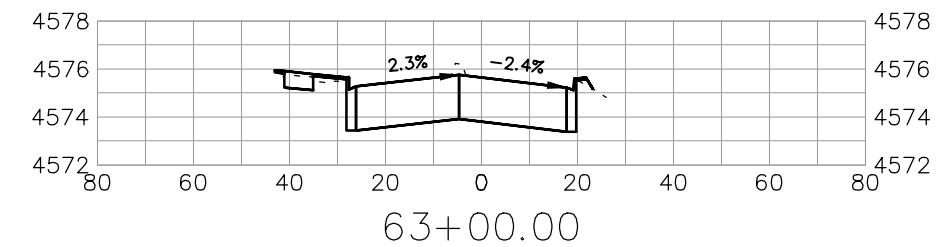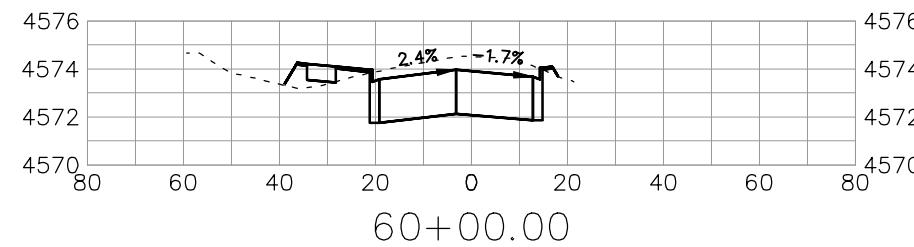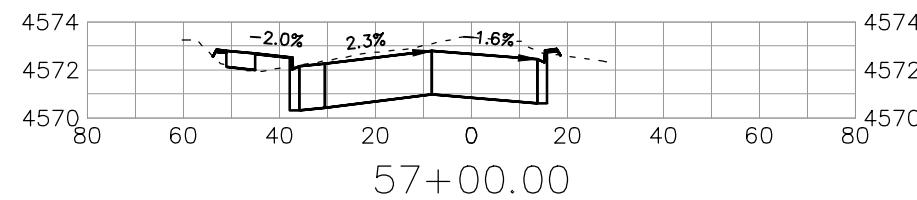

DESCRIPTION	DATE
DRAWN BY JCS	DATE 2020
DESIGNED BY JCS	DATE 2020
CHECKED BY ALC	DATE 2020
APPROVED BY TCP	DATE 2020

SCALES:
PLAN & PROFILE
0 10 20 40
HORIZONTAL
0 4 8
VERTICAL



PUBLIC WORKS
ENGINEERING DIVISION
PROJECT NO. 207-F1903

24 ROAD AND G ROAD
ROAD CROSS SECTIONS — G RD 6

Oversight / NHS

FHWA REGION VIII OVERSIGHT? NO YES

NATIONAL HIGHWAY SYSTEM? NO YES

PUBLIC WORKS, ENGINEERING DIVISION

CITY OF GRAND JUNCTION

Related Projects:

P. E. UNDER PROJECT:
Project Number XXXX XXXX-XXX
Project Code: XXXXX

R.O.W. Projects:

R.O.W. Project Description XXXX XXXX-XXX

BIKE PATH CONSTRUCTION BID PLANS OF PROPOSED FEDERAL AID PROJECT NO. XXXX XXXX-XXX 24 ROAD BIKE PATH MESA COUNTY CONSTRUCTION PROJECT CODE NO. XXXXX

SEC. 4, TOWNSHIP 1 SOUTH, RANGE 1 WEST, UTE PRINCIPAL MERIDIAN
SEC. 33, TOWNSHIP 1 NORTH, RANGE 1 WEST, UTE PRINCIPAL MERIDIAN


DESCRIPTION OF PROJECT

CONSTRUCT A BIKE PATH FROM THE END OF THE EXISTING PATH AT 659 MARKET ST TO CANYON VIEW PARK AT THE NORTH EAST CORNER OF 24 ROAD AND G ROAD. THIS IS A BIKE PATH FUNDED PROJECT WHICH INCLUDES UNCLASSIFIED EXCAVATION, AGGREGATE BASE COURSE, CONCRETE PAVEMENT, DRAINAGE PIPELINE INSTALLATION, SANITARY SEWER PIPELINE RELOCATION, POTABLE WATER PIPELINE RELOCATION, PEDESTRIAN TUNNEL INSTALLATION, AND PREFABRICATED STRUCTURAL STEEL BRIDGE INSTALLATION.

A MANDATORY PRE-BID CONFERENCE WILL BE HELD ON MONTH DAY, YEAR AT TIME XM AT THE MESA CONFERENCE ROOM LOCATED AT 606 SOUTH 9TH STREET (CDOT MAINTENANCE BUILDING), GRAND JUNCTION, COLORADO TO PRESENT A BRIEF OVERVIEW OF THE PROJECT AND TO ANSWER QUESTIONS FROM PROSPECTIVE BIDDERS.

TABULATION OF LENGTH

STATION	BIKE PATH	BRIDGE	TUNNEL
24 ROAD BIKE PATH STA 25+50 TO STA 48+50	2300	70	94
24 ROAD BIKE PATH STA 32+35 TO STA 33+05			
24 ROAD BIKE PATH STA 44+75 TO STA 45+69			
TOTAL FEET	2300	70	94
TOTAL MILES	0.44		

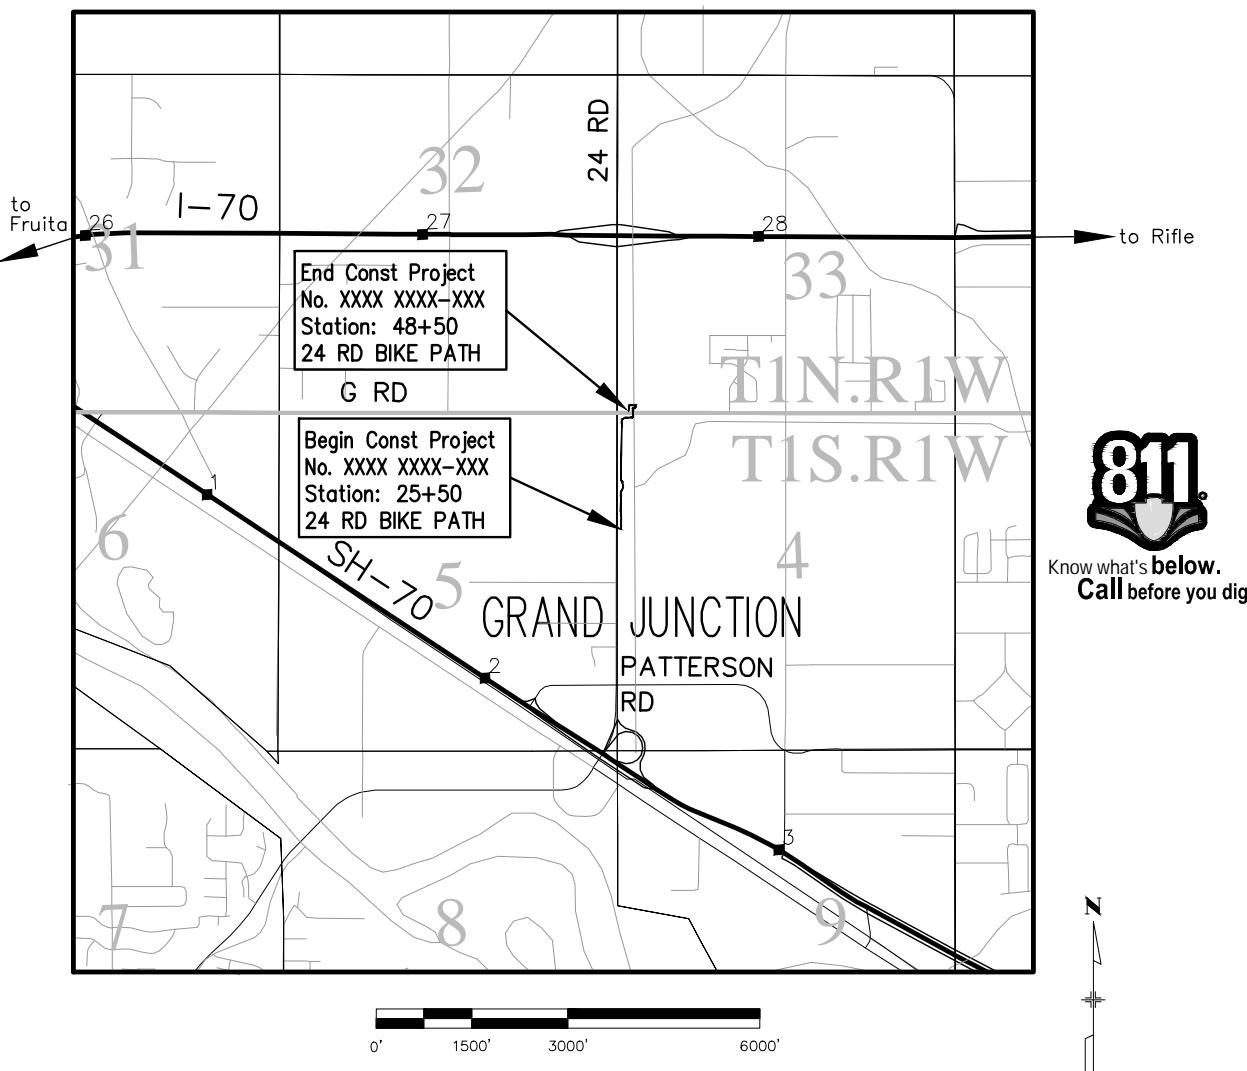

SHEET No. INDEX OF SHEETS

- 1 TITLE SHEET
- 2 CITY STANDARD ABBREVIATIONS, LEGEND, & SYMBOLS
- NA CDOT STANDARD PLAN LIST
- NA TYPICAL SECTIONS
- NA GENERAL NOTES
- NA PROJECT OVERVIEW
- NA SUMMARY OF APPROXIMATE QUANTITIES
- NA SUMMARY OF EARTHWORK QUANTITIES
- NA TABULATION OF REMOVALS
- NA TABULATION OF SURFACING
- NA TABULATION OF UNDERGROUND UTILITIES AND PEDESTRIAN TUNNEL
- NA TABULATION OF WALLS, HEADWALLS, AND WINGWALLS
- NA TABULATION OF MISCELLANEOUS ITEMS
- NA SURVEY TABULATION
- NA PROJECT SURVEY CONTROL
- NA REMOVAL PLAN
- NA UTILITY PLAN
- 3-4 SANITARY SEWER RELOCATE
- 5 WATER LINE RELOCATE
- 6-7 STORM DRAIN RELOCATE
- NA CULVERT PLAN AND PROFILES
- 8 PEDESTRIAN TUNNEL PLAN AND PROFILE
- NA WALL PLAN AND PROFILES
- 9-15 BIKE PATH IMPROVEMENT PLAN
- 16-19 BIKE PATH PROFILE
- 20-23 BIKE PATH CROSS SECTIONS
- NA STORM WATER MANAGEMENT PLAN
- NA STORM WATER MANAGEMENT SITE PLAN

SHEET No. BRIDGE PLANS

Print Date: as shown

File Name: as shown

Horiz. Scale: As Noted Vert. Scale: As Noted

Unit Information: City of GJ Unit Leader Initials: ALC

CITY OF
Grand Junction
COLORADO 333 West Avenue, Bldg C
Grand Junction, CO, 81501
Phone: 970-244-1554

Sheet Revisions

Date:	Comments	Init.

Colorado Department of Transportation

 606 South 9th Street
 Grand Junction, CO, 81501
 Phone: 970-683-6351 FAX: 970-683-6369
 Region 3 RBB

As Constructed

No Revisions:
Revised:
Void:
Comments:

Contract Information

Contractor:	NHPP xxxx-xxx
Resident Engineer:	xxxxx
Project Engineer:	
PROJECT STARTED: ____/____/____	ACCEPTED: ____/____/____
Comments:	


Project No./Code

Sheet Number 1



ABBREVIATIONS

AASHTO	AMERICAN ASSOCIATION OF STATE HIGHWAY & TRANSPORTATION OFFICIALS
ABC	AGGREGATE BASE COURSE
AC	ASBESTOS CEMENT
AP	ANGLE POINT
ASB	ANCHORED STRAW BALES
ASP	ALUMINIZED STEEL PIPE
ASTM	AMERICAN SOCIETY FOR TESTING MATERIALS
AWWA	AMERICAN WATER WORKS ASSOCIATION
BC	BACK OF CURB
BF	BUTTERFLY VALVE
BOW	BACK OF WALK
BCR	BEGIN CURB RETURN
BOT	BOTTOM
BSWMP	BETTER STORM WATER MANAGEMENT PRACTICES
CH	CHORD
CAP	CORRUGATED ALUMINUM PIPE
CDOT	COLORADO DEPARTMENT OF TRANSPORTATION
CI	CAST IRON
C,G,& SW	CURB, GUTTER & SIDEWALK
CL	CENTER LINE
CMP	CLEAR
CO	CORRUGATED METAL PIPE
COMB	CLEAN OUT
CONC	COMBINATION (AS IN STORM SEWER AND SANITARY SEWER)
CSM	CONCRETE
CSP	CITY SURVEY MONUMENT
CU	CORRUGATED STEEL PIPE
DI	COPPER
DWY	DUCTILE IRON
E	DRIVEWAY
ECR	ELECTRIC
EG	END CURB RETURN
EL	EDGE OF GUTTER
EP	ELEVATION
EX	EDGE OF PAVEMENT
FB	EXISTING
FC	FULL BODY
FG	FACE OF CURB
FL	FINISHED GRADE
FM	FLOW LINE
FO	FLANGE
FO	FORCE MAIN
FS	FIBER OPTICS
FS	FAR SIDE
FTG	FOOTING
G	GAS
GB	GRADE BREAK
GM	GAS METER
GV	GATE VALVE
HBP	HOT BITUMINOUS PAVEMENT
HDPE	HIGH DENSITY POLYETHYLENE
INV	INVERT
IRR	IRRIGATION
L	LENGTH OF ARC
LC	LONG CHORD
LF	LINEAR FEET
LL	LONG ARC
LS	SHORT ARC
LT	LEFT
MB	MAILBOX
MCSM	MESA COUNTY SURVEY MONUMENT
MH	MANHOLE
MJ	MECHANICAL JOINT
MW	MILL WRAP
N/A	NOT APPLICABLE
NIC	NOT IN CONTRACT
NOP	NO ONE PERSON
NRCP	NON-REINFORCED CONCRETE PIPE
NS	NEAR SIDE
NTS	NOT TO SCALE
OHP	OVERHEAD POWER
OHT	OVERHEAD TELEPHONE
PC	POINT OF CURVATURE
PCC	POINT OF COMPOUND CURVATURE
PE	POLYETHYLENE
PERF	PERFORATED
PI	POINT OF INTERSECTION
PIP	PLASTIC IRRIGATION PIPE
POC	POINT ON CURVE
POT	POINT ON TANGENT
PR	PROPOSED
PRC	POINT OF REVERSE CURVATURE
PT	POINT OF TANGENCY
PVC	POLYVINYL CHLORIDE
R	RADIUS
RCP	REINFORCED CONCRETE PIPE
REQ'D	REQUIRED
RG	RESTRAINED GLANDS
RL	LONG RADIUS
ROW	RIGHT OF WAY
RP	RADIUS POINT
RR	RAIL ROAD
RS	SHORT RADIUS
RT	RIGHT
S	SLOPE
SAN	SANITARY
SC	SHORT CHORD
SCD	STANDARD CONTRACT DOCUMENTS
SCH	SCHEDULE
SF	SILT FENCE
SL	SECTION LINE
SSRB	STANDARD SPECIFICATIONS FOR ROAD & BRIDGE CONSTRUCTION
SSUU	STANDARD SPECIFICATIONS FOR CONSTRUCTION OF UNDERGROUND UTILITIES
STA	STATION
STL	STEEL
STM	STORM
T	TELEPHONE
TAN	LENGTH OF TANGENT
TC	TOP OF CURB
TH	TEST HOLE
TV	TELEVISION
(TYP)	TYPICAL
UU	UNDERGROUND UTILITIES
VC	VERTICAL CURVE
VCP	VITRIFIED CLAY PIPE
VPC	VERTICAL POINT OF CURVATURE
VPCC	VERTICAL POINT OF COMPOUND CURVATURE
VPRC	VERTICAL POINT OF REVERSE CURVATURE
VPI	VERTICAL POINT OF INTERSECTION
VPT	VERTICAL POINT OF TANGENCY
W	WATER
△	DELTA ANGLE




LEGEND

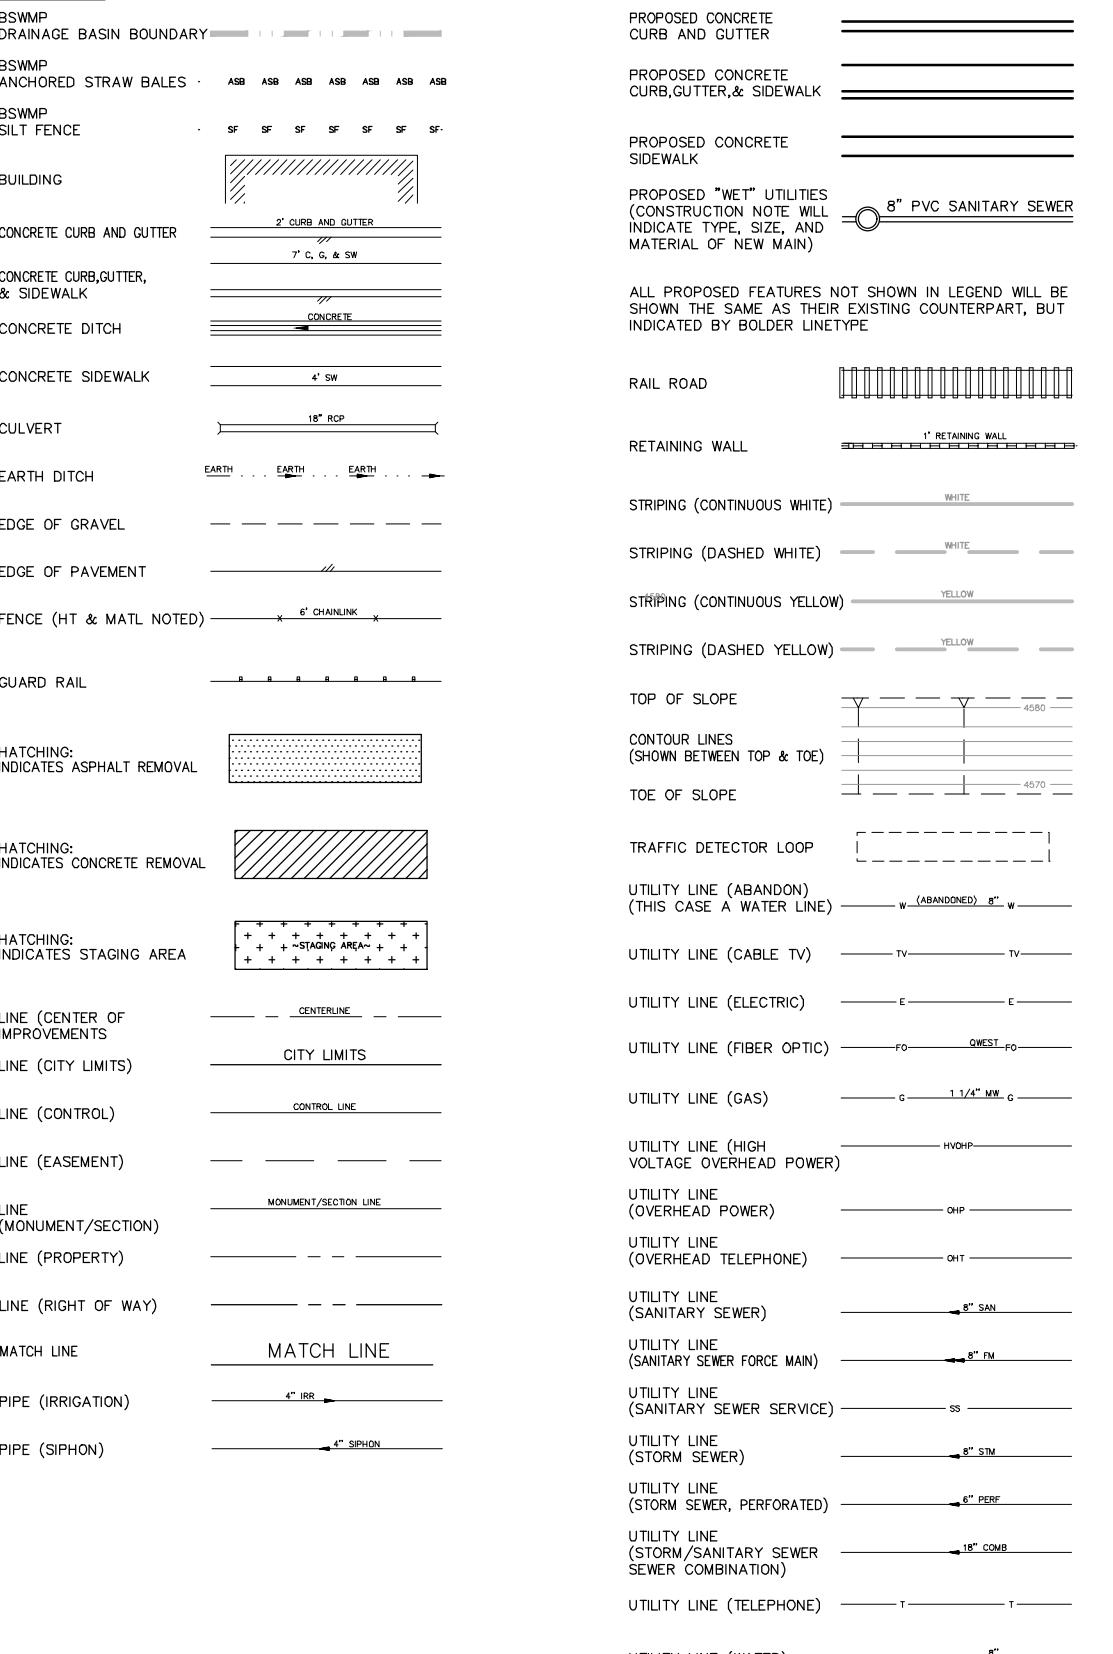

SYMBOLS

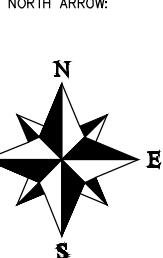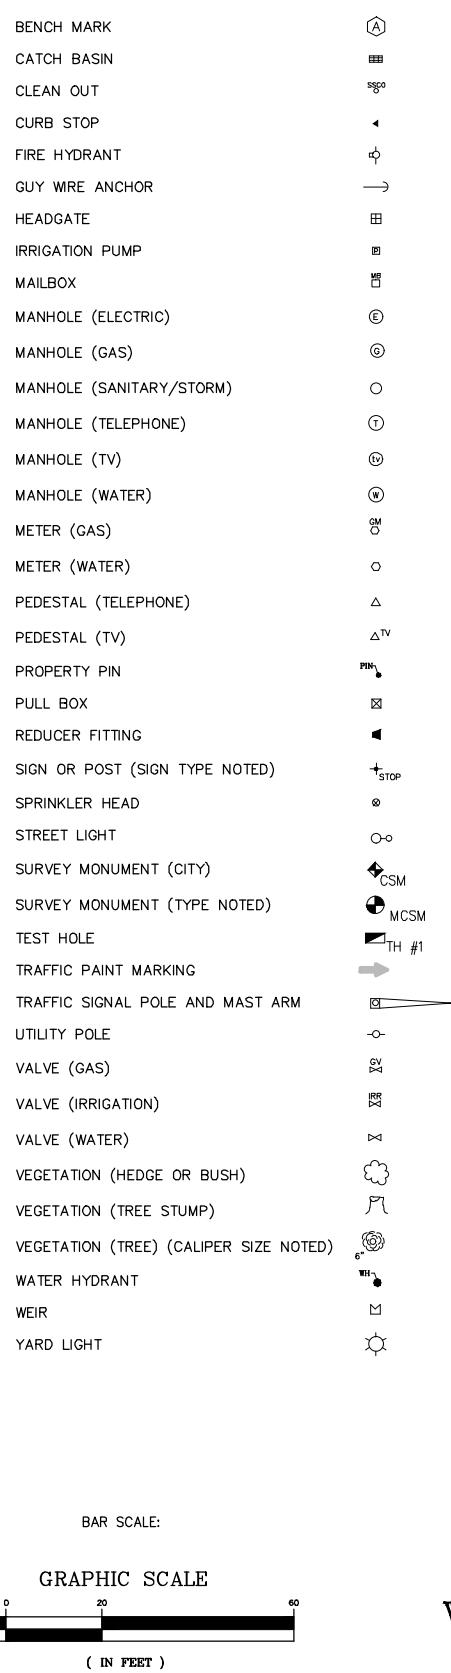

NORTH ARROW:

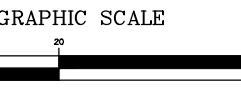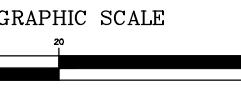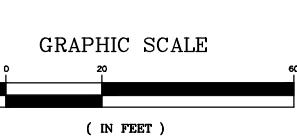



PUBLIC WORKS
ENGINEERING DIVISION
PROJECT NO. FUND-ACTIVITY NO.


24 ROAD BIKE PATH
STANDARD ABBREVIATIONS LEGENDS &
SYMBOLS


DESCRIPTION	DATE
REVISION △ REV 1	DATE
REVISION △ REV 2	DATE
REVISION △ REV 3	DATE
REVISION △ REV 4	DATE
DRAWN BY JCS	DATE 2020
DESIGNED BY JCS	DATE 2020
CHECKED BY ALC	DATE 2020
APPROVED BY TCP	DATE 2020



SEE PLAN FOR SCALE INFO

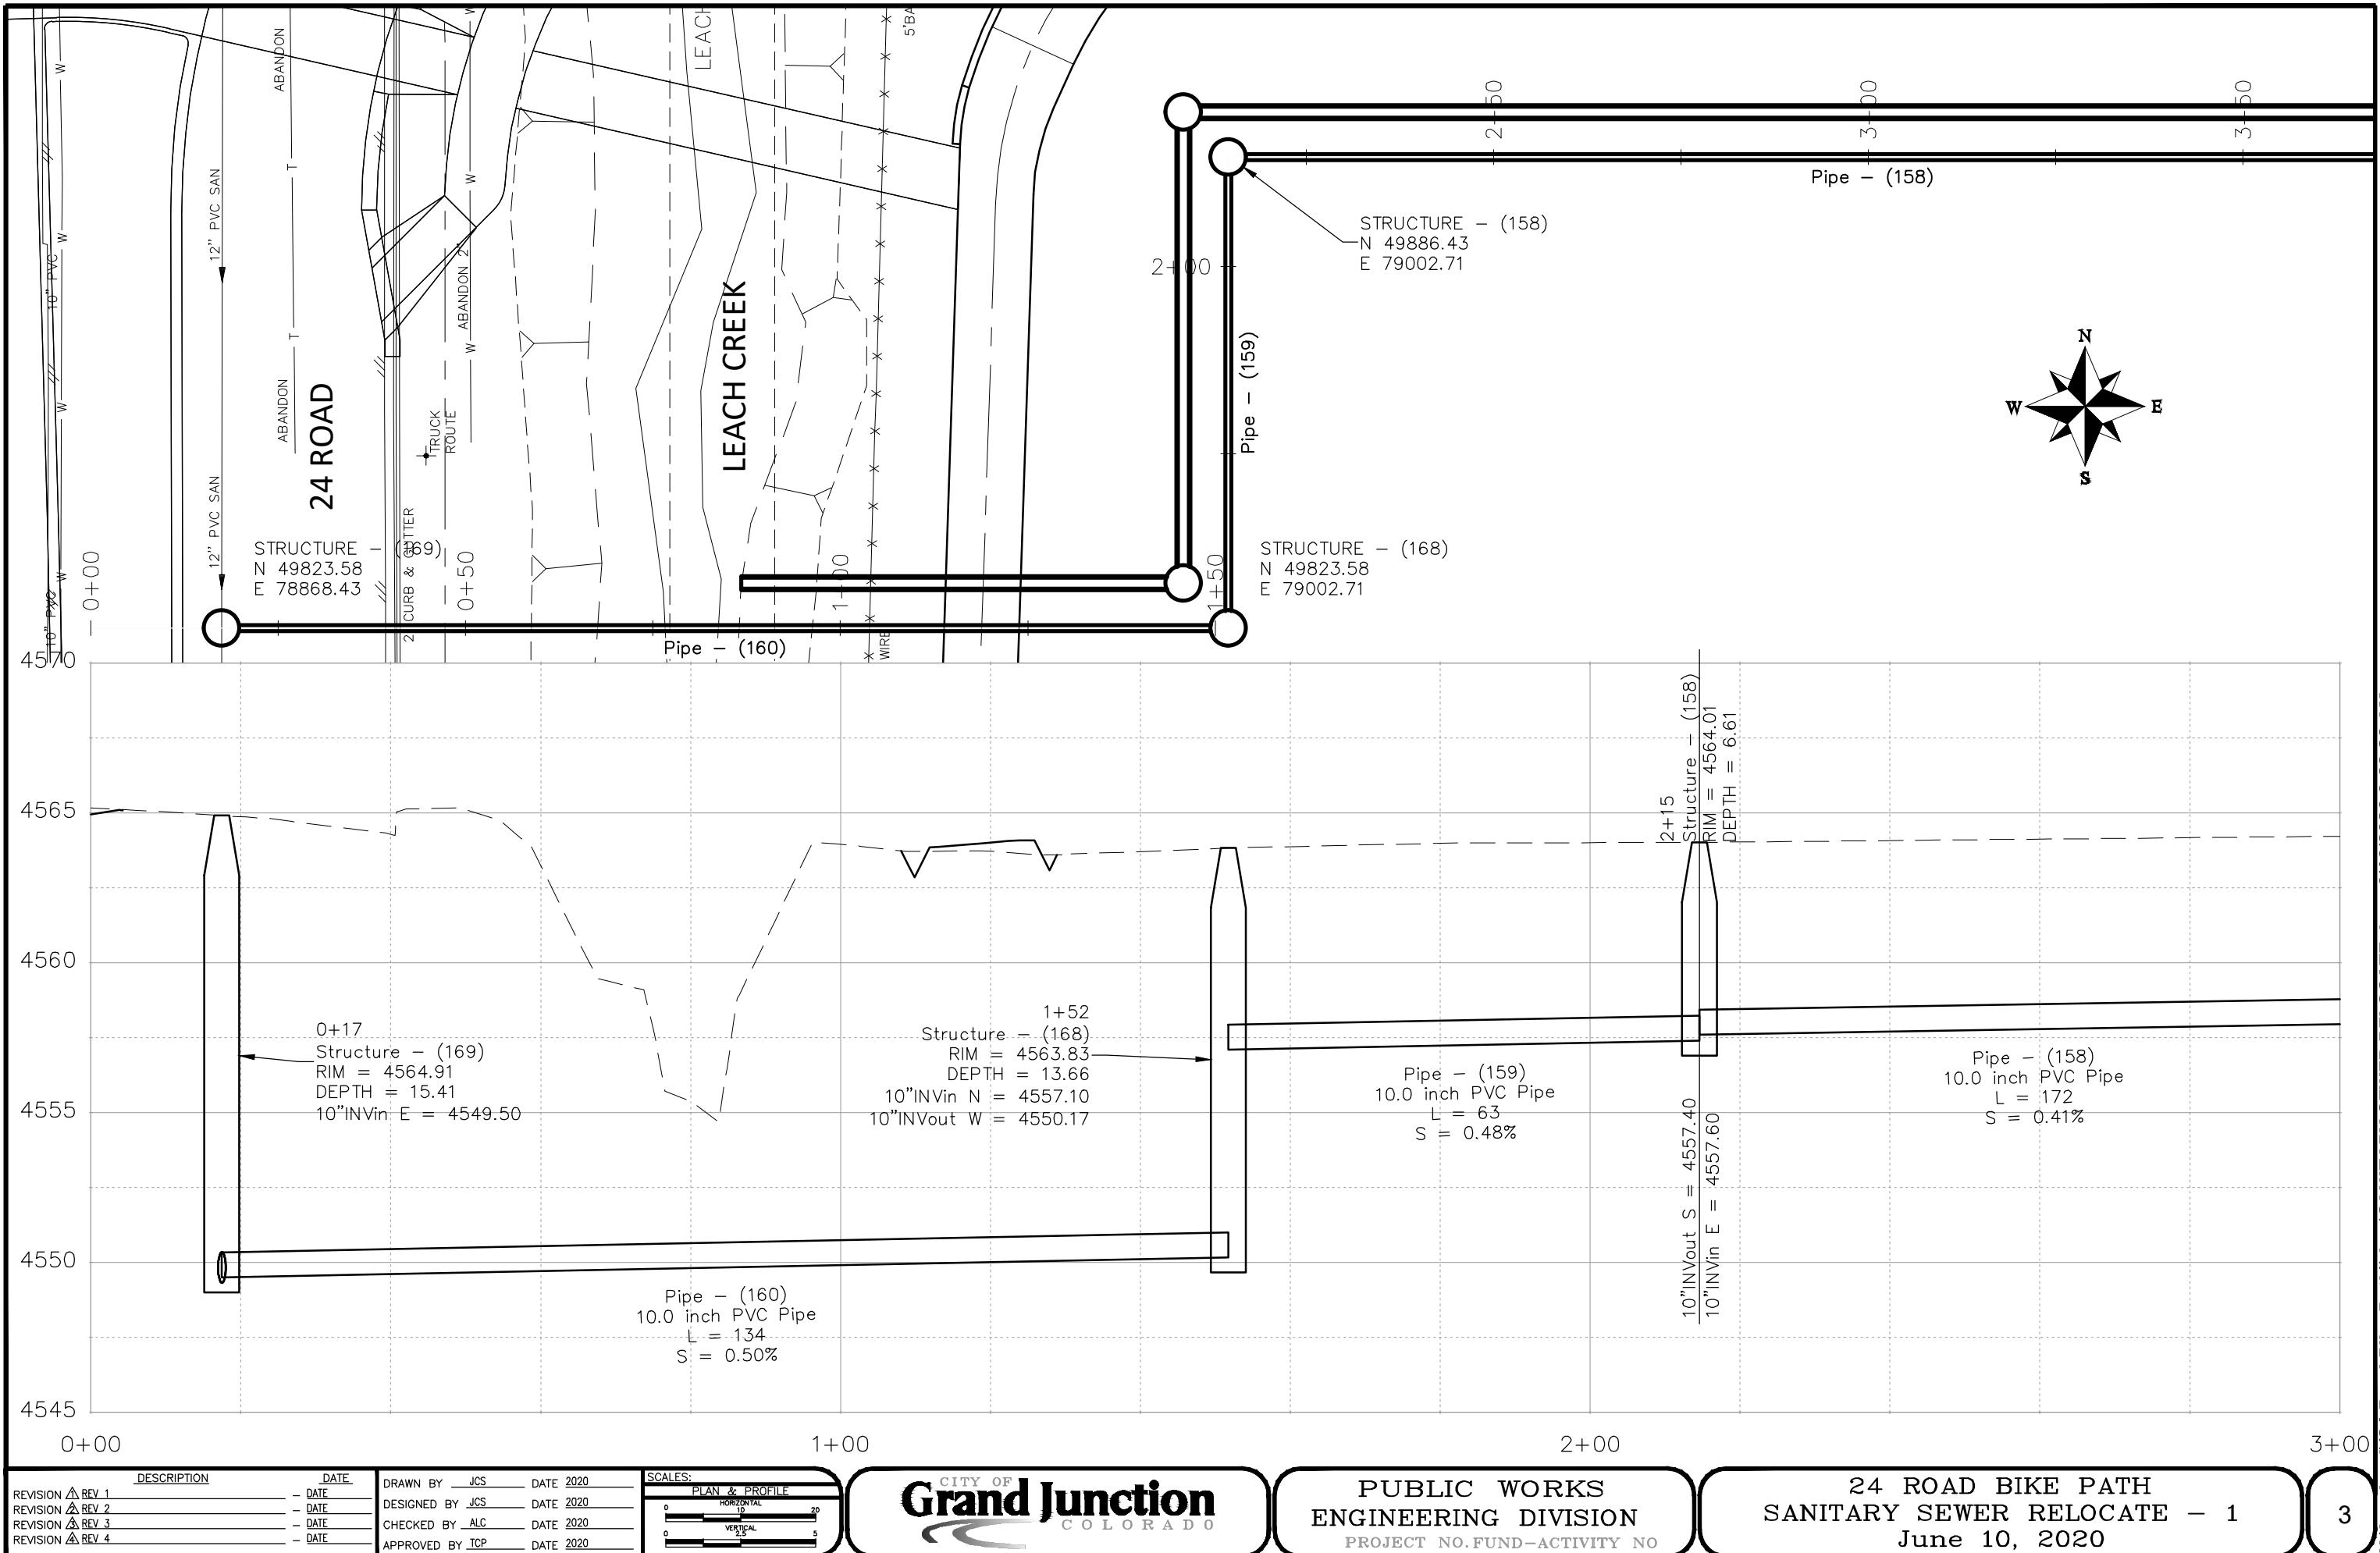

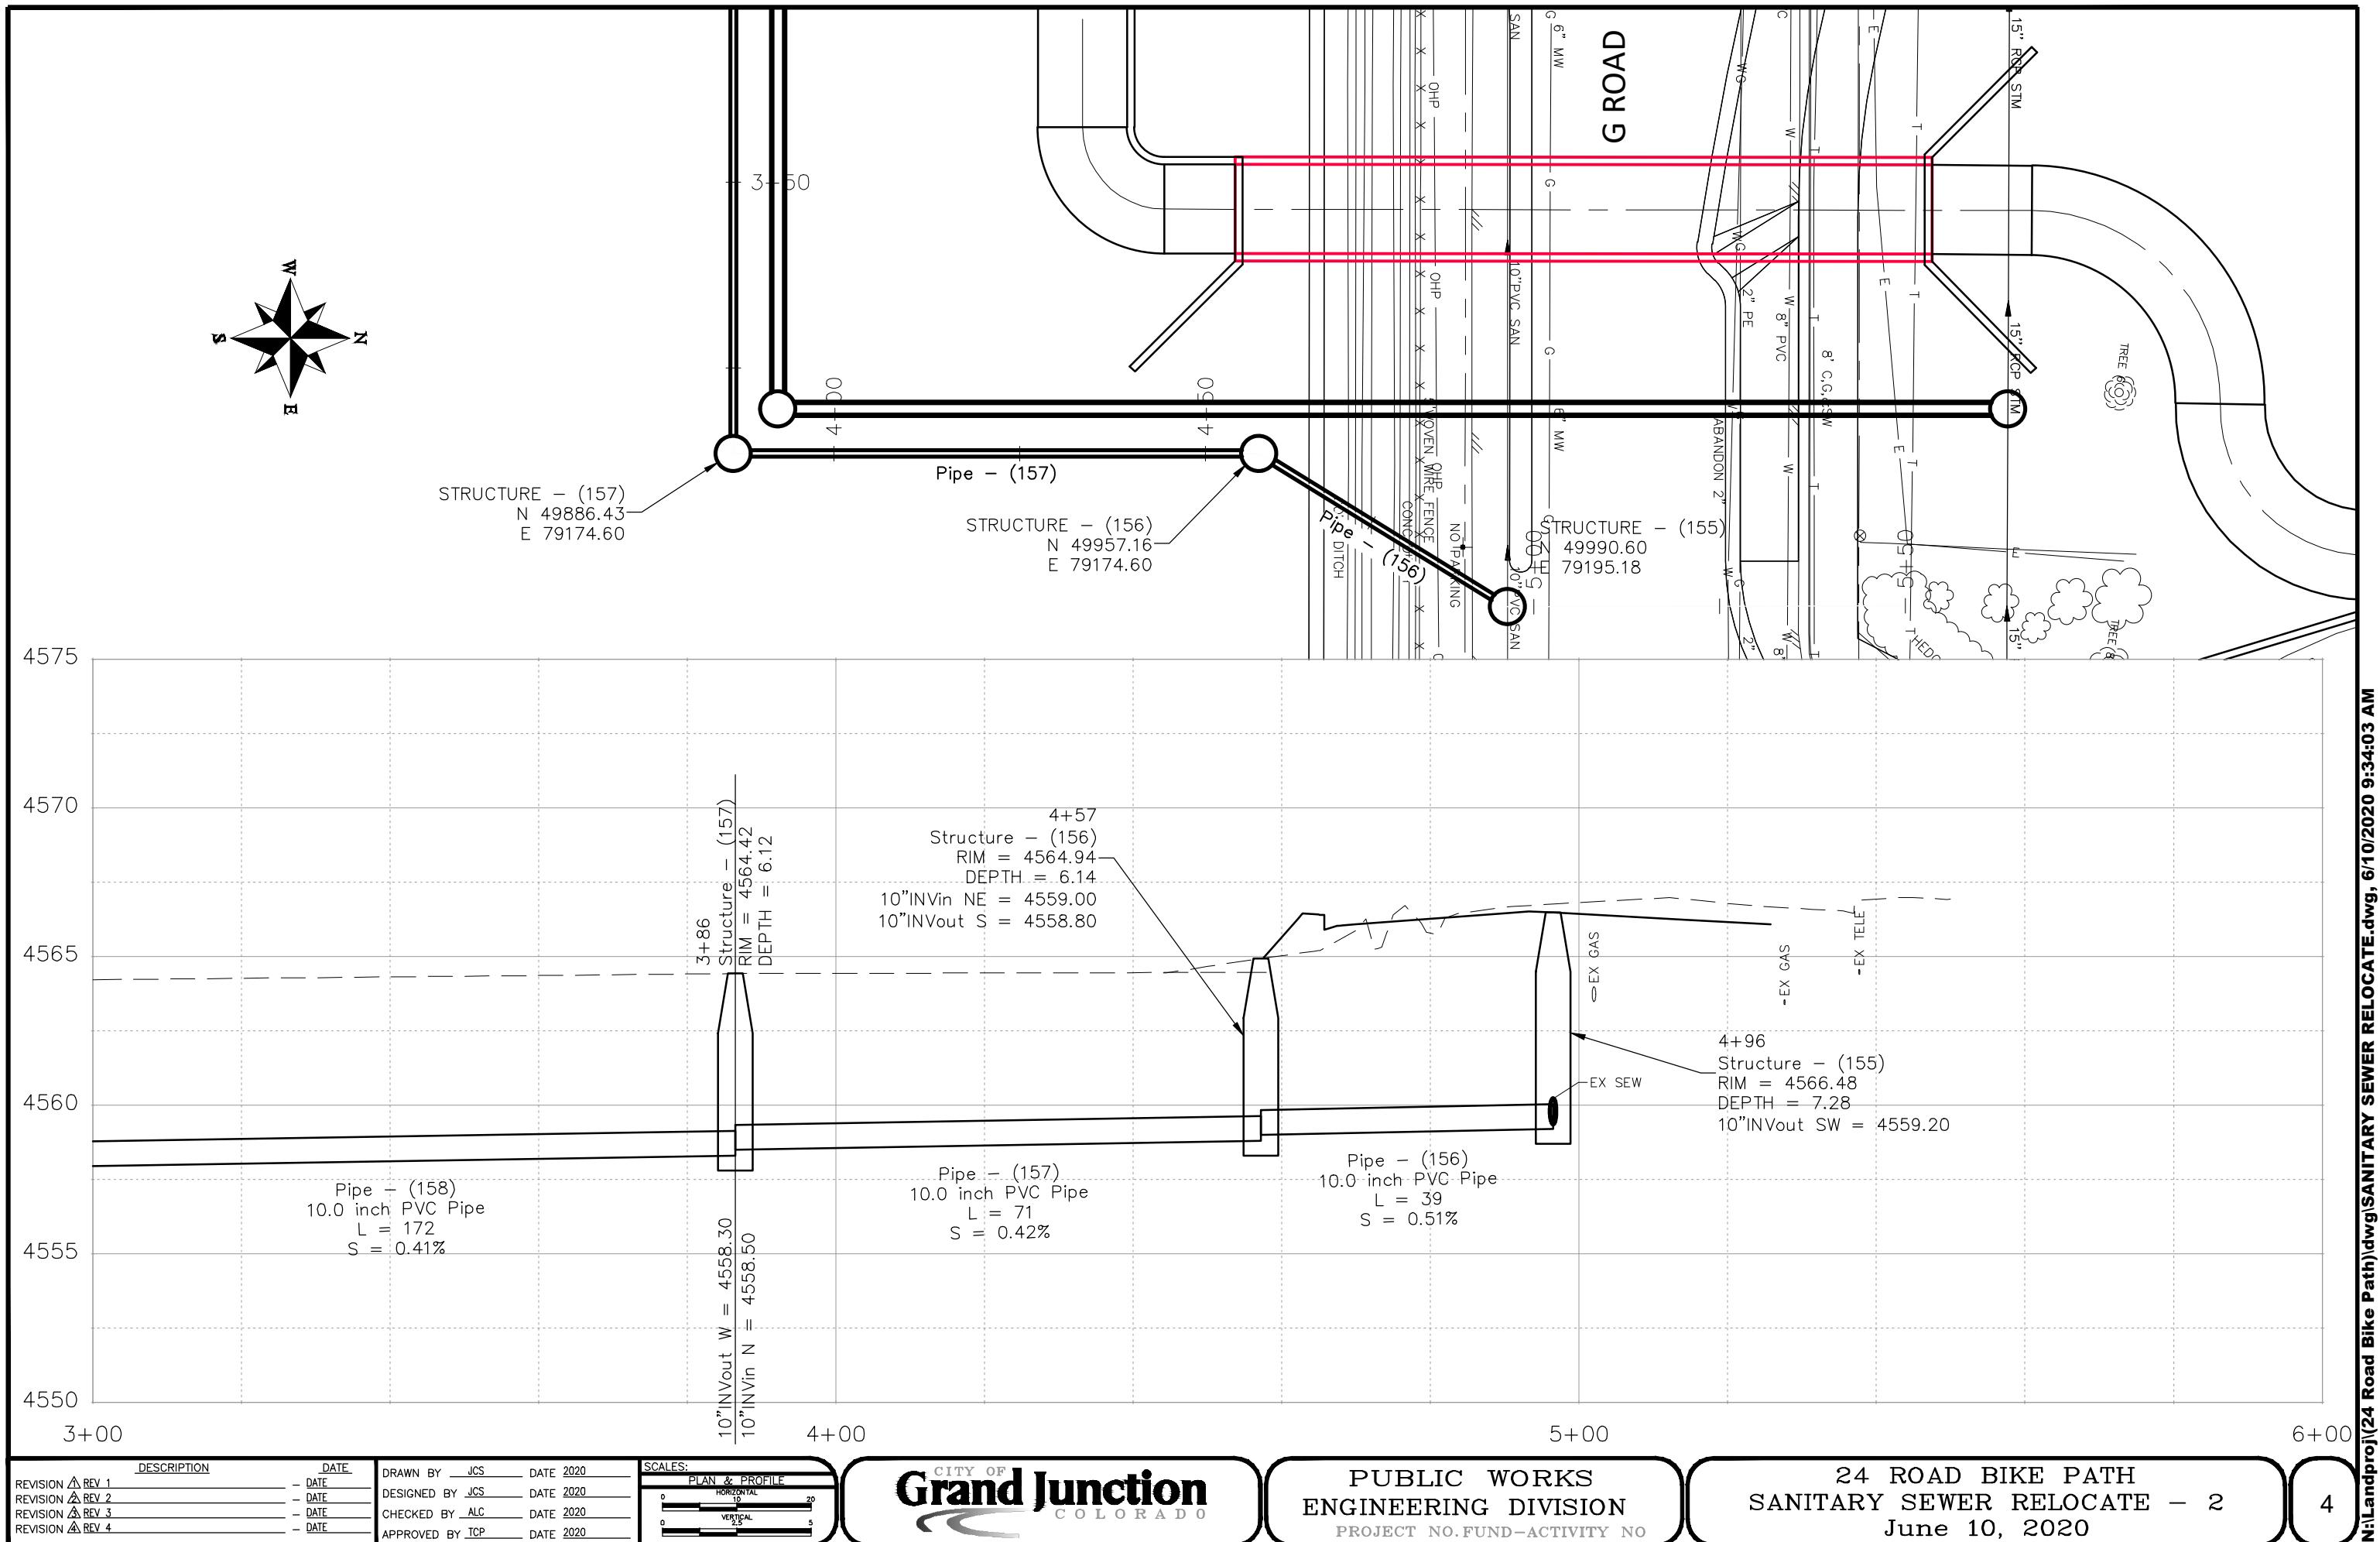

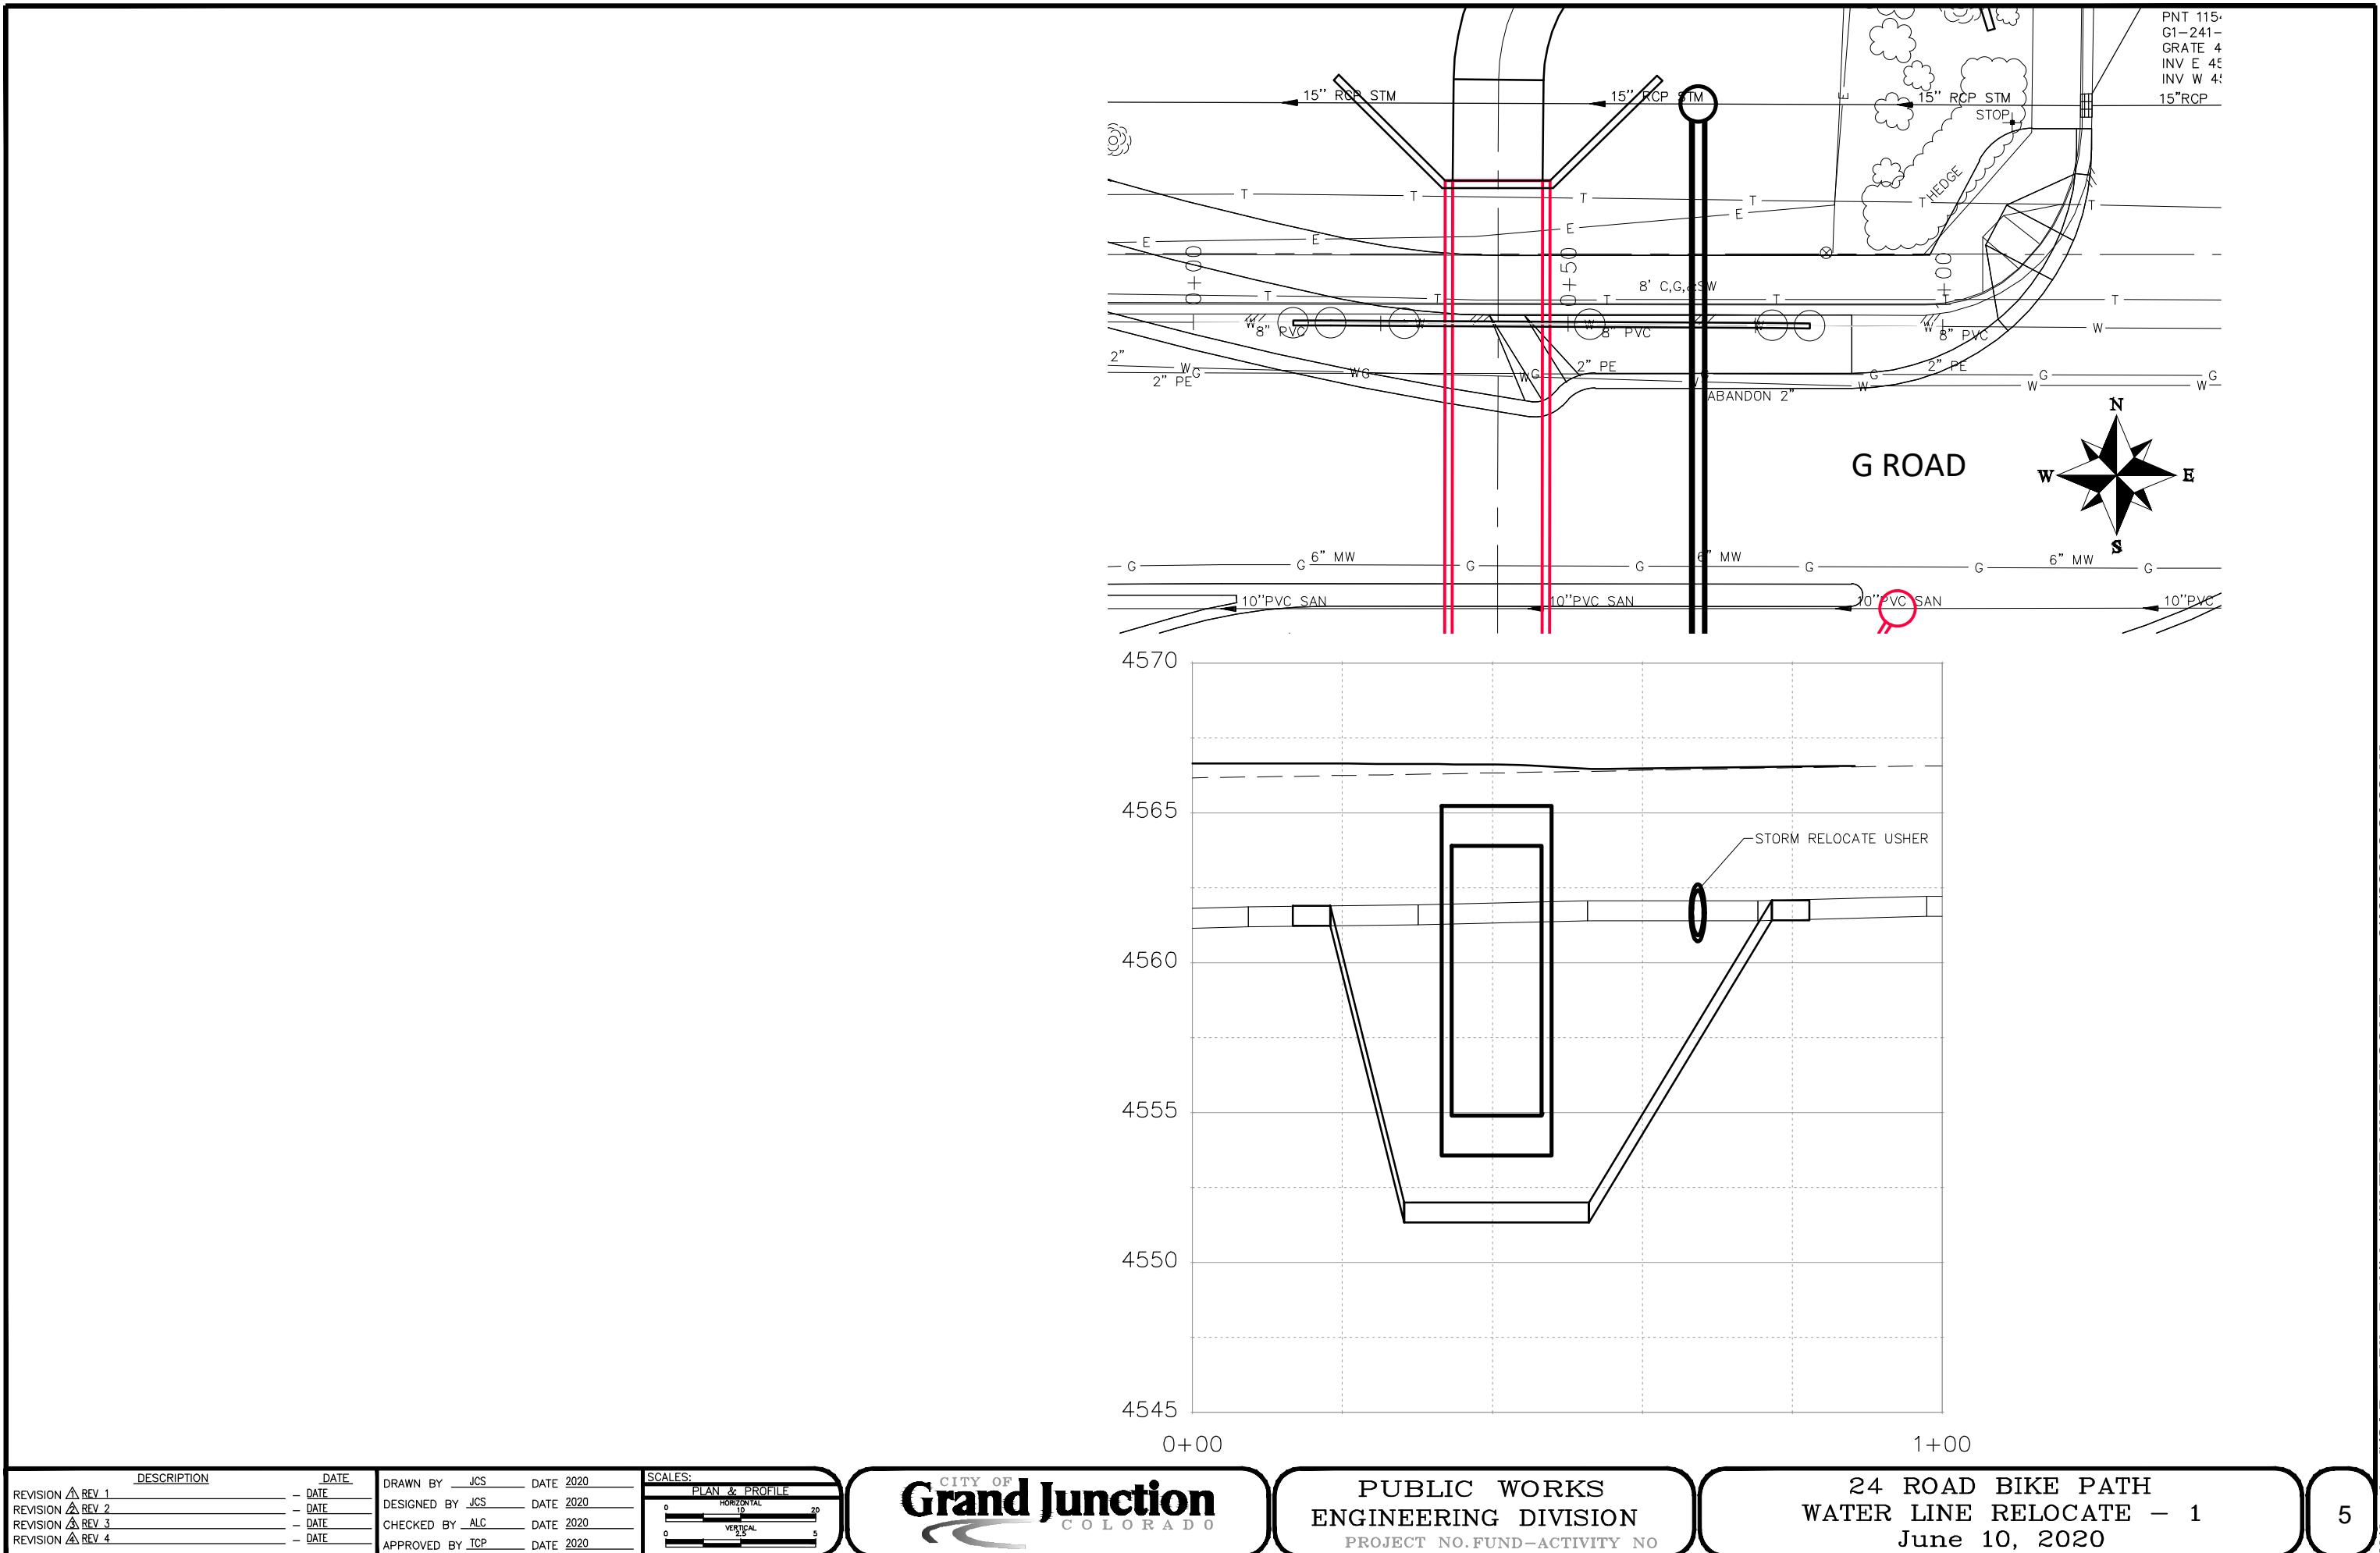

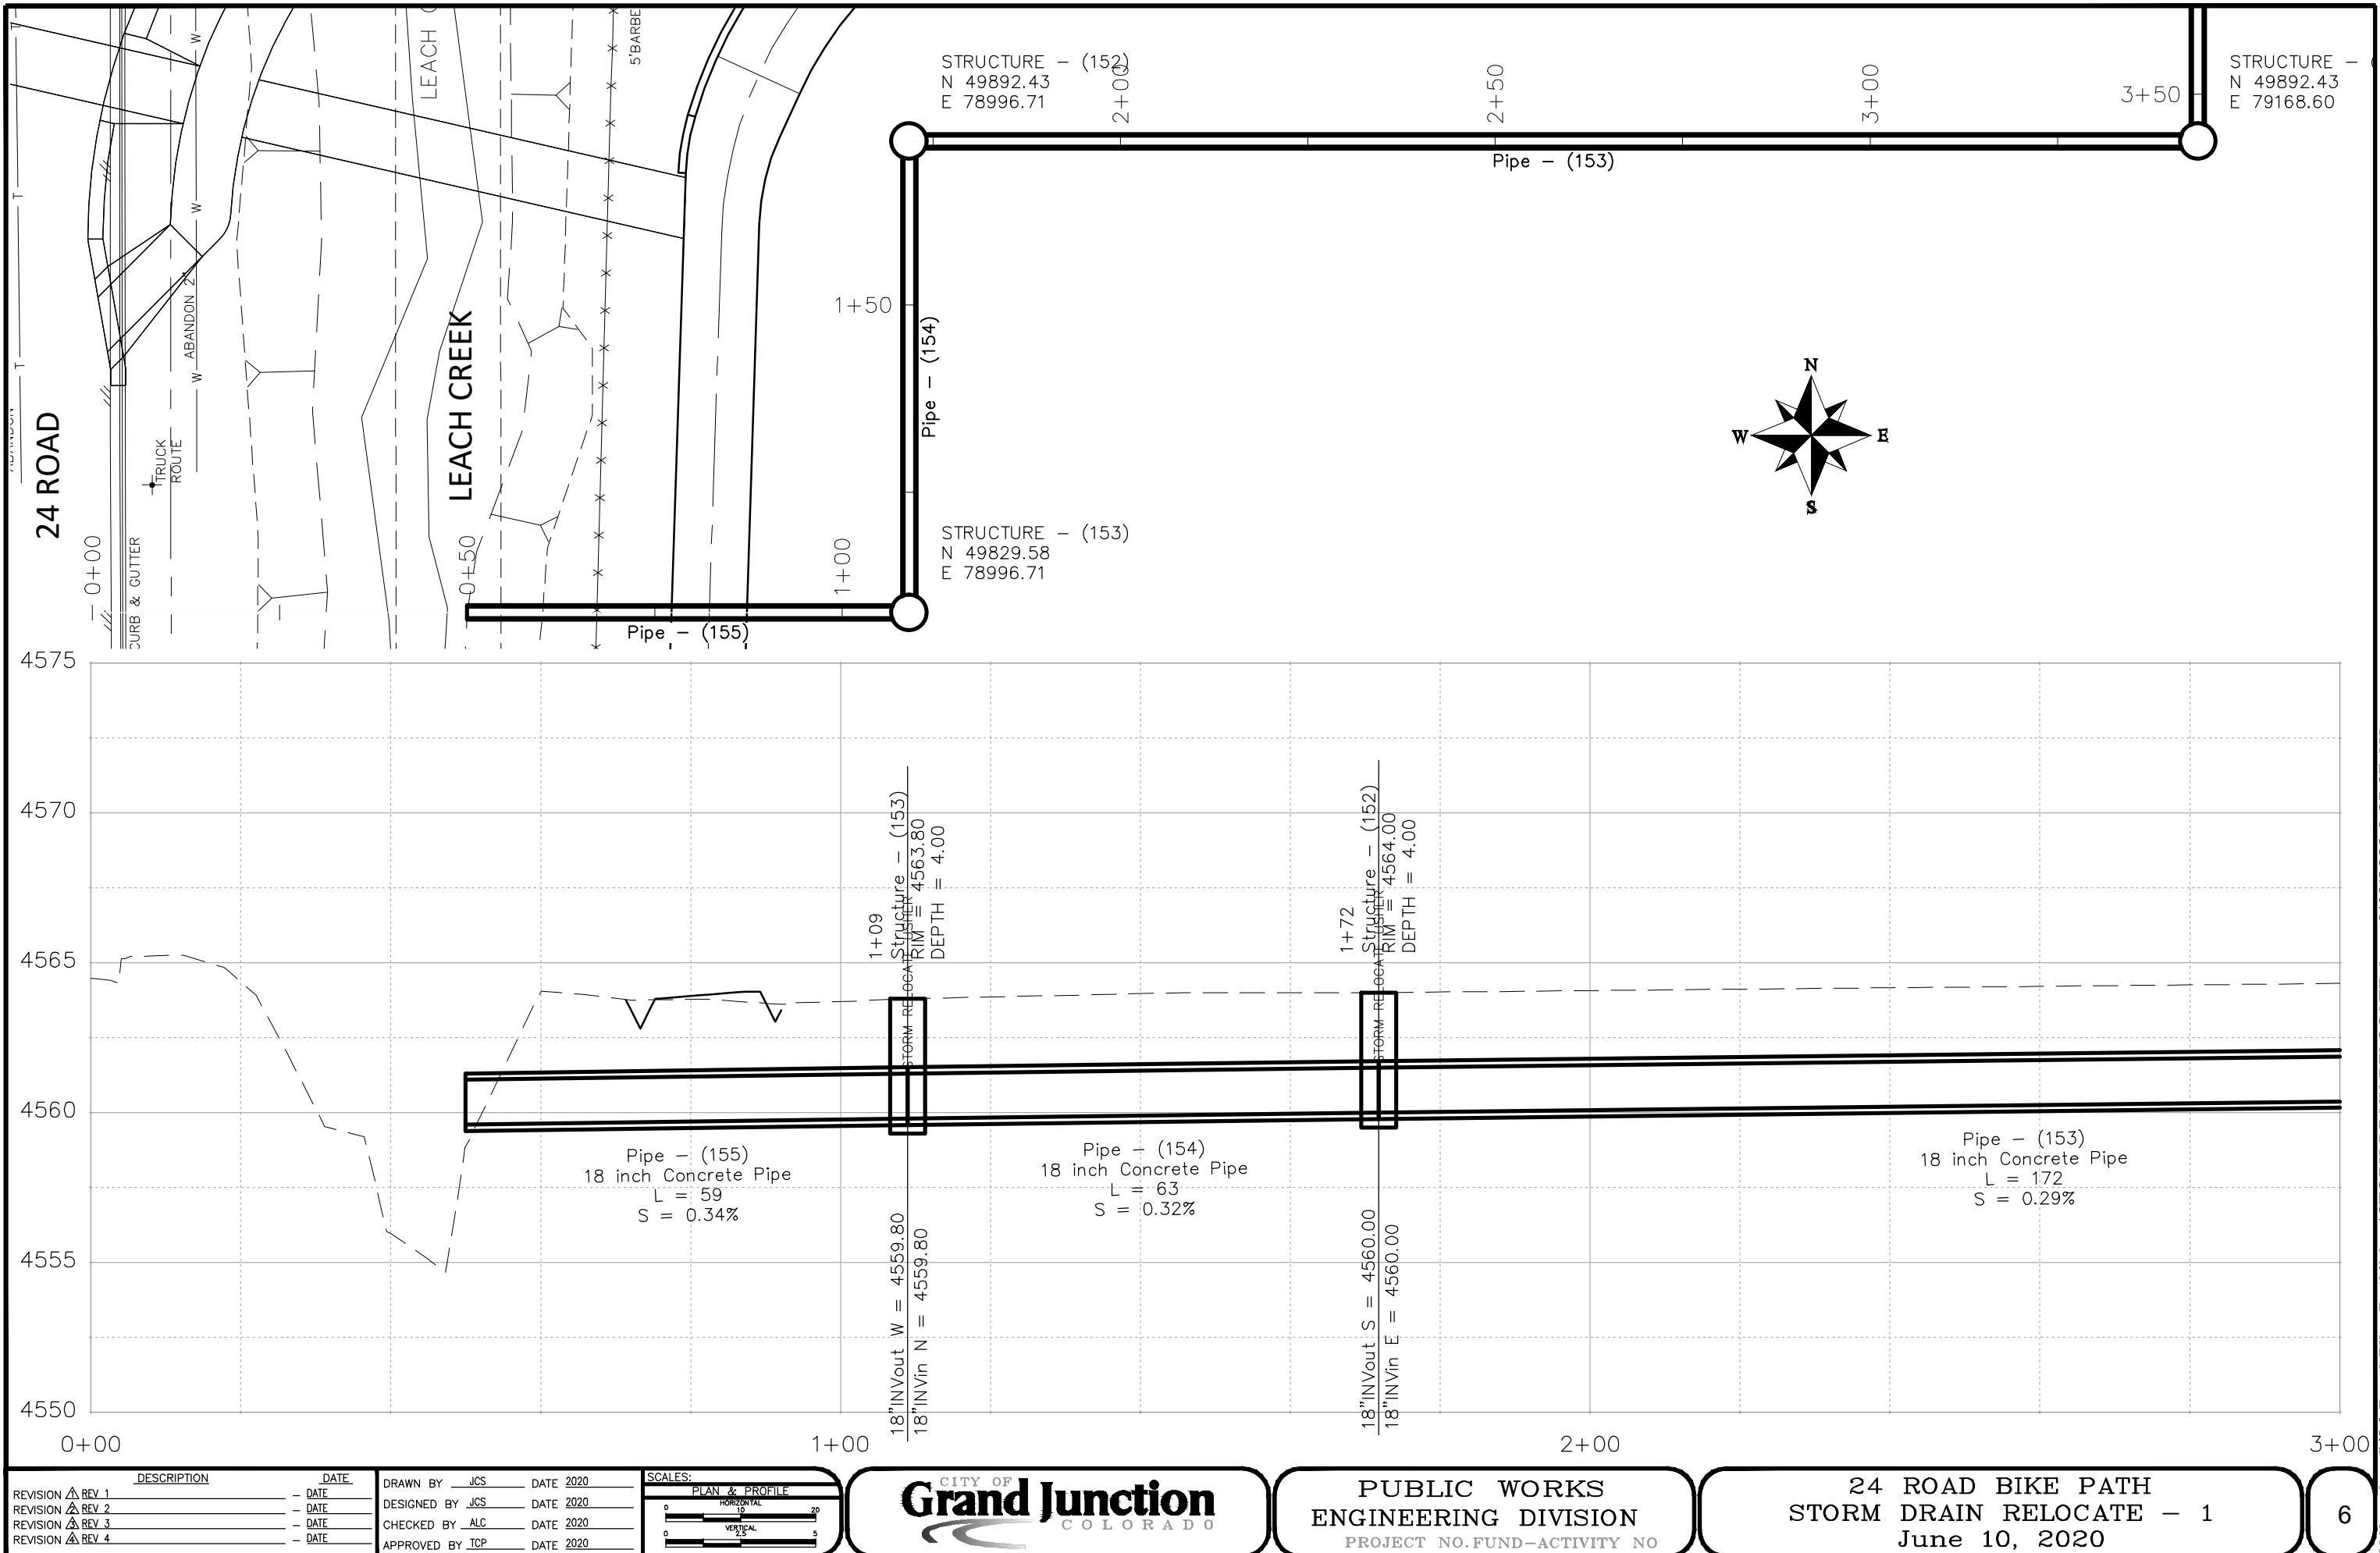

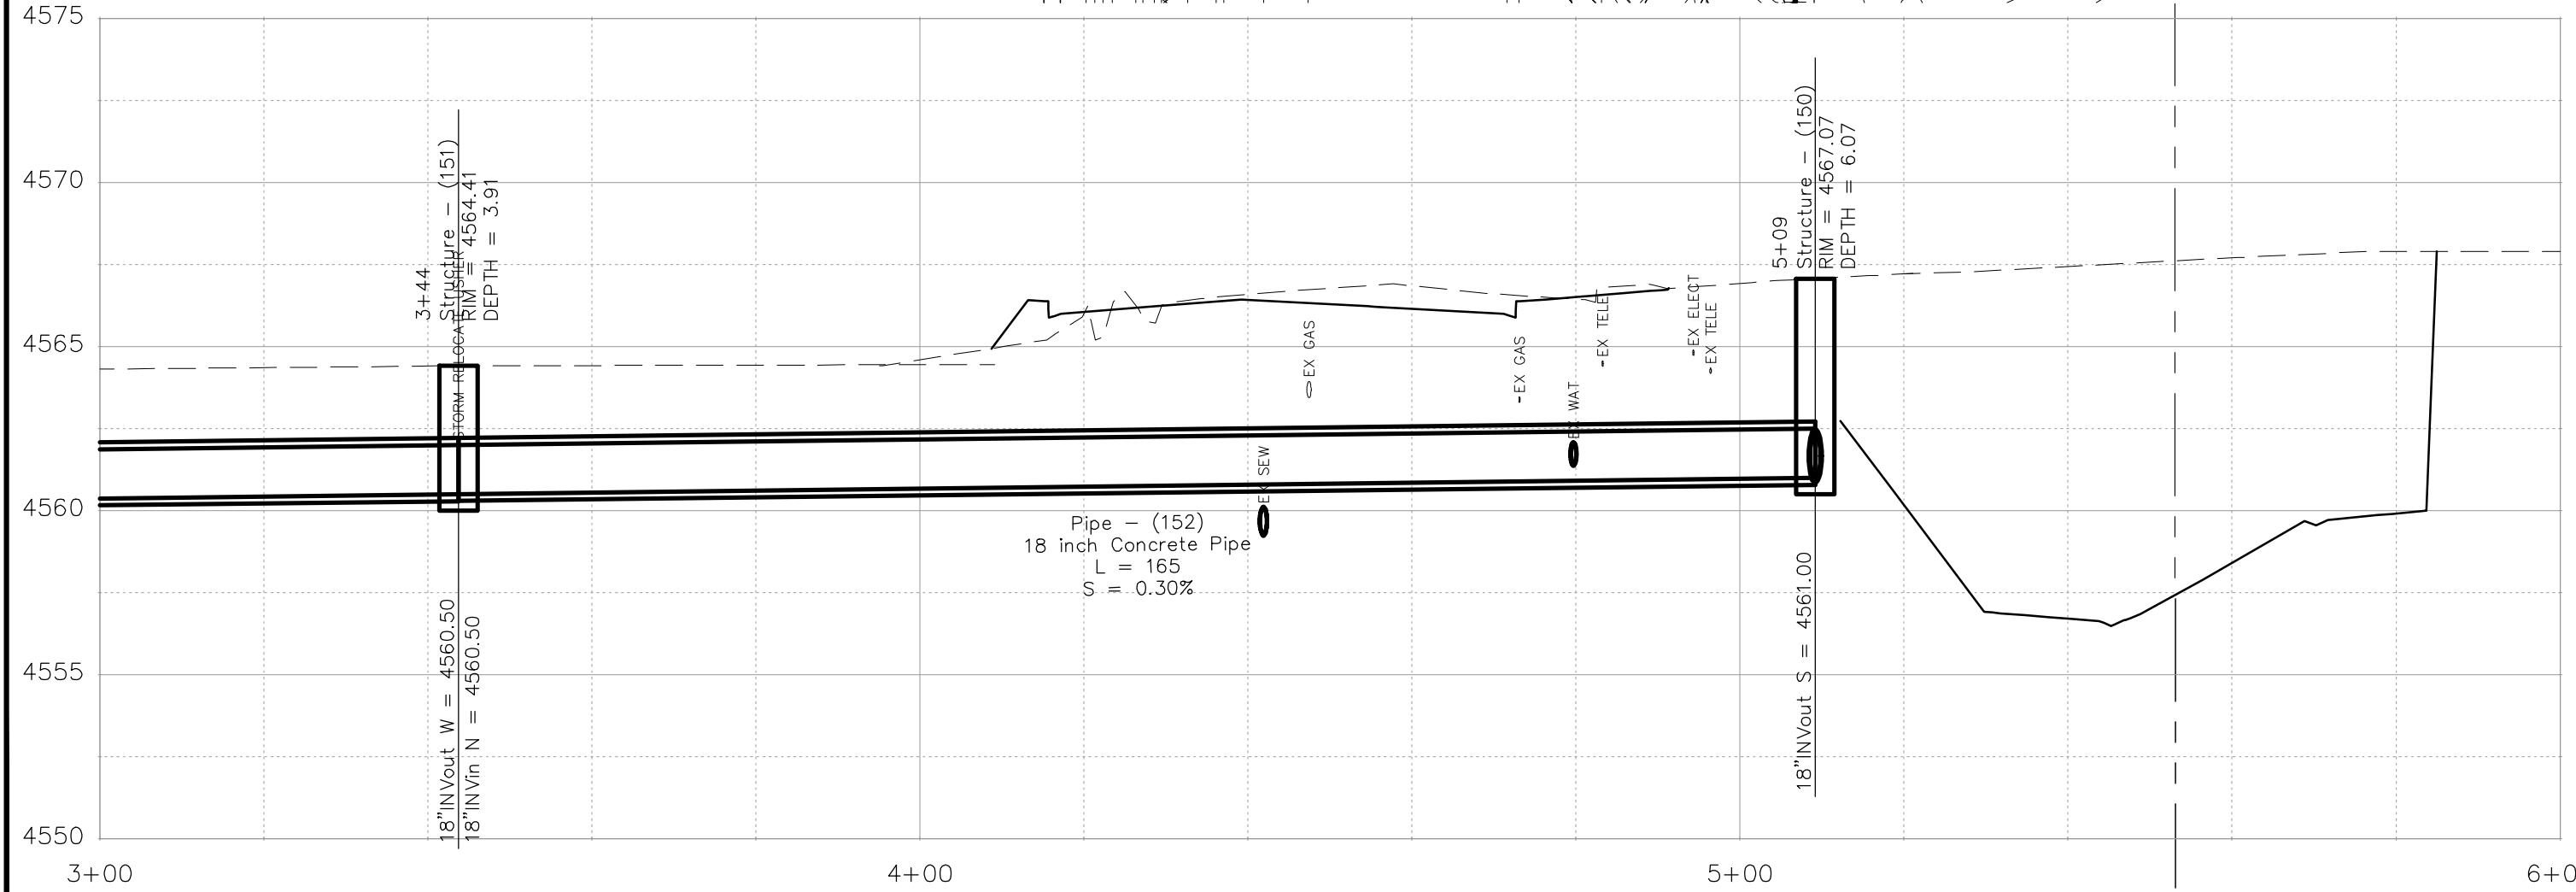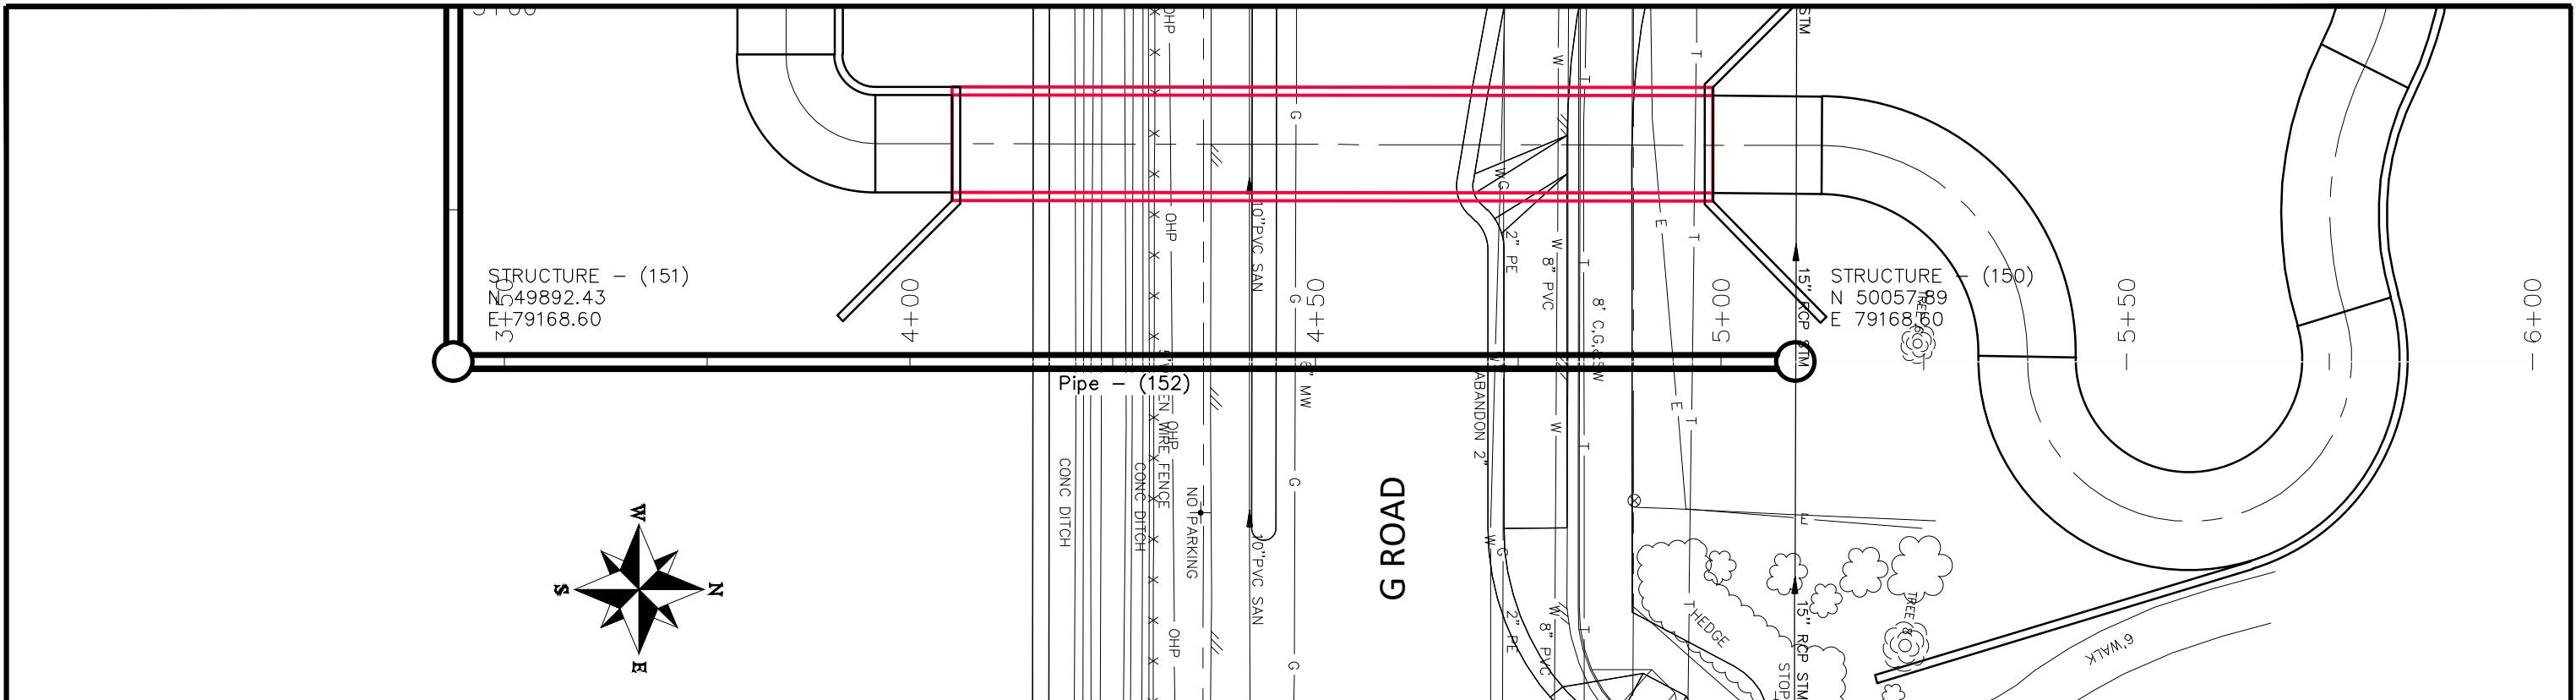

DESCRIPTION	DATE
REVISION A REV 1	DATE
REVISION A REV 2	DATE
REVISION A REV 3	DATE
REVISION A REV 4	DATE

DRAWN BY	JCS	DATE 2020
DESIGNED BY	JCS	DATE 2020
CHECKED BY	ALC	DATE 2020
APPROVED BY	TCP	DATE 2020

SCALES:		
PLAN & PROFILE	HORIZONTAL	20'
0	10'	20'
0	5'	
	VERTICAL	5'


Grand Junction
CITY OF
COLORADO

PUBLIC WORKS
ENGINEERING DIVISION
PROJECT NO. FUND-ACTIVITY NO.

24 ROAD BIKE PATH
STORM DRAIN RELOCATE - 2
June 10, 2020

2945-042-00-018
Southeast Corner of 24 & G Rd
USHER NV LLC

2701-333-00-152
728 24 RD
CITY OF GRAND JUNCTION

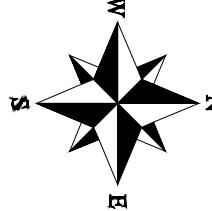



— 0+00

10


= 2 + 50

- 3+00

G ROAD

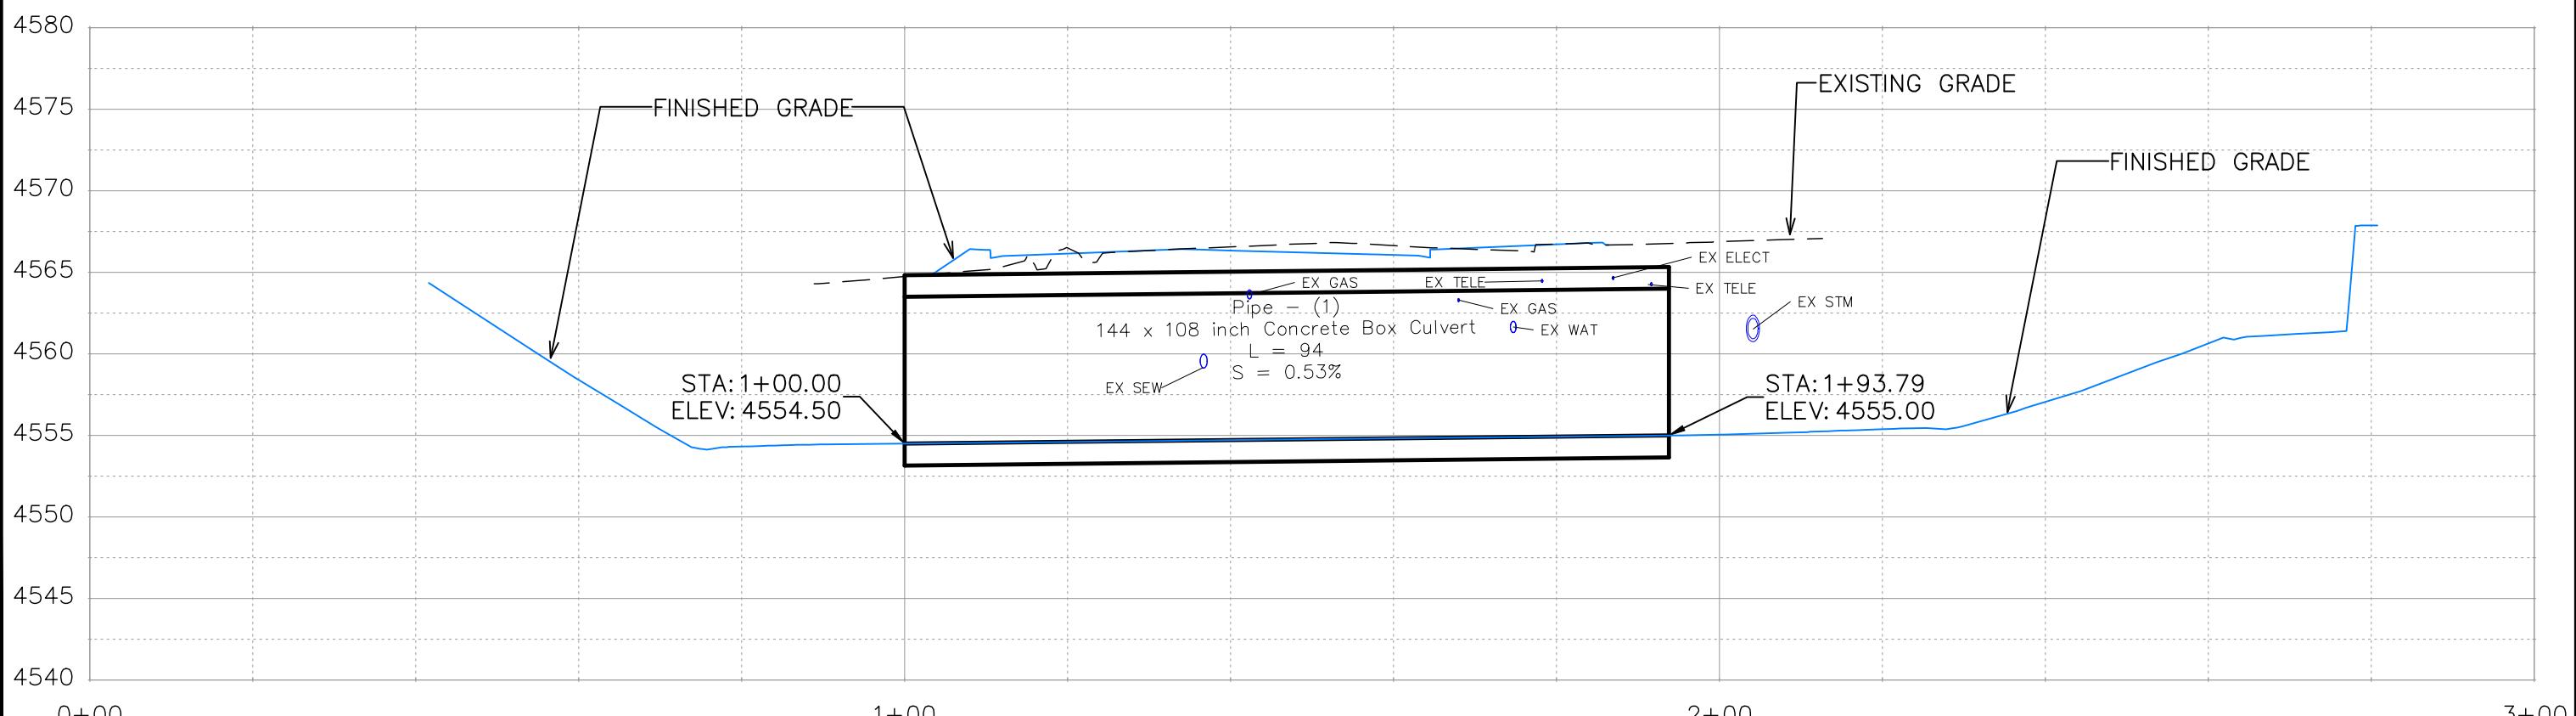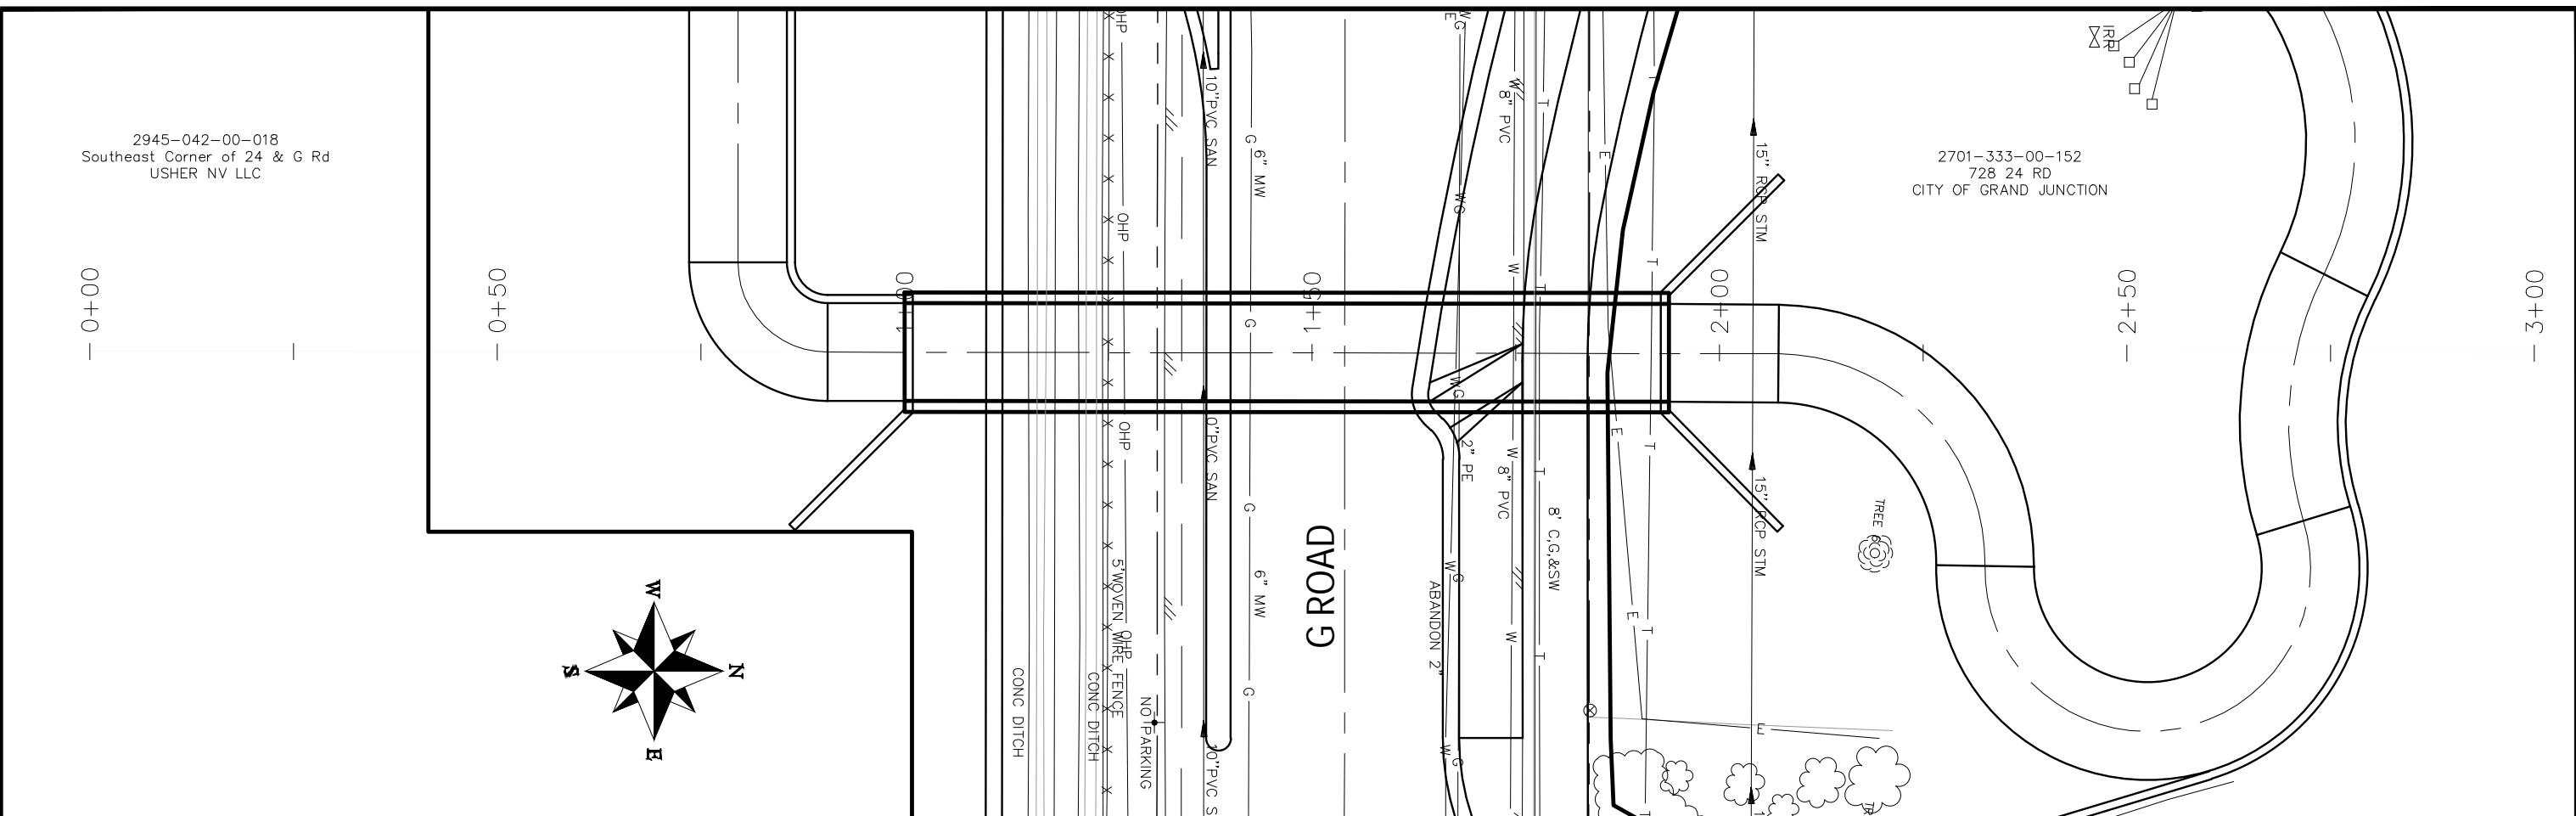


<u>DESCRIPTION</u>	<u>DATE</u>	DRAWN BY	JCS	DATE	2020
REVISION △ REV 1	- DATE	DESIGNED BY	JCS	DATE	2020
REVISION △ REV 2	- DATE	CHECKED BY	ALC	DATE	2020
REVISION △ REV 3	- DATE	APPROVED BY	TCP	DATE	2020
REVISION △ REV 4	- DATE				

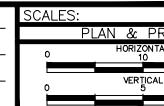


The logo for the City of Grand Junction, Colorado. It features the words "CITY OF" in a small, sans-serif font above the word "Grand" in a large, bold, serif font. Below "Grand" is the word "Junction" in a large, bold, sans-serif font. Underneath "Junction" is the word "COLORADO" in a smaller, all-caps, sans-serif font. A stylized, swooping line graphic starts from the bottom left, under "Grand", and curves upwards and to the right, ending under "Junction".

PUBLIC WORKS
ENGINEERING DIVISION
PROJECT NO. FUND-ACTIVITY NO

24 ROAD BIKE PATH
PEDESTRIAN TUNNEL - 1
June 10, 2020

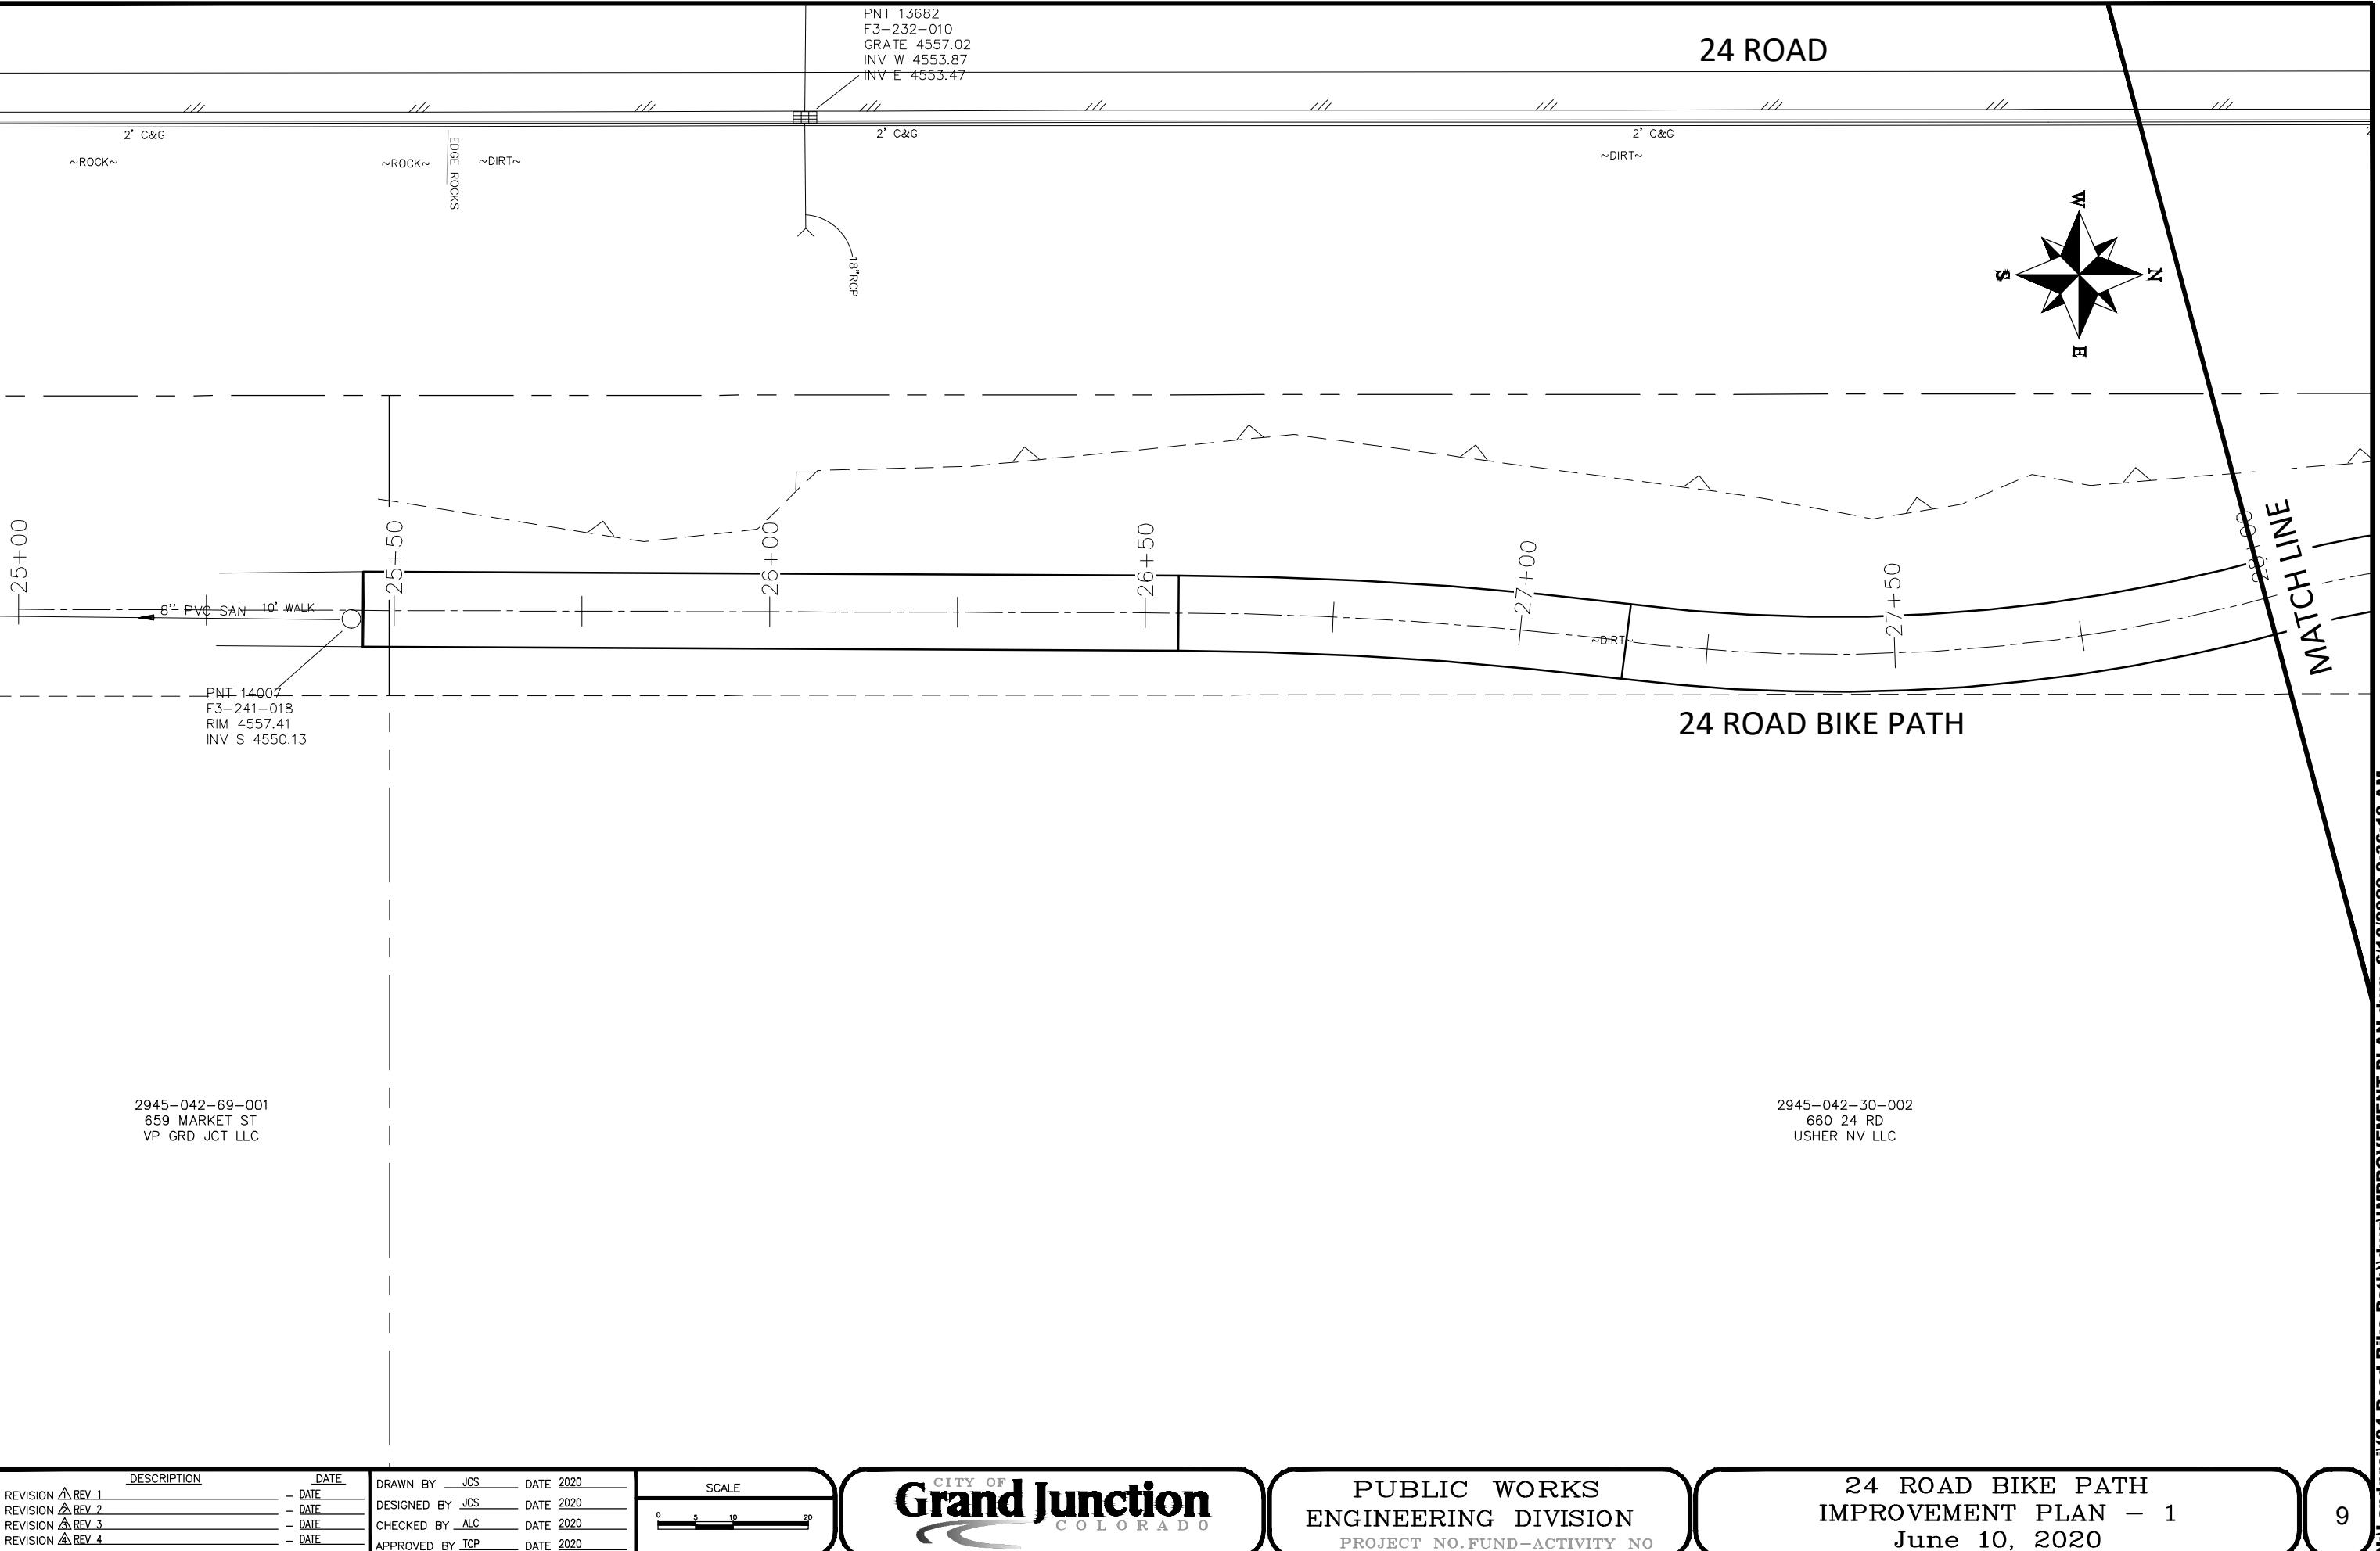

24 ROAD

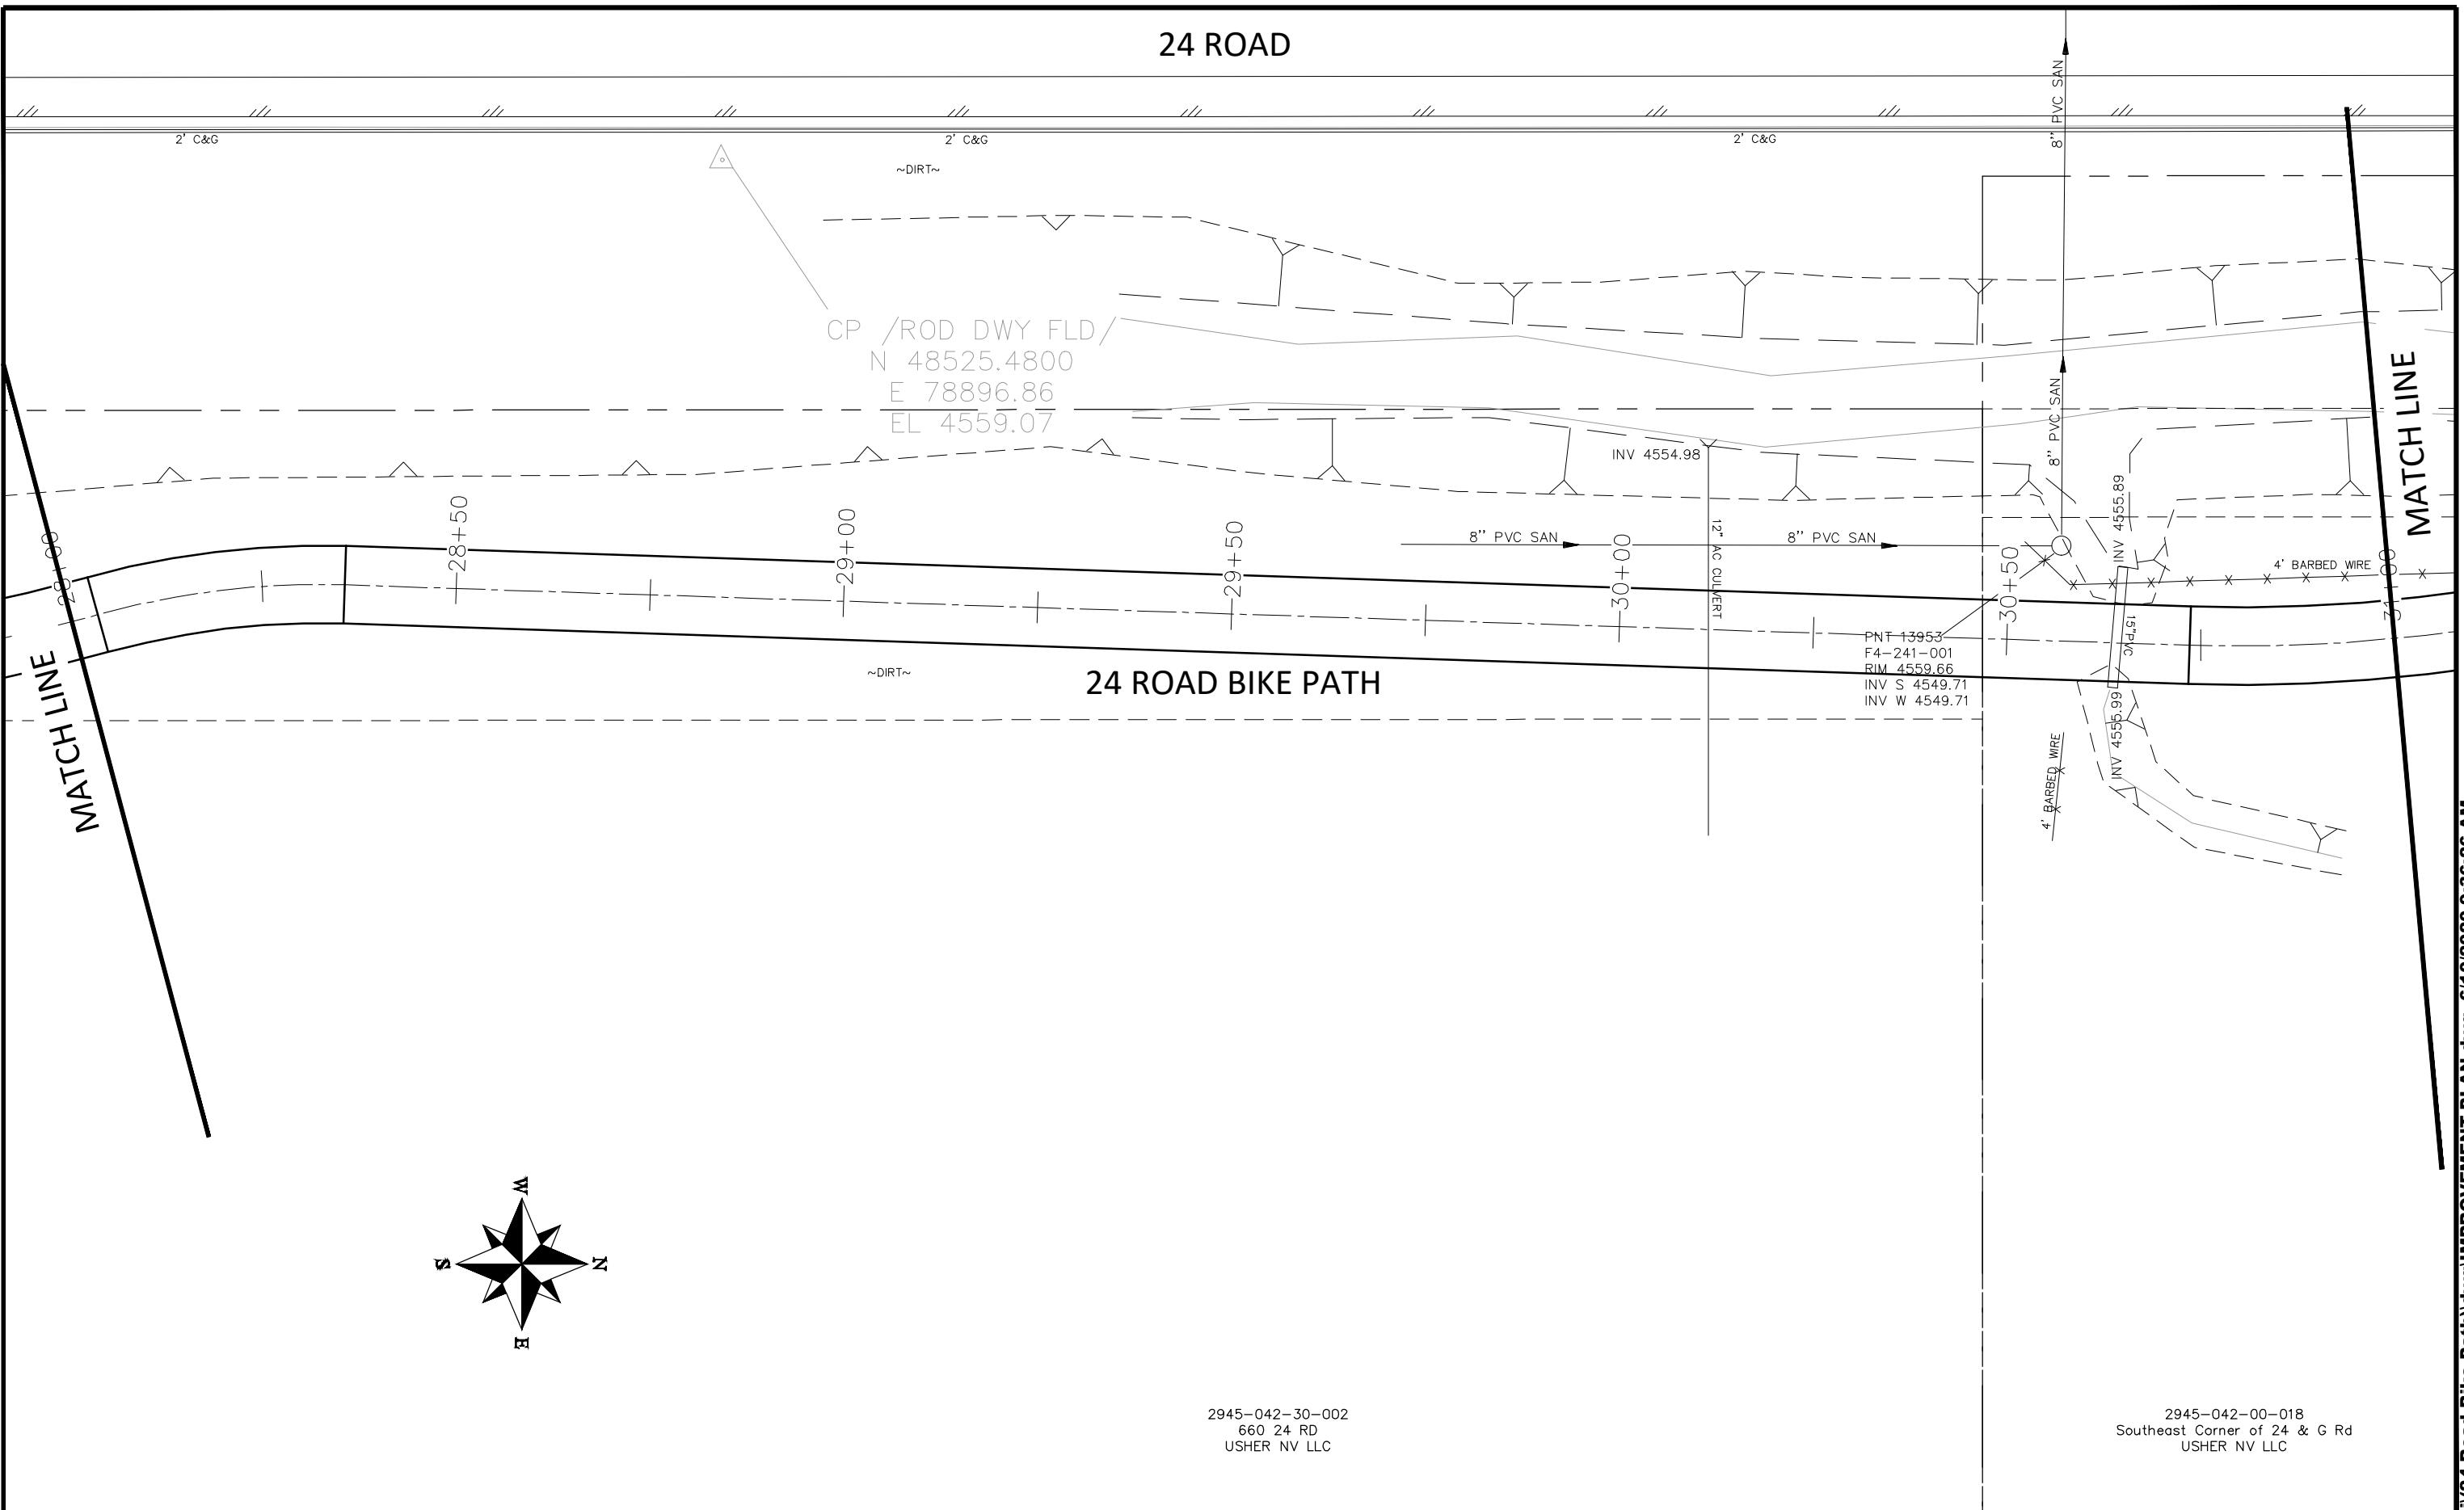

DESCRIPTION	DATE
REVISION A REV 1	- DATE
REVISION A REV 2	- DATE
REVISION A REV 3	- DATE
REVISION A REV 4	- DATE


DRAWN BY	JCS	DATE 2020
DESIGNED BY	JCS	DATE 2020
CHECKED BY	ALC	DATE 2020
APPROVED BY	TCP	DATE 2020

SCALE
0 5 10 20




PUBLIC WORKS
ENGINEERING DIVISION
PROJECT NO. FUND-ACTIVITY NO

24 ROAD BIKE PATH
IMPROVEMENT PLAN - Z
June 10, 2020

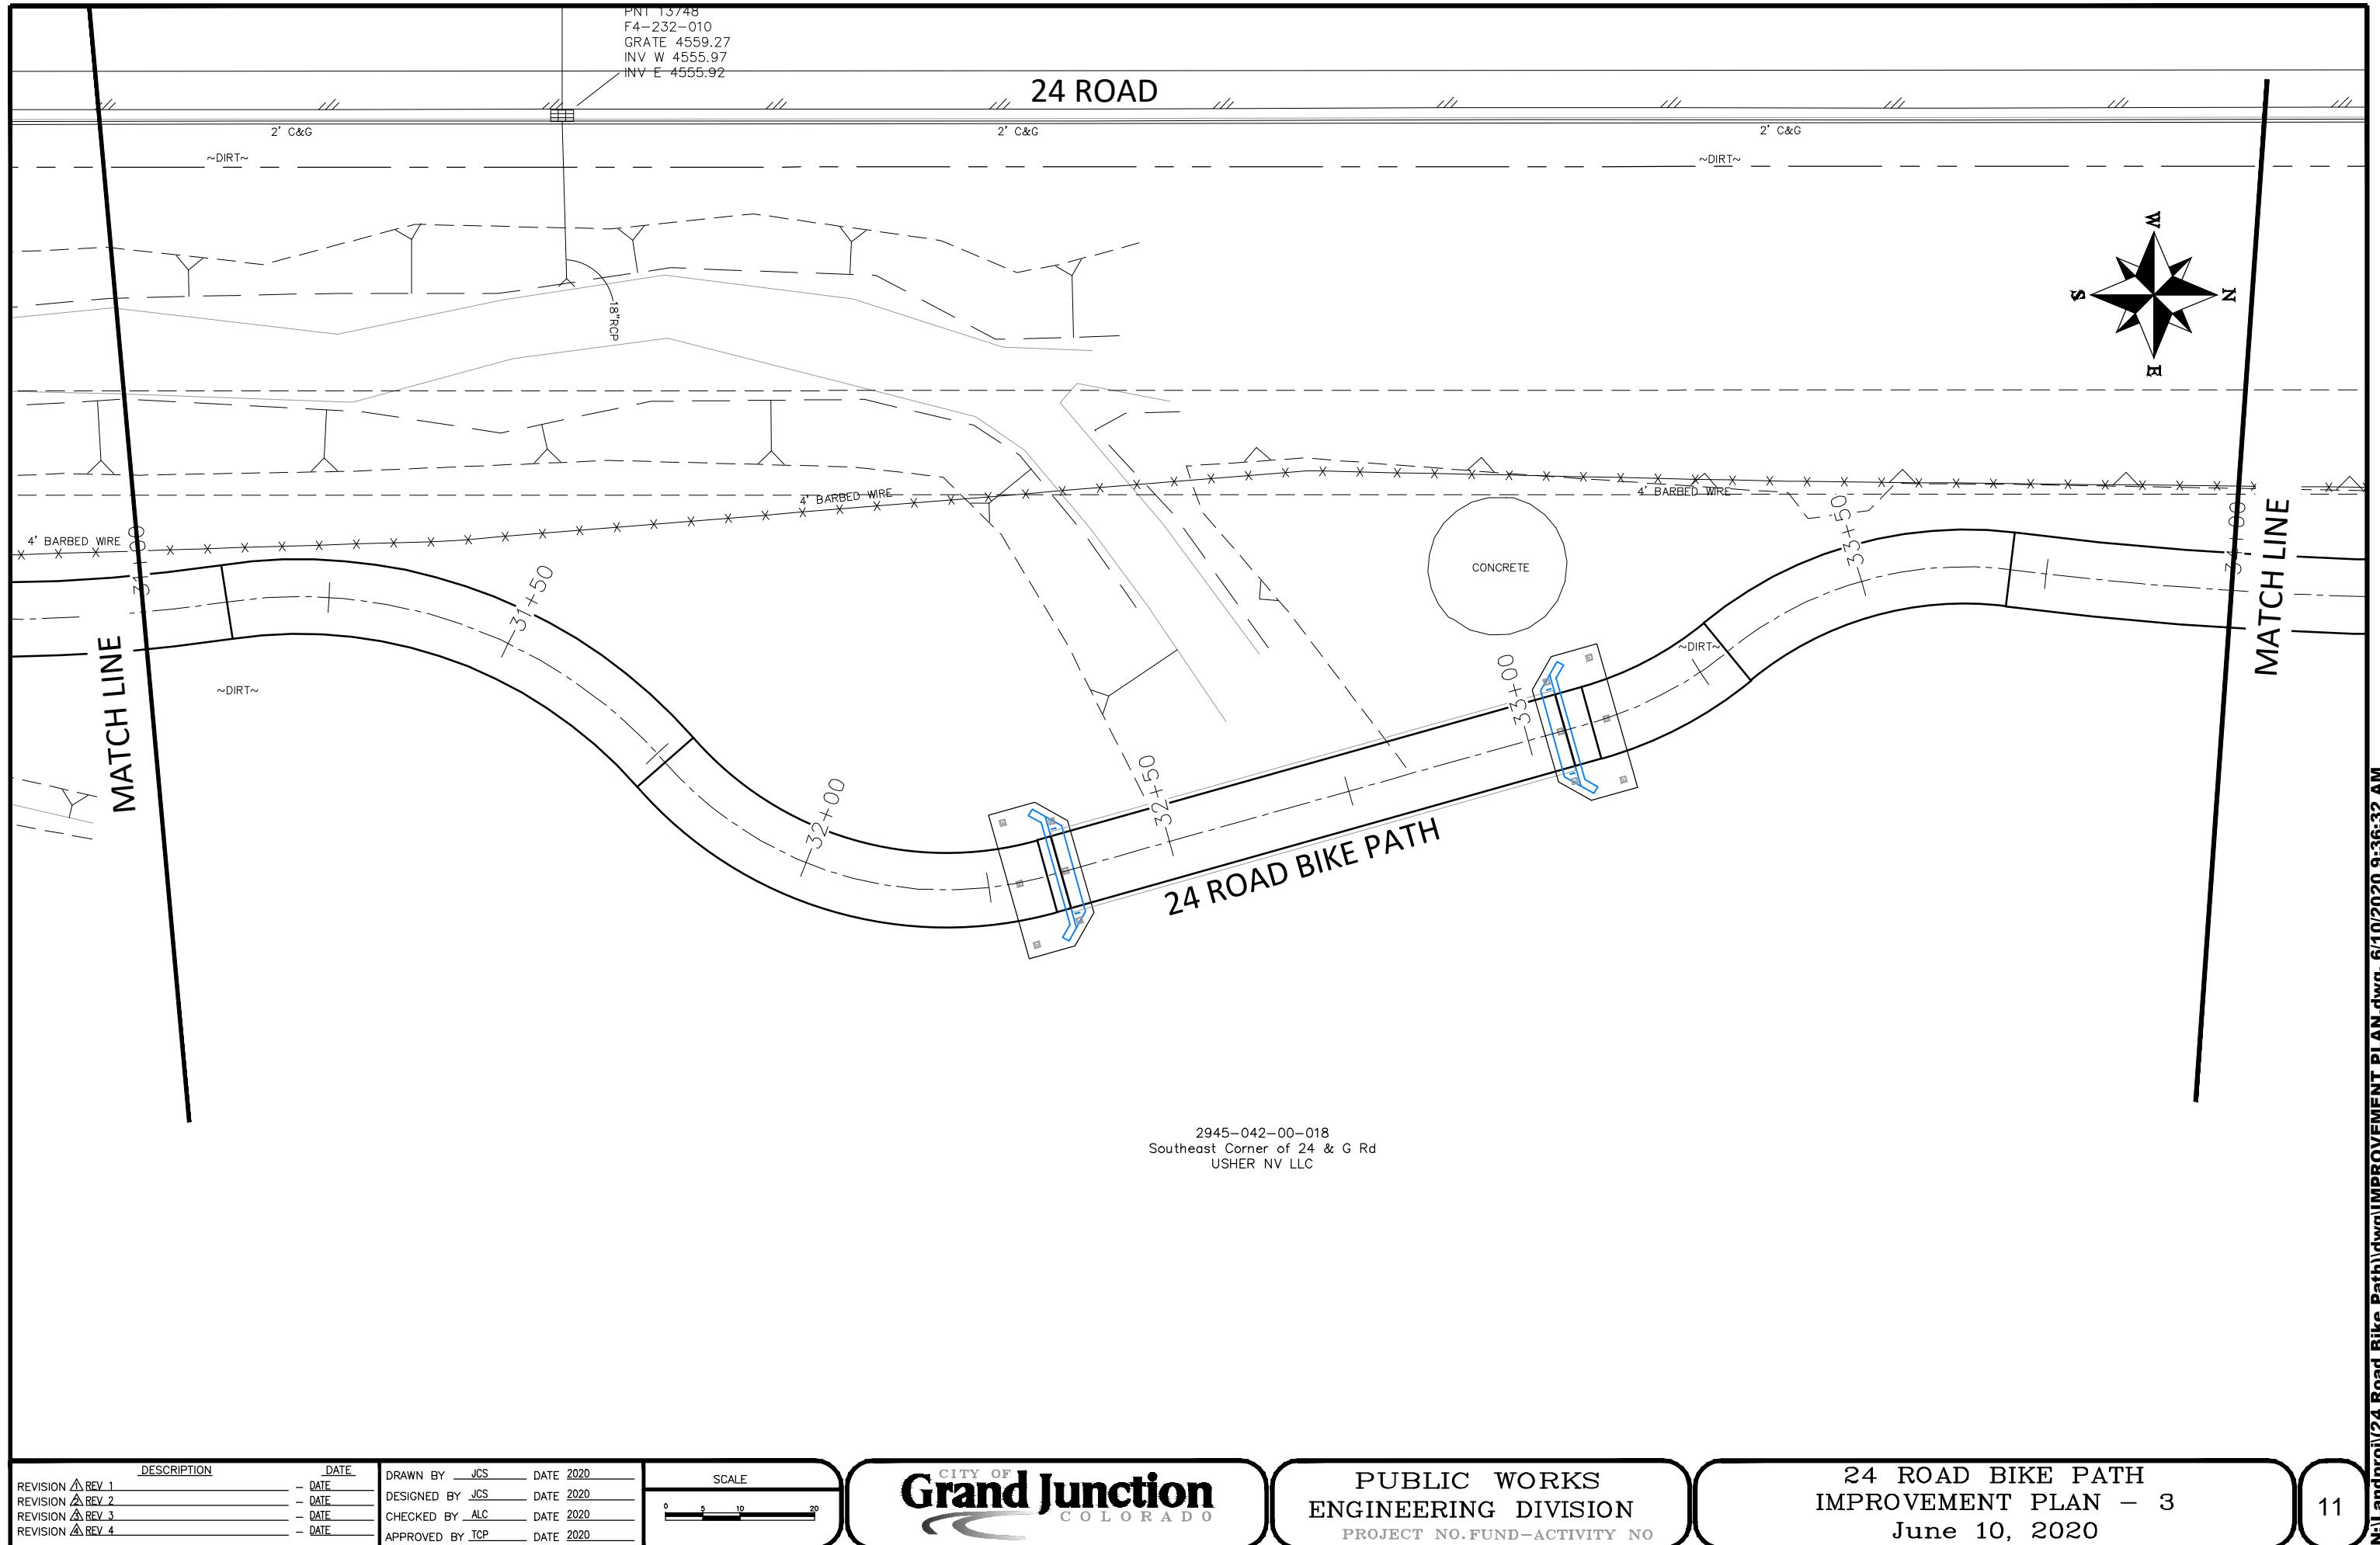

24 ROAD

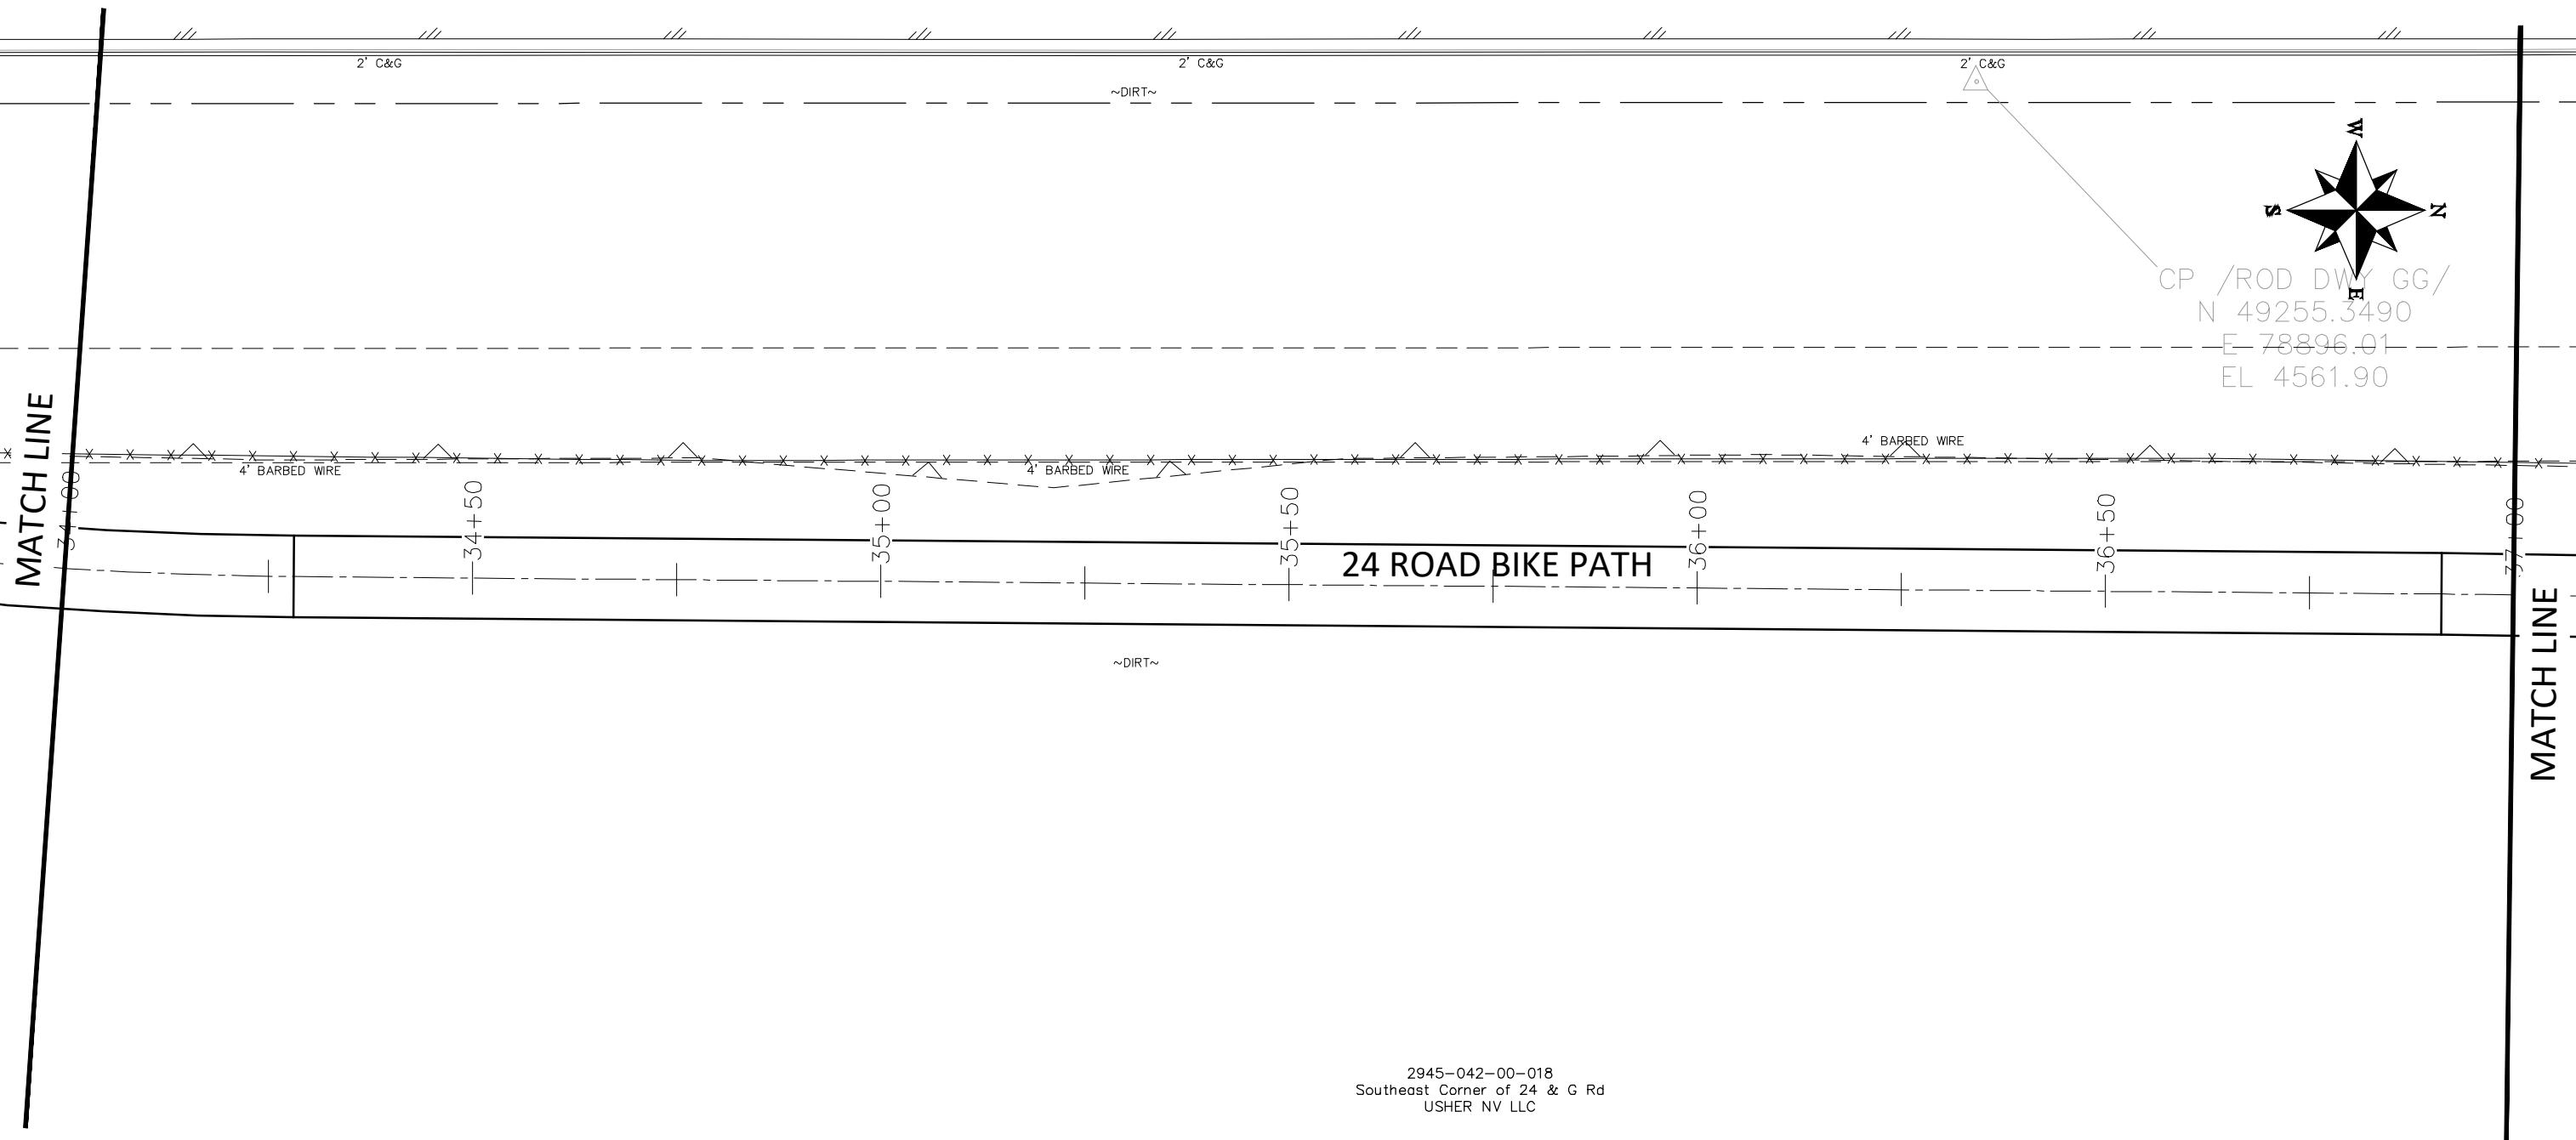

2945-042-00-018
Southeast Corner of 24 & G Rd
USHER NV LLC

DESCRIPTION	DATE
REVISION A REV 1	- DATE
REVISION A REV 2	- DATE
REVISION A REV 3	- DATE
REVISION A REV 4	- DATE

DRAWN BY	JCS	DATE	2020
DESIGNED BY	JCS	DATE	2020
CHECKED BY	ALC	DATE	2020
APPROVED BY	TCP	DATE	2020

SCALE
0 5 10 20




PUBLIC WORKS
ENGINEERING DIVISION
PROJECT NO. FUND-ACTIVITY NO


24 ROAD BIKE PATH
IMPROVEMENT PLAN - 4
June 10, 2020

PNT 11800
F4-232-009
GRATE 4561.72
INV W 4558.52
INV E 4558.47

24 ROAD

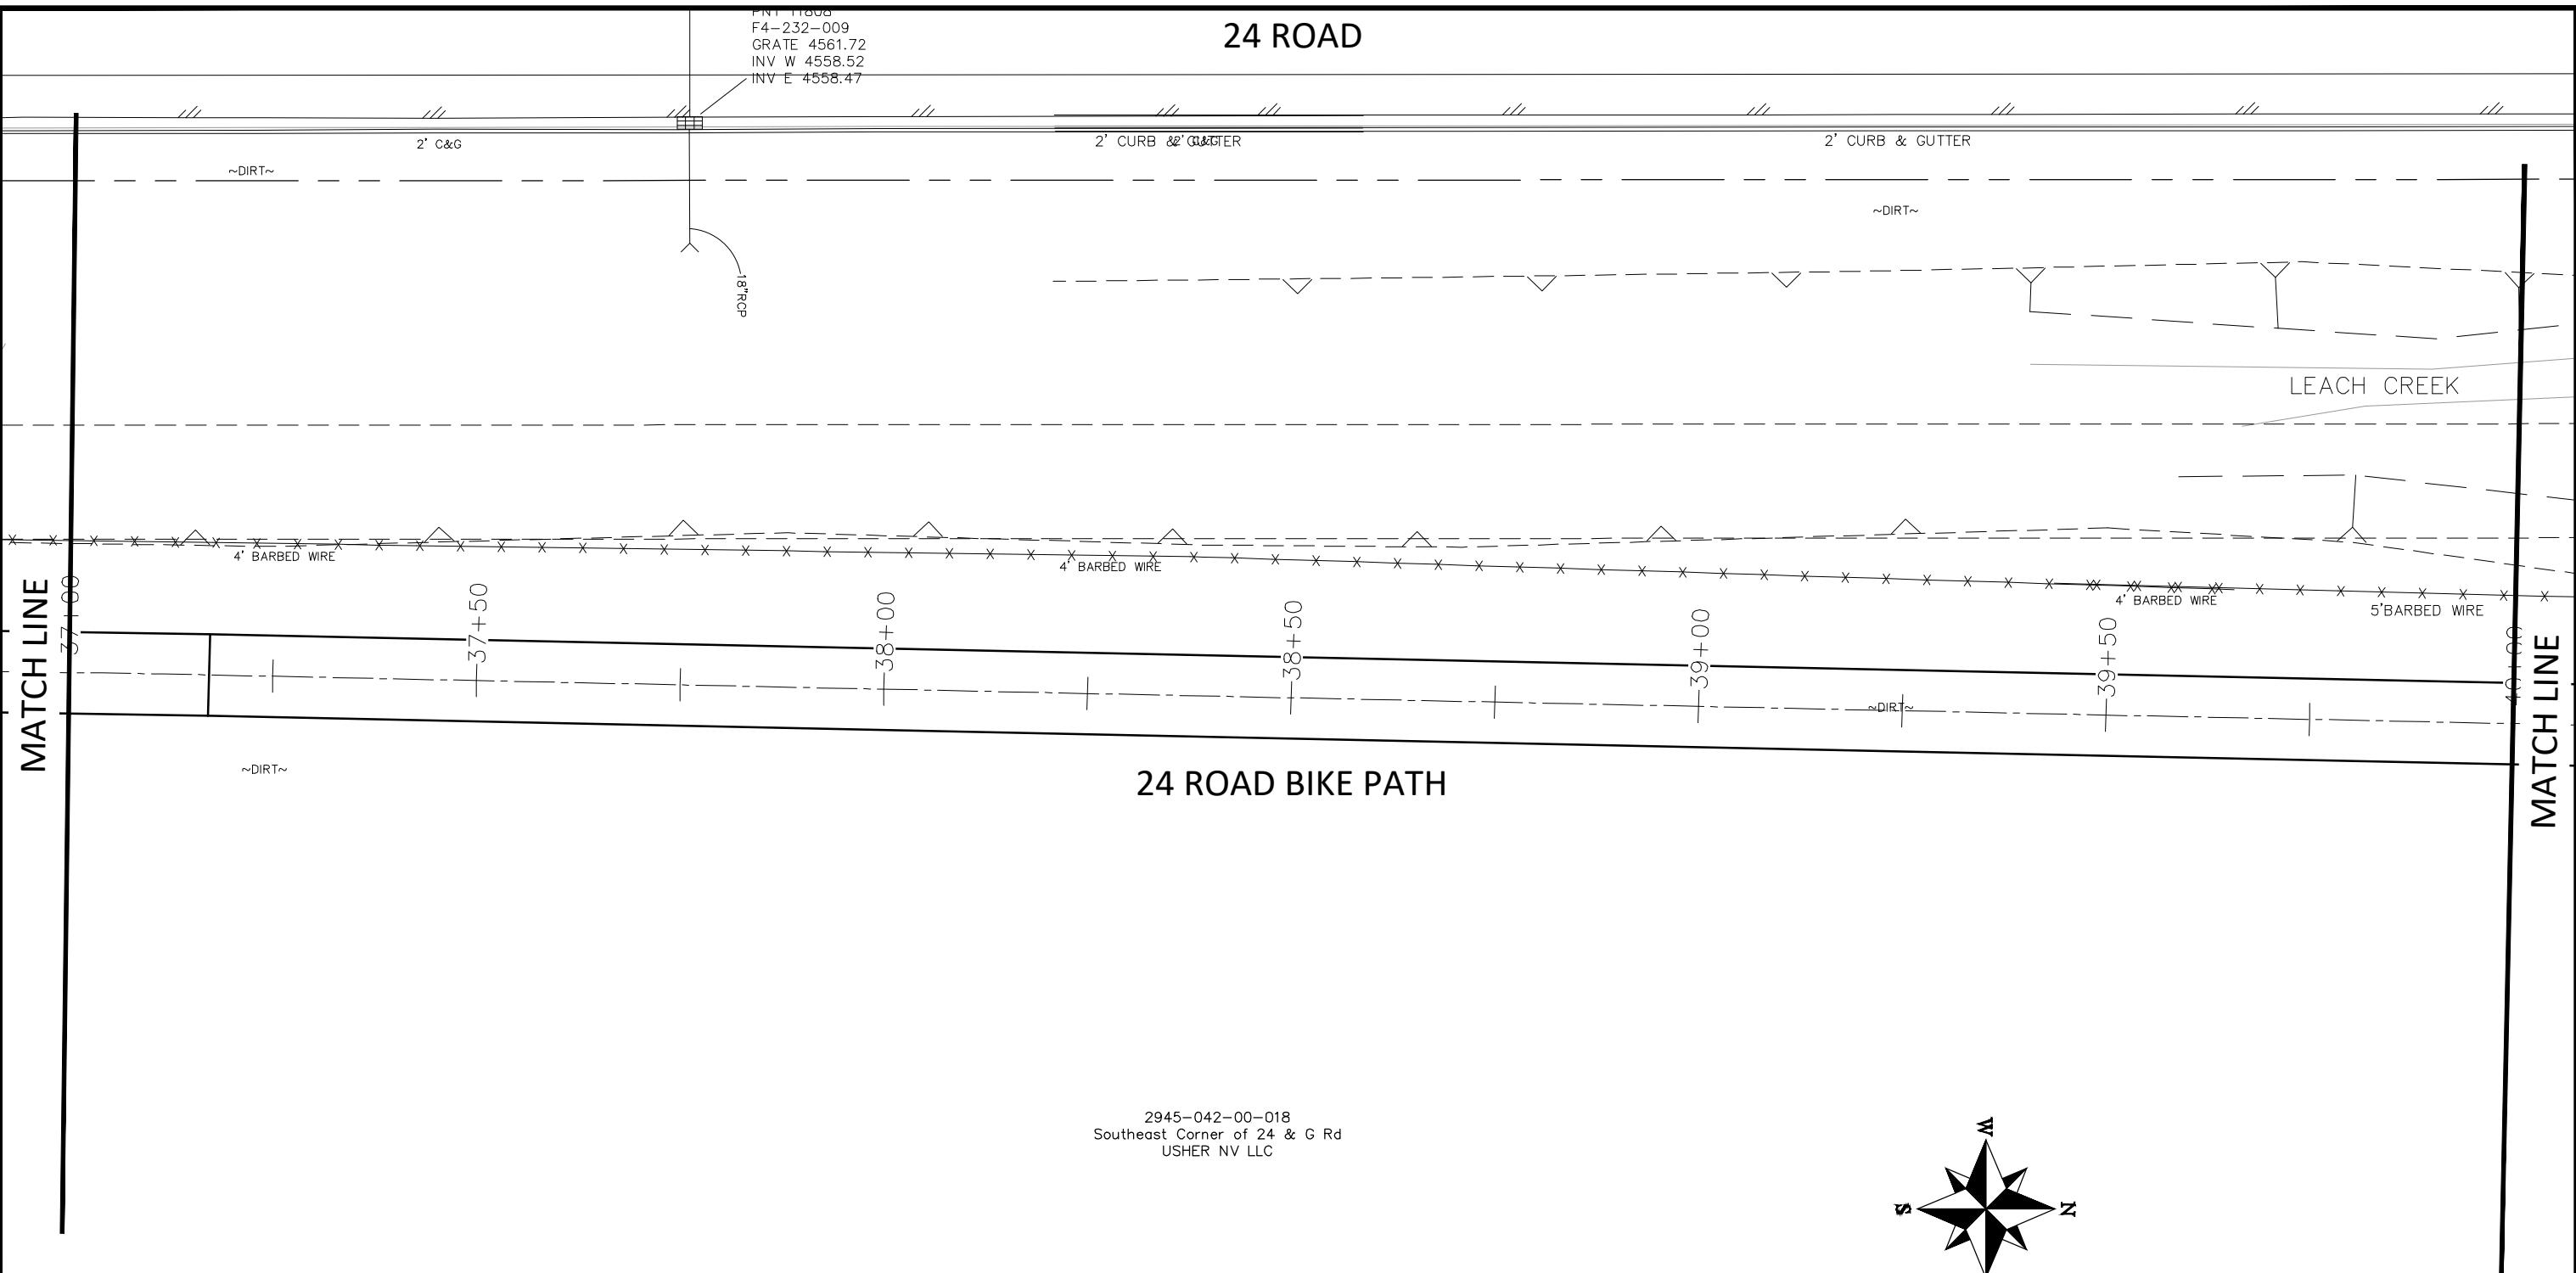


2945-042-00-018
Southeast Corner of 24 & G Rd
USHER NV LLC

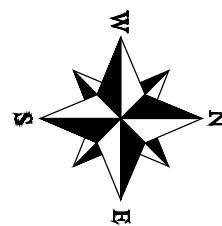



DESCRIPTION	DATE
REVISION A REV 1	- DATE
REVISION A REV 2	- DATE
REVISION A REV 3	- DATE
REVISION A REV 4	- DATE

DRAWN BY	JCS	DATE	2020
DESIGNED BY	JCS	DATE	2020
CHECKED BY	ALC	DATE	2020
APPROVED BY	TCP	DATE	2020

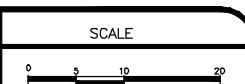

PUBLIC WORKS
ENGINEERING DIVISION
PROJECT NO. FUND-ACTIVITY NO.

24 ROAD BIKE PATH
IMPROVEMENT PLAN - 5
June 10, 2020

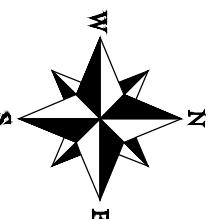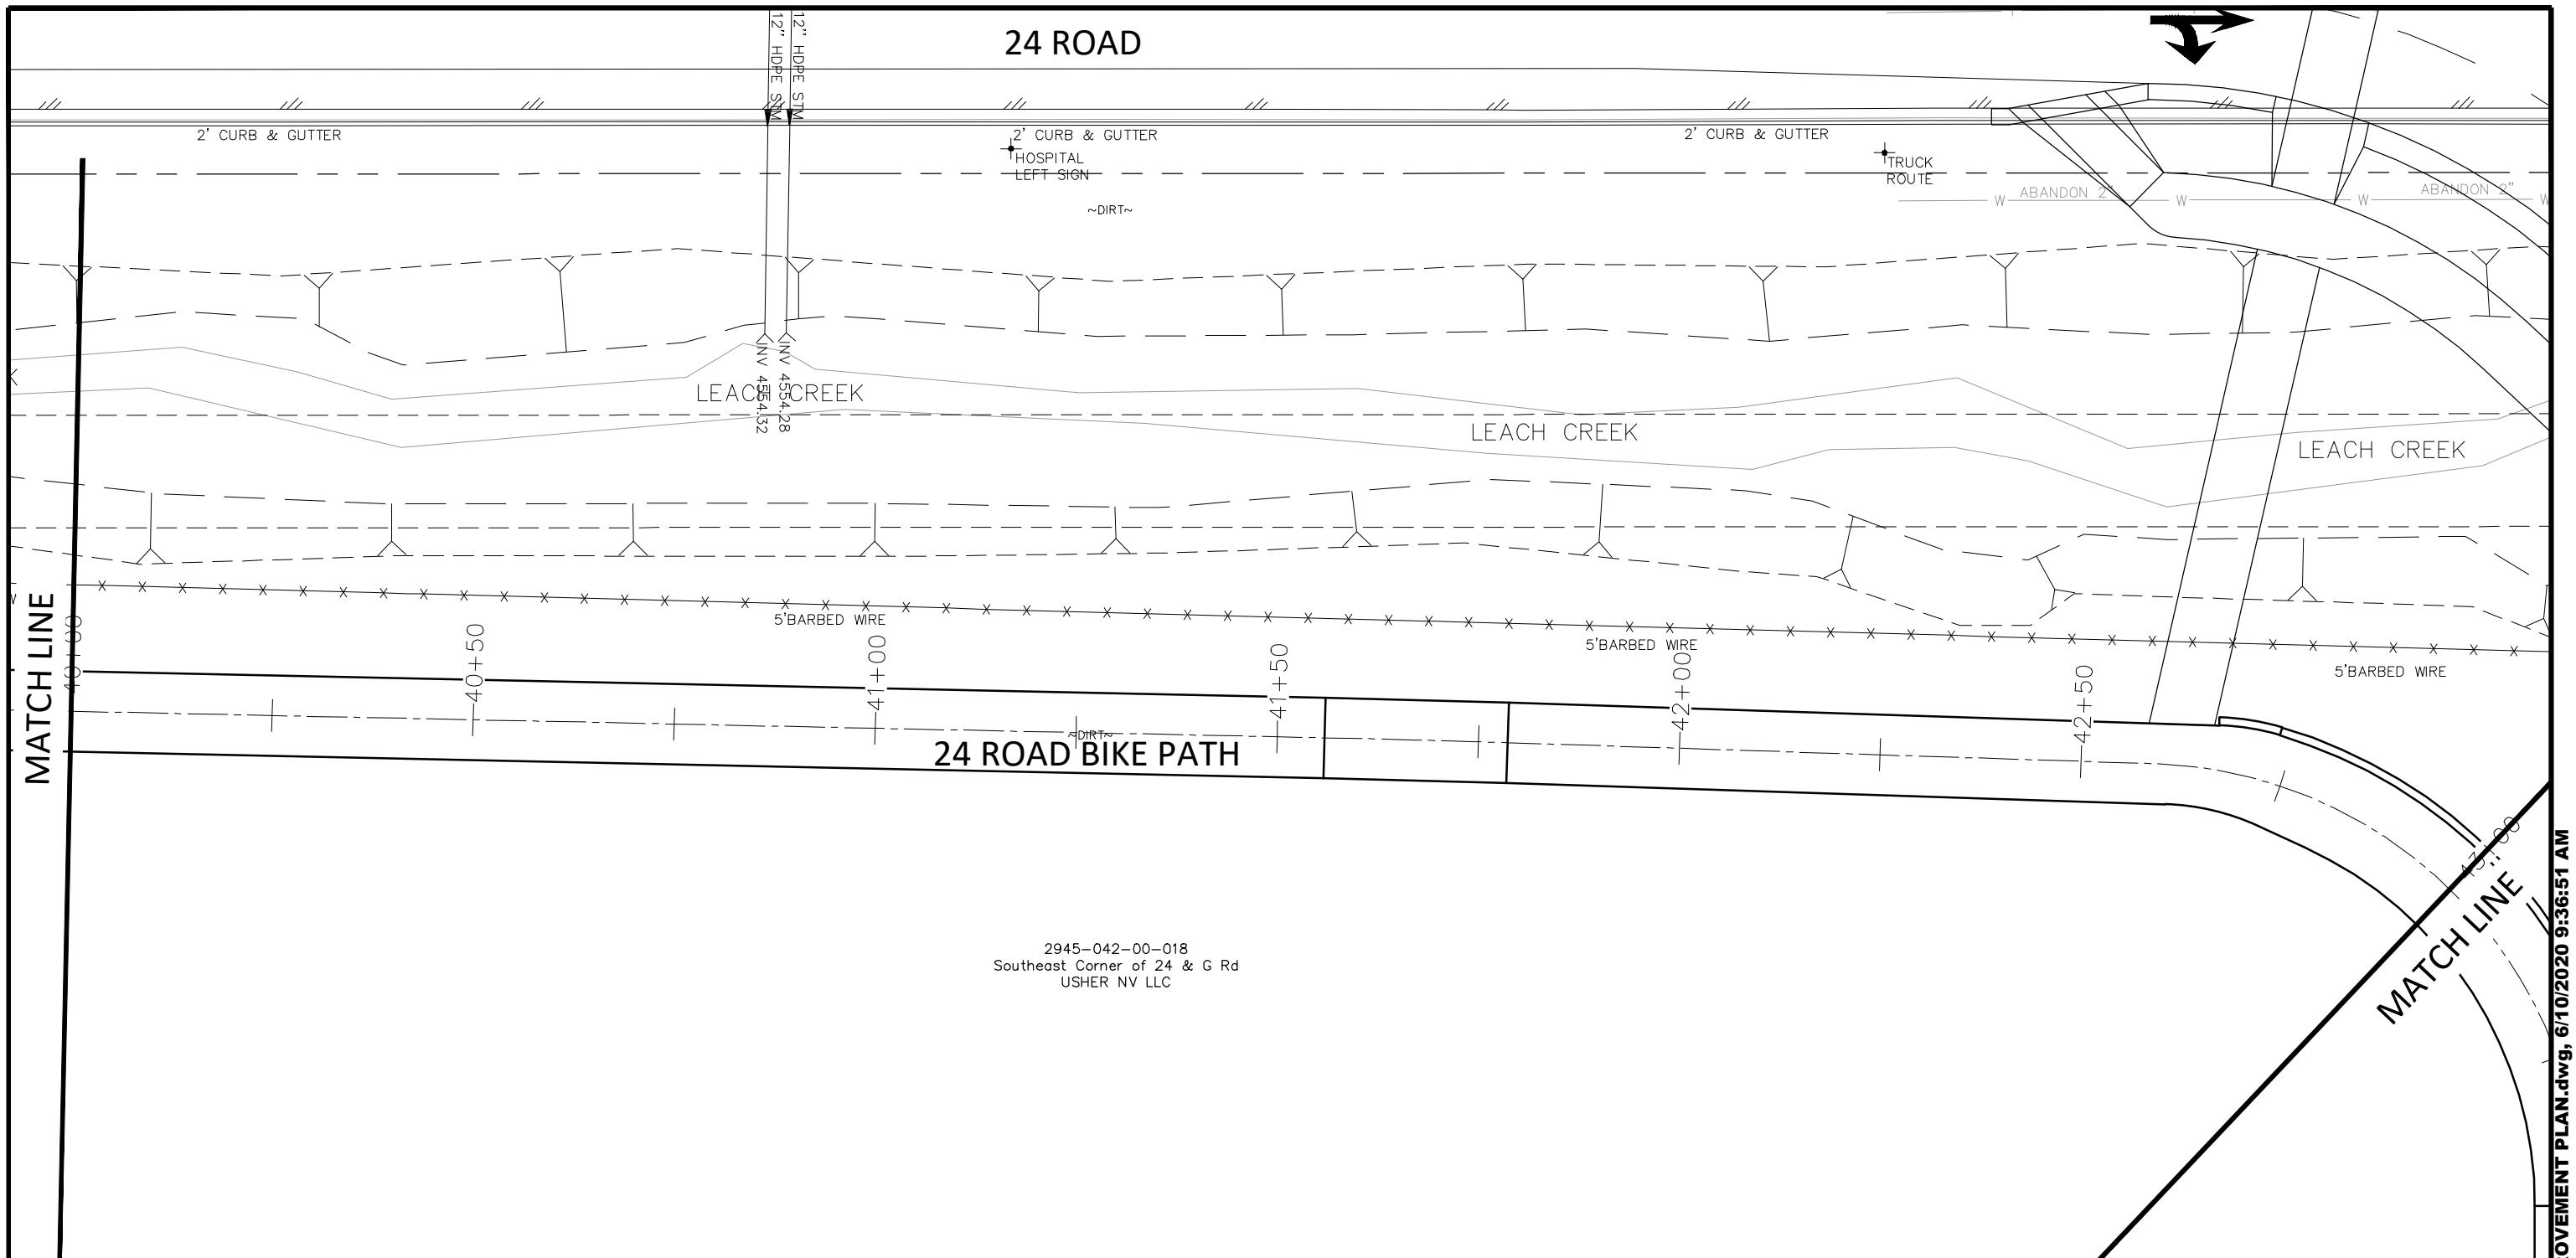

<u>DESCRIPTION</u>	<u>DATE</u>
REVISION Δ REV 1	- DATE
REVISION Δ REV 2	- DATE
REVISION Δ REV 3	- DATE
REVISION Δ REV 4	- DATE

DRAWN BY JCS DATE 2020
DESIGNED BY JCS DATE 2020
CHECKED BY ALC DATE 2020
APPROVED BY TCP DATE 2020

A horizontal scale bar with numerical markings at 0, 5, 10, and 20.

**CITY OF
Grand Junction
COLORADO**


**PUBLIC WORKS
ENGINEERING DIVISION**

24 ROAD BIKE PATH
IMPROVEMENT PLAN - 6
June 10, 2020




<u>DESCRIPTION</u>	<u>DATE</u>
REVISION A REV 1	DATE
REVISION B REV 2	DATE
REVISION C REV 3	DATE
REVISION D REV 4	DATE


DRAWN BY JCS DATE 2020
DESIGNED BY JCS DATE 2020
CHECKED BY ALC DATE 2020
APPROVED BY TCP DATE 2020

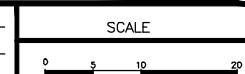

PUBLIC WORKS
ENGINEERING DIVISION
PROJECT NO. FUND-ACTIVITY NO.


24 ROAD BIKE PATH
IMPROVEMENT PLAN - 7

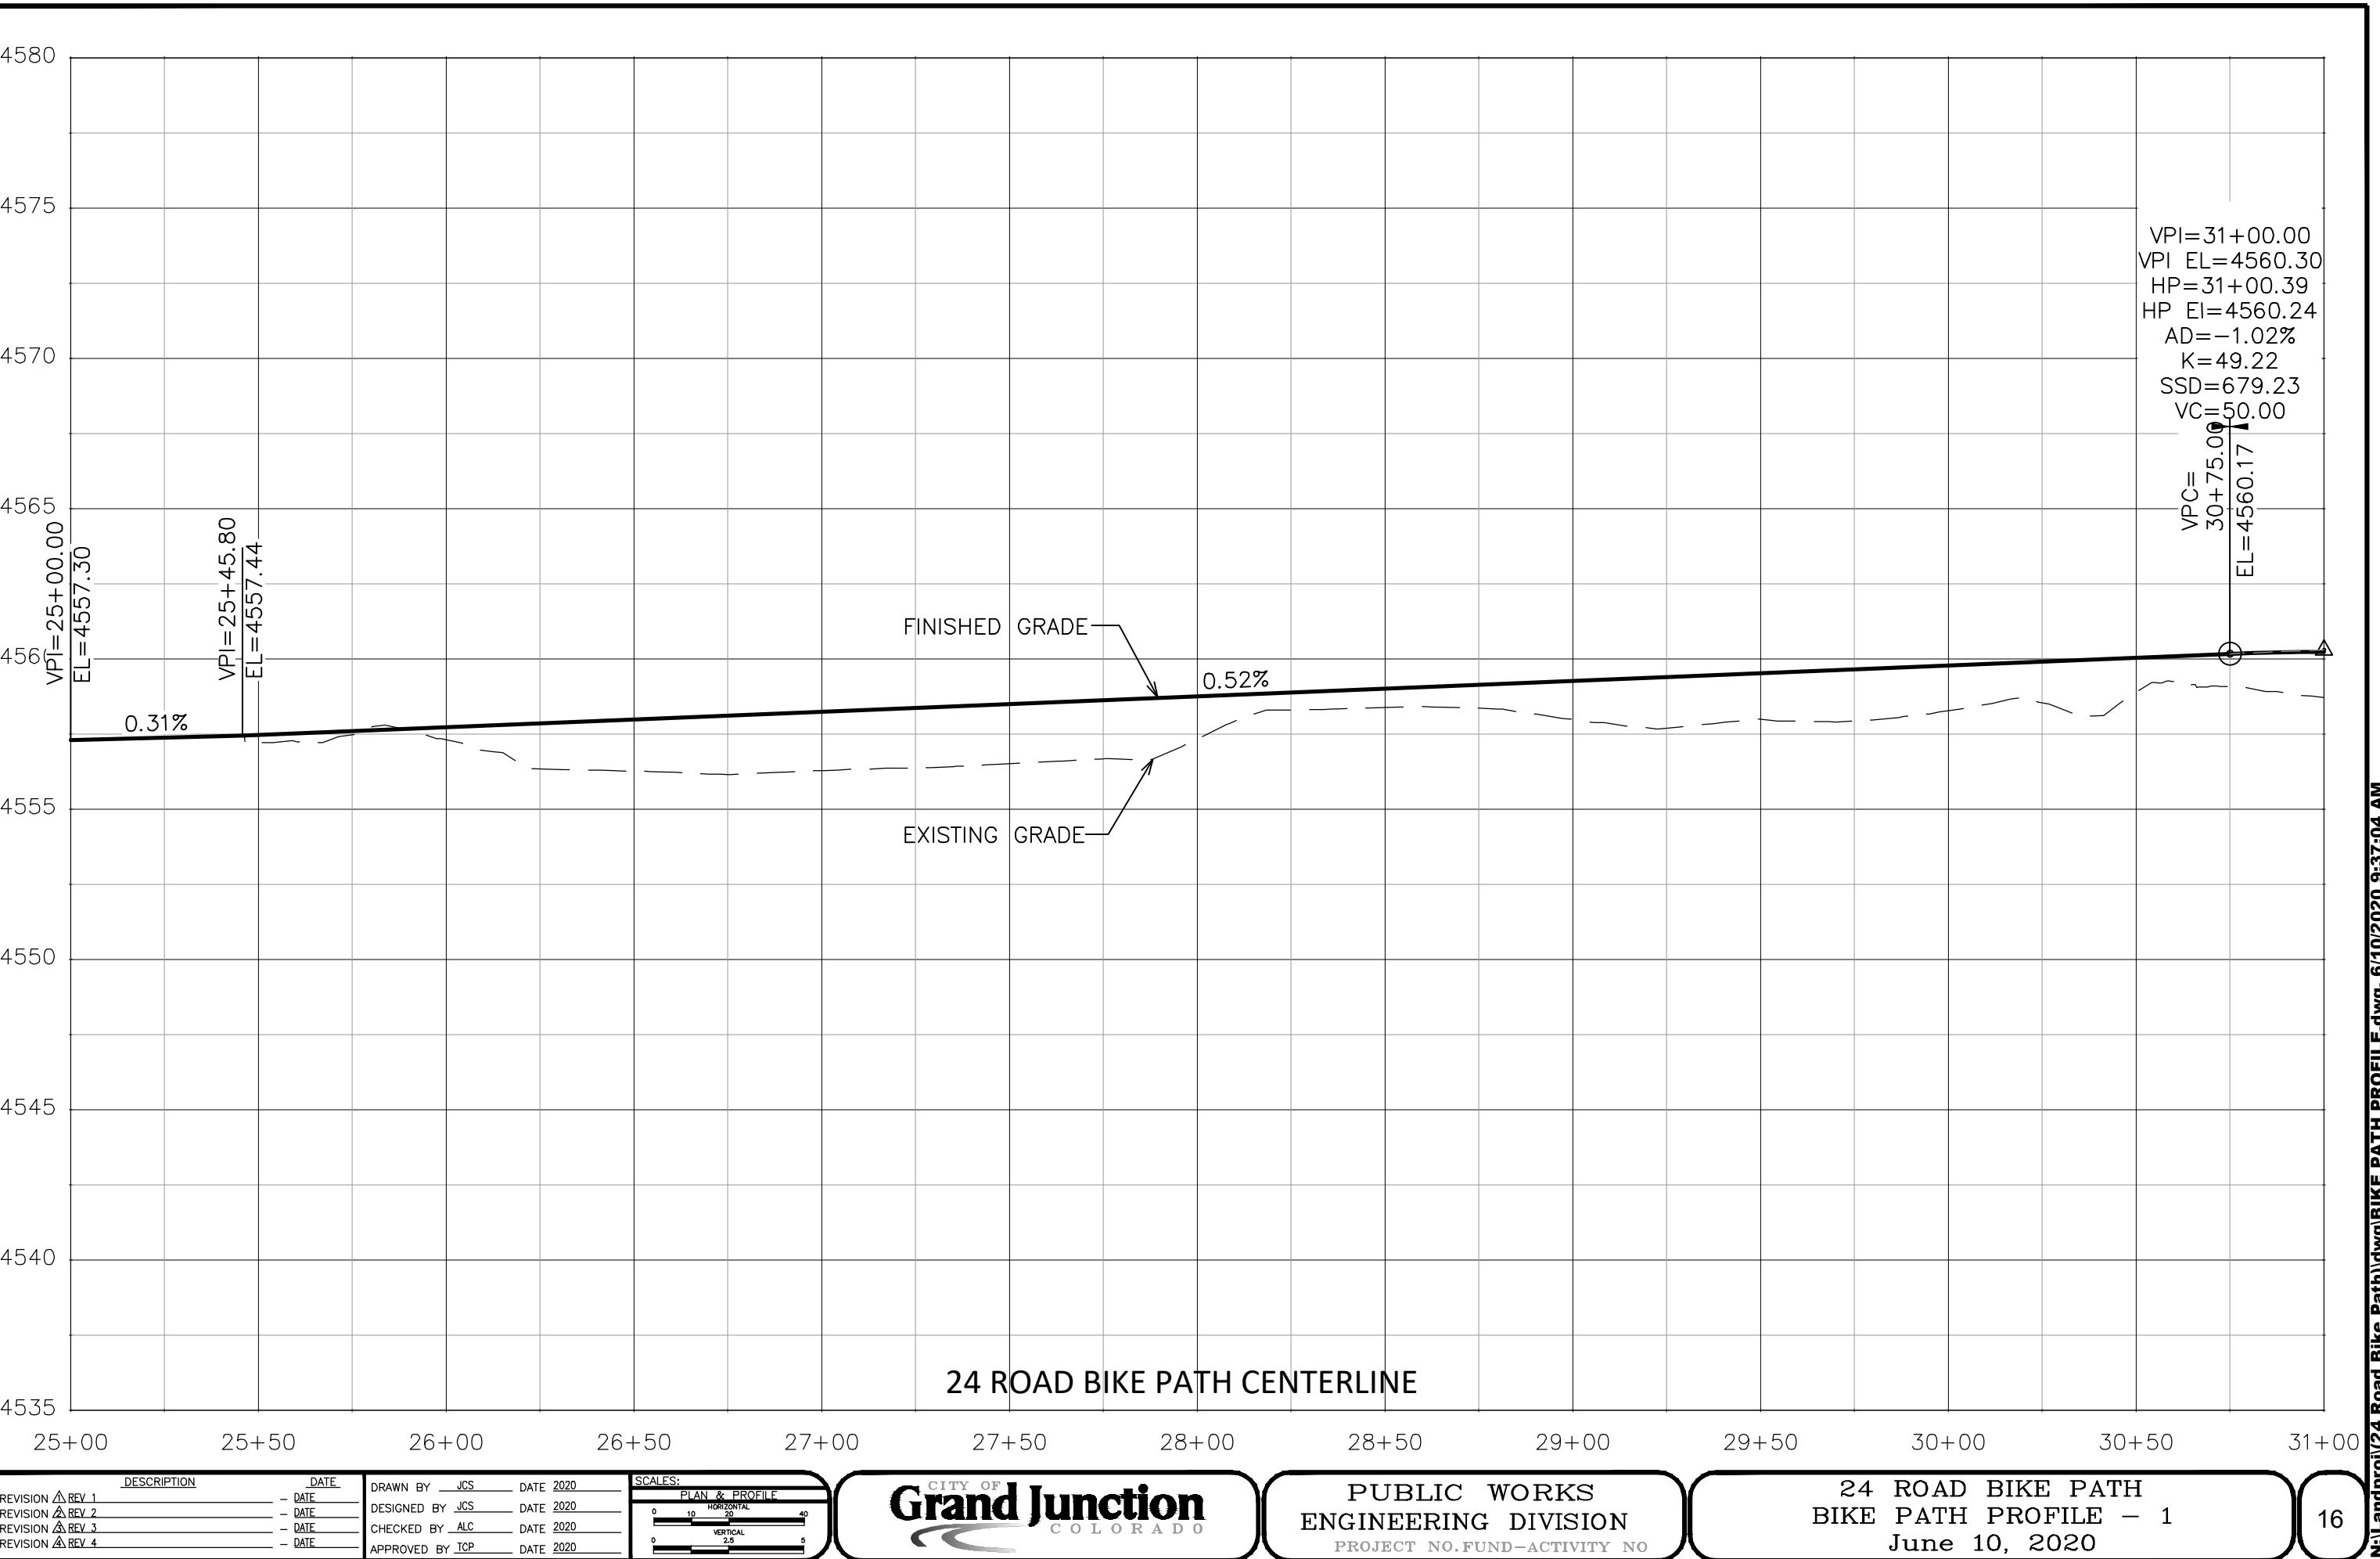

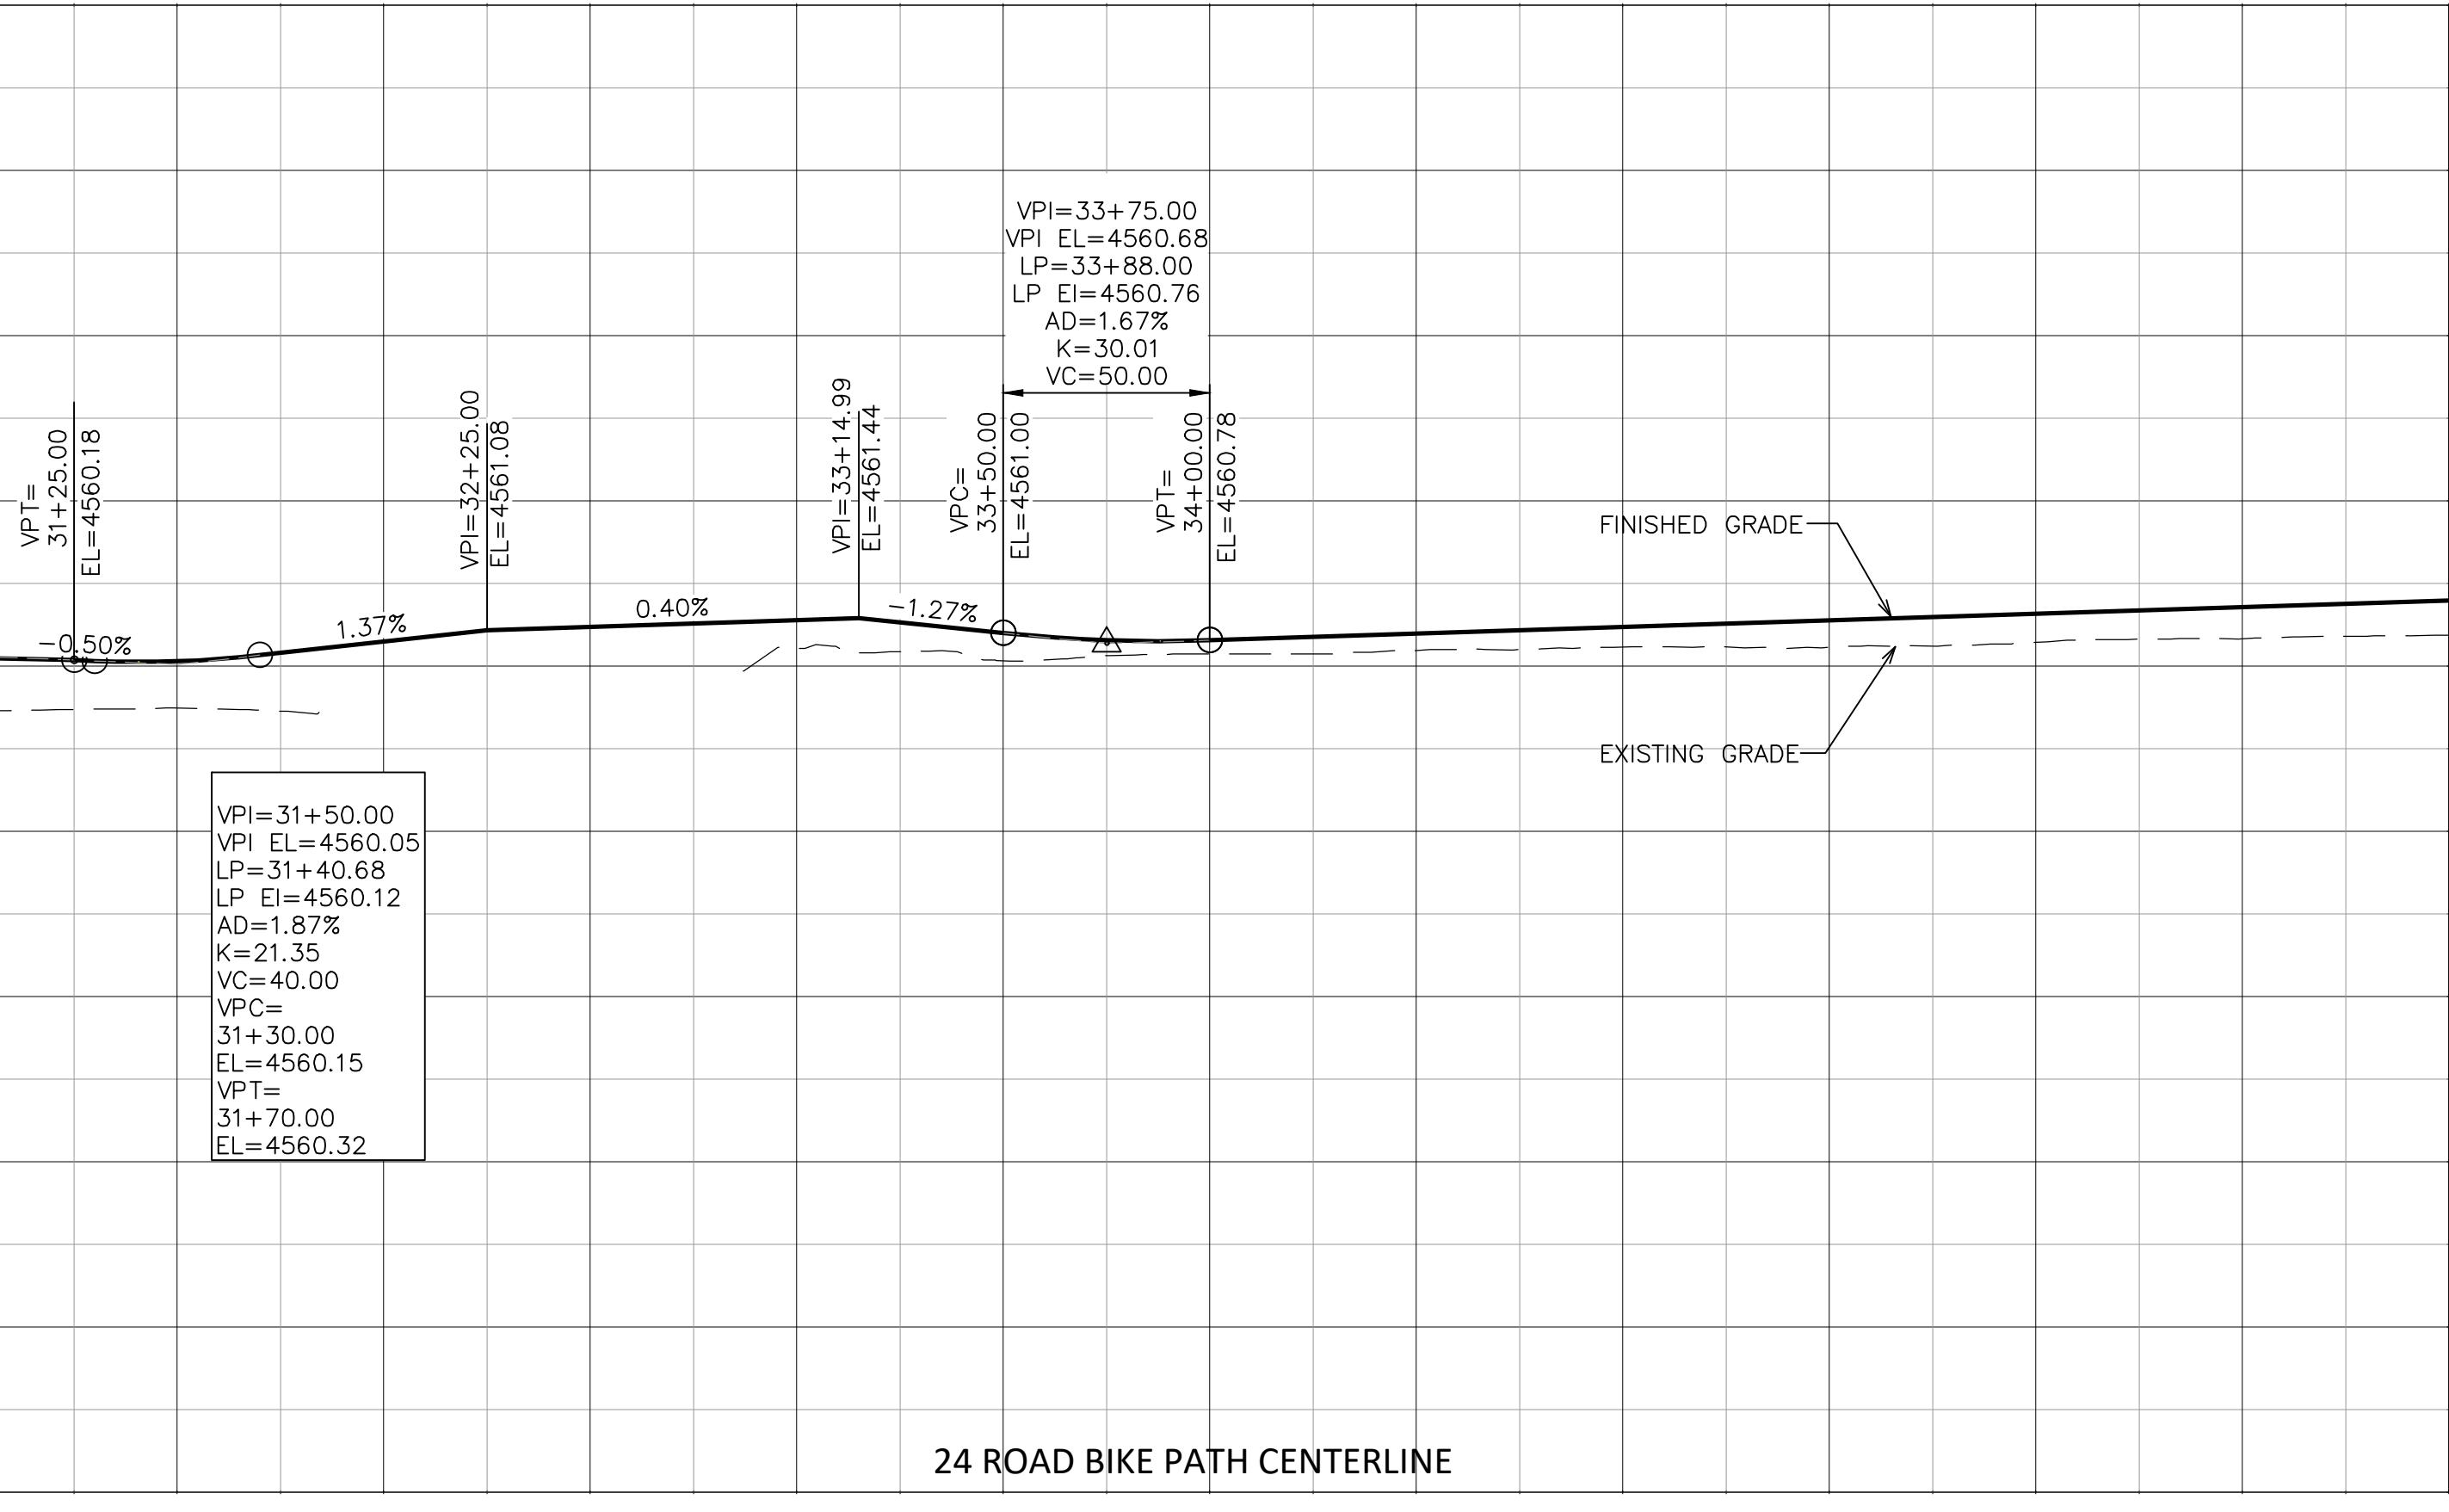


DESCRIPTION	DATE
REVISION A REV 1	- DATE
REVISION A REV 2	- DATE
REVISION A REV 3	- DATE
REVISION A REV 4	- DATE

DRAWN BY	JCS	DATE	2020
DESIGNED BY	JCS	DATE	2020
CHECKED BY	ALC	DATE	2020
APPROVED BY	TCP	DATE	2020

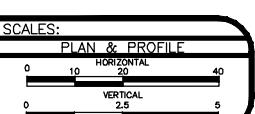

PUBLIC WORKS
ENGINEERING DIVISION
PROJECT NO. FUND-ACTIVITY NO

24 ROAD BIKE PATH
BIKE PATH PROFILE - 2
June 10, 2020

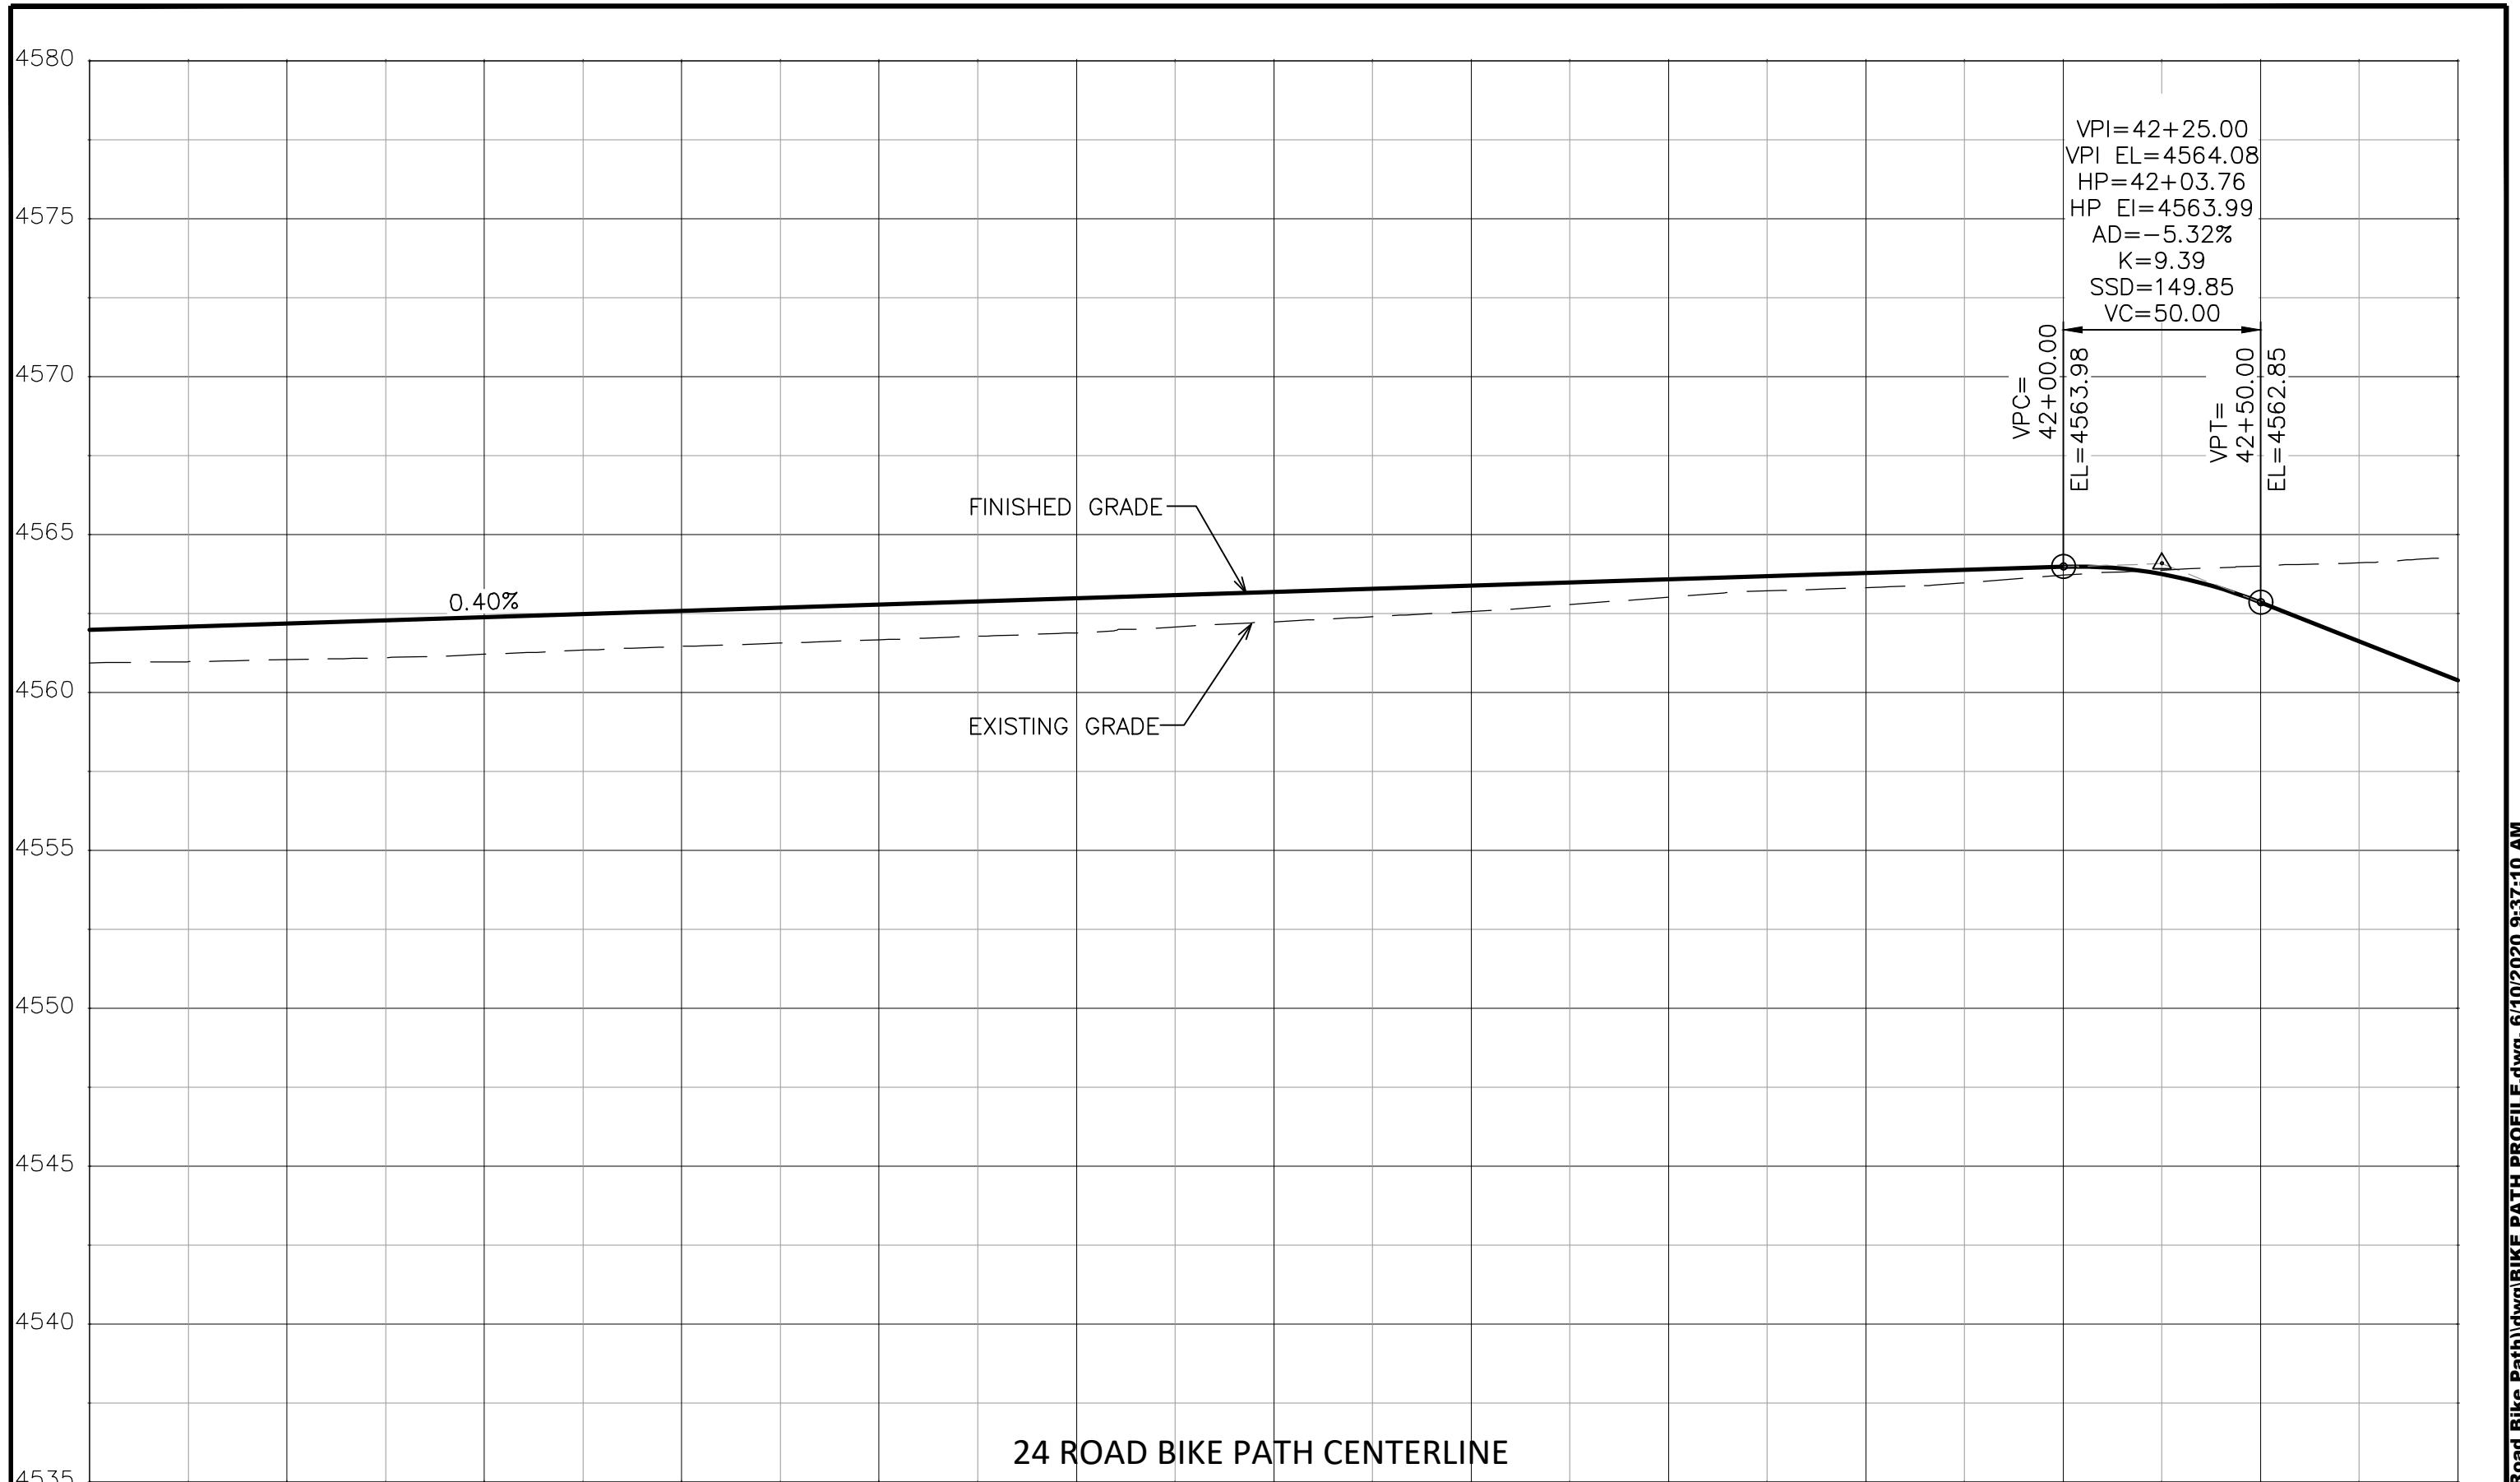

DESCRIPTION	DATE
REVISION A REV 1	- DATE
REVISION A REV 2	- DATE
REVISION A REV 3	- DATE
REVISION A REV 4	- DATE


DRAWN BY	JCS	DATE	2020
DESIGNED BY	JCS	DATE	2020
CHECKED BY	ALC	DATE	2020
APPROVED BY	TCP	DATE	2020

SCALES:			
PLAN & PROFILE			
0	10	20	40
HORIZONTAL			
0	25	5	
VERTICAL			



PUBLIC WORKS
ENGINEERING DIVISION
PROJECT NO. FUND-ACTIVITY NO

24 ROAD BIKE PATH
BIKE PATH PROFILE - 3
June 10, 2020

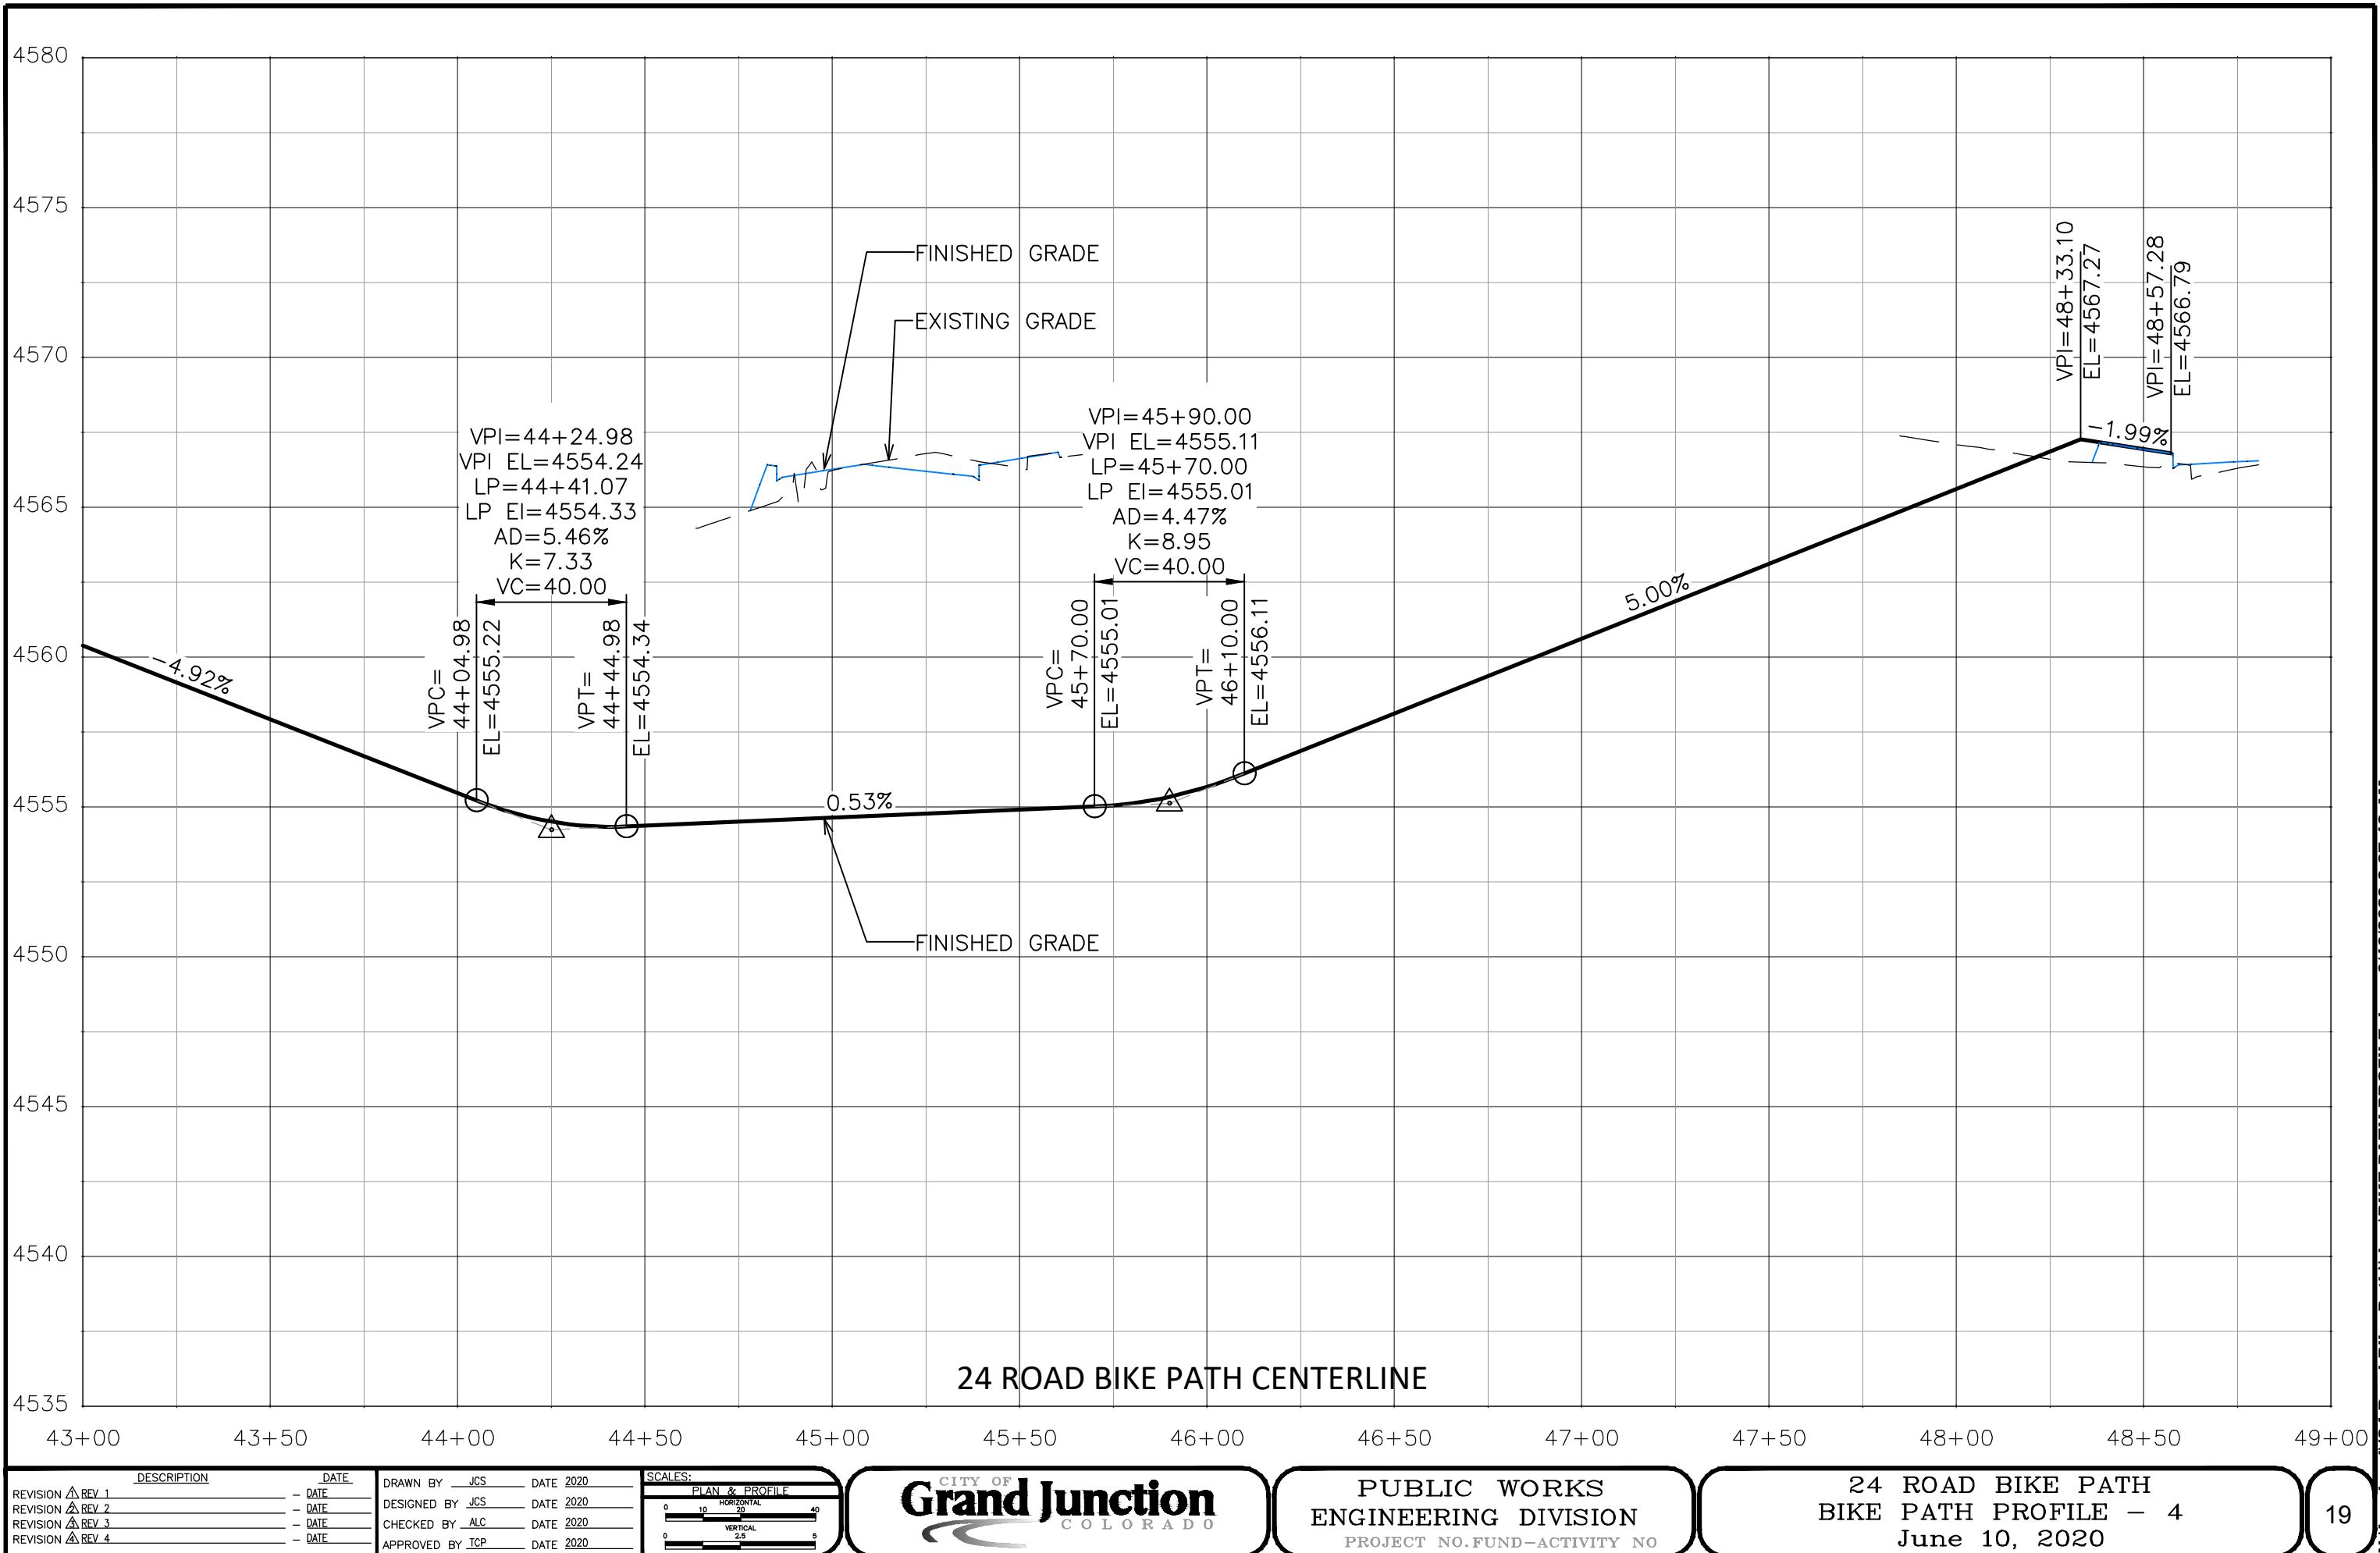

DESCRIPTION DATE
 REVISION A REV 1 - DATE
 REVISION A REV 2 - DATE
 REVISION A REV 3 - DATE
 REVISION A REV 4 - DATE





















DRAWN BY JCS DATE 2020
 DESIGNED BY JCS DATE 2020
 CHECKED BY ALC DATE 2020
 APPROVED BY TCP DATE 2020

















SCALES:
 PLAN & PROFILE
 0 10 20 40
 HORIZONTAL
 0 4
 VERTICAL



PUBLIC WORKS
 ENGINEERING DIVISION
 PROJECT NO. FUND-ACTIVITY NO

24 ROAD BIKE PATH
 BIKE PATH CROSS SECTIONS - 1
 June 10, 2020

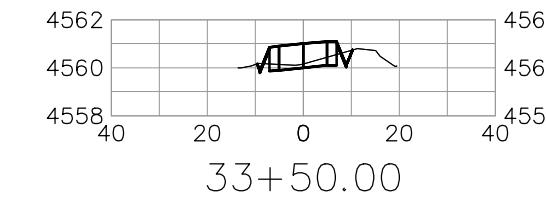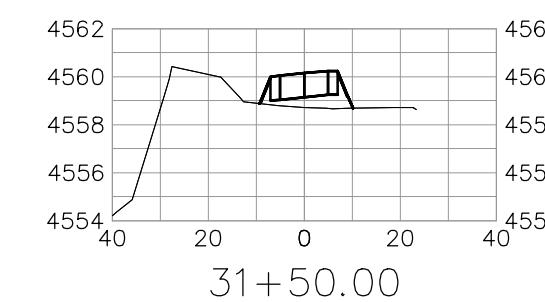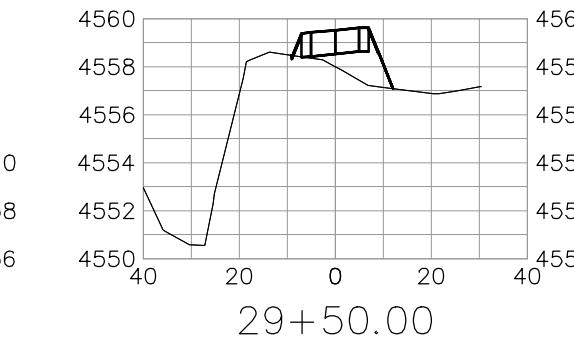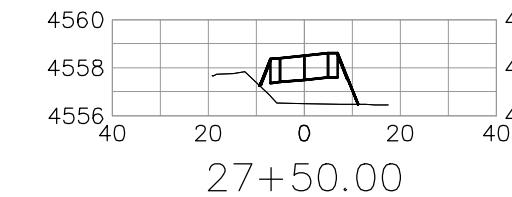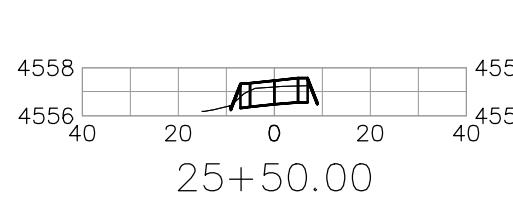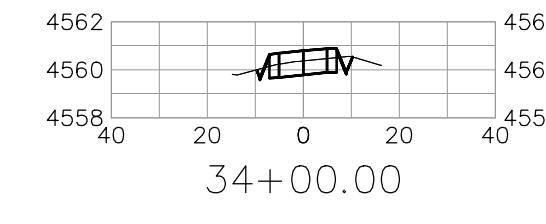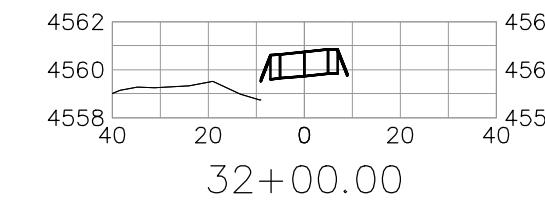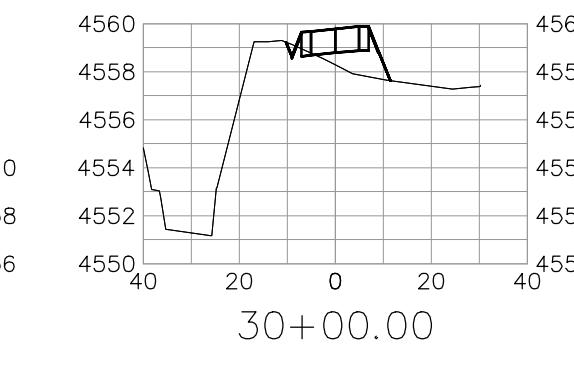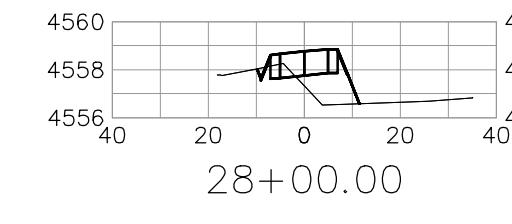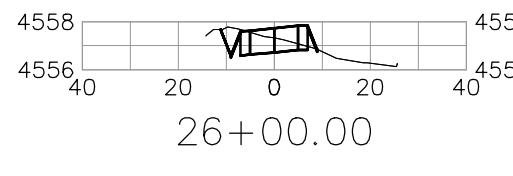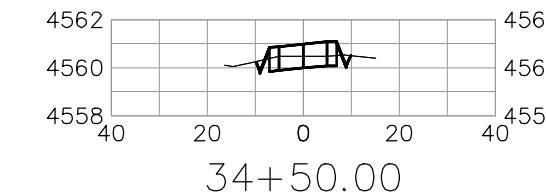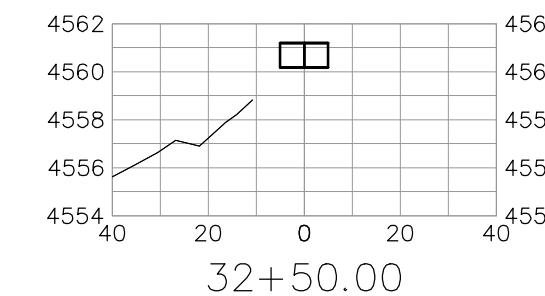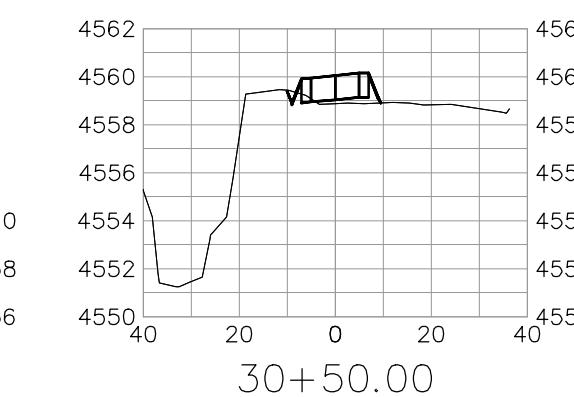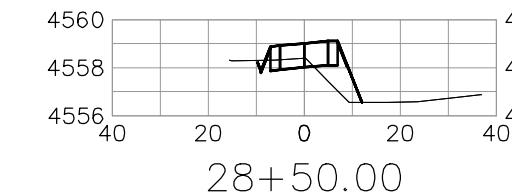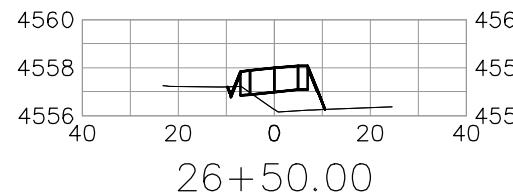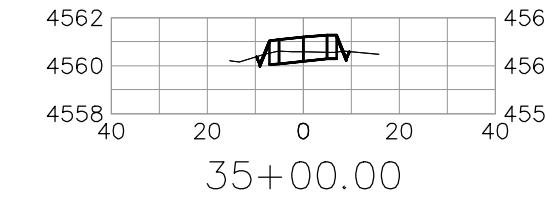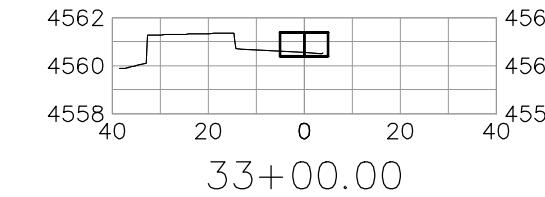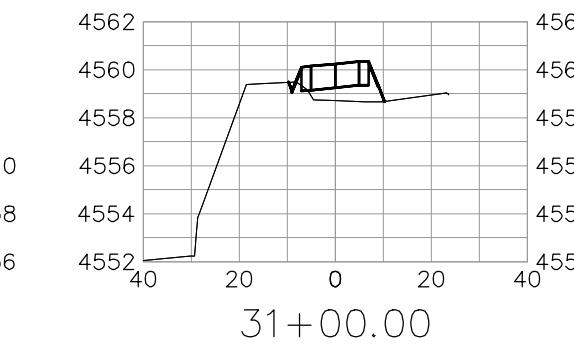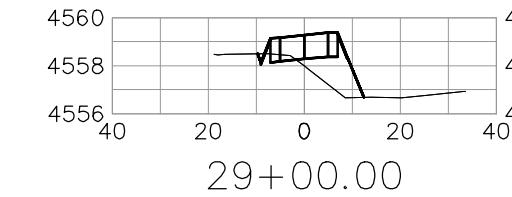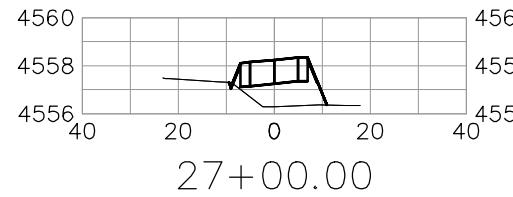

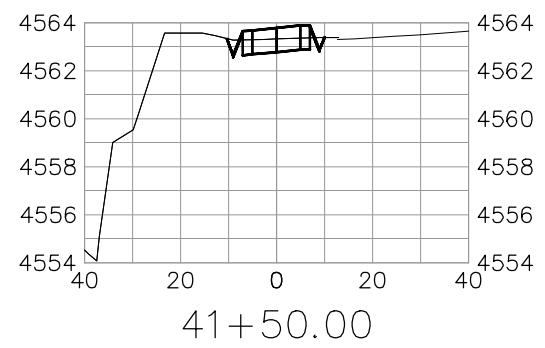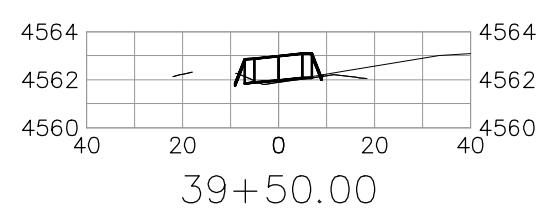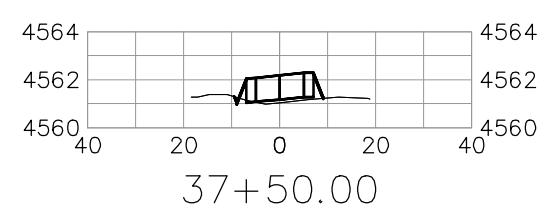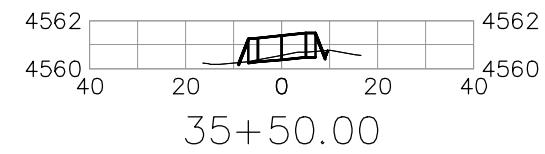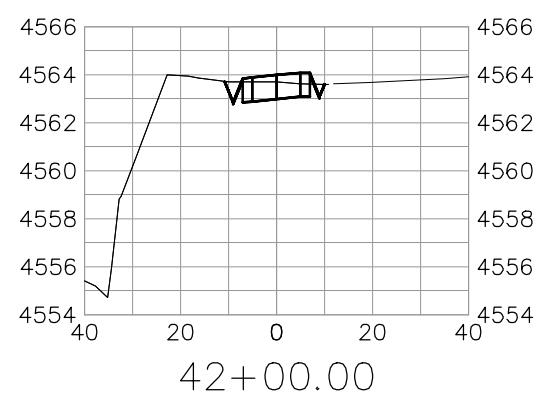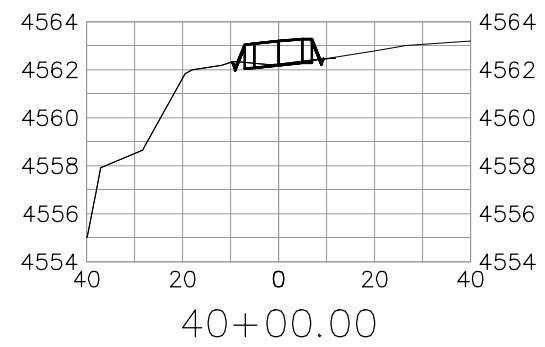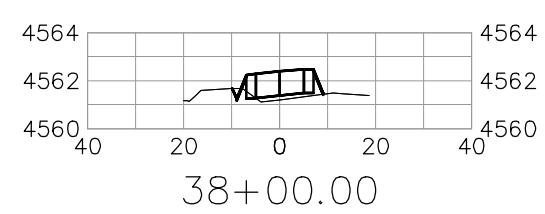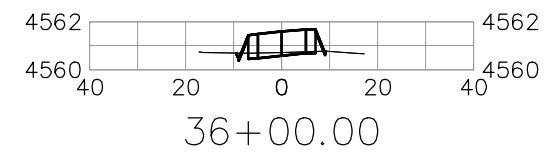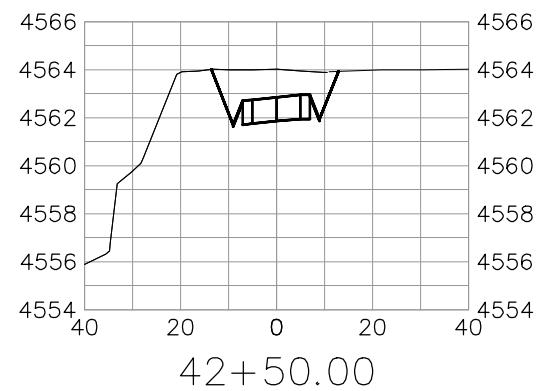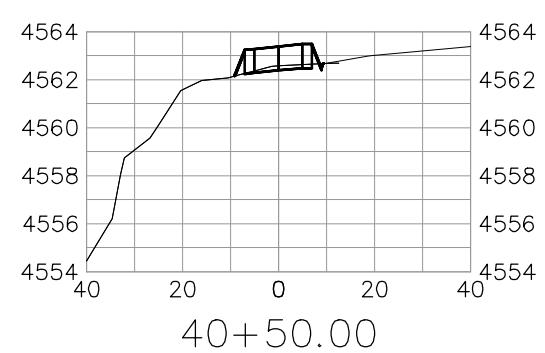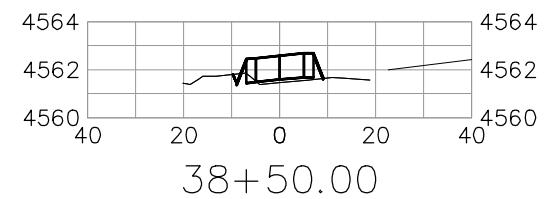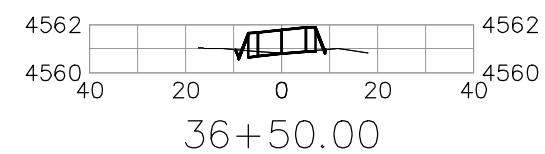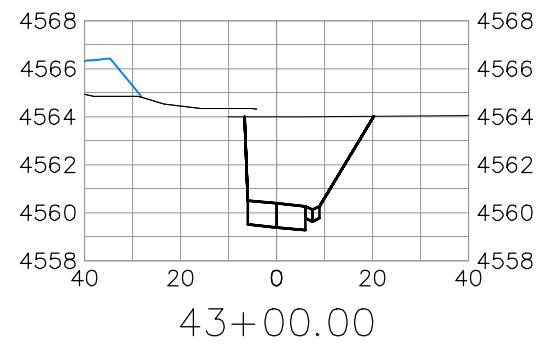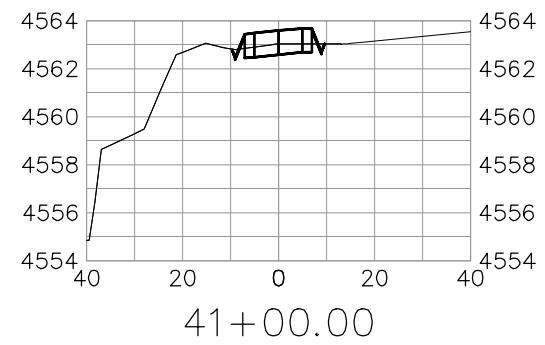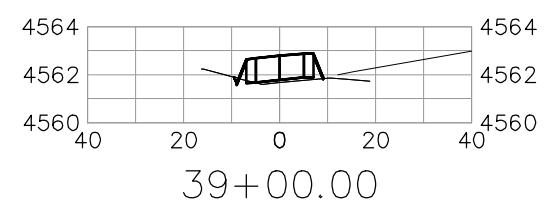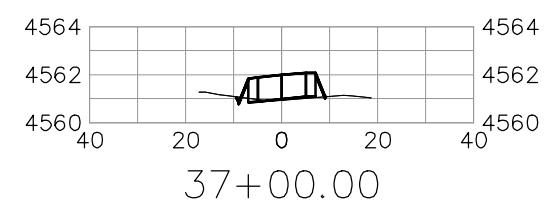

DESCRIPTION DATE
REVISION A REV 1 - DATE
REVISION A REV 2 - DATE
REVISION A REV 3 - DATE
REVISION A REV 4 - DATE










DRAWN BY JCS DATE 2020
DESIGNED BY JCS DATE 2020
CHECKED BY ALC DATE 2020
APPROVED BY TCP DATE 2020

SCALES:
PLAN & PROFILE
0 10 20 40
HORIZONTAL
0 4
VERTICAL

CITY OF
Grand Junction
COLORADO

PUBLIC WORKS
ENGINEERING DIVISION
PROJECT NO. FUND-ACTIVITY NO

24 ROAD BIKE PATH
BIKE PATH CROSS SECTIONS - 2
June 10, 2020

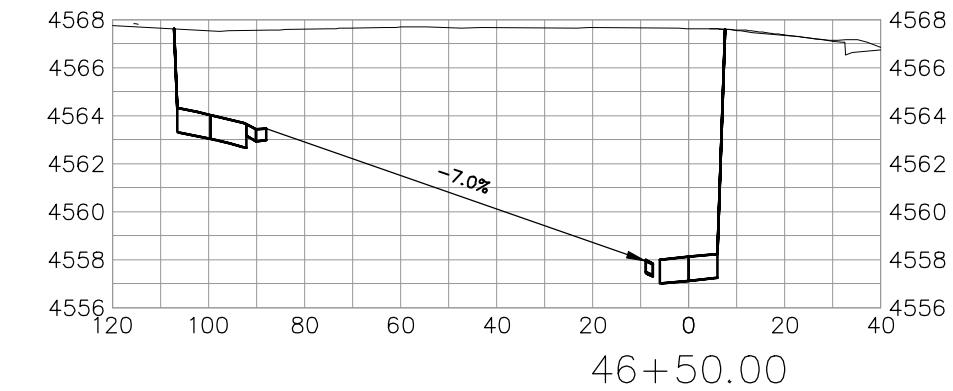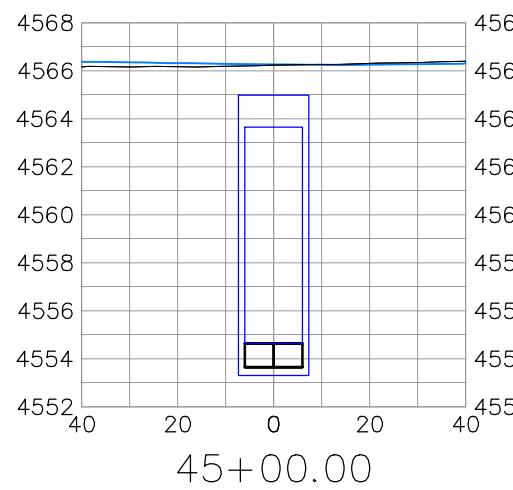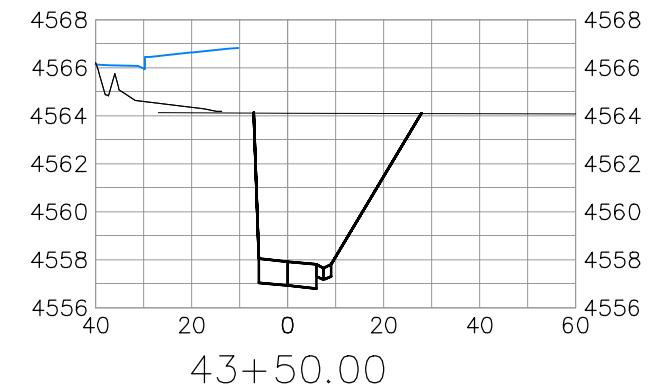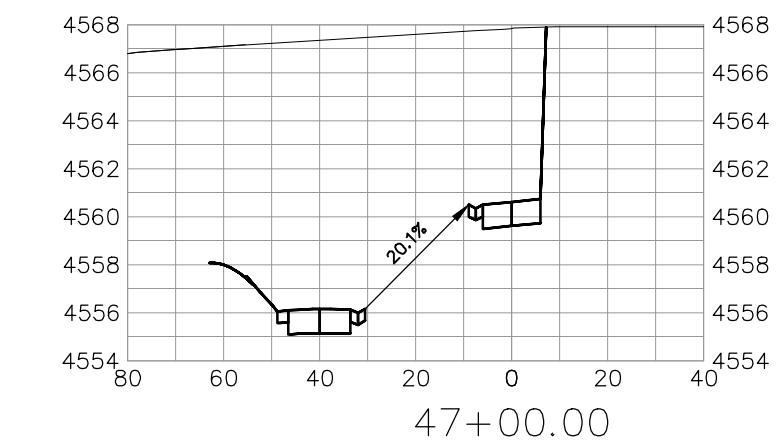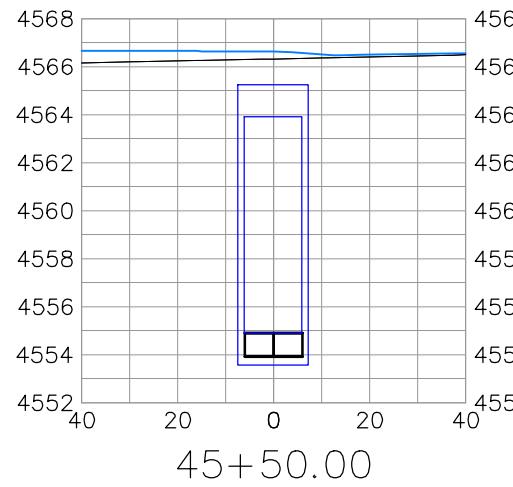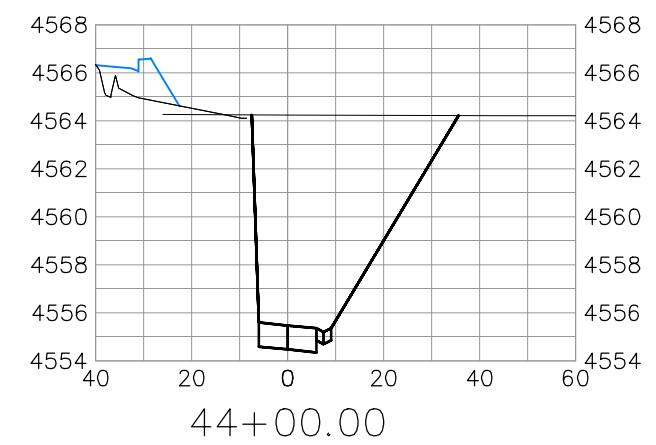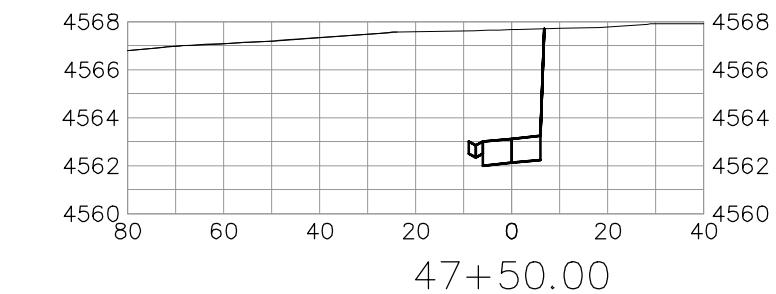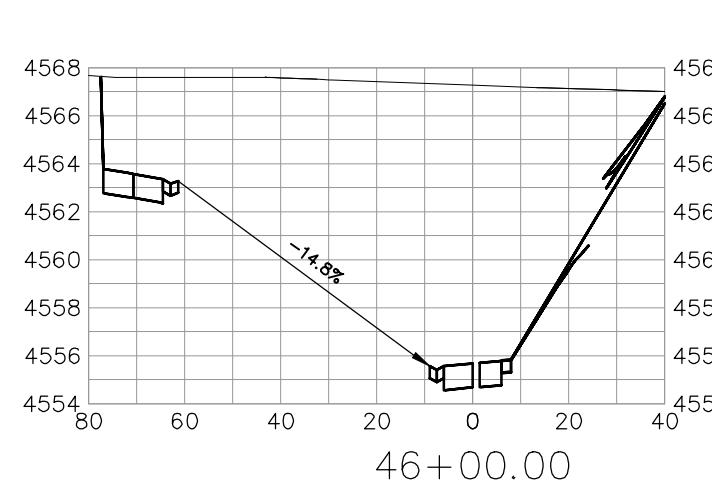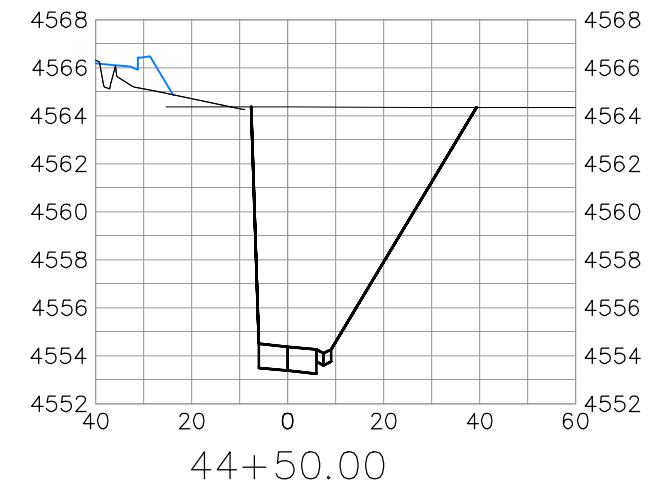

DESCRIPTION		DATE
REVISION A REV 1		- DATE
REVISION A REV 2		- DATE
REVISION A REV 3		- DATE
REVISION A REV 4		- DATE



DRAWN BY	JCS	DATE 2020
DESIGNED BY	JCS	DATE 2020
CHECKED BY	ALC	DATE 2020
APPROVED BY	TCP	DATE 2020

SCALES:
PLAN & PROFILE
0 10 20 40
HORIZONTAL
0 4
VERTICAL



PUBLIC WORKS
ENGINEERING DIVISION
PROJECT NO. FUND-ACTIVITY NO

24 ROAD BIKE PATH
BIKE PATH CROSS SECTIONS - 3
June 10, 2020

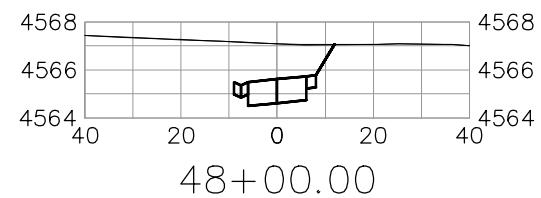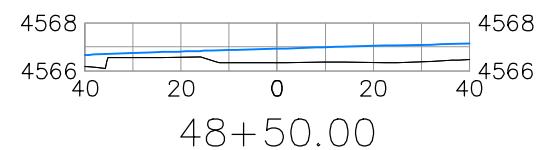

DESCRIPTION		DATE
REVISION A REV 1	- DATE	
REVISION A REV 2	- DATE	
REVISION A REV 3	- DATE	
REVISION A REV 4	- DATE	

DRAWN BY	JCS	DATE 2020
DESIGNED BY	JCS	DATE 2020
CHECKED BY	ALC	DATE 2020
APPROVED BY	TCP	DATE 2020

SCALES:		
PLAN & PROFILE		
0	10	20
HORIZONTAL		40
0	4	8
VERTICAL		



PUBLIC WORKS
ENGINEERING DIVISION
PROJECT NO. FUND-ACTIVITY NO

24 ROAD BIKE PATH
BIKE PATH CROSS SECTIONS - 4
June 10, 2020

SUMMARY OF APPROXIMATE QUANTITIES


ITEM	DESCRIPTION	QUAN.	UNIT
201	CLEARING AND GRUBBING	1	LUMP SUM
202	REMOVAL OF PORTIONS OF STRUCTURE	1	LUMP SUM
202	REMOVAL OF GROUND SIGN	0 A	EACH
206	STRUCTURE EXCAVATION	213	CU. YDS.
207	STRUCTURE BACKFILL (SPECIAL)	268	CU. YDS.
207	TOP SOIL (AS MEASURED IN THE FIELD)	0 A	CU. YDS.
208	SILT FENCE	500	LIN. FT.
208	EROSION BALES	100	EACH
216	SOIL RETENTION BLANKET	11456 20	SQ. YDS.
403	HOT BITUMINOUS PAVEMENT (GRADING C) (2" THICK)	107106 12	TON
502	DRIVING TIPS	22	EACH
502	STEEL PILING (HP8x36)	11825 800	LIN. FT.
509	STRUCTURAL STEEL	15570	LBS.
509	FIELD CLEANING AND PAINTING STEEL	105	LS
515	WATERPROOFING (MEMBRANE)	105	SQ. YDS.
601	CONCRETE CLASS D (DECK)	155	CU. YDS.
602	REINFORCING STEEL (EPOXY COATED)	7635	LBS.
606	BRIDGE RAIL (SPECIAL)	797	LIN. FT.
608	CONCRETE SIDEWALK (SPECIAL)	1345 898	SQ. FT.
609	CURB AND GUTTER (SPECIAL)	0 78	LIN. FT.
613	ELECTRICAL CONDUIT (2 INCH)	0 116	LIN. FT.
613	ELECTRICAL CONDUIT (4 INCH)	0 150	LIN. FT.
613	ELECTRICAL CONDUIT (6 INCH)	0 146	LIN. FT.
F/A	FORCE ACCOUNT	1	LUMP SUM
626	MOBILIZATION	1	LUMP SUM
630	CONSTRUCTION SURVEYING	1	LUMP SUM
630	TRAFFIC CONTROL	1	LUMP SUM

TOTAL COST = \$113,800.86

FOR DETAILS OF

BALI SEE

60
55

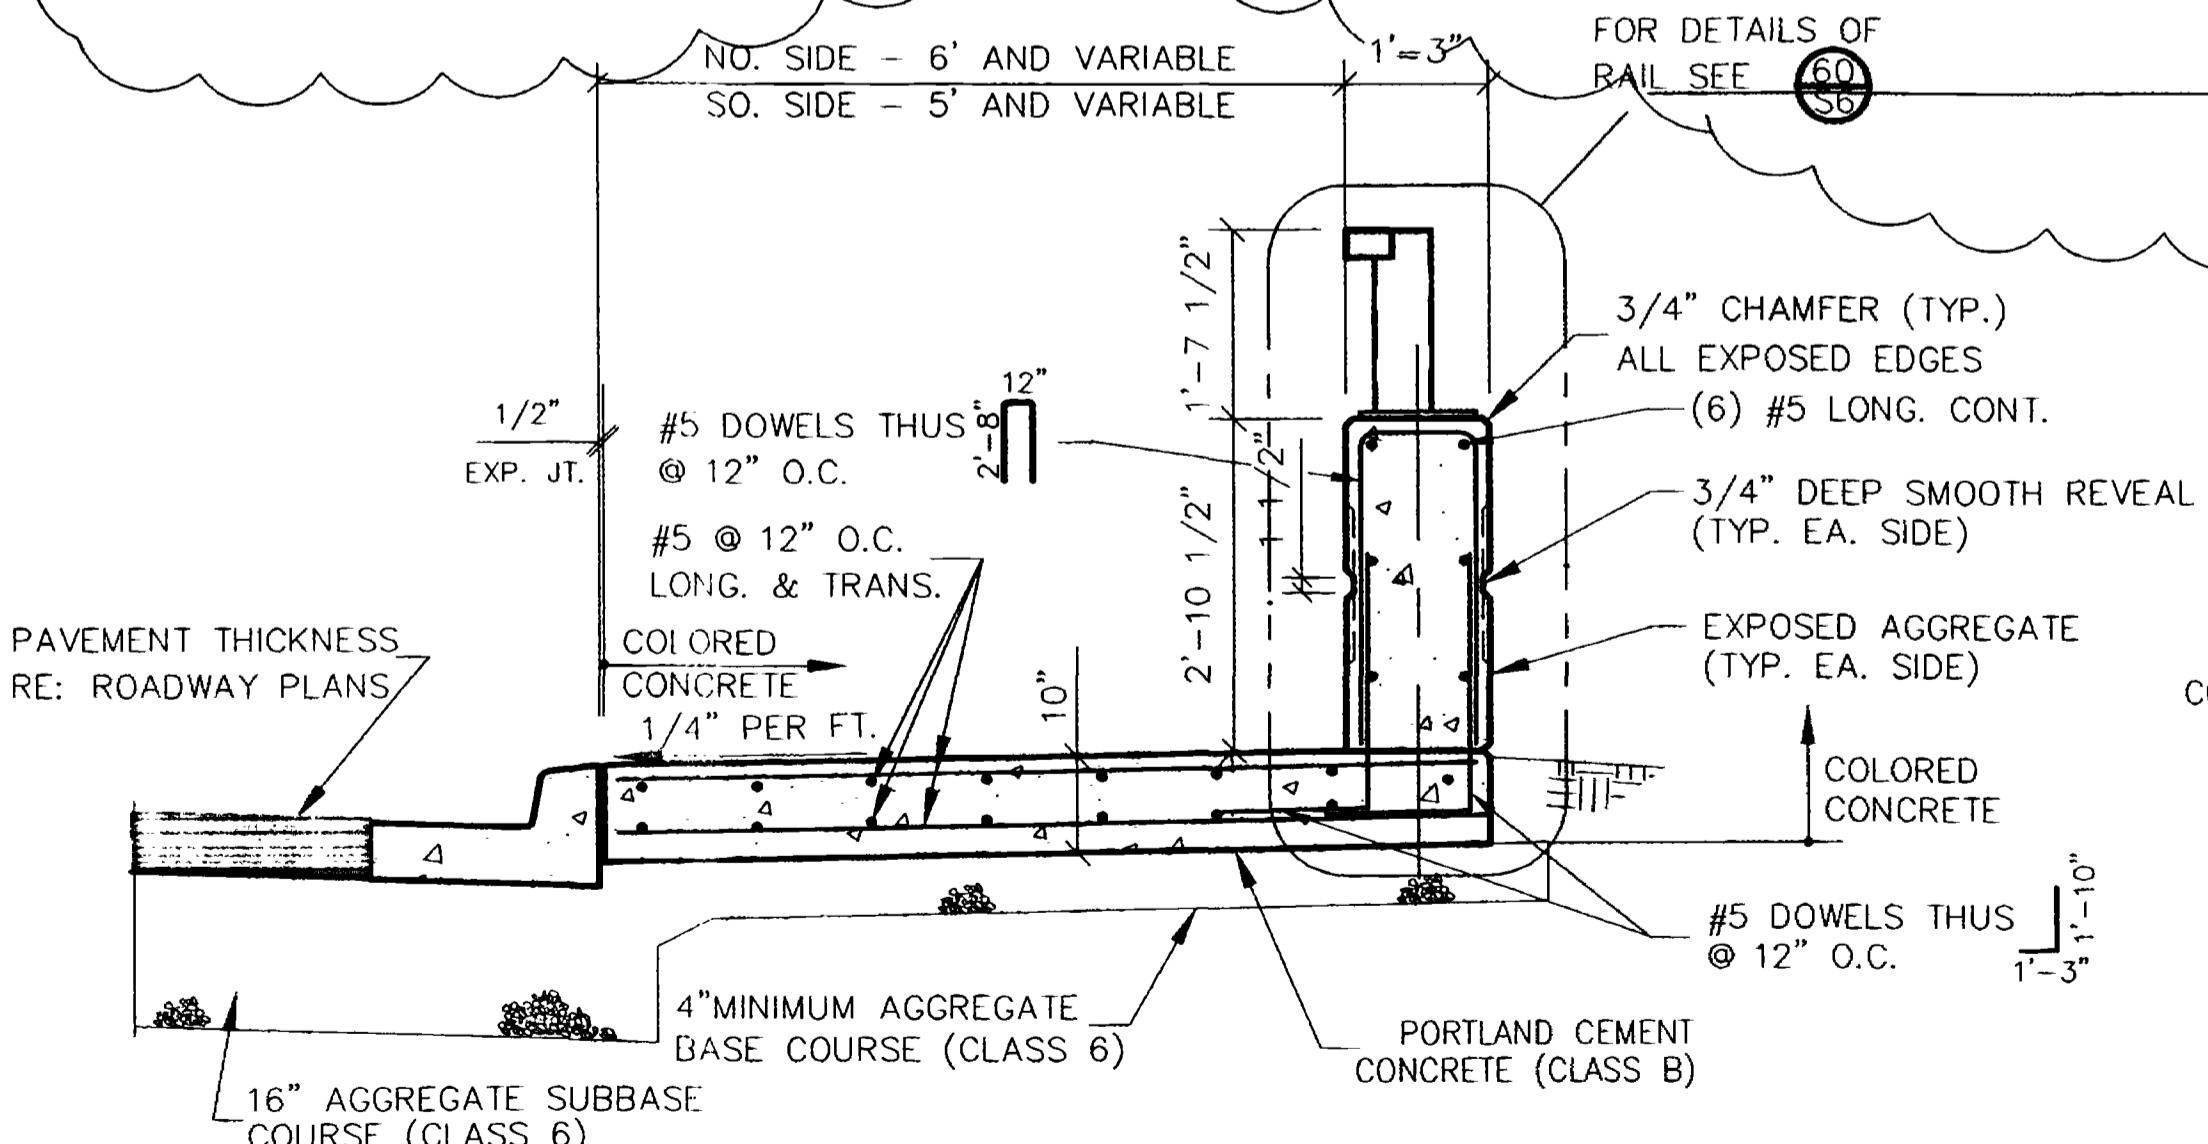


SECTION 20
S2 3/4"=1'-0"

SEE NOTE 3, EXHIBIT "E",
STANDARD CONCRETE DETAILS
FOR COMPACTION REQUIREMENTS


MCSM
STA. 54+60.63 (24 ROAD)
NE CORN SECT. 5
T15,R1W,UM
N50008.08
E78898.11
ELEV. 4566.43

PROJECT CONTROL COORDINATES

DESCRIPTION	24 RD. STA.	NORTHING	EASTING	ELEVATION
BK. WEST ABUTMENT	STA. 10+21.93	50008.065	78920.040	4566.89
BK. EAST ABUTMENT	STA. 10+41.93	50008.051	78940.040	4566.94

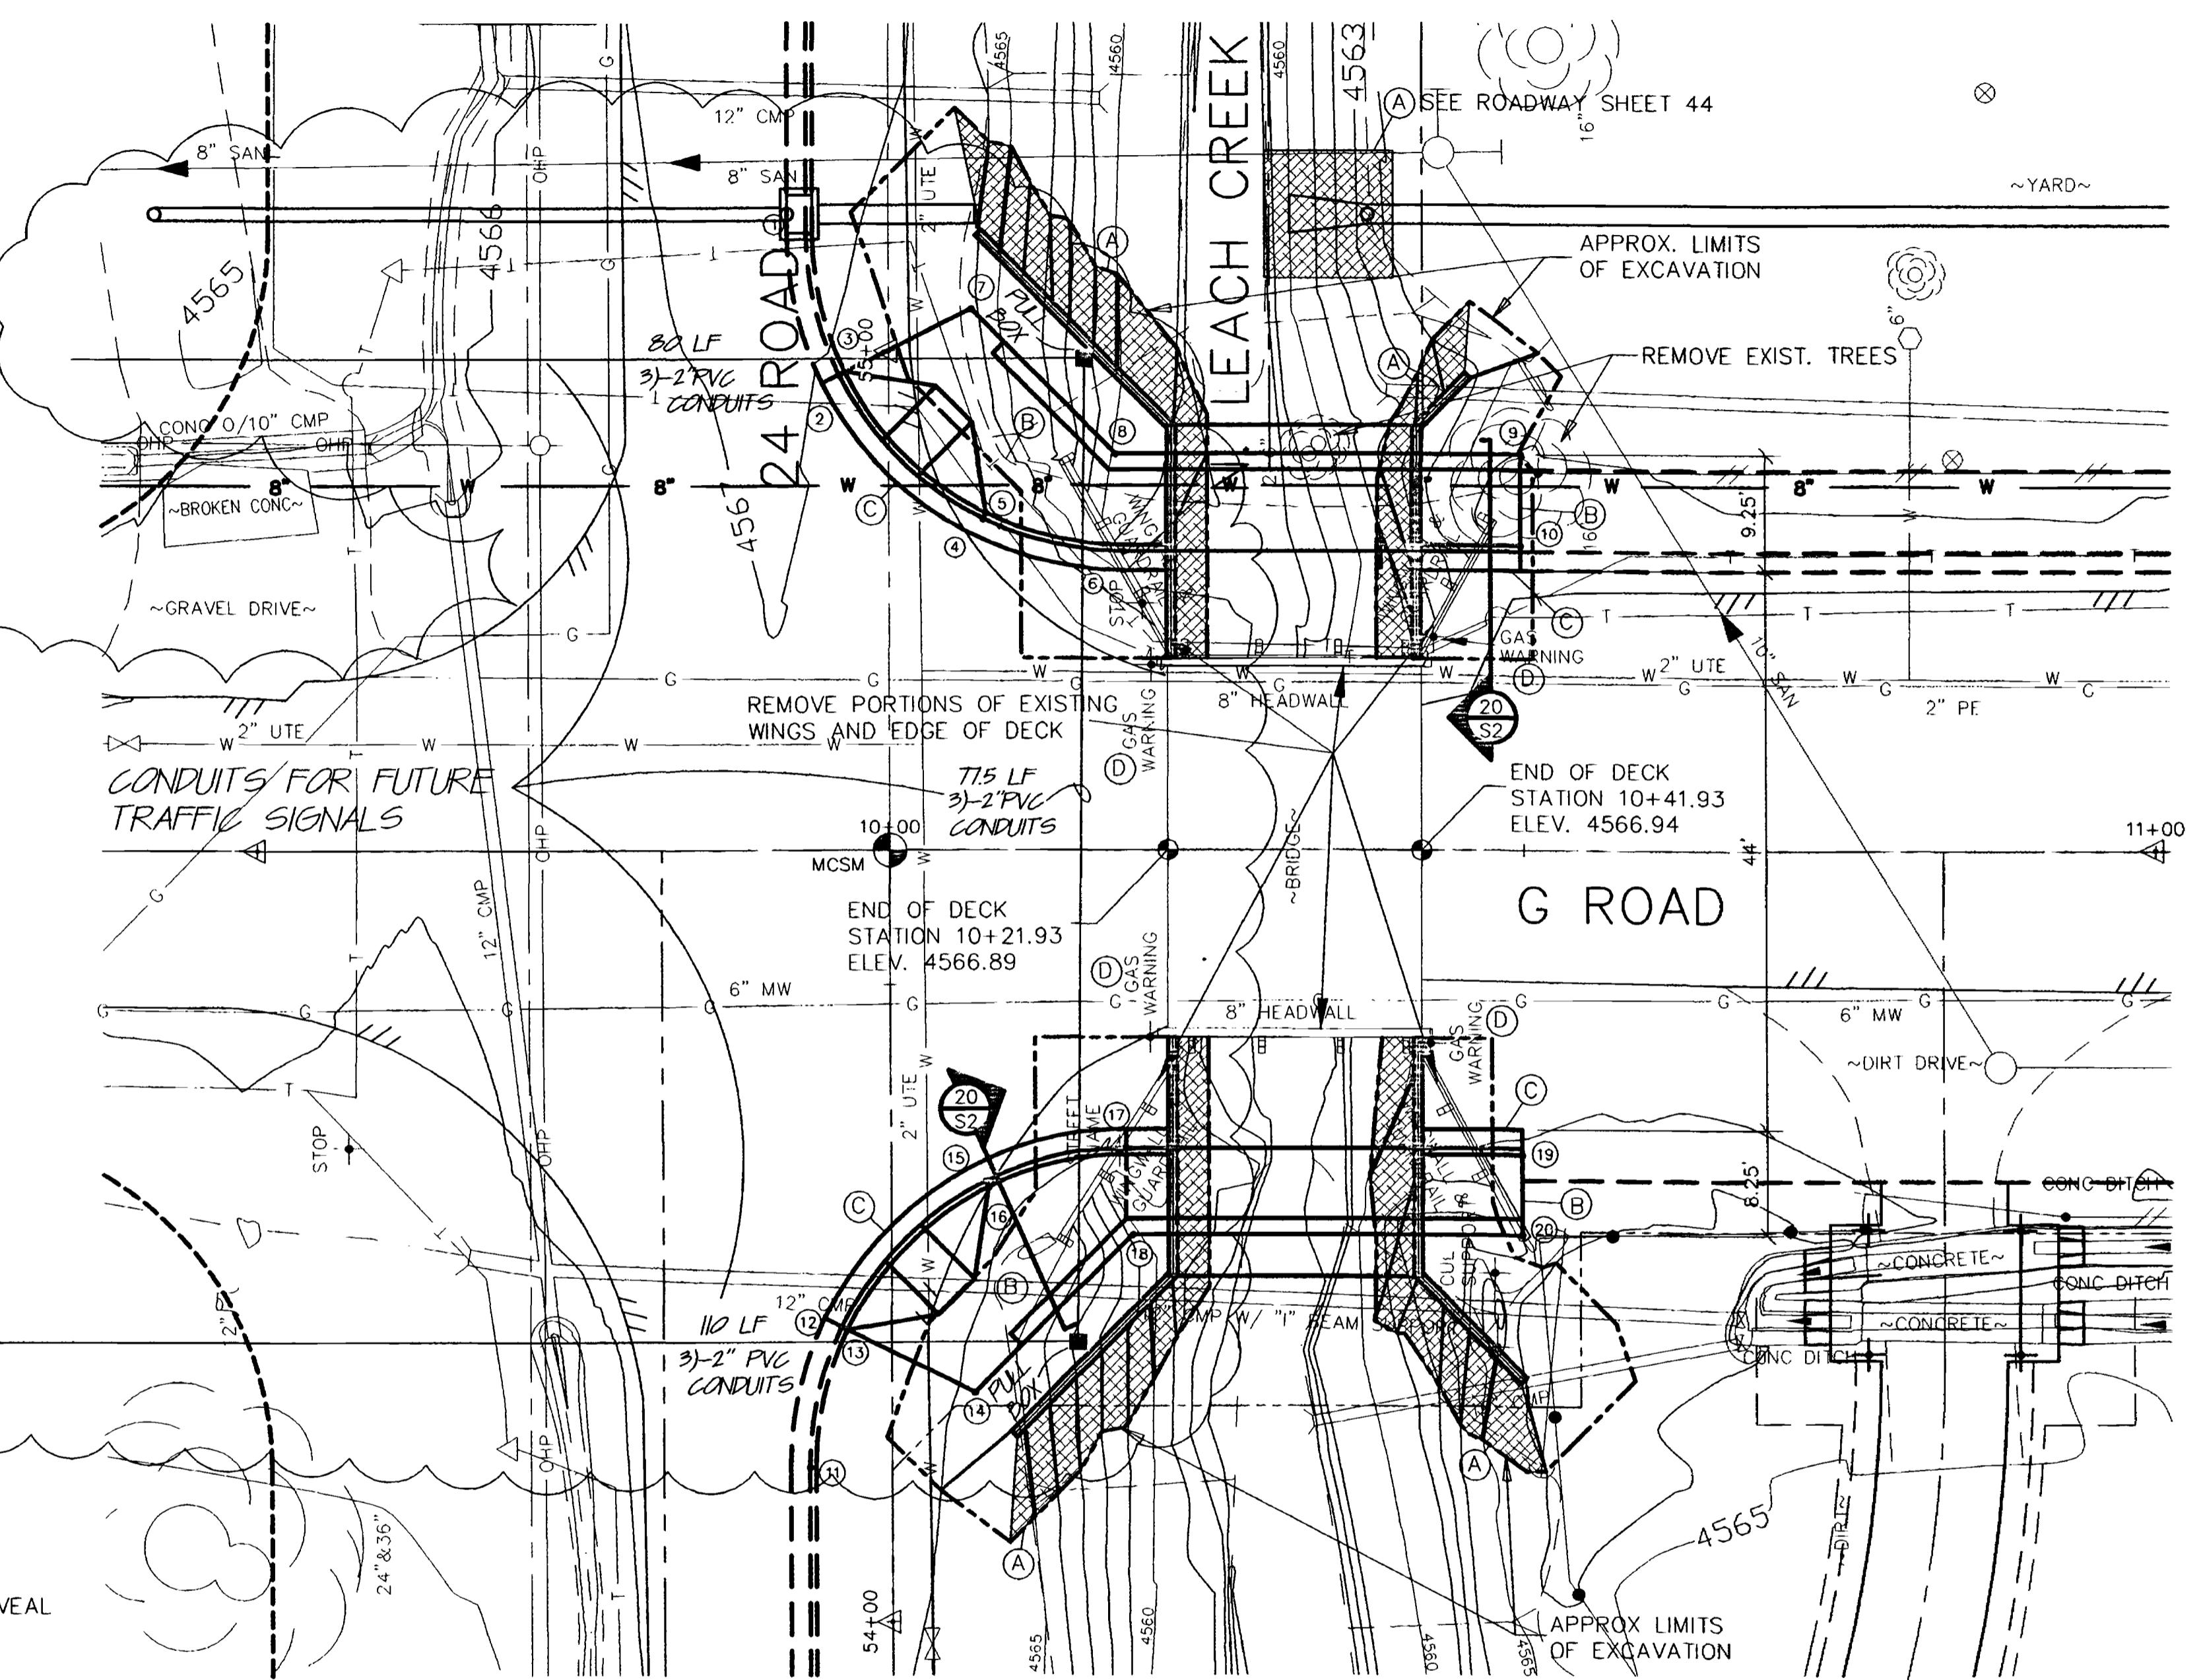

GENERAL PLAN

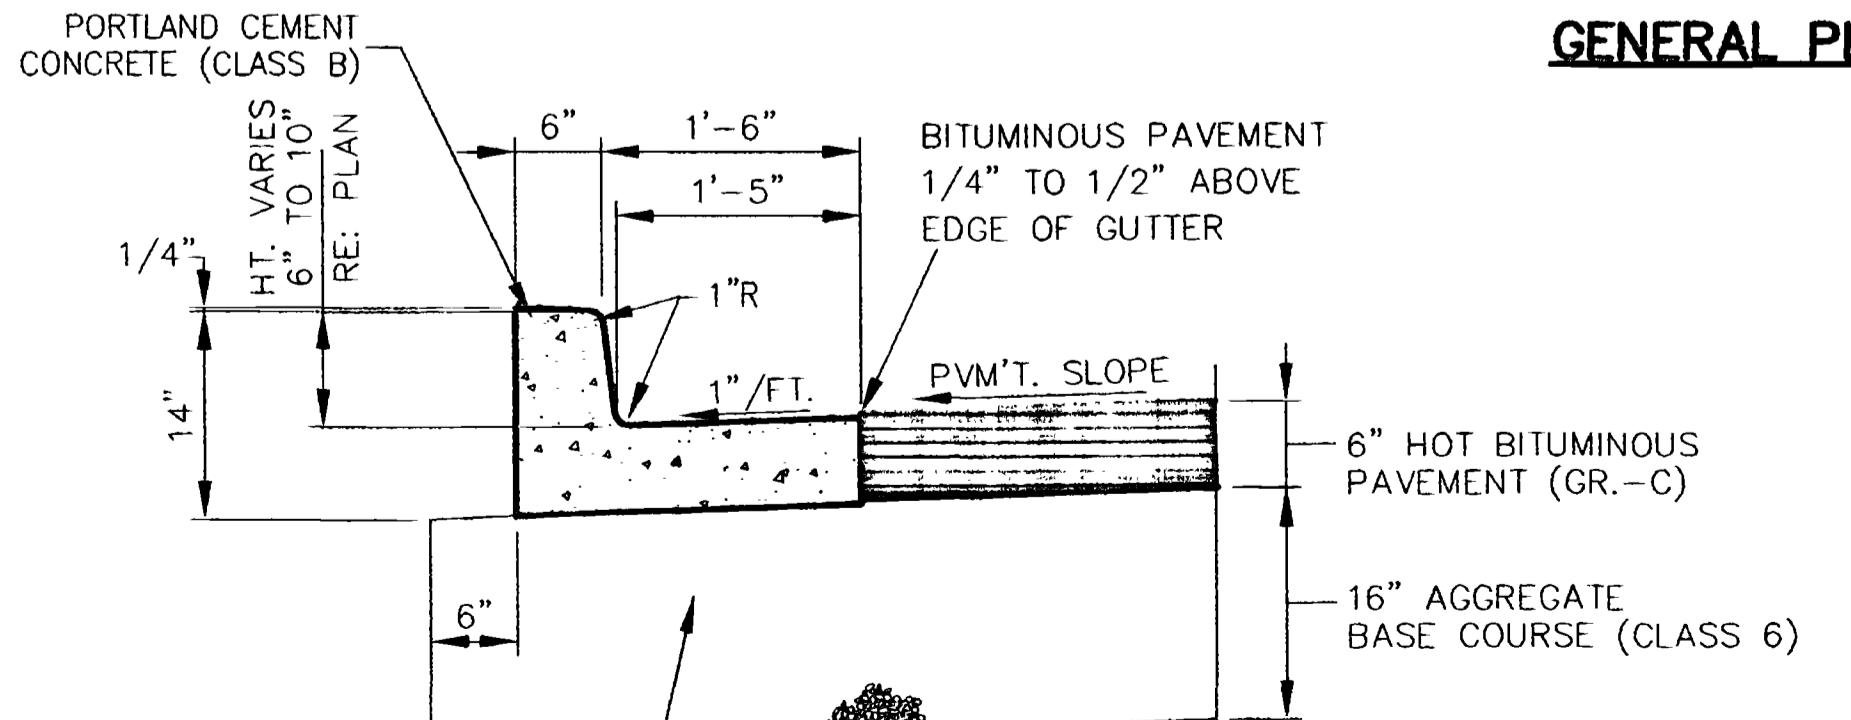

CURB & GUTTER

PNT	STATION	OFFSET	DESCRIPTION	NORTHING	EASTING	ELEV.
1	9+93.52	-48.26	FLOWLINE	50056.588	78891.651	4566.21
2	9+96.11	-37.45	FLOWLINE	50045.527	78894.221	4566.27
3	9+96.53	-37.67	TBC	50045.748	78894.669	4566.79
4	10+07.45	-26.08	FLOWLINE	50034.154	78905.576	4566.36
5	10+07.71	-26.53	TBC	50034.602	78905.798	4566.88
6	10+18.51	-23.50	FLOWLINE	50031.567	78916.633	4566.42
7	10+06.53	-42.60	BOW	50050.670	78904.670	4567.02
8	10+17.87	-31.25	BOW	50039.320	78916.003	4567.26
9	10+49.81	-31.25	BOW	50039.298	78947.939	4567.15
10	10+49.81	-24.0	TBC	50032.046	78947.934	4567.00
11	9+93.35	48.53	FLOWLINE	49959.551	78891.642	4565.67
12	9+96.10	37.50	FLOWLINE	49970.584	78894.200	4565.89
13	9+96.55	37.72	TBC	49970.364	78894.649	4566.41
14	10+06.61	42.64	BOW	49965.433	78904.693	4566.64
15	10+07.49	26.09	FLOWLINE	49981.989	78905.585	4566.25
16	10+07.71	26.53	TBC	49981.541	78905.806	4566.78
17	10+18.51	23.5	FLOWLINE	49984.567	78916.659	4566.51
18	10+19.09	30.25	BOW	49977.820	78917.175	4567.24
19	10+49.81	24.0	TBC	49984.046	78947.901	4567.00
20	10+49.81	30.25	BOW	49977.800	78947.896	4567.13

50 OF 54

04119854.tif

BRIDGE WIDENING - 24 & G ROADS
CITY OF GRAND JUNCTION, COLORADO

NICHOLS
ASSOCIATES, INC.

CIVIL ENGINEERING • PHOTOGRAVEMETRY • SURVEYING
701 Horizon Court • Grand Junction, Colorado 81506 • Phone: 970-244-7101


DATE
11/30/99

SCALE
1"=10'

PROJECT NUMBER
3480B

REVISIONS
1/30/00 ASBUILT

DESIGNED BY
DRAWN BY
SURVEY DATE

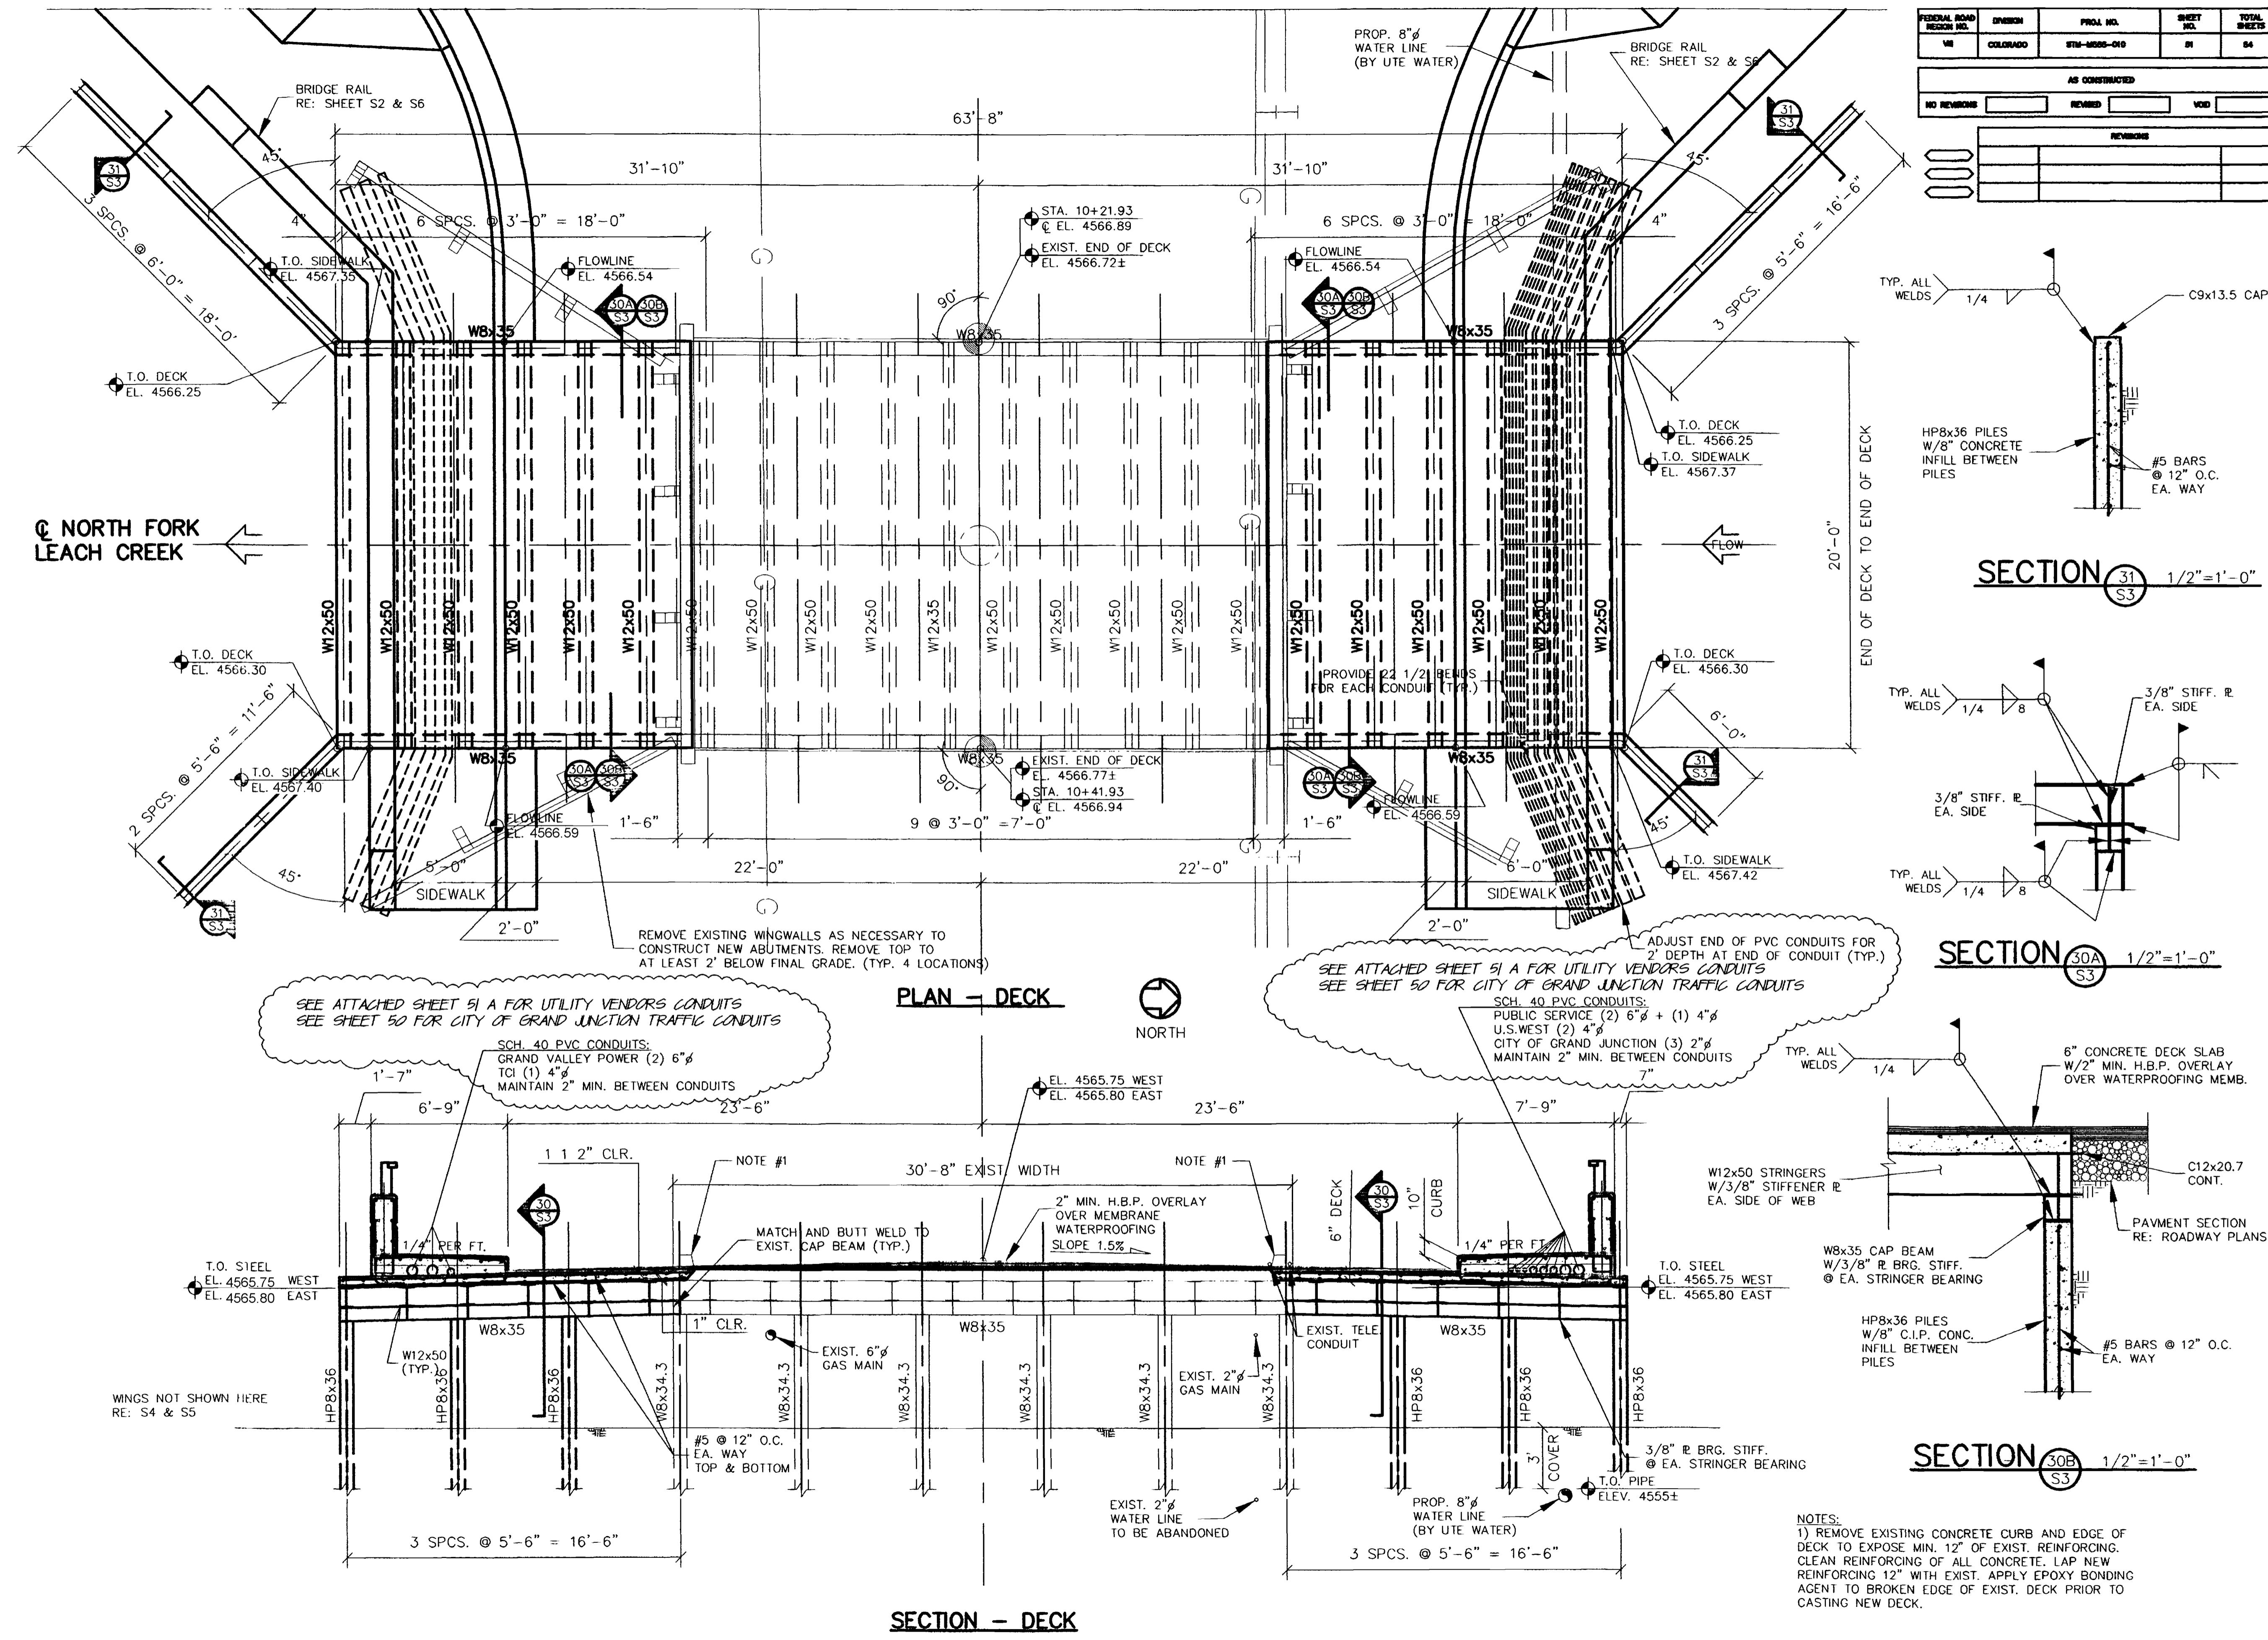

CML ENGINEERING • PHOTOGRAMMETRY • SURVEYING

711 Harrison Street • Suite 200 • Denver, Colorado 80202 • (303) 295-2101

CITY OF GLEN MICHOLS

1/19/99

$4'' \equiv 1' = 0''$

3480B

1 54

**G - 24 & G ROADS
JUNCTION, COLORADO**

100

DATE

11/19/99

PROJECT

3480B

1119855.tif

FEDERAL ROAD SECTION NO.	DIVISION	PROJ. NO.	SHET NO.	TOTAL SHEETS
VI	COLORADO	STM-M005-010	01	54


AS CONSTRUCTED
NO REVISIONS REVISED VOID

REVISIONS		
<input type="checkbox"/>	<input type="checkbox"/>	<input type="checkbox"/>
<input type="checkbox"/>	<input type="checkbox"/>	<input type="checkbox"/>
<input type="checkbox"/>	<input type="checkbox"/>	<input type="checkbox"/>
<input type="checkbox"/>	<input type="checkbox"/>	<input type="checkbox"/>

DESIGNED BY	DRAWN BY
SURVEY DATE	

REVISIONS		
NO.	DATE	REMARKS
1	3-2000	AS BUILT
		JCS

BRIDGE WIDENING - 24 & G ROADS
CITY OF GRAND JUNCTION, COLORADO
CIVL ENGINEERING • PHOTOGRAVIMETRY • SURVEYING
781 Horizon Court • Grand Junction, Colorado 81508 • Phone: 670-246-7101

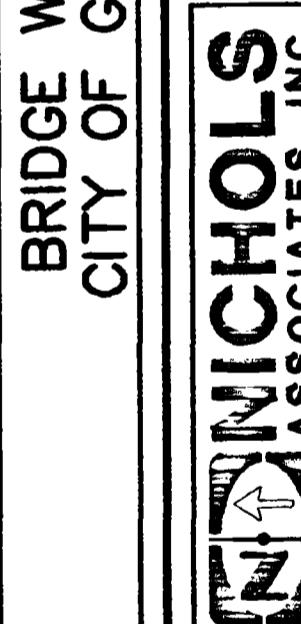


DATE	11/19/99
------	----------

SCALE	1/4" = 1'-0"
-------	--------------

PROJECT	3480B
---------	-------

SHEET
51a OF 54

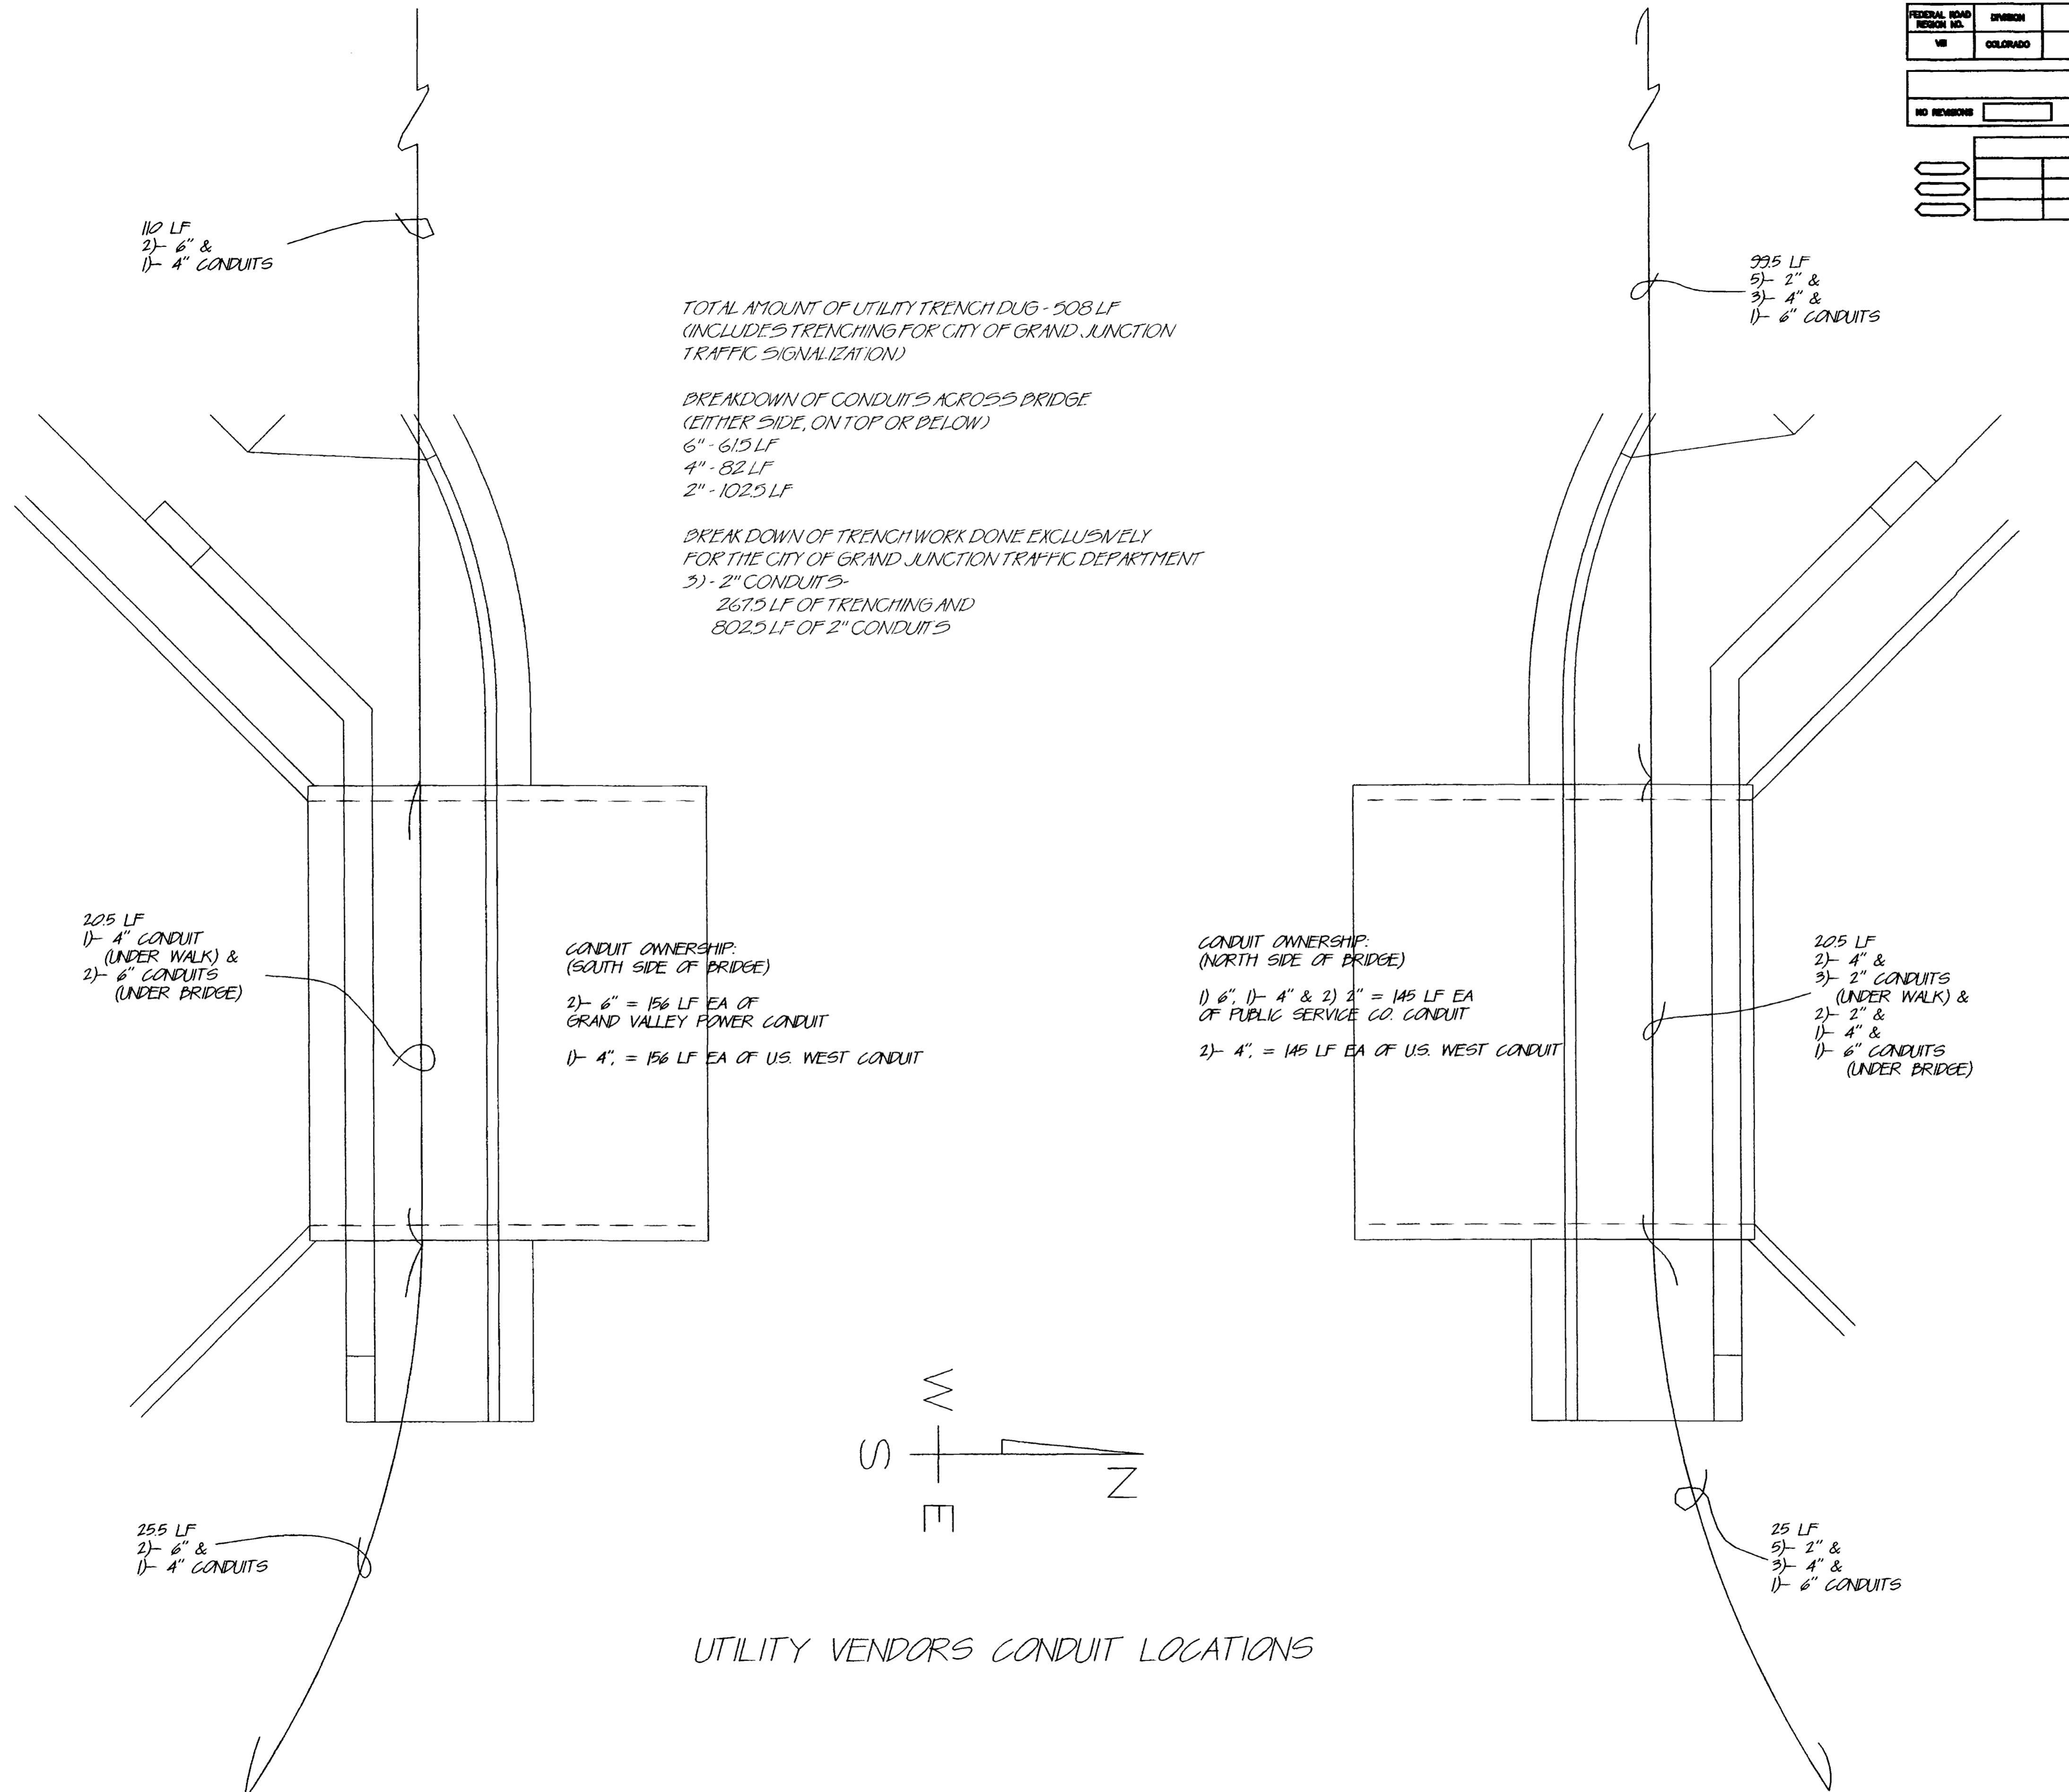

AS BUILT

04119856.tif

FEDERAL ROAD SECTION NO.	BRANCH	PROJ. NO.	SHEET NO.	TOTAL SHEETS
W6	COLORADO	STM-W600-010	02	04
AS CONSTRUCTED				
NO REVISIONS	REVIEWED	VIS		
			REVISIONS	



DESIGNED BY	BY
DRAWN BY	BY
SURVEY DATE	

CIVL ENGINEERING • PHOTOGAMMTRY • SURVEYING
 701 Horizon Court • Grand Junction, Colorado 81508 • Phone: (970) 246-7101

BRIDGE WIDENING - 24 & G ROADS CITY OF GRAND JUNCTION, COLORADO



DATE	11/19/99
SCALE	1/4" = 1'-0"
PROJECT	3480B
SHEET	52 of 54

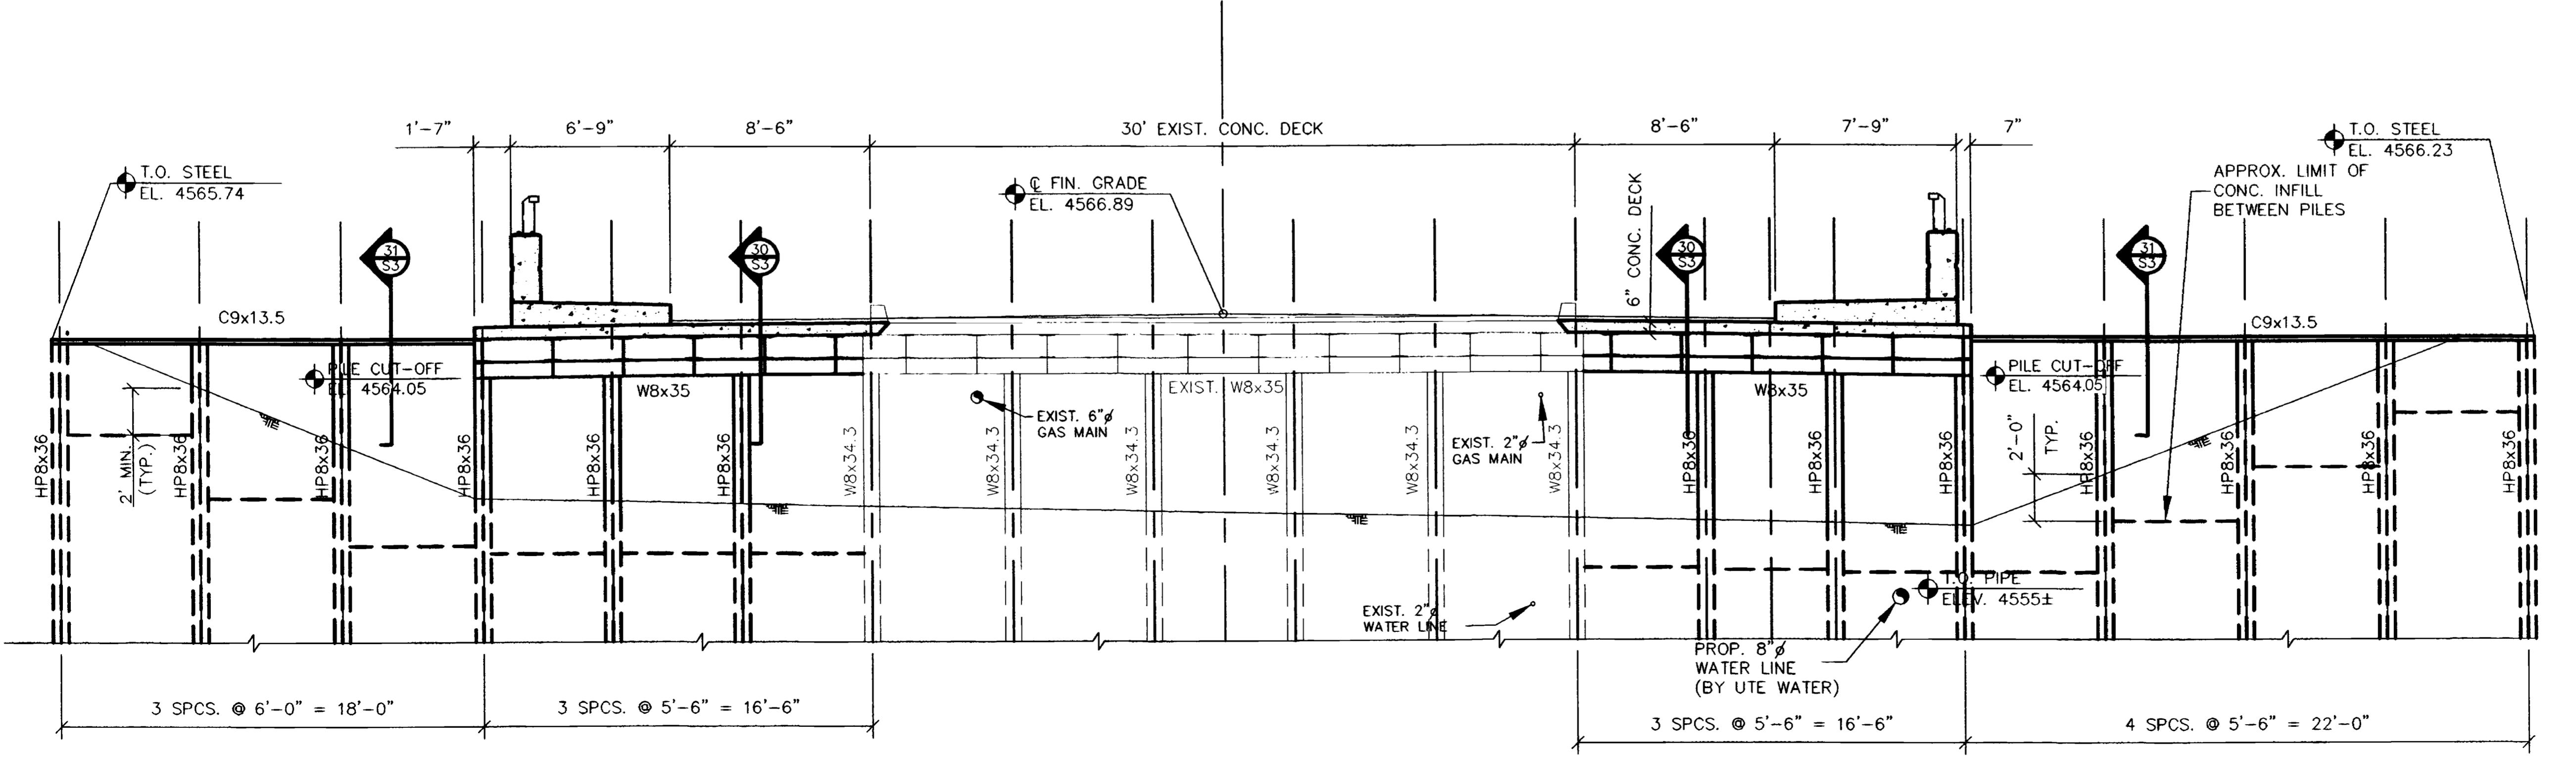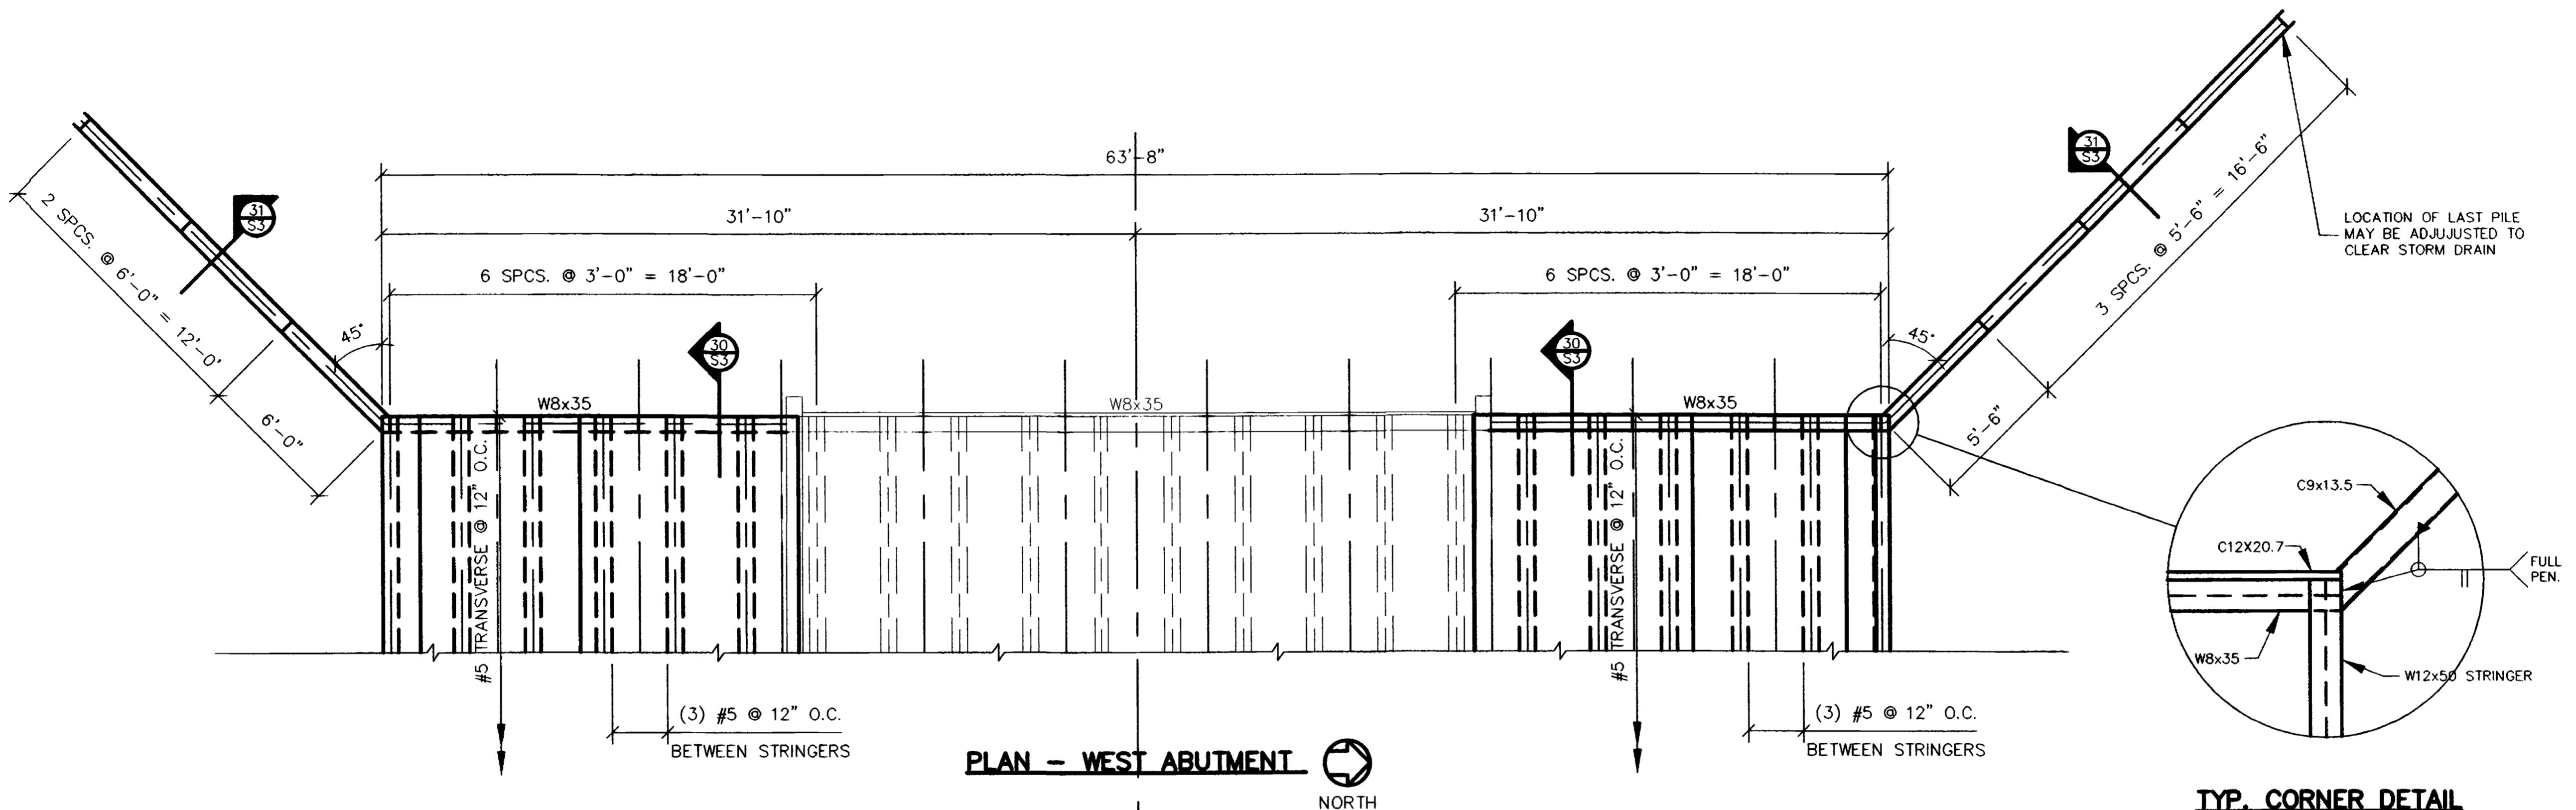

FEDERAL ROAD PERMISSION NO.	DIVISION	PROJ. NO.	SPANN.	TOTAL SHEETS
VR	COLORADO	STR-M005-010	S3	64

AS CONSTRUCTED
NO REVISIONS REVISED VOID



REVISIONS

REVISIONS

NO. DATE REVISIONS
1/19/99

NICHOLS
ASSOCIATES, INC.

CIVIL ENGINEERING • PHOTOGRAVEMETRY • SURVEYING
701 Horizon Court • Grand Junction, Colorado 81508 • Phone: 970-246-7101

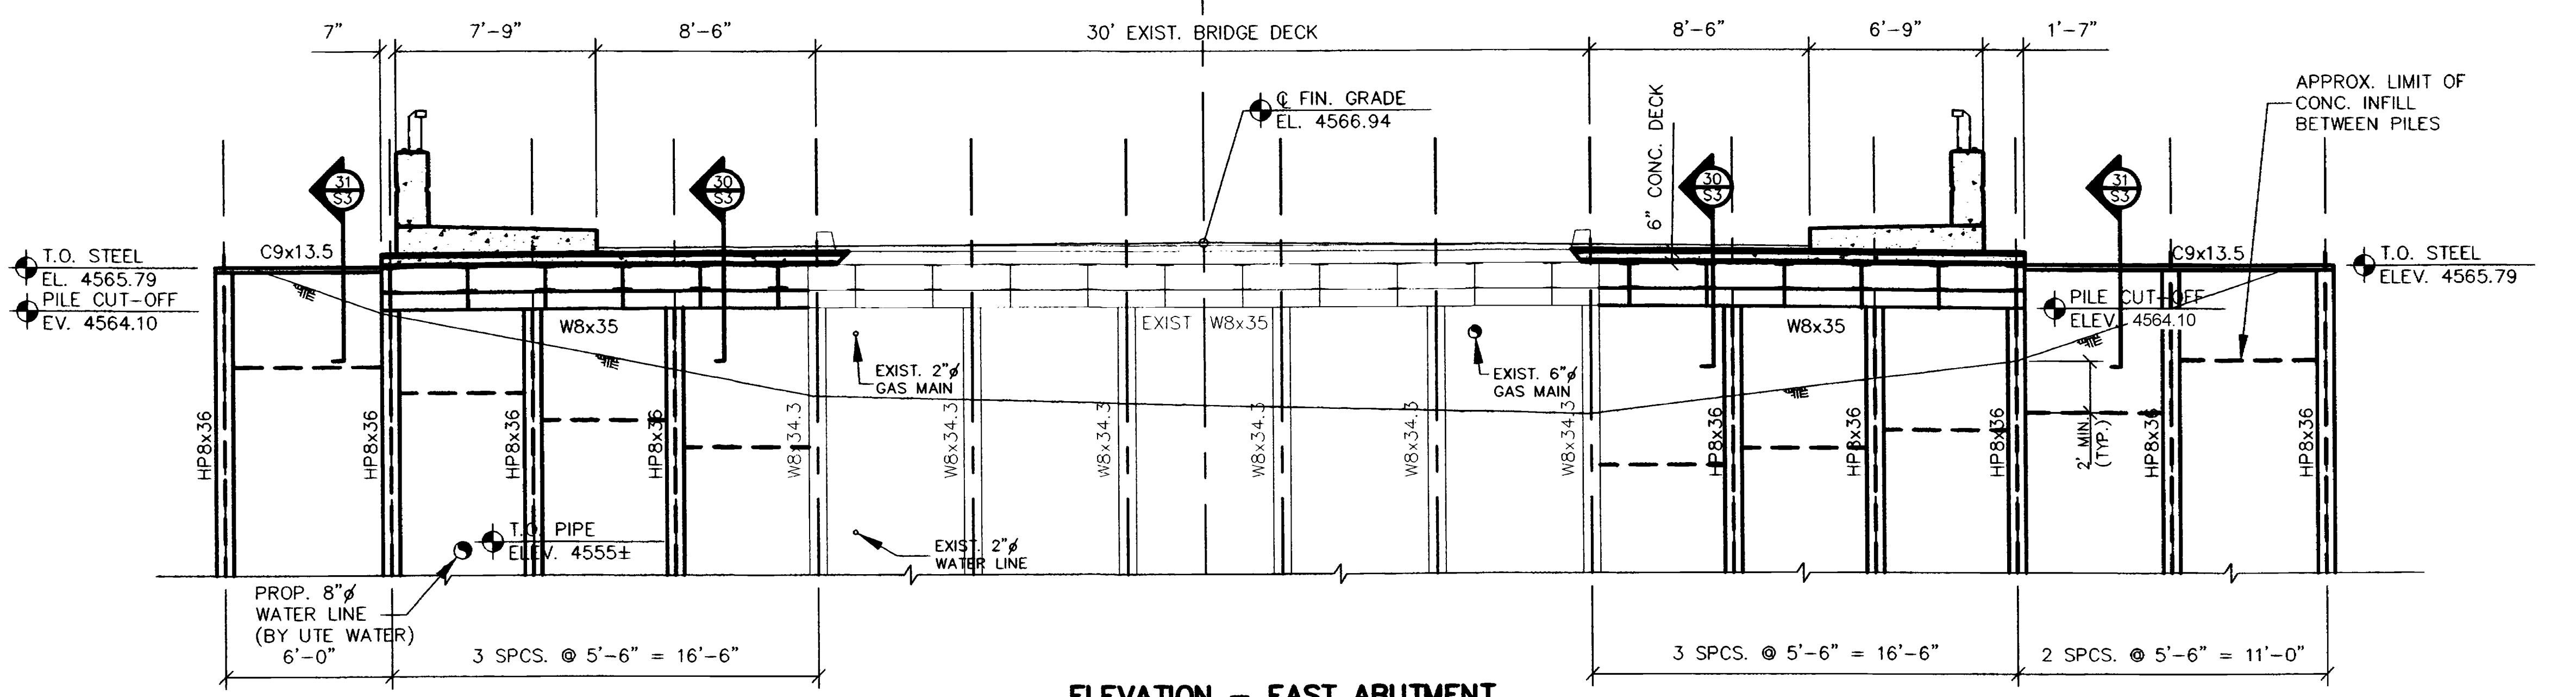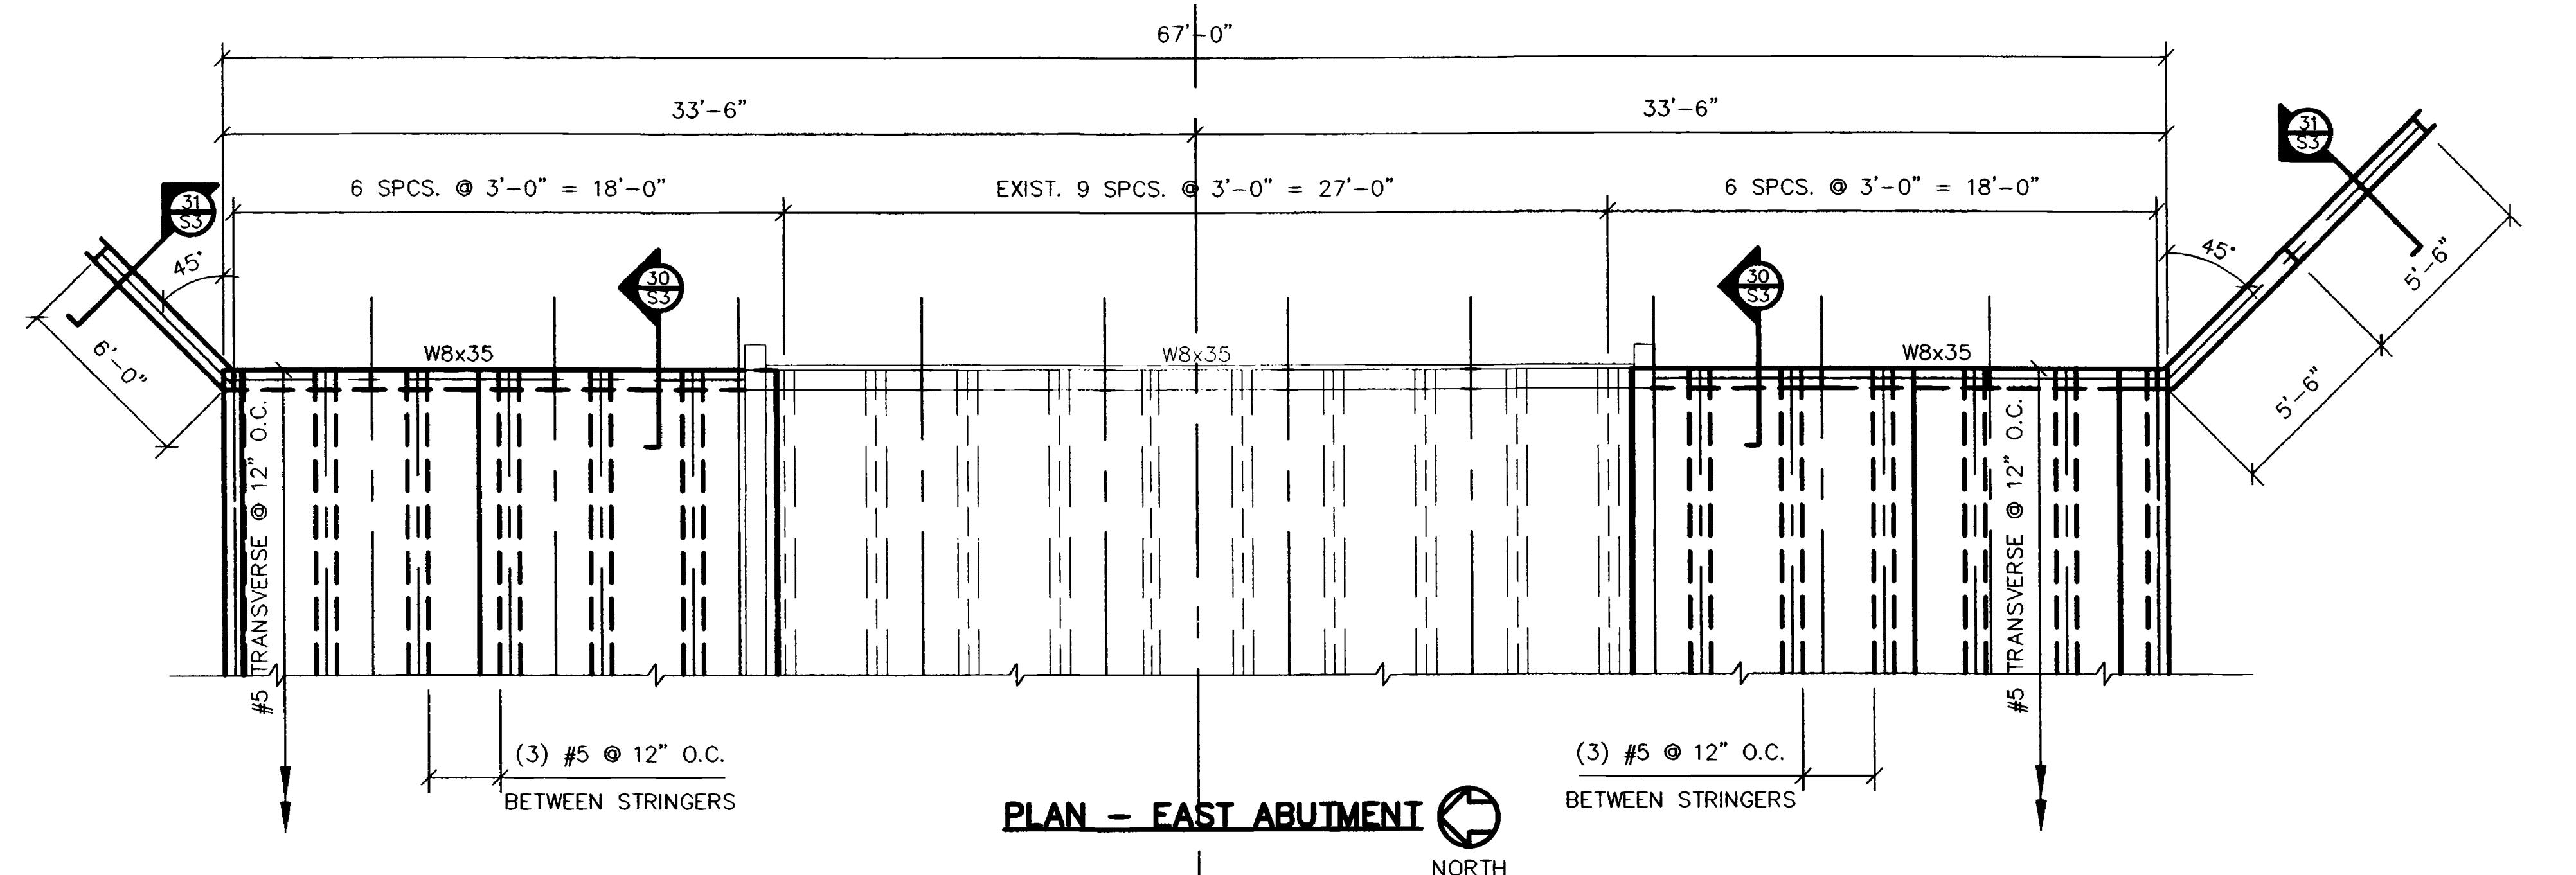

DATE
1/19/99

SCALE
1/4"=1'-0"

PROJECT
3480B

SHEET
53 OF 54


FEDERAL ROAD REGION NO.	DIVISION	PROJ. NO.	SHEET NO.	TOTAL SHEETS
10	COLORADO	STM-9805-010	54	54

AS CONSTRUCTED		
NO REVISIONS	REVISED	VOID
REVISIONS		
DRAWN BY		


DESIGNED BY
REVISIONS
DRAWN BY
SURVEY DATE

REVISIONS
BY
REMARKS



25.5 ROAD BRIDGE OVER GRAND VALLEY CANAL
CITY OF GRAND JUNCTION, COLORADO
CIVL ENGINEERING • PHOTOGRAFETY • SURVEYING
781 Horizon Court • Grand Junction, Colorado 81508 • Phone: 970-246-7101

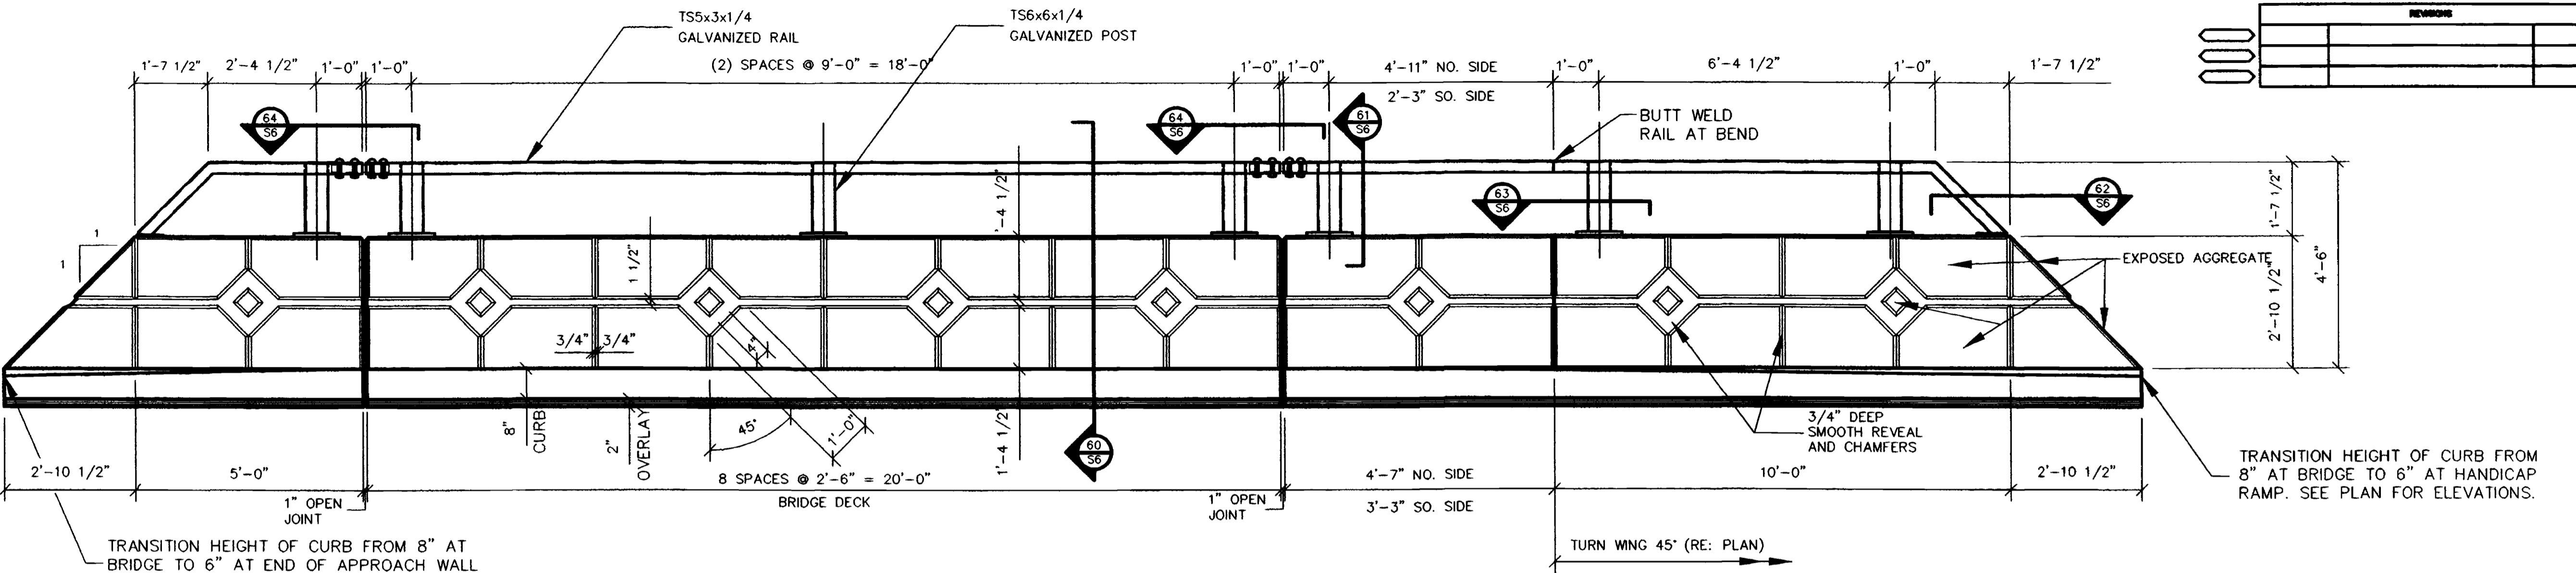


CONCRETE FOR RAIL SHALL BE CLASS "D" WITH COLOR AS INDICATED ON THIS SHEET. SIDEWALK WILL BE PAID AT THE UNIT PRICE FOR CONCRETE SIDEWALK (SPECIAL) WHICH SHALL BE OF VARYING THICKNESS BUT NOMINALLY 10 INCHES THICK. ALL BRIDGE RAIL WORK ABOVE THE SIDEWALK WILL BE CONSIDERED AND PAID FOR AS BRIDGE RAIL (SPECIAL) WHICH WILL INCLUDE ALL ITEMS INCLUDING CONCRETE, REINFORCING AND STRUCTURAL STEEL.

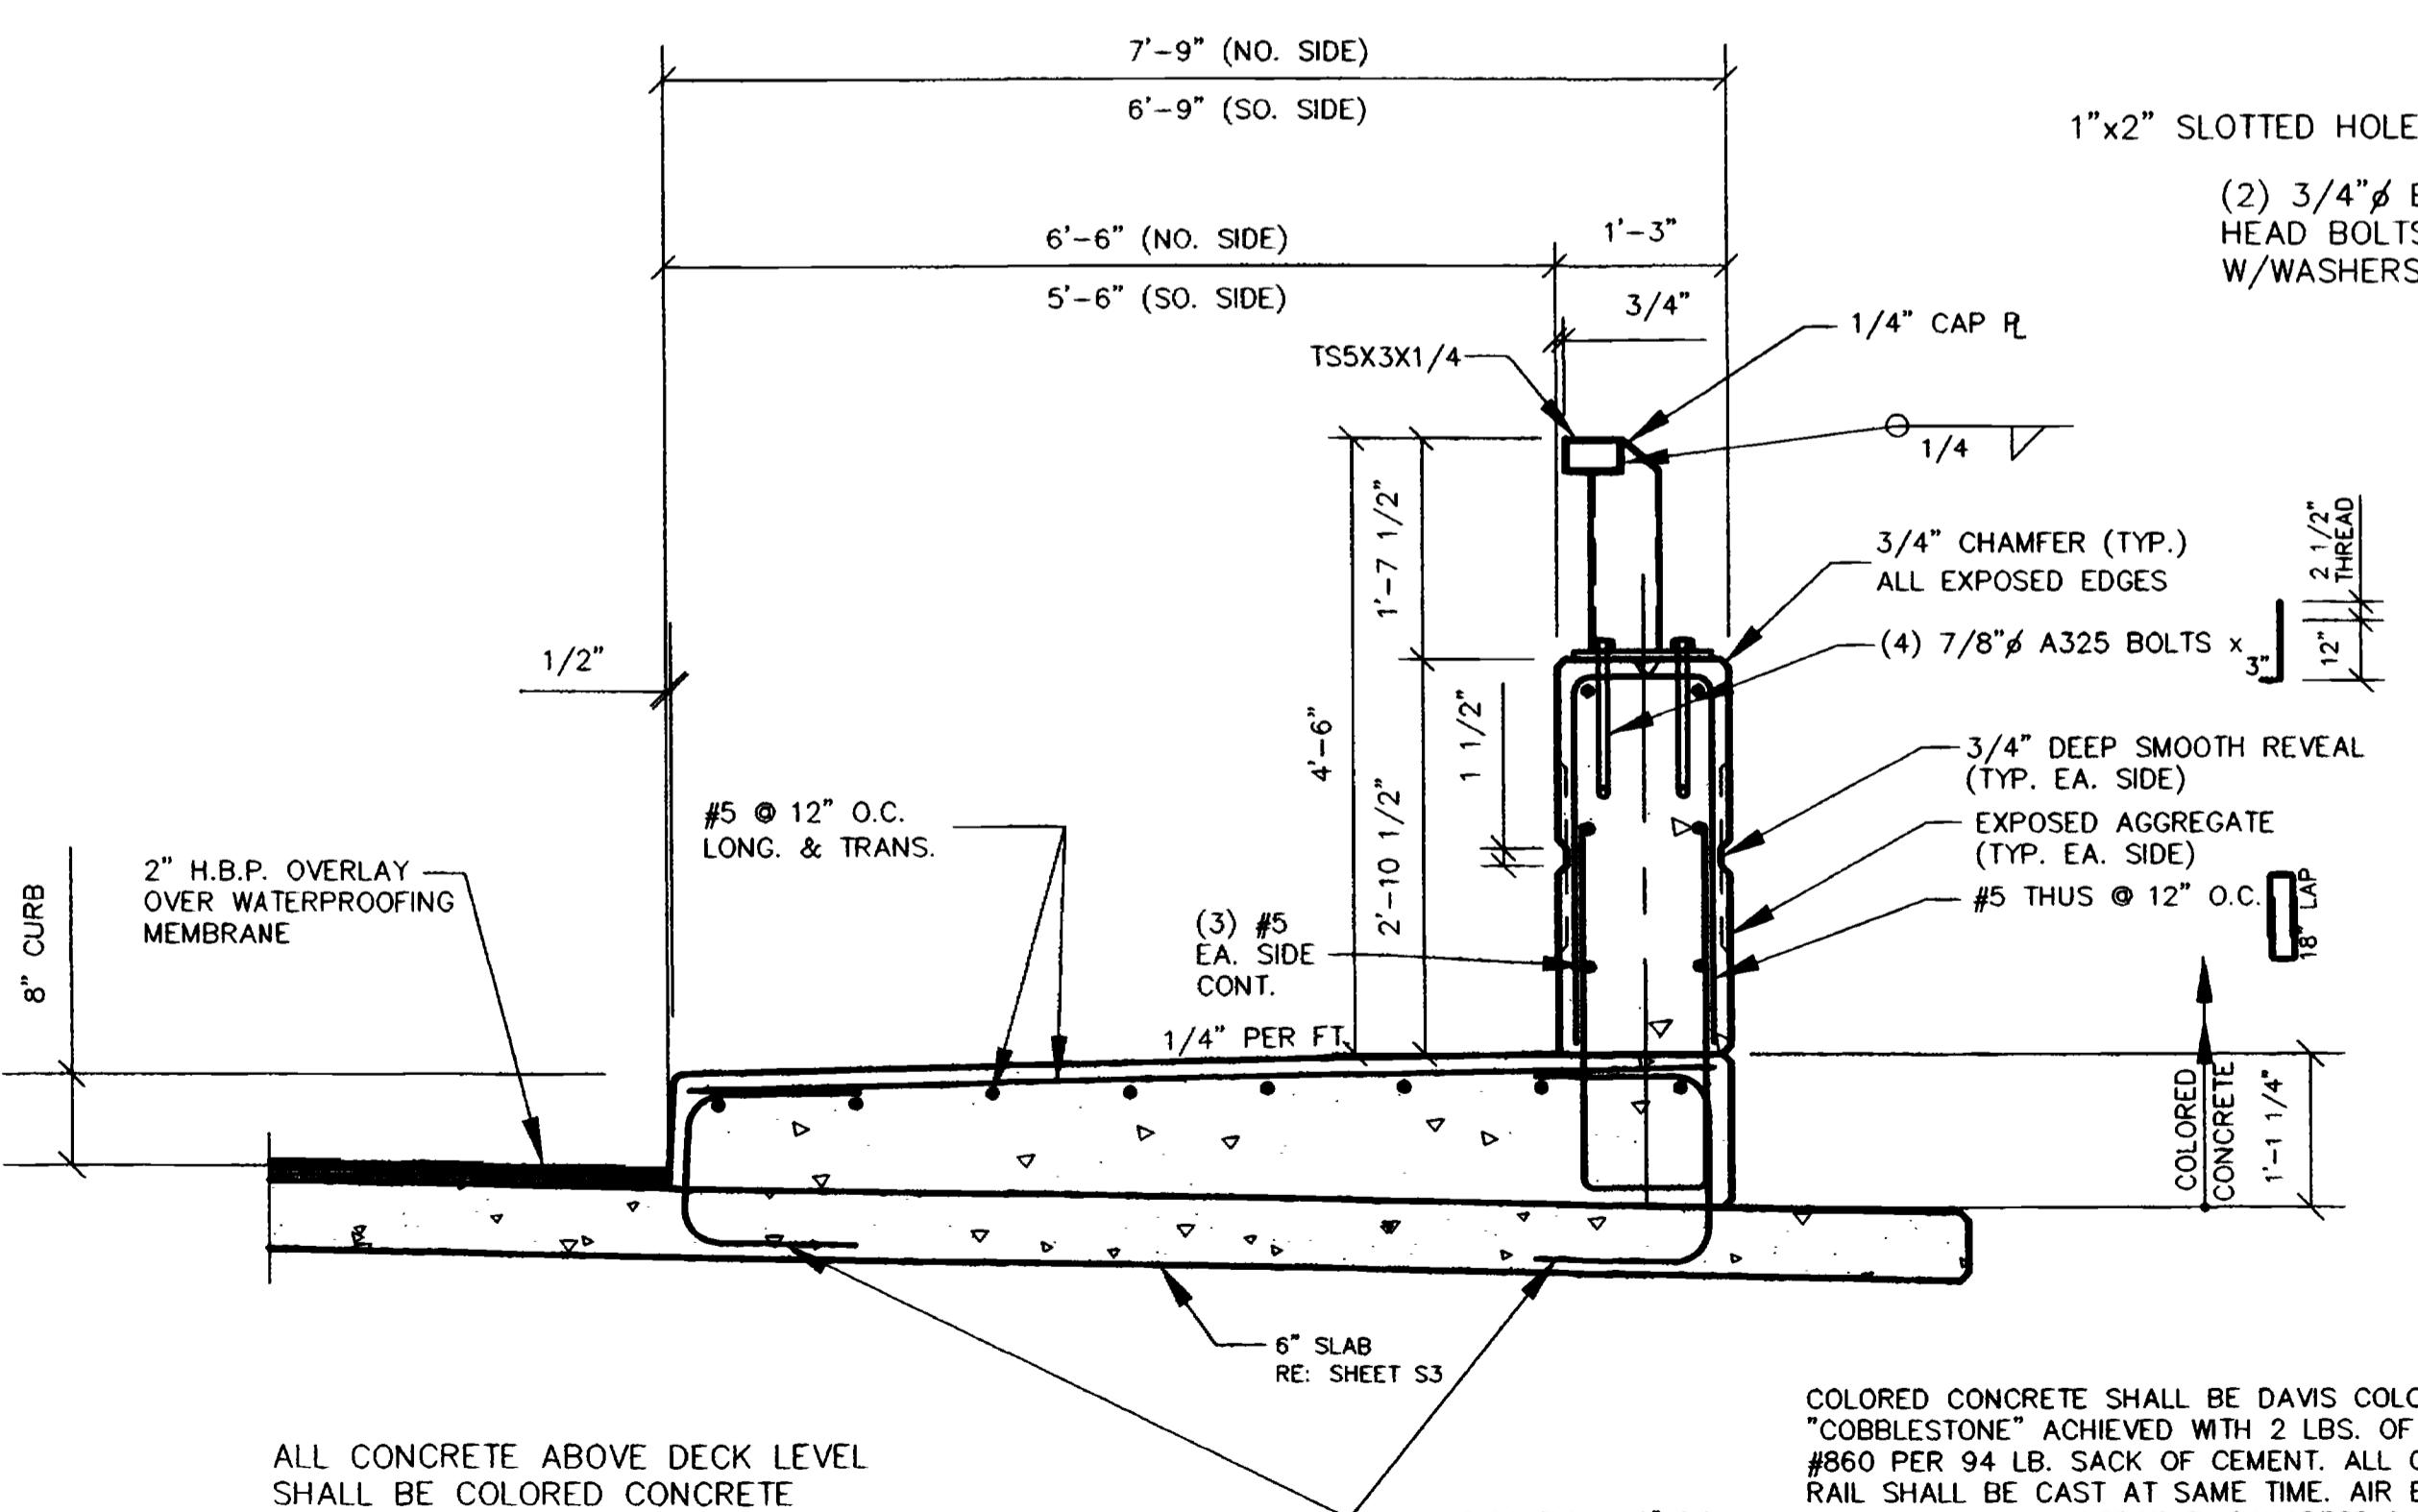


DETAIL A 1/2"=1'-0"

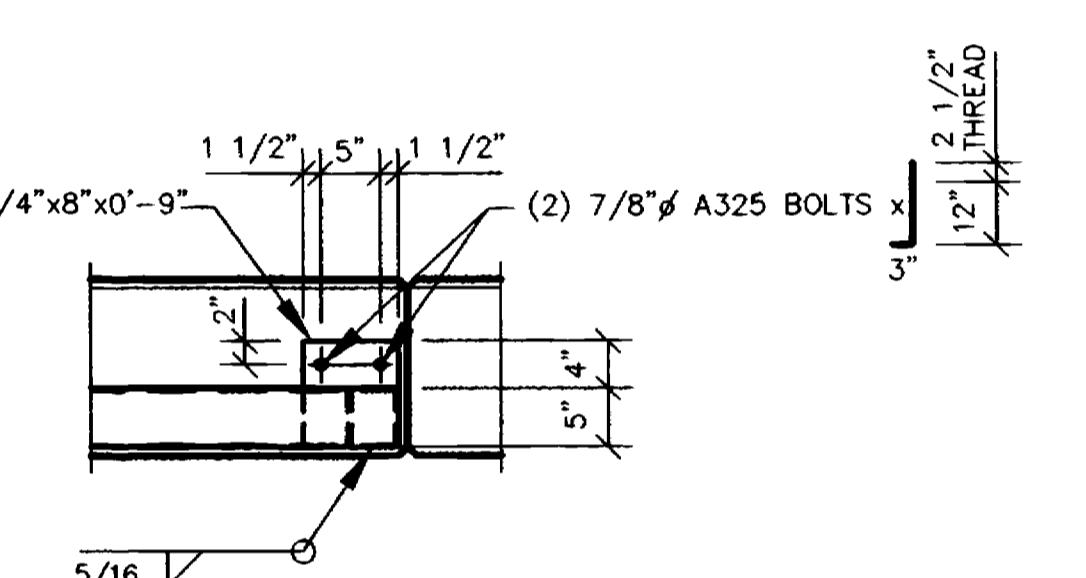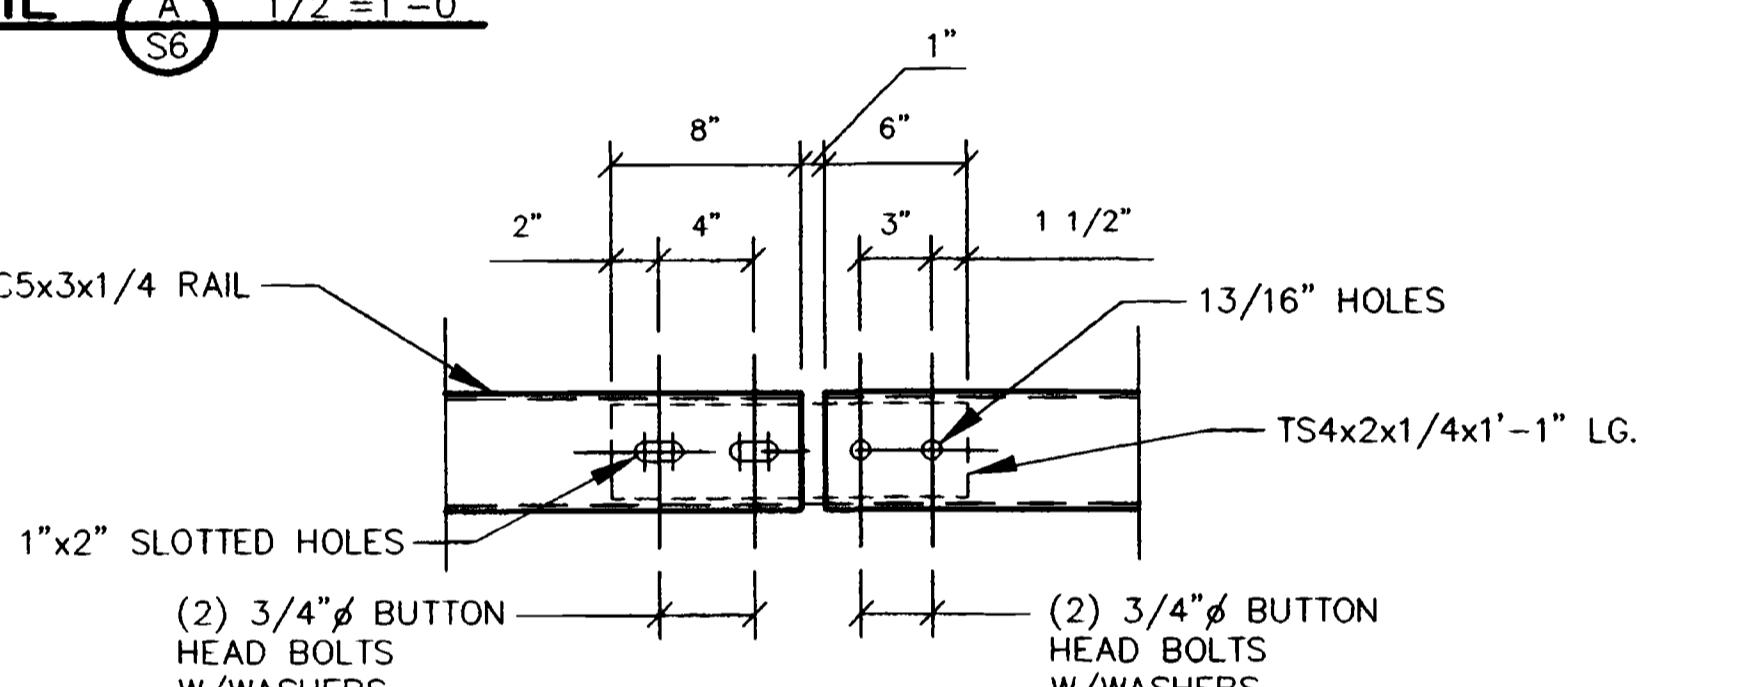

DETAIL 64 3/4"=1'-0"

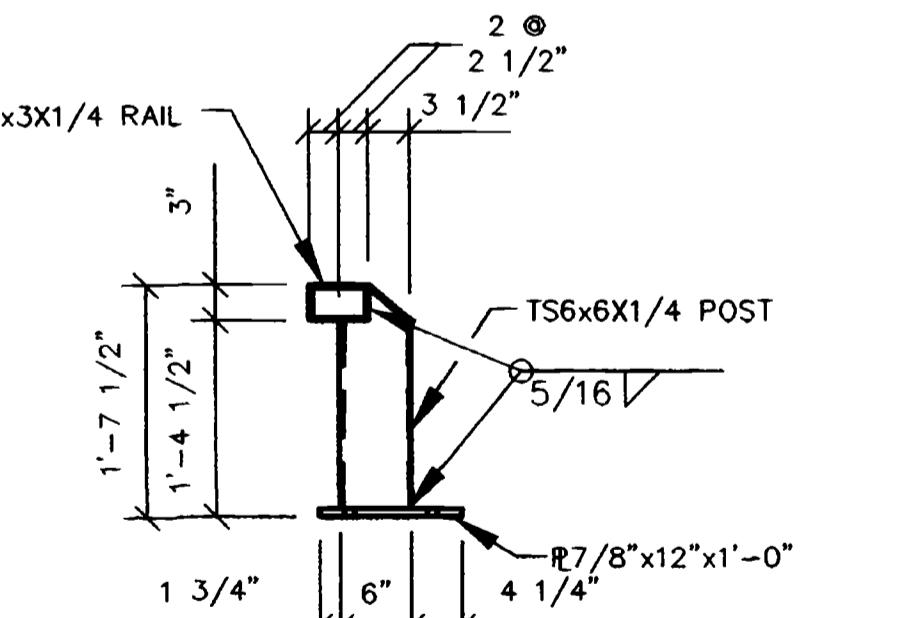

SECTION 61 3/4"=1'-0"

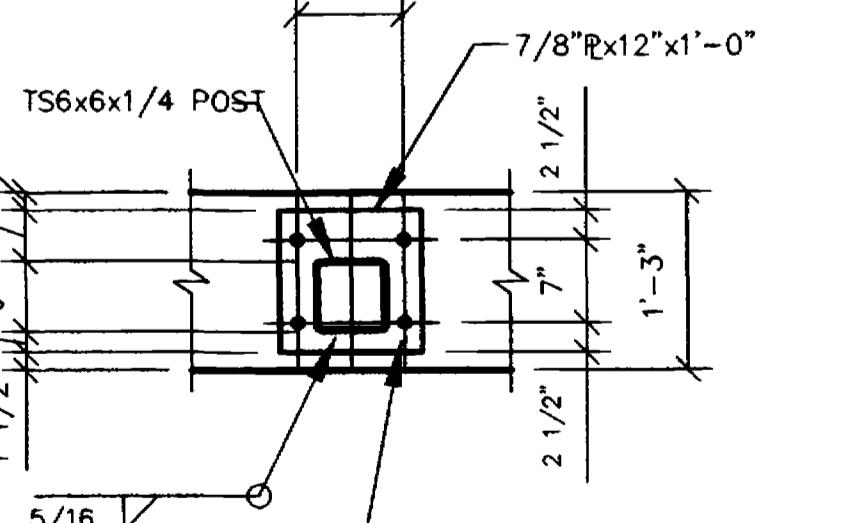

SECTION 63 3/4"=1'-0"

1. ALL TUBES SHALL BE FABRICATED FROM ASTM A-500, GRADE B.
2. ALL OTHER MATERIAL SHALL BE ASTM A-36 EXCEPT BOLTS WHICH SHALL BE ASTM A-325 WITH SUITABLE WASHERS AND NUTS.
3. ALL MATERIALS SHALL BE HOT-DIPPED GALVANIZED AFTER FABRICATION.
4. ALL MATERIALS, INCLUDING STEEL, BOLTS, CONCRETE AND REINFORCING STEEL SHALL BE INCLUDED IN THE COST OF ITEM 606 - BRIDGE RAIL.
5. ALL CONNECTIONS SHALL BE WELDED UNLESS OTHERWISE INDICATED

SECTION 60 3/4"=1'-0"