


ELECTRICAL CONNECTIONS

| EQUIP | LOCATION | WIRE SIZE | VOLTAGE | CIRCUIT NO. | BREAKER SETTING |
|-------|----------|-----------|----------|-------------|-----------------|
| P-2 | ROOM 122 | NO. 12 | 120/1/00 | 81 | 25 AMP |
| P-3 | ROOM 200 | NO. 12 | 120/1/00 | 71 | 20 AMP (SPARE) |
| P-4 | ROOM 122 | NO. 12 | 120/1/00 | 82 | 25 AMP |

NOTE: PROVIDE GROUND WIRE FROM SOLAR PANELS & FRAMES

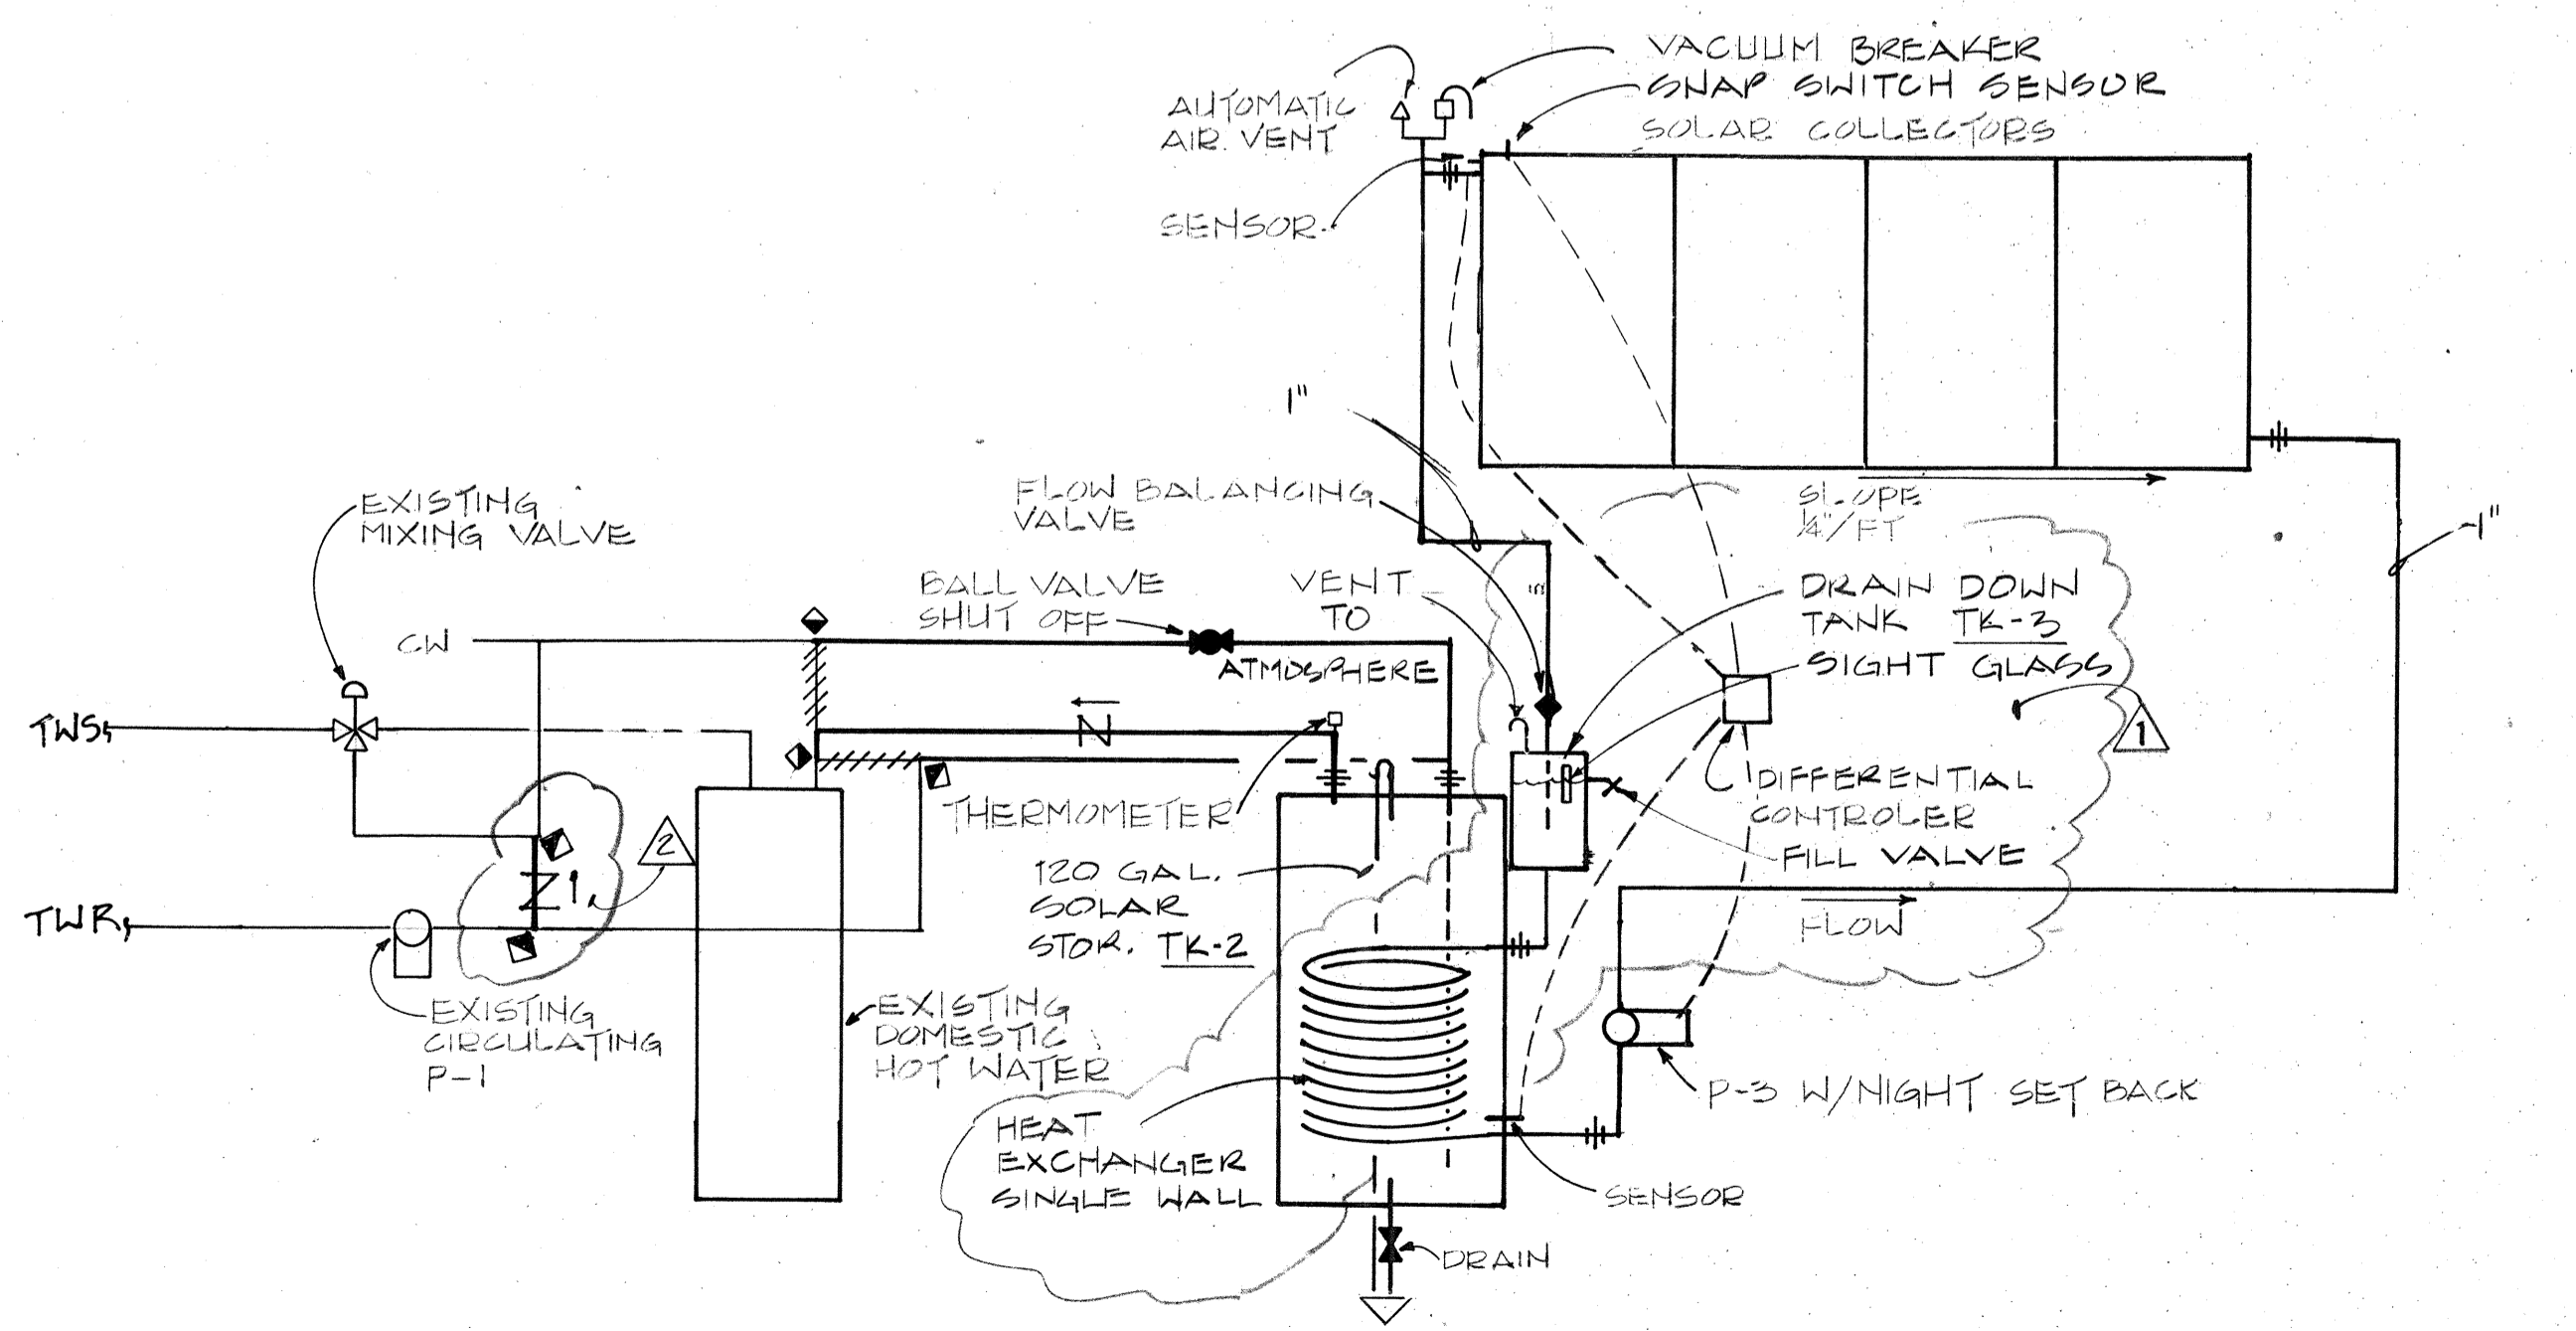

DOMESTIC HOT WATER SOLAR SYSTEM SCHEMATIC
NO SCALE

POOL SOLAR HEATING SYSTEM SCHEMATIC
NO SCALE
APPENDUM # 1 10-22-82
APPENDUM # 2 10-27-82

ADDITION TO PROJECT

| | | | |
|--|---|--|---|
| ARIX Engineers Architects Planners Greeley, Colorado Grand Junction, Colorado Riverton, Wyoming | A Professional Corporation THIS DRAWING IS THE PROPERTY OF ARIX, AND IS NOT TO BE REPRODUCED, MODIFIED OR USED FOR ANY OTHER PROJECT OR EXTENSION OF THIS PROJECT EXCEPT BY AGREEMENT WITH SAID COMPANY. | SCALE: AS SHOWN DRAWN: FWD CHECKED: DTL APPROVED: MLM DATE: OCT 1982 PROJECT NO: 82139.01 | CITY OF GRAND JUNCTION MESA COUNTY ORCHARD MESA POOL GRAND JUNCTION, COLORADO. SOLAR HEATING SYSTEMS M-7 |
|--|---|--|---|