



**Purchasing Division**

**ADDENDUM NO. 6**

**DATE:** August 5, 2022  
**FROM:** City of Grand Junction Purchasing Division  
**TO:** All Offerors  
**RE:** IFB-5096-22-DD Odor Control Improvement Projects

Offerors responding to the above referenced solicitation are hereby instructed that the requirements have been clarified, modified, superseded, and supplemented as to this date as hereinafter described.

Please make note of the following clarifications: (Following Mandatory Pre-Bid Meeting)

1. Q. Will we need to provide our own Bid Bond form?  
A. Bid Bond form will be the contractor's responsibility. Most Bond Surety Companies have a form and that is acceptable.
2. Q. In the Invitation to Bid, Pages 25-26 (3.6 **Contractor Bid Documents**: For Contractor's convenience, the following is a list of forms/items to be submitted with the Contractor's bid response. However, should a form/item not be listed in this section, but required in the solicitation documents, it is Contractor's responsibility to ensure all forms/items are submitted).  
-Contractor's Bid Form  
-Price Bid Schedule  
-References  
-Manufacturer's Certificate of Authorizing for Contractor (**Could not locate Form**)  
A. "Manufacturer's Certificate of Authorization for Contractor" Form not required
3. Q. Are there any milestones other than completion?  
A. No
4. Q. Is 180 calendar days deemed as final completion?  
A. Yes, from "Notice to Proceed" scheduled as October 18<sup>th</sup> plus 180 days is final completion. Scheduled final completion is April 13<sup>th</sup>.
5. Q. What if required equipment/material purchases results in delays and the 180 days is overrun?  
A. Submit all information estimated timelines for material and equipment procurement with a schedule and plan to complete the work as close to 180 days or less if possible. If not possible in 180 calendar days, then as fast as possible with hard dates for estimated procurement of equipment and materials installed and operational.
6. Q. How are the Addendums acknowledged on the Contractor's Bid Form?

- A. Wrote on the Bid Schedule that “Addendums 1 through 6 (or latest Addendum) are acknowledged under written out total bid. Include more Addendums as needed. Alternatively, a letter written on the Contractor’s letter head stating the acknowledgement with signature and title of signer would be adequate.
7. Q. In the solicitation, it states no equipment to be provided by the city, however, in the drawings it says there is. Which is correct?  
A. Correction, no equipment will be provided by the city.  
Drawing Number 10-C301  
Drawing Sheet #009  
Note “C”  
Contractor will eliminate the installation of the 48” gate replacement at the Headworks building. This work will be completed under the portion of the Persigo WWTP Expansion.  
***See Attached page with strike through.***
8. Q. Are the flowrates and/or measurements available?  
A. This information is being researched and will be addressed in a forthcoming Addendum.
9. Q. Please clarify traffic control operations and times required by CDOT.  
A. CDOT times for lane closures are 9:00 pm through 1:00 pm Monday through Friday unless a variance is approved from CDOT.
10. Q. What will the working hours be? Is weekend or night work authorized?  
A. 7:00 am to 4:00 pm Monday through Friday. Additional hours and dares allowed and anticipated with prior approval and discussion.

The original solicitation for the project noted above is amended as noted.

All other conditions of subject remain the same.

Respectfully,



Dolly Daniels, Senior Buyer  
City of Grand Junction, Colorado



© 2021 GARVER, LLC  
 THIS DOCUMENT, ALONG WITH THE IDEAS AND DESIGNS CONVEYED HEREIN, SHALL BE CONSIDERED INSTRUMENTS OF PROFESSIONAL SERVICE AND ARE PROPERTY OF GARVER, LLC. ANY USE, REPRODUCTION, OR DISTRIBUTION OF THIS DOCUMENT, ALONG WITH THE IDEAS AND DESIGN CONTAINED HEREIN, IS PROHIBITED UNLESS AUTHORIZED IN WRITING BY GARVER, LLC OR EXPLICITLY ALLOWED IN THE GOVERNING PROFESSIONAL SERVICES AGREEMENT FOR THIS WORK.

REGISTRATION NO.  
20171218008



Digitally Signed 08/23/2021

REV.	DATE	DESCRIPTION	BY


CITY OF GRAND JUNCTION  
 GRAND JUNCTION, COLORADO  
**Grand Junction**  
 CITY OF GRAND JUNCTION  
 GRAND JUNCTION  
 ODOR CONTROL IMPROVEMENTS

PERSIGO WWTP  
YARD PIPING PLAN

JOB NO.: 20W23045  
 DATE: AUGUST 2021  
 DESIGNED BY: CDG  
 DRAWN BY: TNP

BAR IS ONE INCH ON ORIGINAL DRAWING  
 IF NOT ONE INCH ON THIS SHEET, ADJUST SCALES ACCORDINGLY.

DRAWING NUMBER  
**10-C301**  
 SHEET NUMBER  
**009**

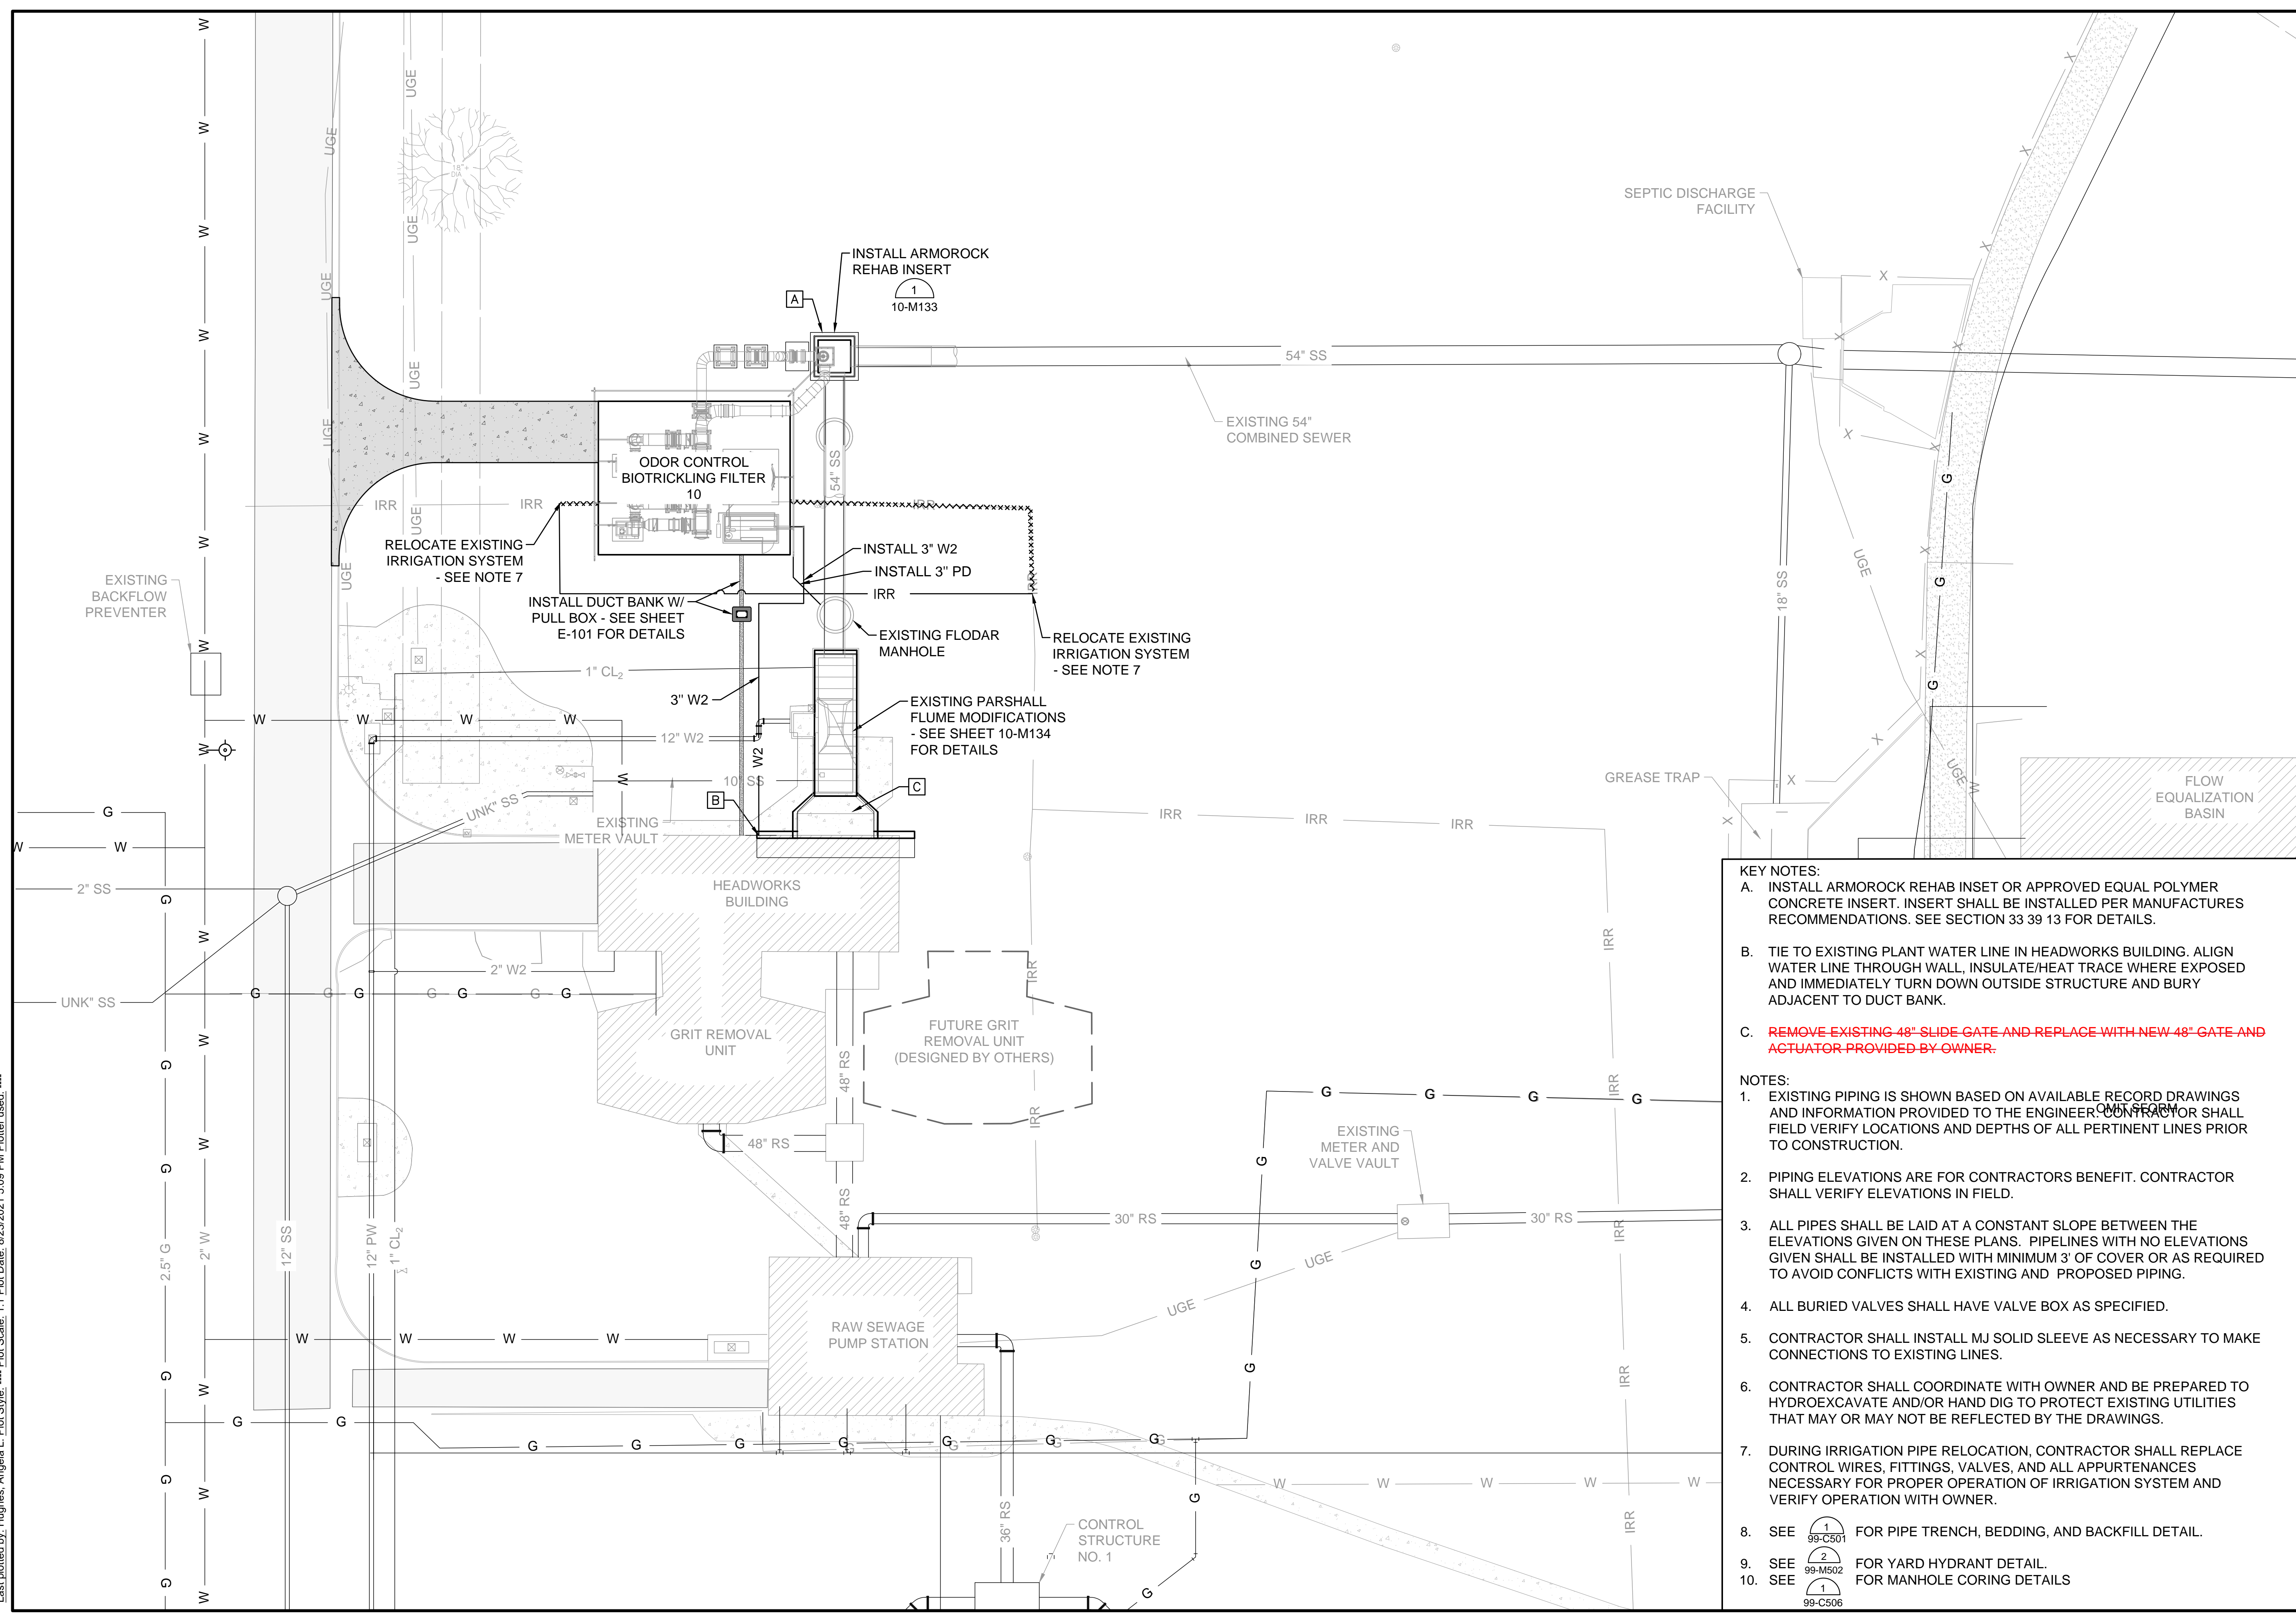

- KEY NOTES:**
- A. INSTALL ARMOROCK REHAB INSET OR APPROVED EQUAL POLYMER CONCRETE INSERT. INSERT SHALL BE INSTALLED PER MANUFACTURERS RECOMMENDATIONS. SEE SECTION 33 39 13 FOR DETAILS.
  - B. TIE TO EXISTING PLANT WATER LINE IN HEADWORKS BUILDING. ALIGN WATER LINE THROUGH WALL. INSULATE/HEAT TRACE WHERE EXPOSED AND IMMEDIATELY TURN DOWN OUTSIDE STRUCTURE AND BURY ADJACENT TO DUCT BANK.
  - C. **REMOVE EXISTING 48" SLIDE GATE AND REPLACE WITH NEW 48" GATE AND ACTUATOR PROVIDED BY OWNER.**
- NOTES:**
1. EXISTING PIPING IS SHOWN BASED ON AVAILABLE RECORD DRAWINGS AND INFORMATION PROVIDED TO THE ENGINEER. CONTRACTOR SHALL FIELD VERIFY LOCATIONS AND DEPTHS OF ALL PERTINENT LINES PRIOR TO CONSTRUCTION.
  2. PIPING ELEVATIONS ARE FOR CONTRACTORS BENEFIT. CONTRACTOR SHALL VERIFY ELEVATIONS IN FIELD.
  3. ALL PIPES SHALL BE LAID AT A CONSTANT SLOPE BETWEEN THE ELEVATIONS GIVEN ON THESE PLANS. PIPELINES WITH NO ELEVATIONS GIVEN SHALL BE INSTALLED WITH MINIMUM 3' OF COVER OR AS REQUIRED TO AVOID CONFLICTS WITH EXISTING AND PROPOSED PIPING.
  4. ALL BURIED VALVES SHALL HAVE VALVE BOX AS SPECIFIED.
  5. CONTRACTOR SHALL INSTALL MJ SOLID SLEEVE AS NECESSARY TO MAKE CONNECTIONS TO EXISTING LINES.
  6. CONTRACTOR SHALL COORDINATE WITH OWNER AND BE PREPARED TO HYDROEXCAVATE AND/OR HAND DIG TO PROTECT EXISTING UTILITIES THAT MAY OR MAY NOT BE REFLECTED BY THE DRAWINGS.
  7. DURING IRRIGATION PIPE RELOCATION, CONTRACTOR SHALL REPLACE CONTROL WIRES, FITTINGS, VALVES, AND ALL APPURTENANCES NECESSARY FOR PROPER OPERATION OF IRRIGATION SYSTEM AND VERIFY OPERATION WITH OWNER.
  8. SEE 1/99-C501 FOR PIPE TRENCH, BEDDING, AND BACKFILL DETAIL.
  9. SEE 2/99-M502 FOR YARD HYDRANT DETAIL.
  10. SEE 1/99-C506 FOR MANHOLE CORING DETAILS.

File: L:\2020\20W23045 - Grand Junction Persigo Biotrickling Des\Drawings\GPBD-10-C301-YD.dwg, Last Save: 8/23/2021 12:20 PM, Last saved by: P.Malik  
 Last plotted by: Hughes, Angela L., Plot Date: 8/23/2021 5:09 PM, Plotter used: ...