


**BASEMENT PLAN**  
SCALE: 1/4" = 1'-0"



**ELECTRICAL PLAN**  
SCALE: 1/4" = 1'-0"

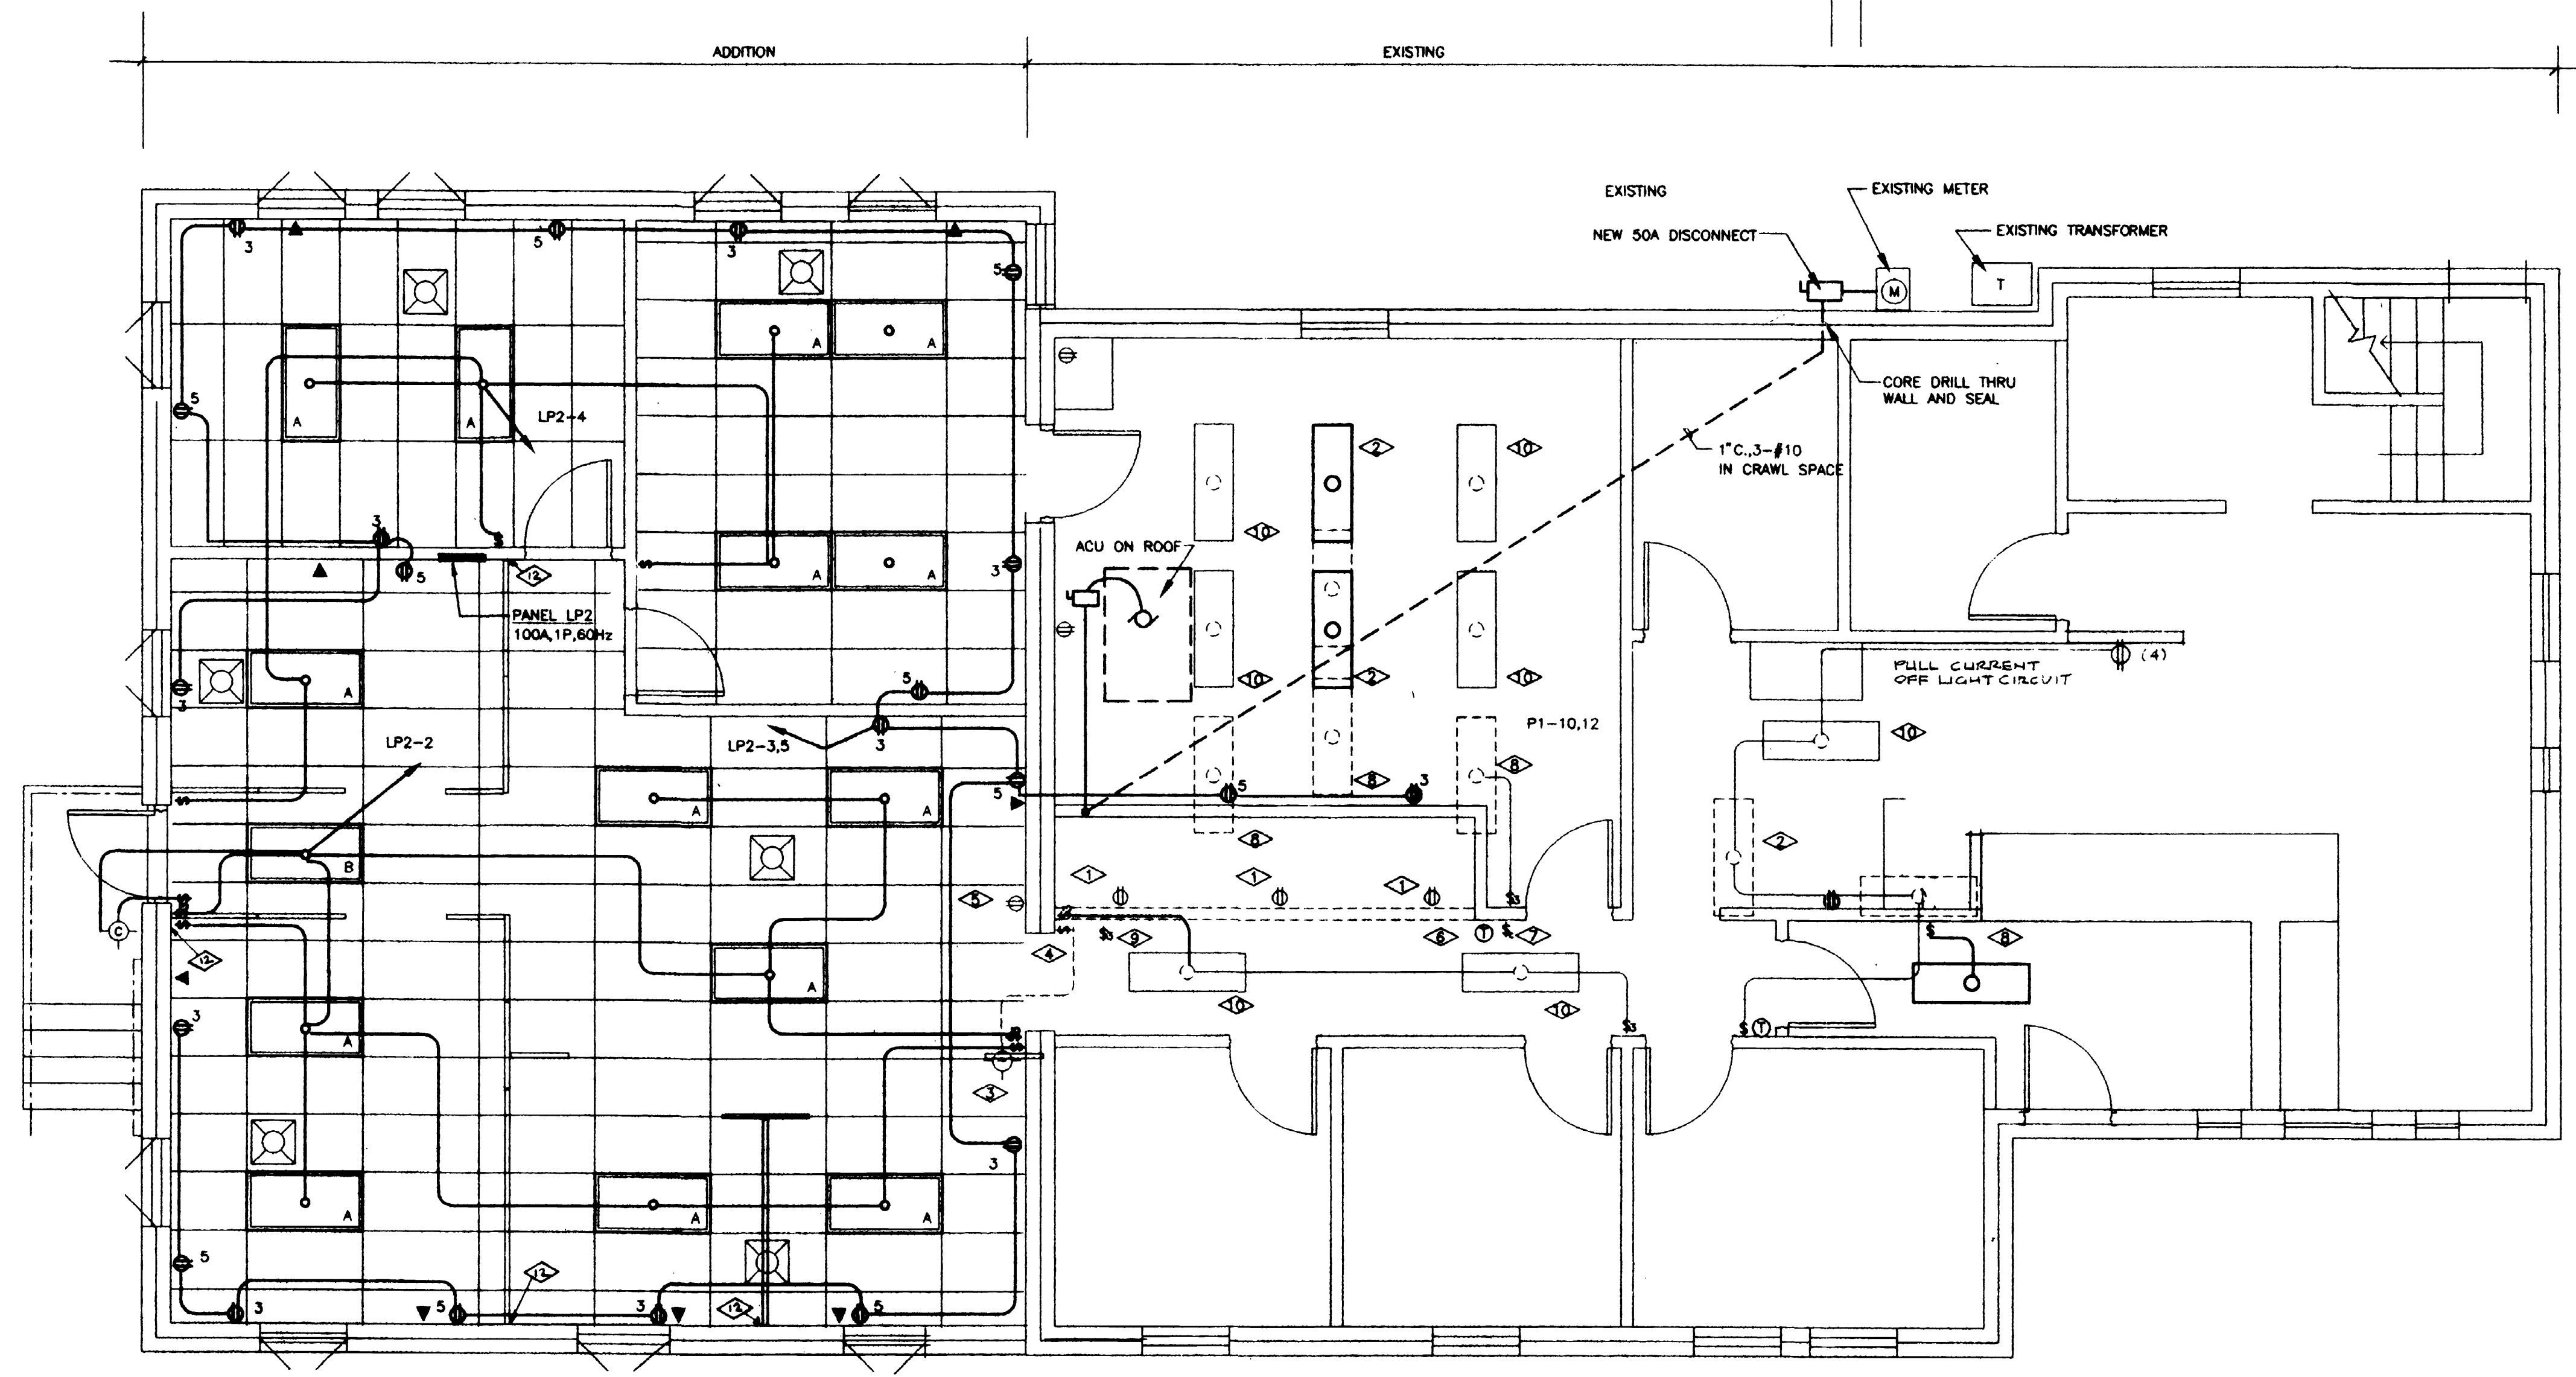

**ELECTRICAL DESIGN NOTES**

- ◇ REMOVE EXISTING RECEPTACLE INCLUDING ALL CONDUIT AND WIRE.
- ◇ REMOVE EXISTING SURFACE MOUNTED FLUORESCENT FIXTURE INCLUDING ALL CONDUIT AND WIRE.
- ◇ REMOVE EXISTING EXTERIOR WALL MOUNTED FIXTURE INCLUDING ALL CONDUIT AND WIRE. RELOCATE TO NEW LOCATION ON ADDITION AND REWIRE AS INDICATED.
- ◇ REMOVE EXISTING SWITCH INCLUDING ALL CONDUIT AND WIRE.
- ◇ REMOVE EXISTING W. P. RECEPTACLE INCLUDING ALL CONDUIT AND WIRE.
- ◇ REMOVE EXISTING THERMOSTAT AND RELOCATE AS REQUIRED.
- ◇ REMOVE EXISTING EVAPORATIVE COOLER CONTROL AND RELOCATE AS REQUIRED.
- ◇ REMOVE EXISTING SURFACE MOUNTED FLUORESCENT FIXTURE AND INCLUDING ALL CONDUIT AND WIRE. RELOCATE TO NEW LOCATION AND REWIRE AS INDICATED.
- ◇ REMOVE EXISTING THREE-WAY SWITCH INCLUDING ALL CONDUIT AND WIRE.
- ◇ EXISTING SURFACE FLUORESCENT FIXTURE TO REMAIN.
- ◇ EXISTING RECEPTACLE TO REMAIN.
- ◇ LOCATE 'J' BOXES @ INTERSECTION OF FREE-STANDING PANELS WITH STUD WALLS. PUT (A) 'J' BOXES ON SEPARATE (SAME) CIRCUIT @ PANEL.

**LEGEND**

- NEW FLUORESCENT LIGHT FIXTURE  
LITHONIA ZGT 4 40 A12 120 ES LPESOW
- NEW FLUORESCENT LIGHT FIXTURE  
LITHONIA ZGT 2 40 A12 120 ES LPESOW
- EXISTING FLUORESCENT LIGHT FIXTURE
- EXISTING FLUORESCENT FIXTURE TO BE REMOVED.
- NEW WALL MOUNTED FIXTURE  
LITHONIA TWL 28DIT 120 NPF
- EXISTING WALL MOUNTED FIXTURE TO BE REMOVED
- EXISTING RECEPTACLE
- NEW RECEPTACLE
- NEW SWITCH
- EXISTING SWITCH
- TELEPHONE OUTLET, 4-S BOX WITH CONDUIT TO BELOW FLOOR
- FUSED DISCONNECT SWITCH

NO.	DATE	REVISIONS

PA/DS  
PROFESSIONAL DESIGN GROUP  
ARCHITECTURE · PLANNING  
917 Main Street  
Grand Junction, Colorado 81501

PROJECT TITLE  
**BUILDING ADDITION  
PARKS AND RECREATION  
1340 GUNNISON AVE., GRAND JUNCTION, CO.**

SHEET TITLE  
**ELECTRICAL PLAN  
BASEMENT PLAN**