



ADDENDUM NO. 1

DATE: June 2, 2023
FROM: City of Grand Junction Purchasing Division
TO: All Offerors
RE: Pomona Parking Lot Landscaping & Irrigation Construction IFB-5260-23-KF

Offerors responding to the above referenced solicitation are hereby instructed the requirements have been clarified, modified, superseded, and supplemented as to this date as hereinafter described.

Please make note of the following clarifications:

1. Firms shall utilize the Addendum 1 version of the Bid Schedule attached for its bid response.
2. Revised drawing "Sheet No. IR-1" with new notes, attached.
3. Existing irrigation drawing for old parking lot is attached to address added line-item no. 3.
4. Provide existing irrigation zone layout, attached.

The original solicitation for the project noted above is amended as noted.

All other conditions of subject remain the same.

Respectfully,

A handwritten signature in blue ink, appearing to read "K. Franklin".

Kathleen Franklin, Senior Buyer
City of Grand Junction, Colorado


Bid Schedule: Grand Junction Fire Department - Pomona Parking Lot Landscaping & Irrigation Construction Addendum 1

Item No.	Division No.	Description	Quantity	Units	Unit Price	Total Price
1	32	Exterior Improvements - Irrigation (including all heads, drip systems, valves, controls, laterals and main lines, and labor to install and connect new irrigation system to existing Pomona Park irrigation system)	1.	LS	\$ _____	\$ _____
2	32	Exterior Improvements - Landscaping (including soil prep, hardscaping, turf, plants and labor to install)	1.	LS	\$ _____	\$ _____
3	32	Exterior Improvements - Existing Irrigation Connection (including all equipment and labor to reconnect existing irrigation zones at existing parking lot landscaping and street landscaping to existing Pomona Park irrigation system)	1.	LS	\$ _____	\$ _____
MCR		MINOR CONTRACT REVISIONS	---	---	---	\$ <u>1,500.00</u>

Bid Amount: \$ _____

Total Bid Amount written:

_____ dollars

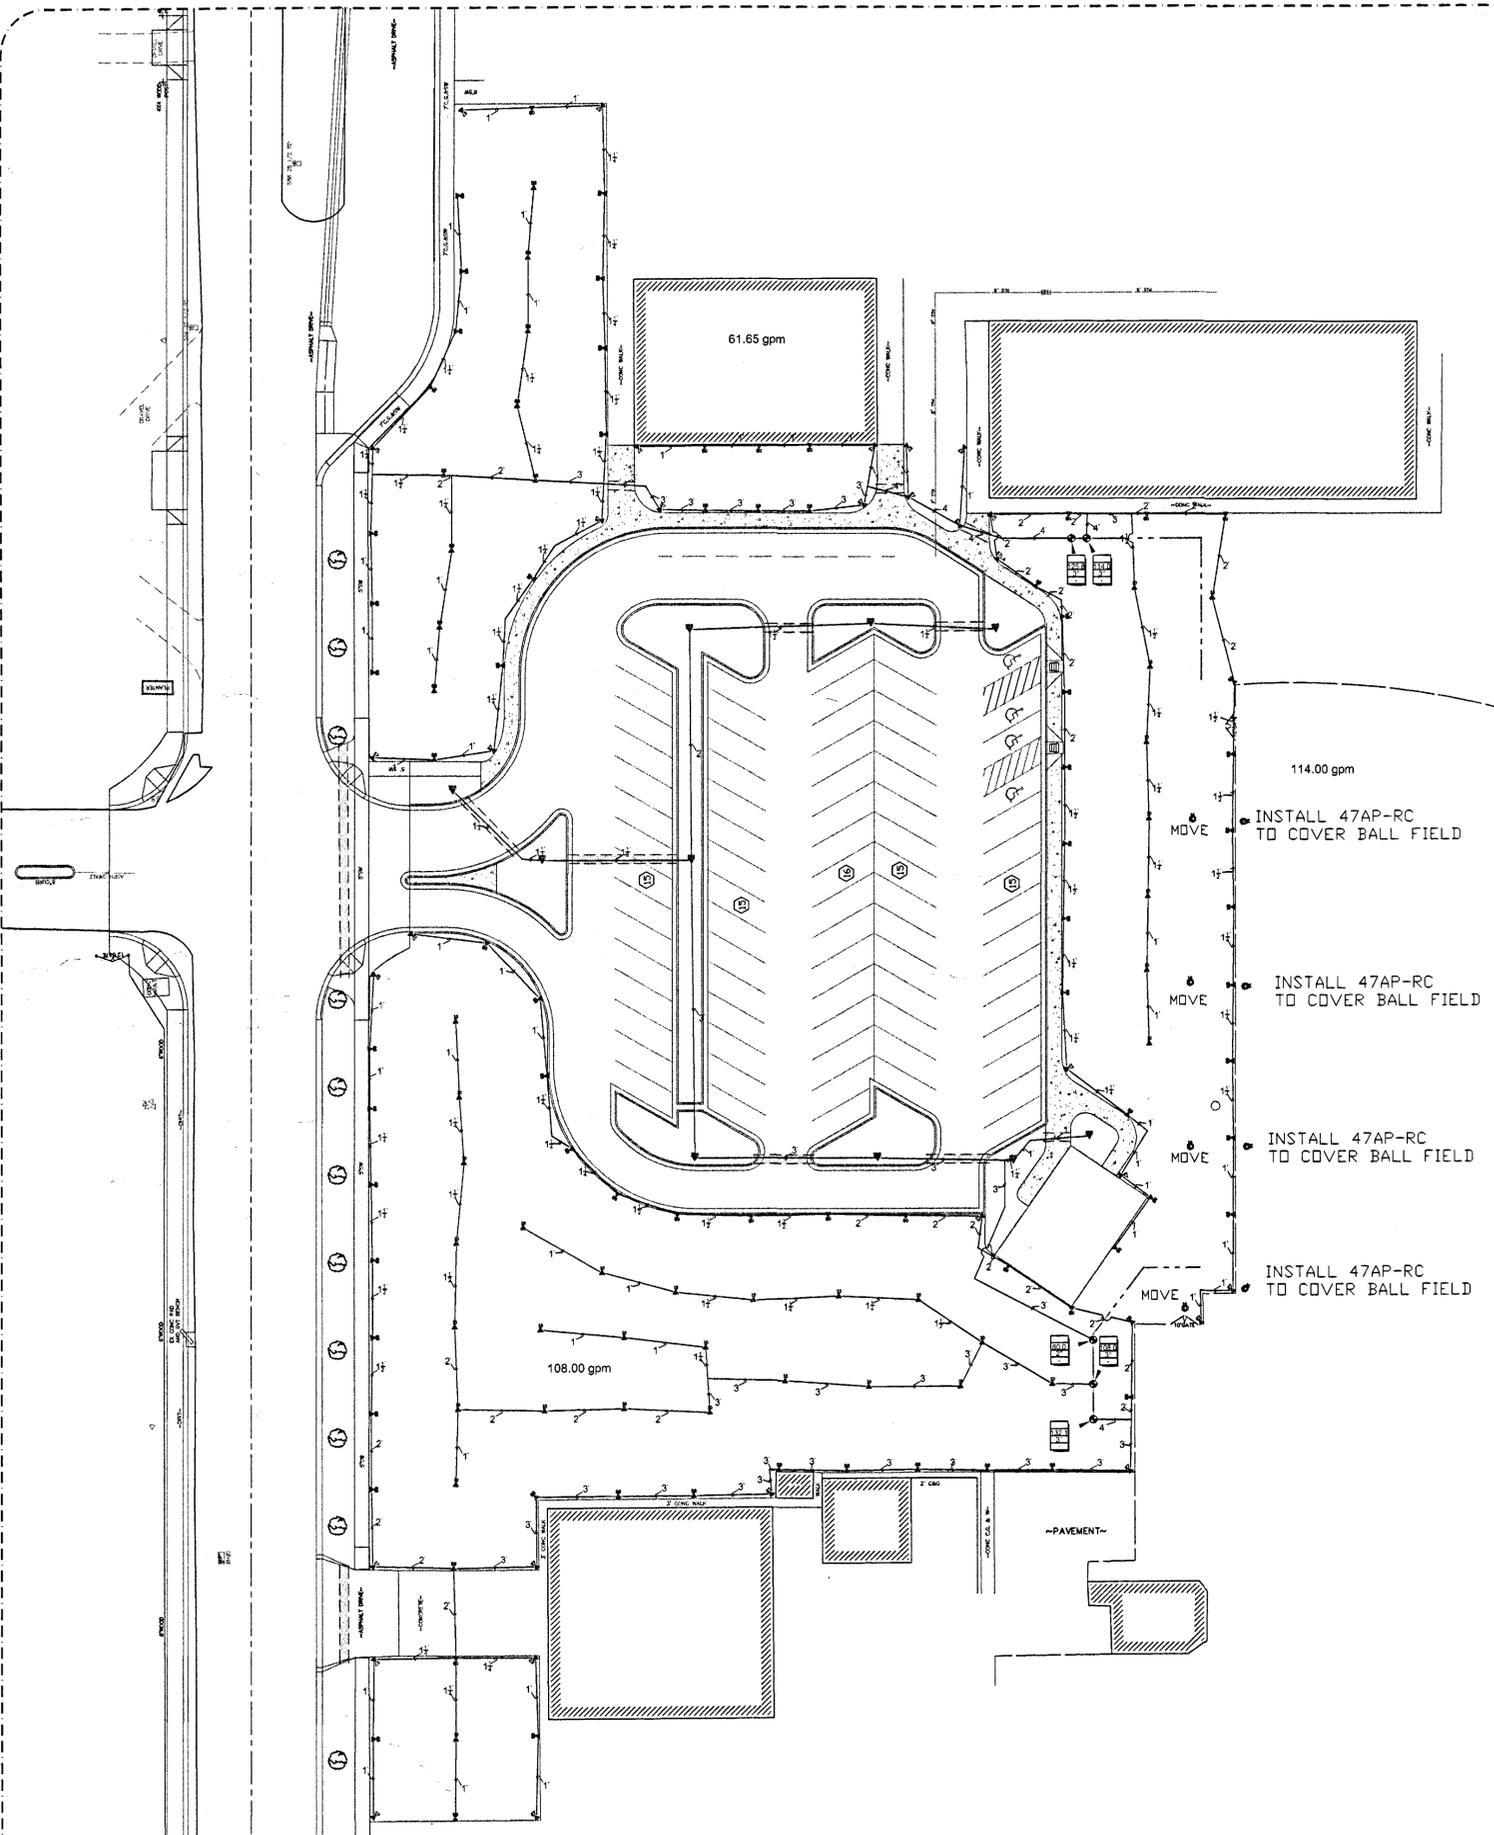


- LEGEND**
- ✕ Rain Bird 2045A MAXI-PAW w/ 07 Nozzle
 - ✕ Rain Bird 2045A MAXI-PAW w/ 08 Nozzle
 - ✕ Rain Bird 2045A MAXI-PAW w/ 10 Nozzle
 - ✕ Rain Bird 2045A MAXI-PAW w/ 07-LA Nozzle
 - ⊙ Rain Bird 47AP-16 Rotor
 - ▽ 1" Riser for Low Volume
 - ⊙ Rain Bird 200-PESB 2" Remote Control Valve
 - ⊙ Rain Bird 300BPES 3" Angle Remote Control Valve
 - 4" CL 200 PVC MAIN LINE
- RUN NEW ZONE WIRES BACK TO CLOCK LOCATION AT THE PUMP
 CHANGE EXISTING FULL CIRCLE HEADS TO PART CIRCLE HEADS IN BALL FIELD

ALL LATERALS TO BE 1" CL200 PVC EXCEPT WHERE NOTED


NOTE:
 This drawing is provided for recommendation only. It is for the aid & service of our customers & is not to be construed as a PROFESSIONAL ENGINEERED DESIGN. This Design is done per customers request, and information is supplied to GJ Pipe by the Customer. Any changes will effect the design of this system. DUE TO NON INSPECTION OF SITE LOCATION AND CONSTRUCTION PROCEDURES, GJ PIPE IS NOT RESPONSIBLE FOR DAMAGE THAT CAN BE DONE TO EXISTING TREES AND SHRUBS DURING TRENCHING AND INSTALLATION OF SPRINKLER SYSTEM.

**Pomona Parking
 Lot Irrigation
 GRAND JUNCTION**

**Grand Junction
 Pipe & Supply**
 West Branch
 756 Valley Ct.
 Grand Jct, CO 81505
 (970) 254-2870
 Main Branch
 2868 I-70 Bus. Loop
 Grand Jct, CO 81501
 (970) 243-4604

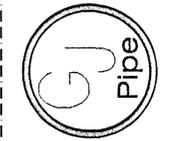

Drawn By:	M.A.V.
Designed By:	M.A.V.
Design Date:	7-15-04
Revision Date:	
Scale:	1"=30'-0"
Drawing Number:	40000
Page:	1 of 1

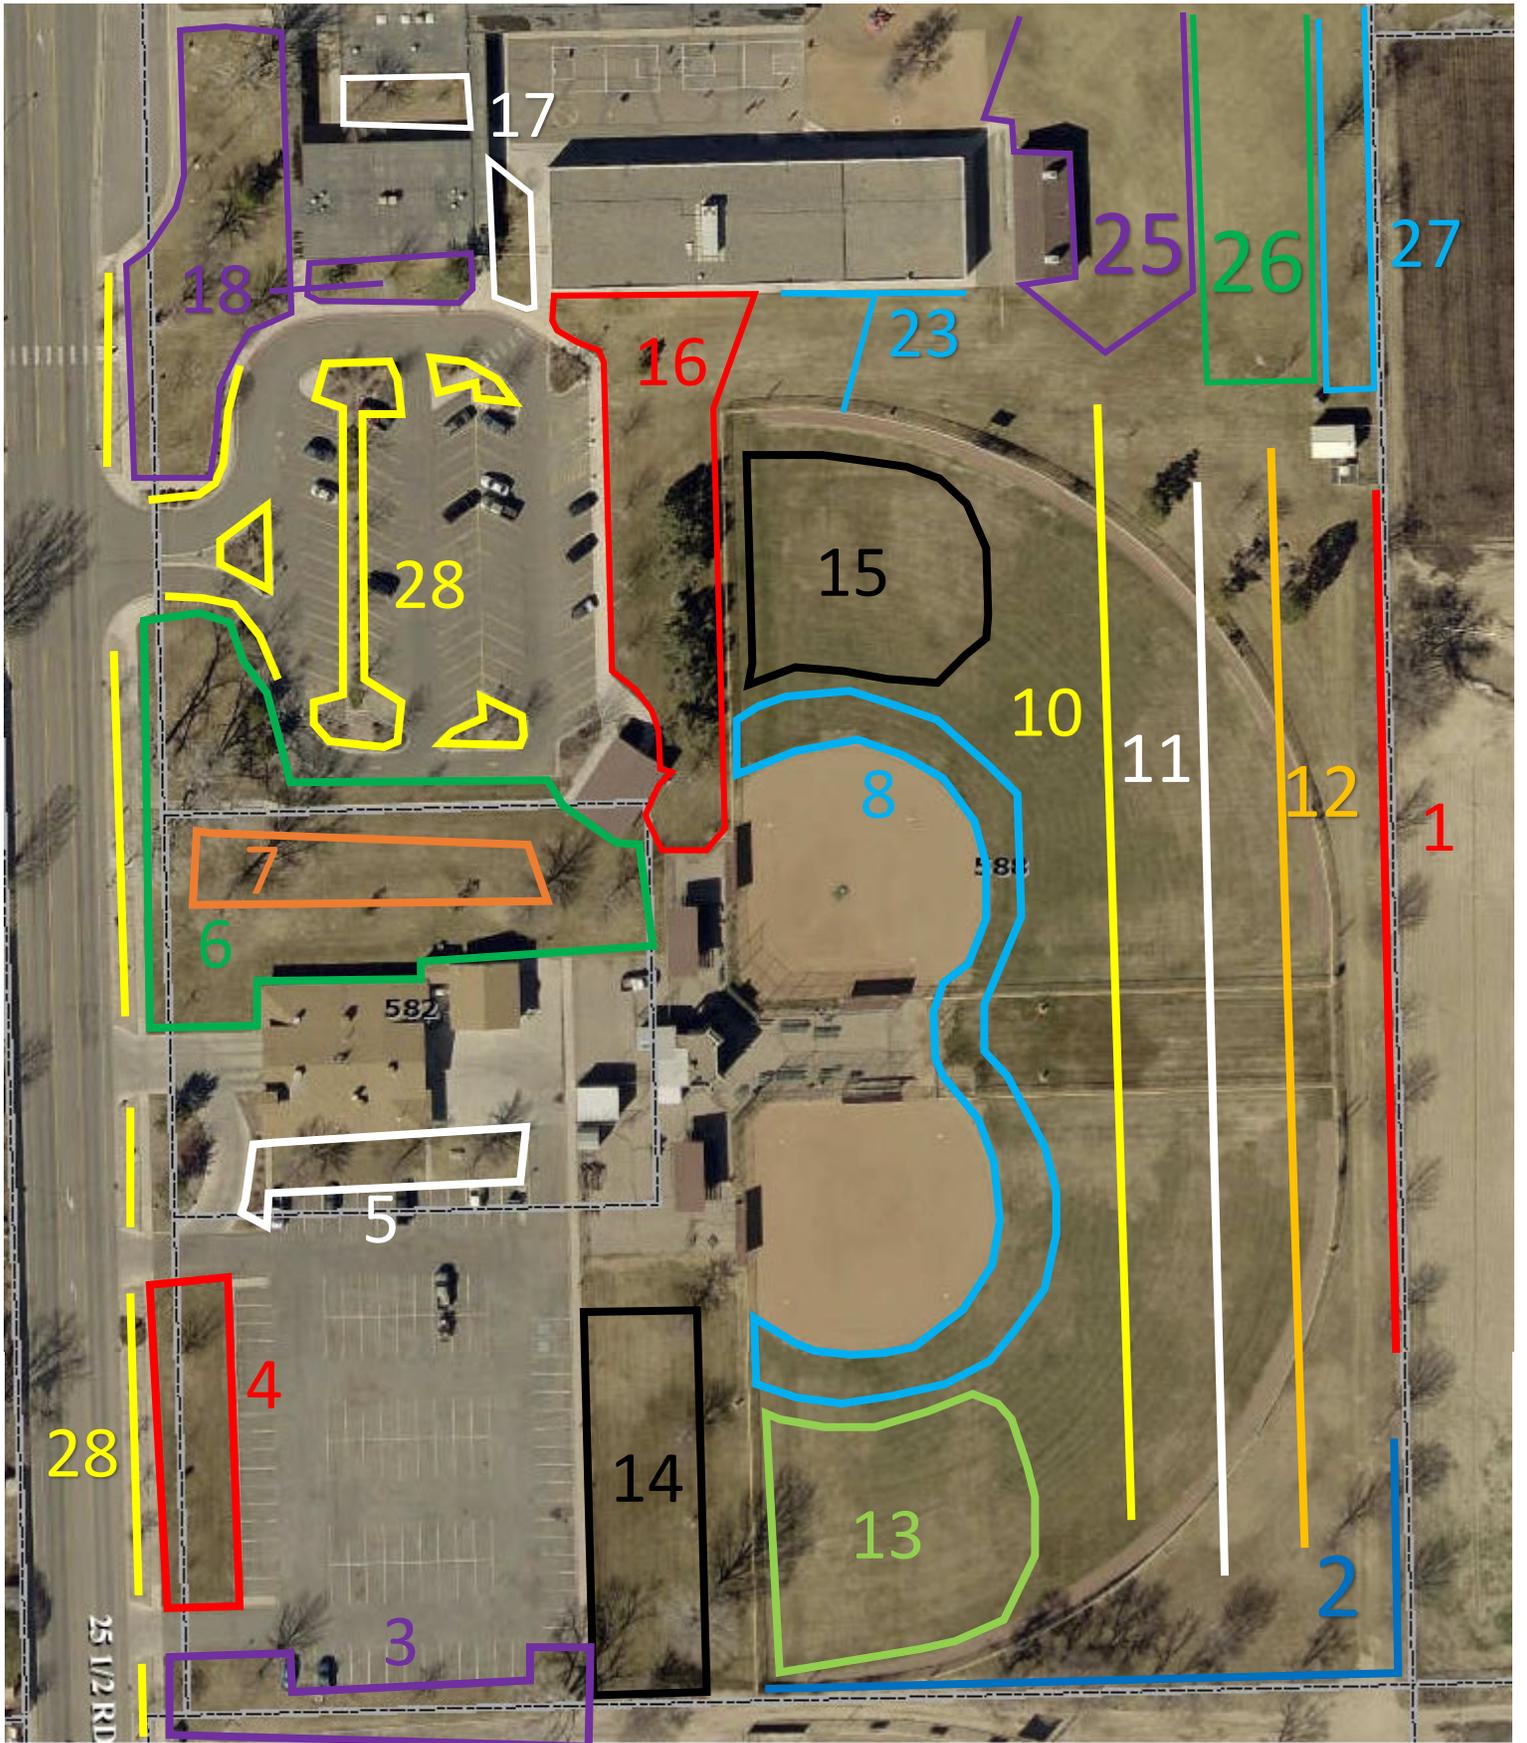

*Bad hole in clock number 9

