


ELYTHE

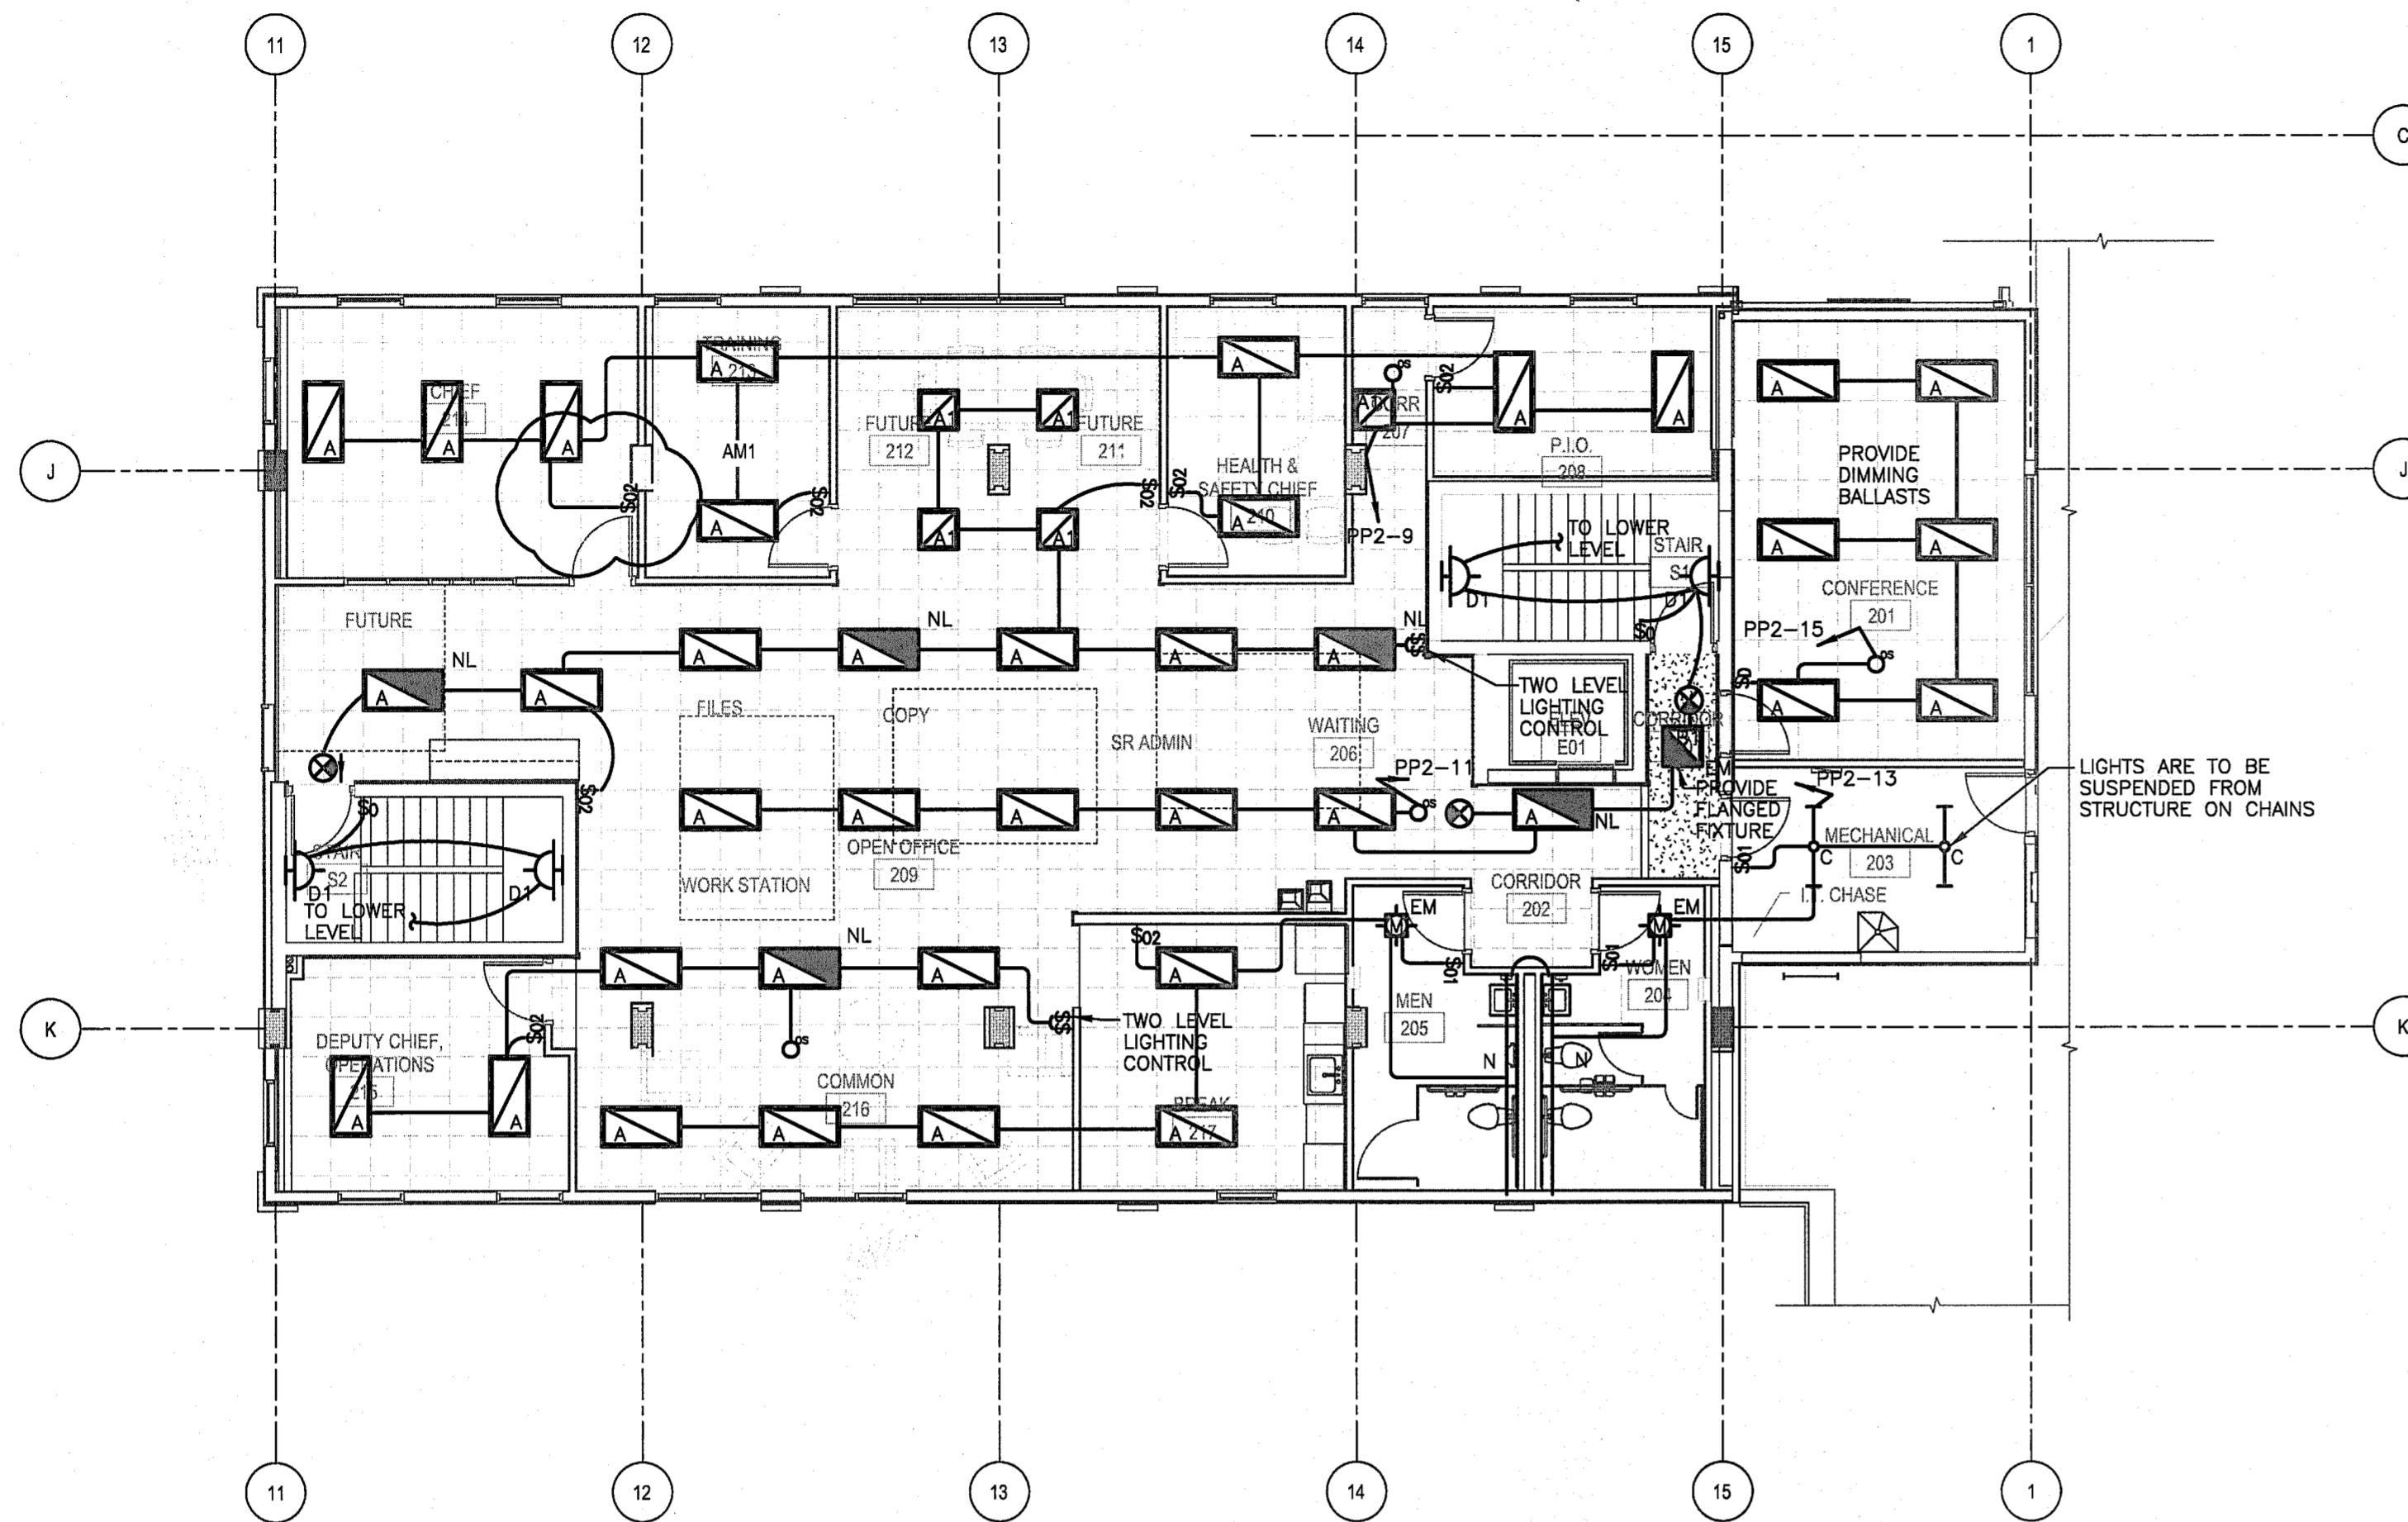

LIGHTING SECOND FLOOR PLAN


SCALE: 1/8"=1'-0"

NORTH

TYPE	MANUFACTURER CATALOG NO.	MANUFACTURER CATALOG NO.	VOLTAGE	MOUNTING # OF LAMPS	BALLAST LAMP TYPE	CAT. #	DESCRIPTION	
							INDIRECT	INDIRECT
A	LITHONIA 2AVG 332 SBL MVOLT GEB10IS	APPROVED EQUIVALENT	120	RECESS GRID 3	ELECTRONIC FLOURESCENT	F32T8SPX41ECHO	2' X 4' RECESSED DIRECT/INDIRECT FIXTURE WITH STRAIGHT BLADE LOUVER AND ROUND HOLES (2) ELECTRONIC BALLASTS AND 4100K LAMPS	
A1	LITHONIA AVG 317 SBL MVOLT GEB10IS	APPROVED EQUIVALENT	120	RECESS GRID 3	ELECTRONIC (2 EA)	F17T8SPX41ECHO	2' X 2' RECESSED DIRECT/INDIRECT FIXTURE WITH STRAIGHT BLADE LOUVER AND ROUND HOLES (2) ELECTRONIC BALLASTS AND 4100K LAMPS	
A2	LITHONIA 2AVG 332 SBL MVOLT GEB10IS	APPROVED EQUIVALENT	120	RECESS CEILING	ELECTRONIC (2 EA)	F32T8SPX41ECHO	2' X 4' RECESSED CEILING DIRECT/INDIRECT FIXTURE WITH STRAIGHT BLADE LOUVER AND ROUND HOLES (2) ELECTRONIC BALLASTS AND 4100K LAMPS	
B	LITHONIA 2SPG 232 A12125 MVOLT GEB10IS	APPROVED EQUIVALENT	120	RECESS GRID	ELECTRONIC	F32T8SPX41ECHO	2' X 4' RECESSED GRID TROFFER WITH .125" ACRYLIC LENS ELECTRONIC BALLAST AND 4100K LAMPS	
B1	LITHONIA 2SPG 217 A12125 MVOLT GEB10IS	APPROVED EQUIVALENT	120	RECESS GRID	ELECTRONIC	F17T8SPX41ECHO	2' X 2' RECESSED GRID TROFFER WITH .125" ACRYLIC LENS ELECTRONIC BALLAST AND 4100K LAMPS	
B2	LITHONIA 2SPG 332 A12125 MVOLT GEB10IS	APPROVED EQUIVALENT	120	RECESS GRID 3	ELECTRONIC FLOURESCENT	F32T8SPX41ECHO	2' X 4' RECESSED GRID TROFFER WITH .125" ACRYLIC LENS ELECTRONIC BALLAST AND 4100K LAMPS	
B3	LITHONIA 2SPG 232 A12125 MVOLT GEB10IS	APPROVED EQUIVALENT	120	RECESS GRID 2	ELECTRONIC FLOURESCENT	F32T8SPX41ECHO	1' X 4' RECESSED GRID TROFFER WITH .125" ACRYLIC LENS ELECTRONIC BALLAST AND 4100K LAMPS	
C	LITHONIA EJS 232 MVOLT GEB10IS	APPROVED EQUIVALENT	120	SURFACE	ELECTRONIC	F32T8SPX41ECHO	4 1/4" W X 4 1/4" D X 48" STRIP LIGHT SOLENOID SELECTOR HIGH GLOSS WHITE FINISH ELECTRONIC BALLAST AND 4100K LAMPS	
D	LITHONIA WP 225 120 GEB10IS	APPROVED EQUIVALENT	120	WALL SURFACE	ELECTRONIC FLOURESCENT	F25T8SPX41ECHO	7 3/8" W X 3 1/4" D X 36 7/16" L WALL MOUNTED DIRECT/INDIRECT FIXTURE ELECTRONIC BALLAST AND 4100K LAMPS	
D1	LITHONIA WP 225 120 GEB10IS EL	APPROVED EQUIVALENT	120	WALL SURFACE	ELECTRONIC FLOURESCENT	F32T8SPX41ECHO	7 3/8" W X 3 1/4" D X 48" L WALL MOUNTED DIRECT/INDIRECT FIXTURE ELECT. BLST. & 4100K LPS AND EMERG. BALLAST	
F	LITHONIA DMW 232 AR 120 GEB10IS	APPROVED EQUIVALENT	120	CEILING	ELECTRONIC FLOURESCENT	F32T8SPX41ECHO	7 5/8" W X 4 3/4" D X 50" L SURFACE MOUNTED WET LOCATION FIXTURE ELECTRONIC BALLAST AND 4100K LAMPS	
H	LITHONIA WSTL-70M-MD-120 LPI	APPROVED EQUIVALENT	120	EXTERIOR WALL	PULSE START METAL HALIDE	18 1/4" W X 6 3/4" D X 74" H WALL MOUNTED EXTERIOR LIGHT, METAL HALIDE 70MH		
H1	LITHONIA WFL2-150M-FT-120 SCWA BBW UV LPI	APPROVED EQUIVALENT	120	EXTERIOR WALL	PULSE START METAL HALIDE	18 1/2" W X 9 1/8" D X 7 1/4" H WALL MOUNTED EXTERIOR LIGHT, METAL HALIDE 150MH		
K	LUMASCAPE 2UC 32 AR 120 GEB10IS SWR	APPROVED EQUIVALENT	120	UNDER CABINET	ELECTRONIC FLOURESCENT	F32T8SPX41ECHO	5 1/4" W X 1 15/16" D X 48" L UNDER CABINET FIXTURE, HIGH IMPACT ACRYLIC LENS	
M	LITHONIA CCR62 26-42TRT B07A MVOLT GEB10IS	APPROVED EQUIVALENT	120	CEILING RECESS	ELECTRONIC FLOURESCENT	F32T8SPX41ECHO	6" DIAMETER RECESSED DOWN LIGHT, CLEAR REFLECTOR, VERTICAL LAMP, TRT LAMP ELECTRONIC BALLAST AND 4100K LAMP	
N	LUMASCAPE WW5 D2SC ET8 120 MBL R BW CONTINUOUS	APPROVED EQUIVALENT	120	CEILING RECESS	ELECTRONIC FLOURESCENT	F32T8SPX41ECHO	6.5" W X 10" D X VARIOUS RECESSED WALL WASHER WITH WHITE LOUVER ELECTRONIC BALLAST AND 4100K LAMP	
P	LUMASCAPE LS47 LED-2X14W-28W4 H MARK BRONZE	APPROVED EQUIVALENT	120	EXTERIOR WALL	ELECTRONIC DRIVER	4.3" DIAMETER WALL MOUNTED UP/DOWN LIGHT. IP66 & 1P67 RATED, DARK BRONZE FINISH.		
S	STONCO VK 1 CC	APPROVED EQUIVALENT	120	CEILING SURFACE	INCANDESCENT	100W A19	4 1/8" DIA X 7 1/2" H LIGHT FIXTURE WITH GLASS GLOBE AND CAST GUARD.	
W	LITHONIA 16LM2N2H	APPROVED EQUIVALENT	120/277	SURFACE	NONE REQUIRED	16.25" W X 6-3/8" D X 7" H IMPACT RESISTANT POLYCARBONATE HOUSING 6W HALOGEN LAMPS NICKEL CADMIUM BATTERY		
W1	LITHONIA LE S 16120/277ELN SEE NOTE 4	APPROVED EQUIVALENT	120/277	WALL/CEILING	N/A	12-7/8" W X 9-1/2" H X 4" D, DIE CAST ALUMINUM HOUSING W/ GREEN LETTERING, NICAD BATTERY		
W2	LITHONIA LE S 16120/277ELN RO/ELN SEE NOTE 5	APPROVED EQUIVALENT	120/277	WALL/CEILING	N/A	12-7/8" W X 9-1/2" H X 4" D, DIE CAST ALUMINUM HOUSING W/ GREEN LETTERING, NICAD BATTERY W/ND REMOTE HEAD		
W3	LITHONIA ELA-W-HOB06	APPROVED	120/277	WALL/CEILING	NONE REQUIRED	4.75" W X 7.75" H X 5.5" D WHITE SEALED REMOTE MOUNTED FIXTURE, 6 VOLT, 8 WATT LAMP, VERIFY COMPATIBILITY WITH EMERGENCY FIXTURE		

NOTES:

1. THE ELECTRONIC FLUORESCENT BALLAST SHALL HAVE A TOTAL HARMONIC DISTORTION OF PLUS/MINUS 10% AND A BALLAST FACTOR EQUAL TO OR GREATER THAN 85%
2. ALL LIGHTING FIXTURES DENOTED WITH "EM" OR HALF SHADED SHALL BE PROVIDED WITH AN ENGINEER APPROVED EMERGENCY BALLAST FOR OPERATION OF TWO LAMPS IN A 2 OR 3 LAMP FIXTURE. BALLAST SHALL BE CONNECTED IN THE TRANSFORMER OF THE LIGHTING FIXTURE.
3. T-BAR TROFFER TYPE LIGHTING FIXTURES SHALL NOT BE SUPPORTED FROM THE T-BAR CEILING GRID.
4. THE SYMBOL USED IN THIS SCHEDULE IS A GENERIC SYMBOL TO INDICATE AN EXIT LIGHT FIXTURE. REFER TO THE PLANS FOR THE NUMBER OF FACES REQUIRED AT EACH EXIT. INSTALL THE NUMBER OF FACES REQUIRED AT EACH EXIT. FIELD ADJUST THE LOCATION OF THE EXIT SIGNS FOR THE BEST VISIBILITY POSSIBLE.
5. THIS EXIT SIGN REQUIRES THE EXTRA BATTERY CAPACITY TO OPERATE THE REMOTELY LOCATED EMERGENCY HEAD FOR EGRESS AWAY FROM THE BUILDING.

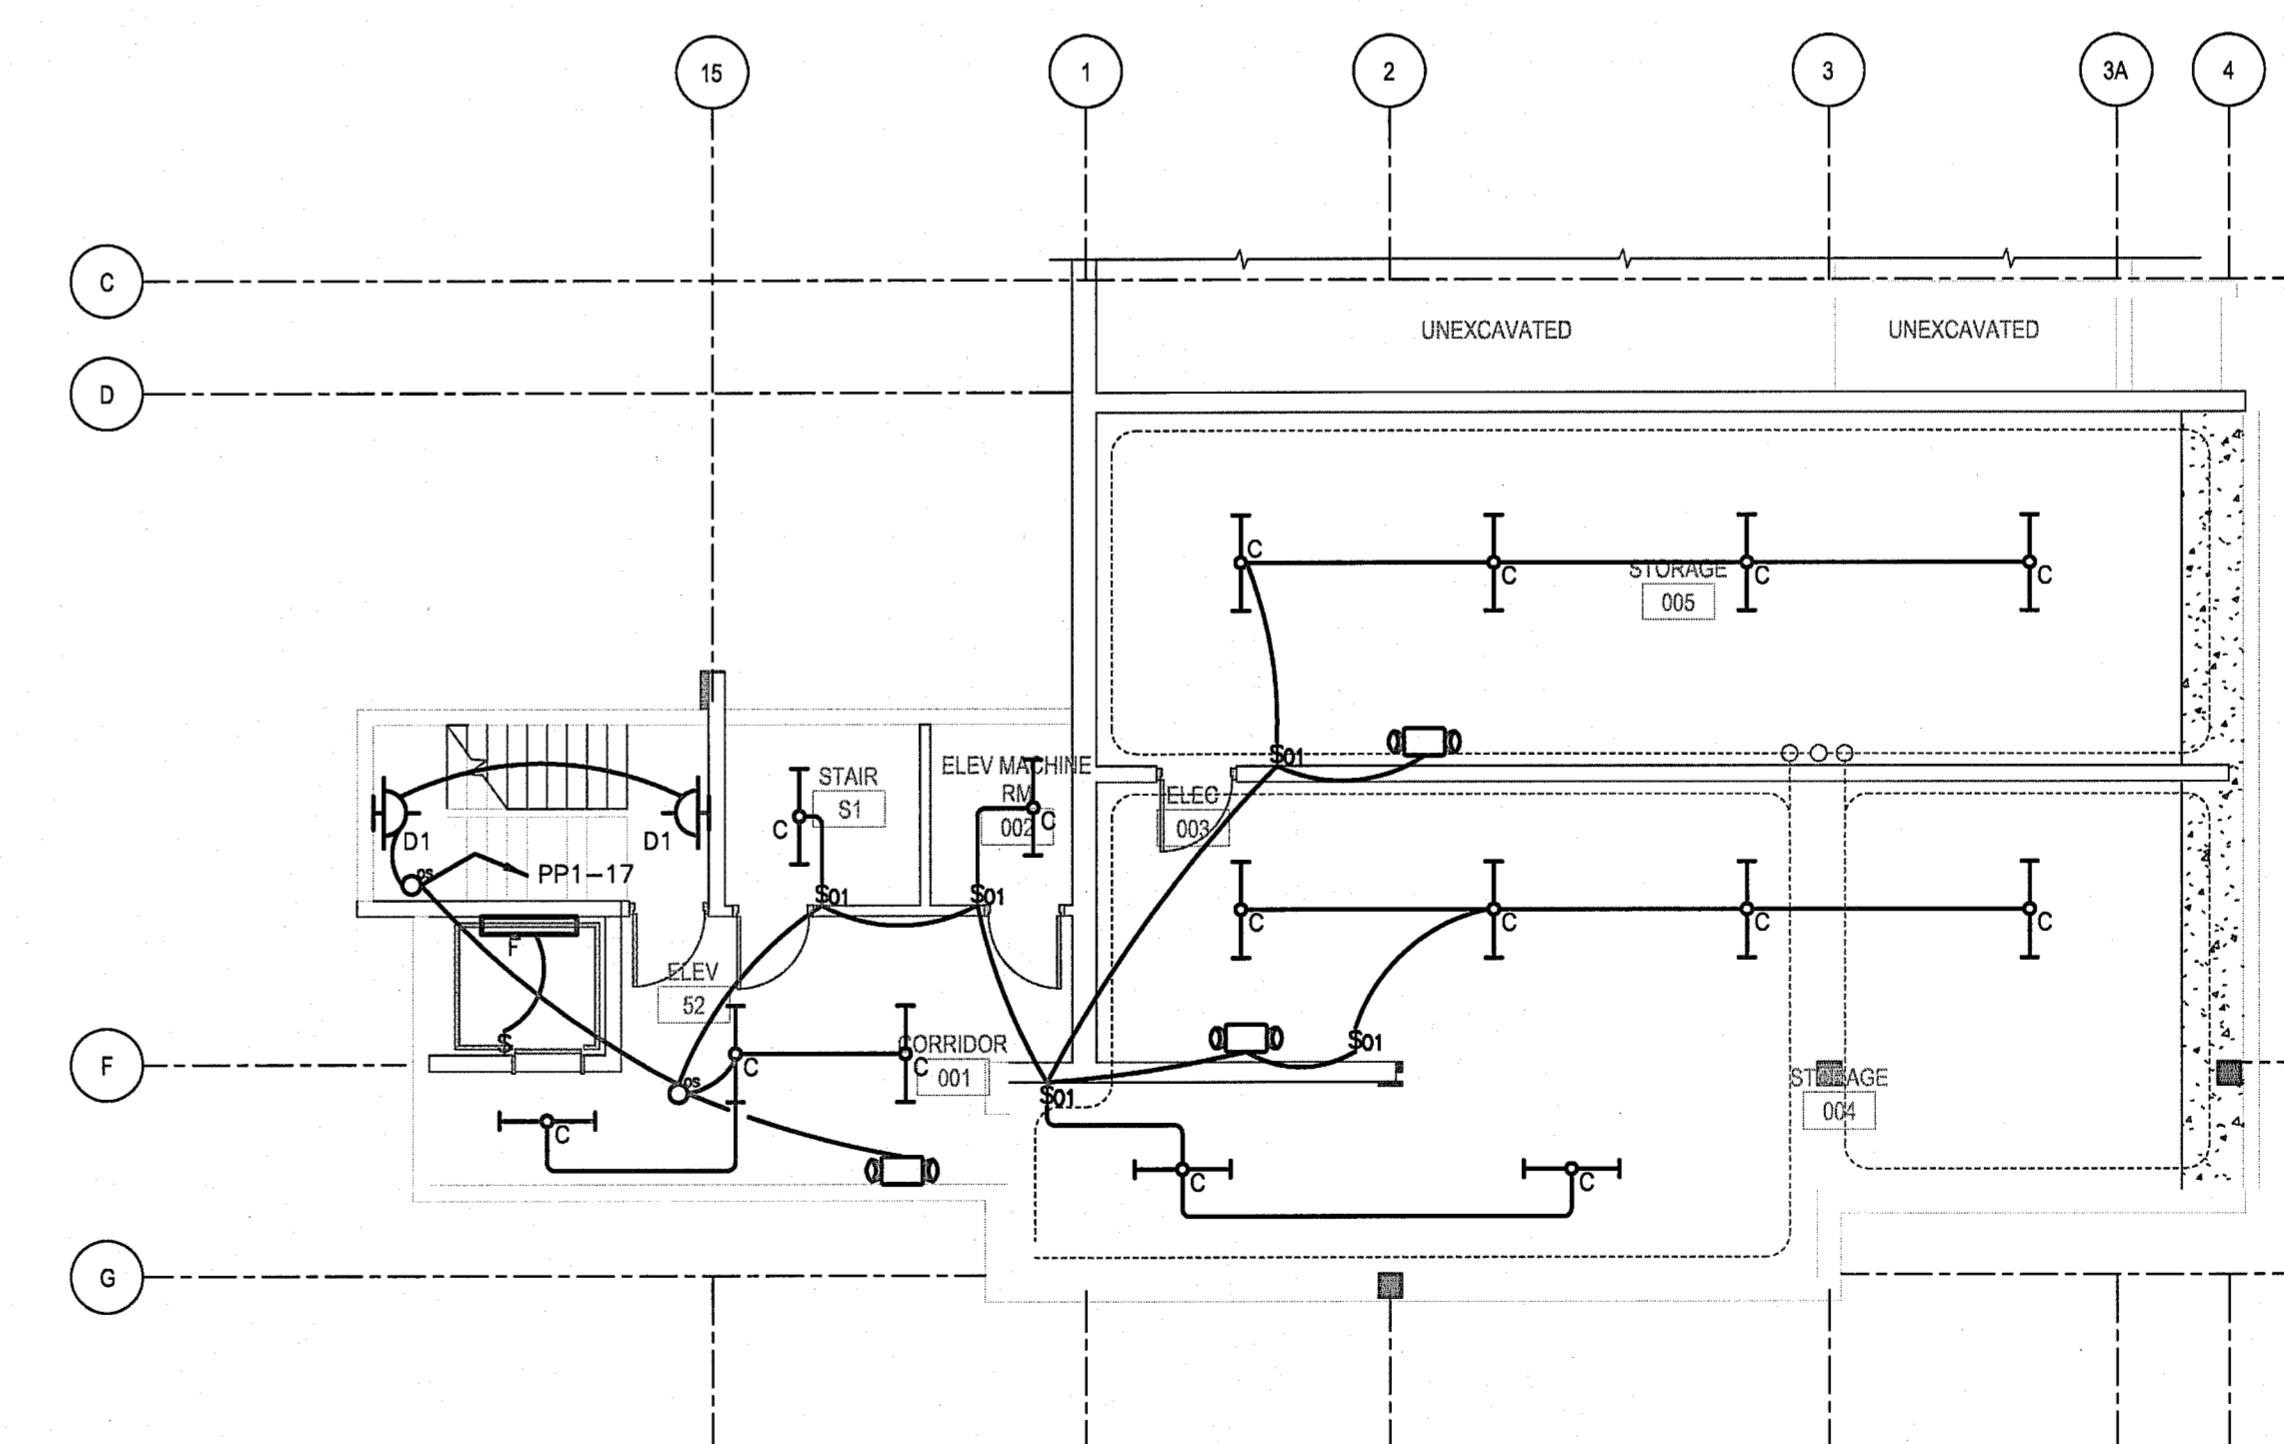

LIGHTING BASEMENT FLOOR PLAN

SCALE: 1/8"=1'-0"

NORTH

THIS SET OF CONFORMANCE DRAWINGS IS PROVIDED AS A CONVENIENCE TO THE CONTRACTOR. ARCHITECT AND ENGINEERS HAVE ATTEMPTED TO INCORPORATE ALL 4 ADDENDA, COMMENTS AND ANY CONTRACT. THE ORIGINALLY ISSUED DOCUMENTS SHALL GOVERN. CONTRACTOR SHALL BE RESPONSIBLE FOR VERIFICATION THAT THE CONFORMANCE SET FULLY INCORPORATES THE CONTRACT DOCUMENTS IN THEIR ENTIRETY.

REV. DESC. DATE: 12  
CONFIRM 10-19-12

DATE:  
PROJECT #:  
SHEET #:

E1-2

LIGHTING BASEMENT AND SECOND FLOOR PLANS

