


AUTHORIZED FOR CONSTRUCTION
TRENTON C. PRALL, ENGINEERING MANAGER DATE

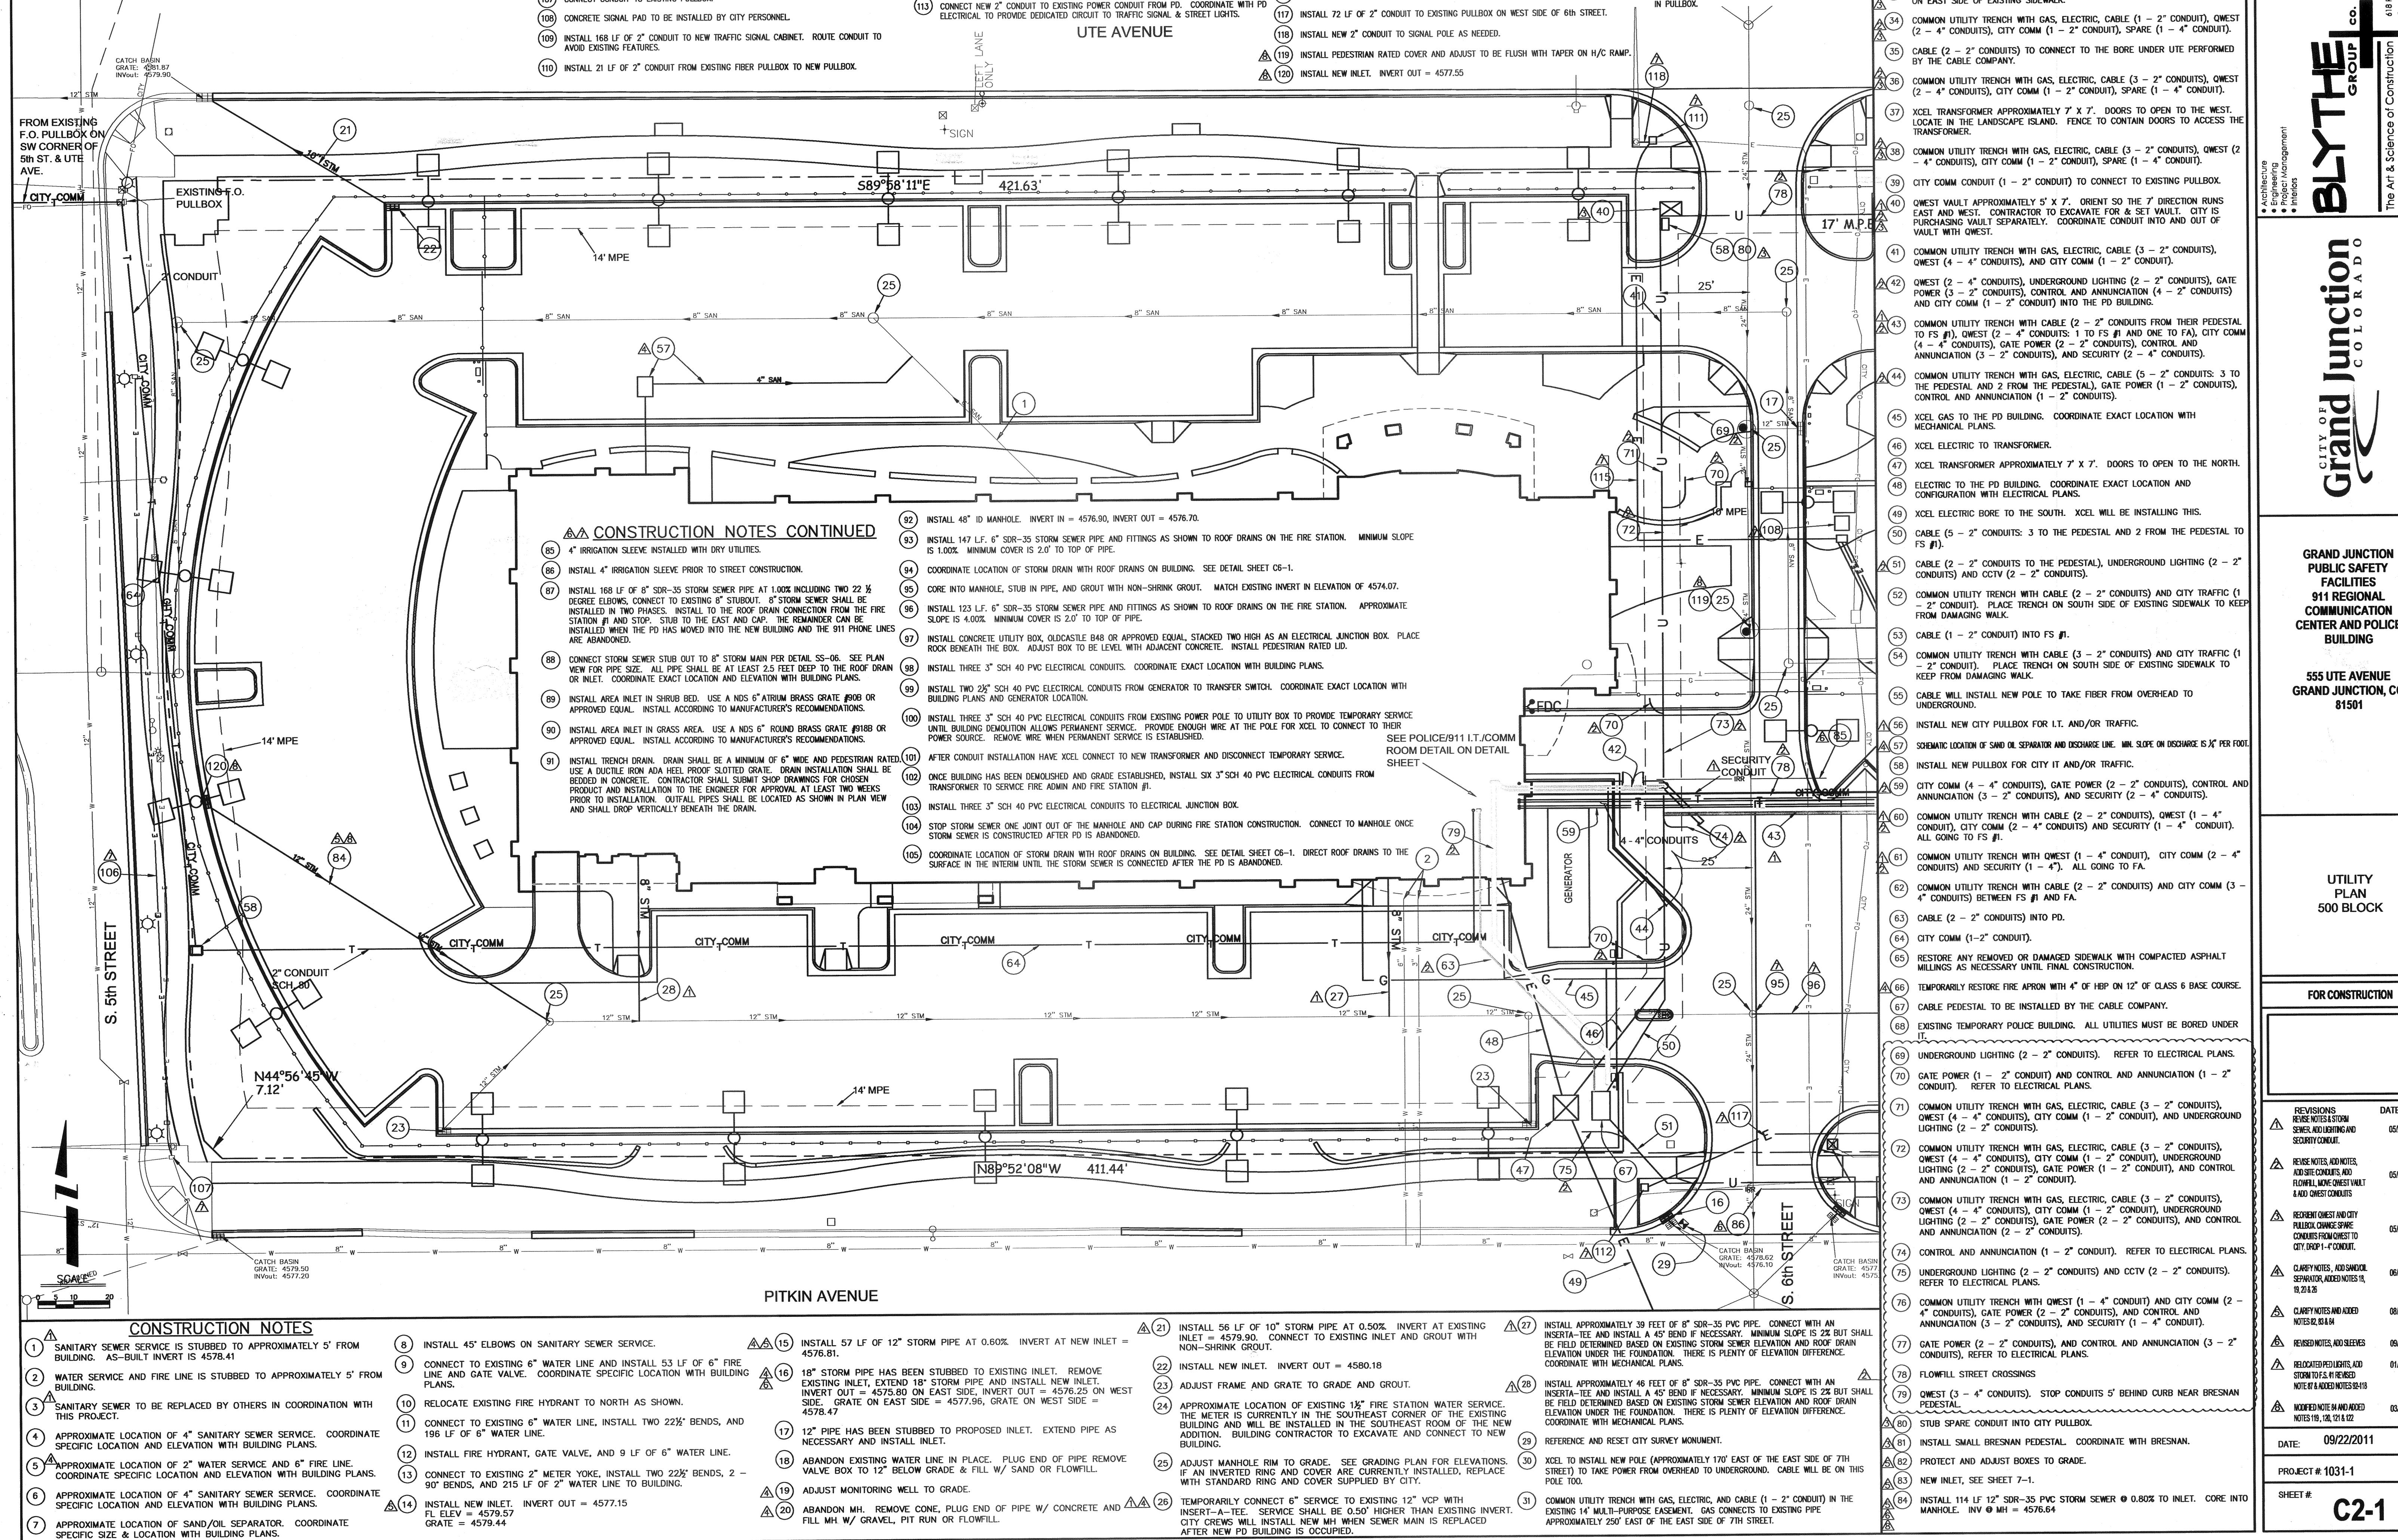

GRAND JUNCTION
PUBLIC SAFETY
FACILITIES
911 REGIONAL
COMMUNICATION
CENTER AND POLICE
BUILDING

555 UTE AVENUE
GRAND JUNCTION, CO
81501

UTILITY
PLAN
500 BLOCK

FOR CONSTRUCTION

REVISIONS:
REVERSE NOTES & STORM
SEWER, LIGHTING AND
SECURITY CONDUIT.

REVERSE NOTES, ADD NOTES,
ADD SITE CONDUITS AND
FLOWWELL QWEST VAULT

REPORT QWEST AND CITY
PULLBOX CHANGES
CONDUITS FROM QWEST TO
CITY, DROP 1" CONDUIT.

CLEAR NOTES, ADD SAND
SEPARATOR, ADD NOTES
13, 21, 26

CLEAR NOTES AND ADDED
NOTES 2, 3, 6, 84

REVERSE NOTES, ADD SLEEVES

RELOCATED LIGHTS, ADD
STORM TO 14" REVERSE

NOTES 19, 24, 26, 42, 43

MODIFIED 94 AND ADDED
NOTES 19, 24, 26, 42

DATE: 09/22/2011

PROJECT # 1031-1

SHEET # C2-1

618 Rock Avenue
Grand Junction, CO 81501
office: 719.242.1058
www.blythegroup.com

The Art & Science of Construction

AUTHORIZED FOR CONSTRUCTION

TRENTON C. PRALL, ENGINEERING MANAGER

DATE

SEE SHEET 7

CONSTRUCTION NOTES CONTINUED


106. INSTALL 212 LF OF 2" ELECTRICAL CONDUIT TO ALL 4 PED LIGHTS. BRING TO SURFACE WITH 90 DEGREE SWEEPS. 30' OF COVER. LOCATE PULL BOX ABOUT 2.5' AWAY FROM PED LIGHT AND KEEP OUT OF SIDEWALK. XCEL WILL INSTALL BASES, POLES, AND LIGHTS.

107. CONNECT CONDUIT TO EXISTING PULLBOX.

108. CONCRETE SIGNAL PAD TO BE INSTALLED BY CITY PERSONNEL.

109. INSTALL 168 LF OF 2" CONDUIT TO NEW TRAFFIC SIGNAL CABINET. ROUTE CONDUIT TO AVOID EXISTING FEATURES.

110. INSTALL 21 LF OF 2" CONDUIT FROM EXISTING FIBER PULLBOX TO NEW PULLBOX.

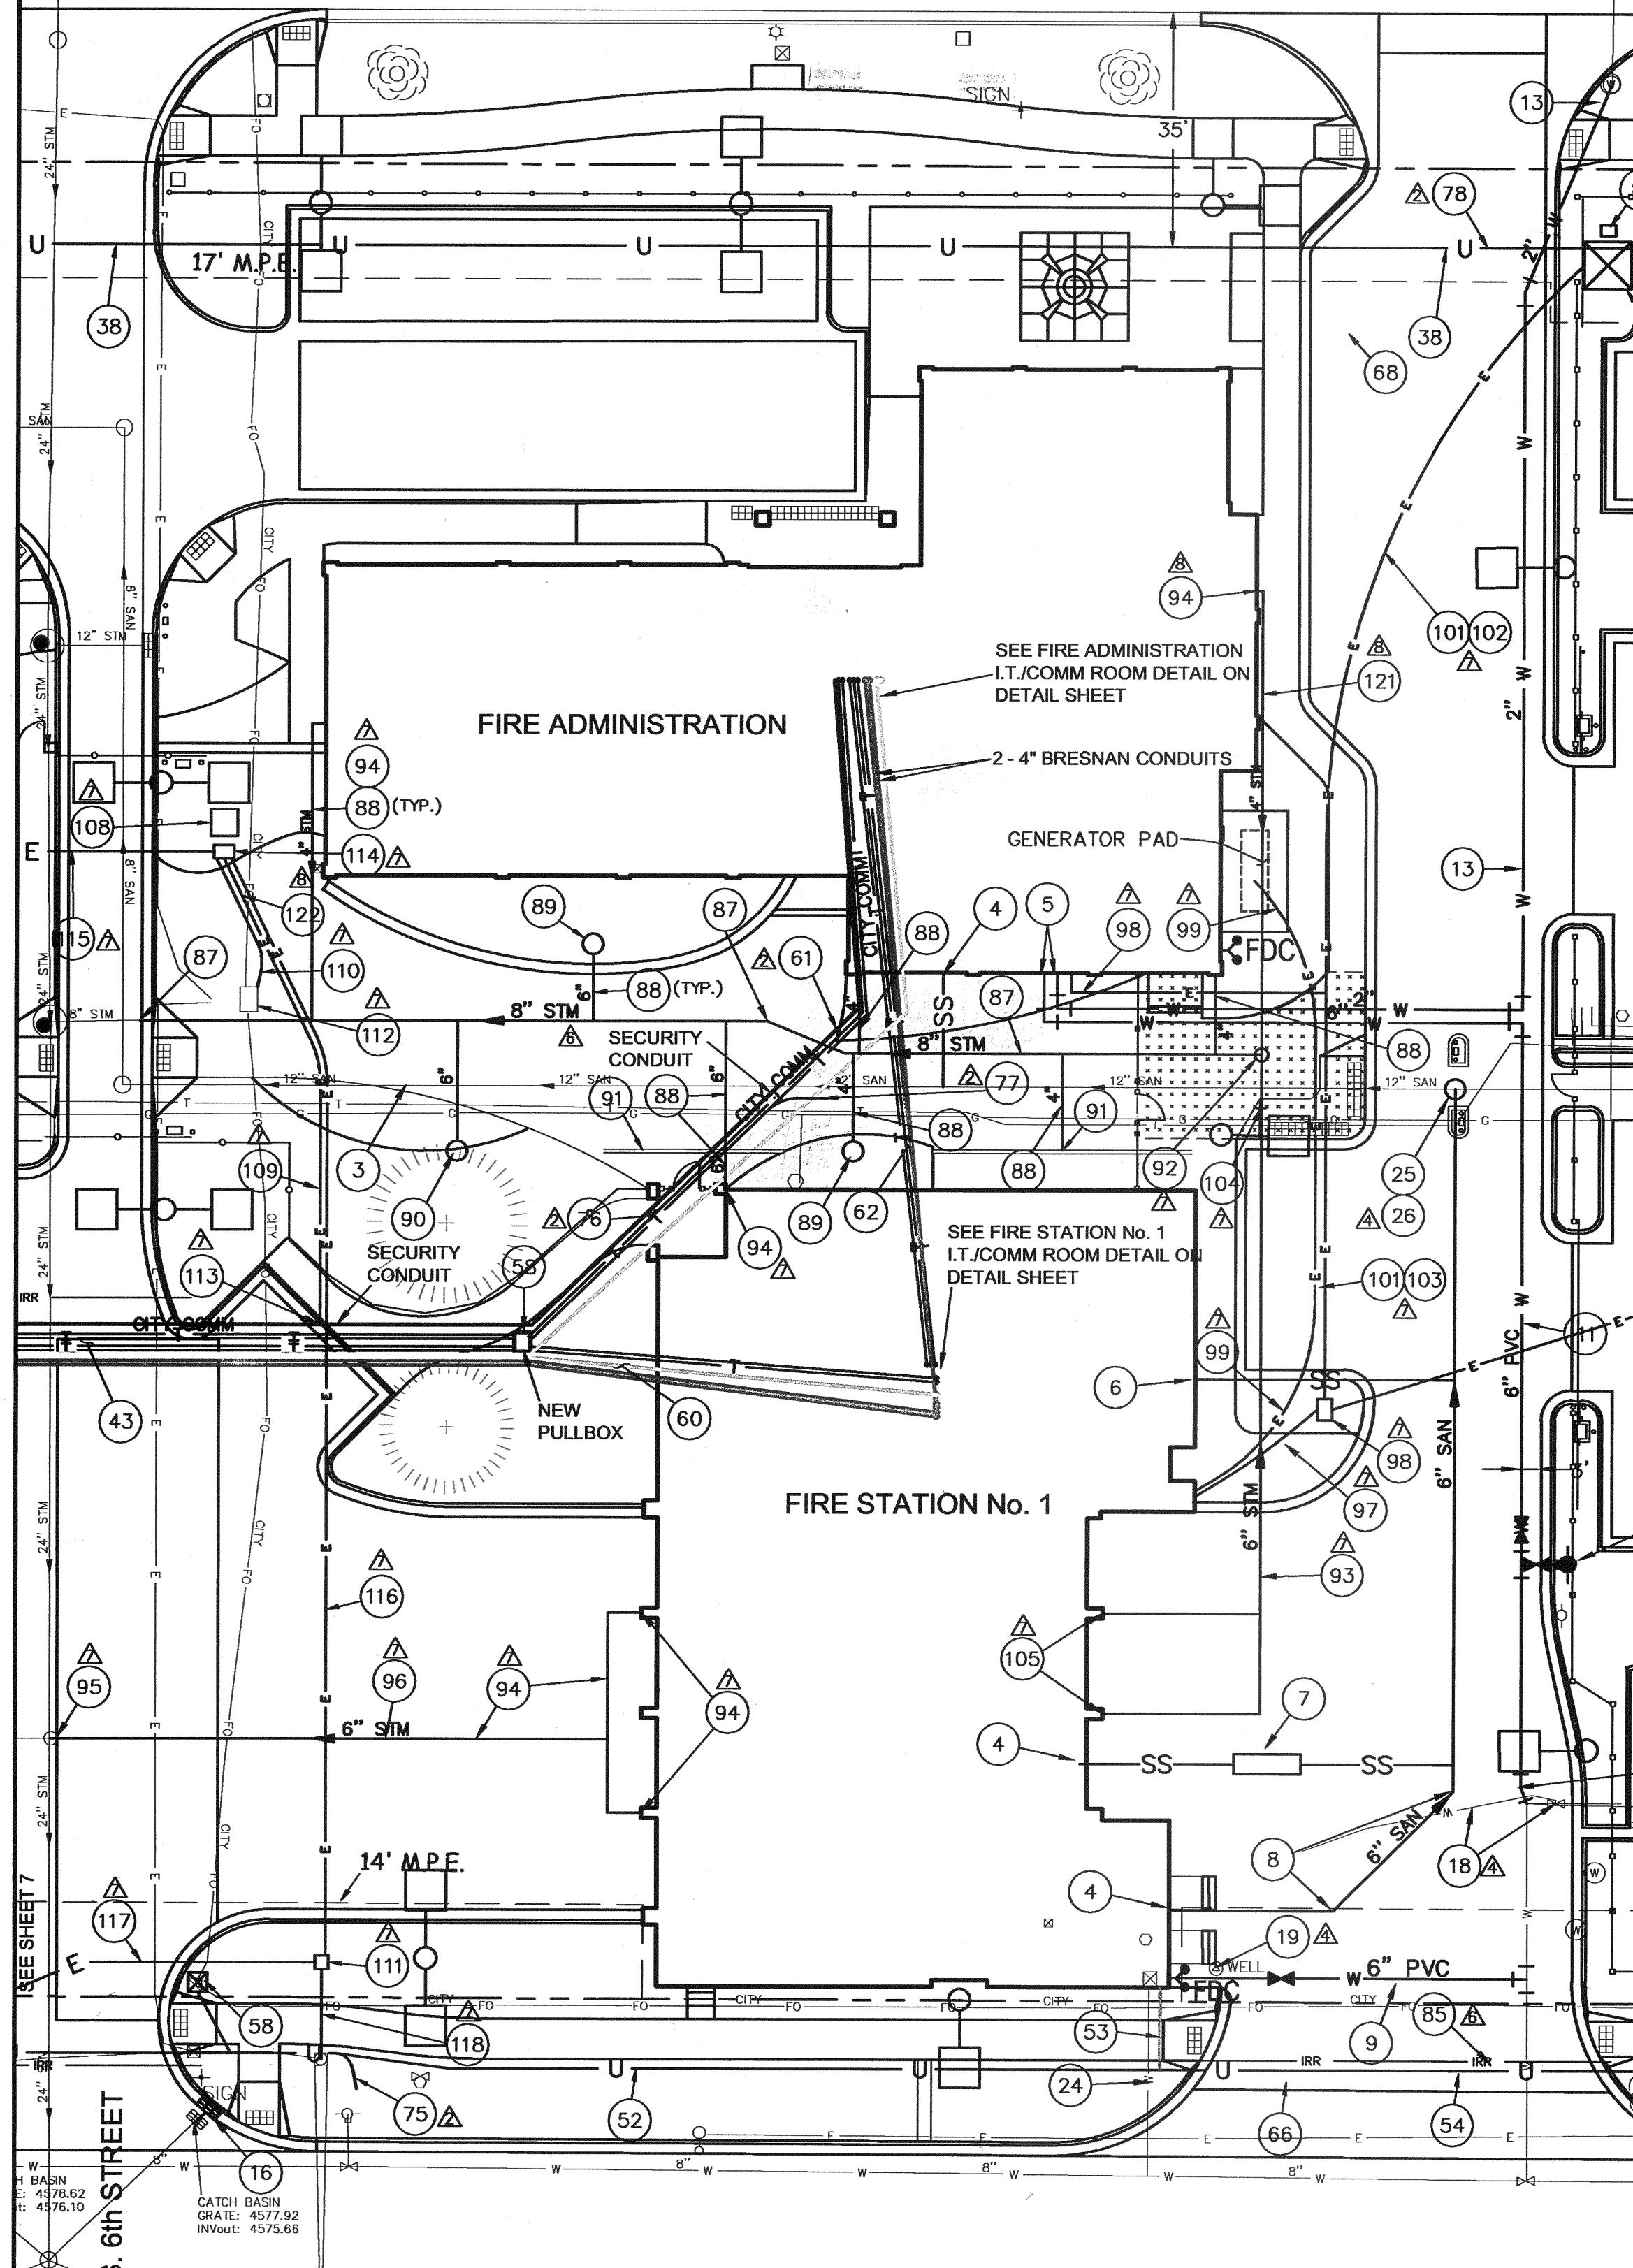

CONSTRUCTION NOTES

15. INSTALL 57 LF OF 12" STORM PIPE AT 0.60% INVERT AT NEW INLET = 4576.81.

16. 18" STORM PIPE HAS BEEN STUBBED TO EXISTING INLET. REMOVE EXISTING INLET, EXTEND 18" STORM PIPE, AND INSTALL NEW INLET. INVERT OUT = 4575.81 ON EAST SIDE, INVERT OUT = 4576.25 ON WEST SIDE. GRADE ON EAST SIDE = 4577.96, GRADE ON WEST SIDE = 4578.47

17. 12" PIPE HAS BEEN STUBBED TO PROPOSED INLET. EXTEND PIPE AS NECESSARY AND INSTALL INLET.

18. ABANDON EXISTING WATER LINE IN PLACE. PLUG END OF PIPE REMOVE VALVE BOX TO 12" BELOW GRADE & FILL W/ SAND OR FLOWFILL.

19. ADJUST MONITORING WELL TO GRADE.

20. ABANDON MH. REMOVE CONE, PLUG END OF PIPE W/ CONCRETE AND FILL MH W/ GRAVEL, PIT RUN OR FLOWFILL.

21. INSTALL 56 LF OF 10" STORM PIPE AT 0.50%. INVERT AT EXISTING INLET = 4579.90. CONNECT TO EXISTING INLET AND GROUT WITH NON-SHRINK GROUT.

22. INSTALL NEW INLET. INVERT OUT = 4580.18

23. ADJUST FRAME AND GRATE TO GRADE AND GROUT.

24. APPROXIMATE LOCATION OF EXISTING 1½" FIRE STATION WATER SERVICE. THE METER IS CURRENTLY IN THE SOUTHEAST CORNER OF THE EXISTING BUILDING AND WILL BE INSTALLED IN THE SOUTHEAST ROOM OF THE NEW ADDITION. BUILDING CONTRACTOR TO EXCAVATE AND CONNECT TO NEW BUILDING. COORDINATE WITH MECHANICAL PLANS.

25. ADJUST MANHOLE RIM AND COVER. SEE GRADING PLAN FOR ELEVATIONS. THE EXTERIOR RING AND COVER ARE CURRENTLY INSTALLED. REPLACE WITH STANDARD RING AND COVER SUPPLIED BY CITY.

26. TEMPORARILY CONNECT 6" SERVICE TO EXISTING 12" VCP WITH INSERT-A-TEE. SERVICE SHALL BE 0.50" HIGHER THAN EXISTING INVERT. CITY CREWS WILL INSTALL NEW MH WHEN SEWER MAIN IS REPLACED AFTER NEW PD BUILDING IS OCCUPIED.

27. INSTALL APPROXIMATELY 39 FEET OF 8" SDR-35 PVC PIPE. CONNECT WITH AN INSERT-A-TEE AND INSTALL A 45° BEND IF NECESSARY. MINIMUM SLOPE IS 2% BUT SHALL BE FIELD DETERMINED BASED ON EXISTING STORM SEWER ELEVATION AND ROOF DRAIN ELEVATION UNDER THE FOUNDATION. THERE IS PLENTY OF ELEVATION DIFFERENCE.

28. INSTALL APPROXIMATELY 46 FEET OF 8" SDR-35 PVC PIPE. CONNECT WITH AN INSERT-A-TEE AND INSTALL A 45° BEND IF NECESSARY. MINIMUM SLOPE IS 2% BUT SHALL BE FIELD DETERMINED BASED ON EXISTING STORM SEWER ELEVATION AND ROOF DRAIN ELEVATION UNDER THE FOUNDATION. THERE IS PLENTY OF ELEVATION DIFFERENCE.

29. REFERENCE AND RESET CITY SURVEY MONUMENT.

30. XCEL TO INSTALL NEW POLE (APPROXIMATELY 17' EAST OF THE EAST SIDE OF 7TH STREET) TO TAKE POWER FROM OVERHEAD TO UNDERGROUND. CABLE WILL BE ON THIS POLE. THE EXTERIOR RING AND COVER ARE CURRENTLY INSTALLED. REPLACE WITH STANDARD RING AND COVER SUPPLIED BY CITY.

31. COMMON UTILITY TRENCH WITH GAS, ELECTRIC, AND CABLE (1 - 2" CONDUIT) IN THE EXISTING 14' MULTI-PURPOSE EASEMENT. GAS CONNECTS TO EXISTING PIPE APPROXIMATELY 250' EAST OF THE EAST SIDE OF 7TH STREET.

32. 7TH STREET CAN BE OPEN CUT. PATCH ASPHALT PER CITY REQUIREMENTS INCLUDING T-TOPPING.

33. UTILITY TRENCH FOR QWEST (2 - 4" CONDUITS) AND SPARE (1 - 4" CONDUIT) ON EAST SIDE OF EXISTING SIDEWALK.

34. COMMON UTILITY TRENCH WITH GAS, ELECTRIC, CABLE (1 - 2" CONDUIT), QWEST (2 - 4" CONDUITS), CITY COMM (1 - 2" CONDUIT), SPARE (1 - 4" CONDUIT).

35. CABLE (2 - 2" CONDUITS) TO CONNECT TO THE BORE UNDER UTE PERFORMED BY THE CABLE COMPANY.

36. COMMON UTILITY TRENCH WITH GAS, ELECTRIC, CABLE (3 - 2" CONDUITS), QWEST (2 - 4" CONDUITS), CITY COMM (1 - 2" CONDUIT), SPARE (1 - 4" CONDUIT).

37. XCEL TRANSFORMER APPROXIMATELY 7' X 7'. DOORS TO OPEN TO THE WEST. LOCATE IN THE LANDSCAPE ISLAND. FENCE TO CONTAIN DOORS TO ACCESS THE TRANSFORMER.

38. COMMON UTILITY TRENCH WITH GAS, ELECTRIC, CABLE (3 - 2" CONDUITS), QWEST (2 - 4" CONDUITS), CITY COMM (1 - 2" CONDUIT), SPARE (1 - 4" CONDUIT).

39. CITY COMM CONDUIT (1 - 2" CONDUIT) TO CONNECT TO EXISTING PULLBOX.

40. QWEST VAULT APPROXIMATELY 5' X 7'. ORIENT SO THE 7' DIRECTION RUNS EAST AND WEST. CONTRACTOR TO EXCAVATE FOR & SET VAULT. CITY IS PURCHASING VAULT SEPARATELY. COORDINATE CONDUIT INTO AND OUT OF VAULT WITH QWEST.

41. COMMON UTILITY TRENCH WITH GAS, ELECTRIC, CABLE (3 - 2" CONDUITS), QWEST (2 - 4" CONDUITS), AND CITY COMM (1 - 2" CONDUIT).

42. QWEST (2 - 4" CONDUITS), UNDERGROUND LIGHTING (2 - 2" CONDUITS), GATE POWER (3 - 2" CONDUITS), CONTROL AND ANNUNCIATION (4 - 2" CONDUITS) AND CITY COMM (1 - 2" CONDUIT) INTO THE PD BUILDING.

43. COMMON UTILITY TRENCH WITH CABLE (2 - 2" CONDUITS) FROM THEIR PEDESTAL TO FS #1, QWEST (2 - 4" CONDUITS), 1 TO FS #1 AND ONE TO FA, CITY COMM (4 - 2" CONDUITS), GATE POWER (2 - 2" CONDUITS), CONTROL AND ANNUNCIATION (3 - 2" CONDUITS), AND SECURITY (2 - 4" CONDUITS).

44. COMMON UTILITY TRENCH WITH GAS, ELECTRIC, CABLE (5 - 2" CONDUITS: 3 TO THE PEDESTAL AND 2 FROM THE PEDESTAL), GATE POWER (1 - 2" CONDUITS), CONTROL AND ANNUNCIATION (1 - 2" CONDUITS).

45. XCEL GAS TO THE PD BUILDING. COORDINATE EXACT LOCATION WITH MECHANICAL PLANS.

46. XCEL ELECTRIC TO TRANSFORMER.

47. XCEL TRANSFORMER APPROXIMATELY 7' X 7'. DOORS TO OPEN TO THE NORTH.

48. ELECTRIC TO THE PD BUILDING. COORDINATE EXACT LOCATION AND CONFIGURATION WITH ELECTRICAL PLANS.

49. XCEL ELECTRIC BORE TO THE SOUTH. XCEL WILL BE INSTALLING THIS.

50. CABLE (5 - 2" CONDUITS: 3 TO THE PEDESTAL AND 2 FROM THE PEDESTAL TO FS #1).

51. CABLE (2 - 2" CONDUITS TO THE PEDESTAL), UNDERGROUND LIGHTING (2 - 2" CONDUITS) AND CCTV (2 - 2" CONDUITS).

52. COMMON UTILITY TRENCH WITH CABLE (2 - 2" CONDUITS) AND CITY TRAFFIC (1 - 2" CONDUIT). PLACE TRENCH ON SOUTH SIDE OF EXISTING SIDEWALK TO KEEP FROM DAMAGING WALK.

53. CABLE (1 - 2" CONDUIT) INTO FS #1.

54. COMMON UTILITY TRENCH WITH CABLE (3 - 2" CONDUITS) AND CITY TRAFFIC (1 - 2" CONDUIT). PLACE TRENCH ON SOUTH SIDE OF EXISTING SIDEWALK TO KEEP FROM DAMAGING WALK.

55. CABLE WILL INSTALL NEW POLE TO TAKE FIBER FROM OVERHEAD TO UNDERGROUND.

56. INSTALL NEW CITY PULLBOX FOR IT, AND/OR TRAFFIC.

57. SCHEMATIC LOCATION OF SAND OIL SEPARATOR AND DISCHARGE LINE. MIN. SLOPE ON DISCHARGE IS 1% PER FOOT.

58. INSTALL NEW PULLBOX FOR CITY IT AND/OR TRAFFIC.

59. CITY COMM (4 - 4" CONDUITS), GATE POWER (2 - 2" CONDUITS), CONTROL AND ANNUNCIATION (3 - 2" CONDUITS), AND SECURITY (2 - 4" CONDUITS).

60. COMMON UTILITY TRENCH WITH CABLE (2 - 2" CONDUITS), QWEST (1 - 4" CONDUIT), CITY COMM (2 - 4" CONDUITS) AND SECURITY (1 - 4" CONDUIT). ALL GOING TO FS #1.

61. COMMON UTILITY TRENCH WITH QWEST (1 - 4" CONDUIT), CITY COMM (2 - 4" CONDUITS) AND SECURITY (1 - 4" CONDUIT). ALL GOING TO FA.

62. COMMON UTILITY TRENCH WITH CABLE (2 - 2" CONDUITS) AND CITY COMM (3 - 4" CONDUITS) BETWEEN FS #1 AND FA.

63. CABLE (2 - 2" CONDUITS) INTO PD.

64. CITY COMM (1 - 2" CONDUIT).

65. RESTORE ANY REMOVED OR DAMAGED SIDEWALK WITH COMPAKTED ASPHALT MILLINGS AS NECESSARY UNTIL FINAL CONSTRUCTION.

66. TEMPORARILY RESTORE FIRE APRON WITH 4" OF HEP ON 12" OF CLASS 6 BASE COURSE. CABLE PEDESTAL TO BE INSTALLED BY THE CABLE COMPANY.

67. EXISTING TEMPORARY POLICE BUILDING. ALL UTILITIES MUST BE BORED UNDER IT.

68. UNDERGROUND LIGHTING (2 - 2" CONDUITS). REFER TO ELECTRICAL PLANS.

69. GATE POWER (1 - 2" CONDUIT) AND CONTROL AND ANNUNCIATION (1 - 2" CONDUIT). REFER TO ELECTRICAL PLANS.

70. COMMON UTILITY TRENCH WITH GAS, ELECTRIC, CABLE (3 - 2" CONDUITS), QWEST (4 - 4" CONDUITS), CITY COMM (1 - 2" CONDUIT), AND UNDERGROUND LIGHTING (2 - 2" CONDUITS).

71. COMMON UTILITY TRENCH WITH GAS, ELECTRIC, CABLE (3 - 2" CONDUITS), QWEST (4 - 4" CONDUITS), CITY COMM (1 - 2" CONDUIT), AND UNDERGROUND LIGHTING (2 - 2" CONDUITS).

72. COMMON UTILITY TRENCH WITH GAS, ELECTRIC, CABLE (3 - 2" CONDUITS), QWEST (4 - 4" CONDUITS), CITY COMM (1 - 2" CONDUIT), UNDERGROUND LIGHTING (2 - 2" CONDUITS), GATE POWER (1 - 2" CONDUIT), AND CONTROL AND ANNUNCIATION (1 - 2" CONDUIT).

73. COMMON UTILITY TRENCH WITH GAS, ELECTRIC, CABLE (3 - 2" CONDUITS), QWEST (4 - 4" CONDUITS), CITY COMM (1 - 2" CONDUIT), UNDERGROUND LIGHTING (2 - 2" CONDUITS), GATE POWER (2 - 2" CONDUITS), AND CONTROL AND ANNUNCIATION (2 - 2" CONDUITS).

74. CONTROL AND ANNUNCIATION (1 - 2" CONDUIT). REFER TO ELECTRICAL PLANS.

75. UNDERGROUND LIGHTING (2 - 2" CONDUITS) AND CCTV (2 - 2" CONDUITS). REFER TO ELECTRICAL PLANS.

76. COMMON UTILITY TRENCH WITH QWEST (1 - 4" CONDUIT) AND CITY COMM (2 - 4" CONDUITS), GATE POWER (2 - 2" CONDUITS), AND CONTROL AND ANNUNCIATION (3 - 2" CONDUITS), AND SECURITY (1 - 4" CONDUIT).

77. GATE POWER (2 - 2" CONDUITS), AND CONTROL AND ANNUNCIATION (3 - 2" CONDUITS). REFER TO ELECTRICAL PLANS.

78. FLOWFILL STREET CROSSINGS

79. QWEST (3 - 4" CONDUITS). STOP CONDUITS 5' BEHIND CURB NEAR BRESNAN PEDESTAL

80. STUB SPARE CONDUIT INTO CITY PULLBOX

81. INSTALL SMALL BRESNAN PEDESTAL. COORDINATE WITH BRESNAN.

82. PROTECT AND ADJUST BOXES TO GRADE.

83. NOT USED.

84. INSTALL 40 LF 12" SDR-35 PVC STORM SEWER @ 0.80%. CORE INTO MANHOLE. INV @ MH = 4576.64, PIPE END INV = 4576.96. INSTALL CAP ON END OF PIPE AND MARK WITH GREEN 4x4 POST.

85. CLARIFY NOTES ADD/DED NOTES

86. REVISED & ADDED NOTES, STORM DRAIN, ADD/DED NOTES

87. REVERSE NOTES & STORM SEWER ADD/DED NOTES, ADD/DED NOTES, ADD/DED NOTES, ADD/DED NOTES

88. REVERSE NOTES & STORM SEWER ADD/DED NOTES, ADD/DED NOTES, ADD/DED NOTES

89. REVERSE NOTES & STORM SEWER ADD/DED NOTES, ADD/DED NOTES, ADD/DED NOTES

177. REVERSE NOTES & STORM SEWER ADD/DED NOTES

LUMINAIRE SCHEDULE												
MARK	DESCRIPTION	MANUFACTURER	CATALOG NUMBER	LAMPS		BALLAST		TOTAL WATTS	VOLTS	MOUNTING		NOTES
				NO.	TYPE	NO.	TYPE			TYPE	HEIGHT	
AA	SUSPENDED LINEAR LED	LEDALITE	1201 LAA Q S xx 7 2 E T	1	LED	1	5% DIMM	37.5	277	SUSPENDED	10' UON	1,2,5,6,9
AD	SUSPENDED LINEAR LED W/ INTEGRAL DAYLIGHT SENSOR	LEDALITE	1201 LAA Q S xx 7 2 E T DS	1	LED	1	5% DIMM	37.5	277	SUSPENDED	10' UON	1,2,5,6,9
AF	SUSPENDED LINEAR FLUOR	LEDALITE	1201 F10 Q S xx 1 2 E T	1	F28T5	1	ELEC	28	277	SUSPENDED	10' UON	1,2,5,6,9
AG	SUSPENDED LINEAR FLUOR	LEDALITE	1201 F20 Q S xx 2 2 E T	2	F28T5	1	STEP DIMM	56	277	SUSPENDED	10' UON	1,2,5,6,9
AK	CANTILEVER WALL MOUNT FLUOR	LEDALITE	1238 F10 Q S xx 1 2 E T	1	F28T5	1	ELEC	28	277	WALL	AS NOTED	1,2,5,6,9
AS	FLUOR WALL MOUNTED ASYMETRICAL	LEDALITE	1238 F20 Q S xx 1 2 E T-DS	2	F28T5	1	STEP DIMM	56	277	WALL	8' UON	1,2,5,6,9
AW	FLUOR WALL MOUNTED ASYMETRICAL	LEDALITE	1228 F10 Q S xx 1 2 E T	1	F28T5	1	ELEC	28	277	WALL	9'-4" UON	1,2,5,6,9
BA	2L 2X4 RECESSED	LEDALITE	3324 D1 ST F228 S 2 2 E	2	F28T5	1	STEP DIMM	56	277	RECESSED		1,3,6
BB	2L 2X4 RECESSED DIMMING	LEDALITE	3324 D1 ST F228 S 7 2 E	2	F28T5	2	5% DIMM	56	277	RECESSED		1,3,6
BV	2L 1X4 VIDEO TELECONF. RECESSED	COLUMBIA	VC-14-228-PVC-U-DIM	2	F28T5	1	5% DIMM	56	277	RECESSED		1,3,6,8
CA	2L 2X4 LENSED TROFFER	HE WILLIAMS	50GS 24 2 28T5S S A12125 EB2 277	2	F28T5	1	ELEC	56	277	RECESSED		1,3,6
CB	3L 2X4 LENSED TROFFER	HE WILLIAMS	50GS 24 3 28T5S S A12125 EB2 277	3	F28T5	1	ELEC	84	277	RECESSED		1,3,6
CC	2L 2X2 LENSED TROFFER	HE WILLIAMS	50GS 22 2 14T5S S A12125 EB2 277	2	F14T5	1	ELEC	28	277	RECESSED		1,3,6
DA	6" SQUARE LED DOWNLIGHT	HE WILLIAMS	LEDSQ60 1100 41K 277	1	LED	1	5% DIMM	18	277	RECESSED		1,3,6
DC	6" SQUARE FLUOR DOWNLIGHT	HE WILLIAMS	PHSQ60 142T EB1 277	1	F42TTT	1	ELEC	42	277	RECESSED		1,3,6
DD	6" SQUARE WALL WASH DOWNLIGHT	HE WILLIAMS	PHSQ60 142T WW EB1 277	1	F42TTT	1	5% DIMM	42	277	RECESSED		1,3,6
DS	6" HIGH IMPACT LENS DOWNLIGHT, UL WET	PRESCOLITE	CFT632HEB ST602H PW PL	1	F26TTT	1	ELEC	26	277	RECESSED		1,3,6,12
DW	EXTERIOR LED DOWNLIGHT	KENALL	ME 11 MR1 24L40K	1	LED	1	ELEC	24	277	RECESSED		1,3,6,12
DPZ	12" SQUARE LED DOWNLIGHT	KENALL	ME 11 MR1 24L40K	1	LED	1	5% DIMM	24	277	RECESSED		1,3,6
H2	2L 2X4 HINGED DOORFRAME	KENALL	RMCD4-x-1-2 F32T8-IS1-277-7/2-1	2	F32T8	1	ELEC	64	277	RECESSED		1,3,6
H3	3L 2X4 HINGED DOORFRAME	KENALL	RMCD4-x-1-3 F32T8-IS1-277-7/2-1	3	F32T8		ELEC	96	277	RECESSED		1,3,6
I2	2L 1X4 INDUSTRIAL STRIP	HE WILLIAMS	GLN-4-228T5S-EB2-UNV-OCCSEN-SCHA118	2	F28T5	1	ELEC	56	277	SUSPENDED	9'	1,2,5,6
IG	INDUSTRIAL CORNER MOUNTED	HE WILLIAMS	MLHAB8S-XX/XX-F-LG-CP-254-RS2-277-CMB	2	F28T5HO	2	ELEC (OR STEP DIMM)	84	277	CORNER	9'	1,2,5,6,7
JA	RECESSED LINEAR DIRECT	PINNACLE	E4A-2T5-xx-FL-UNV-IC-CC	2	F28T5	1	ELEC	56	277	RECESSED - CEILING		1,3,6,8
JB	WALL RECESSED LINEAR DIRECT SEE PRE 4	PINNACLE	E4A-2T5-xx-FL-UNV-IC-CC	2	F28T5	1	ELEC	56	277	RECESSED - WALL		1,3,6,8
JC	WALL RECESSED LINEAR DIRECT	PINNACLE	E4A-1T5-xx-FL-UNV-IC-CC	1	F28T5	1	ELEC	28	277	RECESSED - WALL		1,3,6,8
P	PENDANT	CAMMAN	P5000-36-LED-277-CA-CPF-AC-MOD	1	LED		--	277		SUSPENDED	10' 2"	1,2,5,6,13
R2	2' ROUND TROFFER	HE WILLIAMS	RND-2-3T5-XX-FL-UNV-1C-CC	3	F14T5	2	ELEC	42	277	RECESSED		1,3,6
R3	3' ROUND TROFFER	HE WILLIAMS	RND-3-425-FXA-EB2/2	4	21T5S	2	ELEC	84	277	RECESSED		1,3,6
R4	4' ROUND TROFFER	HE WILLIAMS	RND-4-628T5-FXA-EB4/2	6	28WT5	2	ELEC	168	277	RECESSED		1,3,6
SA	INTERIOR SCONCE	INDESSA	425 2CFQ26-MOD				ELEC	277		WALL		1,2,5,6,11
SF	CUSTOM EXTERIOR SCONCE 18" SQUARE	LUMOS	EXD-LED 5038-A-14	2	LED		--	277		WALL		1,2,5,6
SG	CUSTOM EXTERIOR SCONCE 14" SQUARE	LUMOS	EXD-LED 5038-A-18	2	LED		--	277		WALL	13' 10"	1,2,5,6
SL	EXTERIOR CUT OFF	AEL	AEL 48 128 277 CL BKH	1	28WT5		ELEC	28	277	WALL	13' 10"	1,2,5,6
SM	EXTERIOR CUT OFF	AEL	AEL 48 128 277 CL BKH-OC	1	28WT5		ELEC	28	277	WALL	8' 6"	1,2,5,6
SP	EXTERIOR WALL GRAZE FLOOD	AEL	ON-18LED-BW-CUSTOM-NAH-RECESS	1	LED		--	19	277	WALL	8' 6"	1,2,5,6
											14' 8"	2,5,6,12,14
TA	TASK LIGHT - LED	BRUCK	ORION 138501MC-XX 14	1	LED		--	277		SURFACE UNDER CABINET		5,6,10
TB	DOCK LIGHT WITH 40" ARM			1	55W CF	--	--	55	120			
X1	EMERGENCY EXIT SIGN	EXITRONIX	S902-LB RC BA		LED		--	1.5	277	SURFACE		1,2,4,5,6
X2	EMERGENCY EXIT SIGN	EXITRONIX	S903-LB RC BA		LED		--	3	277	SURFACE		1,2,4,5,6
X9	LED "IN USE" LIGHT	EXITRONIX	903R-LB RC ZC BA		LED		--	3	277	RECESSED		1,3,6

NOTES:

- REFER TO ARCHITECTURAL REFLECTED CEILING PLAN FOR EXACT LOCATION OF FIXTURES IN THE CEILING GRID.
- Mounting height for fixture as indicated, bottom of fixture height above finished floor (AFF), unless otherwise noted on drawings.
- VERIFY CEILING TYPE WITH ARCHITECTURAL PLANS PRIOR TO ORDERING FIXTURE AND PROVIDE APPROPRIATE TRIM TO ACCOMMODATE CEILING TYPE.
- PROVIDE DIRECTIONAL ARROWS WHERE INDICATED ON DRAWINGS. MOUNTING HEIGHT 8' AFF ON OPEN WALLS OR 4" ABOVE DOOR FRAME WHEN ABOVE A DOOR
- COORDINATE EXACT MOUNTING HEIGHT WITH ARCHITECTURAL DRAWINGS
- COORDINATE FIXTURE FINISHES WITH ARCHITECTS.
- WHERE DIMMING OR STEP DIMMING BALLASTS ARE INDICATED ENSURE BALLAST IS COMPATIBLE WITH DIMMING CONTROLS.
- FOR TYPE Jx FIXTURES, PROVIDE CONTINUOUS LINEAR ASSEMBLY WITH ILLUMINATED CONNECTOR OPTION WHERE REQUIRED TO TURN AT A RIGHT ANGLE, SEE ARCHITECTURAL ELEVATIONS FOR ADDITIONAL DETAIL.
- FOR TYPE Ax FIXTURES PROVIDE CONTINUOUS LINEAR ASSEMBLY AS INDICATED. PROVIDE LUMINOUS END CAP AT EACH END OF EACH LINEAR ASSEMBLY.
- COORDINATE MOUNTING OF TASK AND UNDER CABINET LIGHTING WITH ARCHITECTURAL CASEWORK DETAILS. PROVIDE LENGTH AS REQUIRED FOR LENGTH OF CABINET IN EACH LOCATION, AS INDICATED.
- Fixture type SA modify standard to solid front with finish to match type Ax.
- UL WET LOCATION.
- MODIFY LUMINAIRE P4100K LED, 20% UP LIGHT / 80% DOWN LIGHT; CA - ARCHITECT SHALL SELECT LENS FROM MANUFACTURERS FULL LINE OF ACRYLICS, PROVIDE SAMPLES UPON REQUEST; CPF = MATCH FINISH TO FIXTURE TYPE AF.
- FOR TYPE SP FIXTURES MATCH FINISH TO TYPE SG AND SF, PROVIDE 4100K LEDs, MOUNT SEMI-RECESSED CENTERED ABOVE SIGN SUPPORTS, SEE ARCHITECTURAL ELEVATIONS FOR EXACT LOCATIONS.

SITE LUMINAIRE SCHEDULE												
Fixture Type	Description	Manufacturer	Catalog Number	LAMPS		Total Watts	Volts	Mounting		Notes		
				No.	Type			Type	Height			
W9-3	POLE MOUNTED LED AREA LUMINAIRE, TYPE 3 DISTRIBUTION	KIM	WP9L3-120-L5K-277	120	LED	140	277	POLE	30'	1,2		
W9-4	POLE MOUNTED LED AREA LUMINAIRE, TYPE 4 DISTRIBUTION	KIM	WP9L4-120-L5K-277	120	LED	140	277	POLE	30'	1,2		
SP	LED GRADE MOUNTED	ABS	5550LED-HRN-5000K WHITE-277-BD-KSF-00BLK	36	5000K LED	42	277	SLIPFIT	-5"	3		
SQ	IN-GRADE FLAG LIGHT, LED, NARROW FLOOD	KIM	LTV71NF-18L5K-UV-TR50	1	23W LED 5000K	23	277	IN-GRADE	0'	--		

NOTES:

- 27' ROUND TAPERED STEEL POLE. MATCH POLE FINISH AND FIXTURE FINISH TO APPROVED ARCHITECTURALLY SPECIFIED PAINT COLOR. VERIFY FINISH WITH ARCHITECT AND OWNER PRIOR TO ORDERING FIXTURE. POLE FINISH AND POLE ACCESSORIES AND ENCLOSURE FINISHES SHALL MATCH APPROVED LUMINAIRE FINISH.
- PROVIDE 3" HIGH CONCRETE BASE. FIXTURE MOUNTING HEIGHT EQUALS POLE AND BASE.
- PROVIDE 5000K LED TO MATCH TYPE SQ. ADJUST SHIELDS TO BEST ILLUMINATE SIGN AND LIMIT GLARE THRU ARCH AND ABOVE