

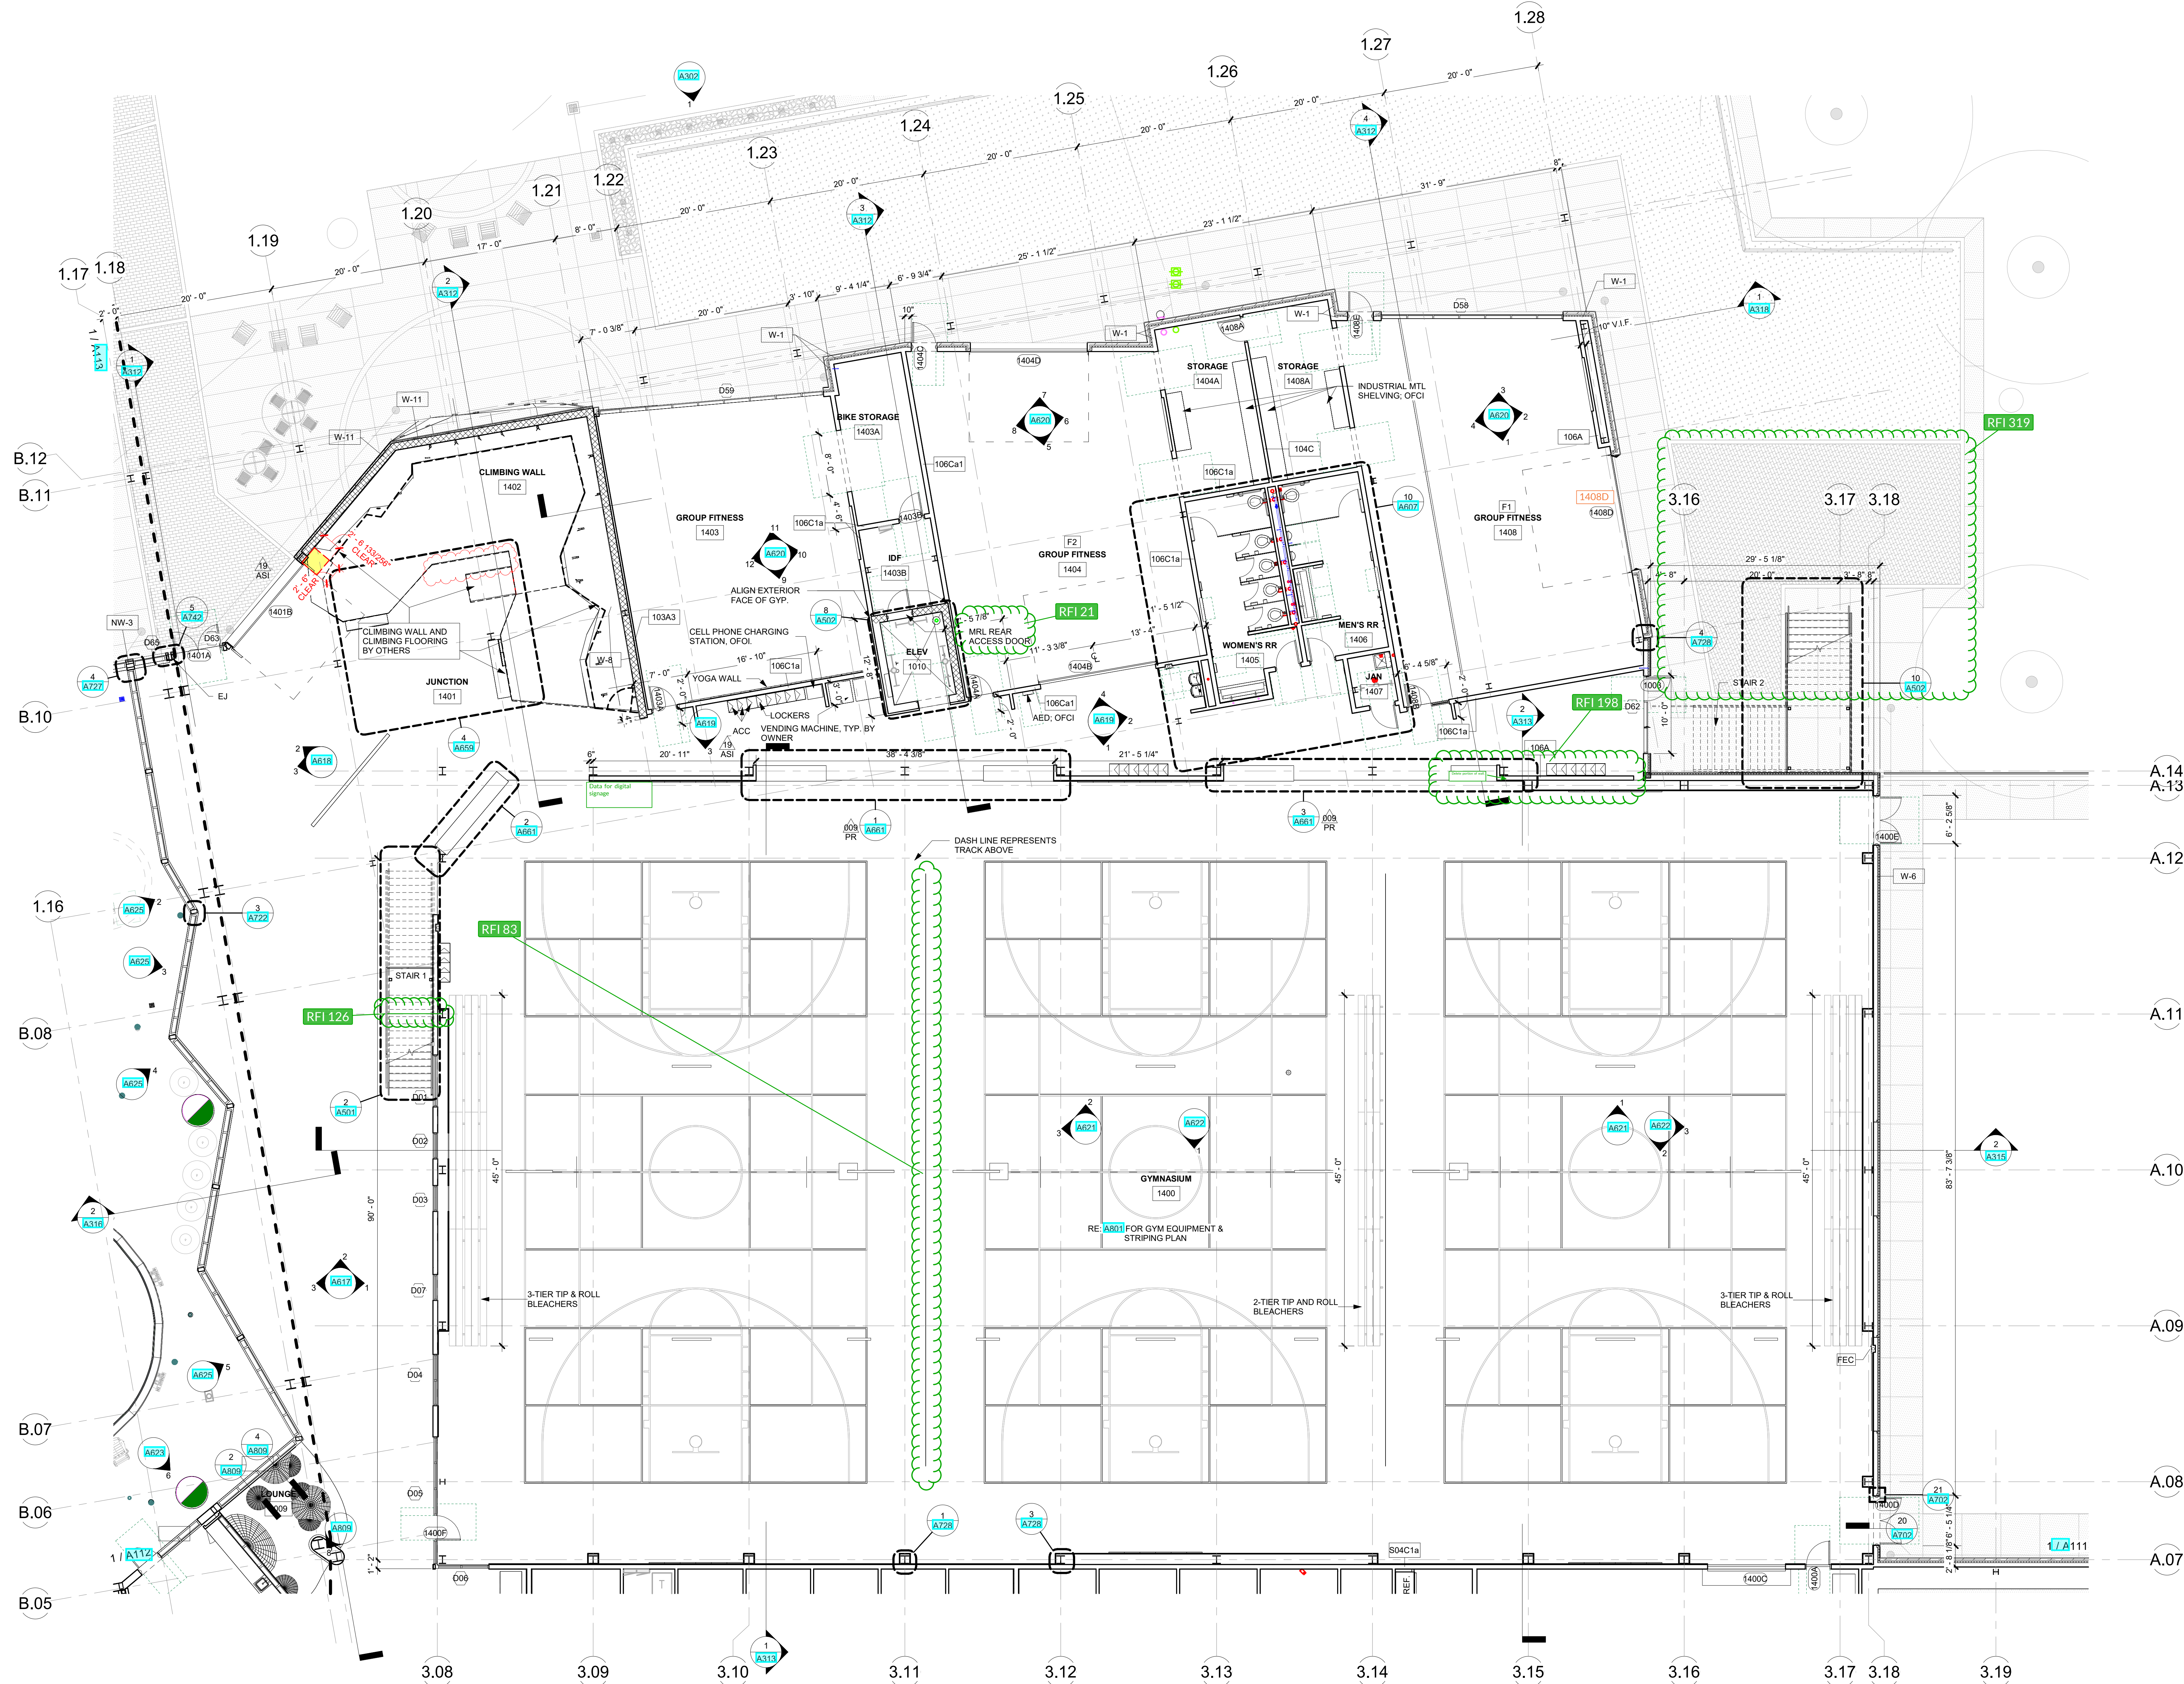
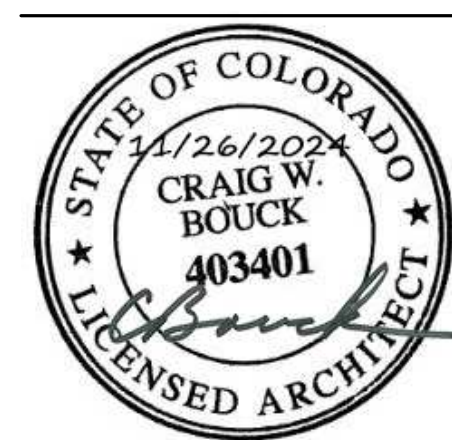


11/24/2025 2:43:54 PM Autodesk Docs://Grand Junction Community Recreation Center/GJCRC_ARCH_R24.rvt

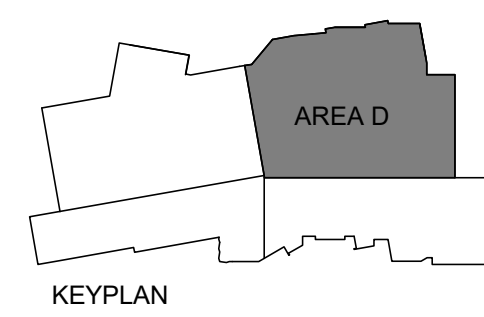

1
A114
FIRST FLOOR PLAN - AREA D
1/8" = 1'-0"

0 4' 8' 16'

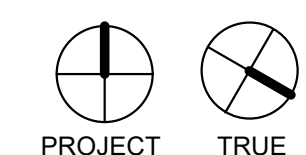

Project Number:	2023.024	
Issue:	CONFORMANCE SET	
Date:	11/26/2024	
Drawn By:	LSB	
Checked By:	MK	
Revisions:		
Rev.	Description	Date:
1	Addendum #1	2024.08.15
2	Addendum #2	2024.08.29
3	Addendum #3	2024.09.25
4	Addendum #4	2024.11.26
39	ASI #019	2025.06.05
56	PR-009	2025.09.25
65	PR-017	2025.11.24

Sheet title:
FIRST FLOOR PLAN - AREA D