

FEE \$	10.00
TCP \$	0
SIF \$	292.00

PLANNING CLEARANCE
(Single Family Residential and Accessory Structures)
Community Development Department

BLDG PERMIT NO. _____



Your Bridge to a Better Community

BLDG ADDRESS 2536 Applewood PL. SQ. FT. OF PROPOSED BLDGS/ADDITION 2394

TAX SCHEDULE NO. 2945-011-05-001 SQ. FT. OF EXISTING BLDGS 0

SUBDIVISION Apple blossom TOTAL SQ. FT. OF EXISTING & PROPOSED 2394

FILING _____ BLK 2 LOT 1 NO. OF DWELLING UNITS:
Before: 0 After: 1 this Construction

(1) OWNER Lowell + Rhonda Huscusson NO. OF BUILDINGS ON PARCEL
Before: 0 After: 1 this Construction

(1) ADDRESS 2786 Cortland Ct. USE OF EXISTING BUILDINGS Residence

(1) TELEPHONE 245 5227 DESCRIPTION OF WORK & INTENDED USE _____

(2) APPLICANT owner TYPE OF HOME PROPOSED:
 Site Built _____ Manufactured Home (UBC)
_____ Manufactured Home (HUD)
_____ Other (please specify) _____

(2) ADDRESS _____

(2) TELEPHONE _____

REQUIRED: One plot plan, on 8 1/2" x 11" paper, showing all existing & proposed structure location(s), parking, setbacks to all property lines, ingress/egress to the property, driveway location & width & all easements & rights-of-way which abut the parcel.

THIS SECTION TO BE COMPLETED BY COMMUNITY DEVELOPMENT DEPARTMENT STAFF

ZONE RSF-4 Maximum coverage of lot by structures 50%

SETBACKS: Front 20' from property line (PL) Permanent Foundation Required: YES NO _____
or _____ from center of ROW, whichever is greater

Side 7' from PL, Rear 25' from PL Parking Req'mt 2

Maximum Height 35' Special Conditions _____

CENSUS _____ TRAFFIC _____ ANN# _____

Modifications to this Planning Clearance must be approved, in writing, by the Community Development Department. The structure authorized by this application cannot be occupied until a final inspection has been completed and a Certificate of Occupancy has been issued, if applicable, by the Building Department (Section 305, Uniform Building Code).


I hereby acknowledge that I have read this application and the information is correct; I agree to comply with any and all codes, ordinances, laws, regulations or restrictions which apply to the project. I understand that failure to comply shall result in legal action, which may include but not necessarily be limited to non-use of the building(s).

Applicant Signature Lowell Huscusson Date 7-23-03

Department Approval Gayle Anderson Date 7-23-03

Additional water and/or sewer tap fee(s) are required:	YES <input checked="" type="checkbox"/>	NO	W/O No. <u>16343</u>
Utility Accounting <u>No Answer</u>	Date <u>7-22-03</u>		

VALID FOR SIX MONTHS FROM DATE OF ISSUANCE (Section 9-3-2C Grand Junction Zoning & Development Code)

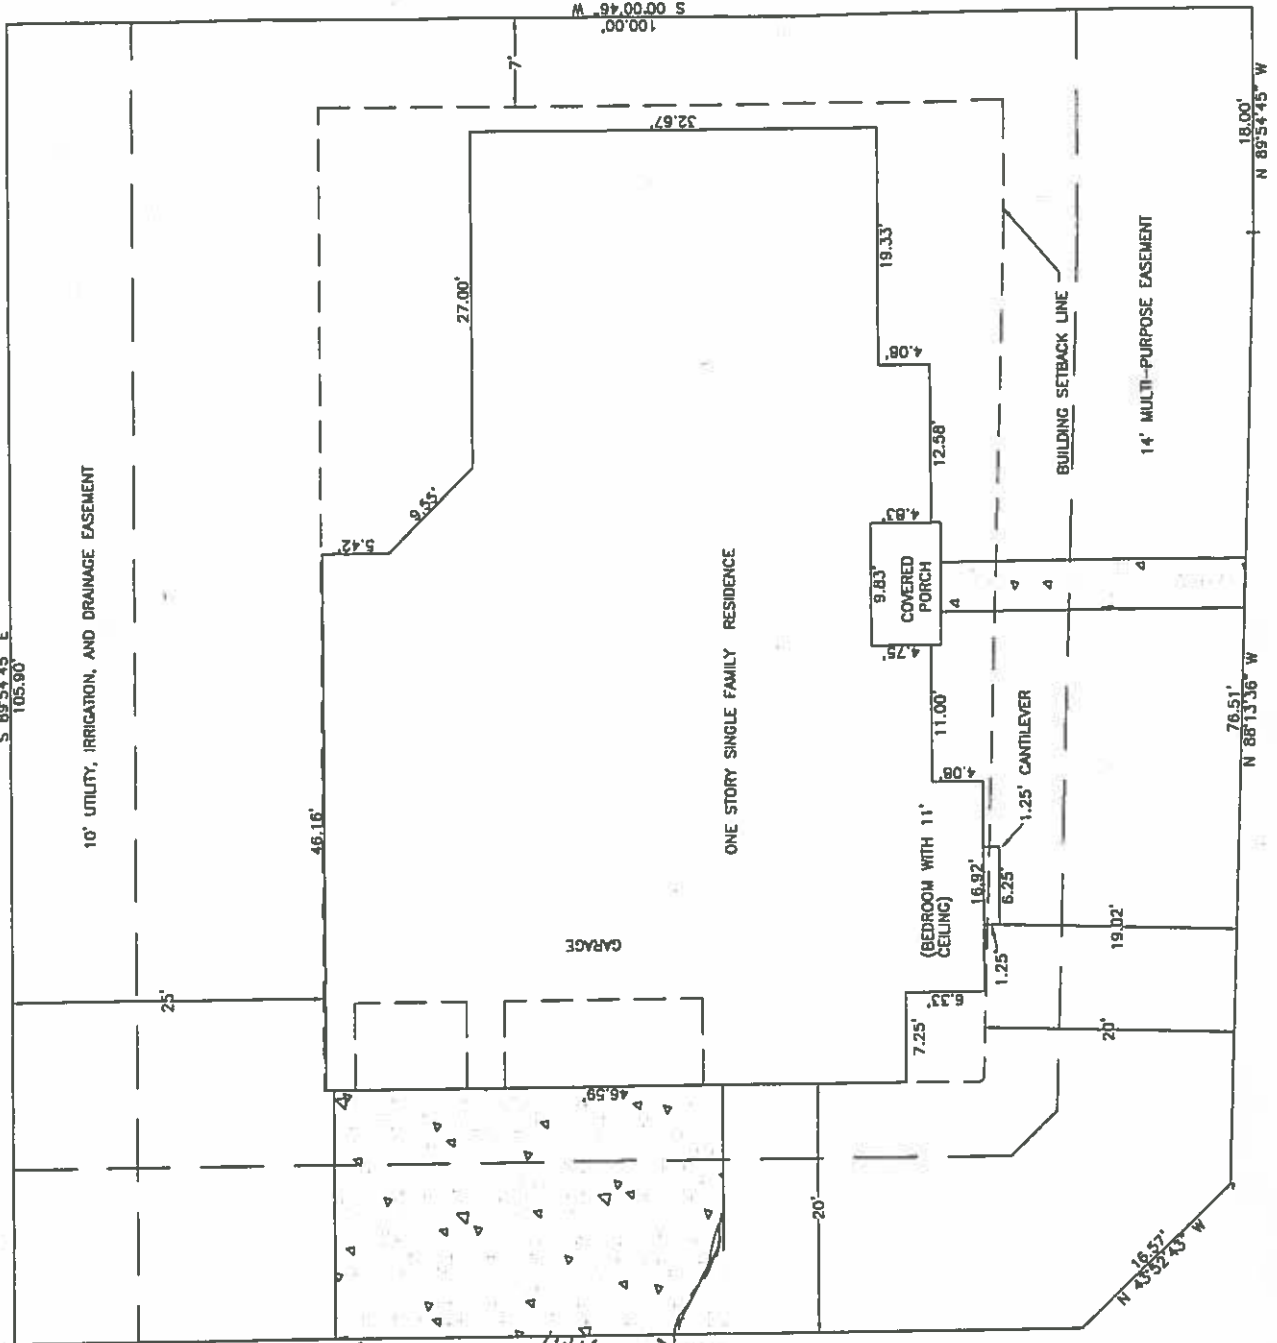

Applewood Place

7-23-03

Bayle Henderson

ACCEPTED
 ANY CHANGE OF SETBACKS MUST BE APPROVED BY THE CITY PLANNING DEPT. IT IS THE APPLICANT'S RESPONSIBILITY TO PROPERLY LOCATE AND IDENTIFY EASEMENTS AND PROPERTY LINES.

*Done OK
 Paul Davis
 7-23-03*