

DATE SUBMITTED: 6/20/85

PERMIT # _____

FEE 500

FENCE PERMIT

GRAND JUNCTION PLANNING DEPARTMENT

BLDG ADDRESS: 138 Santa Fe

TAX SCHEDULE #: 2945-121-07-001

PROPERTY OWNER: T. Dennis Price

PHONE: 242-7779


CONTRACTOR: owner

PHONE: same

MATERIAL: standard chain link fence

HEIGHT: 48"

* PLOT PLAN

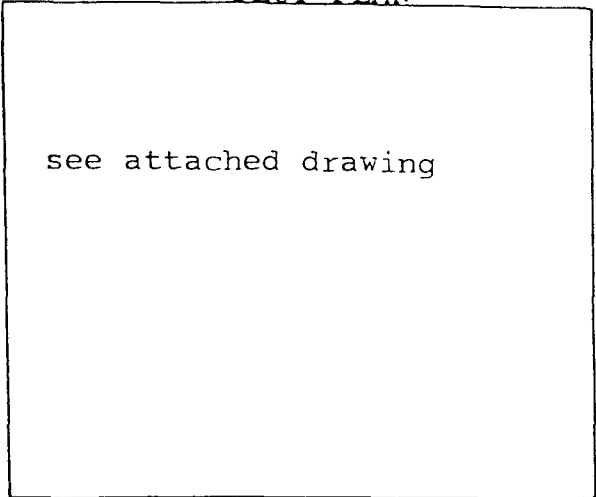


*Showing Property Line Dimensions, Easements, Streets, all Structures, and Setbacks from Property Lines.

FOR OFFICE USE ONLY


ZONE: _____

SETBACKS: F _____ S _____ R _____

SPECIAL CONDITIONS: Allowed to connect w/ city installed fence

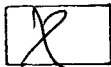

FINAL PERMIT

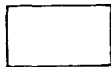

WILL REQUIRE SEPARATE PERMIT FROM THE CITY/COUNTY BUILDING DEPARTMENT.

ANY MODIFICATION TO THIS APPROVED FENCE PERMIT MUST BE APPROVED, IN WRITING, BY THIS DEPARTMENT.

I HEREBY ACKNOWLEDGE THAT I HAVE READ THIS APPLICATION AND THE ABOVE IS CORRECT, AND I AGREE TO COMPLY WITH THE REQUIREMENTS ABOVE. FAILURE TO COMPLY SHALL RESULT IN LEGAL ACTION.


T. Dennis Price
SIGNATURE

APPROVED BY: [Signature]

DATE APPROVED: 6/20/85

NW corner NE 1/4 NE 1/4
 Sec 12, T13, R1W, U.M.
 M.C.S.M. #279

Northeast corner
 Sec 12, T13, R1W, U.M.
 M.C.S.M. #36

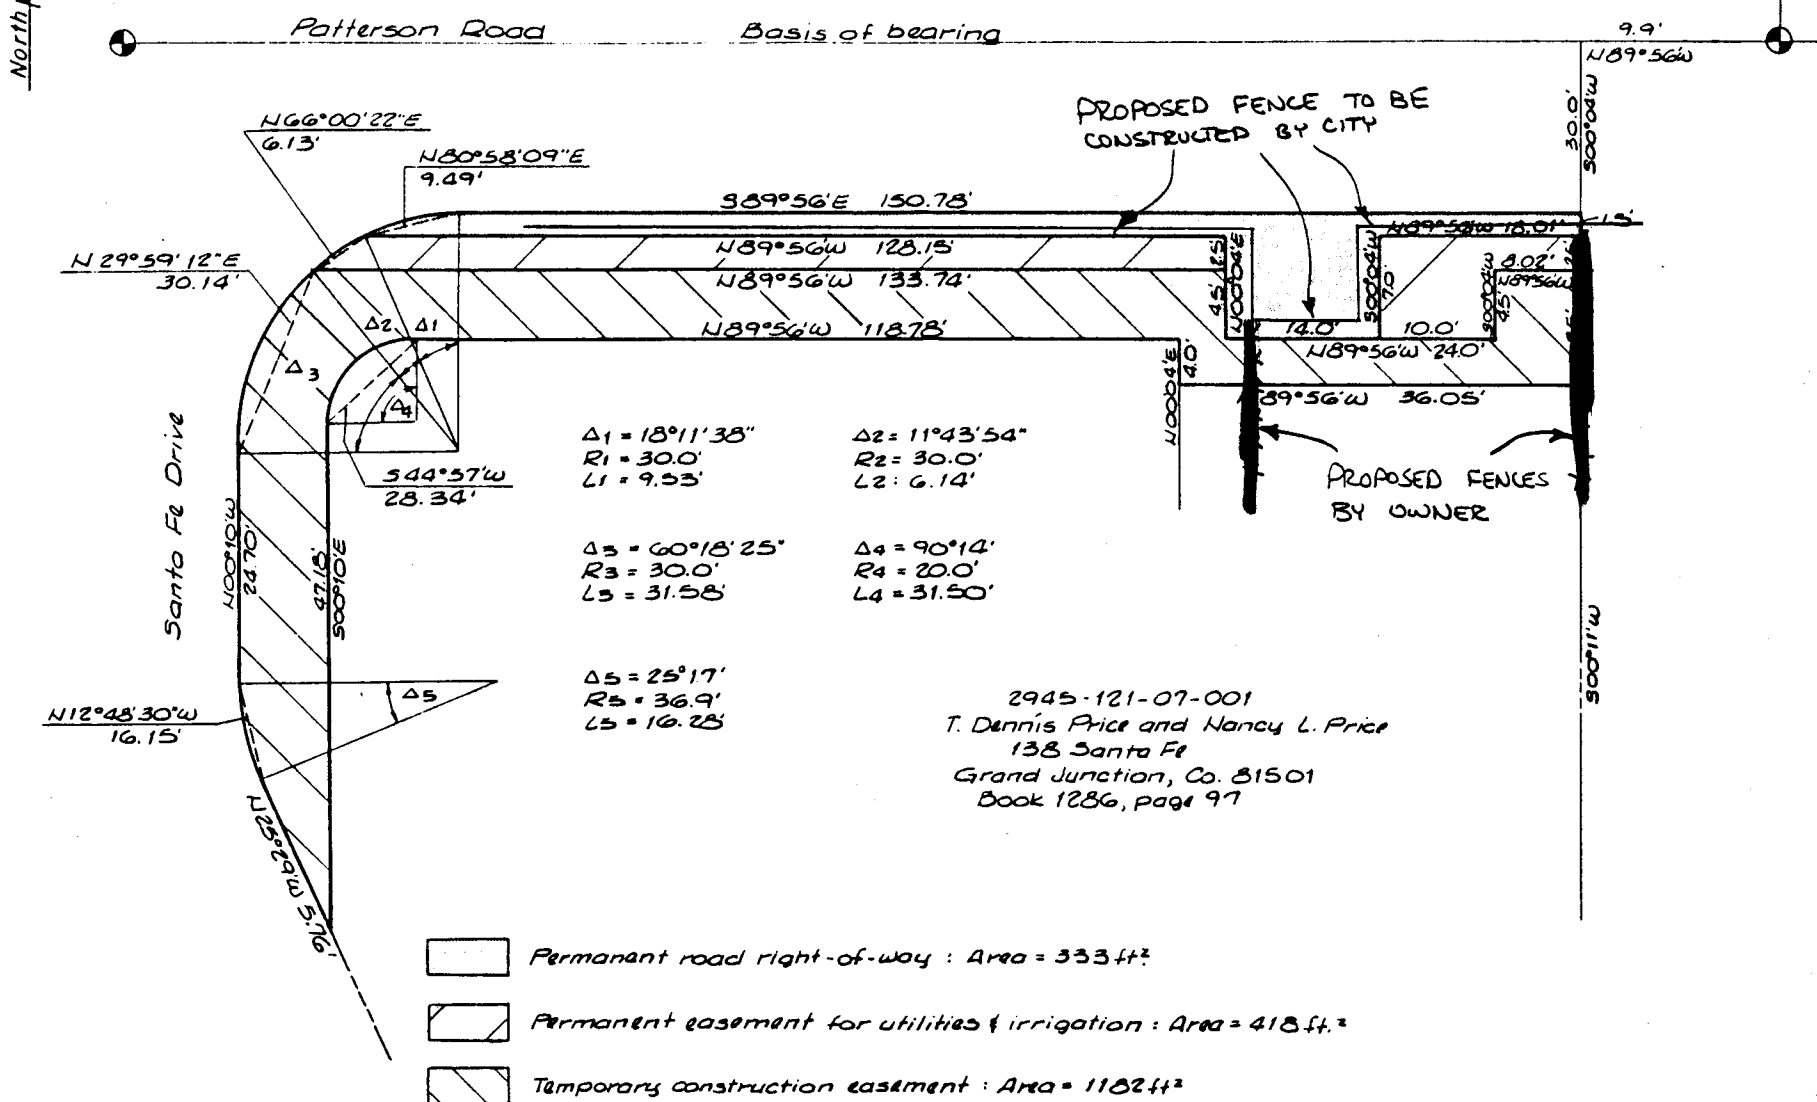

2945-121-07-001
 T. Dennis Price and Nancy L. Price
 138 Santa Fe
 Grand Junction, Co. 81501
 Book 1286, page 97

R.O.W. DESCRIPTION MAP PARCEL NO. <u>26118, 221-221A, 26323</u> APPROVED _____ DATE _____	CITY OF GRAND JUNCTION, COLORADO DEPT. OF PUBLIC WORKS & UTILITIES, ENGINEERING DIV. Patterson Road - 27 1/2 Road to 28 1/4 Road Right-of-way & Easements
--	--