

DATE SUBMITTED: 12/30/85

PERMIT # _____

FEE 5.00

FENCE PERMIT

GRAND JUNCTION PLANNING DEPARTMENT

BLDG ADDRESS: 473 28 1/2 Road

TAX SCHEDULE #: 2943-182 - 00-975

PROPERTY OWNER: Community Training Center

PHONE: 241-0001


CONTRACTOR: J. E. S. Fence Co. Inc.

PHONE: 243-2723

MATERIAL: Chain link

HEIGHT: 6'

* PLOT PLAN

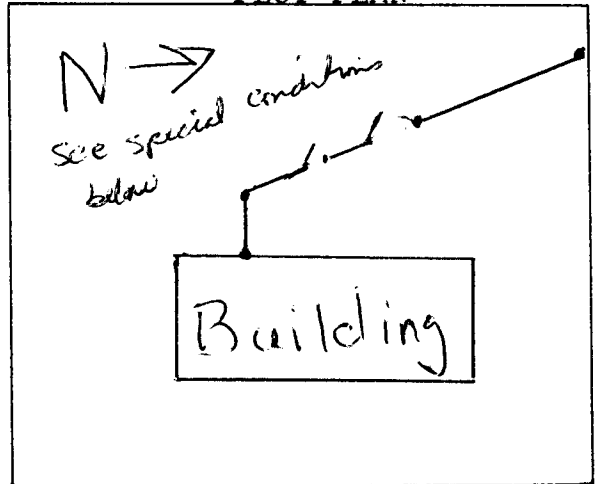

*Showing Property Line Dimensions, Easements, Streets, all Structures, and Setbacks from Property Lines.


FOR OFFICE USE ONLY

ZONE: C1

SETBACKS: F 40' S 0 R 0

SPECIAL CONDITIONS: As Per Previous

Discussion w/rep. from Community Training Center - fence must be within these lines

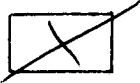

FINAL PERMIT



WILL REQUIRE SEPARATE PERMIT FROM THE CITY/COUNTY BUILDING DEPARTMENT.

ANY MODIFICATION TO THIS APPROVED FENCE PERMIT MUST BE APPROVED, IN WRITING, BY THIS DEPARTMENT.

I HEREBY ACKNOWLEDGE THAT I HAVE READ THIS APPLICATION AND THE ABOVE IS CORRECT, AND I AGREE TO COMPLY WITH THE REQUIREMENTS ABOVE. FAILURE TO COMPLY SHALL RESULT IN LEGAL ACTION.

Linda R. Wetzel
SIGNATURE

APPROVED BY: Linda Wetzel

DATE APPROVED: 12/30/85