

DATE SUBMITTED: 8-9-85

PERMIT # \_\_\_\_\_

FEE \$5.00

# FENCE PERMIT

GRAND JUNCTION PLANNING DEPARTMENT

BLDG ADDRESS: 640 N. 15<sup>th</sup>

TAX SCHEDULE #: 2945-132-05-003

PROPERTY OWNER: R.D. O'Connor

PHONE: 245-9375


CONTRACTOR: J & S Fence Co., Inc.

PHONE: 243-2723

MATERIAL: Chain link

HEIGHT: 6'

\* PLOT PLAN

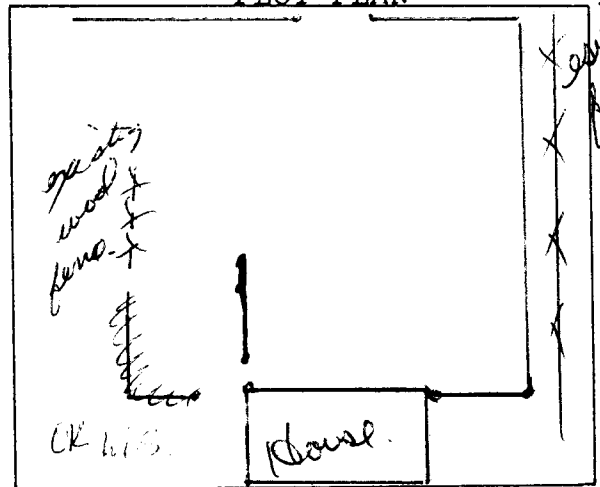

\*Showing Property Line Dimensions, Easements, Streets, all Structures, and Setbacks from Property Lines.

\*\*\*\*\*

### FOR OFFICE USE ONLY

ZONE: RSF 8

SETBACKS: F 50 S 3' R 3'

SPECIAL CONDITIONS: \_\_\_\_\_

FINAL PERMIT

WILL REQUIRE SEPARATE PERMIT FROM THE CITY/COUNTY BUILDING DEPARTMENT.

\*\*\*\*\*

ANY MODIFICATION TO THIS APPROVED FENCE PERMIT MUST BE APPROVED, IN WRITING, BY THIS DEPARTMENT.

I HEREBY ACKNOWLEDGE THAT I HAVE READ THIS APPLICATION AND THE ABOVE IS CORRECT, AND I AGREE TO COMPLY WITH THE REQUIREMENTS ABOVE. FAILURE TO COMPLY SHALL RESULT IN LEGAL ACTION.

[Signature]  
SIGNATURE

APPROVED BY: Kathy Portner (DW) MS

DATE APPROVED: 8/9/85