

DATE SUBMITTED: 3-6-86

PERMIT # _____

FEE 5.00

FENCE PERMIT

GRAND JUNCTION PLANNING DEPARTMENT

BLDG ADDRESS: 2876 Lexas

TAX SCHEDULE #: _____

PROPERTY OWNER: Claude Hathrop

PHONE: 241-5495


CONTRACTOR: J & S Fence Co. Inc.

PHONE: 243-2703

MATERIAL: Chain link

HEIGHT: 48"

* PLOT PLAN

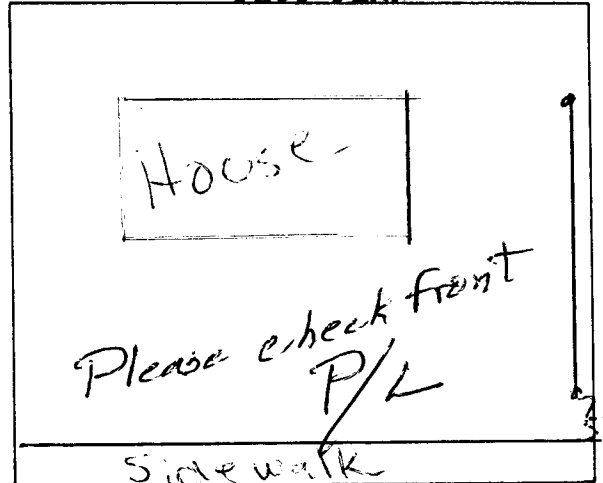

*Showing Property Line Dimensions, Easements, Streets, all Structures, and Setbacks from Property Lines.

FOR OFFICE USE ONLY

ZONE: RSF 8

SETBACKS: F PL S _____ R _____

SPECIAL CONDITIONS: _____

FINAL PERMIT

WILL REQUIRE SEPARATE PERMIT FROM THE CITY/COUNTY BUILDING DEPARTMENT.

ANY MODIFICATION TO THIS APPROVED FENCE PERMIT MUST BE APPROVED, IN WRITING, BY THIS DEPARTMENT.

I HEREBY ACKNOWLEDGE THAT I HAVE READ THIS APPLICATION AND THE ABOVE IS CORRECT, AND I AGREE TO COMPLY WITH THE REQUIREMENTS ABOVE. FAILURE TO COMPLY SHALL RESULT IN LEGAL ACTION.

[Handwritten Signature]
SIGNATURE

APPROVED BY: Don

DATE APPROVED: 3/6/86