

DATE SUBMITTED: 5-16-88


PERMIT # \_\_\_\_\_

FEE 5.00

# FENCE PERMIT

GRAND JUNCTION PLANNING DEPARTMENT

BLDG ADDRESS: 264 Laurelle  
 TAX SCHEDULE #: 2945-251-04-009  
 PROPERTY OWNER: Don Nichols  
 PHONE: 242-5530  
 CONTRACTOR: Self  
 PHONE: \_\_\_\_\_  
 MATERIAL: Cedar Split Rail  
 HEIGHT: 4' 2 Rails

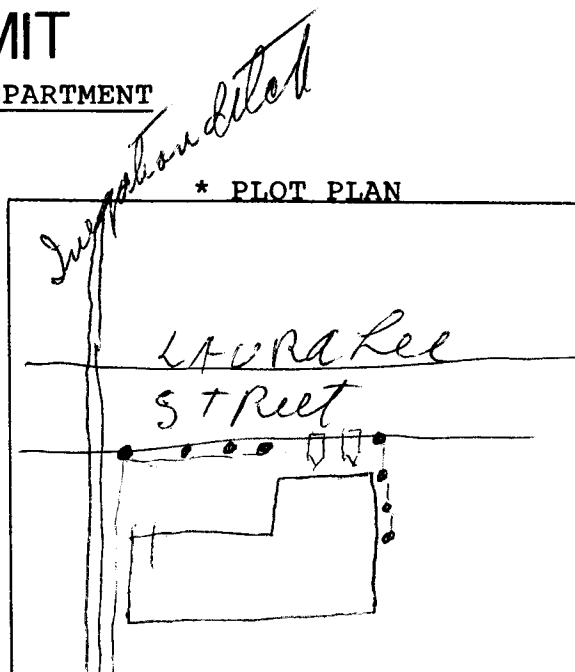

\*Showing Property Line Dimensions, Easements, Streets, all Structures, and Setbacks from Property Lines.

\*\*\*\*\*  
 FOR OFFICE USE ONLY

ZONE: RSP-d

SETBACKS: F PL S PL R PL

SPECIAL CONDITIONS: Fence to be 2/3 open

FINAL PERMIT

WILL REQUIRE SEPARATE PERMIT FROM THE CITY/COUNTY BUILDING DEPARTMENT.

\*\*\*\*\*

ANY MODIFICATION TO THIS APPROVED FENCE PERMIT MUST BE APPROVED, IN WRITING, BY THIS DEPARTMENT.

I HEREBY ACKNOWLEDGE THAT I HAVE READ THIS APPLICATION AND THE ABOVE IS CORRECT, AND I AGREE TO COMPLY WITH THE REQUIREMENTS ABOVE. FAILURE TO COMPLY SHALL RESULT IN LEGAL ACTION.

Don Nichols  
 SIGNATURE

APPROVED BY: Linda

DATE APPROVED: 5-16-88