

DATE SUBMITTED: 05-02-89


PERMIT # _____

FEE \$5.00

FENCE PERMIT

GRAND JUNCTION PLANNING DEPARTMENT

BLDG ADDRESS: 2635 Gunnison
 TAX SCHEDULE #: 2945-137-08-002
 PROPERTY OWNER: Mary Simple
 PHONE: 245-1572
 CONTRACTOR: J & J Fence Co.
 PHONE: 243-2723
 MATERIAL: Chain Link
 HEIGHT: 48"

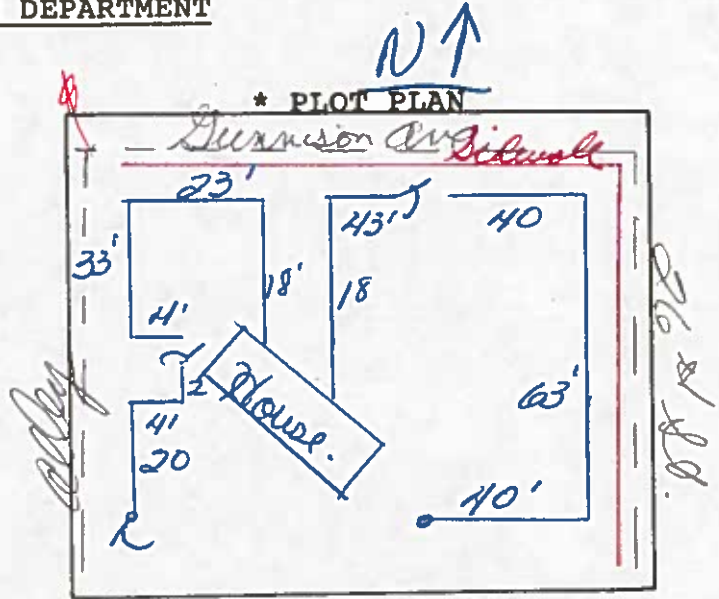

*Showing Property Line Dimensions, Easements, Streets, all Structures, and Setbacks from Property Lines.

All fence on established property lines, setback from edge of sidewalk 9'.

FOR OFFICE USE ONLY

ZONE: RSF-R

SETBACKS: F _____ S PL R PL

SPECIAL CONDITIONS: Corner lots shall meet 2 front yard setbacks
Chain link to remain open



FINAL PERMIT



WILL REQUIRE SEPARATE PERMIT FROM THE CITY/COUNTY BUILDING DEPARTMENT.

ANY MODIFICATION TO THIS APPROVED FENCE PERMIT MUST BE APPROVED, IN WRITING, BY THIS DEPARTMENT.

I HEREBY ACKNOWLEDGE THAT I HAVE READ THIS APPLICATION AND THE ABOVE IS CORRECT, AND I AGREE TO COMPLY WITH THE REQUIREMENTS ABOVE. FAILURE TO COMPLY SHALL RESULT IN LEGAL ACTION.

Chris Sussemeto
SIGNATURE

APPROVED BY: Linda Wetzel

DATE APPROVED: 5/5/89