

DATE SUBMITTED: (X) 3/28/09

PERMIT # _____

FEE \$5.00

FENCE PERMIT

GRAND JUNCTION PLANNING DEPARTMENT

BLDG ADDRESS: (X) 2715 9th Ct

TAX SCHEDULE #: _____

PROPERTY OWNER: (X) Mary A. Robinson


PHONE: (X) 242-3825

CONTRACTOR: (X) Family

PHONE: (X) _____

MATERIAL: (X) Wood picket fence

HEIGHT: (X) 6'

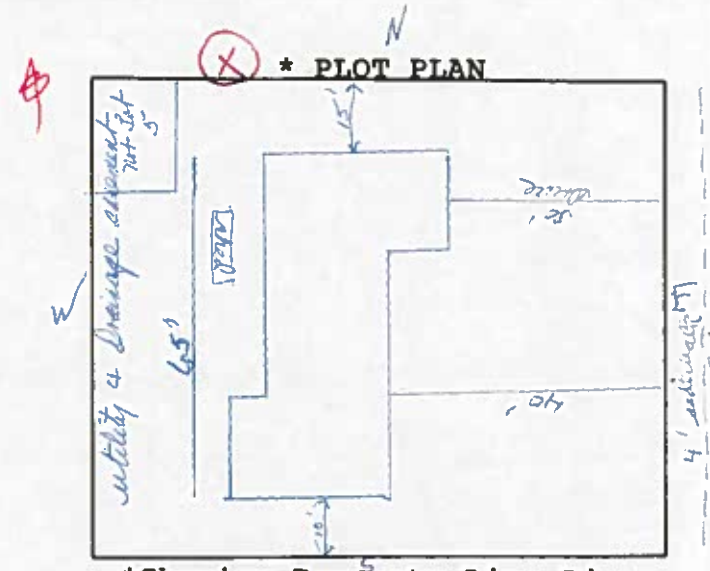

*Showing Property Line Dimensions, Easements, Streets, all Structures, and Setbacks from Property Lines.

FOR OFFICE USE ONLY

ZONE: Rsf-4

SETBACKS: F 20' S 0' R 0'

SPECIAL CONDITIONS: 6 WOOD
Fence must remain 20 feet from Property line in front yard

FINAL PERMIT

WILL REQUIRE SEPARATE PERMIT FROM THE CITY/COUNTY BUILDING DEPARTMENT.

ANY MODIFICATION TO THIS APPROVED FENCE PERMIT MUST BE APPROVED, IN WRITING, BY THIS DEPARTMENT.

I HEREBY ACKNOWLEDGE THAT I HAVE READ THIS APPLICATION AND THE ABOVE IS CORRECT, AND I AGREE TO COMPLY WITH THE REQUIREMENTS ABOVE. FAILURE TO COMPLY SHALL RESULT IN LEGAL ACTION.

(X) Mary A. Robinson
SIGNATURE

APPROVED BY: Linda Watzel

DATE APPROVED: 3/28/09