

DATE SUBMITTED: 11/12/90


PERMIT # _____

FEE 5.00

FENCE PERMIT

GRAND JUNCTION PLANNING DEPARTMENT

BLDG ADDRESS: 2060 Main St
 TAX SCHEDULE #: 2945-134-00-012
 PROPERTY OWNER: Motorcycles
 PHONE: 242-9495
 CONTRACTOR: J+S Fence Co Inc
 PHONE: 243-2723
 MATERIAL: Chain Link
 HEIGHT: 72" w barbed wire

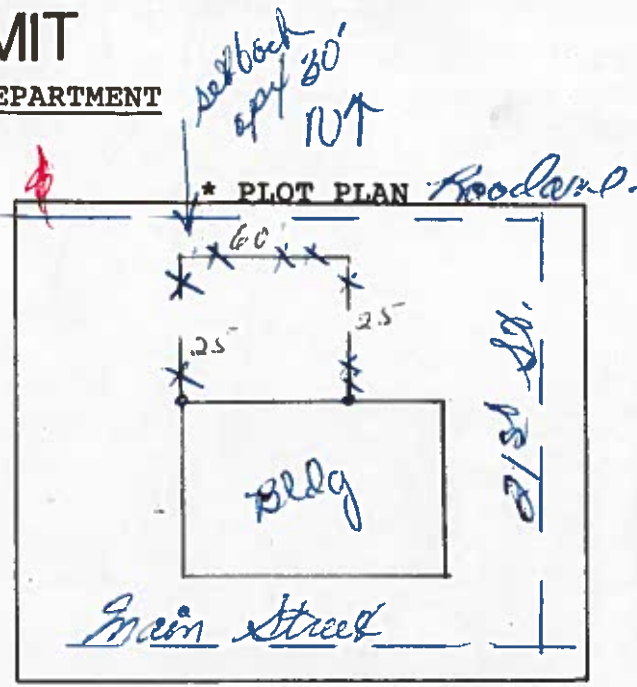

*Showing Property Line Dimensions, Easements, Streets, all Structures, and Setbacks from Property Lines.

FOR OFFICE USE ONLY

ZONE: C-2

SETBACKS: F PL S PL R PL

SPECIAL CONDITIONS: _____

FINAL PERMIT

WILL REQUIRE SEPARATE PERMIT FROM THE CITY/COUNTY BUILDING DEPARTMENT.

ANY MODIFICATION TO THIS APPROVED FENCE PERMIT MUST BE APPROVED, IN WRITING, BY THIS DEPARTMENT.

I HEREBY ACKNOWLEDGE THAT I HAVE READ THIS APPLICATION AND THE ABOVE IS CORRECT, AND I AGREE TO COMPLY WITH THE REQUIREMENTS ABOVE. FAILURE TO COMPLY SHALL RESULT IN LEGAL ACTION.

Chris Susemiho
SIGNATURE

APPROVED BY: B. Paulson

DATE APPROVED: 11/15/90