

DATE SUBMITTED: 3/13/91

PERMIT # _____

FEE 500

FENCE PERMIT

GRAND JUNCTION PLANNING DEPARTMENT

BLDG ADDRESS: 4055 MAUREEN ST

TAX SCHEDULE #: 2945-011-44-001

PROPERTY OWNER: GORDON W MOORE


PHONE: 242-9279, 244-1266 (WORK)

CONTRACTOR: SELF

PHONE: _____

MATERIAL: CEDAR

HEIGHT: 5' AT SIDE YARD; 6' AT PATIO SCREEN;
6' BETWEEN GARAGE + EXISTING 6' FENCE ON NORTH SIDE.

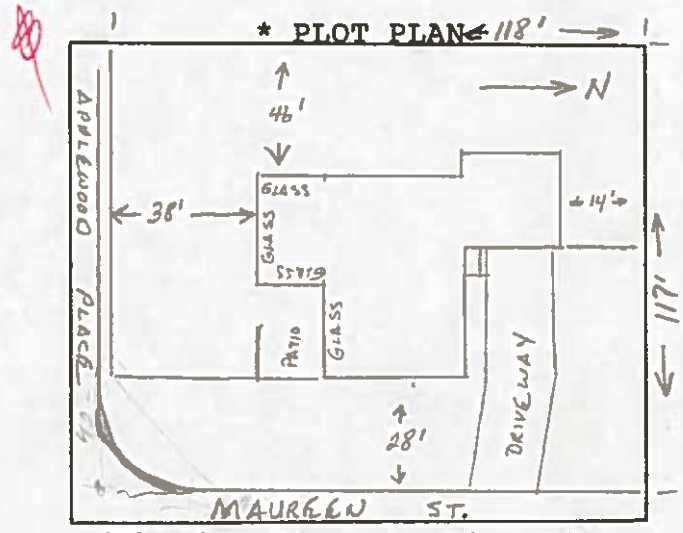

*Showing Property Line Dimensions, Easements, Streets, all Structures, and Setbacks from Property Lines.

FOR OFFICE USE ONLY

ZONE: PR

SETBACKS: F S R

SPECIAL CONDITIONS: MAINTAIN 40'

SHORT DISTANCE TRIANGLE AT INTERSECTION.

FINAL PERMIT

WILL REQUIRE SEPARATE PERMIT FROM THE CITY/COUNTY BUILDING DEPARTMENT.

ANY MODIFICATION TO THIS APPROVED FENCE PERMIT MUST BE APPROVED, IN WRITING, BY THIS DEPARTMENT.

I HEREBY ACKNOWLEDGE THAT I HAVE READ THIS APPLICATION AND THE ABOVE IS CORRECT, AND I AGREE TO COMPLY WITH THE REQUIREMENTS ABOVE. FAILURE TO COMPLY SHALL RESULT IN LEGAL ACTION.

Gordon W Moore
SIGNATURE

APPROVED BY: [Signature]

DATE APPROVED: 3/13/91