

DATE SUBMITTED: 8/3/93

PERMIT # _____

FEE 5.00

FENCE PERMIT

GRAND JUNCTION PLANNING DEPARTMENT

BLDG ADDRESS: 270 S. 13th St.

* PLOT PLAN

TAX SCHEDULE #: 2945-133-18-001

PROPERTY OWNER: Head Start (Lease)


PHONE: _____

CONTRACTOR: SAN CROWEZ

PHONE: 245-4701

MATERIAL: Chain Link Fence

HEIGHT: 4'

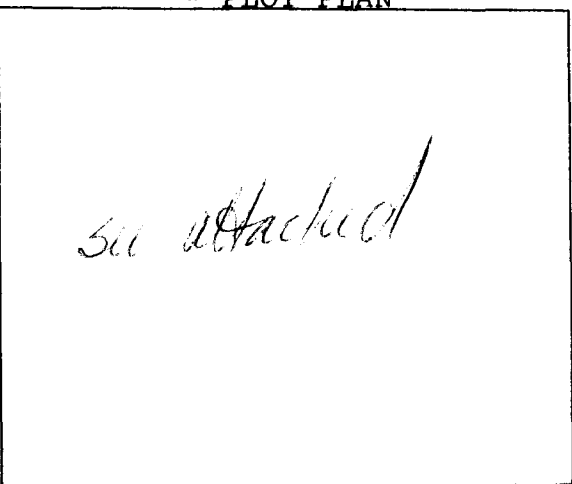

*Showing Property Line Dimensions, Easements, Streets, all Structures, and Setbacks from Property Lines.

FOR OFFICE USE ONLY

ZONE: B-1

SETBACKS: F property line S _____ R _____

SPECIAL CONDITIONS: -

FINAL PERMIT

WILL REQUIRE SEPARATE PERMIT FROM THE CITY/COUNTY BUILDING DEPARTMENT.


ANY MODIFICATION TO THIS APPROVED FENCE PERMIT MUST BE APPROVED, IN WRITING, BY THIS DEPARTMENT.

I HEREBY ACKNOWLEDGE THAT I HAVE READ THIS APPLICATION AND THE ABOVE IS CORRECT, AND I AGREE TO COMPLY WITH THE REQUIREMENTS ABOVE. FAILURE TO COMPLY SHALL RESULT IN LEGAL ACTION.

SIGNATURE

APPROVED BY: Lobby Vetter

DATE APPROVED: 8/3/93

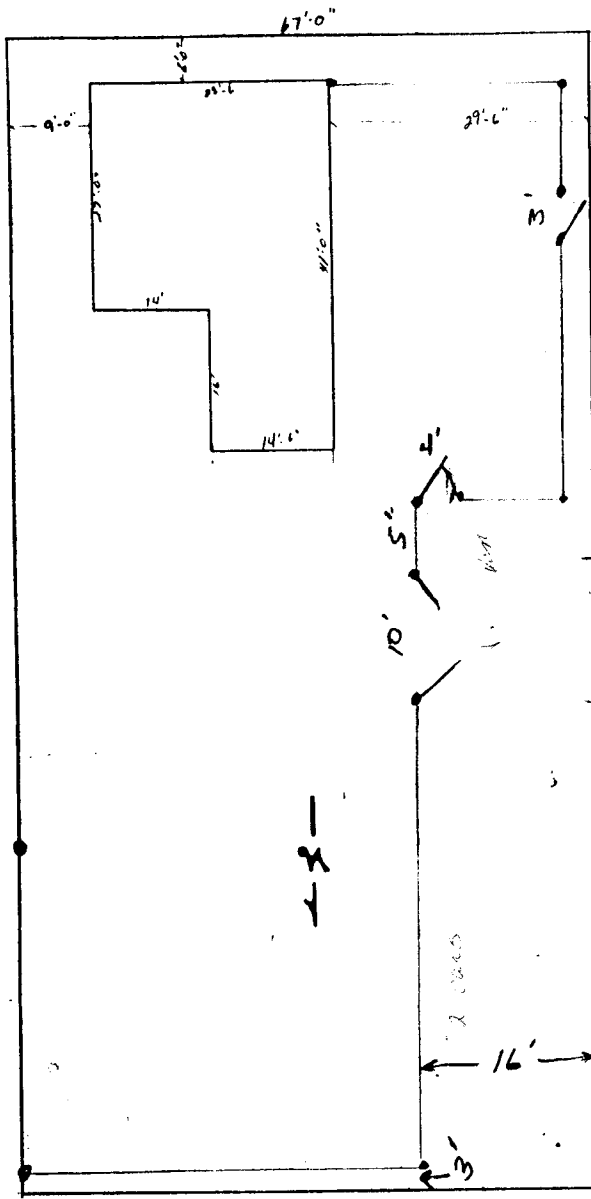


Plot Plan 1"=10'
Scale

Chattanooga

Sidewalk

1371 13th St.

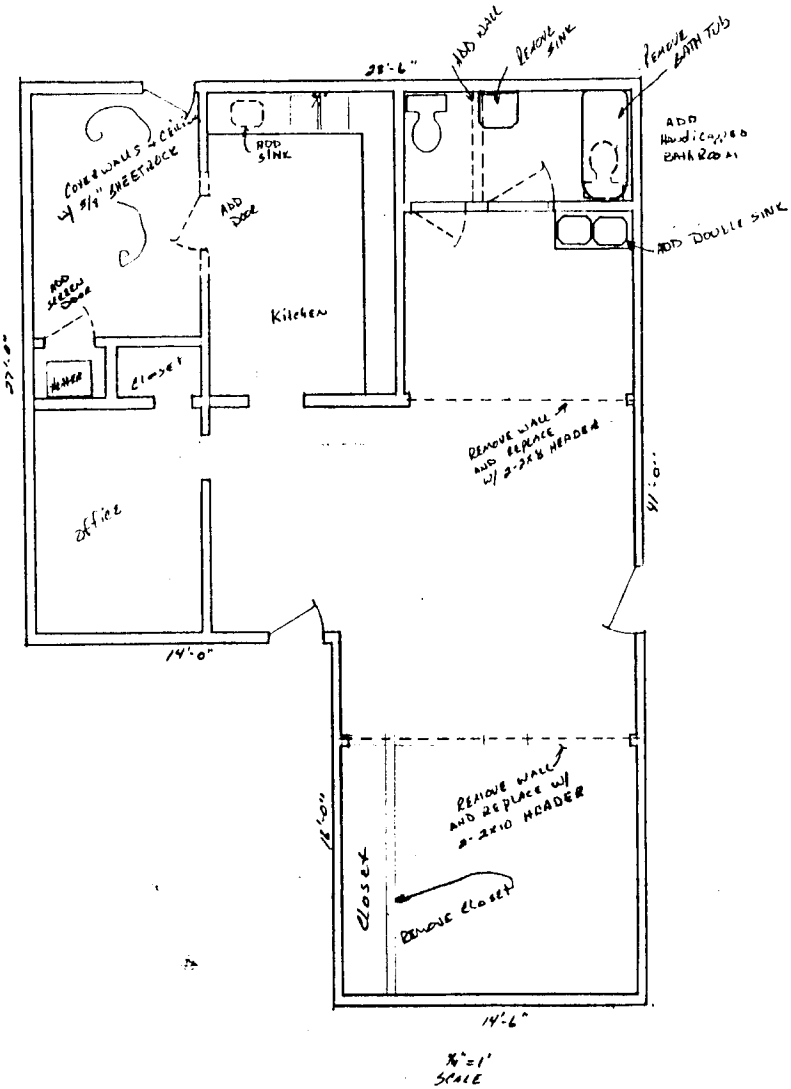

215-4701

Rocky Mountain S.E.R. Head Start		
DATE	APPROVED BY	DRAWN BY
7-18-93		SAW
220 S. 13th ST.		
Grand Junction, Co. 8150.		