

DATE SUBMITTED: 11-18-92

PERMIT # _____

FEE 5.00

FENCE PERMIT

GRAND JUNCTION PLANNING DEPARTMENT

BLDG ADDRESS: 4300 27 1/2 Rd.

TAX SCHEDULE #: 2945-01-46-027

PROPERTY OWNER: Jerry King

PHONE: 242-4015


CONTRACTOR: Taylor Fence Company

PHONE: 241-1473

MATERIAL: Wood / Chain Link

HEIGHT: 6'

* PLOT PLAN

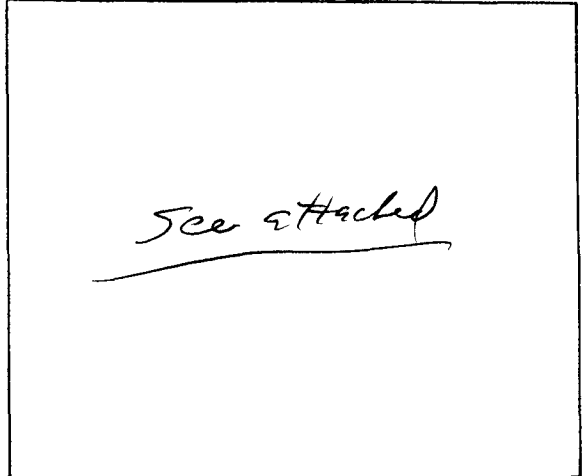

*Showing Property Line Dimensions, Easements, Streets, all Structures, and Setbacks from Property Lines.

FOR OFFICE USE ONLY

ZONE: PR 7.2

SETBACKS: F 20' S 5' R 5'

SPECIAL CONDITIONS: _____



FINAL PERMIT



WILL REQUIRE SEPARATE PERMIT FROM THE CITY/COUNTY BUILDING DEPARTMENT.

ANY MODIFICATION TO THIS APPROVED FENCE PERMIT MUST BE APPROVED, IN WRITING, BY THIS DEPARTMENT.

I HEREBY ACKNOWLEDGE THAT I HAVE READ THIS APPLICATION AND THE ABOVE IS CORRECT, AND I AGREE TO COMPLY WITH THE REQUIREMENTS ABOVE. FAILURE TO COMPLY SHALL RESULT IN LEGAL ACTION.

APPROVED BY: [Signature]


[Signature]
SIGNATURE

DATE APPROVED: 11-18-92

1 VS 0

20" Water off Line
Line

Water Line 20" in off property Line
Cedar

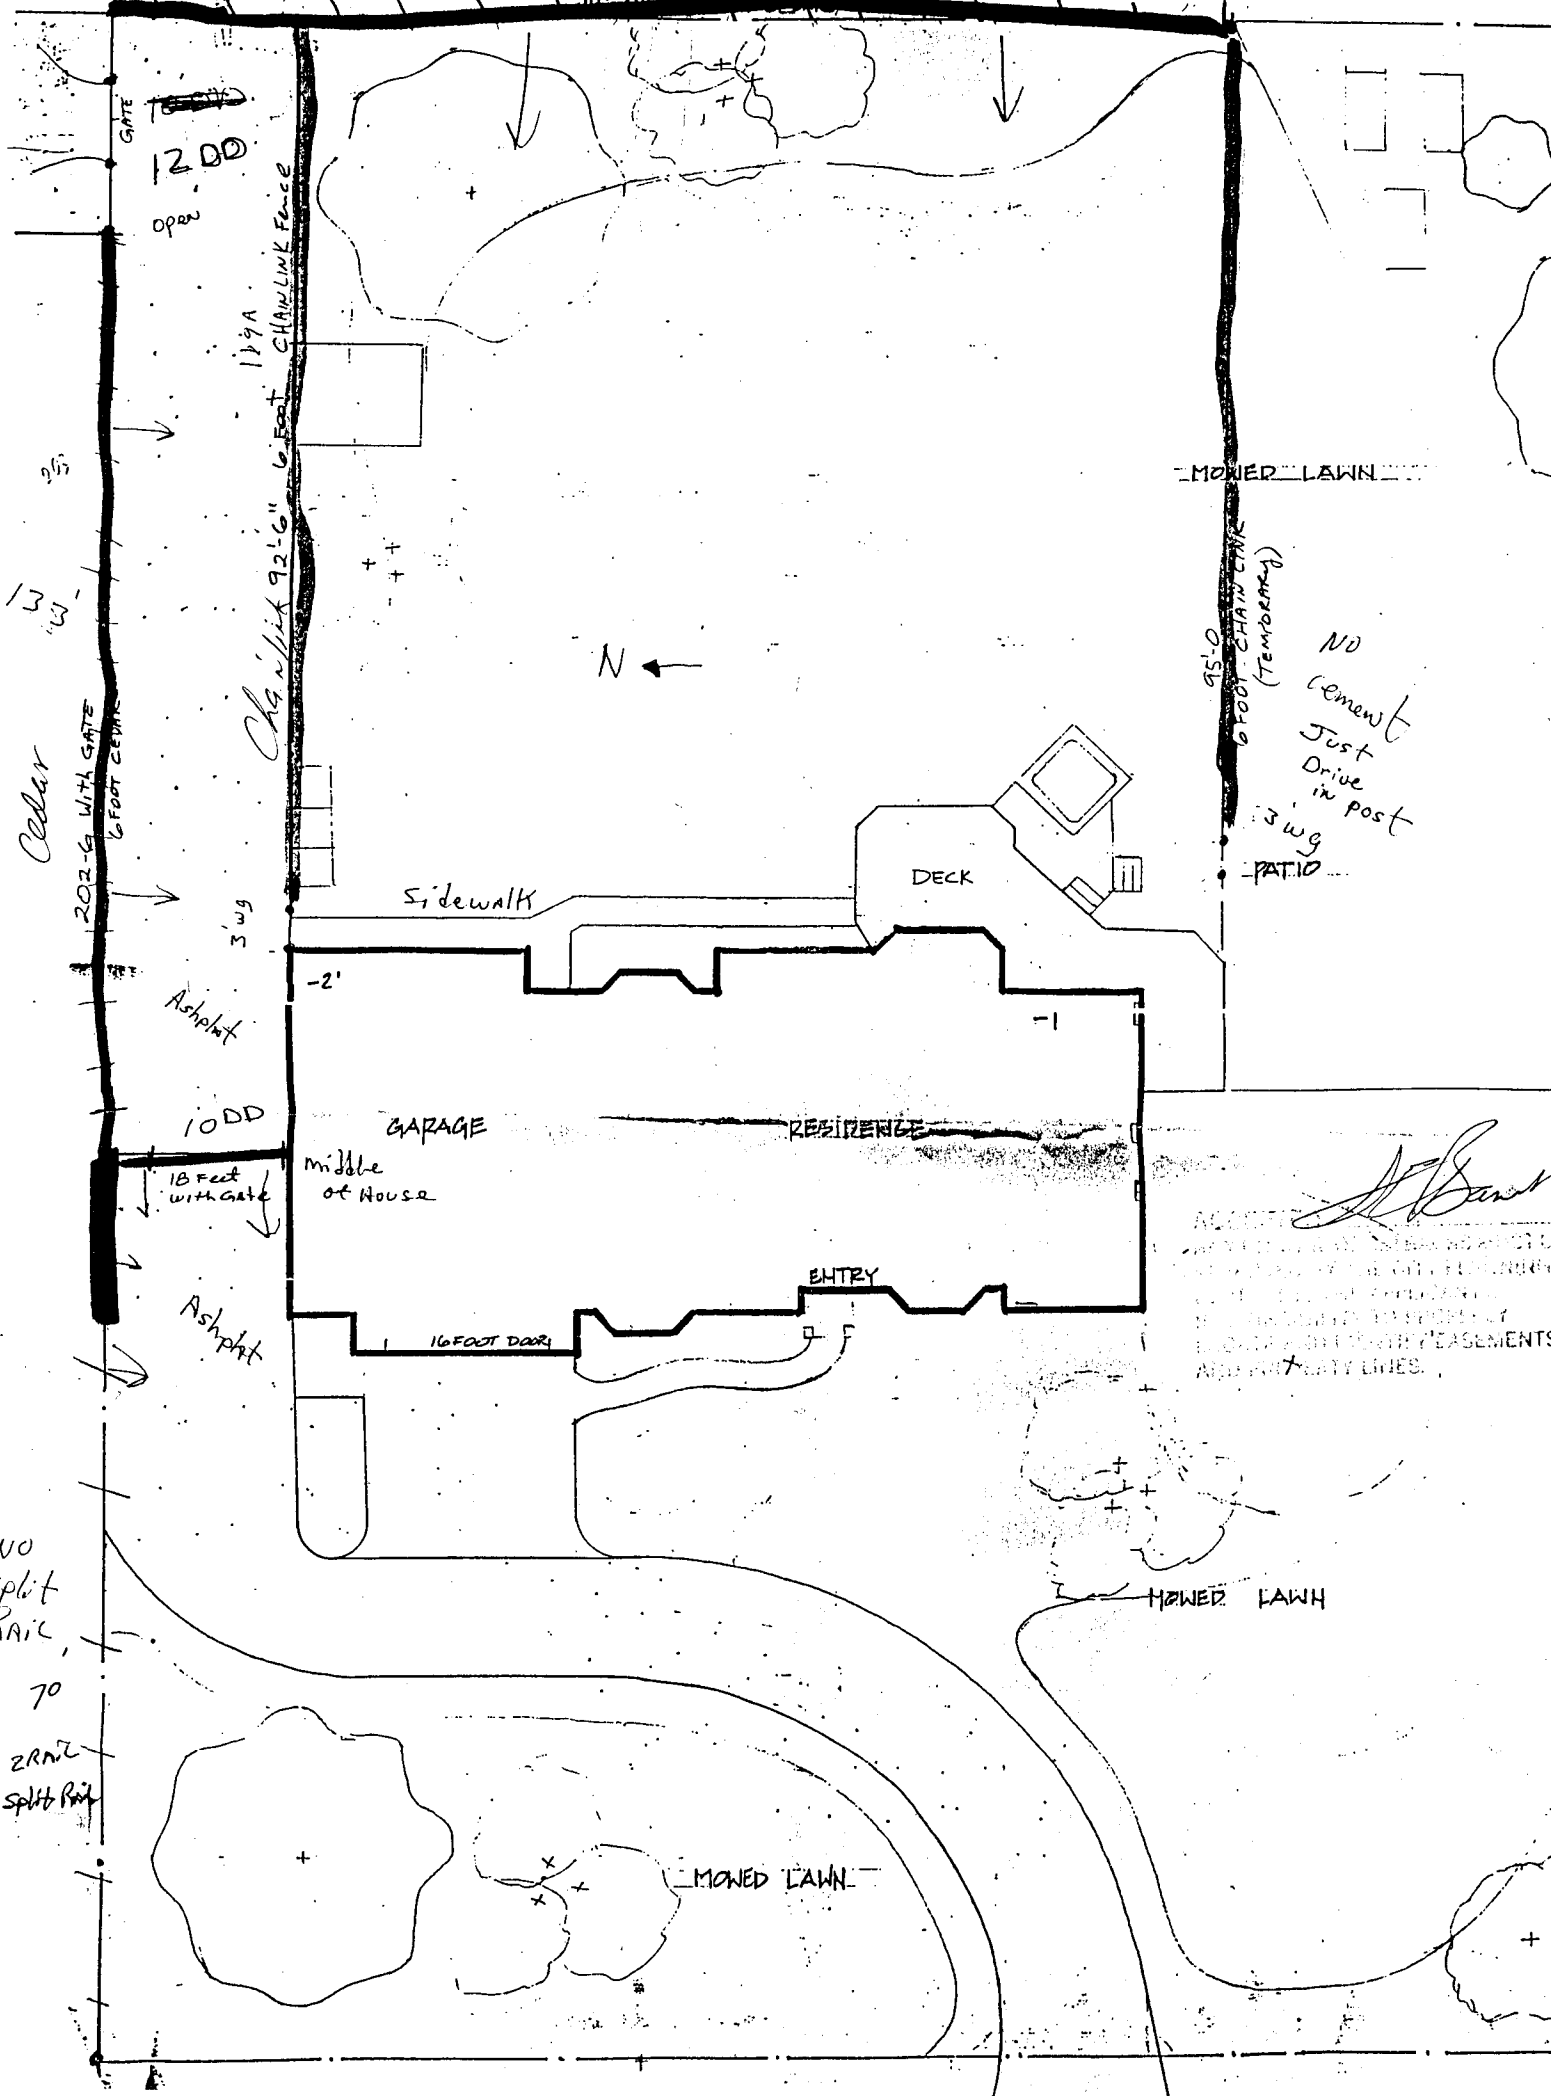

NO
Cement
Just
Drive
in post
3' w/g
PATIO

[Signature]
ACCEPTED
I hereby certify that the above is a true and correct copy of the original plan as shown to me by the owner and that I have not made any alterations or additions thereto.
DATE: _____
BY: _____
REGISTERED PROFESSIONAL SURVEYOR
NO. _____ STATE OF _____
ADDRESS: _____

2 Rail SR
6' Cedar
6' chainlink