

DATE SUBMITTED: 3/4/92

5' Existing Fence

PERMIT # \_\_\_\_\_

FEE 5.00

# FENCE PERMIT

## GRAND JUNCTION PLANNING DEPARTMENT

BLDG ADDRESS: 740-742 Bunting Ave.

TAX SCHEDULE #: 2945-114-15-026

PROPERTY OWNER: CURTIS M OTTO


PHONE: 243-9408

CONTRACTOR: Self

PHONE: \_\_\_\_\_

MATERIAL: Cedar Wood

HEIGHT: 6'

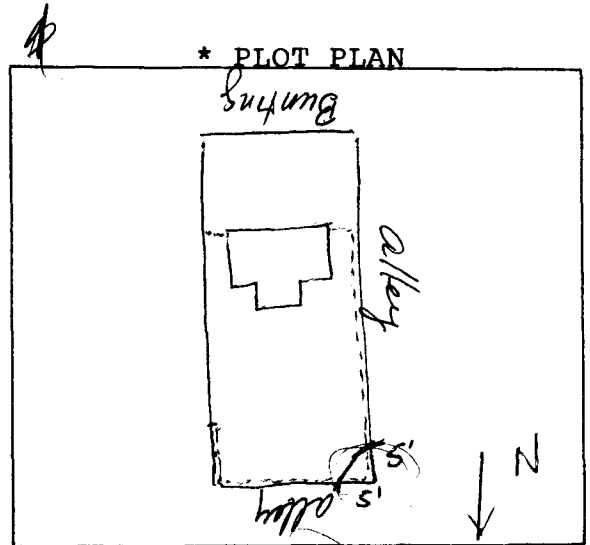

\*Showing Property Line Dimensions, Easements, Streets, all Structures, and Setbacks from Property Lines.


Five foot triangle required -  
Fence to be placed on existing  
Fence line.

\*\*\*\*\*  
**FOR OFFICE USE ONLY**

ZONE: RSF-8

SETBACKS: F \_\_\_\_\_ S \_\_\_\_\_ R \_\_\_\_\_

SPECIAL CONDITIONS: \_\_\_\_\_

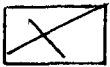

FINAL PERMIT



WILL REQUIRE SEPARATE PERMIT FROM THE CITY/COUNTY BUILDING DEPARTMENT.

\*\*\*\*\*

ANY MODIFICATION TO THIS APPROVED FENCE PERMIT MUST BE APPROVED, IN WRITING, BY THIS DEPARTMENT.

I HEREBY ACKNOWLEDGE THAT I HAVE READ THIS APPLICATION AND THE ABOVE IS CORRECT, AND I AGREE TO COMPLY WITH THE REQUIREMENTS ABOVE. FAILURE TO COMPLY SHALL RESULT IN LEGAL ACTION.

Curtis M Otto

SIGNATURE

APPROVED BY: [Signature]

DATE APPROVED: 3-4-92

DATE SUBMITTED: 3/4/92

PERMIT # \_\_\_\_\_

FEE \_\_\_\_\_

# FENCE PERMIT

GRAND JUNCTION PLANNING DEPARTMENT

BLDG ADDRESS: 740-742 Bunting Ave.

TAX SCHEDULE #: \_\_\_\_\_

PROPERTY OWNER: CHRIS M 0110

PHONE: 243-9468


CONTRACTOR: Self

PHONE: \_\_\_\_\_

MATERIAL: Cedar Wood

HEIGHT: 6'

\* PLOT PLAN

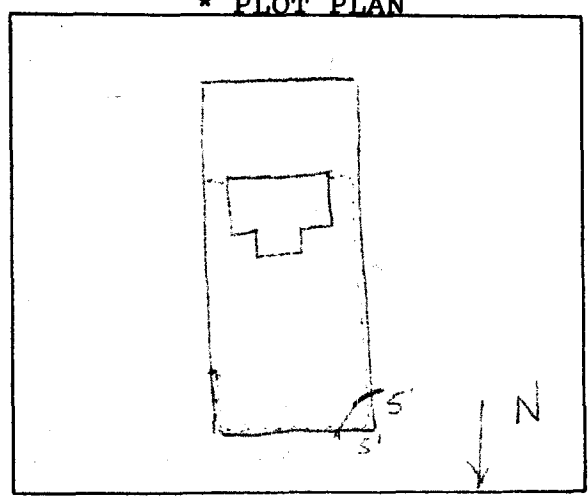

\*Showing Property Line Dimensions, Easements, Streets, all Structures, and Setbacks from Property Lines.

*Handwritten notes:*  
7' to front to the right of fence  
7' to the place of existing  
fence


\*\*\*\*\*

### FOR OFFICE USE ONLY


ZONE: BSE-1A

SETBACKS: F \_\_\_\_\_ S \_\_\_\_\_ R \_\_\_\_\_

SPECIAL CONDITIONS: \_\_\_\_\_

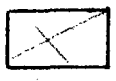

FINAL PERMIT

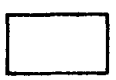

WILL REQUIRE SEPARATE PERMIT FROM THE CITY/COUNTY BUILDING DEPARTMENT.

\*\*\*\*\*

ANY MODIFICATION TO THIS APPROVED FENCE PERMIT MUST BE APPROVED, IN WRITING, BY THIS DEPARTMENT.

I HEREBY ACKNOWLEDGE THAT I HAVE READ THIS APPLICATION AND THE ABOVE IS CORRECT, AND I AGREE TO COMPLY WITH THE REQUIREMENTS ABOVE. FAILURE TO COMPLY SHALL RESULT IN LEGAL ACTION.

Chris M 0110  
SIGNATURE

APPROVED BY: \_\_\_\_\_

DATE APPROVED: \_\_\_\_\_