

DATE SUBMITTED: 11-24-93

PERMIT # _____

FEE 5.00

FENCE PERMIT

GRAND JUNCTION PLANNING DEPARTMENT

BLDG ADDRESS: 903 MAIN

TAX SCHEDULE #: 2945-144-22-001

PROPERTY OWNER: MICHAEL WHITE


PHONE: 242-2392

CONTRACTOR: Taylor Fence

PHONE: ~~242-2392~~

MATERIAL: RED WOOD

HEIGHT: 6 FT.

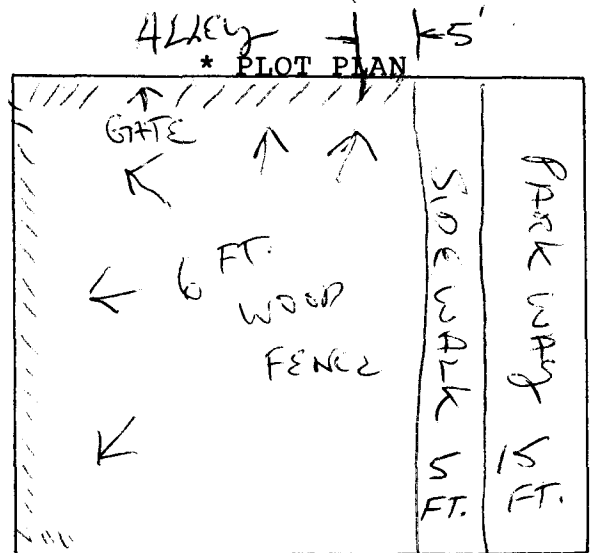

*Showing Property Line Dimensions, Easements, Streets, all Structures, and Setbacks from Property Lines. MAIN ST.

FOR OFFICE USE ONLY

ZONE: B-3

SETBACKS: F _____ S _____ R _____

SPECIAL CONDITIONS: Fence must start @ least 5' back from sidewalk.



FINAL PERMIT



WILL REQUIRE SEPARATE PERMIT FROM THE CITY/COUNTY BUILDING DEPARTMENT.

ANY MODIFICATION TO THIS APPROVED FENCE PERMIT MUST BE APPROVED, IN WRITING, BY THIS DEPARTMENT.

I HEREBY ACKNOWLEDGE THAT I HAVE READ THIS APPLICATION AND THE ABOVE IS CORRECT, AND I AGREE TO COMPLY WITH THE REQUIREMENTS ABOVE. FAILURE TO COMPLY SHALL RESULT IN LEGAL ACTION.

Jerry [Signature]
SIGNATURE

APPROVED BY: M. Petzj

DATE APPROVED: 11-24-93