

DATE SUBMITTED: 3/1/93

PERMIT # \_\_\_\_\_

FEE 5.00

# FENCE PERMIT

GRAND JUNCTION PLANNING DEPARTMENT

BLDG ADDRESS: Crestview Sub div

TAX SCHEDULE #: \_\_\_\_\_

PROPERTY OWNER: GERALD F DORN I


PHONE: 243-3736 1516 Crestview Way

CONTRACTOR: G.F. Lovelace

PHONE: 243-3736

MATERIAL: 1-6' picket fence

HEIGHT: 6'

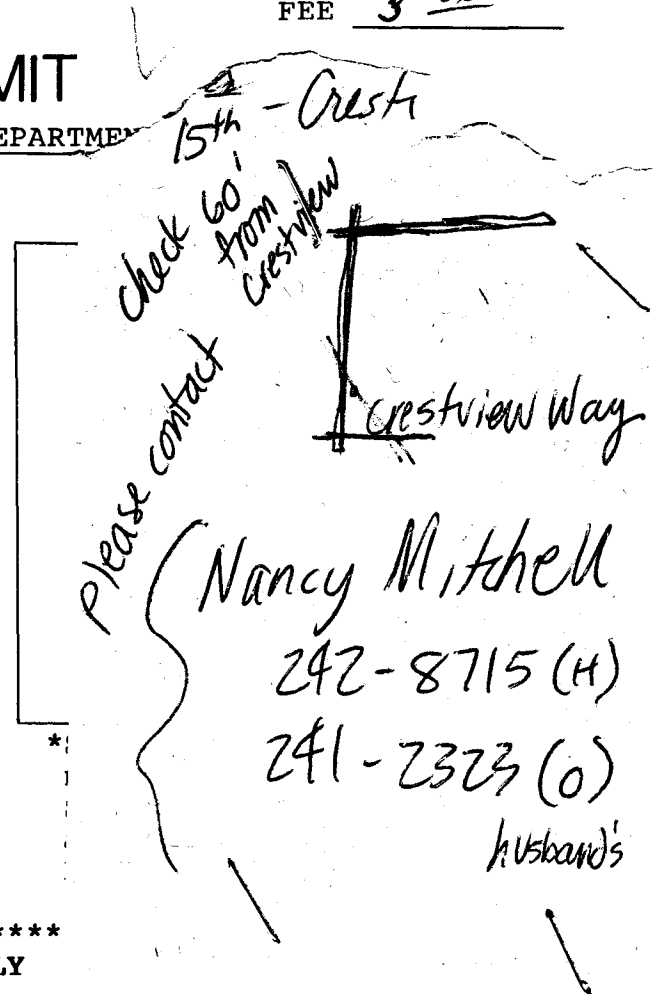

\*\*\*\*\*

### FOR OFFICE USE ONLY

ZONE: PR

SETBACKS: F \_\_\_\_\_ S \_\_\_\_\_ R \_\_\_\_\_

SPECIAL CONDITIONS: \_\_\_\_\_

AS PER APPROVED REVOCABLE PERMIT

FINAL PERMIT

WILL REQUIRE SEPARATE PERMIT FROM THE CITY/COUNTY BUILDING DEPARTMENT.

\*\*\*\*\*

ANY MODIFICATION TO THIS APPROVED FENCE PERMIT MUST BE APPROVED, IN WRITING, BY THIS DEPARTMENT.

I HEREBY ACKNOWLEDGE THAT I HAVE READ THIS APPLICATION AND THE ABOVE IS CORRECT, AND I AGREE TO COMPLY WITH THE REQUIREMENTS ABOVE. FAILURE TO COMPLY SHALL RESULT IN LEGAL ACTION.

Gerald F Dorn  
SIGNATURE

APPROVED BY: KEM

DATE APPROVED: 3/1/93

CRESTVIEW ROAD

60' TOR

⊕ PALE

APPROX

65' TOR

61' TOR

30'

4'

20'

COMMAND AREA

DORN RESI

DARBELL RESI

HOUSE

GARAGE

HOUSE

YELLOW NEW FENCE

← 15TH STREET →

Side walk 4'8"

118'6"

5'6"

⊕ PALE

⊕ PALE

8'3"

SHRUBS IN THIS AREA

SHRUB IN THIS AREA

RED EXISTING FENCE

ADEN RESI

WESTERKOPF RESI

