

DATE SUBMITTED: 3/19/93


PERMIT # _____

FEE 5.00

FENCE PERMIT ✓

GRAND JUNCTION PLANNING DEPARTMENT

BLDG ADDRESS: 2335 N 1ST S
 TAX SCHEDULE #: 2945-101-15-001
 PROPERTY OWNER: TERRY LORENZEN
 PHONE: 345 2124
 CONTRACTOR: SAME
 PHONE: _____
 MATERIAL: Pol Foa
 HEIGHT: 4' + 5'

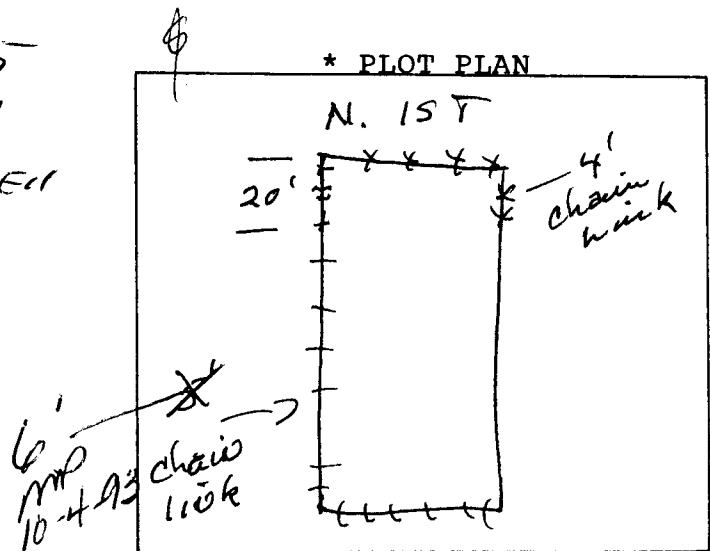

*Showing Property Line Dimensions, Easements, Streets, all Structures, and Setbacks from Property Lines.

FOR OFFICE USE ONLY

ZONE: RSF-5

SETBACKS: F S R

SPECIAL CONDITIONS: _____

FINAL PERMIT

WILL REQUIRE SEPARATE PERMIT FROM THE CITY/COUNTY BUILDING DEPARTMENT.

ANY MODIFICATION TO THIS APPROVED FENCE PERMIT MUST BE APPROVED, IN WRITING, BY THIS DEPARTMENT.

I HEREBY ACKNOWLEDGE THAT I HAVE READ THIS APPLICATION AND THE ABOVE IS CORRECT, AND I AGREE TO COMPLY WITH THE REQUIREMENTS ABOVE. FAILURE TO COMPLY SHALL RESULT IN LEGAL ACTION.

Lorenzen
SIGNATURE

APPROVED BY: [Signature]

DATE APPROVED: 3/19/93