

FEE \$5.00/10

V#

FENCE PERMIT

GRAND JUNCTION COMMUNITY DEVELOPMENT DEPARTMENT

THIS SECTION TO BE COMPLETED BY APPLICANT

PROPERTY ADDRESS 225 N. 5th
~~4TH & WHITE AVE.~~

TAX SCHEDULE NO 294514309-008010

PROPERTY OWNER HASCO WESTERN INC

OWNER'S PHONE _____

OWNER'S ADDRESS _____


CONTRACTOR STTI

CONTRACTOR'S PHONE 243-1642

FENCE MATERIAL CHAIN LINK FENCE

FENCE HEIGHT 6'

PLOT PLAN

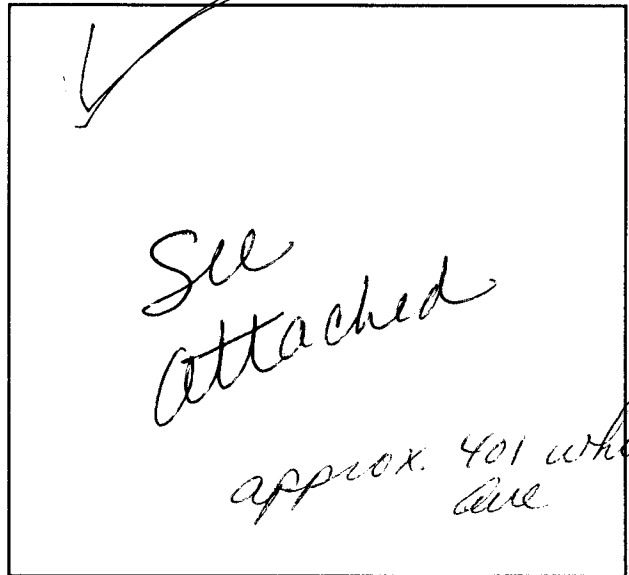

Plot plan must show property lines and property dimensions, all easements, all rights-of-way, all structures, all setbacks from property lines, & fence height(s).

THIS SECTION TO BE COMPLETED BY COMMUNITY DEVELOPMENT DEPARTMENT STAFF

ZONE B-3

SETBACKS: Front _____ from property line (PL) or

SPECIAL CONDITIONS _____

_____ from center of ROW, whichever is greater.

Side _____ from PL Rear _____ from PL

Fences exceeding six feet in height require a separate permit from the City/County Building Department. A fence constructed on a corner lot that extends past the rear of the house along the side yard or abuts an alley requires approval from the City Engineer (Section 5-5-5B of the Grand Junction Zoning and Development Code).

The owner/applicant must correctly identify all property lines, easements, and rights-of-way and ensure the fence is located within the property's boundaries. Covenants, conditions, restrictions, easements and/or rights-of-way may restrict or prohibit the placement of fence(s). The owner/applicant is responsible for compliance with covenants, conditions, and restrictions which may apply. Fences built in easements may be subject to removal at the property owner's sole and absolute expense. Any modification of design and/or material as approved in this fence permit must be approved, in writing, by the Community Development Department Director.

I hereby acknowledge that I have read this application and the information and plot plan are correct; I agree to comply with any and all codes, ordinances, laws, regulations, or restrictions which apply.

I understand that failure to comply shall result in legal action, which may include but not necessarily be limited to removal of the fence(s) at the owner's cost.

Applicant's Signature Lawrence J. Moran Date 5/5/95

Community Development's Approval Marcia Babideaux Date 5-5-95

City Engineer's Approval (if required) _____ Date _____

VALID FOR SIX MONTHS FROM DATE OF ISSUANCE (Section 9-3-2D Grand Junction Zoning & Development Code)

(White: Community Development)

(Yellow: Code Enforcement)

(Pink: Customer)

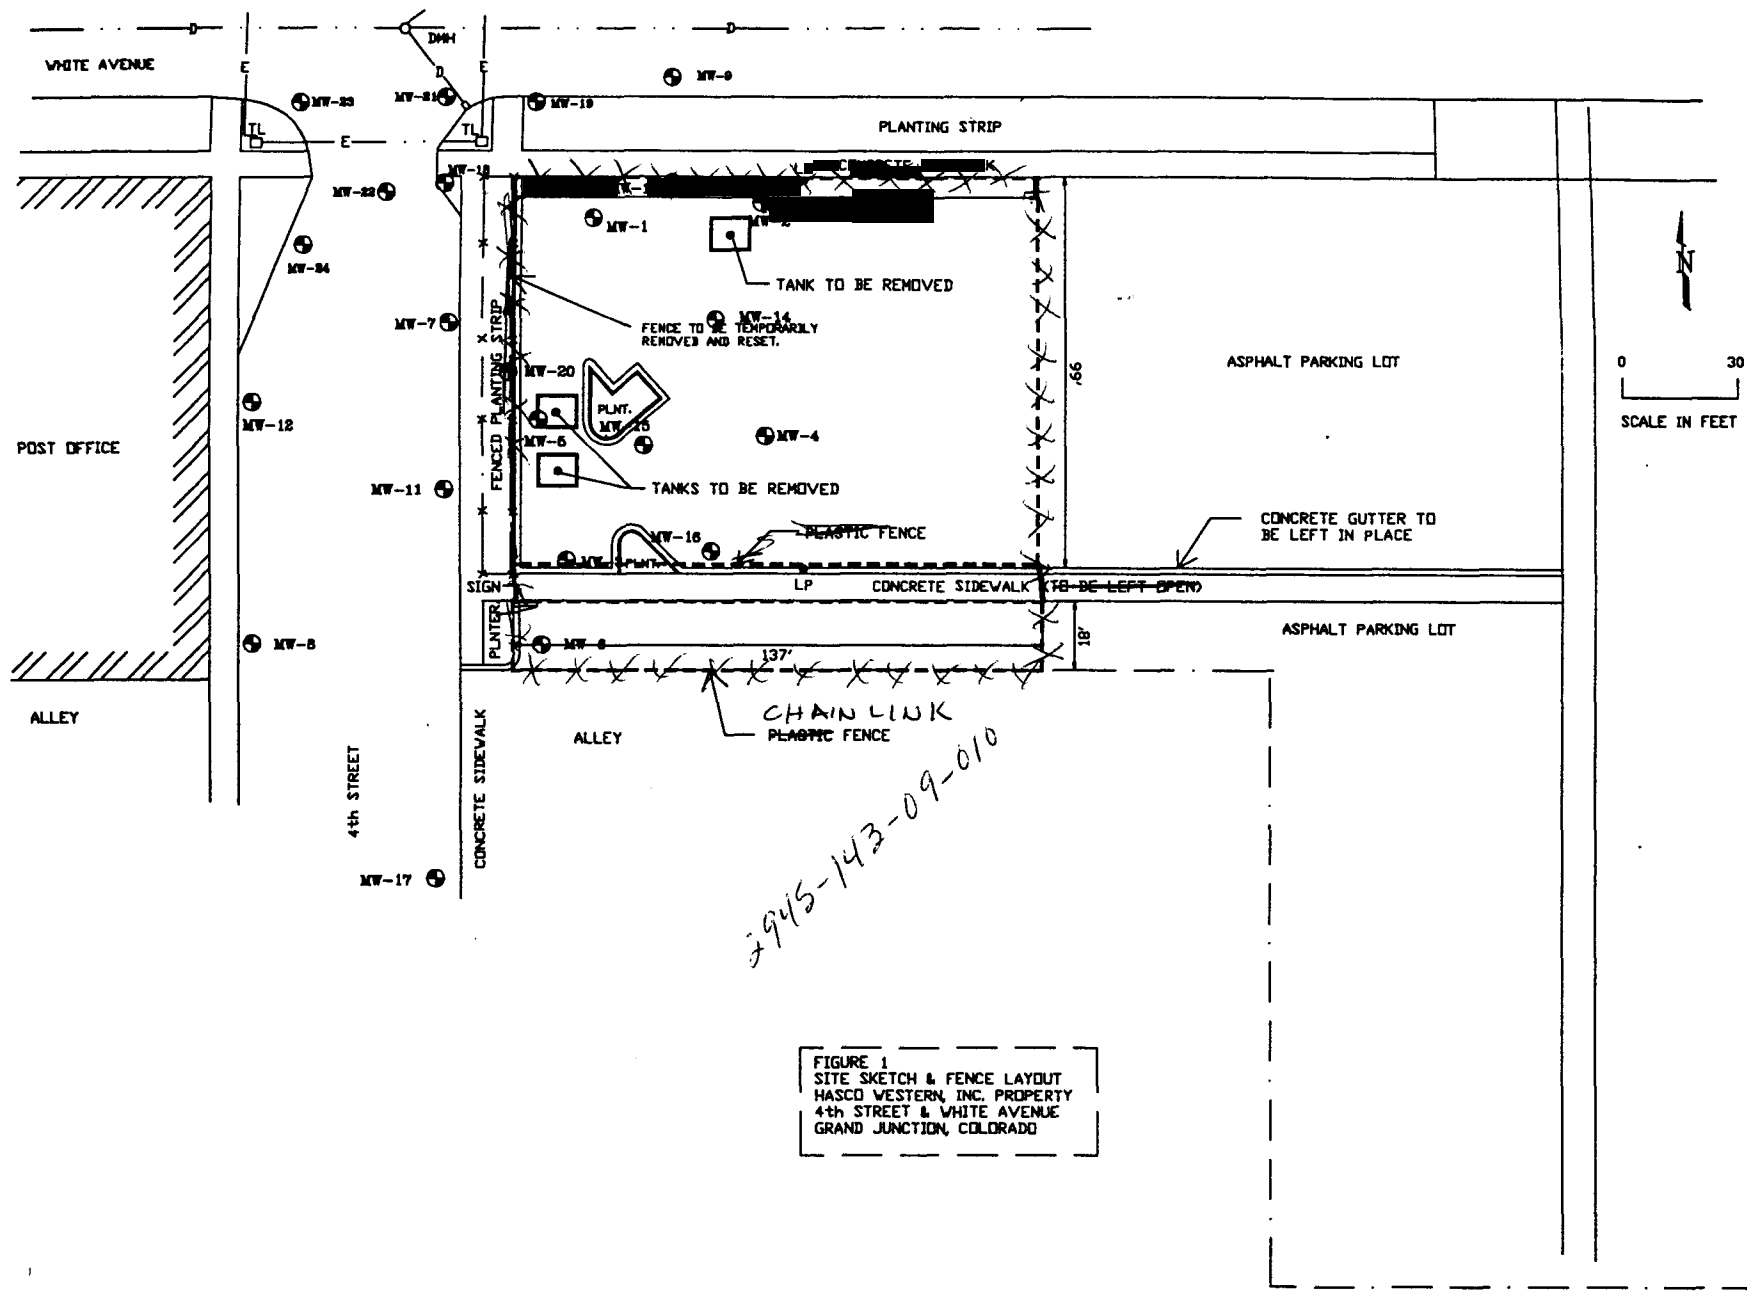



FIGURE 1
 SITE SKETCH & FENCE LAYOUT
 HASCO WESTERN, INC. PROPERTY
 4th STREET & WHITE AVENUE
 GRAND JUNCTION, COLORADO


 Storage Tank Technology, Inc.
 1048 Independent Ave #108
 Grand Junction, CO
 (303) 243-1842
 Fax (303) 243-1959