

FEE ~~\$5.00~~ \$10.00


FENCE PERMIT
GRAND JUNCTION COMMUNITY DEVELOPMENT DEPARTMENT



THIS SECTION TO BE COMPLETED BY APPLICANT

PLOT PLAN

PROPERTY ADDRESS 2440 BUNTING AVE
TAX SCHEDULE NO 2945-124-21-027
PROPERTY OWNER R. J. BROWN
OWNER'S PHONE 242-6827
OWNER'S ADDRESS 2440 BUNTING AVE
CONTRACTOR OWNER
CONTRACTOR'S PHONE ADOLE
FENCE MATERIAL CEDAR
FENCE HEIGHT SIX FEET

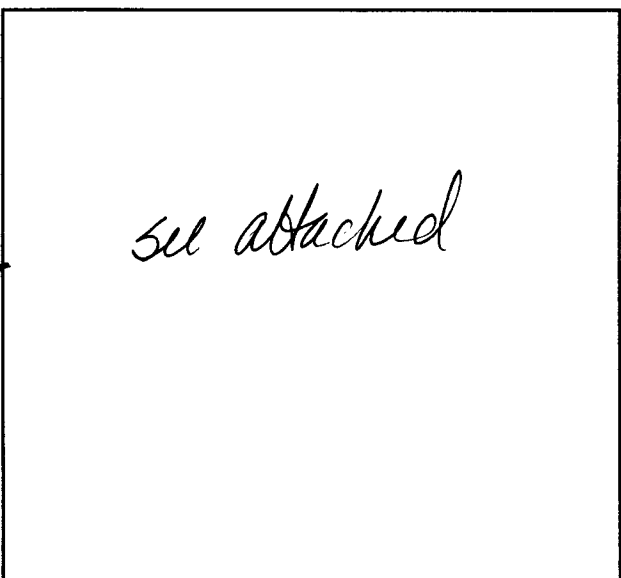

Plot plan must show property lines and property dimensions, all easements, all rights-of-way, all structures, all setbacks from property lines, & fence height(s).

THIS SECTION TO BE COMPLETED BY COMMUNITY DEVELOPMENT DEPARTMENT STAFF

ZONE RMF-32

SETBACKS: Front Property line from property line (PL) or

SPECIAL CONDITIONS _____

_____ from center of ROW, whichever is greater.

Side _____ from PL Rear _____ from PL

Fences exceeding six feet in height require a separate permit from the City/County Building Department. A fence constructed on a corner lot that extends past the rear of the house along the side yard or abuts an alley requires approval from the City Engineer (Section 5-5-5B of the Grand Junction Zoning and Development Code).

The owner/applicant must correctly identify all property lines, easements, and rights-of-way and ensure the fence is located within the property's boundaries. Covenants, conditions, restrictions, easements and/or rights-of-way may restrict or prohibit the placement of fence(s). The owner/applicant is responsible for compliance with covenants, conditions, and restrictions which may apply. Fences built in easements may be subject to removal at the property owner's sole and absolute expense. Any modification of design and/or material as approved in this fence permit must be approved, in writing, by the Community Development Department Director.

I hereby acknowledge that I have read this application and the information and plot plan are correct; I agree to comply with any and all codes, ordinances, laws, regulations, or restrictions which apply.

I understand that failure to comply shall result in legal action, which may include but not necessarily be limited to removal of the fence(s) at the owner's cost.

Applicant's Signature [Signature] Date June 7 1995

Community Development's Approval [Signature] Date 6/7/95

City Engineer's Approval (if required) [Signature] Date _____

VALID FOR SIX MONTHS FROM DATE OF ISSUANCE (Section 9-3-2D Grand Junction Zoning & Development Code)


(White: Community Development) (Yellow: Code Enforcement) (Pink: Customer)

IMPROVEMENT LOCATION CERTIFICATE

2440 BLUNTING AVENUE

FIRST AMERICAN TITLE #120408A
BROWN/SUTTON ACCT.
LOT 4 IN BLOCK 1 OF TELLER ACRES, MESA COUNTY, COLORADO.

X - 6' Cedar

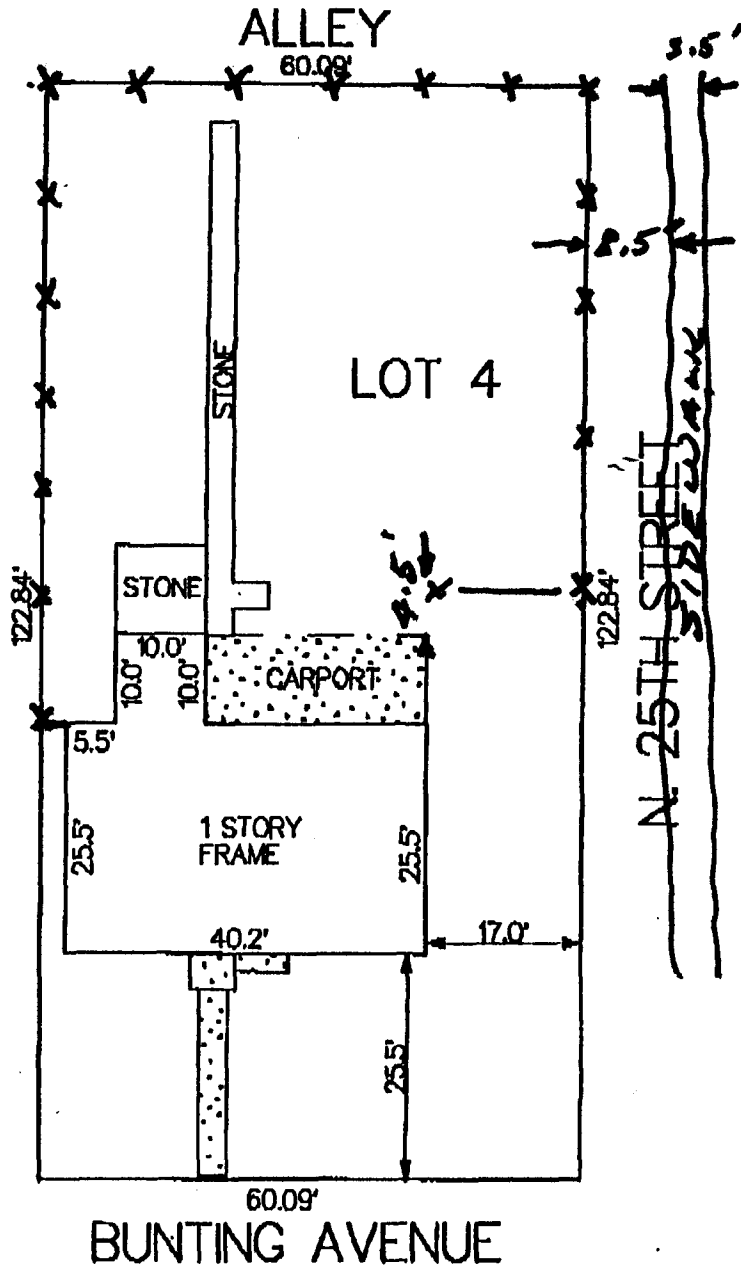

SCALE: 1" = 20'


6-7-95
KL 6-7-95

NOTE: THIS PROPERTY DOES NOT FALL WITHIN ANY 100 YEAR FLOODPLAIN.

I HEREBY CERTIFY THAT THIS IMPROVEMENT LOCATION CERTIFICATE WAS PREPARED FOR MESA NATIONAL BANK, THAT IT IS NOT A LAND SURVEY PLAT OR IMPROVEMENT SURVEY PLAT, AND THAT IT IS NOT TO BE RELED UPON FOR THE ESTABLISHMENT OF FENCE, BUILDING OR OTHER FUTURE IMPROVEMENT LINES. I FURTHER CERTIFY THE IMPROVEMENTS ON THE ABOVE DESCRIBED PARCEL ON THIS DATE, 5/30/95 EXCEPT UTILITY CONNECTIONS, ARE ENTIRELY WITHIN THE BOUNDARIES OF THE PARCEL, EXCEPT AS SHOWN, THAT THERE ARE NO ENCROACHMENTS UPON THE DESCRIBED PREMISES BY IMPROVEMENTS ON ANY ADJOINING PREMISES, EXCEPT AS INDICATED, AND THAT THERE IS NO EVIDENCE OR SIGN OF ANY EASEMENT CROSSING OR BURDENING ANY PART OF SAID PARCEL, EXCEPT AS NOTED.

● = FOUND PIN

Kenneth L. Glenn
KENNETH L. GLENN R.L.S. 12770

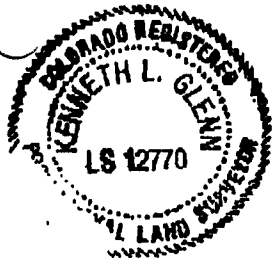

SURVEYIT

PHONE: 303-245-3777 FAX: 241-4847



by GLENN

MAILING:
2004 NORTH 12th
SUITE 17
GRAND JUNCTION, CO. 81501

SURVEYED BY:	J.G.	DATE SURVEYED:	5/30/95
DRAWN BY:	J.G.	DATE DRAWN:	5/30/95
REVISION:		SCALE:	1" = 20'