

FEE ~~\$5.00~~

100


FENCE PERMIT

GRAND JUNCTION COMMUNITY DEVELOPMENT DEPARTMENT

THIS SECTION TO BE COMPLETED BY APPLICANT

PLOT PLAN

PROPERTY ADDRESS 2749 Unawap Ave.
 TAX SCHEDULE NO 2945-252-23-001
 PROPERTY OWNER Robert La Sherrid Mason
 OWNER'S PHONE (970) 245-8799
 OWNER'S ADDRESS same.
 CONTRACTOR _____
 CONTRACTOR'S PHONE _____
 FENCE MATERIAL Chain link
 FENCE HEIGHT 48"

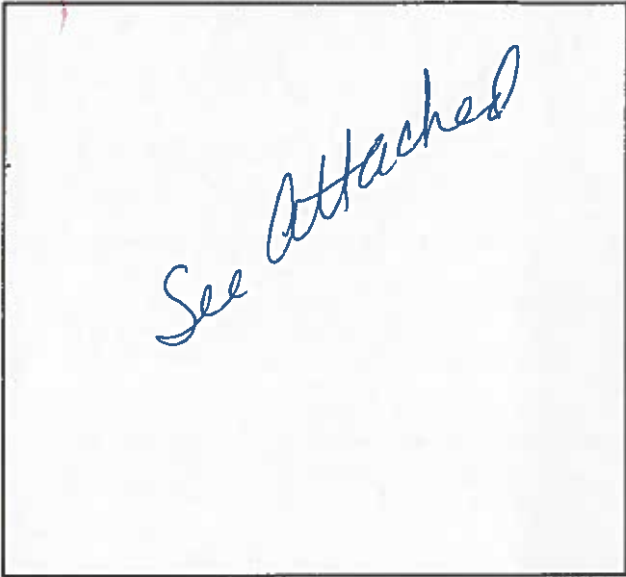

Plot plan must show property lines and property dimensions, all easements, all rights-of-way, all structures, all setbacks from property lines, & fence height(s).

THIS SECTION TO BE COMPLETED BY COMMUNITY DEVELOPMENT DEPARTMENT STAFF

ZONE RSF-8 SETBACKS: Front _____ from property line (PL) or
 SPECIAL CONDITIONS _____ _____ from center of ROW, whichever is greater.
 Side _____ from PL Rear _____ from PL

Fences exceeding six feet in height require a separate permit from the City/County Building Department. A fence constructed on a corner lot that extends past the rear of the house along the side yard or abuts an alley requires approval from the City Engineer (Section 5-5-5B of the Grand Junction Zoning and Development Code).

The owner/applicant must correctly identify all property lines, easements, and rights-of-way and ensure the fence is located within the property's boundaries. Covenants, conditions, restrictions, easements and/or rights-of-way may restrict or prohibit the placement of fence(s). The owner/applicant is responsible for compliance with covenants, conditions, and restrictions which may apply. Fences built in easements may be subject to removal at the property owner's sole and absolute expense. Any modification of design and/or material as approved in this fence permit must be approved, in writing, by the Community Development Department Director.

I hereby acknowledge that I have read this application and the information and plot plan are correct; I agree to comply with any and all codes, ordinances, laws, regulations, or restrictions which apply.

I understand that failure to comply shall result in legal action, which may include but not necessarily be limited to removal of the fence(s) at the owner's cost.

Applicant's Signature Sherrid Mason Date 11-22-95

Community Development's Approval Ronnie Edwards Date 11-22-95

City Engineer's Approval (if required) N/A Date _____

VALID FOR SIX MONTHS FROM DATE OF ISSUANCE (Section 9-3-2D Grand Junction Zoning & Development Code)


(White: Community Development) (Yellow: Code Enforcement) (Pink: Customer)

Approximate scale 1:1010



Robert Mason
2749 UNAWEEP

62.86

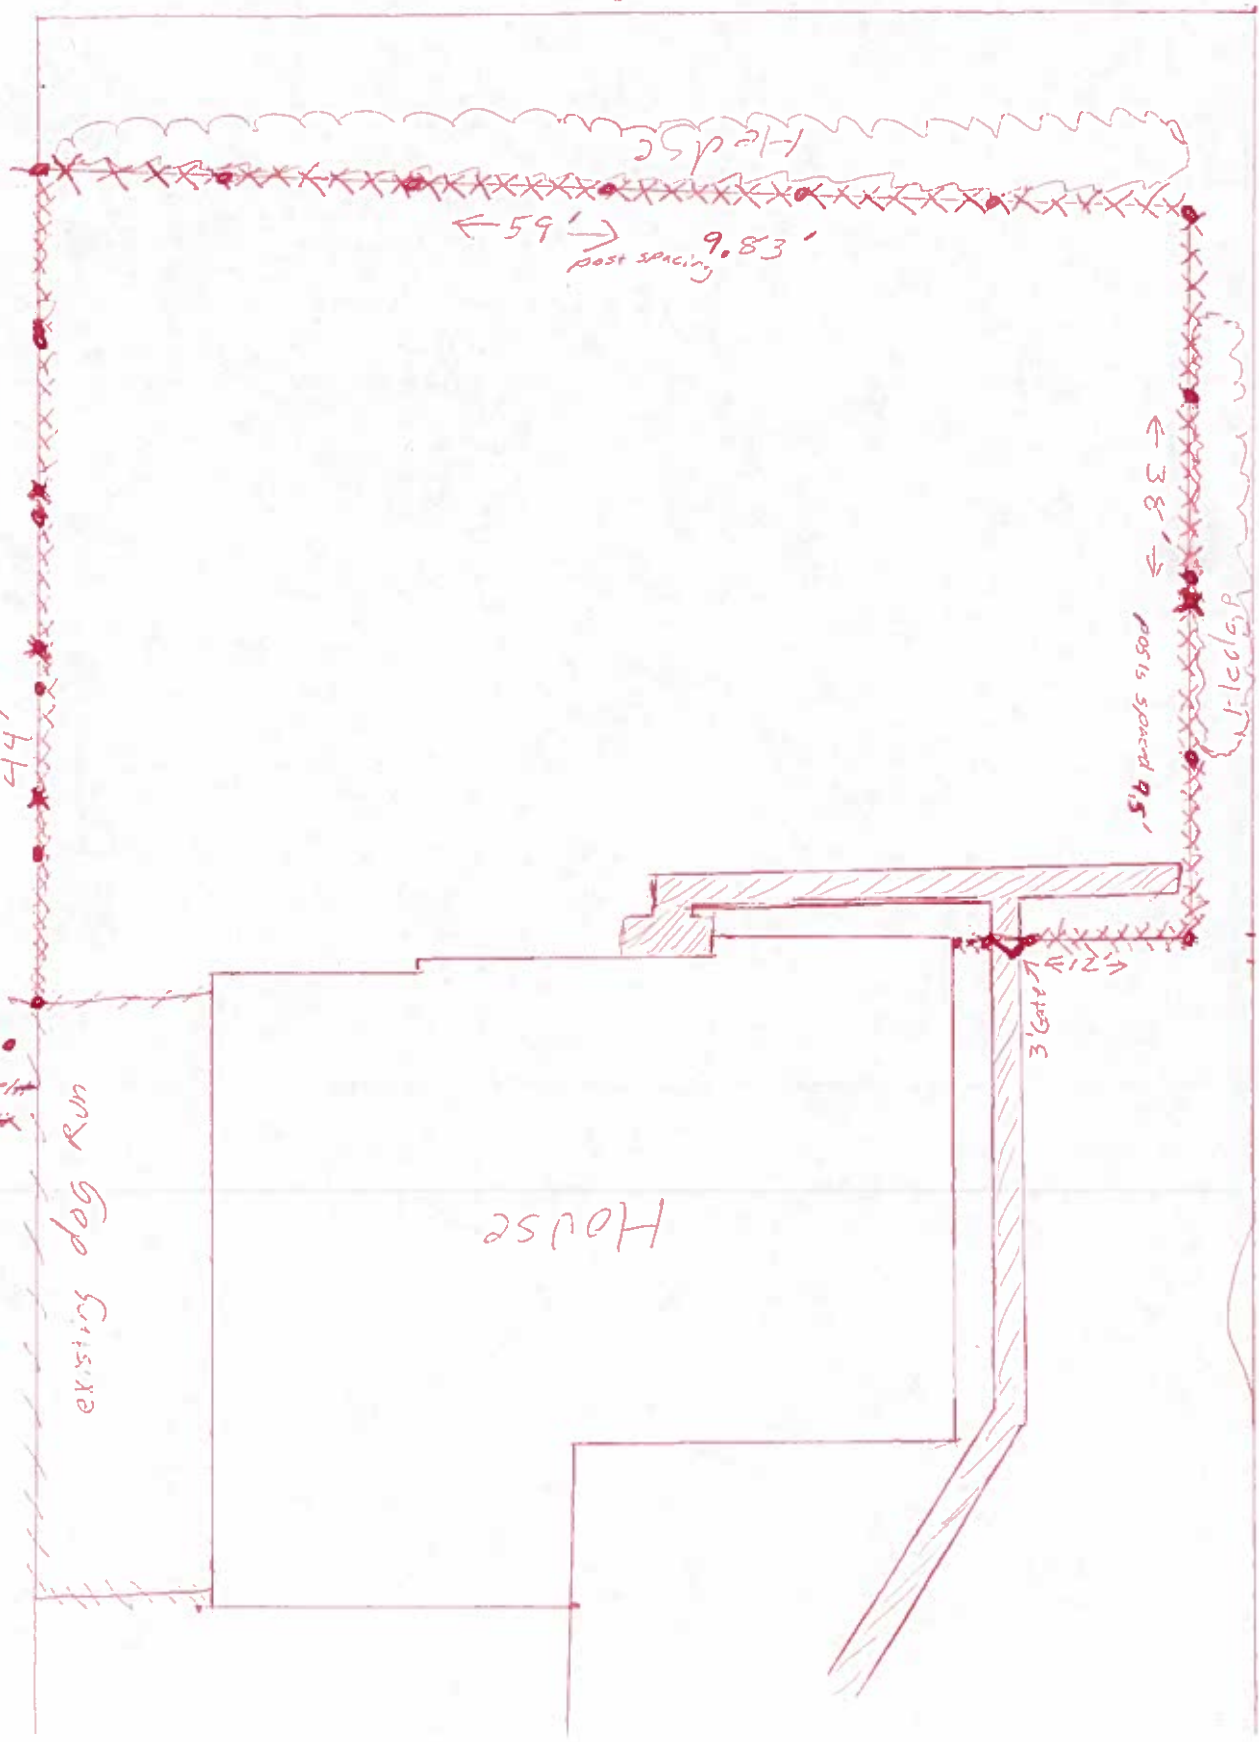

Posts spaced 8.8'

44'

59' ← →
post spacing 9.83'

← 38' →
posts spaced 9.5'

11.66'

3 Gate

150'

27 1/2 Road

Fence posts ●
Existing fence
grass fence
greenbank
existing

existing dog run

House