

FEE ~~\$5.00~~ 10.00


FENCE PERMIT

GRAND JUNCTION COMMUNITY DEVELOPMENT DEPARTMENT

THIS SECTION TO BE COMPLETED BY APPLICANT

PLOT PLAN

PROPERTY ADDRESS 774 S. Sedona Ct.
 TAX SCHEDULE NO 2701-351-53-011
 PROPERTY OWNER Orville D. & Mary E. Brown
 OWNER'S PHONE 242-3915
 OWNER'S ADDRESS 2705 Crossroads Blvd.
 CONTRACTOR Owner
 CONTRACTOR'S PHONE Same as above
 FENCE MATERIAL Chain link
 FENCE HEIGHT 6' existing

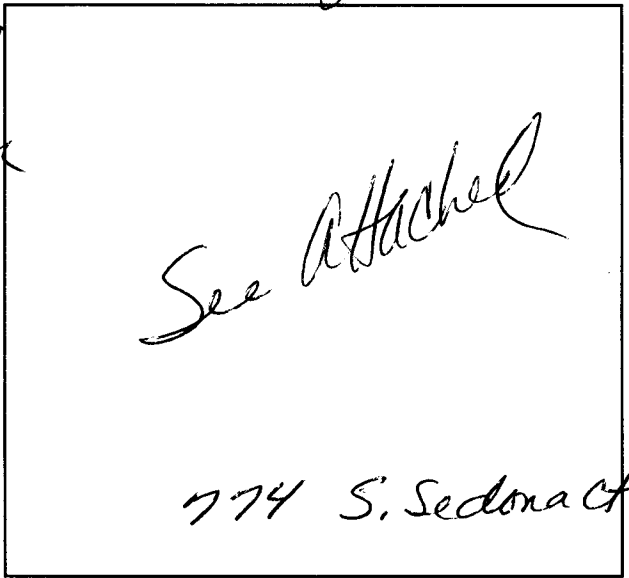

Plot plan must show property lines and property dimensions, all easements, all rights-of-way, all structures, all setbacks from property lines, & fence height(s).

THIS SECTION TO BE COMPLETED BY COMMUNITY DEVELOPMENT DEPARTMENT STAFF

ZONE PR
 SPECIAL CONDITIONS _____

SETBACKS: Front _____ from property line (PL) or
 _____ from center of ROW, whichever is greater.
 Side _____ from PL Rear _____ from PL

Fences exceeding six feet in height require a separate permit from the City/County Building Department. A fence constructed on a corner lot that extends past the rear of the house along the side yard or abuts an alley requires approval from the City Engineer (Section 5-5-5B of the Grand Junction Zoning and Development Code).

The owner/applicant must correctly identify all property lines, easements, and rights-of-way and ensure the fence is located within the property's boundaries. Covenants, conditions, restrictions, easements and/or rights-of-way may restrict or prohibit the placement of fence(s). The owner/applicant is responsible for compliance with covenants, conditions, and restrictions which may apply. Fences built in easements may be subject to removal at the property owner's sole and absolute expense. Any modification of design and/or material as approved in this fence permit must be approved, in writing, by the Community Development Department Director.


I hereby acknowledge that I have read this application and the information and plot plan are correct; I agree to comply with any and all codes, ordinances, laws, regulations, or restrictions which apply.

I understand that failure to comply shall result in legal action, which may include but not necessarily be limited to removal of the fence(s) at the owner's cost.

Applicant's Signature Orville D. Brown Date 2-7-95
 Community Development's Approval Ponnie Edwards Date 2-7-95
 City Engineer's Approval (if required) N/A Date _____

VALID FOR SIX MONTHS FROM DATE OF ISSUANCE (Section 9-3-2D Grand Junction Zoning & Development Code)

(White: Community Development) (Yellow: Code Enforcement) (Pink: Customer)

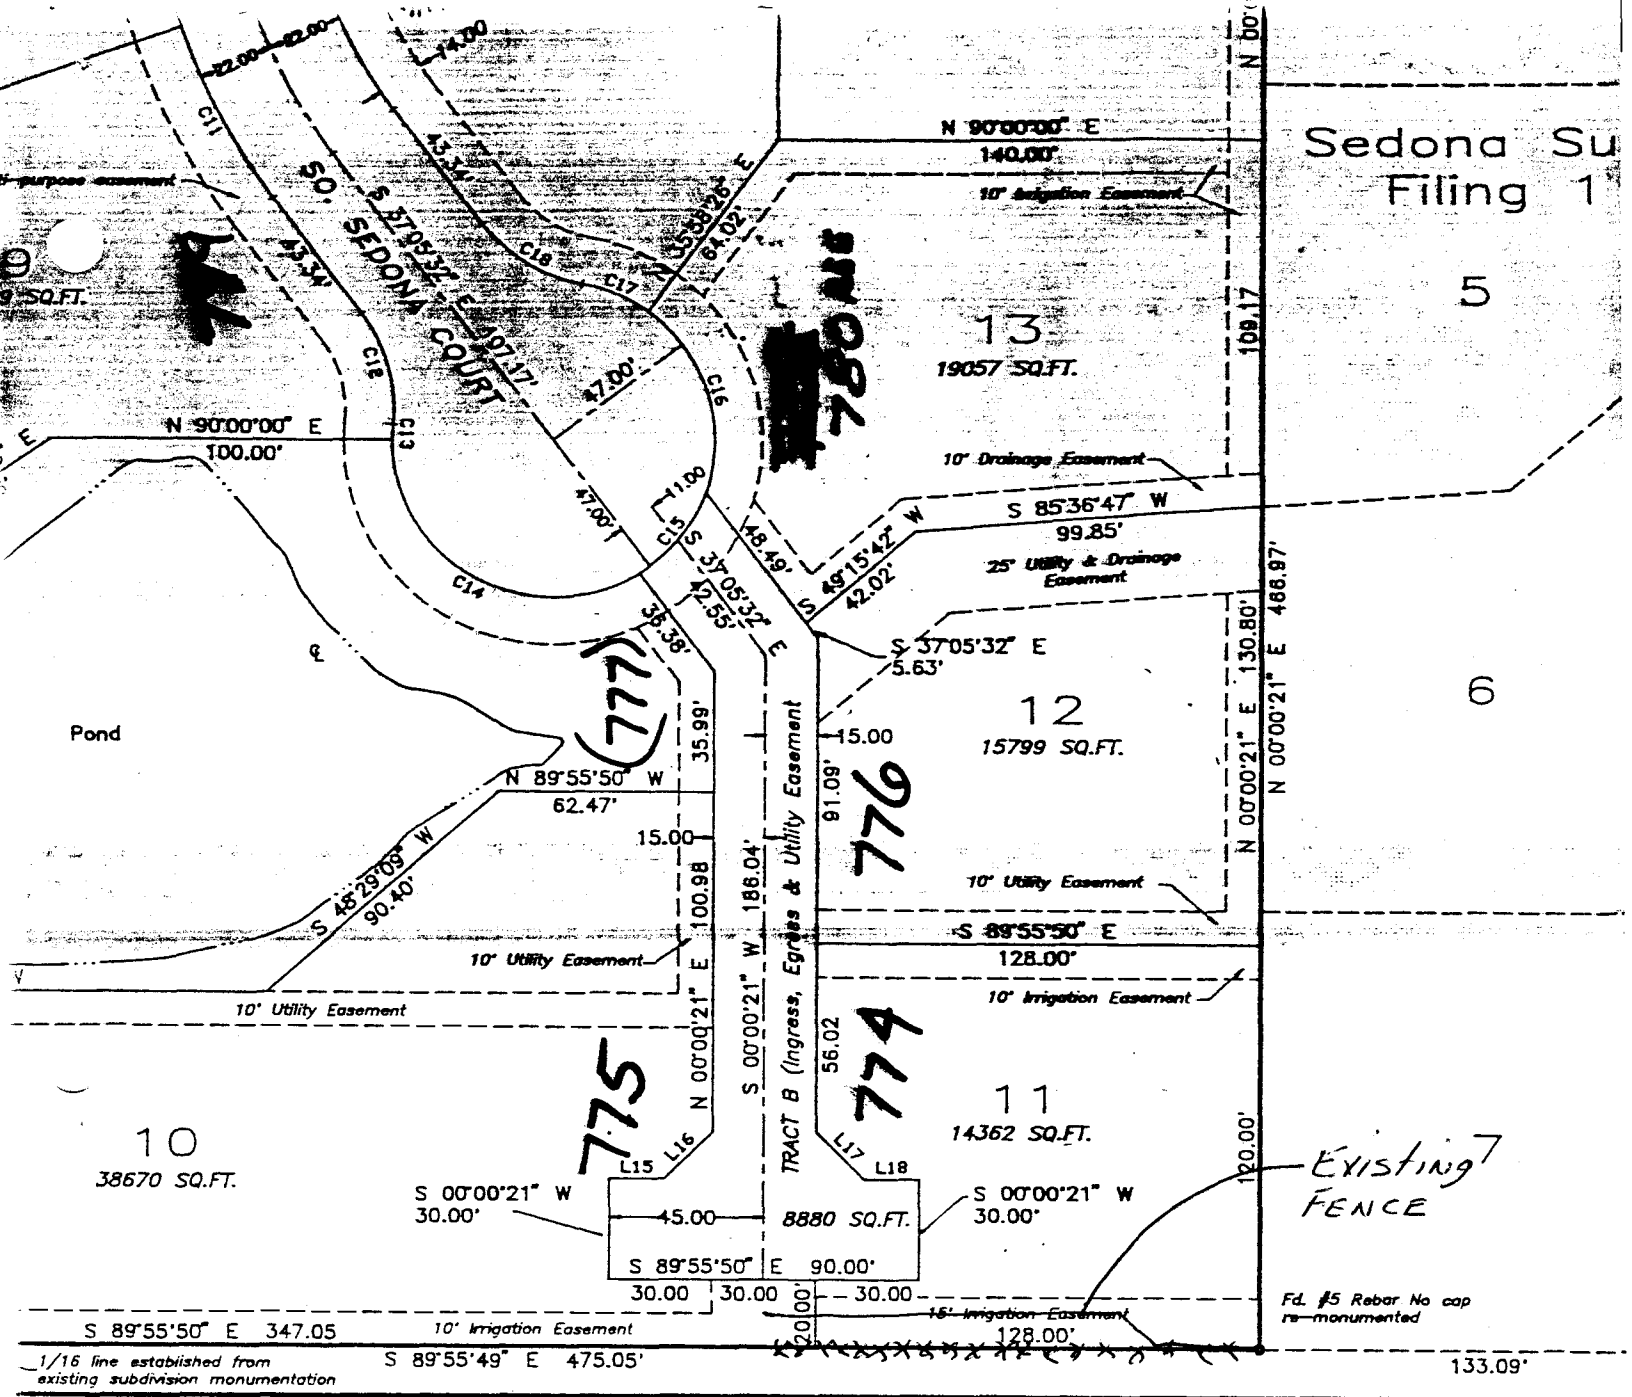

Sedona Sub
Filing 1

5

6

10
38670 SQ.FT.

11
14362 SQ.FT.

12
15799 SQ.FT.

13
19057 SQ.FT.

775

776

774

780

Existing
FENCE

Fd. #5 Rebar No cap
re-monumented

1/16 line established from
existing subdivision monumentation

133.09'