

FEE \$10.00

N/C

✓


# FENCE PERMIT

## GRAND JUNCTION COMMUNITY DEVELOPMENT DEPARTMENT

THIS SECTION TO BE COMPLETED BY APPLICANT

PLOT PLAN

PROPERTY ADDRESS 597 1/2 28 1/2 RD  
 TAX SCHEDULE NO 2943-072-16-042  
 PROPERTY OWNER HARRY L. JONES  
 OWNER'S PHONE 970-256-9042  
 OWNER'S ADDRESS 597 1/2 28 1/2 RD  
 CONTRACTOR TAYLOR FENCE  
 CONTRACTOR'S PHONE \_\_\_\_\_  
 FENCE MATERIAL CEDAR  
 FENCE HEIGHT 6' to 0'

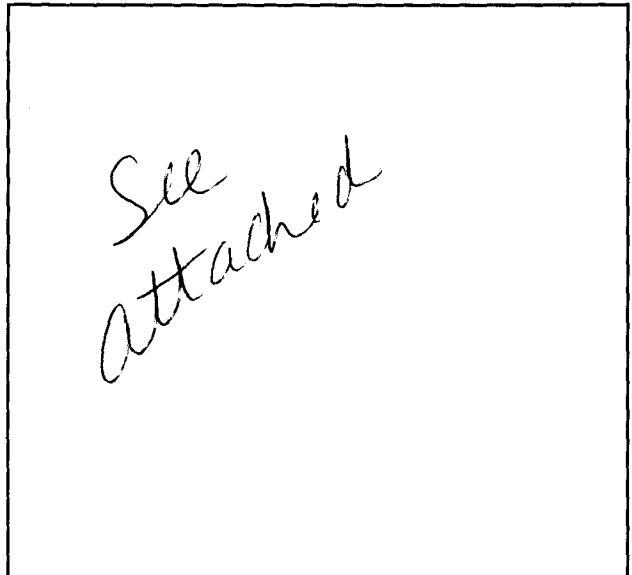

Plot plan must show property lines and property dimensions, all easements, all rights-of-way, all structures, all setbacks from property lines, & fence height(s).

THIS SECTION TO BE COMPLETED BY COMMUNITY DEVELOPMENT DEPARTMENT STAFF

ZONE PR  
 SPECIAL CONDITIONS \_\_\_\_\_  
 \_\_\_\_\_

SETBACKS: Front \_\_\_\_\_ from property line (PL) or  
 \_\_\_\_\_ from center of ROW, whichever is greater.  
 Side \_\_\_\_\_ from PL Rear \_\_\_\_\_ from PL

Fences exceeding six feet in height require a separate permit from the City/County Building Department. A fence constructed on a corner lot that extends past the rear of the house along the side yard or abuts an alley requires approval from the City Engineer (Section 5-5-5B of the Grand Junction Zoning and Development Code).

The owner/applicant must correctly identify all property lines, easements, and rights-of-way and ensure the fence is located within the property's boundaries. Covenants, conditions, restrictions, easements and/or rights-of-way may restrict or prohibit the placement of fence(s). The owner/applicant is responsible for compliance with covenants, conditions, and restrictions which may apply. Fences built in easements may be subject to removal at the property owner's sole and absolute expense. Any modification of design and/or material as approved in this fence permit must be approved, in writing, by the Community Development Department Director.

I hereby acknowledge that I have read this application and the information and plot plan are correct; I agree to comply with any and all codes, ordinances, laws, regulations, or restrictions which apply.

I understand that failure to comply shall result in legal action, which may include but not necessarily be limited to removal of the fence(s) at the owner's cost.

Applicant's Signature [Signature]

Date X 3-29-96

Community Development's Approval [Signature]

Date 3-29-96

City Engineer's Approval (if required) \_\_\_\_\_

Date \_\_\_\_\_

VALID FOR SIX MONTHS FROM DATE OF ISSUANCE (Section 9-3-2D Grand Junction Zoning & Development Code)

(White: Community Development)


(Yellow: Code Enforcement)

(Pink: Customer)

14' FROM SIDEWALK TO DECK

5' FROM (PROPERTY LINE) SIDEWALK TO DECK

30 FT FROM HOUSE TO ROAD

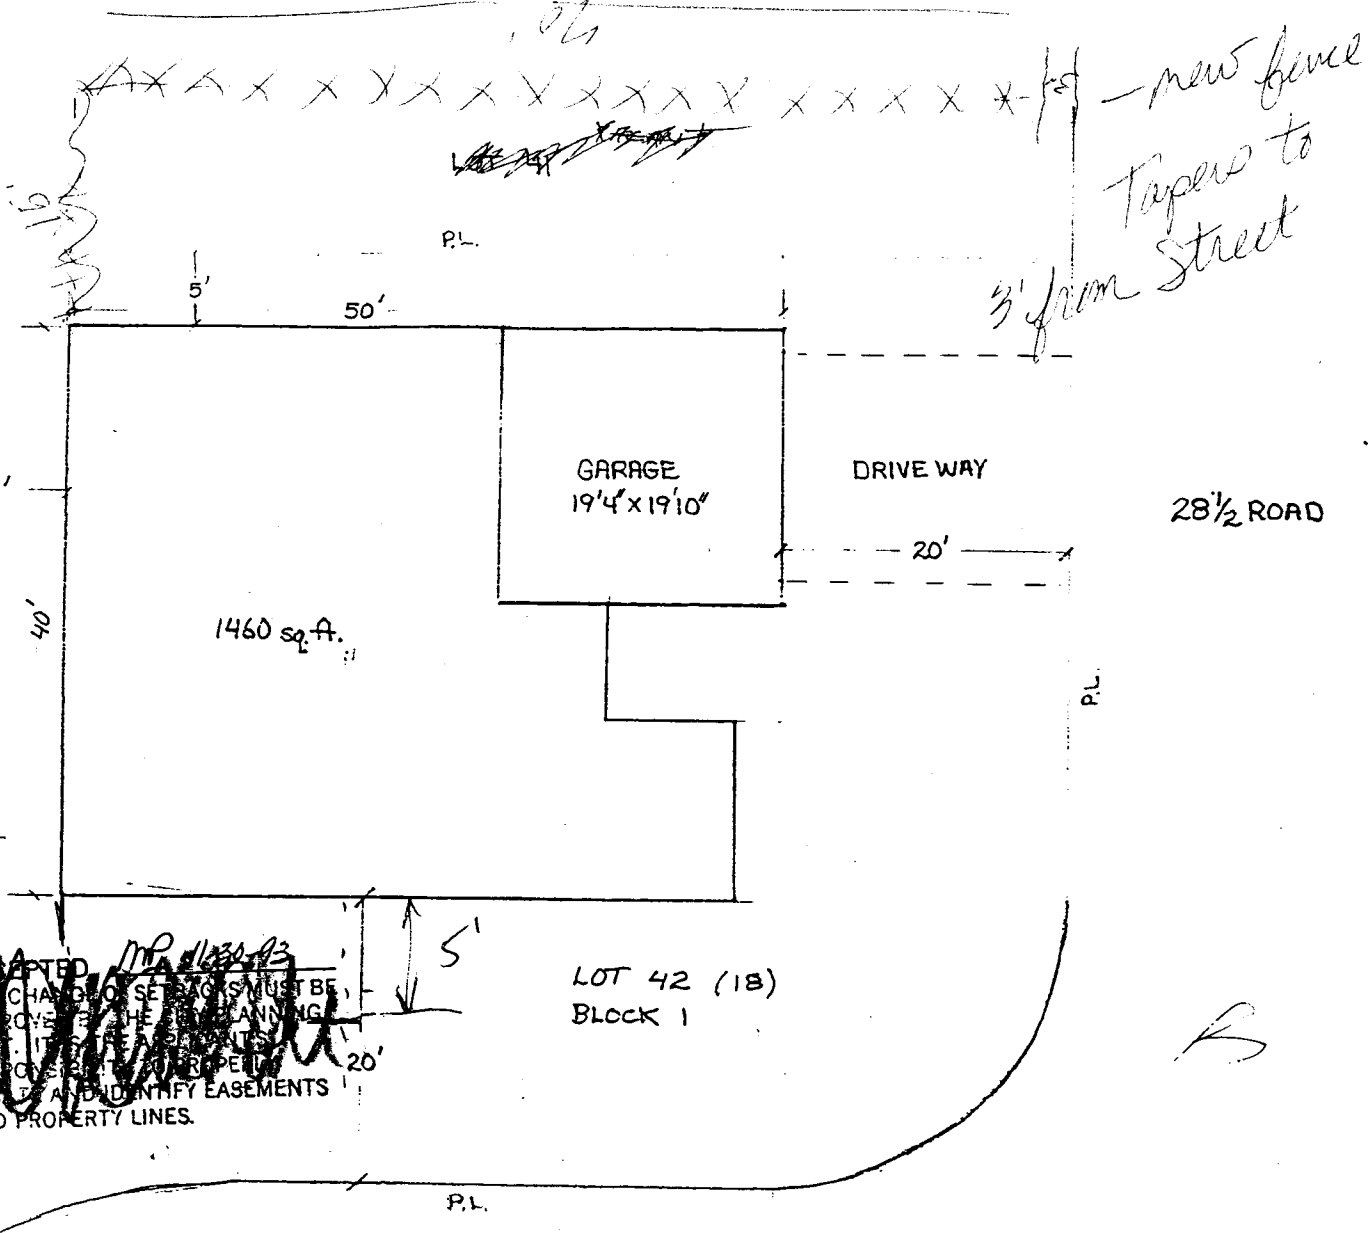

ACCEPTED *MP 11230-93*  
 ANY CHANGE OF SETBACKS MUST BE APPROVED BY THE PLANNING DEPARTMENT. THE RESULTS REPORT SHALL BE OPEN TO PUBLIC INSPECTION AND IDENTIFY EASEMENTS AND PROPERTY LINES.

LOT 42 (18)  
 BLOCK 1

NORTH GRANDEUR COURT

SCALE 1" = 3/32" = 1/4"

*Handwritten notes:*  
 To be per to  
 [scribbles]

*Handwritten notes:*  
 Prop. line to edge of deck

*Handwritten letter:* B