

FEE \$10.00


FENCE PERMIT

GRAND JUNCTION COMMUNITY DEVELOPMENT DEPARTMENT

THIS SECTION TO BE COMPLETED BY APPLICANT

PROPERTY ADDRESS 2554 S. CORRAL DR
 TAX SCHEDULE NO 2701-344-11-002
 PROPERTY OWNER PAUL PETERSON
 OWNER'S PHONE 245 9686
 OWNER'S ADDRESS 2554 S. CORRAL
 CONTRACTOR _____
 CONTRACTOR'S PHONE _____
 FENCE MATERIAL CEDAR
 FENCE HEIGHT 6 foot

PLOT PLAN

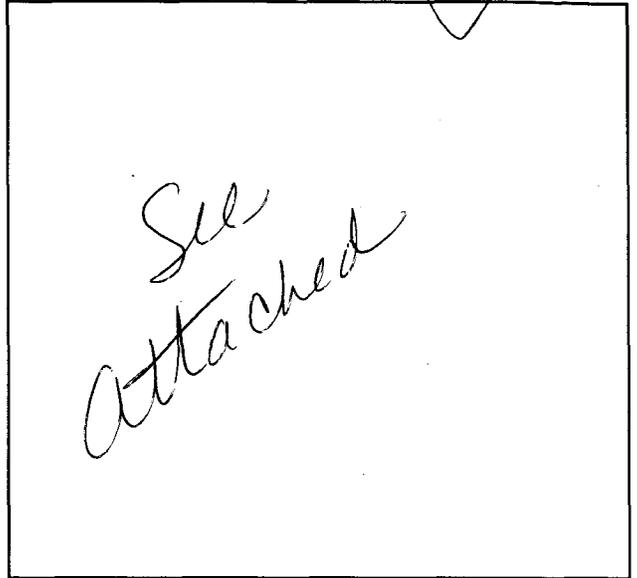

Plot plan must show property lines and property dimensions, all easements, all rights-of-way, all structures, all setbacks from property lines, & fence height(s).

THIS SECTION TO BE COMPLETED BY COMMUNITY DEVELOPMENT DEPARTMENT STAFF

ZONE PR-4.4
 SPECIAL CONDITIONS ACCO
approval required

SETBACKS: Front _____ from property line (PL) or
 _____ from center of ROW, whichever is greater.
 Side _____ from PL Rear _____ from PL

Fences exceeding six feet in height require a separate permit from the City/County Building Department. A fence constructed on a corner lot that extends past the rear of the house along the side yard or abuts an alley requires approval from the City Engineer (Section 5-5-5B of the Grand Junction Zoning and Development Code).

The owner/applicant must correctly identify all property lines, easements, and rights-of-way and ensure the fence is located within the property's boundaries. Covenants, conditions, restrictions, easements and/or rights-of-way may restrict or prohibit the placement of fence(s). The owner/applicant is responsible for compliance with covenants, conditions, and restrictions which may apply. Fences built in easements may be subject to removal at the property owner's sole and absolute expense. Any modification of design and/or material as approved in this fence permit must be approved, in writing, by the Community Development Department Director.

I hereby acknowledge that I have read this application and the information and plot plan are correct; I agree to comply with any and all codes, ordinances, laws, regulations, or restrictions which apply.

I understand that failure to comply shall result in legal action, which may include but not necessarily be limited to removal of the fence(s) at the owner's cost.

Applicant's Signature Paul Peterson

Date May 2-97

Community Development's Approval Marcia Rabideaux

Date 5-2-97

City Engineer's Approval (if required) _____


Date _____

VALID FOR SIX MONTHS FROM DATE OF ISSUANCE (Section 9-3-2D Grand Junction Zoning & Development Code)

(White: Community Development)

(Yellow: Code Enforcement)

(Pink: Customer)

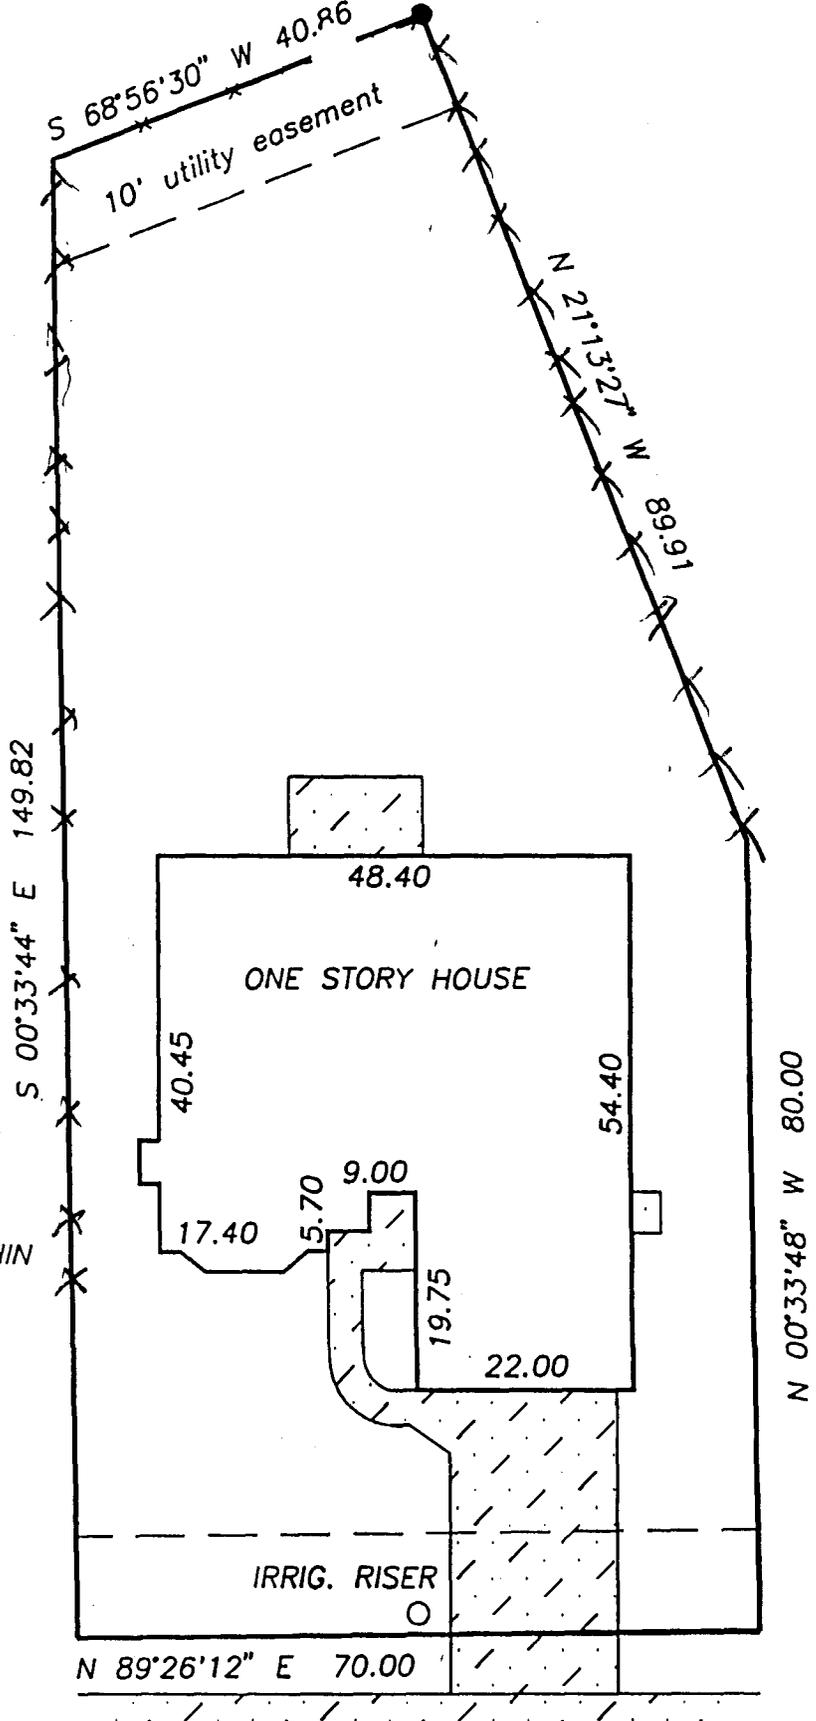

DESCRIPTION

LOT 2, BLOCK 1,
WILSON RANCH FILING 2
MESA COUNTY, COLORADO

MERIDIAN 20306

LEGEND & NOTES

● FOUND SURVEY MONUMENTS SET BY
QED

THIS PROPERTY DOES NOT FALL WITHIN
THE 100 YEAR FLOOD PLAIN

IMPROVEMENT LOCATION CERTIFICATE

I hereby certify that this improvement location certificate was prepared for NORWEST MORTGAGE; the improvement location being based on monuments as shown hereon, and is not to be relied upon for the establishment of fence, building or other future improvement lines. I further certify that the improvements on the above described parcel on this date, _____, except utility connections, are entirely within the boundaries of the parcel, except as shown, and that there are no encroachments upon the described premises by improvements or any adjoining premises except as indicated, and that there is no evidence or sign of any easement crossing or burdening any part of said parcel, except as noted.

**SOUTH
CORRAL
DRIVE**

