

FEE \$10.00

PERMIT # 10379


FENCE PERMIT

GRAND JUNCTION COMMUNITY DEVELOPMENT DEPARTMENT

THIS SECTION TO BE COMPLETED BY APPLICANT

PLOT PLAN

PROPERTY ADDRESS 505 W. UTE AVE
 TAX SCHEDULE NO 2945-154-24-001
 PROPERTY OWNER WILLIAM F. NOVINGER
 OWNER'S PHONE 970-241-5051
 OWNER'S ADDRESS 505 W. UTE AVE
 CONTRACTOR SELF
 CONTRACTOR'S PHONE _____
 FENCE MATERIAL Chain Link
 FENCE HEIGHT 6'

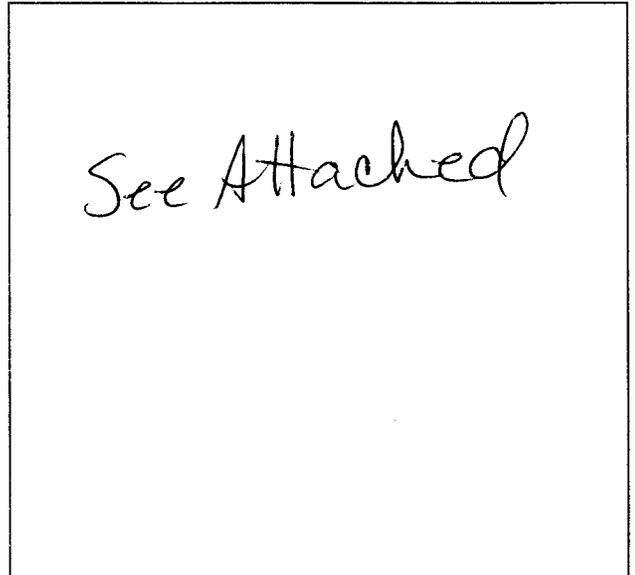

Plot plan must show property lines and property dimensions, all easements, all rights-of-way, all structures, all setbacks from property lines, & fence height(s).

THIS SECTION TO BE COMPLETED BY COMMUNITY DEVELOPMENT DEPARTMENT STAFF

ZONE RSF-8
 SPECIAL CONDITIONS _____

SETBACKS: Front 20' from property line (PL) or
45' from center of ROW, whichever is greater.
 Side _____ from PL Rear _____ from PL

Fences exceeding six feet in height require a separate permit from the City/County Building Department. A fence constructed on a corner lot that extends past the rear of the house along the side yard or abuts an alley requires approval from the City Engineer (Section 5-5-5B of the Grand Junction Zoning and Development Code).

The owner/applicant must correctly identify all property lines, easements, and rights-of-way and ensure the fence is located within the property's boundaries. Covenants, conditions, restrictions, easements and/or rights-of-way may restrict or prohibit the placement of fence(s). The owner/applicant is responsible for compliance with covenants, conditions, and restrictions which may apply. Fences built in easements may be subject to removal at the property owner's sole and absolute expense. Any modification of design and/or material as approved in this fence permit must be approved, in writing, by the Community Development Department Director.

I hereby acknowledge that I have read this application and the information and plot plan are correct; I agree to comply with any and all codes, ordinances, laws, regulations, or restrictions which apply.

I understand that failure to comply shall result in legal action, which may include but not necessarily be limited to removal of the fence(s) at the owner's cost.

Applicant's Signature William F. Novinger
 Community Development's Approval Luca J. Costello
 City Engineer's Approval (if required) _____


Date 6-9-98
 Date 6-9-98
 Date _____

VALID FOR SIX MONTHS FROM DATE OF ISSUANCE (Section 9-3-2D Grand Junction Zoning & Development Code)

(White: Community Development)

(Yellow: Code Enforcement)

(Pink: Customer)

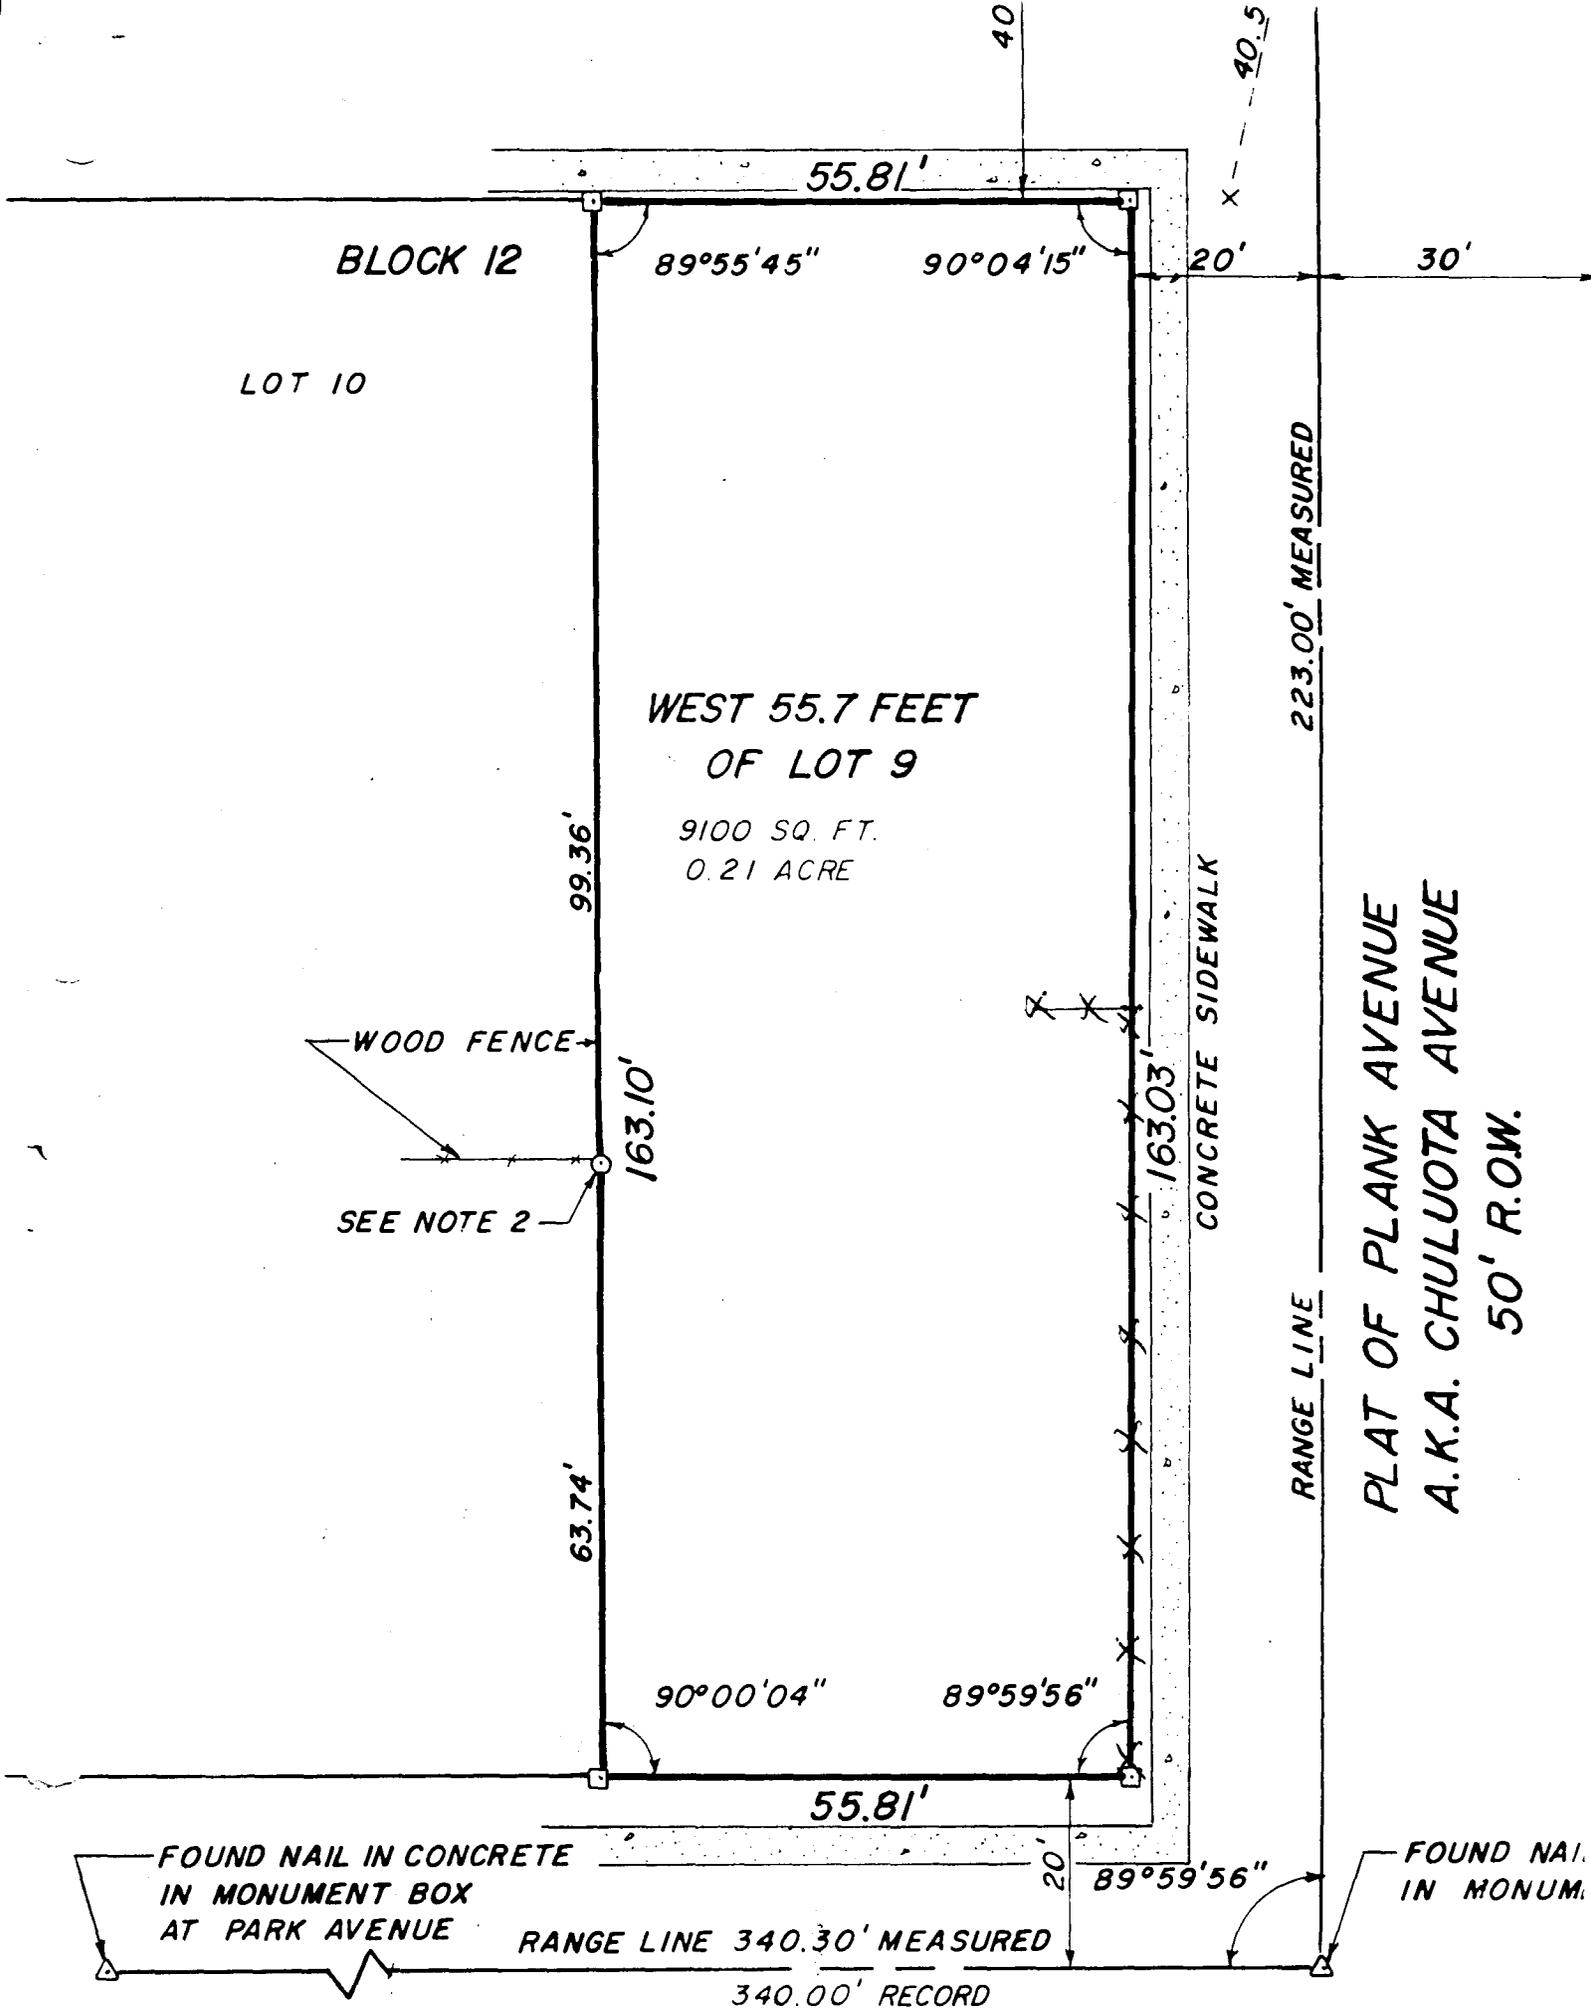

BLOCK 12

LOT 10

WEST 55.7 FEET
OF LOT 9

9100 SQ. FT.
0.21 ACRE

PLAT OF PLANK AVENUE
A.K.A. CHULUOTA AVENUE
50' R.O.W.

FOUND NAIL IN CONCRETE
IN MONUMENT BOX
AT PARK AVENUE

FOUND NAIL
IN MONUM.

RANGE LINE 340.30' MEASURED

340.00' RECORD

RIVERVIEW (A.K.A. FAIRVIEW) AVENUE