

FEE \$10.00

PERMIT # 10330

# FENCE PERMIT

## GRAND JUNCTION COMMUNITY DEVELOPMENT DEPARTMENT

THIS SECTION TO BE COMPLETED BY APPLICANT

PLOT PLAN

PROPERTY ADDRESS 1514 PIERMIGAN CT SOUTH  
 TAX SCHEDULE NO 2945-012.53-002  
 PROPERTY OWNER RONALD & KATHERINE CLINE  
 OWNER'S PHONE 245-4400  
 OWNER'S ADDRESS same as above  
 CONTRACTOR self  
 CONTRACTOR'S PHONE \_\_\_\_\_  
 FENCE MATERIAL cedar  
 FENCE HEIGHT 6'



Plot plan must show property lines and property dimensions, all easements, all rights-of-way, all structures, all setbacks from property lines, & fence height(s).

THIS SECTION TO BE COMPLETED BY COMMUNITY DEVELOPMENT DEPARTMENT STAFF

ZONE RSF-4  
 SPECIAL CONDITIONS cannot build a 6' fence in setback

SETBACKS: Front 20' from property line (PL) or  
45' from center of ROW, whichever is greater.  
 Side \_\_\_\_\_ from PL Rear \_\_\_\_\_ from PL

Fences exceeding six feet in height require a separate permit from the City/County Building Department. A fence constructed on a corner lot that extends past the rear of the house along the side yard or abuts an alley requires approval from the City Engineer (Section 5-5-5B of the Grand Junction Zoning and Development Code).

The owner/applicant must correctly identify all property lines, easements, and rights-of-way and ensure the fence is located within the property's boundaries. Covenants, conditions, restrictions, easements and/or rights-of-way may restrict or prohibit the placement of fence(s). The owner/applicant is responsible for compliance with covenants, conditions, and restrictions which may apply. Fences built in easements may be subject to removal at the property owner's sole and absolute expense. Any modification of design and/or material as approved in this fence permit must be approved, in writing, by the Community Development Department Director.

I hereby acknowledge that I have read this application and the information and plot plan are correct; I agree to comply with any and all codes, ordinances, laws, regulations, or restrictions which apply.

I understand that failure to comply shall result in legal action, which may include but not necessarily be limited to removal of the fence(s) at the owner's cost.

Applicant's Signature Ronald D. Cline

Date 5/18/98

Community Development's Approval X Valdez

Date 5-18-98

City Engineer's Approval (if required) \_\_\_\_\_

Date \_\_\_\_\_

VALID FOR SIX MONTHS FROM DATE OF ISSUANCE (Section 9-3-2D Grand Junction Zoning & Development Code)

(White: Community Development)

(Yellow: Code Enforcement)


(Pink: Customer)

WITH TO THE CENTERLINE OF SAID VACATED STREET AS  
 OF PTARMIGAN RIDGE FILING 2; THENCE N 89°49'54" W  
 00'10'05" E 20.00 FEET; THENCE S 89°49'54" E 74.26 FEET  
 FINISHING,  
 ADO.

*Surveyor*



SCALE: 1" = 30'

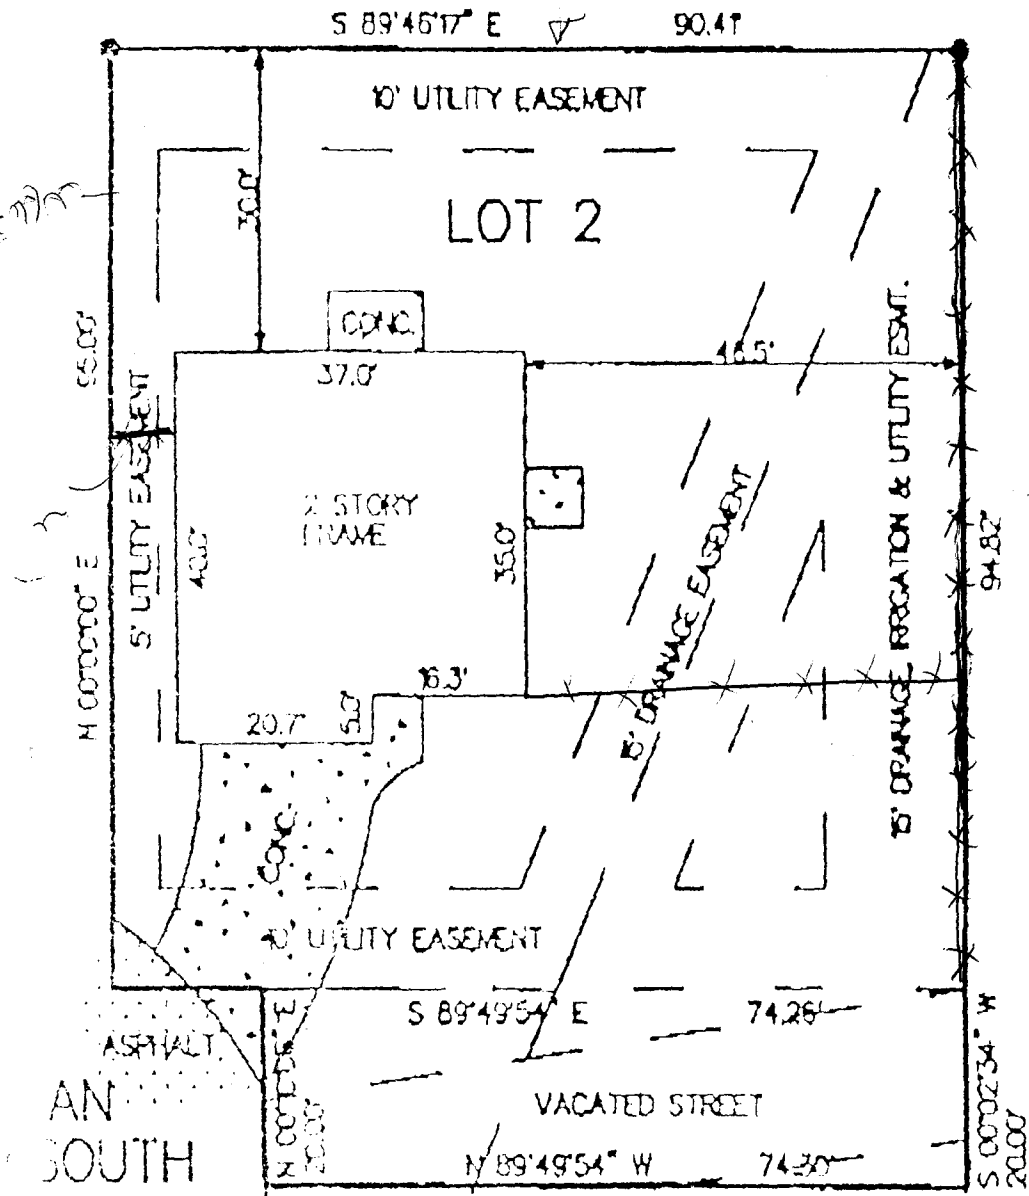

UTILITY, DRAINAGE  
 & IRRIGATION  
 EASEMENT  
 INGRESS &  
 EGRESS ACCESS  
 BK 2032  
 &  
 PAGE 509

AN  
 SOUTH