

FEE \$10.00

PERMIT # 10238


FENCE PERMIT

GRAND JUNCTION COMMUNITY DEVELOPMENT DEPARTMENT

THIS SECTION TO BE COMPLETED BY APPLICANT

PLOT PLAN

PROPERTY ADDRESS 4225 Applwood Ct
 TAX SCHEDULE NO 2945-011-710-004
 PROPERTY OWNER Mark + Dana Naatz
 OWNER'S PHONE 243-5414
 OWNER'S ADDRESS 4225 Applwood Ct
 CONTRACTOR Duf
 CONTRACTOR'S PHONE _____
 FENCE MATERIAL Cedar
 FENCE HEIGHT 6 ft

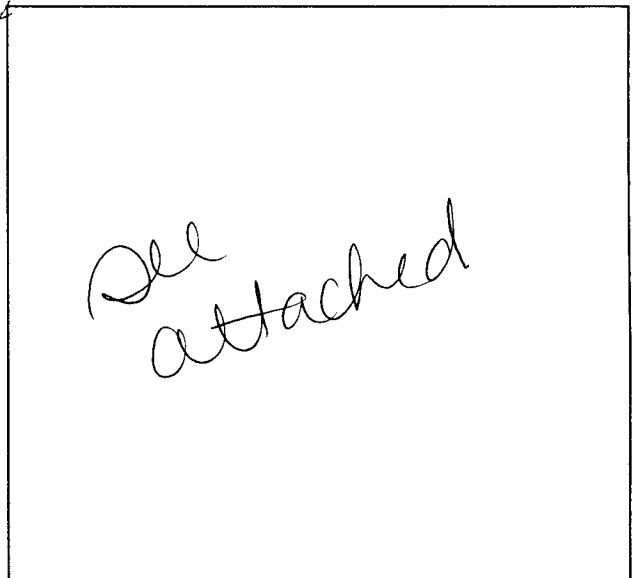

Plot plan must show property lines and property dimensions, all easements, all rights-of-way, all structures, all setbacks from property lines, & fence height(s).

THIS SECTION TO BE COMPLETED BY COMMUNITY DEVELOPMENT DEPARTMENT STAFF

ZONE PR-2
 SPECIAL CONDITIONS _____

SETBACKS: Front 20' from property line (PL) or _____ from center of ROW, whichever is greater.
 Side _____ from PL Rear _____ from PL

Fences exceeding six feet in height require a separate permit from the City/County Building Department. A fence constructed on a corner lot that extends past the rear of the house along the side yard or abuts an alley requires approval from the City Engineer (Section 5-5-5B of the Grand Junction Zoning and Development Code).

The owner/applicant must correctly identify all property lines, easements, and rights-of-way and ensure the fence is located within the property's boundaries. Covenants, conditions, restrictions, easements and/or rights-of-way may restrict or prohibit the placement of fence(s). The owner/applicant is responsible for compliance with covenants, conditions, and restrictions which may apply. Fences built in easements may be subject to removal at the property owner's sole and absolute expense. Any modification of design and/or material as approved in this fence permit must be approved, in writing, by the Community Development Department Director.

I hereby acknowledge that I have read this application and the information and plot plan are correct; I agree to comply with any and all codes, ordinances, laws, regulations, or restrictions which apply.

I understand that failure to comply shall result in legal action, which may include but not necessarily be limited to removal of the fence(s) at the owner's cost.

Applicant's Signature Dana J. Naatz
 Community Development's Approval [Signature] per SC
 City Engineer's Approval (if required) _____

Date 3/24/98
 Date 3-24-98
 Date _____

VALID FOR SIX MONTHS FROM DATE OF ISSUANCE (Section 9-3-2D Grand Junction Zoning & Development Code)

(White: Community Development) (Yellow: Code Enforcement) (Pink: Customer)

IMPROVEMENT LOCATION CERTIFICATE

4225 APPLEWOOD COURT


MERIDIAN LAND TITLE #26336
NAATZ ACCT.

LOT 4 IN BLOCK 2 OF VISTA DE NORTE,
MESA COUNTY, COLORADO.



SCALE: 1" = 30'

242 - 0040
Jack Braughton

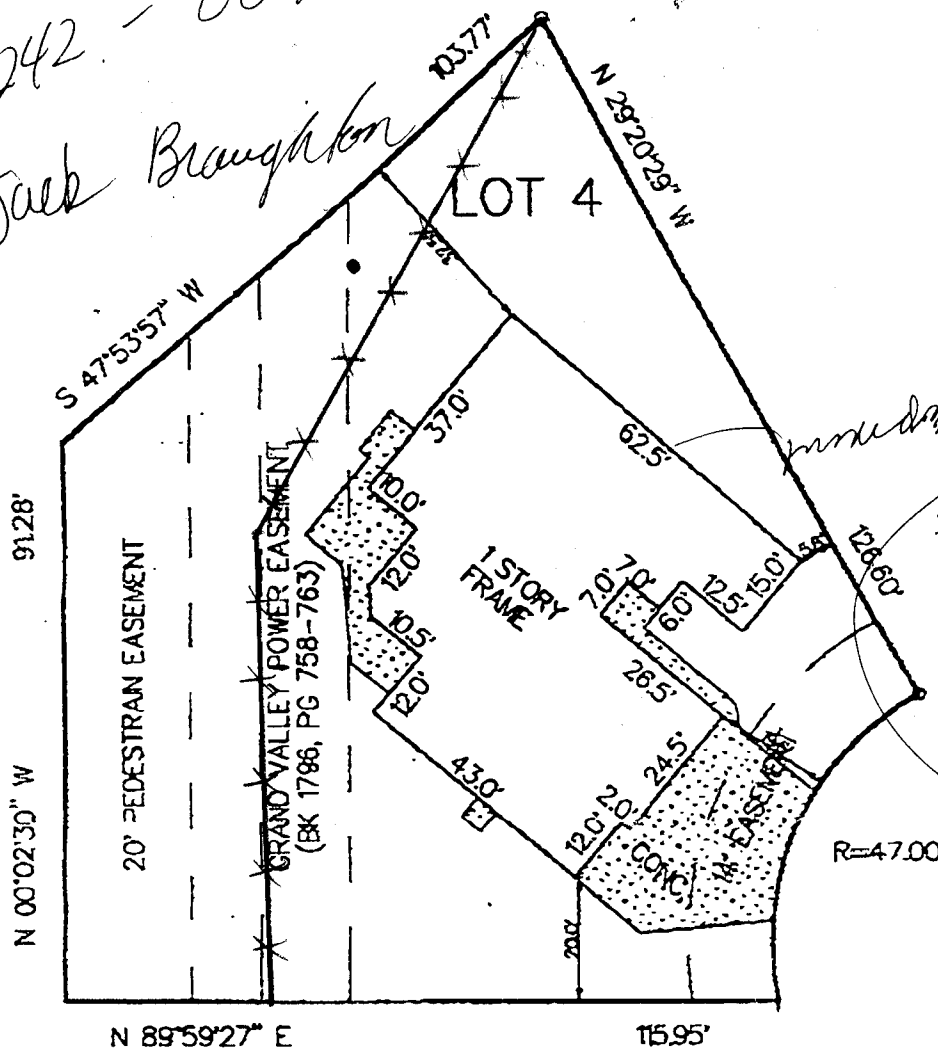

*Community Development Dept
City of Mesa
6/10/97
HSC*

NOTE: THIS PROPERTY DOES NOT FALL WITHIN ANY 100 YEAR FLOODPLAIN.

I HEREBY CERTIFY THAT THIS IMPROVEMENT LOCATION CERTIFICATE WAS PREPARED FOR CENTENNIAL SAVINGS, THAT IT IS NOT A LAND SURVEY PLAT OR IMPROVEMENT SURVEY PLAT, AND THAT IT IS NOT TO BE RELIED UPON FOR THE ESTABLISHMENT OF FENCE, BUILDING OR OTHER FUTURE IMPROVEMENT LINES. I FURTHER CERTIFY THE IMPROVEMENTS ON THE ABOVE DESCRIBED PARCEL ON THIS DATE, 6/10/97 EXCEPT UTILITY CONNECTIONS, ARE ENTIRELY WITHIN THE BOUNDARIES OF THE PARCEL, EXCEPT AS SHOWN, THAT THERE ARE NO ENCROACHMENTS UPON THE DESCRIBED PREMISES BY IMPROVEMENTS ON ANY ADJOINING PREMISES, EXCEPT AS INDICATED, AND THAT THERE IS NO EVIDENCE OR SIGN OF ANY EASEMENT CROSSING OR BURDENING ANY PART OF SAID PARCEL, EXCEPT AS NOTED.

○ = FOUND PIN

Kenneth I. Glenn
KENNETH I. GLENN R.L.S. 12770



GRAND VALLEY POWER

P.O. Box 190, 2727 Grand Avenue
Grand Junction, Colorado 81502-0190
(970) 242-0040 • FAX (970) 242-0612

FAX TRANSMITTAL SHEET

Date: 3/23/98 pg 1 of 1

Transmitted: Time By

To: GRAND JUNCTION COMMUNITY

DEVELOPMENT DEPT. Fax # 244-1599

Attn: SENITA COSTELLO.

Subject: FENCE PERMIT, VISTA DEL NORTE,
BLOCK #2, LOT #4. (DANA NAATZ)

PERMISSION IS GRANTED FOR FENCELINE, CEDAR FENCE,
(REAR) TO BE INSTALLED 3'-0" INTO
EXISTING GRAND VALLEY POWER, 25'-0,
"NO STRUCTURE ZONE" OR 22'-0" EAST OF
TRANSMISSION LINE, CENTERLINE.

VARIANCE IS NECESSARY TO MATCH FENCELINE
OF LOT 3, BLOCK 2, PERMIT #10043, 6/12/97,

VARIANCE IS ALSO GRANTED HEREIN, SAME DISTANCE,
LOT 3, BLOCK 2 FOR THE RECORD.

From: Chuck Mitisek, Manager of Engineering

• Your Coop - Committed to Service •
GRAND VALLEY RURAL POWER LINES, INC.

CORRECTION: PER CHUCK MITISEK

3/24/98



GRAND VALLEY POWER

P.O. Box 190, 2727 Grand Avenue
Grand Junction, Colorado 81502-0190
(970) 242-0040 • FAX (970) 242-0612

CONVERSATION W/
DANA NAATZ
NK 248-9869

FAX TRANSMITTAL SHEET

Date: 3/24/98 pg 1 of 1

Transmitted: Time By

TO: GRAND JUNCTION COMMUNITY


DEVELOPMENT DEPT. Fax # 244-1599

Attn: SENTA COSTELLO.

SUBJECT: FENCE PERMIT, VISTA DEL NORTE,
BLOCK #2, LOT #4. (DANA NAATZ)

PERMISSION IS GRANTED FOR FENCELINE, CEDAR FENCE,
(PEAR) TO BE INSTALLED 3'-0" INTO
EXISTING GRAND VALLEY POWER, 25'-0,
"NO STRUCTURE ZONE" OR 22'-0" EAST OF
TRANSMISSION LINE, CENTERLINE.

DELETE

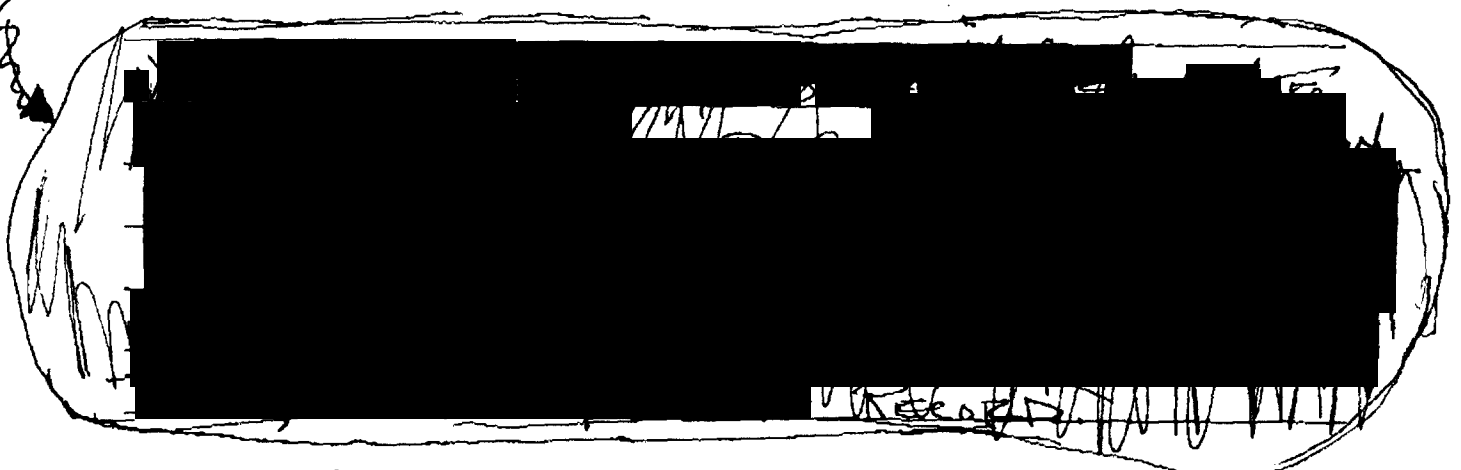

From: Chuck Mitisek, Manager of Engineering