

FEE \$10.00

PERMIT # 11325




FENCE PERMIT
GRAND JUNCTION COMMUNITY DEVELOPMENT DEPARTMENT

THIS SECTION TO BE COMPLETED BY APPLICANT

Handwritten initials in a circle

PLOT PLAN

PROPERTY ADDRESS 330 Sherman Dr
TAX SCHEDULE NO. 2945-252-17-022
PROPERTY OWNER Frank Tenorio
OWNER'S PHONE 970-241-8913
OWNER'S ADDRESS 330 Sherman Dr
CONTRACTOR Frank Tenorio
CONTRACTOR'S PHONE Same
CONTRACTOR'S ADDRESS Same
FENCE MATERIAL Cedar
FENCE HEIGHT 6' + 30"

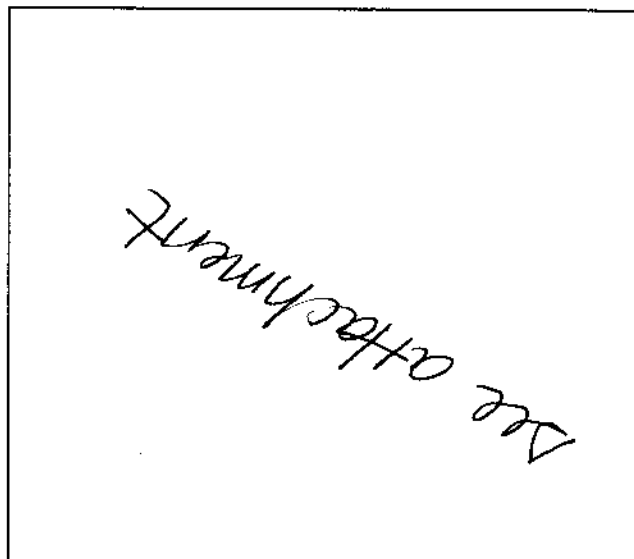

Plot plan must show property lines and property dimensions, all easements, all rights-of-way, all structures, all setbacks from property lines, & fence height(s).

THIS SECTION TO BE COMPLETED BY COMMUNITY DEVELOPMENT DEPARTMENT STAFF

ZONE RSF-8
SPECIAL CONDITIONS

SETBACKS: (principal) Front 20' from property line (PL) or from center of ROW, whichever is greater. Side 5' from PL Rear 15' from PL

Fences exceeding six feet in height require a separate permit from the City/County Building Department. A fence constructed on a corner lot that extends past the rear of the house along the side yard or abuts an alley requires approval from the City Engineer (Section 5-5-5B of the Grand Junction Zoning and Development Code).

The owner/applicant must correctly identify all property lines, easements, and rights-of-way and ensure the fence is located within the property's boundaries. Covenants, conditions, restrictions, easements and/or rights-of-way may restrict or prohibit the placement of fence(s). The owner/applicant is responsible for compliance with covenants, conditions, and restrictions which may apply. Fences built in easements may be subject to removal at the property owner's sole and absolute expense. Any modification of design and/or material as approved in this fence permit must be approved, in writing, by the Community Development Department Director.

I hereby acknowledge that I have read this application and the information and plot plan are correct; I agree to comply with any and all codes, ordinances, laws, regulations, or restrictions which apply.

I understand that failure to comply shall result in legal action, which may include but not necessarily be limited to removal of the fence(s) at the owner's cost.

Applicant's Signature Frank Tenorio
Community Development's Approval [Signature]
City Engineer's Approval (if required)

Date 8/6/99
Date 8-6-99
Date


VALID FOR SIX MONTHS FROM DATE OF ISSUANCE (Section 9-3-2D Grand Junction Zoning & Development Code)
(White: Planning) (Yellow: Customer) (Pink: Code Enforcement)

IMPROVEMENT LOCATION CERTIFICATE

330 SHERMAN DRIVE, GRAND JUNCTION, COLORADO

LOT 4, BLOCK 8, ARTESIA HEIGHTS, MESA COUNTY, COLORADO

SETBACK & SIDEYARD DISTANCES ARE PLUS OR MINUS ONE FOOT.

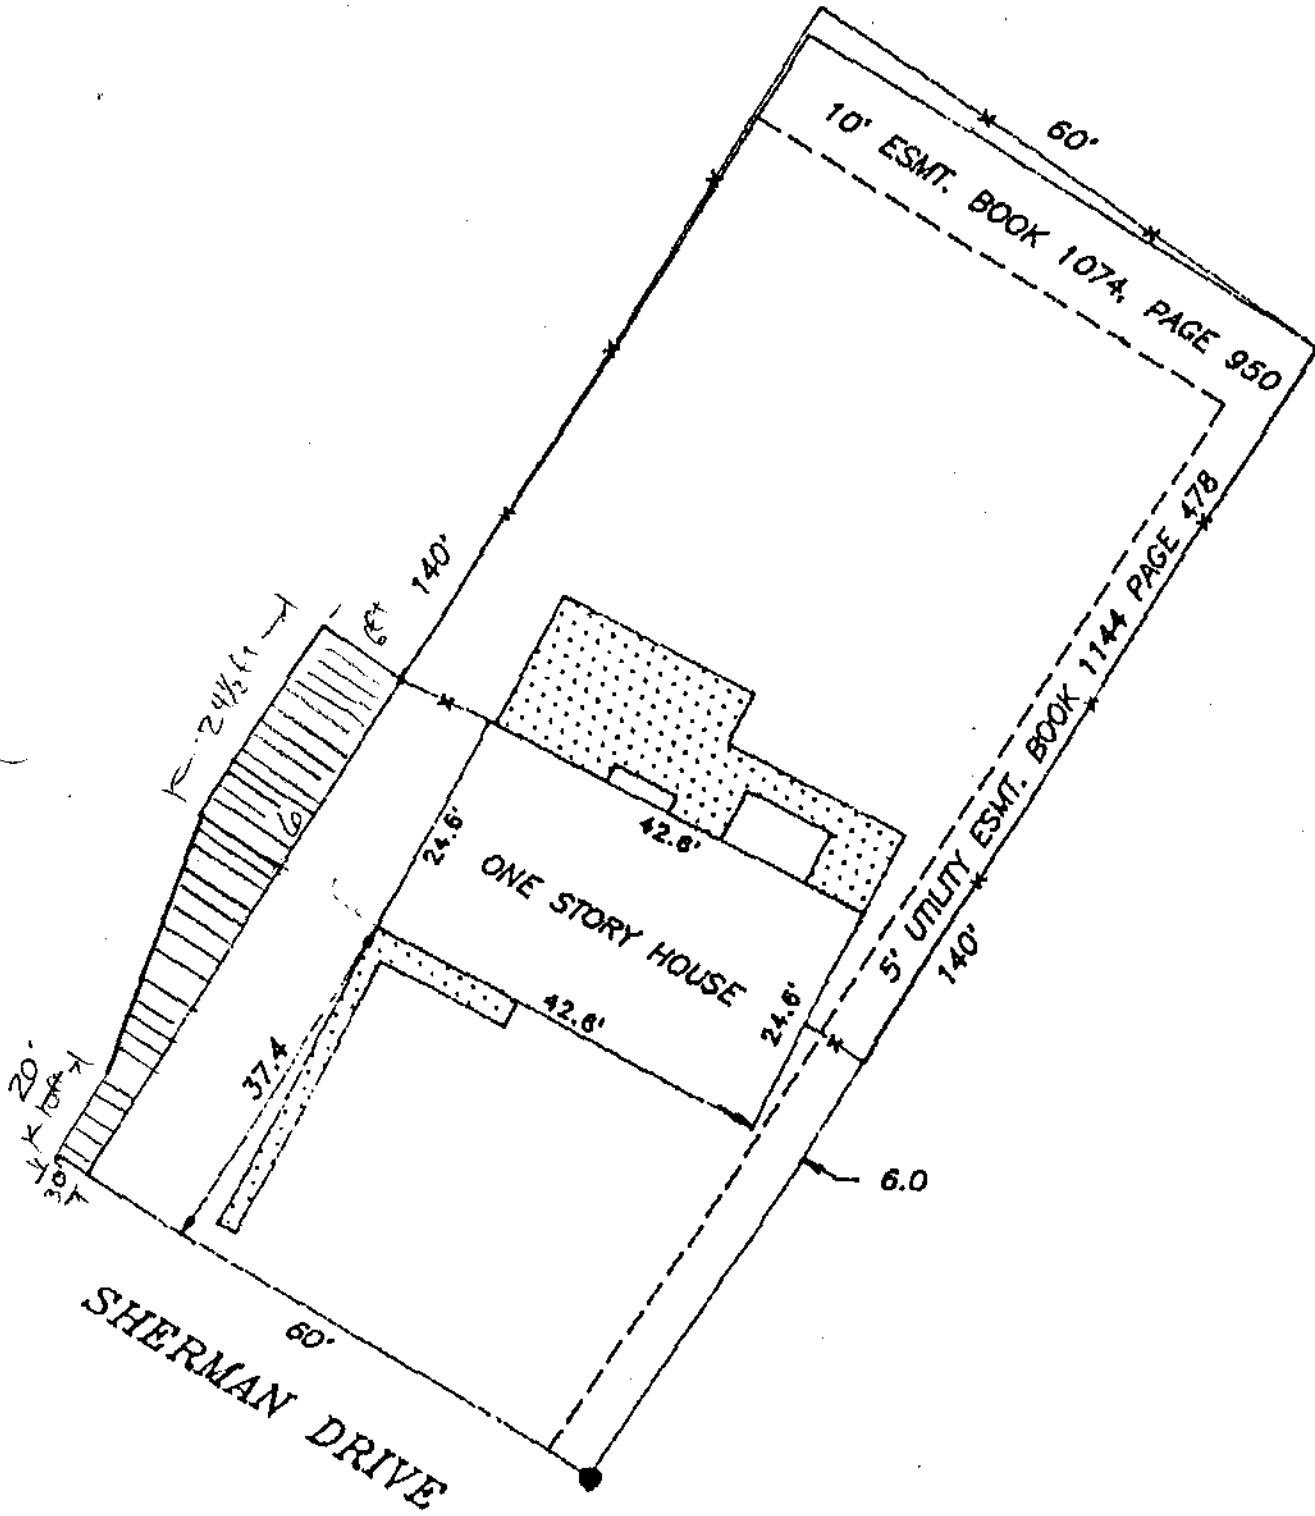

NOTE: LEGAL DESCRIPTION AND EASEMENT INFORMATION PROVIDED BY Abstract & Title
COMMITMENT NUMBER 890061

I HEREBY CERTIFY THAT THIS IMPROVEMENT LOCATION CERTIFICATE WAS PREPARED FOR Columbia Savings, THAT IT IS NOT A LAND SURVEY PLAT OR IMPROVEMENT SURVEY PLAT AND THAT IT IS NOT TO BE RELIED UPON FOR THE ESTABLISHMENT OF BOUNDARIES.