

FEE \$10.00

PERMIT # 10693



FENCE PERMIT
GRAND JUNCTION COMMUNITY DEVELOPMENT DEPARTMENT

Handwritten circled 'G'

THIS SECTION TO BE COMPLETED BY APPLICANT

PLOT PLAN

PROPERTY ADDRESS 2571 TRAILS END CT
TAX SCHEDULE NO 2945-031-44-003
PROPERTY OWNER MARK & Michelle Angela
OWNER'S PHONE 970-242-3714
OWNER'S ADDRESS 2571 TRAILS END CT
CONTRACTOR Owner
CONTRACTOR'S PHONE SAME AS OWNER
CONTRACTOR'S ADDRESS
FENCE MATERIAL CEDAR
FENCE HEIGHT SEE ATTACHED DIAGRAM

SEE ATTACHED DIAGRAM

Plot plan must show property lines and property dimensions, all easements, all rights-of-way, all structures, all setbacks from property lines, & fence height(s).

THIS SECTION TO BE COMPLETED BY COMMUNITY DEVELOPMENT DEPARTMENT STAFF

ZONE PR-3.7

SETBACKS: Front 20' from property line (PL) or from center of ROW, whichever is greater.

SPECIAL CONDITIONS

Handwritten notes: fence height pending, AD outcome # EPA-1999-071

Side from PL Rear from PL

Fences exceeding six feet in height require a separate permit from the City/County Building Department. A fence constructed on a corner lot that extends past the rear of the house along the side yard or abuts an alley requires approval from the City Engineer (Section 5-5-5B of the Grand Junction Zoning and Development Code).

The owner/applicant must correctly identify all property lines, easements, and rights-of-way and ensure the fence is located within the property's boundaries. Covenants, conditions, restrictions, easements and/or rights-of-way may restrict or prohibit the placement of fence(s). The owner/applicant is responsible for compliance with covenants, conditions, and restrictions which may apply. Fences built in easements may be subject to removal at the property owner's sole and absolute expense. Any modification of design and/or material as approved in this fence permit must be approved, in writing, by the Community Development Department Director.

I hereby acknowledge that I have read this application and the information and plot plan are correct; I agree to comply with any and all codes, ordinances, laws, regulations, or restrictions which apply.

I understand that failure to comply shall result in legal action, which may include but not necessarily be limited to removal of the fence(s) at the owner's cost.

Applicant's Signature Mark Angela

Date 4/12/99

Community Development's Approval K. Valdez PUKA

Date 4-12-99

City Engineer's Approval (if required)

Date


VALID FOR SIX MONTHS FROM DATE OF ISSUANCE (Section 9-3-2D Grand Junction Zoning & Development Code) (White: Planning) (Yellow: Customer) (Pink: Code Enforcement)



Scale 1"=30'

NOTE: LOT DOES NOT CLOSE MATHEMATICALLY

● = FOUND No.5 REBAR & CAP IS 27226

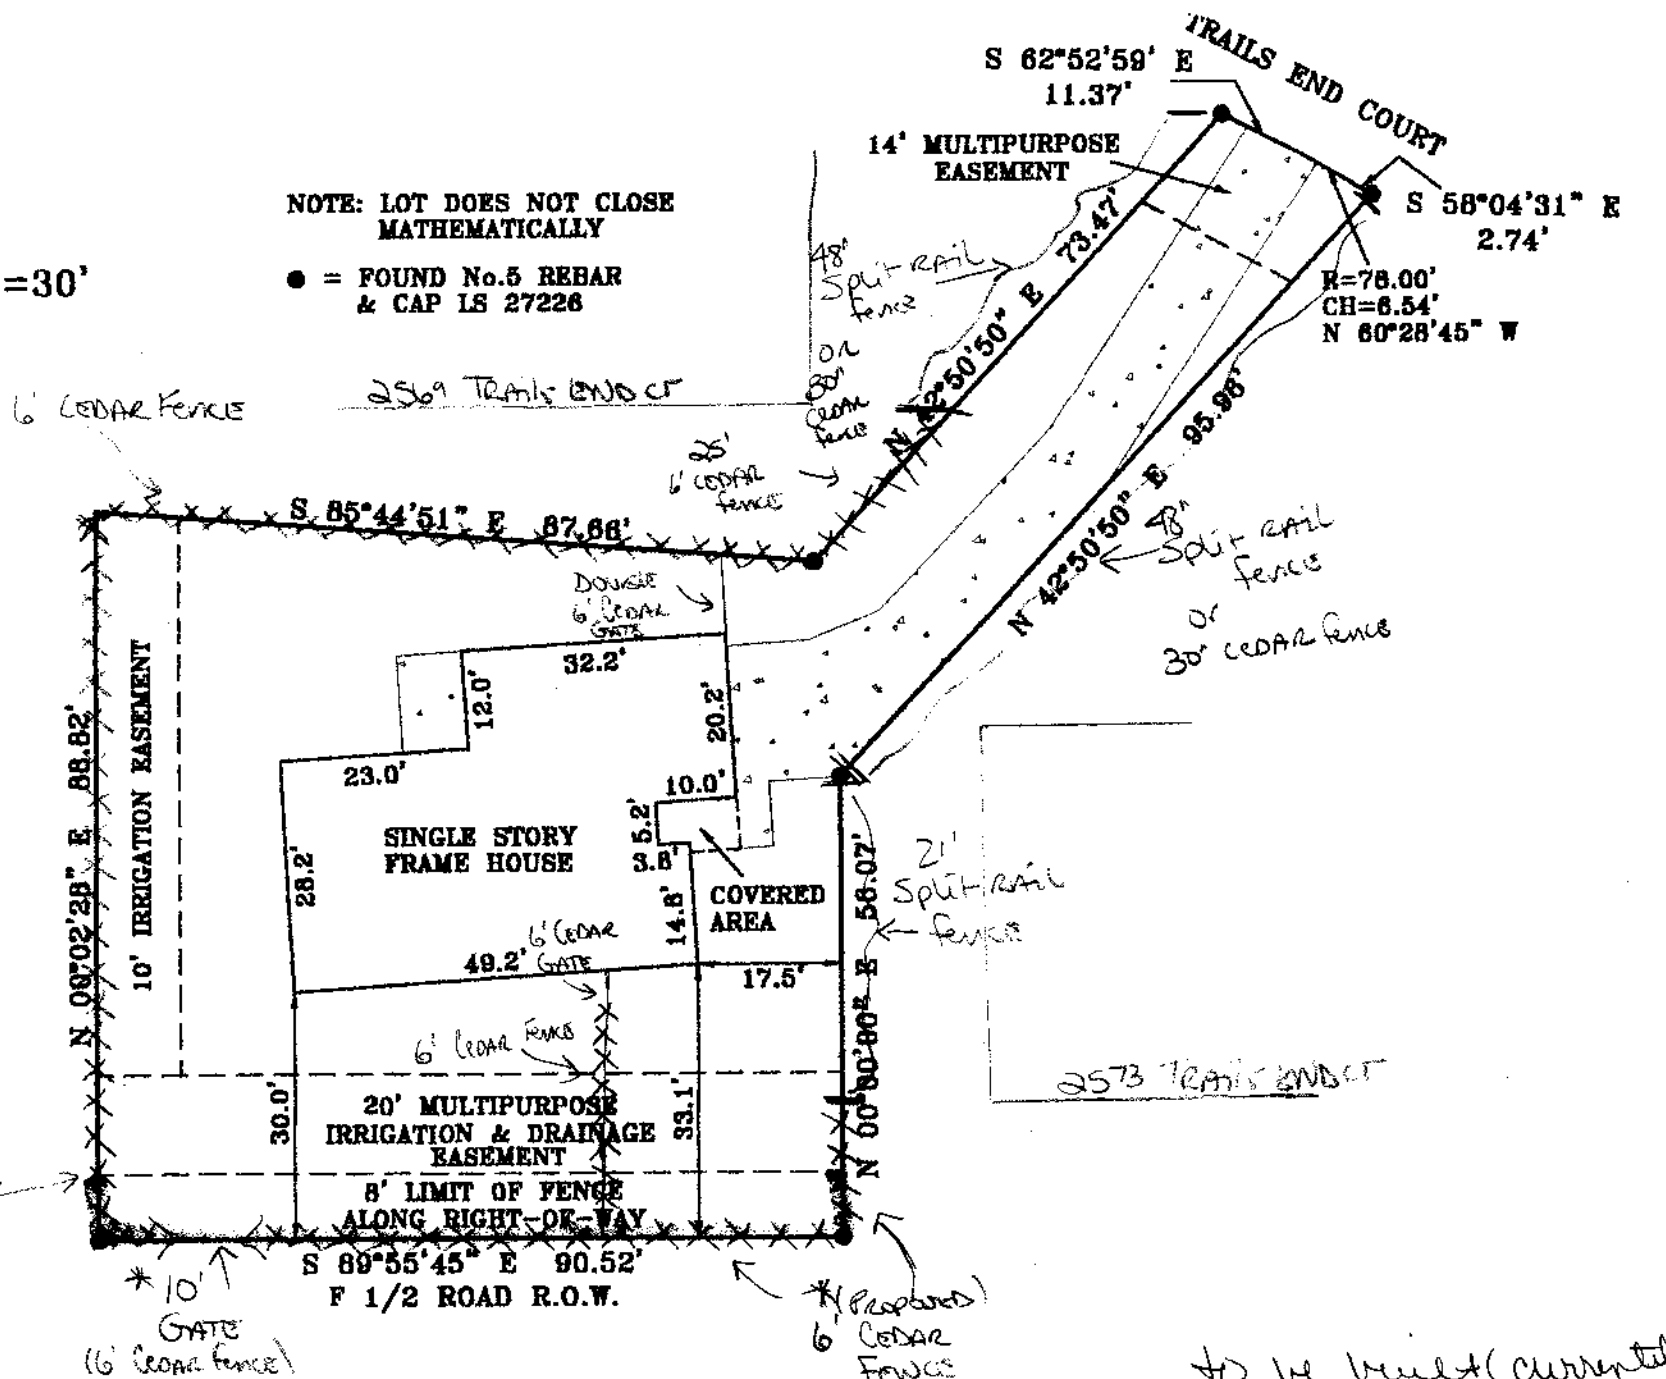

to be built (currently)

pending approval

* TO BE DETERMINED - possibly on 4-20-99