

FEE \$10.00

PERMIT # 10769




FENCE PERMIT
GRAND JUNCTION COMMUNITY DEVELOPMENT DEPARTMENT

Handwritten initials in a circle

THIS SECTION TO BE COMPLETED BY APPLICANT

PLOT PLAN

PROPERTY ADDRESS 619-2938 Rd
TAX SCHEDULE NO 2943-053-64-004
PROPERTY OWNER John & Denise Kampf
OWNER'S PHONE 241-6243
OWNER'S ADDRESS 619 2938 Rd
CONTRACTOR Lynn Phillips
CONTRACTOR'S PHONE 858-0249
CONTRACTOR'S ADDRESS 906 R Rd (MADIC)
FENCE MATERIAL Cedar
FENCE HEIGHT 6ft.

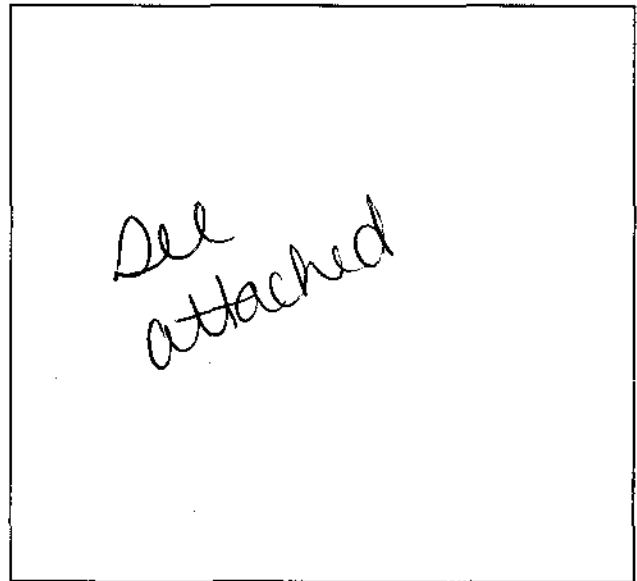

Plot plan must show property lines and property dimensions, all easements, all rights-of-way, all structures, all setbacks from property lines, & fence height(s).

THIS SECTION TO BE COMPLETED BY COMMUNITY DEVELOPMENT DEPARTMENT STAFF

ZONE PR-3.1
SPECIAL CONDITIONS

SETBACKS: Front 20' from property line (PL) or
from center of ROW, whichever is greater.
Side from PL Rear from PL

Fences exceeding six feet in height require a separate permit from the City/County Building Department. A fence constructed on a corner lot that extends past the rear of the house along the side yard or abuts an alley requires approval from the City Engineer (Section 5-5-5B of the Grand Junction Zoning and Development Code).

The owner/applicant must correctly identify all property lines, easements, and rights-of-way and ensure the fence is located within the property's boundaries. Covenants, conditions, restrictions, easements and/or rights-of-way may restrict or prohibit the placement of fence(s). The owner/applicant is responsible for compliance with covenants, conditions, and restrictions which may apply. Fences built in easements may be subject to removal at the property owner's sole and absolute expense. Any modification of design and/or material as approved in this fence permit must be approved, in writing, by the Community Development Department Director.

I hereby acknowledge that I have read this application and the information and plot plan are correct; I agree to comply with any and all codes, ordinances, laws, regulations, or restrictions which apply.

I understand that failure to comply shall result in legal action, which may include but not necessarily be limited to removal of the fence(s) at the owner's cost.

Applicant's Signature Denise Kampf
Community Development's Approval K. Valdez
City Engineer's Approval (if required)


Date 5/27/99
Date 5-27-99
Date

VALID FOR SIX MONTHS FROM DATE OF ISSUANCE (Section 9-3-2D Grand Junction Zoning & Development Code)
(White: Planning) (Yellow: Customer) (Pink: Code Enforcement)

30 W.C.

S 00° 09' 51" E 504.86'


10' IRRIGATION AND UTILITY EASEMENT

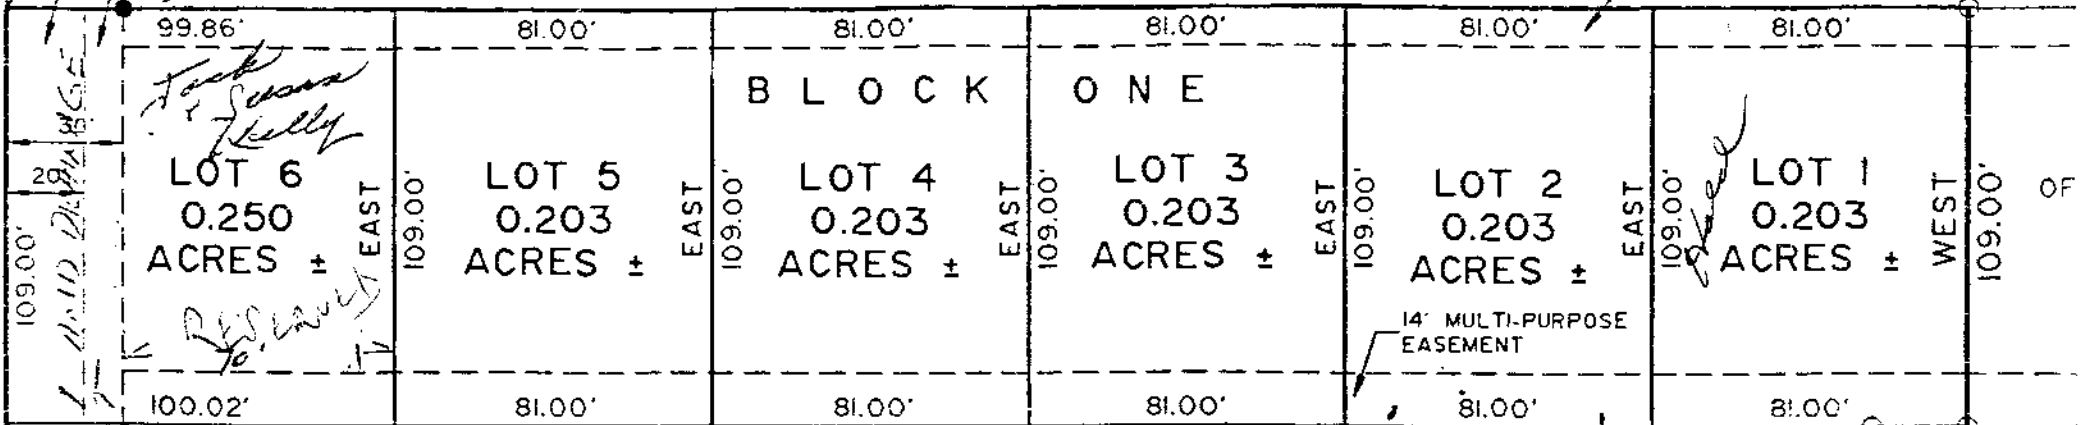

N 00° 09' 51" W
S 00° 09' 51" E

29 3

480.70'
480.73'
N 00° 09' 51" W 24.38'

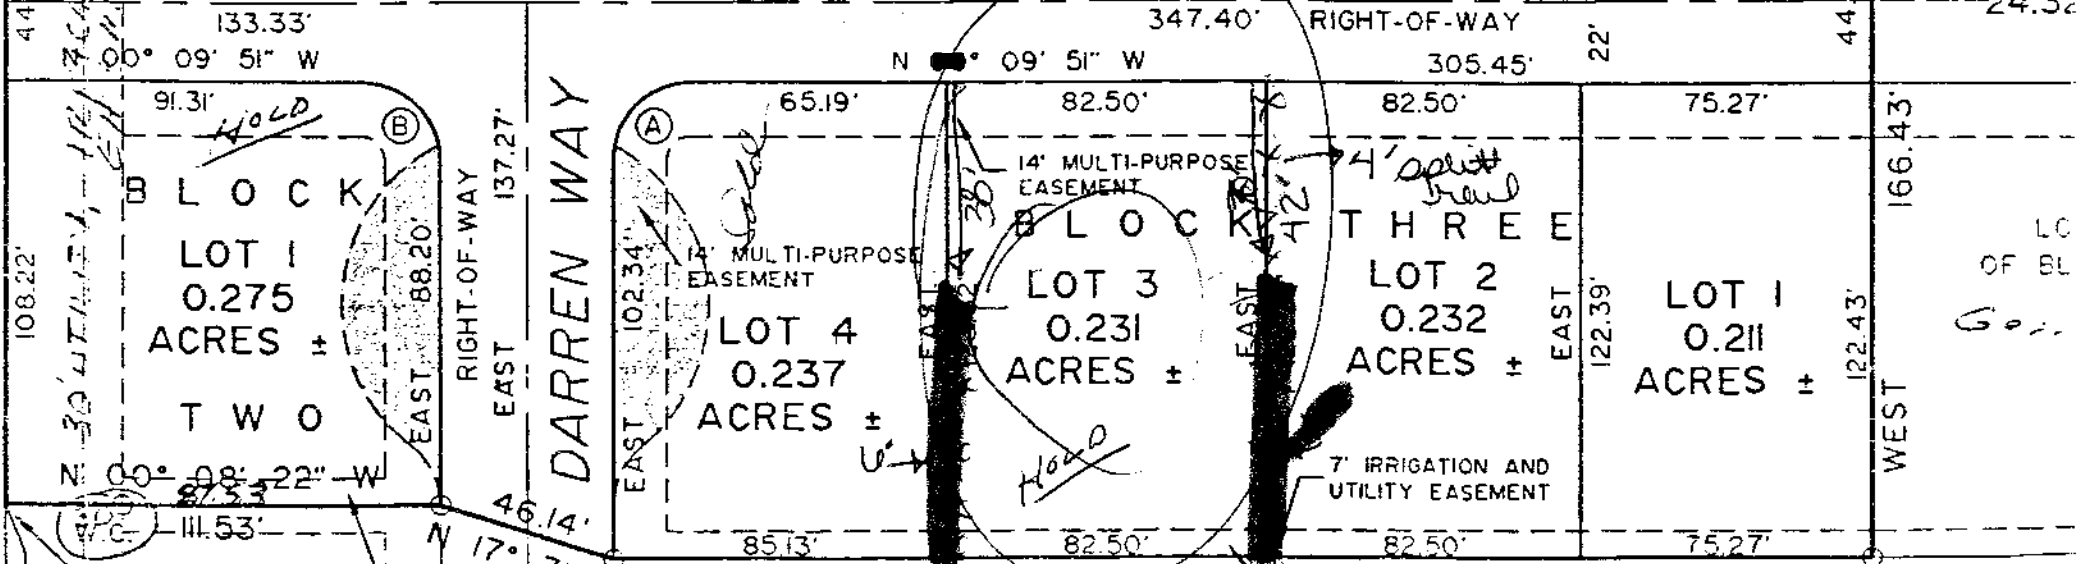

Sold

LOT 4
0.211 ACRES ±

LOT 3
0.218 ACRES ±

Sold

LOT 2
0.218 ACRES ±

Sold

LOT 1
0.279 ACRES ±

Sold

POINT OF
7
0.242 ACRES ±
S
4 00° 08' 22" W

30' W.C.