

FEE \$10.00

PERMIT # 10998

EX



FENCE PERMIT
GRAND JUNCTION COMMUNITY DEVELOPMENT DEPARTMENT

THIS SECTION TO BE COMPLETED BY APPLICANT

PLOT PLAN

PROPERTY ADDRESS 2564 Trails End CT

TAX SCHEDULE NO 2945-131-588-013

PROPERTY OWNER Richard I. and Eugenia G King

OWNER'S PHONE 970-243-3312

OWNER'S ADDRESS 2564 Trails End CT.


CONTRACTOR Self

CONTRACTOR'S PHONE

CONTRACTOR'S ADDRESS

FENCE MATERIAL Wood

FENCE HEIGHT 6 FT and 4 FT.

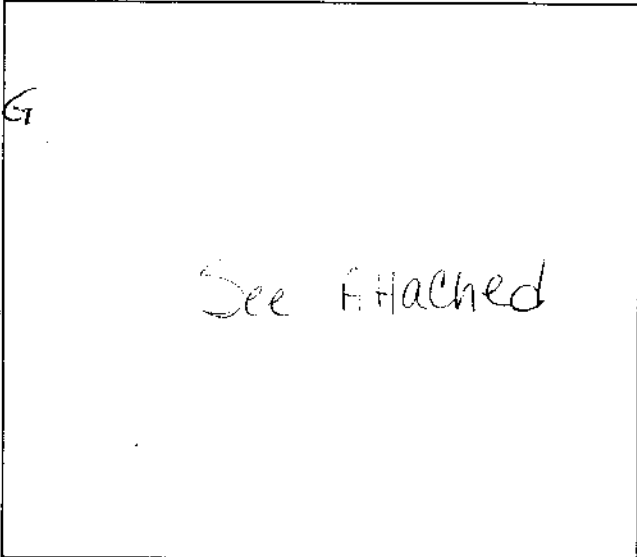

Plot plan must show property lines and property dimensions, all easements, all rights-of-way, all structures, all setbacks from property lines, & fence height(s).

THIS SECTION TO BE COMPLETED BY COMMUNITY DEVELOPMENT DEPARTMENT STAFF

ZONE PR 3.7

SETBACKS: Front from property line (PL) or from center of ROW, whichever is greater.

SPECIAL CONDITIONS

Side from PL Rear from PL

Fences exceeding six feet in height require a separate permit from the City/County Building Department. A fence constructed on a corner lot that extends past the rear of the house along the side yard or abuts an alley requires approval from the City Engineer (Section 5-5-5B of the Grand Junction Zoning and Development Code).

The owner/applicant must correctly identify all property lines, easements, and rights-of-way and ensure the fence is located within the property's boundaries. Covenants, conditions, restrictions, easements and/or rights-of-way may restrict or prohibit the placement of fence(s). The owner/applicant is responsible for compliance with covenants, conditions, and restrictions which may apply. Fences built in easements may be subject to removal at the property owner's sole and absolute expense. Any modification of design and/or material as approved in this fence permit must be approved, in writing, by the Community Development Department Director.

I hereby acknowledge that I have read this application and the information and plot plan are correct; I agree to comply with any and all codes, ordinances, laws, regulations, or restrictions which apply.

I understand that failure to comply shall result in legal action, which may include but not necessarily be limited to removal of the fence(s) at the owner's cost.

Applicant's Signature Richard I. King

Date 4/13/2000

Community Development's Approval Missy Anagon

Date 4/13/10

City Engineer's Approval (if required) N/A

Date


VALID FOR SIX MONTHS FROM DATE OF ISSUANCE (Section 9-3-2D Grand Junction Zoning & Development Code) (White: Planning) (Yellow: Customer) (Pink: Code Enforcement)

Dick and Gena King
 2564 Trails End Court
 Grand Junction, CO 81505
 970-243-3312

2564 Trails End
 Lot B Blk 1 Fl
 Cimarron North
 2945-031-44-013

4/13/00

ALL CHANGE OF SETBACKS MUST BE APPROVED BY THE CITY PLANNING DEPT. IT IS THE APPLICANT'S RESPONSIBILITY TO PROPERLY LOCATE AND IDENTIFY EASEMENTS AND PROPERTY LINES.

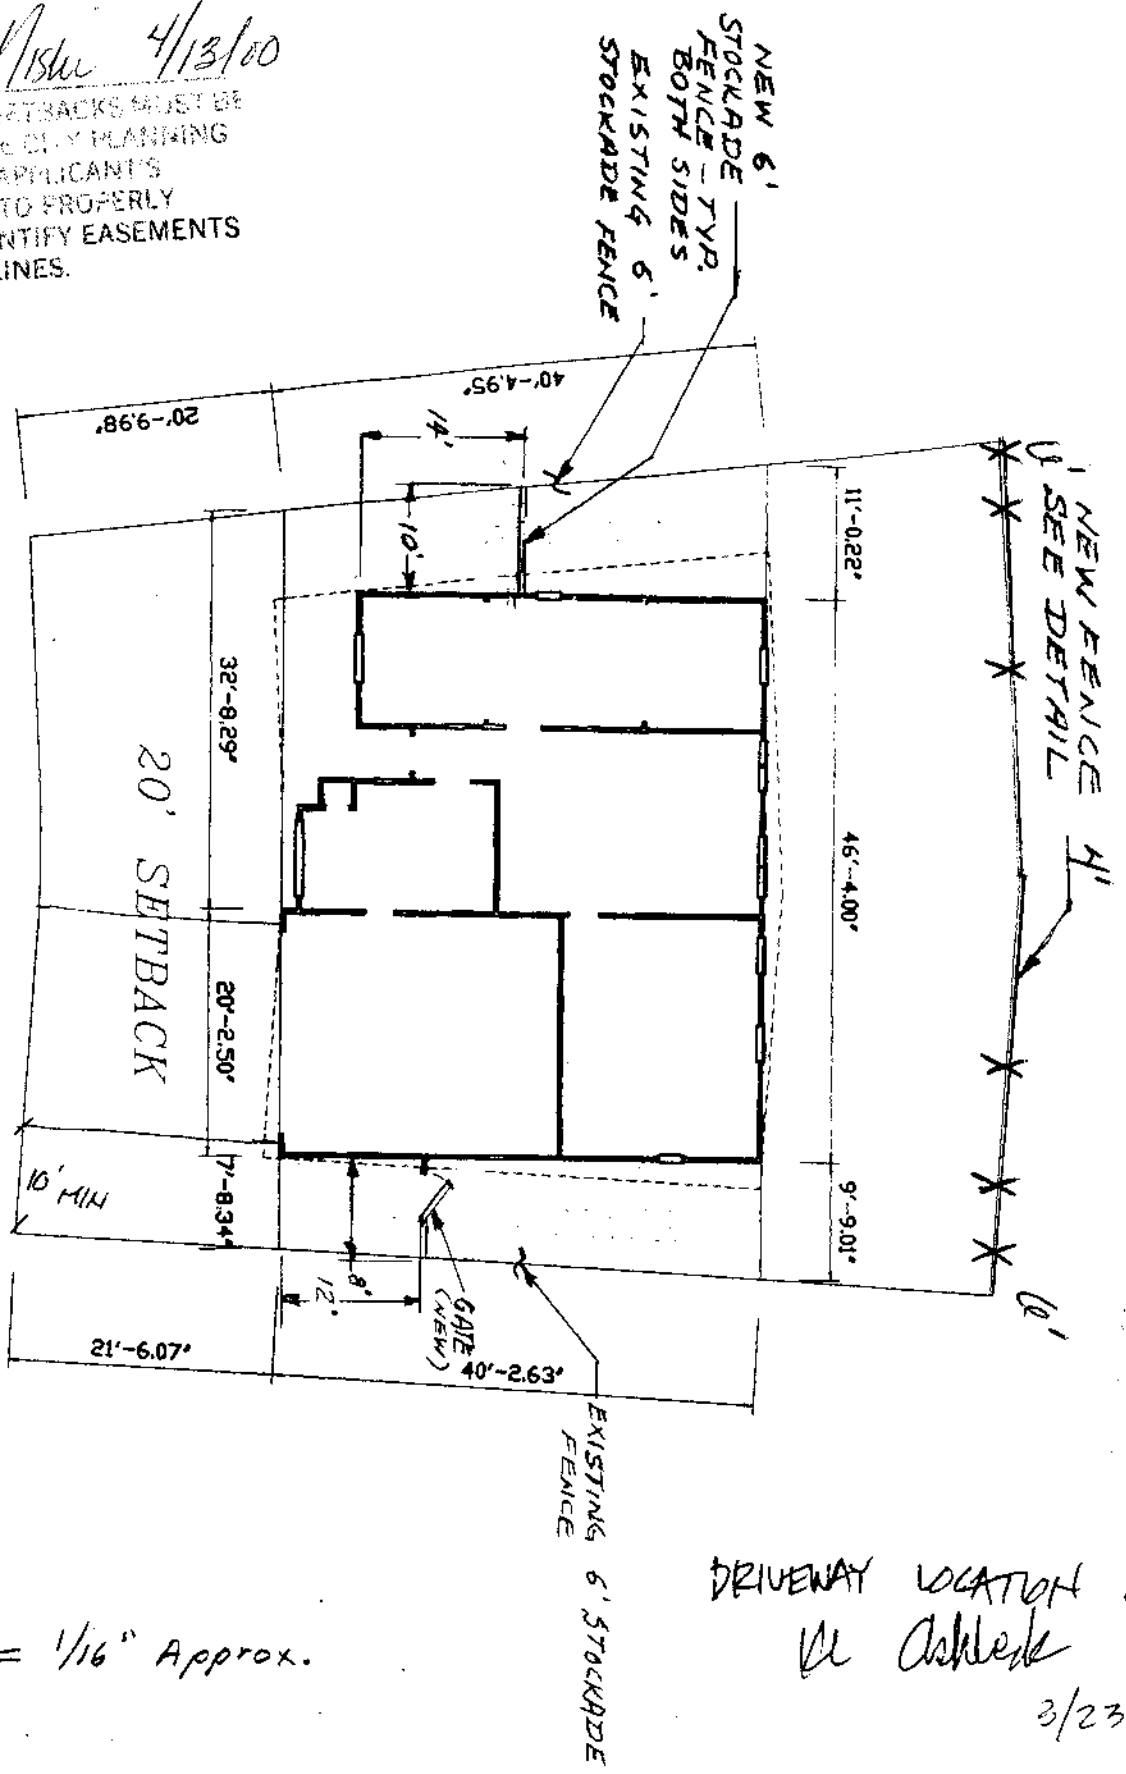

1 FT = 1/16" Approx.

DRIVEWAY LOCATION O.K.
 W. Ashlock
 3/23/98