

Purchasing Division

ADDENDUM NO. 1

DATE: August 3, 2017

FROM: City of Grand Junction Purchasing Division

TO: All Offerors

RE: Concrete Slab Construction for Streets Salt Shed IFB-4402-17-DH

Offerors responding to the above referenced solicitation are hereby instructed that the requirements have been clarified, modified, superseded and supplemented as to this date as hereinafter described.

Please make note of the following clarifications:


- 1. Delete the Bid Option for 8" thick concrete slab (Un-reinforced).
- 2. Meeting the schedule requirements is of great importance because this is a coordinated project involving multiple Contractors. The Contractor for the structure has already been selected, is under contract, and their schedule assumes completion of the floor slab prior to their structure installation.
- 3. This project is being bid with all work under one pay item. The intention is for that pay item to be all inclusive; including any and all ancillary items necessary to construct the slab floor including but not limited to reinforcing steel spacers, modified reinforcing steel placement at door openings, expansion joint materials, final prep of the base, and ensuring proper concrete cure conditions.
- 4. Final concrete surface shall be finished similar to concrete pavement with a burlap drag and light broom finish.
- 5. The Contractor or the Contractor's concrete material supplier shall provide QC level concrete materials testing. The QA level concrete materials testing will be performed by the City's current "on-call" materials testing firm, at the City's expense.
- 6. Requirements for the joint between the concrete slab and the concrete block base wall was described at the site visit portion of the Pre-Bid conference. A sketched detail is being included in this Addenda.
- 7. Requirements for the concrete and reinforcing steel layout in the area of the door openings was described at the site visit portion of the Pre-Bid conference. A sketched detail is being included in this Addenda.


The original solicitation for the project noted above is amended as noted.

All other conditions of subject remain the same.


Respectfully,

Duane Hoff Jr., Senior Buyer City of Grand Junction, Colorado

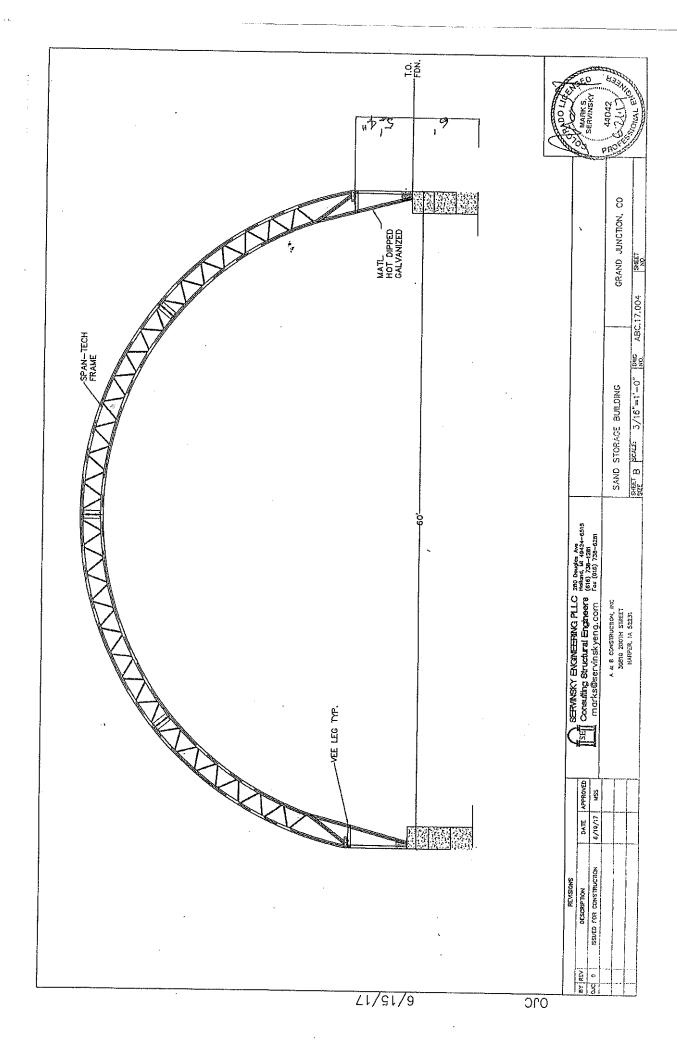

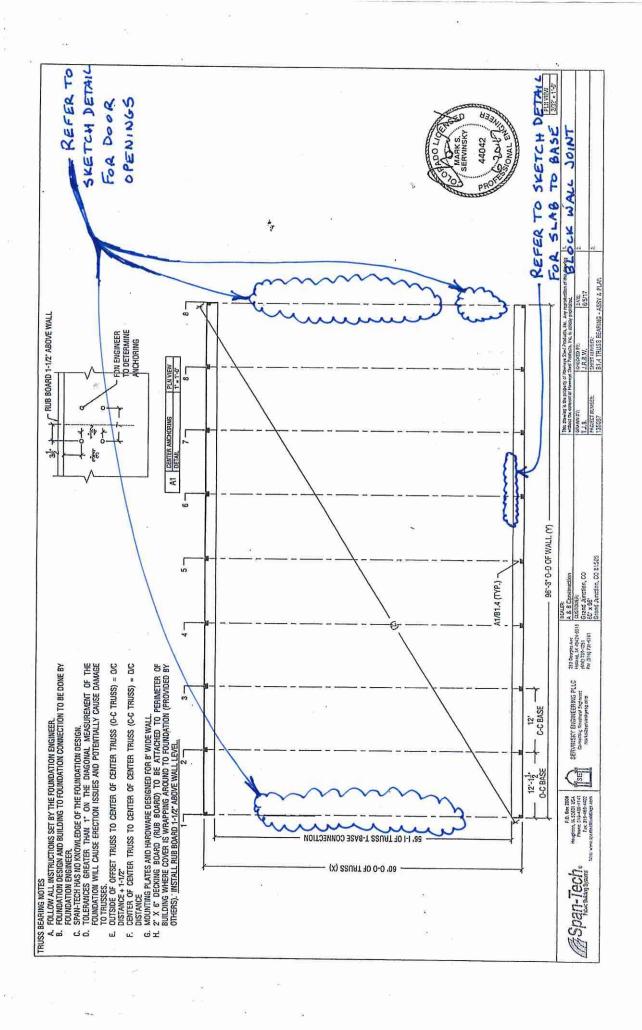


DETAIL FOR DOOR OPENINGS"

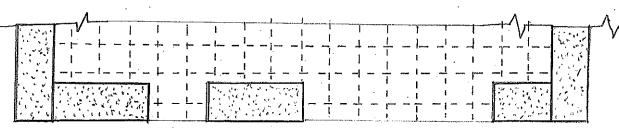

NOTE:

- 1. EXTEND THE SLAB AND REIN. STEEL INTO DOOR OPENINGS TO THE OUTSIDE FACE OF THE BASE BLOCK WALL'S.
- Z. MAINTAIN Z" COVER FROM BARS AND ALL SLAB EDGES. 3. SKETCH NOT TO SCALE
- 4. TYPICAL FOR ALL 3 DOOR OPENINGS

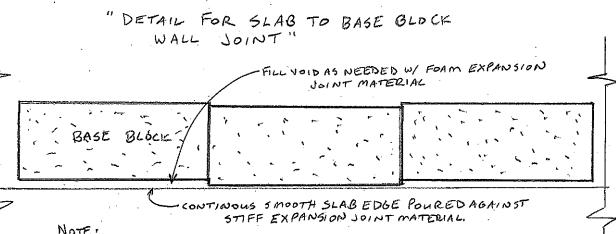

- NOTE:
 - 1. THE SLAB EDGE SHALL BE FLAT, SMOOTH AND NOT IN CONTACT WITH INDIVIDUAL BASE BLOCKS.
 - Z. SLAB SHALL BE SEPARATED FROM BASE BLOCKS BY A /Z" THICK, STIFF EXPANSION JOINT MATERIAL THAT IS CONTINOUS AND SMOOTH FOR THE FULL LENGTH.
 - 3. ADDITIONAL FOAM EXPANSION JOINT MATERIAL SHALL BE PLACED BETWEEN THE STIFF MATERIAL AND THE BASE BLOCKS AS NEEDED TO COMPLETELY FILL ANY VOIDS CREATED BY OFFSETS BETWEEN BLOCK FACES OR OTHER BLOCK IMPERFECTIONS.
 - 4. SKETCH NOT TO SCALE
 - 5. TYPICAL FOR ENTIRE LENGTH OF JOINT