

FEE \$10.00

PERMIT # 11639




FENCE PERMIT
GRAND JUNCTION COMMUNITY DEVELOPMENT DEPARTMENT

THIS SECTION TO BE COMPLETED BY APPLICANT

PLOT PLAN

PROPERTY ADDRESS 685 Centridge Dr.
TAX SCHEDULE NO. 2945-022-07-001
PROPERTY OWNER LINDA R. TODD
OWNER'S PHONE 970-241-0685
OWNER'S ADDRESS SAME
CONTRACTOR SELF
CONTRACTOR'S PHONE 241-0685
CONTRACTOR'S ADDRESS SAME
FENCE MATERIAL Cedar picket
FENCE HEIGHT 6'

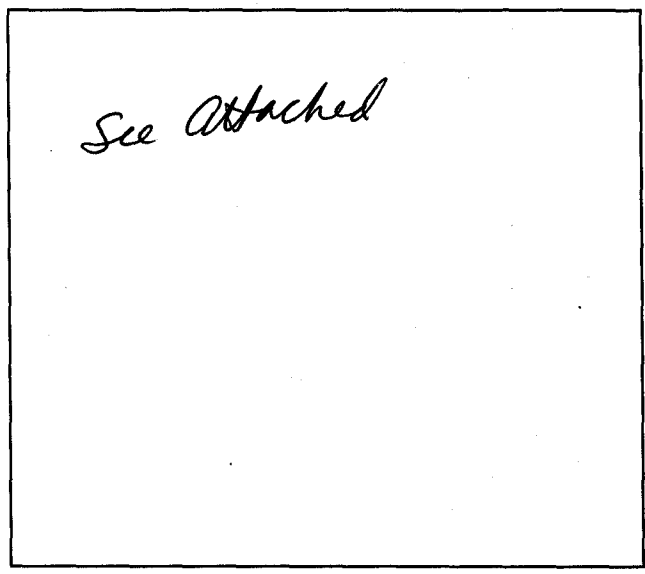

Plot plan must show property lines and property dimensions, all easements, all rights-of-way, all structures, all setbacks from property lines, & fence height(s).

THIS SECTION TO BE COMPLETED BY COMMUNITY DEVELOPMENT DEPARTMENT STAFF

ZONE RSF-1
SPECIAL CONDITIONS

SETBACKS: Front 20' from property line (PL) or
from center of ROW, whichever is greater.
Side 0' from PL Rear 0' from PL

Fences exceeding six feet in height require a separate permit from the City/County Building Department. A fence constructed on a corner lot that extends past the rear of the house along the side yard or abuts an alley requires approval from the City Engineer (Section 5-5-5B of the Grand Junction Zoning and Development Code).

The owner/applicant must correctly identify all property lines, easements, and rights-of-way and ensure the fence is located within the property's boundaries. Covenants, conditions, restrictions, easements and/or rights-of-way may restrict or prohibit the placement of fence(s). The owner/applicant is responsible for compliance with covenants, conditions, and restrictions which may apply. Fences built in easements may be subject to removal at the property owner's sole and absolute expense. Any modification of design and/or material as approved in this fence permit must be approved, in writing, by the Community Development Department Director.

I hereby acknowledge that I have read this application and the information and plot plan are correct; I agree to comply with any and all codes, ordinances, laws, regulations, or restrictions which apply.

I understand that failure to comply shall result in legal action, which may include but not necessarily be limited to removal of the fence(s) at the owner's cost.


Applicant's Signature Linda R. Todd Date 4-19-01
Community Development's Approval Ronnie Edwards Date 4-19-01
City Engineer's Approval (if required) N/A Date

VALID FOR SIX MONTHS FROM DATE OF ISSUANCE (Section 9-3-2D Grand Junction Zoning & Development Code)
(White: Planning) (Yellow: Customer) (Pink: Code Enforcement)

685 CRESTRIDGE DRIVE

TITLE #899320

ACCORDING TO THE REPLAT OF LOTS 4,10,11,12,15 AND 16
IN THE [unclear] SUBDIVISION, ACCORDING TO THE RECORDED PLAT
FILED MARCH 22, 1957 IN PLAT BOOK NO 9 AT PAGE 26.
[unclear], COLORADO.

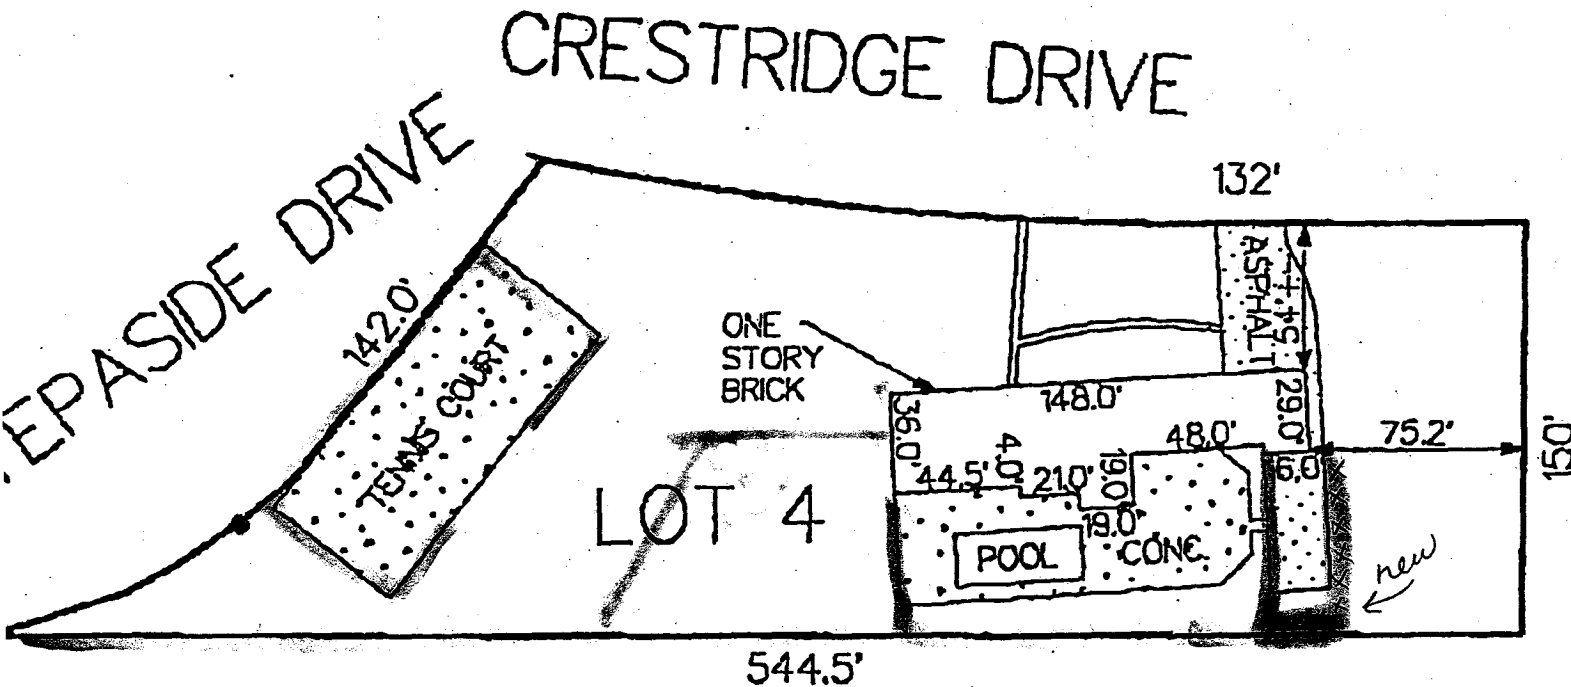

RSF-1
2945-022-

~~EXISTING~~
~~REMOVE~~
New

~~NEW~~
NEXT
YEAR