

FEE \$10.00

PERMIT #

11786

FENCE PERMIT

GRAND JUNCTION COMMUNITY DEVELOPMENT DEPARTMENT




THIS SECTION TO BE COMPLETED BY APPLICANT

AC

PLOT PLAN

PROPERTY ADDRESS 387 1/2 Skyler
 TAX SCHEDULE NO 2943-191-17-012
 PROPERTY OWNER Brand Ridge Properties
 OWNER'S PHONE 434-4616
 OWNER'S ADDRESS 3032 I-70 Bus Loop
 CONTRACTOR Great New Homes
 CONTRACTOR'S PHONE 434-4616
 CONTRACTOR'S ADDRESS 3032 I-70 Bus Loop
 FENCE MATERIAL Cedar
 FENCE HEIGHT 6'

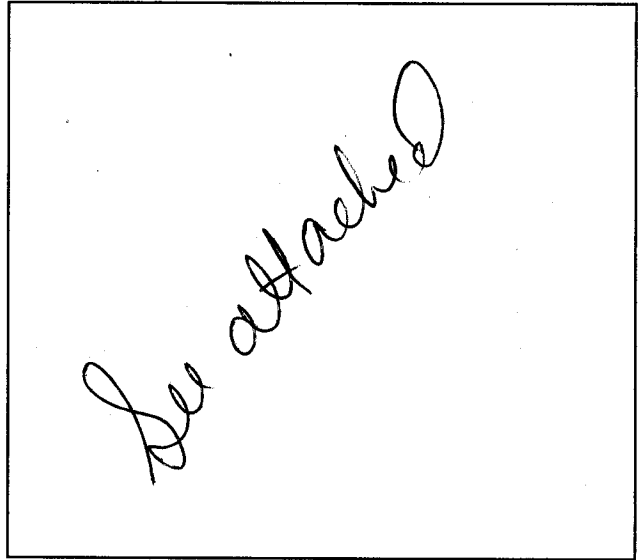

Plot plan must show property lines and property dimensions, all easements, all rights-of-way, all structures, all setbacks from property lines, & fence height(s). NOTE: PROPERTY LINE IS LIKELY ONE FOOT OR MORE BEHIND THE SIDEWALK.

THIS SECTION TO BE COMPLETED BY COMMUNITY DEVELOPMENT DEPARTMENT STAFF

ZONE PD
 SPECIAL CONDITIONS _____

SETBACKS: Front 25' from property line (PL) or
 from center of ROW, whichever is greater.
 Side 7 1/2' from PL Rear 20' from PL

Fences exceeding six feet in height require a separate permit from the City/County Building Department. A fence constructed on a corner lot that extends past the rear of the house along the side yard or abuts an alley requires approval from the City Engineer (Section 4.1.J of the Grand Junction Zoning and Development Code).

The owner/applicant must correctly identify all property lines, easements, and rights-of-way and ensure the fence is located within the property's boundaries. Covenants, conditions, restrictions, easements and/or rights-of-way may restrict or prohibit the placement of fence(s). The owner/applicant is responsible for compliance with covenants, conditions, and restrictions which may apply. Fences built in easements may be subject to removal at the property owner's sole and absolute expense. Any modification of design and/or material as approved in this fence permit must be approved, in writing, by the Community Development Department Director.

I hereby acknowledge that I have read this application and the information and plot plan are correct; I agree to comply with any and all codes, ordinances, laws, regulations, or restrictions which apply. I understand that failure to comply shall result in legal action, which may include but not necessarily be limited to removal of the fence(s) at the owner's cost.

Applicant's Signature [Signature]
 Community Development's Approval [Signature]
 City Engineer's Approval (if required) _____


Date 5-2-02
 Date 5/14/02
 Date _____

VALID FOR SIX MONTHS FROM DATE OF ISSUANCE (Section 2.2.E.1.d Grand Junction Zoning & Development Code)

(White: Planning)


(Yellow: Customer)

(Pink: Code Enforcement)

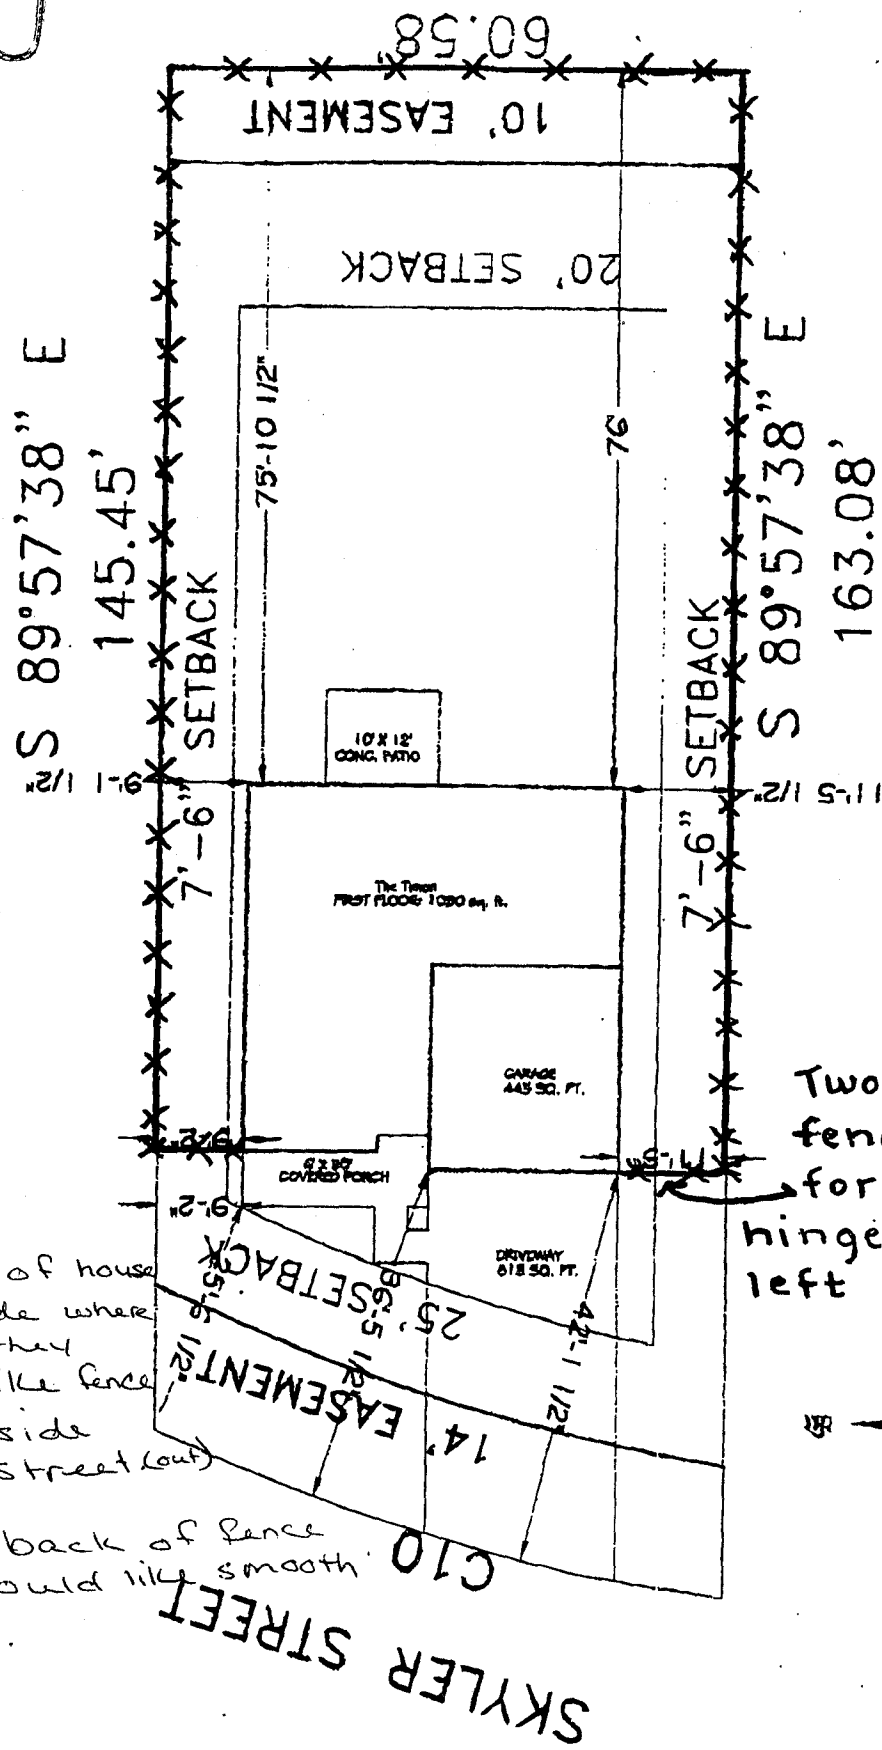

LOT 12 BLOCK 1
 387 1/2 Skyler Street
 Timon, RT

Two (2) 5-foot
 fence sections
 for 10-foot gate
 hinged on right and
 left

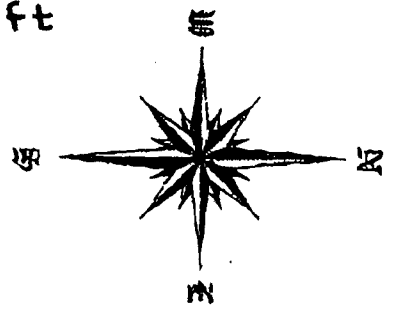

250' fence;

- * - left side of house & right side where gate is, they would like fence smooth side facing street (out)
- sides & back of fence they would like smooth side in.

Attachment "A"