

*(Handwritten initials)*



# FENCE PERMIT

GRAND JUNCTION COMMUNITY DEVELOPMENT DEPARTMENT

THIS SECTION TO BE COMPLETED BY APPLICANT

PLOT PLAN

PROPERTY ADDRESS 655 Starlight DR  
 TAX SCHEDULE NO 2943042-67-019  
 PROPERTY OWNER Terry Albee  
 OWNER'S PHONE NA  
 OWNER'S ADDRESS 655 Starlight DR  
 CONTRACTOR Rip Roaring Const  
 CONTRACTOR'S PHONE (970) 257-1337  
 CONTRACTOR'S ADDRESS 2986 Summerbrook DR  
 FENCE MATERIAL 6'6" (Dog ear) cedar  
 FENCE HEIGHT 6'

see attached

Plot plan must show property lines and property dimensions, all easements, all rights-of-way, all structures, all setbacks from property lines, & fence height(s). NOTE: PROPERTY LINE IS LIKELY ONE FOOT OR MORE BEHIND THE SIDEWALK.

THIS SECTION TO BE COMPLETED BY COMMUNITY DEVELOPMENT DEPARTMENT STAFF

ZONE PD SETBACKS: Front \_\_\_\_\_ from property line (PL) or \_\_\_\_\_ from center of ROW, whichever is greater.  
 SPECIAL CONDITIONS 6' fence along Sunlight Dr. must be 5' back from edge of sidewalk Side \_\_\_\_\_ from PL Rear \_\_\_\_\_ from PL

Fences exceeding six feet in height require a separate permit from the City/County Building Department. A fence constructed on a corner lot that extends past the rear of the house along the side yard or abuts an alley requires approval from the City Engineer (Section 4.1.J of the Grand Junction Zoning and Development Code).

The owner/applicant must correctly identify all property lines, easements, and rights-of-way and ensure the fence is located within the property's boundaries. Covenants, conditions, restrictions, easements and/or rights-of-way may restrict or prohibit the placement of fence(s). The owner/applicant is responsible for compliance with covenants, conditions, and restrictions which may apply. Fences built in easements may be subject to removal at the property owner's sole and absolute expense. Any modification of design and/or material as approved in this fence permit must be approved, in writing, by the Community Development Department Director.

I hereby acknowledge that I have read this application and the information and plot plan are correct; I agree to comply with any and all codes, ordinances, laws, regulations, or restrictions which apply. I understand that failure to comply shall result in legal action, which may include but not necessarily be limited to removal of the fence(s) at the owner's cost.

Applicant's Signature *Terry Albee*

Date 6/25/02

Community Development's Approval *C. Jay Gibson*

Date 6/29/02

City Engineer's Approval (if required) \_\_\_\_\_

Date \_\_\_\_\_


VALID FOR SIX MONTHS FROM DATE OF ISSUANCE (Section 2.2.E.1.d Grand Junction Zoning & Development Code)  
(White: Planning) (Yellow: Customer) (Pink: Code Enforcement)

# IMPROVEMENT LOCATION CERTIFICATE

655 Starlight Drive, Grand Junction, Co. 81506  
Lot 1 in Block 5 of Faircloud Subdivision, Filing No. 3  
Mesa County, Colorado

*Fence only*  
*6' dogeared 6"*  
*Cedar fence*  
*OK*  
*SLB*  
*Faircloud HOA*  
*6-20-02*

*Builder = Alike*  
*257-133.7*  
*NOT permitted*

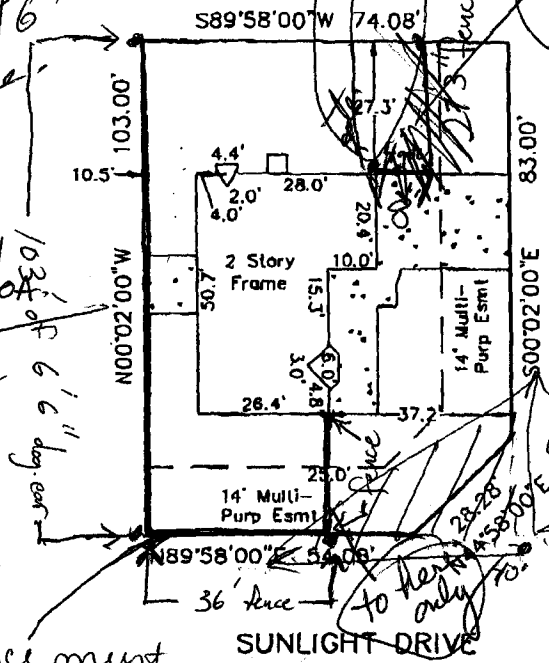


STARLIGHT DRIVE

SUNLIGHT DRIVE

*6' 6" (dog ear cedar)*  
*40' sight distance triangle*


*6' fence must be at least 5' from back of sidewalk*

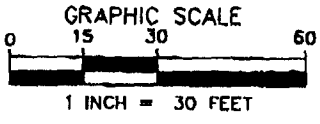

TITLE INFORMATION.  
PROVIDED BY:  
CoWest Mortgage  
FILE NO. 00144773  
BORROWER: Albee

I HEREBY CERTIFY THAT THIS IMPROVEMENT LOCATION CERTIFICATE WAS PREPARED FOR Unifirst Mortgage THAT THIS IS NOT A LAND SURVEY PLAT OR IMPROVEMENT SURVEY PLAT, AND THAT IT IS NOT TO BE RELIED UPON FOR THE ESTABLISHMENT OF FENCES, BUILDINGS, OR OTHER FUTURE IMPROVEMENTS LINES. I FURTHER CERTIFY THE IMPROVEMENTS ON THE ABOVE DESCRIBED PARCEL ON THIS DATE 04/18/02, EXCEPT UTILITY CONNECTIONS ARE ENTIRELY WITHIN THE BOUNDARIES OF THE PARCEL, EXCEPT AS SHOWN, THAT THERE ARE NO ENCROACHMENTS UPON THE DESCRIBED PREMISES BY IMPROVEMENTS OF ANY ADJOINING PREMISES, EXCEPT AS INDICATED, AND THAT THERE IS NO APPARENT EVIDENCE OR SIGN OF ANY EASEMENT CROSSING OR BURDENING ANY PART OF SAID PARCEL, EXCEPT AS NOTED.

*James L. White* 4/18/02  
James L. White PLS 31170

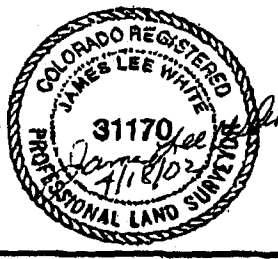

**Grand Valley Surveying**  
P.O. Box 41059  
Grand Junction, CO 81504  
(970) 243-5487 (phone/fax)  
(970) 261-9010 (cell)



SURVEYED BY:	jw	SURVEY DATE:	04/18/02
DRAWN BY:	jw	REQUESTED BY:	CoWest Mortgage
JOB No.	416		