

FEE \$10.00

PERMIT # 12586



FENCE PERMIT

GRAND JUNCTION COMMUNITY DEVELOPMENT DEPARTMENT

10

THIS SECTION TO BE COMPLETED BY APPLICANT

PROPERTY ADDRESS: <u>456 Duffy Dr.</u>	PLOT PLAN <i>see attached</i>
PROPERTY TAX NO: <u>2943-152-00-174</u>	
SUBDIVISION: <u>Summit View Meadows</u>	
PROPERTY OWNER: <u>Jeremiah & Sarah Fischer</u>	
OWNER'S PHONE: <u>434-8121</u>	
OWNER'S ADDRESS: <u>Same as above</u>	
CONTRACTOR NAME: <u>Zeck & Associates</u>	
CONTRACTOR'S PHONE: <u>858-0178</u>	
CONTRACTOR'S ADDRESS: <u>PO Box 550</u>	
FENCE MATERIAL & HEIGHT: <u>6'ft Cedar</u>	

Plot plan must show property lines and property dimensions, all easements, all rights-of-way, all structures, all setbacks from property lines, & fence height(s). NOTE: PROPERTY LINE IS LIKELY ONE FOOT OR MORE BEHIND THE SIDEWALK.

THIS SECTION TO BE COMPLETED BY COMMUNITY DEVELOPMENT DEPARTMENT STAFF

ZONE RMF-8 SETBACKS: Front _____ from property line (PL) or
 SPECIAL CONDITIONS _____ from center of ROW, whichever is greater.
 Side _____ from PL Rear _____ from PL



Fences exceeding six feet in height require a separate permit from the City/County Building Department. A fence constructed on a corner lot that extends past the rear of the house along the side yard or abuts an alley requires approval from the City Engineer (Section 4.1.J of the Grand Junction Zoning and Development Code).

The owner/applicant must correctly identify all property lines, easements, and rights-of-way and ensure the fence is located within the property's boundaries. Covenants, conditions, restrictions, easements and/or rights-of-way may restrict or prohibit the placement of fence(s). The owner/applicant is responsible for compliance with covenants, conditions, and restrictions which may apply. Fences built in easements may be subject to removal at the property owner's sole and absolute expense. Any modification of design and/or material as approved in this fence permit must be approved, in writing, by the Community Development Department Director.

I hereby acknowledge that I have read this application and the information and plot plan are correct; I agree to comply with any and all codes, ordinances, laws, regulations, or restrictions which apply. I understand that failure to comply shall result in legal action, which may include but not necessarily be limited to removal of the fence(s) at the owner's cost.

Applicant's Signature Sarah Fischer Date 9/23/03
 Community Development's Approval Gayleen Henderson Date 9-23-03
 City Engineer's Approval (if required) _____ Date _____

VALID FOR SIX MONTHS FROM DATE OF ISSUANCE (Section 2.2.E.1.d Grand Junction Zoning & Development Code)
 (White: Planning) (Yellow: Customer) (Pink: Code Enforcement)

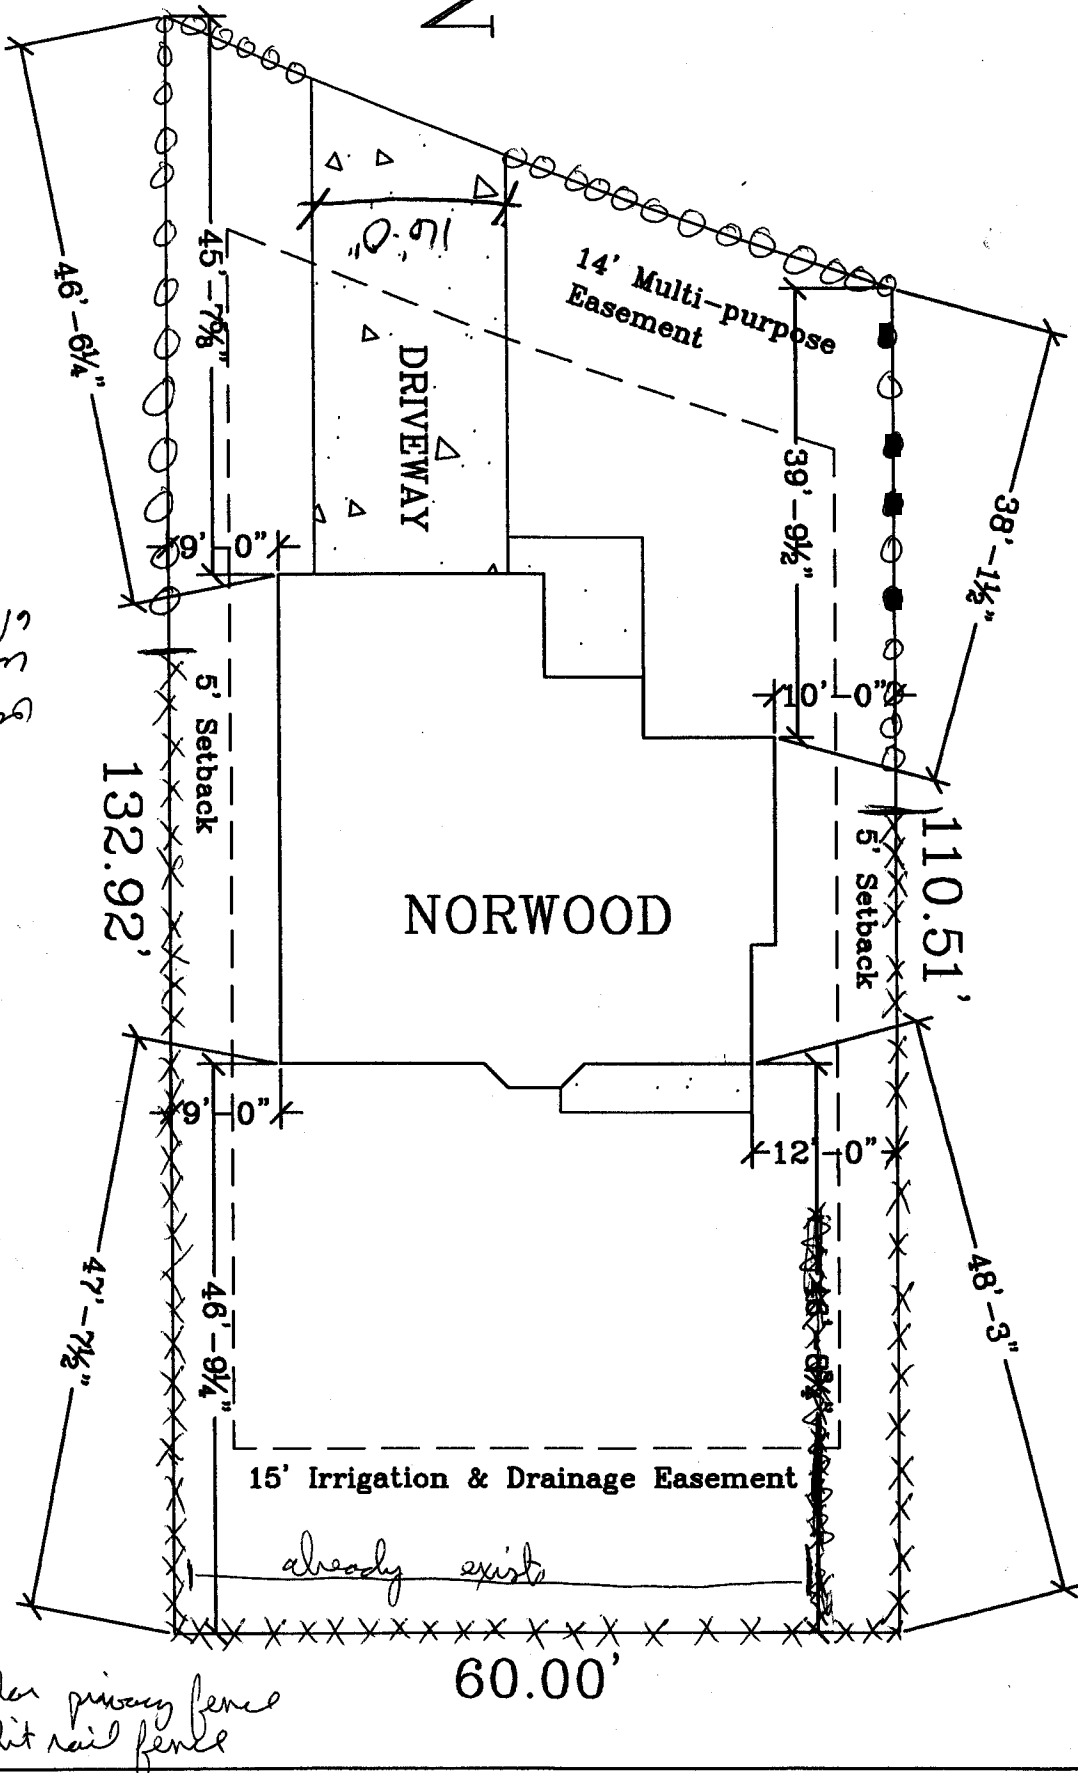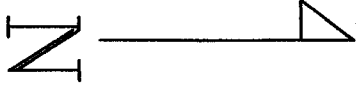

X-6" cedar privacy fence
 O-3" split rail fence

60.00'

<small>DATE</small> <small>BY</small> <small>CHKD</small> <small>APP'D</small>	<small>DATE</small> 5/12/03	Zeck & Associates, LLC P.O. Box 550 Fruita, CO 81521-0550 (970) 858-0178	456 Duffy Drive Summit View Meadows Lot 6 Block 1	<small>NO.</small> <small>DATE</small> <small>BY</small>	<small>NO.</small> 1	<small>DATE</small> 5/12/03	<small>BY</small> MAS
	<small>NO.</small> 1				<small>DATE</small> 5/12/03	<small>BY</small> MAS	