


ACCEPTED *8/14/03*
Chapman
 ANY CHANGE OF SETBACKS MUST BE APPROVED BY THE CITY PLANNING DEPT. IT IS THE APPLICANT'S RESPONSIBILITY TO PROPERLY LOCATE AND IDENTIFY EASEMENTS AND PROPERTY LINES.

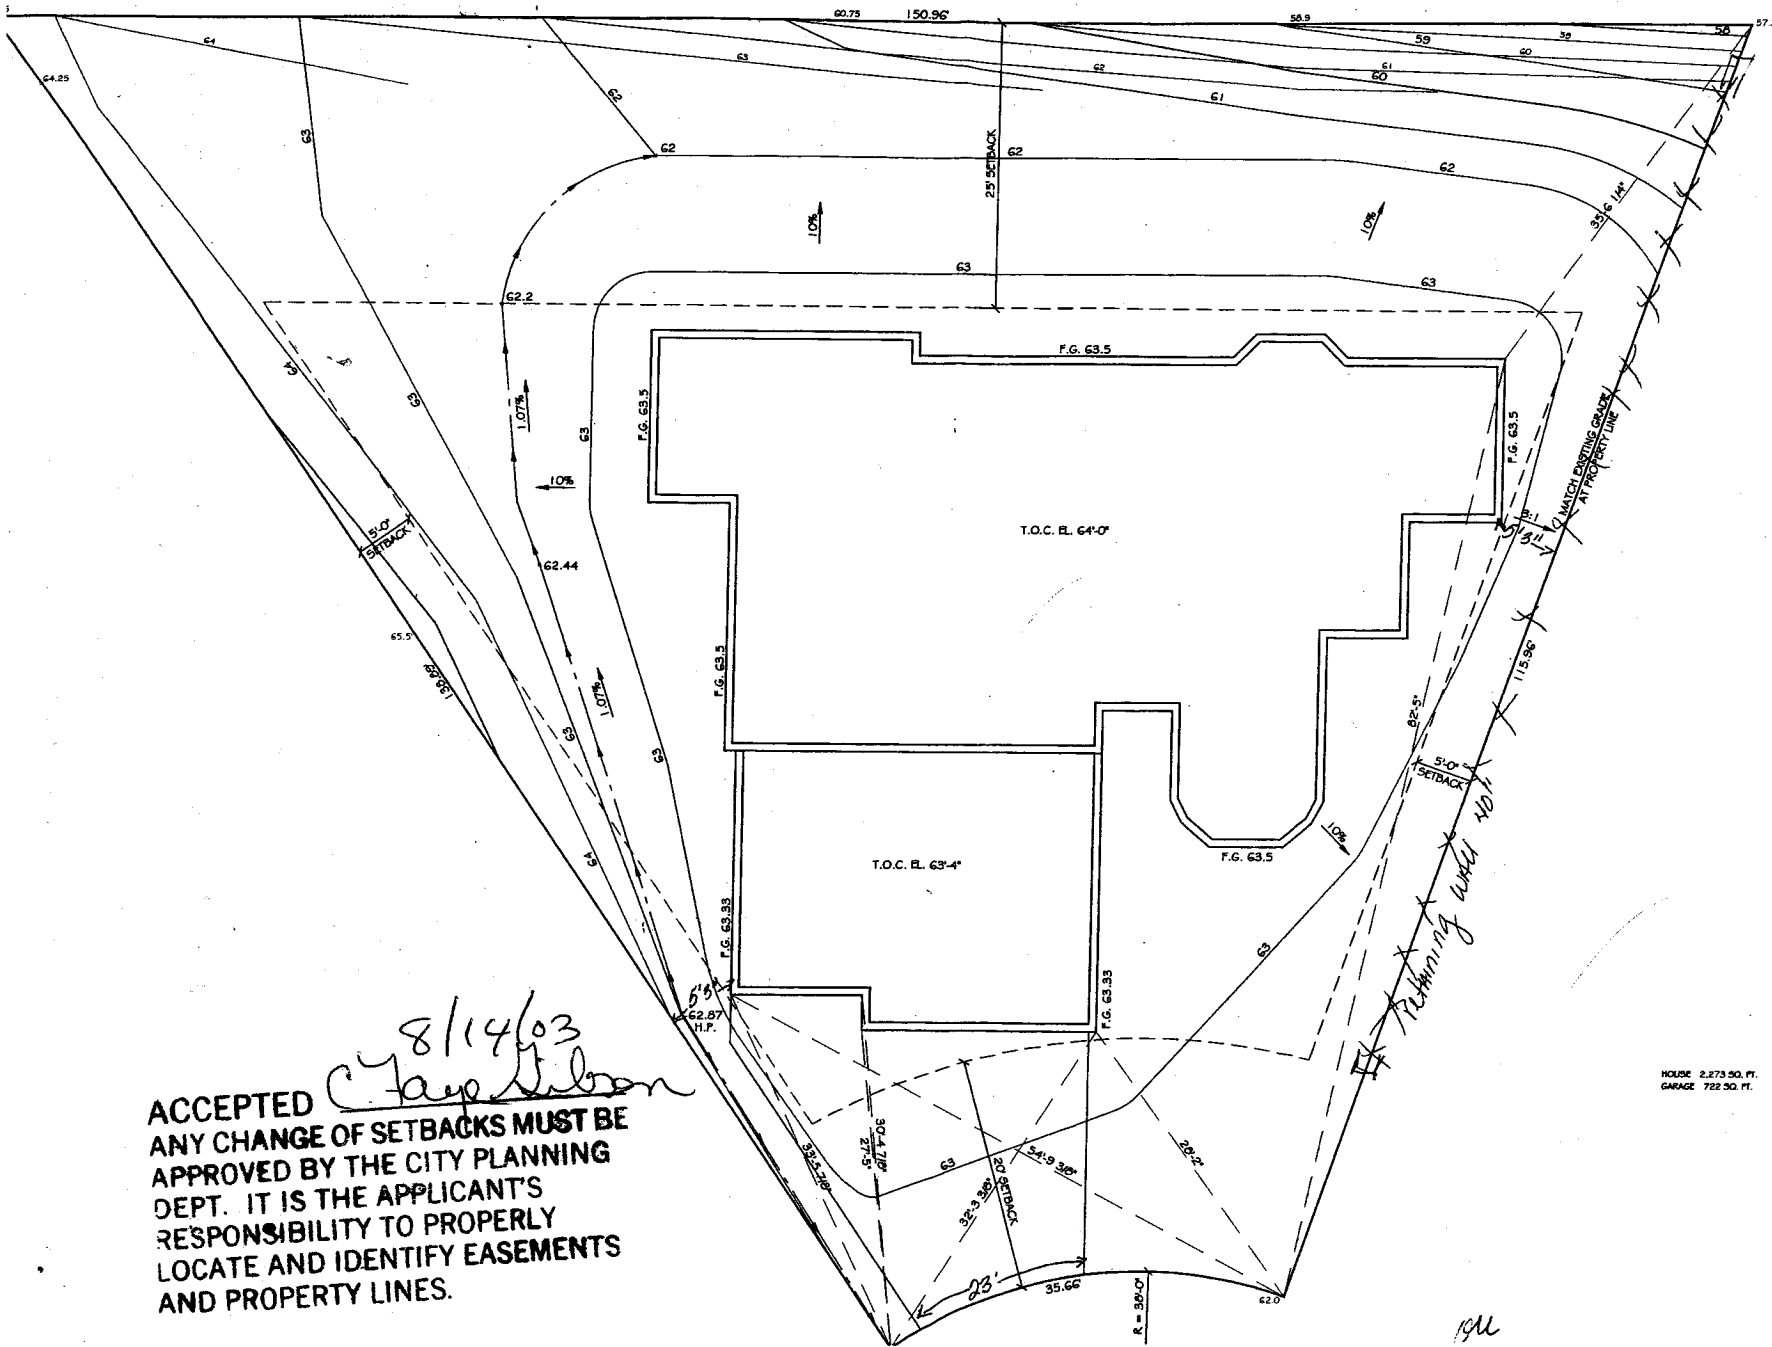

HOUSE 2,273 SQ. FT.
 GARAGE 722 SQ. FT.

DATE	06/13/2003	SCALE	3/16" = 1'-0"																																	
33-032																																				
DB Consulting Engineers, Inc. 2750 Congress Drive, Suite 801 Grand Junction, CO 81505 (970) 841-2846 voice (970) 857-9737 fax email: dbp_engineers@dbi.com																																				
BEHRENS BUILDING, INC. 2613 ASTER COURT GRAND JUNCTION COLORADO																																				
REVISIONS <table border="1"> <thead> <tr> <th>NO.</th> <th>DATE</th> <th>DESCRIPTION</th> </tr> </thead> <tbody> <tr> <td>1</td> <td></td> <td></td> </tr> <tr> <td>2</td> <td></td> <td></td> </tr> <tr> <td>3</td> <td></td> <td></td> </tr> <tr> <td>4</td> <td></td> <td></td> </tr> <tr> <td>5</td> <td></td> <td></td> </tr> <tr> <td>6</td> <td></td> <td></td> </tr> <tr> <td>7</td> <td></td> <td></td> </tr> <tr> <td>8</td> <td></td> <td></td> </tr> <tr> <td>9</td> <td></td> <td></td> </tr> <tr> <td>10</td> <td></td> <td></td> </tr> </tbody> </table>				NO.	DATE	DESCRIPTION	1			2			3			4			5			6			7			8			9			10		
NO.	DATE	DESCRIPTION																																		
1																																				
2																																				
3																																				
4																																				
5																																				
6																																				
7																																				
8																																				
9																																				
10																																				