

FEE \$10.00

PERMIT # 12948



# FENCE PERMIT

GRAND JUNCTION COMMUNITY DEVELOPMENT DEPARTMENT

THIS SECTION TO BE COMPLETED BY APPLICANT

PROPERTY ADDRESS: 373 High Desert Rd

PROPERTY TAX NO: 2945-200-54-002

SUBDIVISION: Redlands Mesa

PROPERTY OWNER: Somma

OWNER'S PHONE: 241-6989

OWNER'S ADDRESS: 448 Whitetail Ln

CONTRACTOR NAME: Steve Josepho

CONTRACTOR'S PHONE: 201-4403

CONTRACTOR'S ADDRESS: Box 1267

FENCE MATERIAL & HEIGHT: 30" solid in front

Plot Plan

See attached

Plot plan must show property lines and property dimensions, all easements, all rights-of-way, all structures, all setbacks from property lines, & fence height(s). NOTE: PROPERTY LINE IS LIKELY ONE FOOT OR MORE BEHIND THE SIDEWALK.

THIS SECTION TO BE COMPLETED BY COMMUNITY DEVELOPMENT DEPARTMENT STAFF

ZONE PD SETBACKS: Front 0' from property line (PL) or

SPECIAL CONDITIONS \_\_\_\_\_ from center of ROW, whichever is greater.

Side 0' from PL Rear 0' from PL

Fences exceeding six feet in height require a separate permit from the City/County Building Department. A fence constructed on a corner lot that extends past the rear of the house along the side yard or abuts an alley requires approval from the City Engineer (Section 4.1.J of the Grand Junction Zoning and Development Code).

The owner/applicant must correctly identify all property lines, easements, and rights-of-way and ensure the fence is located within the property's boundaries. Covenants, conditions, restrictions, easements and/or rights-of-way may restrict or prohibit the placement of fence(s). The owner/applicant is responsible for compliance with covenants, conditions, and restrictions which may apply. Fences built in easements may be subject to removal at the property owner's sole and absolute expense. Any modification of design and/or material as approved in this fence permit must be approved, in writing, by the Community Development Department Director.

I hereby acknowledge that I have read this application and the information and plot plan are correct; I agree to comply with any and all codes, ordinances, laws, regulations, or restrictions which apply. I understand that failure to comply shall result in legal action, which may include but not necessarily be limited to removal of the fence(s) at the owner's cost.

Applicant's Signature [Signature]

Community Development's Approval [Signature]


City Engineer's Approval (if required) [Signature]

Date 6-15-04


Date 6/15/04

Date \_\_\_\_\_


VALID FOR SIX MONTHS FROM DATE OF ISSUANCE (Section 2.2.E.1.d Grand Junction Zoning & Development Code)  
(White: Planning) (Yellow: Customer) (Pink: Code Enforcement)

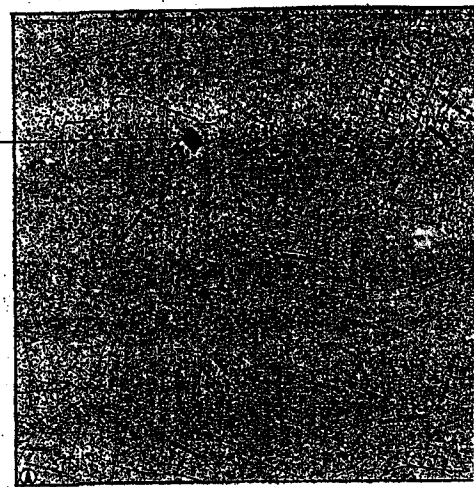

LOCATION

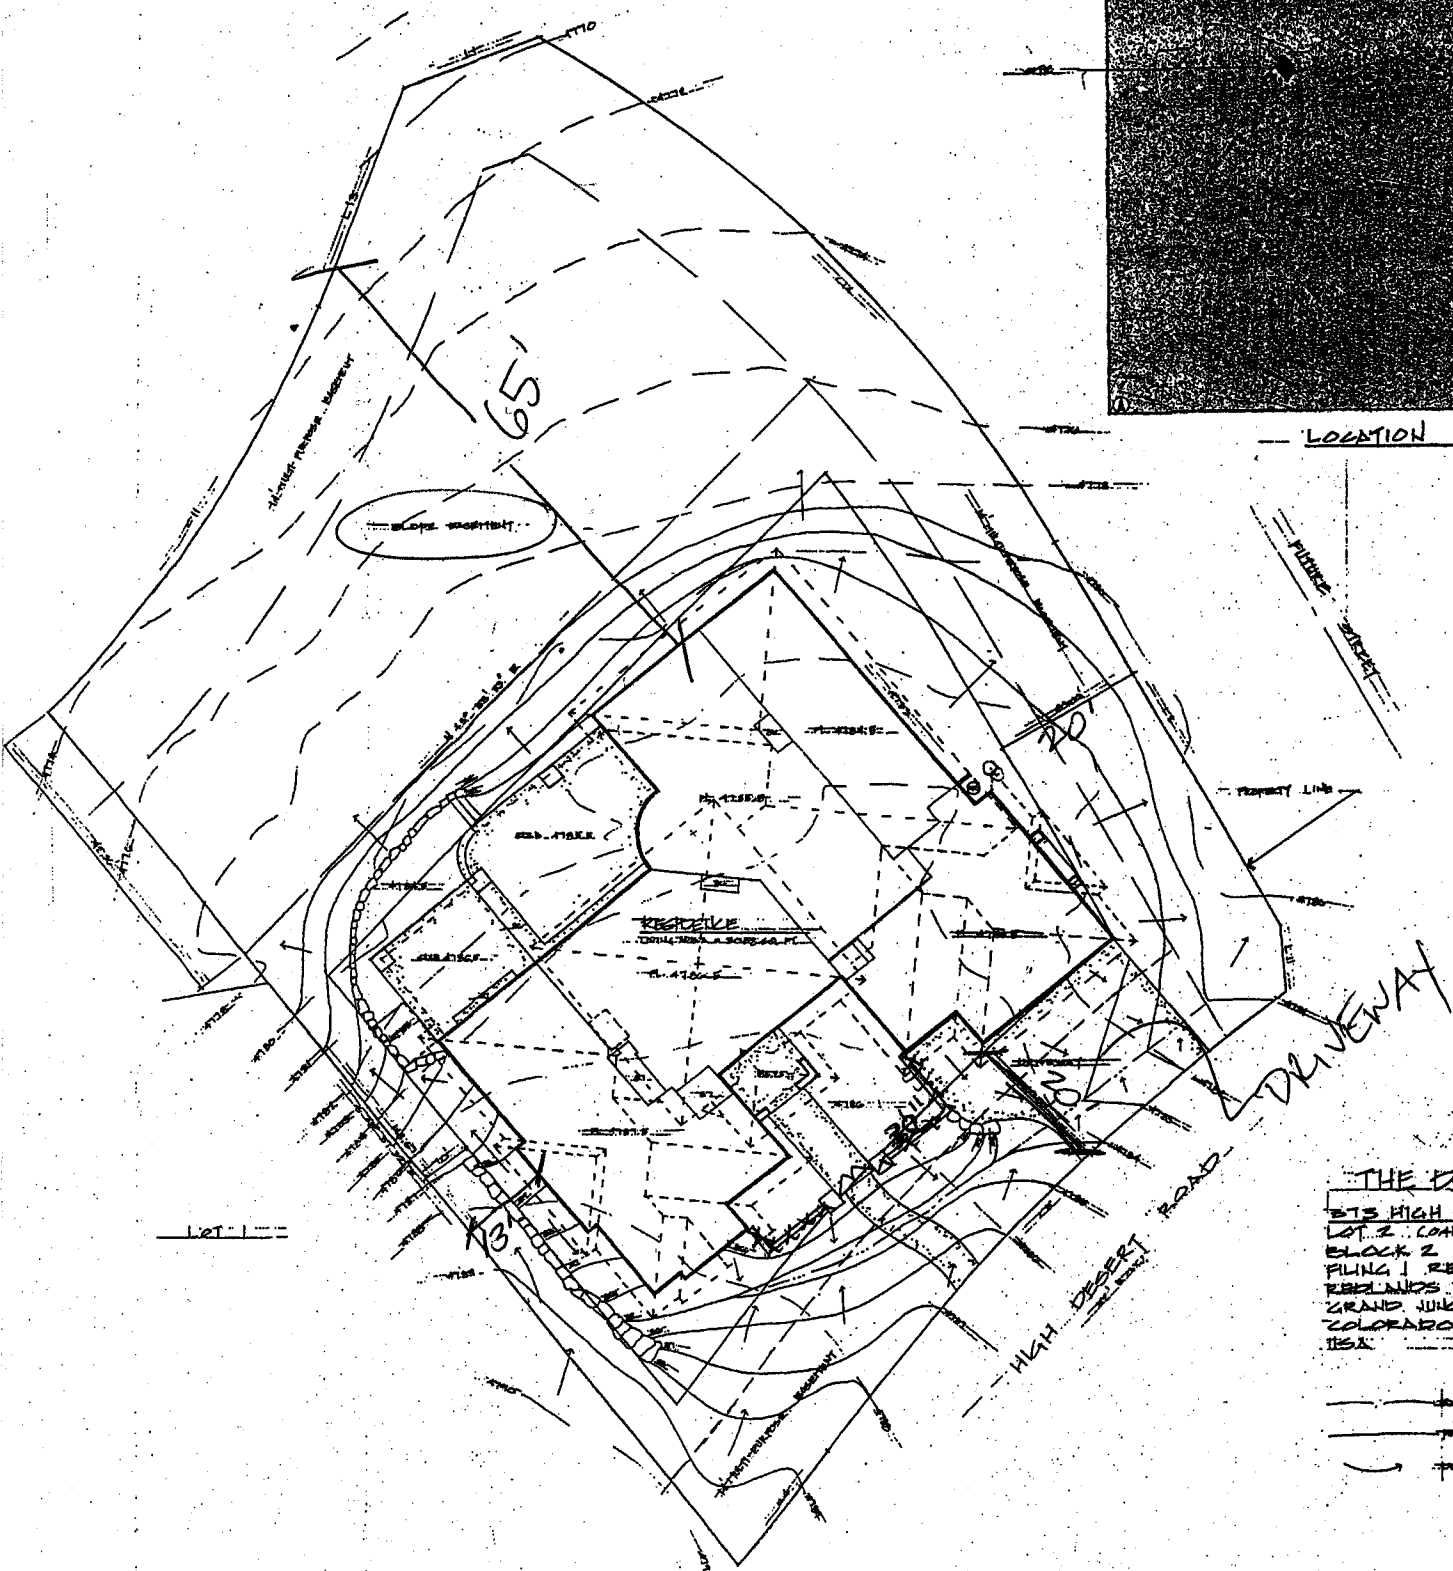

THE DESERT  
675 HIGH DESERT  
LOT 2 (0.411 ACRES)  
BLOCK 2  
FLUNG 1 REFLAT  
REBLANDS MESA  
GRAND JUNCTION  
COLORADO  
TEXAS

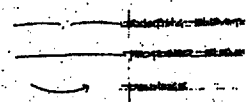

# SITE PLAN

