




N 08°37'34" E

171.46'

53' 1/2"

N 88°02'23" W  
154.84'

N 53°58'59" W  
187.09'

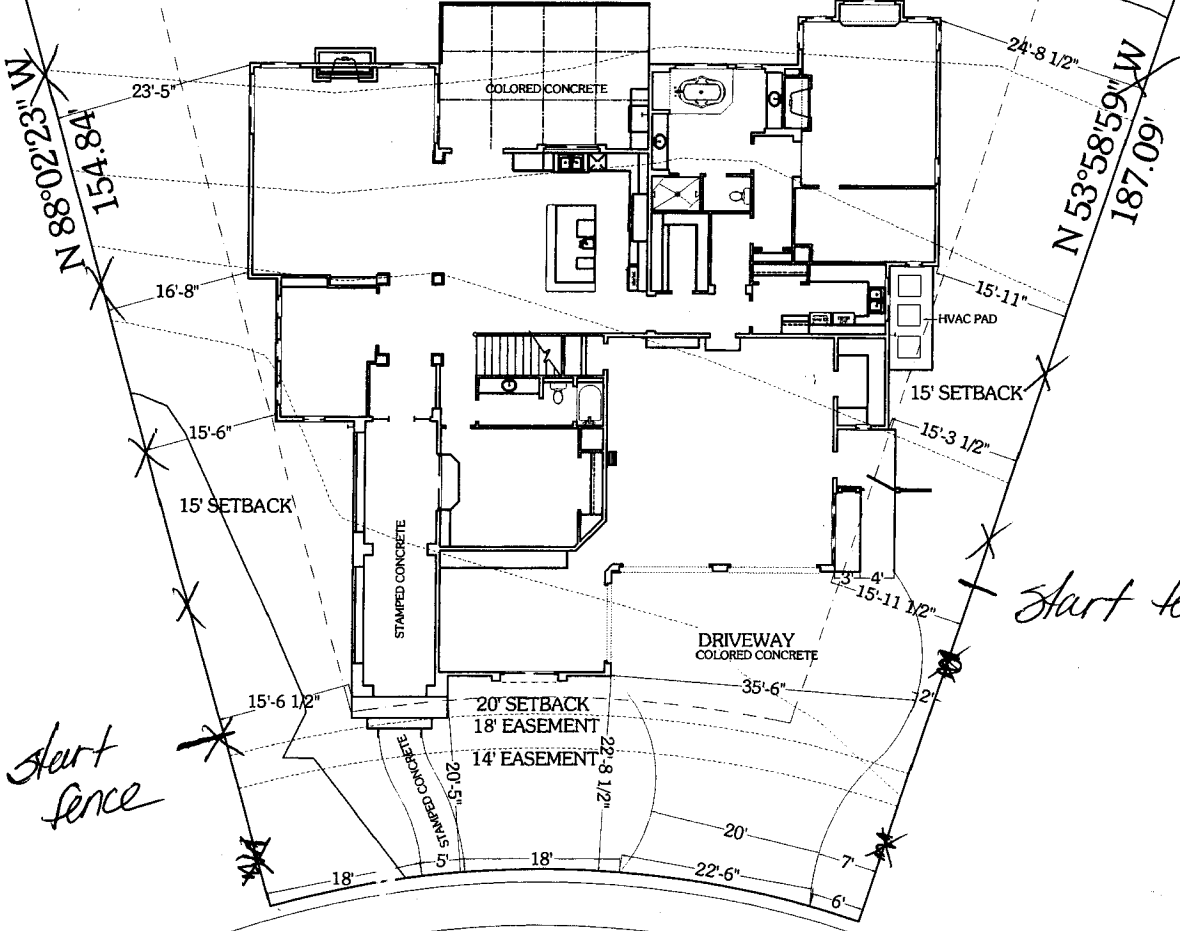

LOT 17  
0.44 ACRES

442 H.P.