




*Steve Werman 3/12/07*

ACCEPTED  
 ANY CHANGE OF SETBACKS MUST BE  
 APPROVED BY THE CITY PLANNING  
 DEPARTMENT. THE APPLICANT'S  
 RESPONSIBILITY IS TO PROPERLY  
 LOCATE AND IDENTIFY EASEMENTS  
 AND PROPERTY LINES.

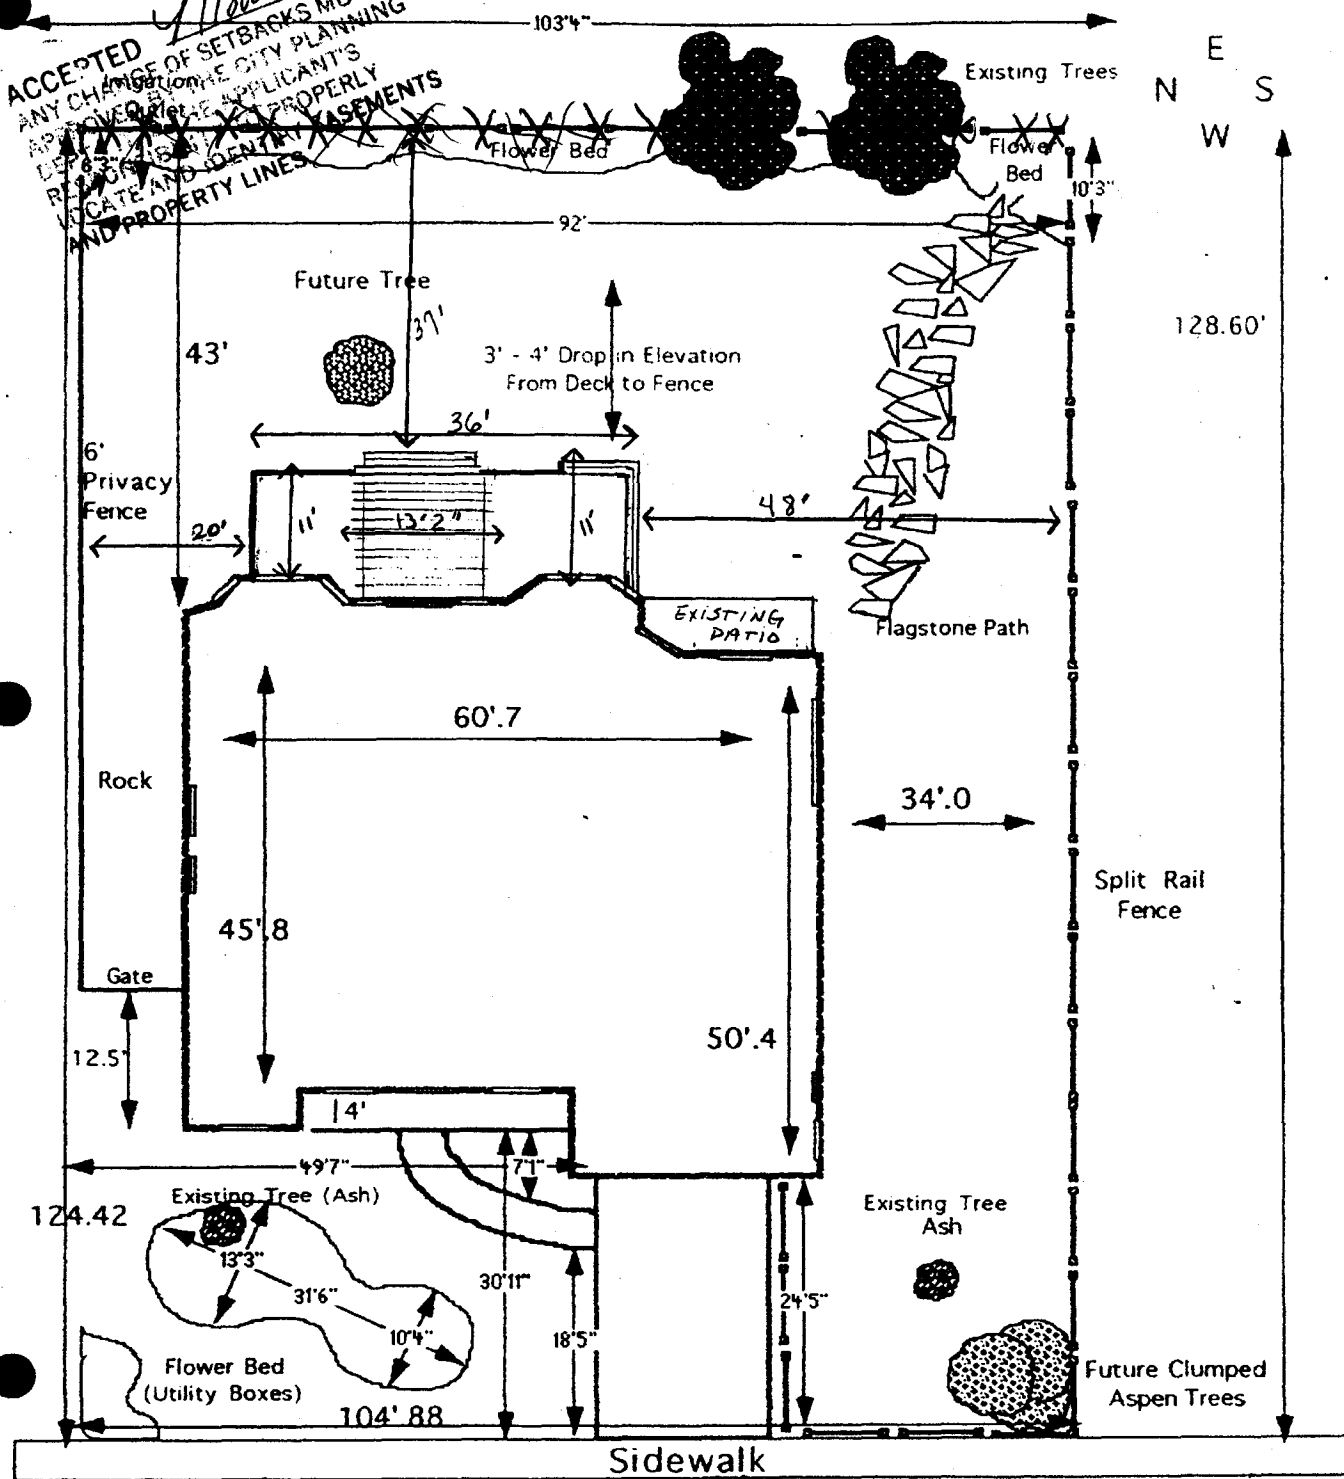

Steve & Tauha Werman  
 2034 PAINT PONY LN  
 GRAND HT CO 91502