


5-9-03 Gayleen Henderson

ACCEPTED
ANY CHANGE OF SETBACKS MUST BE APPROVED BY THE CITY PLANNING DEPT. IT IS THE APPLICANT'S RESPONSIBILITY TO PROPERLY LOCATE AND IDENTIFY EASEMENTS AND PROPERTY LINES.

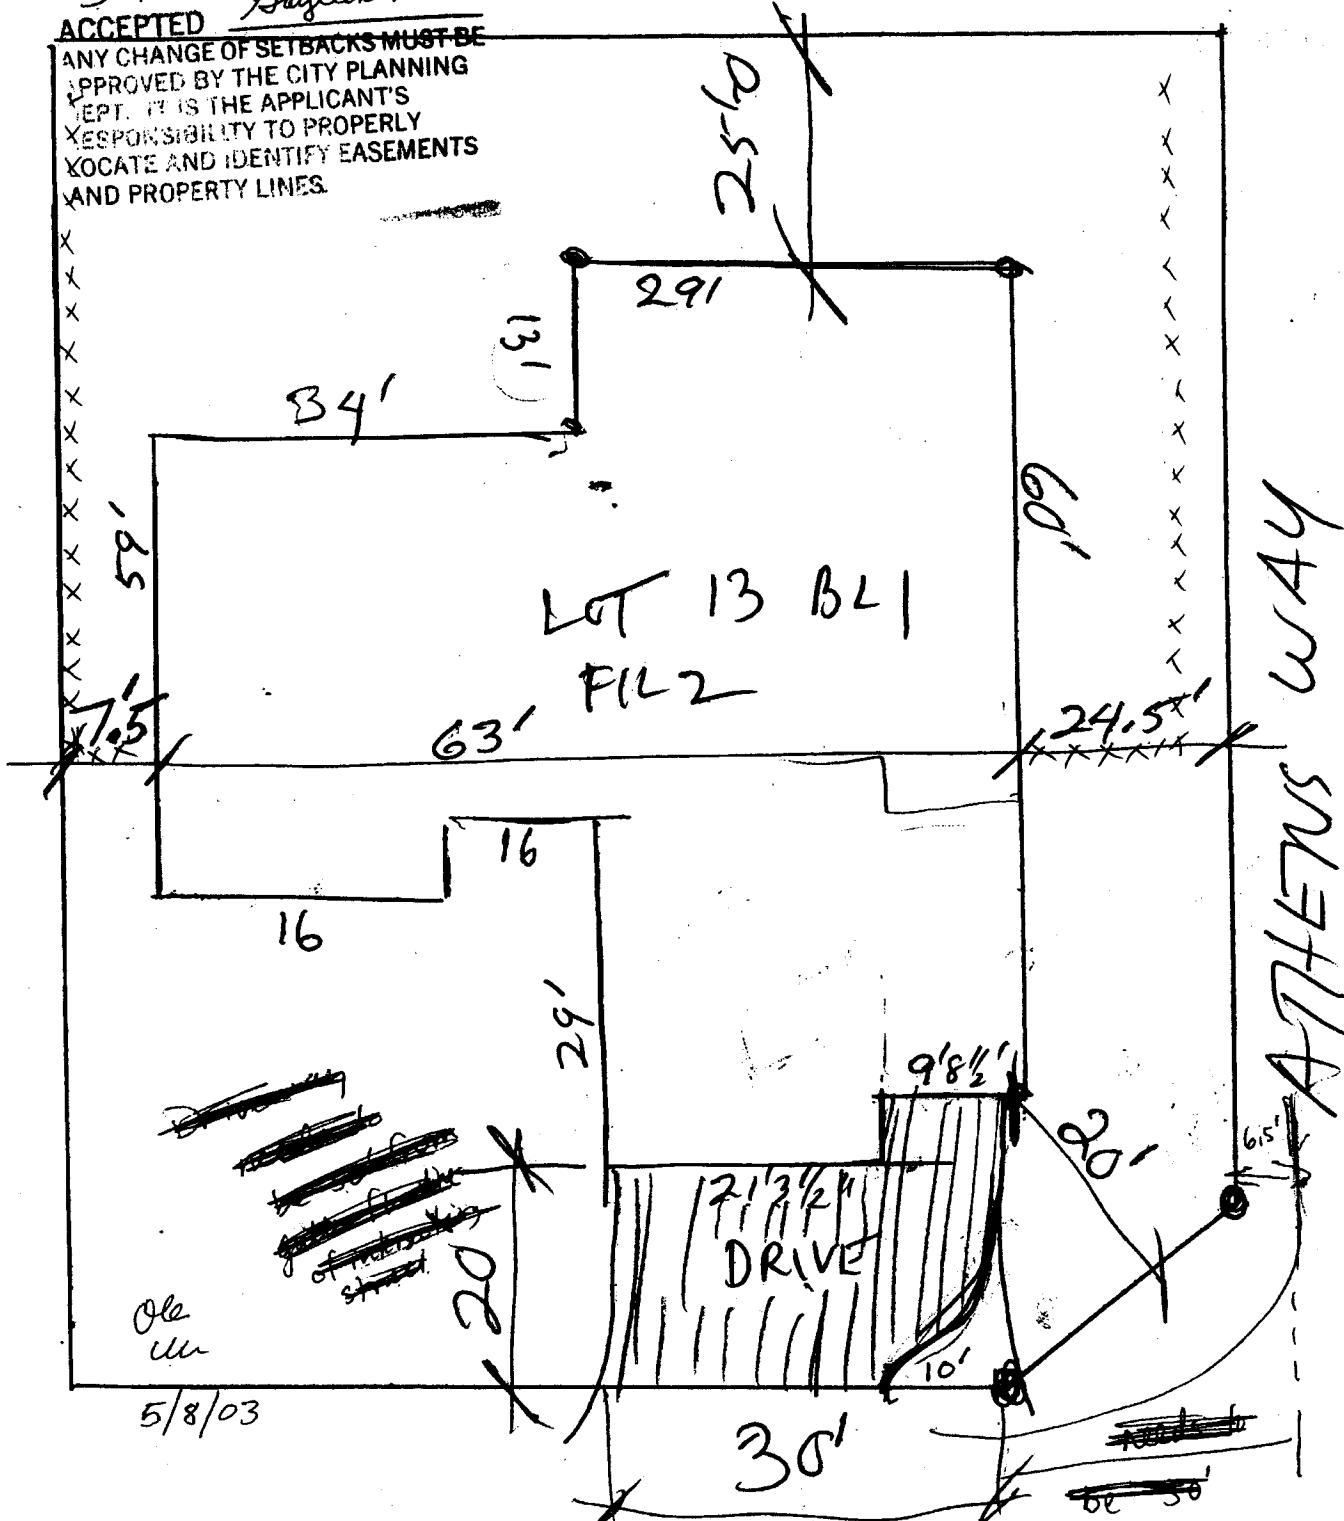

LOT 13 BL1

FIL 2


21 3/4' DRIVE

ATHENS WAY

Old use

5/8/03

2222 DA VINCI PLACE

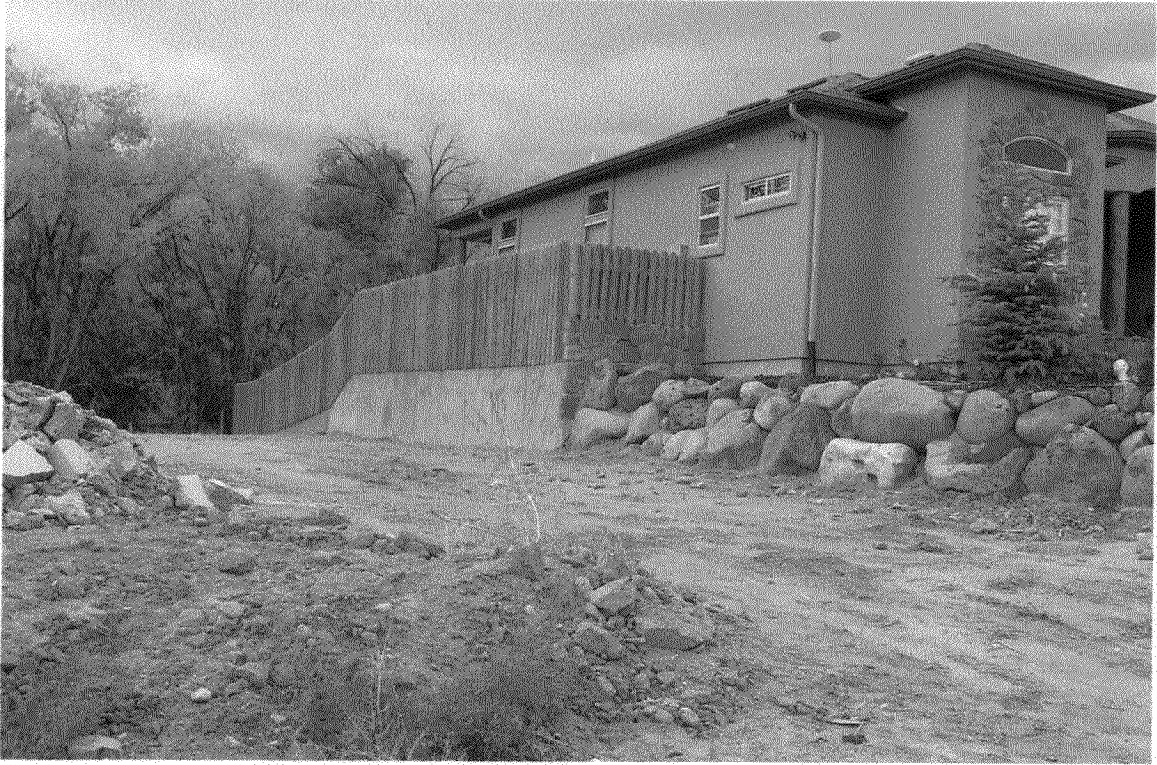

2222 Davinci Place