


25-04 Gayle Handerson
 ACCEPTED BY THE DISTRICT BOARD
 RESPONSIBILITY TO PROPERLY
 LOCATE AND IDENTIFY EASEMENTS
 AND PROPERTY LINES.

Irrigation &
 Drainage
 Easement

Lot 8 BLC 4 (A)

215 104
 W
 W

14' Multipurpose
 Easement

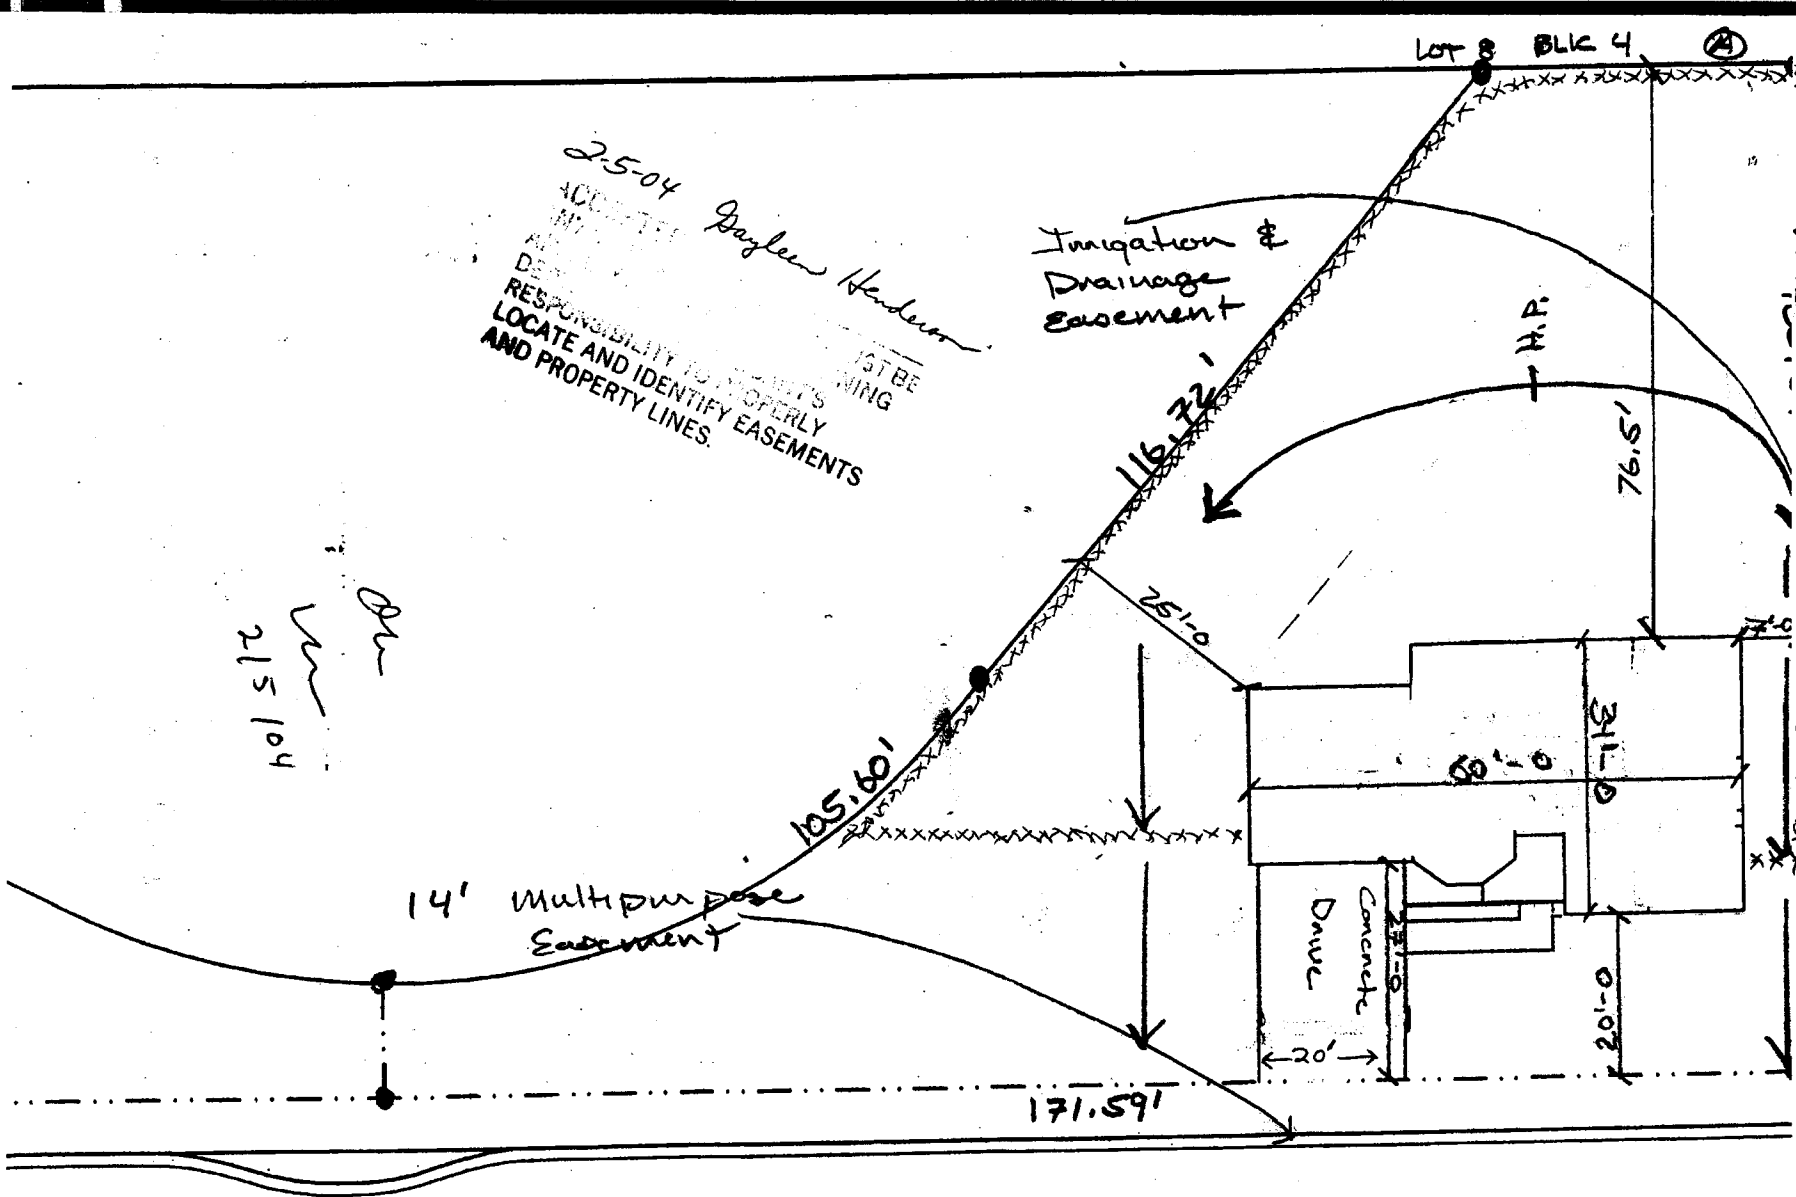

2665 Sheene
 T.O.C MIN. 4678.9
 T.O.C MAX. 4680.9