


95.2' over by site

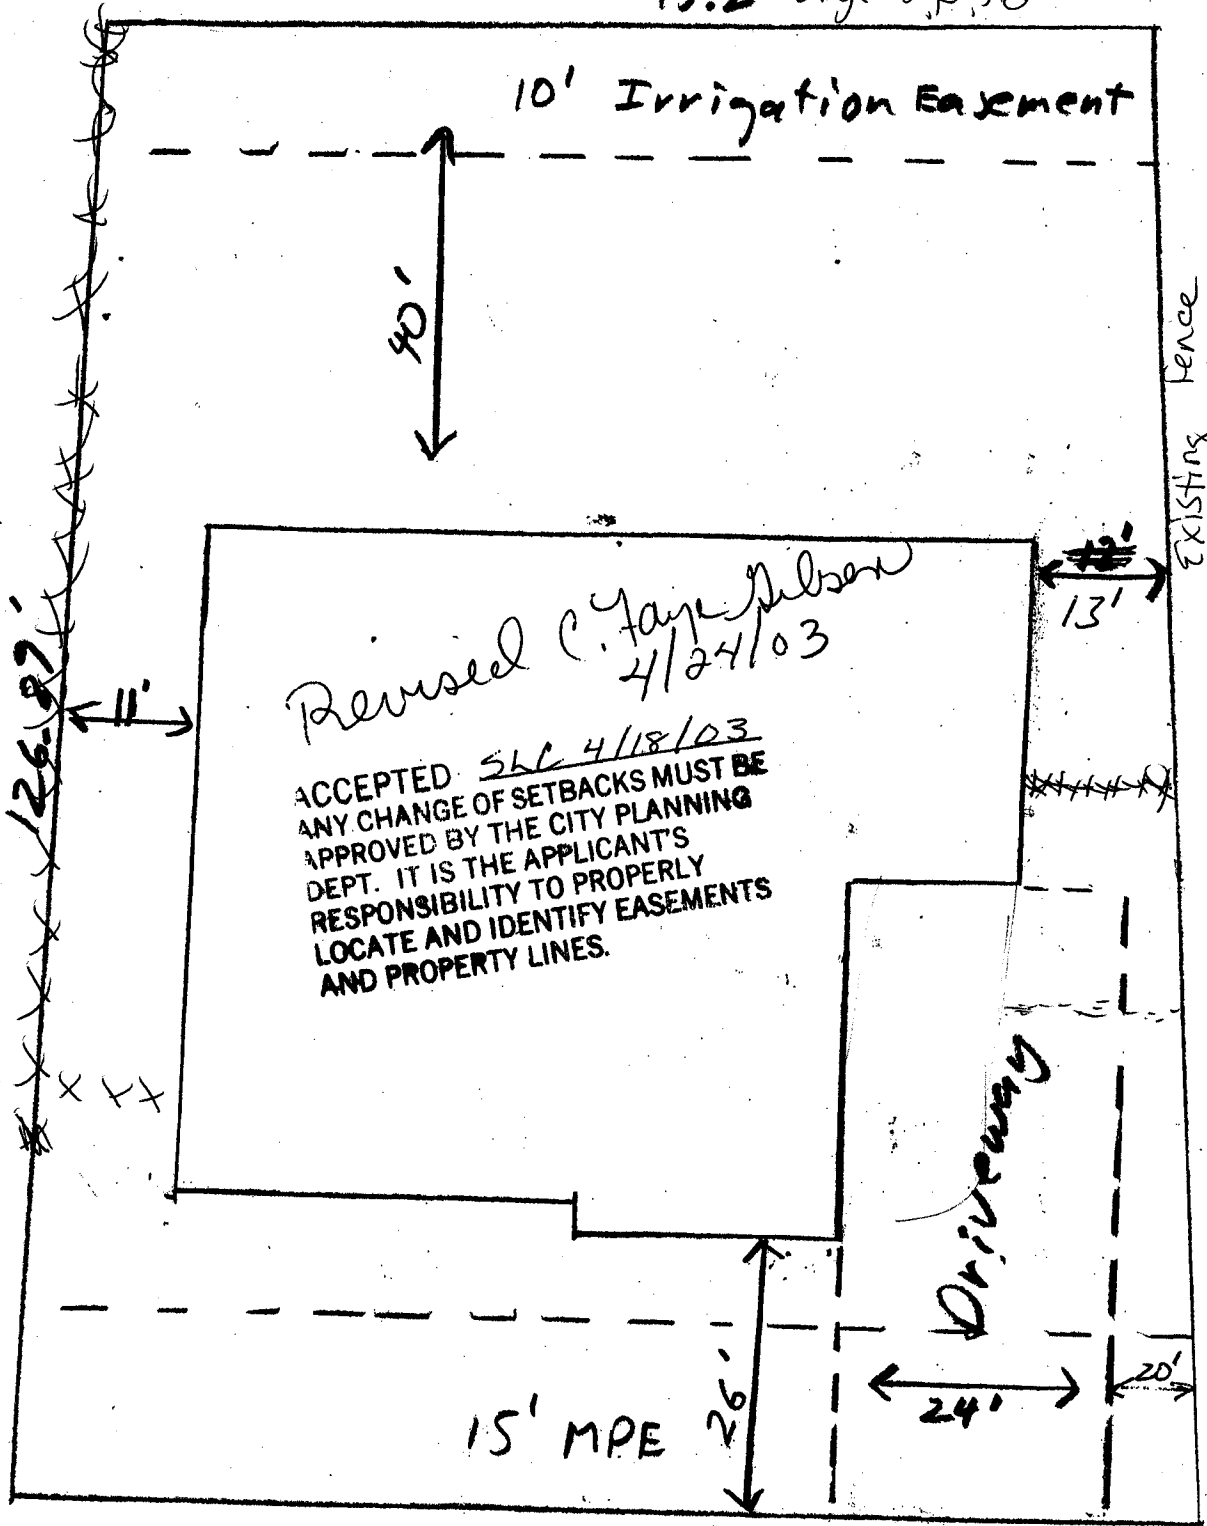

10' Irrigation Easement

40'

Revised C. Jaye Nelson
4/24/03

ACCEPTED. SLC 4/18/03
ANY CHANGE OF SETBACKS MUST BE
APPROVED BY THE CITY PLANNING
DEPT. IT IS THE APPLICANT'S
RESPONSIBILITY TO PROPERLY
LOCATE AND IDENTIFY EASEMENTS
AND PROPERTY LINES.

EXISTING Fence

13'

130.98'

26.87'

11'

Driveway

24'

15' MPE

26'

121.8'

686 Tranquil Trail
Street

on
in
4/18/03