

FEE \$10.00

PERMIT # 13231



FENCE PERMIT
GRAND JUNCTION COMMUNITY DEVELOPMENT DEPARTMENT

THIS SECTION TO BE COMPLETED BY APPLICANT

PROPERTY ADDRESS: 720 Spanish Trail Dr J.C.
PROPERTY TAX NO: 2701-333-40-010 81505
SUBDIVISION: Spanish Trail
PROPERTY OWNER: Charlotte Bercher
OWNER'S PHONE: 241-9249
OWNER'S ADDRESS: 720 Spanish Trail Dr J.C.
CONTRACTOR NAME: 4 Seasons (DAVE) 81505
CONTRACTOR'S PHONE:
CONTRACTOR'S ADDRESS:
FENCE MATERIAL & HEIGHT: 6 ft ? PVC

PLOT PLAN

See attached

Plot plan must show property lines and property dimensions, all easements, all rights-of-way, all structures, all setbacks from property lines, & fence height(s). NOTE: PROPERTY LINE IS LIKELY ONE FOOT OR MORE BEHIND THE SIDEWALK.

THIS SECTION TO BE COMPLETED BY COMMUNITY DEVELOPMENT DEPARTMENT STAFF

ZONE PD
SETBACKS: Front 20' from property line (PL) or
SPECIAL CONDITIONS
Side 0' from PL Rear 0' from PL

Fences exceeding six feet in height require a separate permit from the City/County Building Department. A fence constructed on a corner lot that extends past the rear of the house along the side yard or abuts an alley requires approval from the City Engineer (Section 4.1.J of the Grand Junction Zoning and Development Code).

The owner/applicant must correctly identify all property lines, easements, and rights-of-way and ensure the fence is located within the property's boundaries. Covenants, conditions, restrictions, easements and/or rights-of-way may restrict or prohibit the placement of fence(s). The owner/applicant is responsible for compliance with covenants, conditions, and restrictions which may apply. Fences built in easements may be subject to removal at the property owner's sole and absolute expense. Any modification of design and/or material as approved in this fence permit must be approved, in writing, by the Community Development Department Director.

I hereby acknowledge that I have read this application and the information and plot plan are correct; I agree to comply with any and all codes, ordinances, laws, regulations, or restrictions which apply. I understand that failure to comply shall result in legal action, which may include but not necessarily be limited to removal of the fence(s) at the owner's cost.

Applicant's Signature Charlotte Bercher Date 8-11-04
Community Development's Approval Jay Hall Date 8/11/04
City Engineer's Approval (if required) Date

VALID FOR SIX MONTHS FROM DATE OF ISSUANCE (Section 2.2.E.1.d Grand Junction Zoning & Development Code)
(White: Planning) (Yellow: Customer) (Pink: Code Enforcement)

ACCEPTED *Robert B. ...*  
 ANY CHANGE OF SETBACKS MUST BE APPROVED BY THE CITY PLANNING DEPT. IT IS THE APPLICANT'S RESPONSIBILITY TO PROPERLY LOCATE AND IDENTIFY EASEMENTS AND PROPERTY LINES.


AUTO COURT

*all  
 km  
 12/10/03*

SIDE S  
 REAR 10' PARALLEL W/AUTO CT  
 FRONT (GARAGE) 20'  
 FRONT (HOUSE) 15'  
**SETBACKS:**



SPANISH TRAILS DR.  
 N00°05'29"E 61'

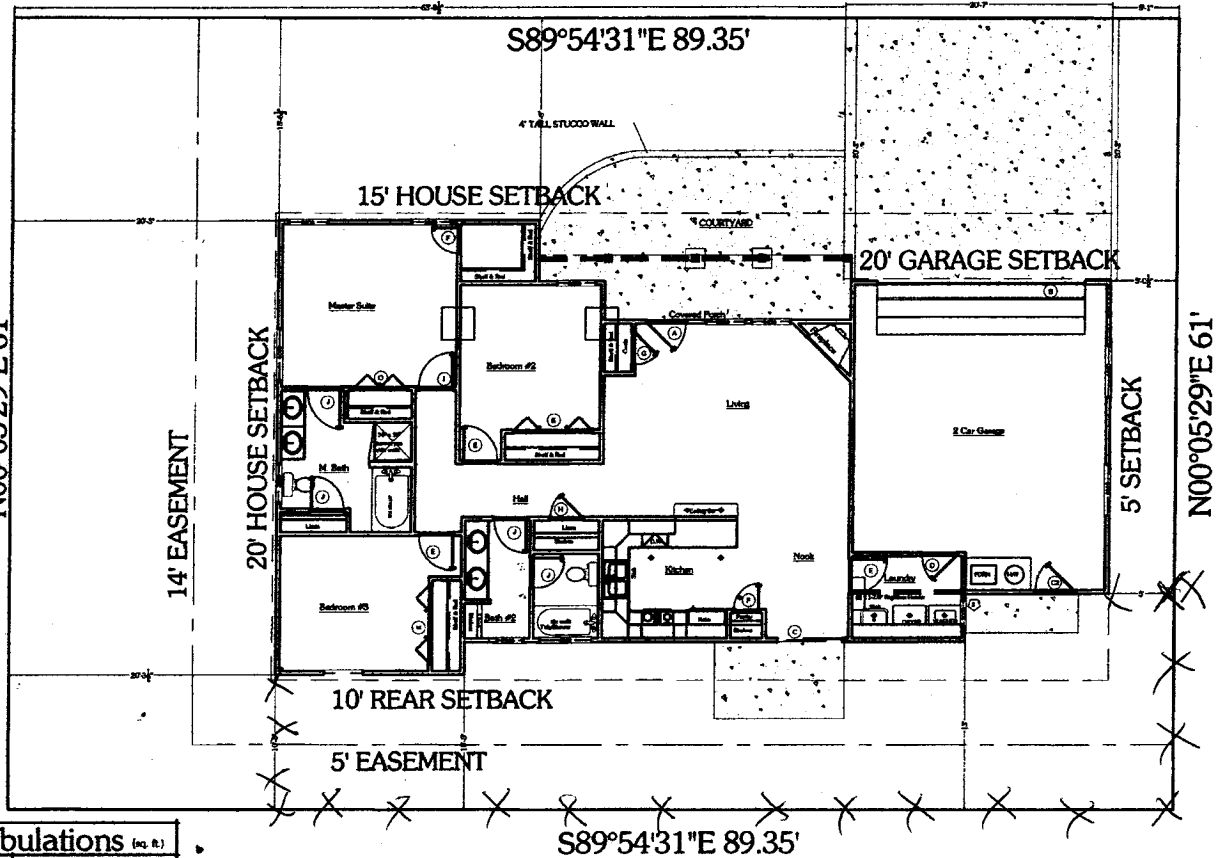

| Standard Area Tabulations (sq. ft.) |        |        |              |
|-------------------------------------|--------|--------|--------------|
| Level                               | Living | Garage | Patios/Decks |
| Main                                | 1367   | 458    | 82           |
| Total                               | 1367   |        |              |

720 SPANISH TRAILS DR.

SITE PLAN

SCALE: 1"=10'

REVISIONS  
 \_\_\_\_\_  
 \_\_\_\_\_  
 \_\_\_\_\_  
 \_\_\_\_\_  
 DRAWN BY:  
 Keith  
 Davis  
 DATE:  
 11-7-03

Address: 720 Spanish Trails  
 Project: RIDEMORE PLAN #1367

SHEET  
**C1**